

# **Appendix C**

## **Utility Agency/Owner Material Received**



# **AT&T Distribution Forms and Figures**







## District 2 Utility Contact Form

**Please Fill Out Completely**

Date: 9/12/2024  
Company Name: ATT FL  
Phone Number: 904 699-4976  
Email Address: pp5963@att.com  
FPI: 210447-5-52-01 SR16 St. Johns Co. Roadway Plan Sheets Dtd 8/5/24 Add Lanes/Reconstruct  
Emergency number to be inserted on plans

**Repair Desk: 877.737.2478**

Existing facilities are located:

- ☒ Within existing FDOT Right-of-Way (between Station: \_\_\_\_\_ to Station: \_\_\_\_\_)  
☐ Within existing County/City Right-of-Way (between Station: \_\_\_\_\_ to Station: \_\_\_\_\_)  
☐ Within railroad Right-of-Way (between Station: \_\_\_\_\_ to Station: \_\_\_\_\_)  
☐ Within an easement or fee title property (Has compensable interest and may claim reimbursement for required relocation) \*  
☐ Not within project limits (Has no facilities within limits)  
☐ No Utility Work Schedule (Has facilities within limits but is not affected)  
☐ There will not be a claim for reimbursement  
☐ There will be a claim for reimbursement \*

\* Please provide any document(s) [i.e. fee title property deed or easement document(s)] within the project limits that formulates the basis for your entitlement to be reimbursed for your utility work. NOTE: A preliminary cost estimate for any utility work within this entitled area is required.

Enclosed please find:

|                                                          |                                                    |
|----------------------------------------------------------|----------------------------------------------------|
| <input checked="" type="checkbox"/> Marked Roadway Plans | <input type="checkbox"/> Company Utility Plans     |
| <input type="checkbox"/> Legal Documents                 | <input type="checkbox"/> Preliminary Cost Estimate |

**POLE OWNERS: List Joint Pole Users**

### COMMENTS:



Level D Markups to be provided in next 2-3 weeks

Signed: \_\_\_\_\_

Title: \_\_\_\_\_

(Signature is not required if uploading directly in PSEE)

210447-5 FDOT Plan Sheets (Roadway - Dtd 8/5/24) 081224

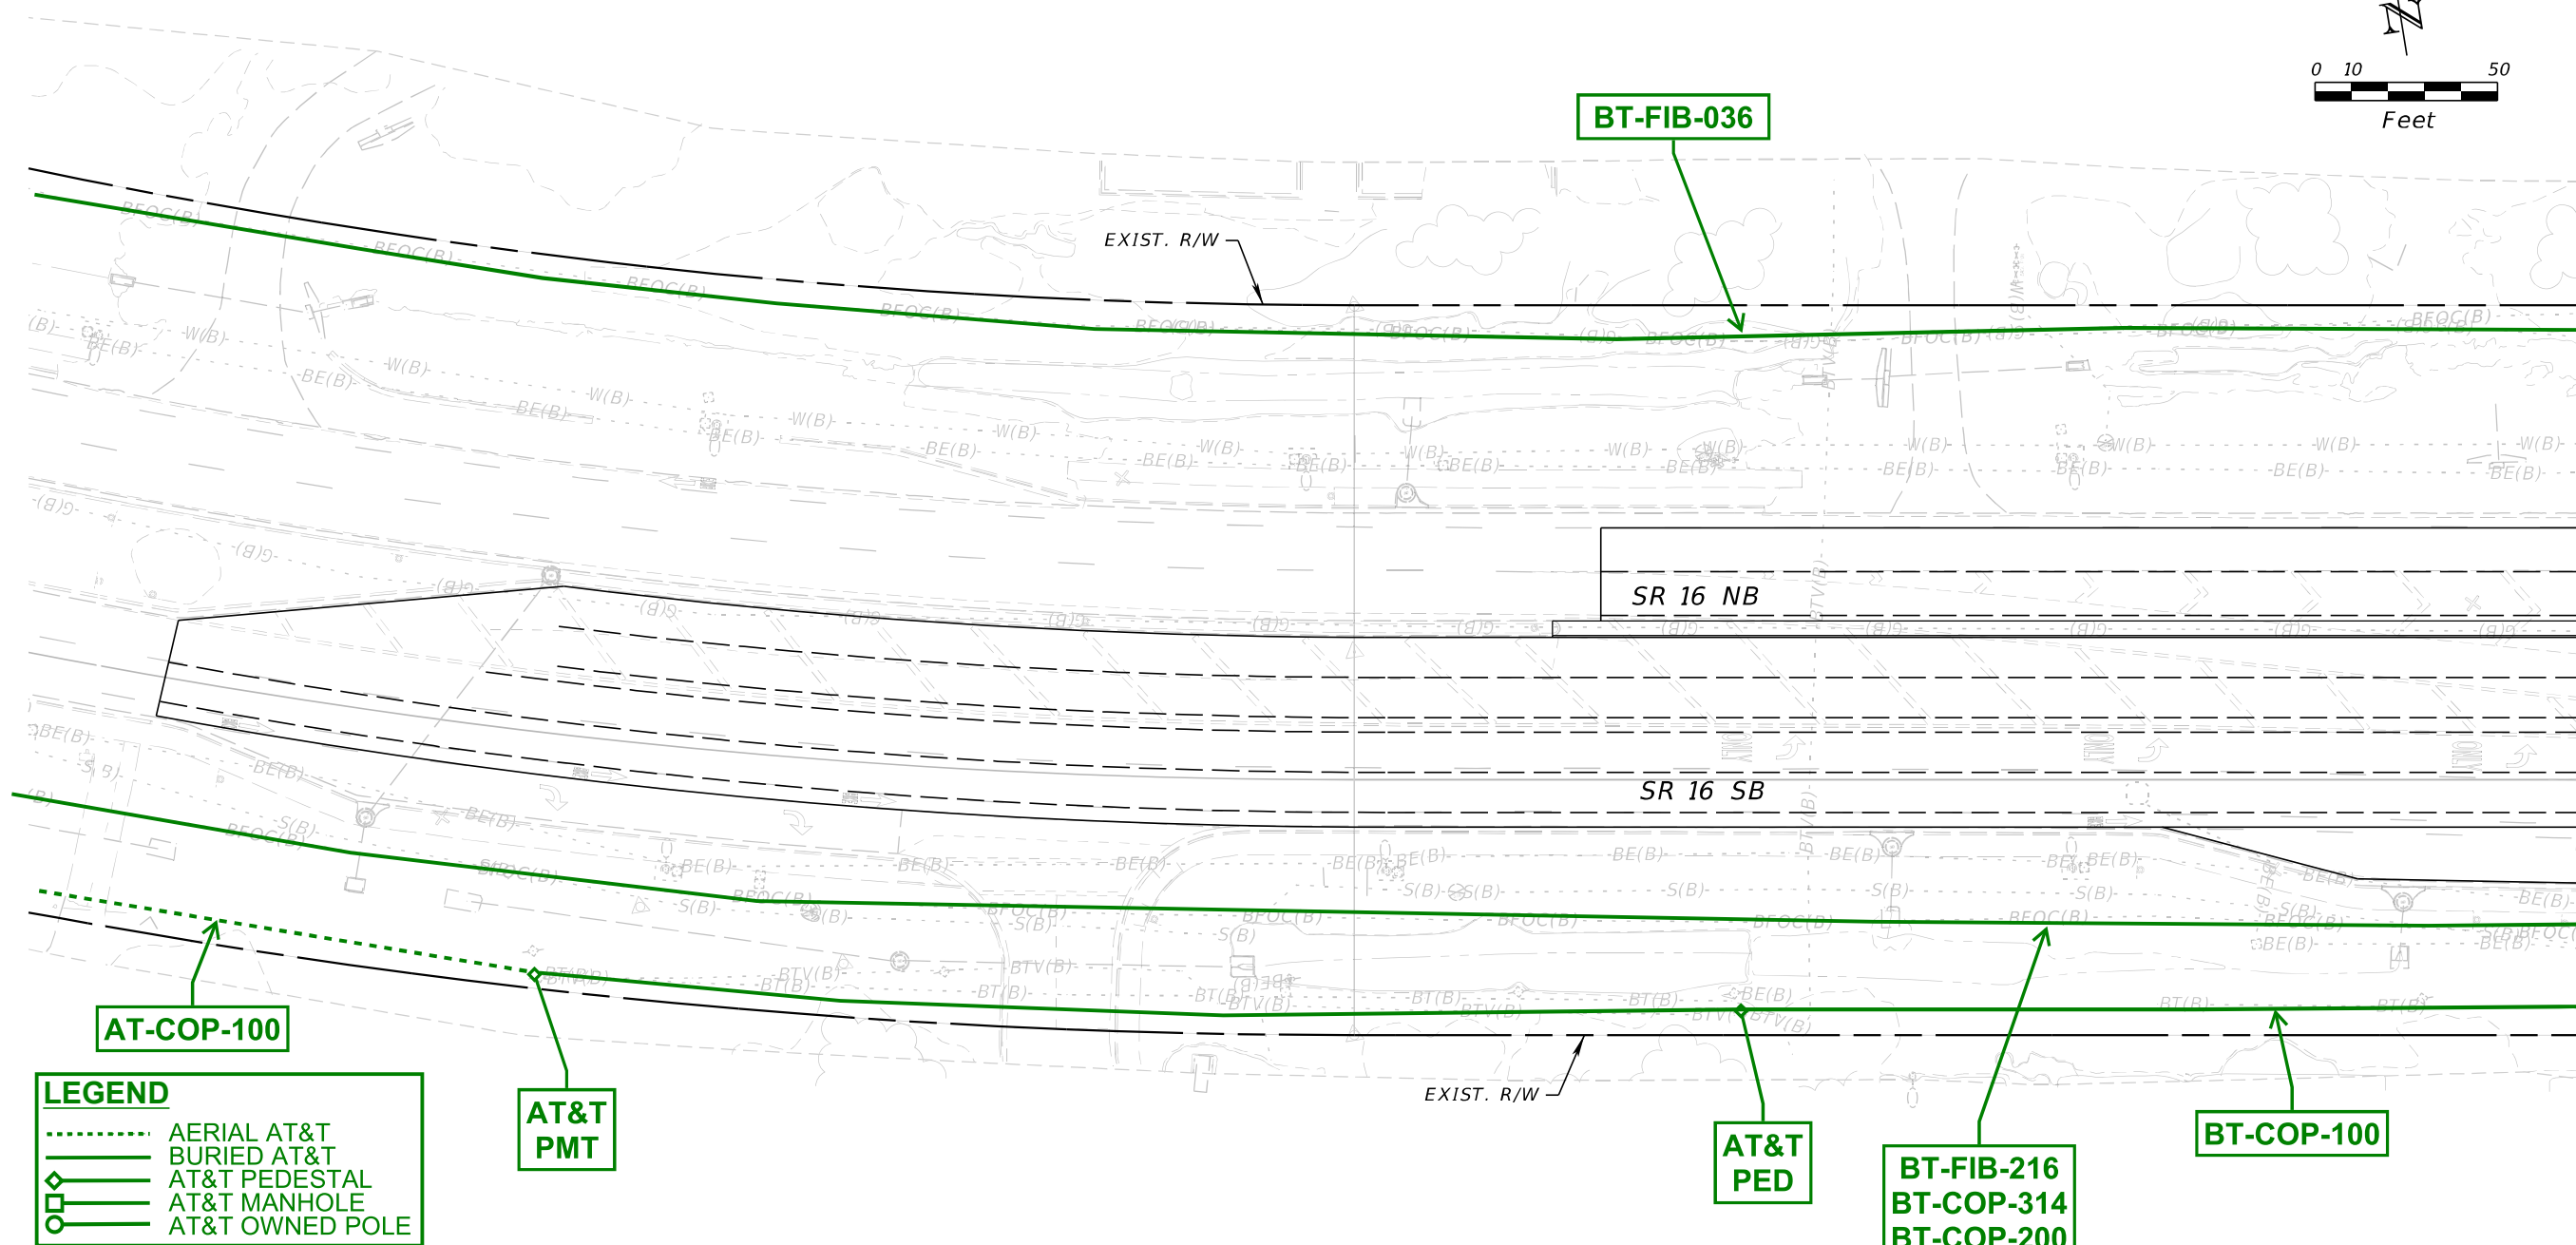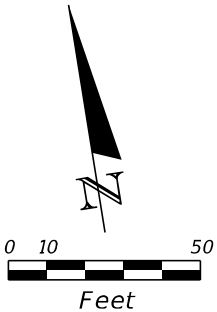

**LEGEND**

- ..... AERIAL AT&T
- BURIED AT&T
- ◇ AT&T PEDESTAL
- AT&T MANHOLE
- AT&T OWNED POLE

All correspondence and coordination herein are with regards to BellSouth Telecommunications, LC d/b/a AT&T Florida (ATT-D) which is not responsible for facilities owned and managed by AT&T Corp (ATT-T). Any questions with regards to ATT-T facilities should be addressed to "Inquiries@pea-inc.net"

All cable locations reflected on these drawings are considered to be approximate (Level D) and should be verified by the design team with field location (Level B) prior to completion of design and by the contractor prior to start of work operation. Call sunshine one-call for field locations: 811 or 1.800.732.4770

**NOTE:**  
The cable locations green lined on these drawings are taken from in house records. The locations shown in no way insinuate the exact location or identity of said facilities.


**A050WR6**  
D&S Telecom Services, LLC  
AT&T LEVEL D Greenline  
Completed: 09/24/2024

| REVISIONS |             |      |             | ENGINEER OF RECORD                                                                                                        |  |  | STATE OF FLORIDA<br>DEPARTMENT OF TRANSPORTATION |           |                      | ROADWAY PLAN | SHEET NO.<br><br>SR 16<br>- PLAN |
|-----------|-------------|------|-------------|---------------------------------------------------------------------------------------------------------------------------|--|--|--------------------------------------------------|-----------|----------------------|--------------|----------------------------------|
| DATE      | DESCRIPTION | DATE | DESCRIPTION | STEPHEN J. PARK, P.E.<br>LICENSE NUMBER: 77656<br>RS&H, INC.<br>10748 DEERWOOD PARK BLVD. SOUTH<br>JACKSONVILLE, FL 32256 |  |  | ROAD NO.                                         | COUNTY    | FINANCIAL PROJECT ID |              |                                  |
|           |             |      |             |                                                                                                                           |  |  | SR 16                                            | ST. JOHNS | 210447-5-52-01       |              |                                  |

8/5/2024 4:28:36 PM BeattyM  
c:\pw\_work\sh\_pw\pw\_user\40439575\PLANRD01.dgn

THE OFFICIAL RECORD OF THIS SHEET IS THE ELECTRONIC FILE DIGITALLY SIGNED AND SEALED UNDER RULE 61G15-23.004, F.A.C.


8/5/2024 4:28:37 PM BeattyM  
c:\pw\_work\sh\_pw\pw\_user\40439575\PLANRD01.dgn

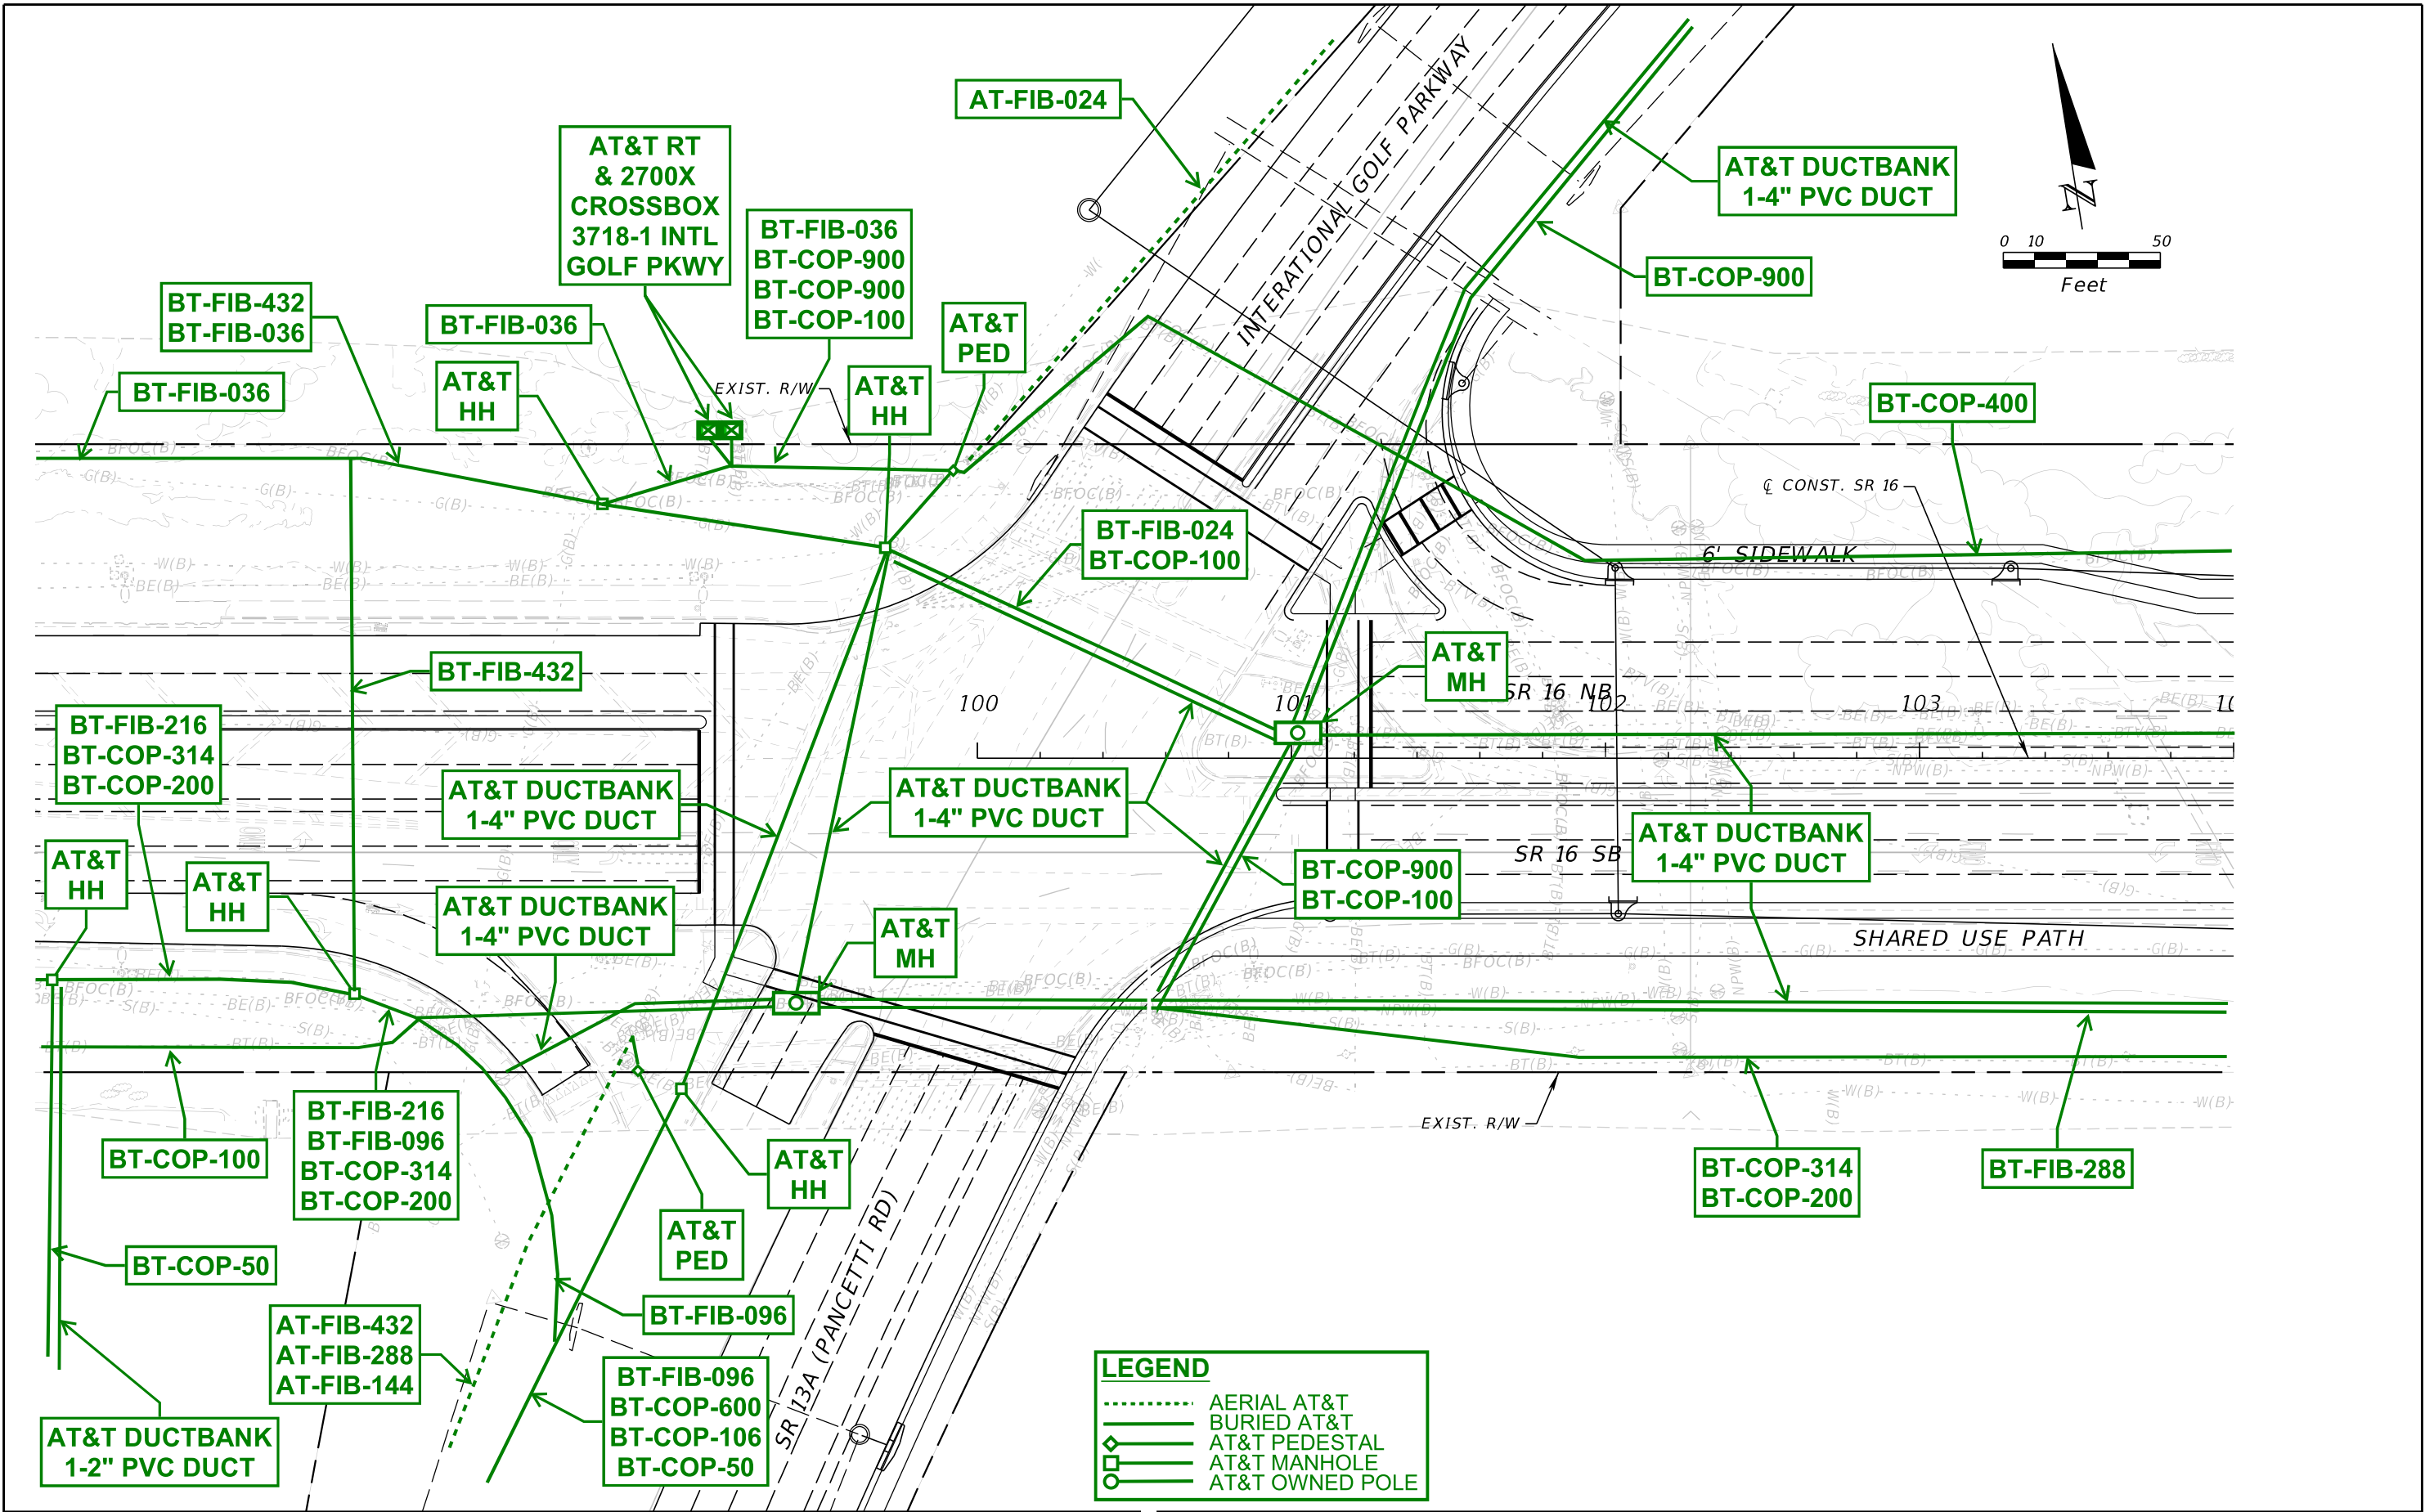

| REVISIONS |             | ENGINEER OF RECORD |                                                                                                                           | STATE OF FLORIDA<br>DEPARTMENT OF TRANSPORTATION |           |                      | ROADWAY PLAN | SHEET NO.<br>SR 16 - PLAN-1 |
|-----------|-------------|--------------------|---------------------------------------------------------------------------------------------------------------------------|--------------------------------------------------|-----------|----------------------|--------------|-----------------------------|
| DATE      | DESCRIPTION | DATE               | DESCRIPTION                                                                                                               | ROAD NO.                                         | COUNTY    | FINANCIAL PROJECT ID |              |                             |
|           |             |                    | STEPHEN J. PARK, P.E.<br>LICENSE NUMBER: 77656<br>RS&H, INC.<br>10748 DEERWOOD PARK BL D. SOUTH<br>JACKSONVILLE, FL 32256 | SR 16                                            | ST. JOHNS | 210447-5-52-01       |              |                             |

THE OFFICIAL RECORD OF THIS SHEET IS THE ELECTRONIC FILE DIGITALLY SIGNED AND SEALED UNDER RULE 61G15-23.004, F.A.C.

8/5/2024 4:28:38 PM BeattyM  
c:\pw\_work\ysh\_pw\pw\_user\0439575\PLAINRD01.dgn


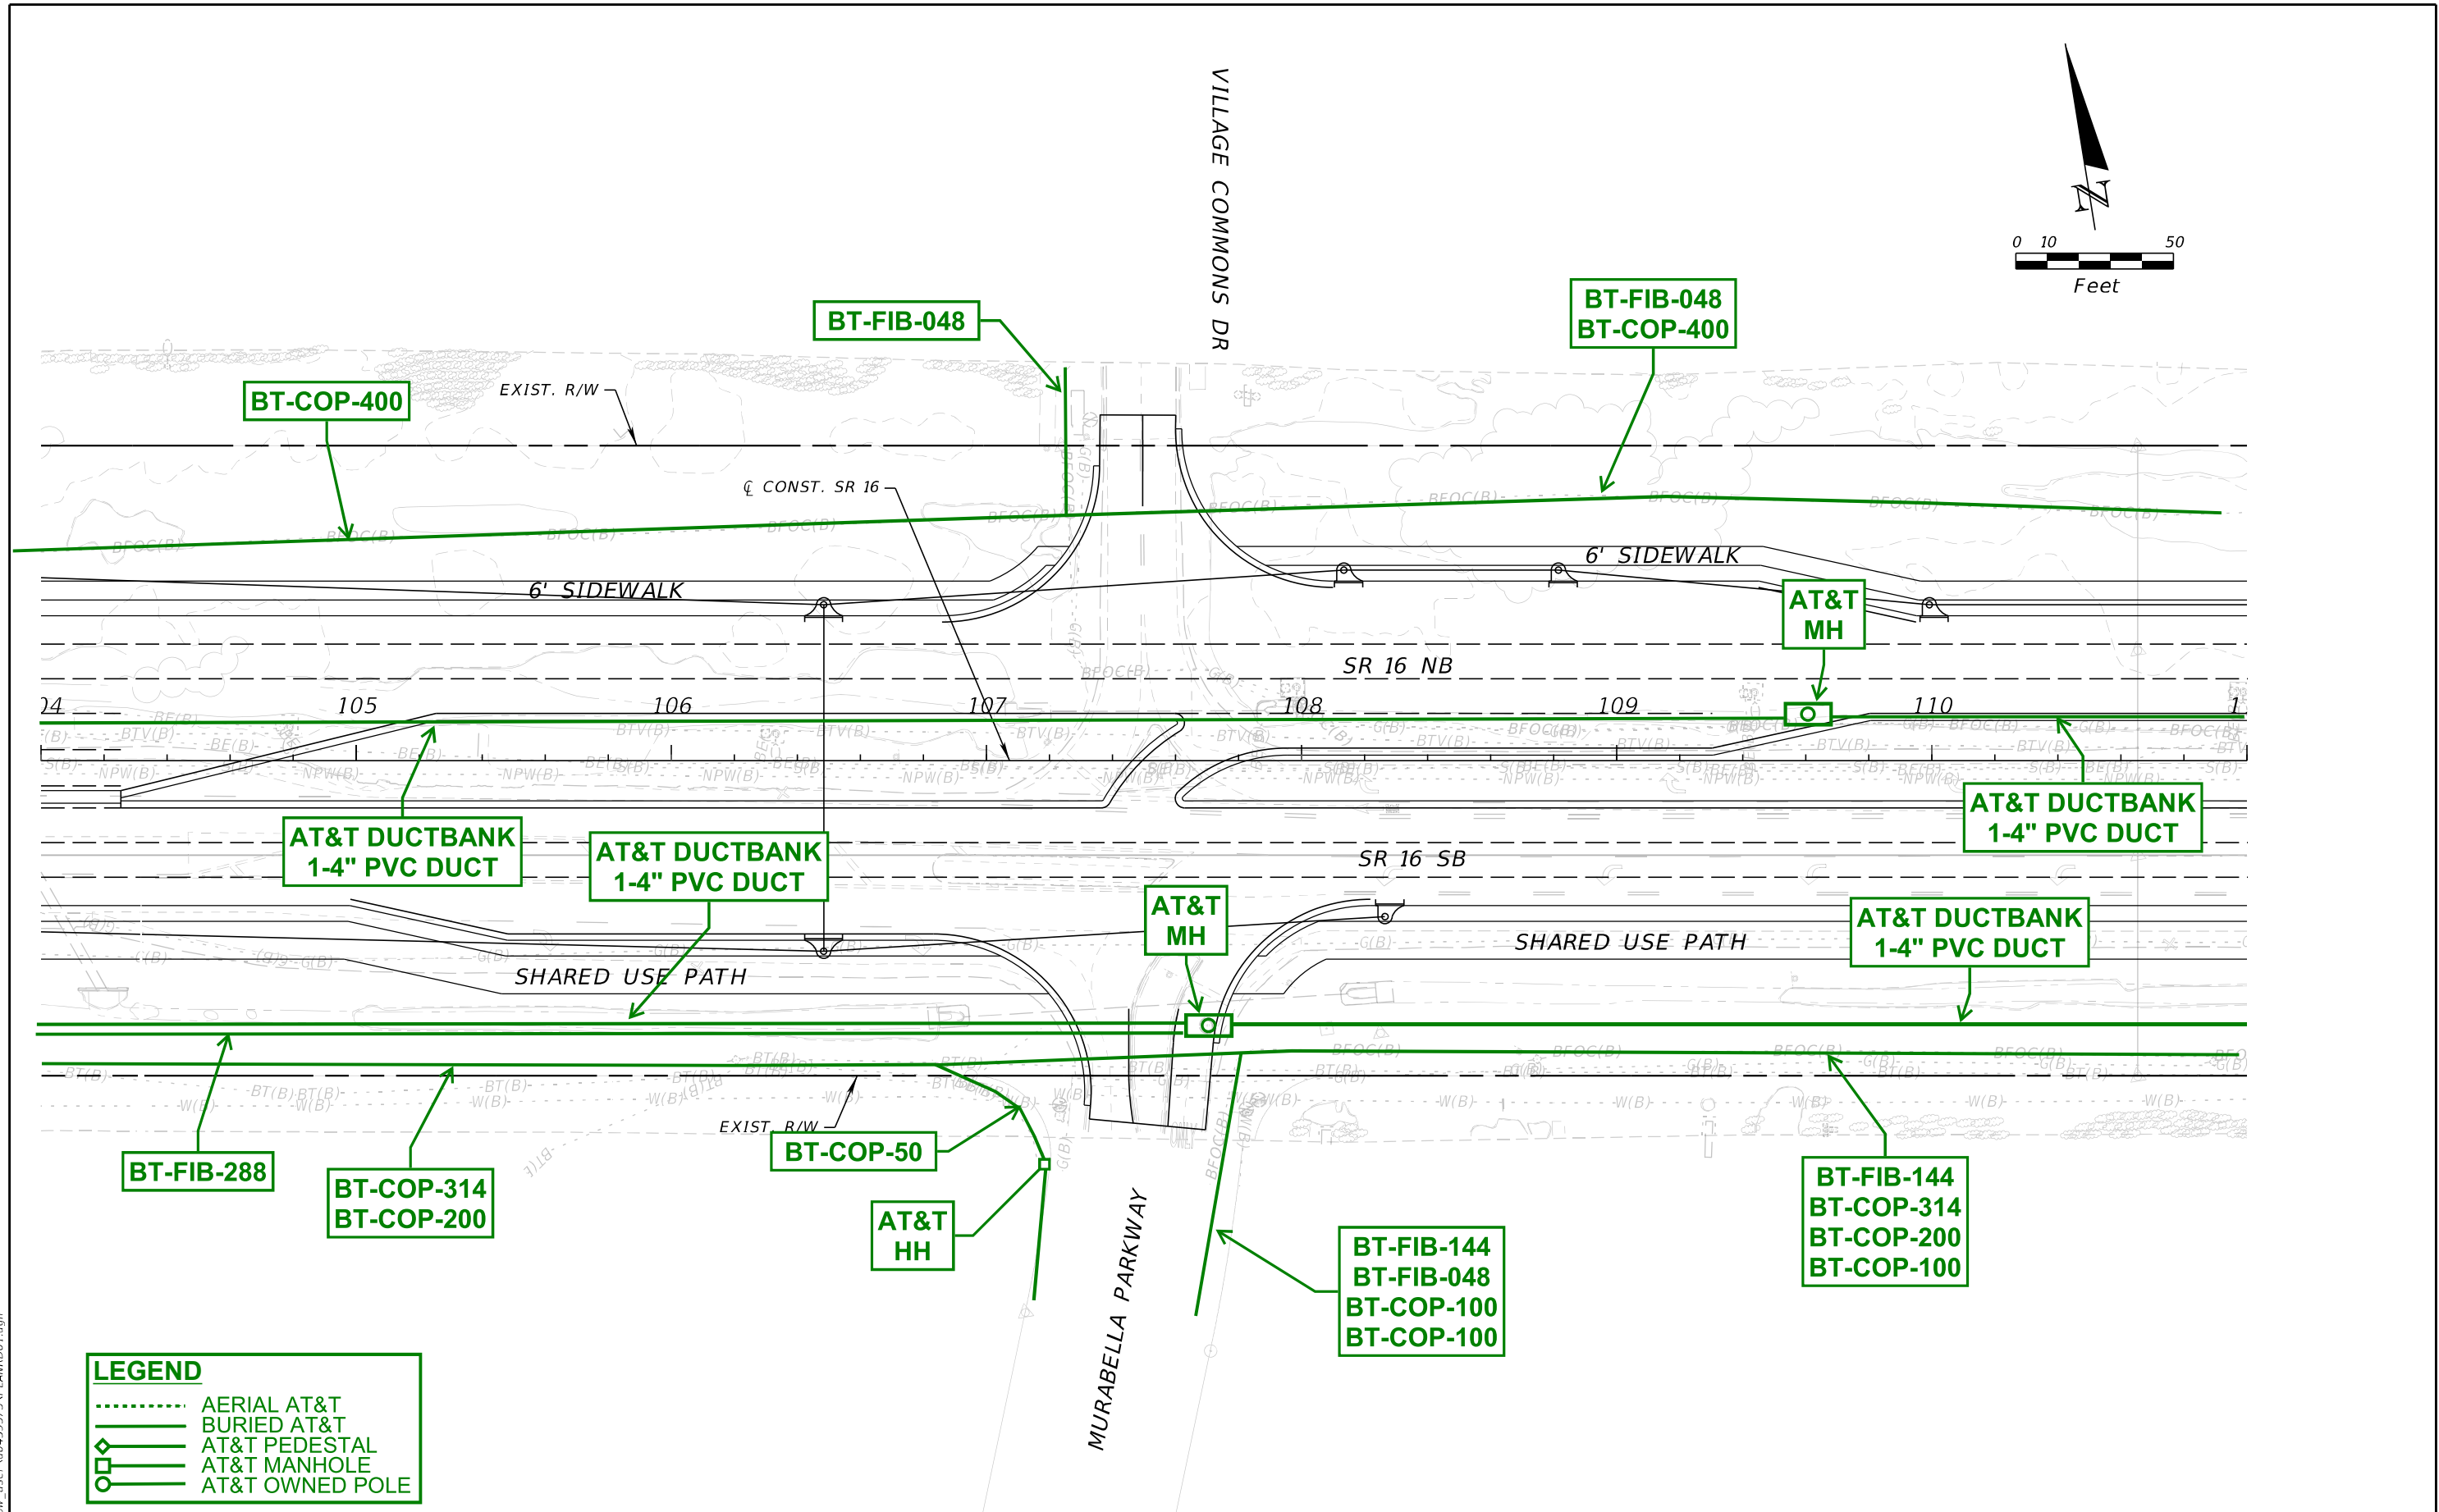


| REVISIONS |             | ENGINEER OF RECORD |                                                                                                                           | STATE OF FLORIDA<br>DEPARTMENT OF TRANSPORTATION |           |                      | ROADWAY PLAN | SHEET NO.<br><br>SR 16<br>- PLAN -<br>2 |
|-----------|-------------|--------------------|---------------------------------------------------------------------------------------------------------------------------|--------------------------------------------------|-----------|----------------------|--------------|-----------------------------------------|
| DATE      | DESCRIPTION | DATE               | DESCRIPTION                                                                                                               | ROAD NO.                                         | COUNTY    | FINANCIAL PROJECT ID |              |                                         |
|           |             |                    | STEPHEN J. PARK, P.E.<br>LICENSE NUMBER: 77656<br>RS&H, INC.<br>10748 DEERWOOD PARK BLVD. SOUTH<br>JACKSONVILLE, FL 32256 | SR 16                                            | ST. JOHNS | 210447-5-52-01       |              |                                         |

THE OFFICIAL RECORD OF THIS SHEET IS THE ELECTRONIC FILE DIGITALLY SIGNED AND SEALED UNDER RULE 61G15-23.004, F.A.C.



8/5/2024 4:28:39 PM BeattyM  
c:\pw\_work\sh\_pw\pw\_user\0439575\PLANRD01.dgn

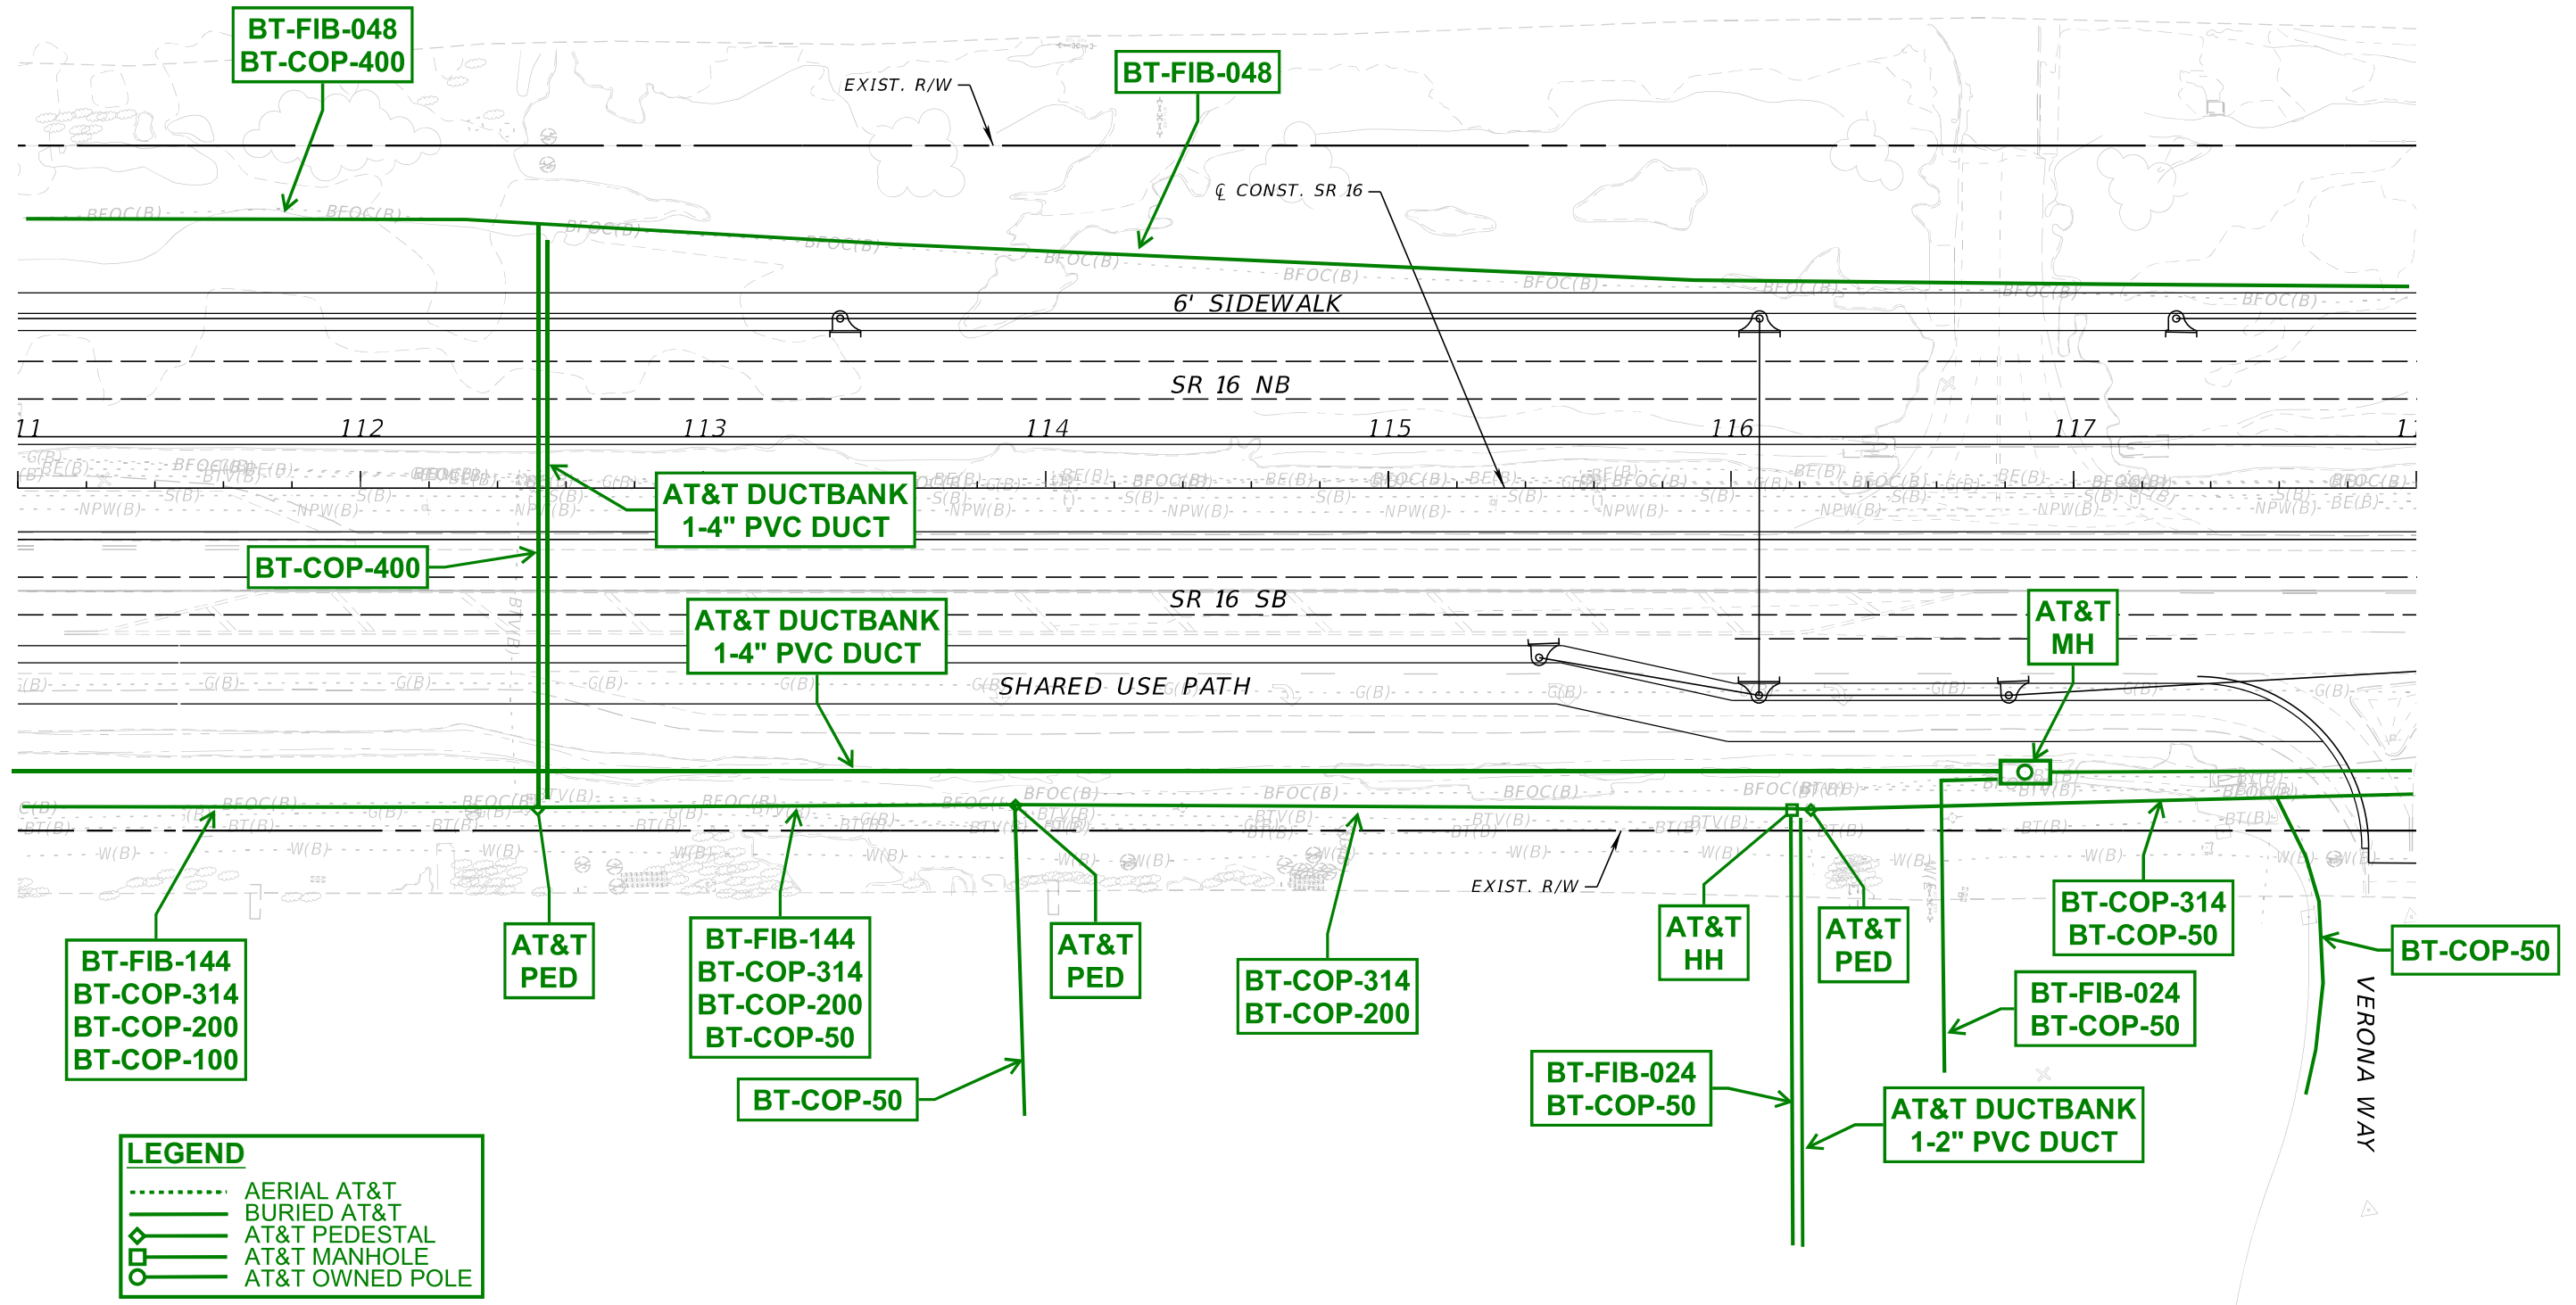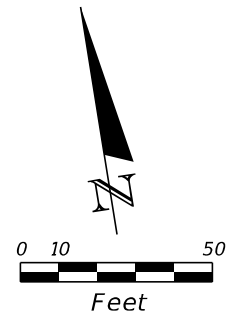


| LEGEND |                 |
|--------|-----------------|
| .....  | AERIAL AT&T     |
| ———    | BURIED AT&T     |
| ◇      | AT&T PEDESTAL   |
| □      | AT&T MANHOLE    |
| ○      | AT&T OWNED POLE |

| REVISIONS |             |      |             | ENGINEER OF RECORD                                                                                                        | STATE OF FLORIDA<br>DEPARTMENT OF TRANSPORTATION |           |                      | SHEET<br>NO.          |
|-----------|-------------|------|-------------|---------------------------------------------------------------------------------------------------------------------------|--------------------------------------------------|-----------|----------------------|-----------------------|
| DATE      | DESCRIPTION | DATE | DESCRIPTION |                                                                                                                           | ROAD NO.                                         | COUNTY    | FINANCIAL PROJECT ID |                       |
|           |             |      |             |                                                                                                                           | SR 16                                            | ST. JOHNS | 210447-5-52-01       |                       |
|           |             |      |             | STEPHEN J. PARK, P.E.<br>LICENSE NUMBER: 77656<br>RS&H, INC.<br>10748 DEERWOOD PARK BLVD. SOUTH<br>JACKSONVILLE, FL 32256 |                                                  |           |                      | 11x17<br>Plan<br>Only |

THE OFFICIAL RECORD OF THIS SHEET IS THE ELECTRONIC FILE DIGITALLY SIGNED AND SEALED UNDER RULE 61G15-23.004, F.A.C.

8/5/2024 4:28:40 PM BeattyM  
c:\pw\_work\sh\_pw\pw\_user\0439575\PLANRD01.dgn


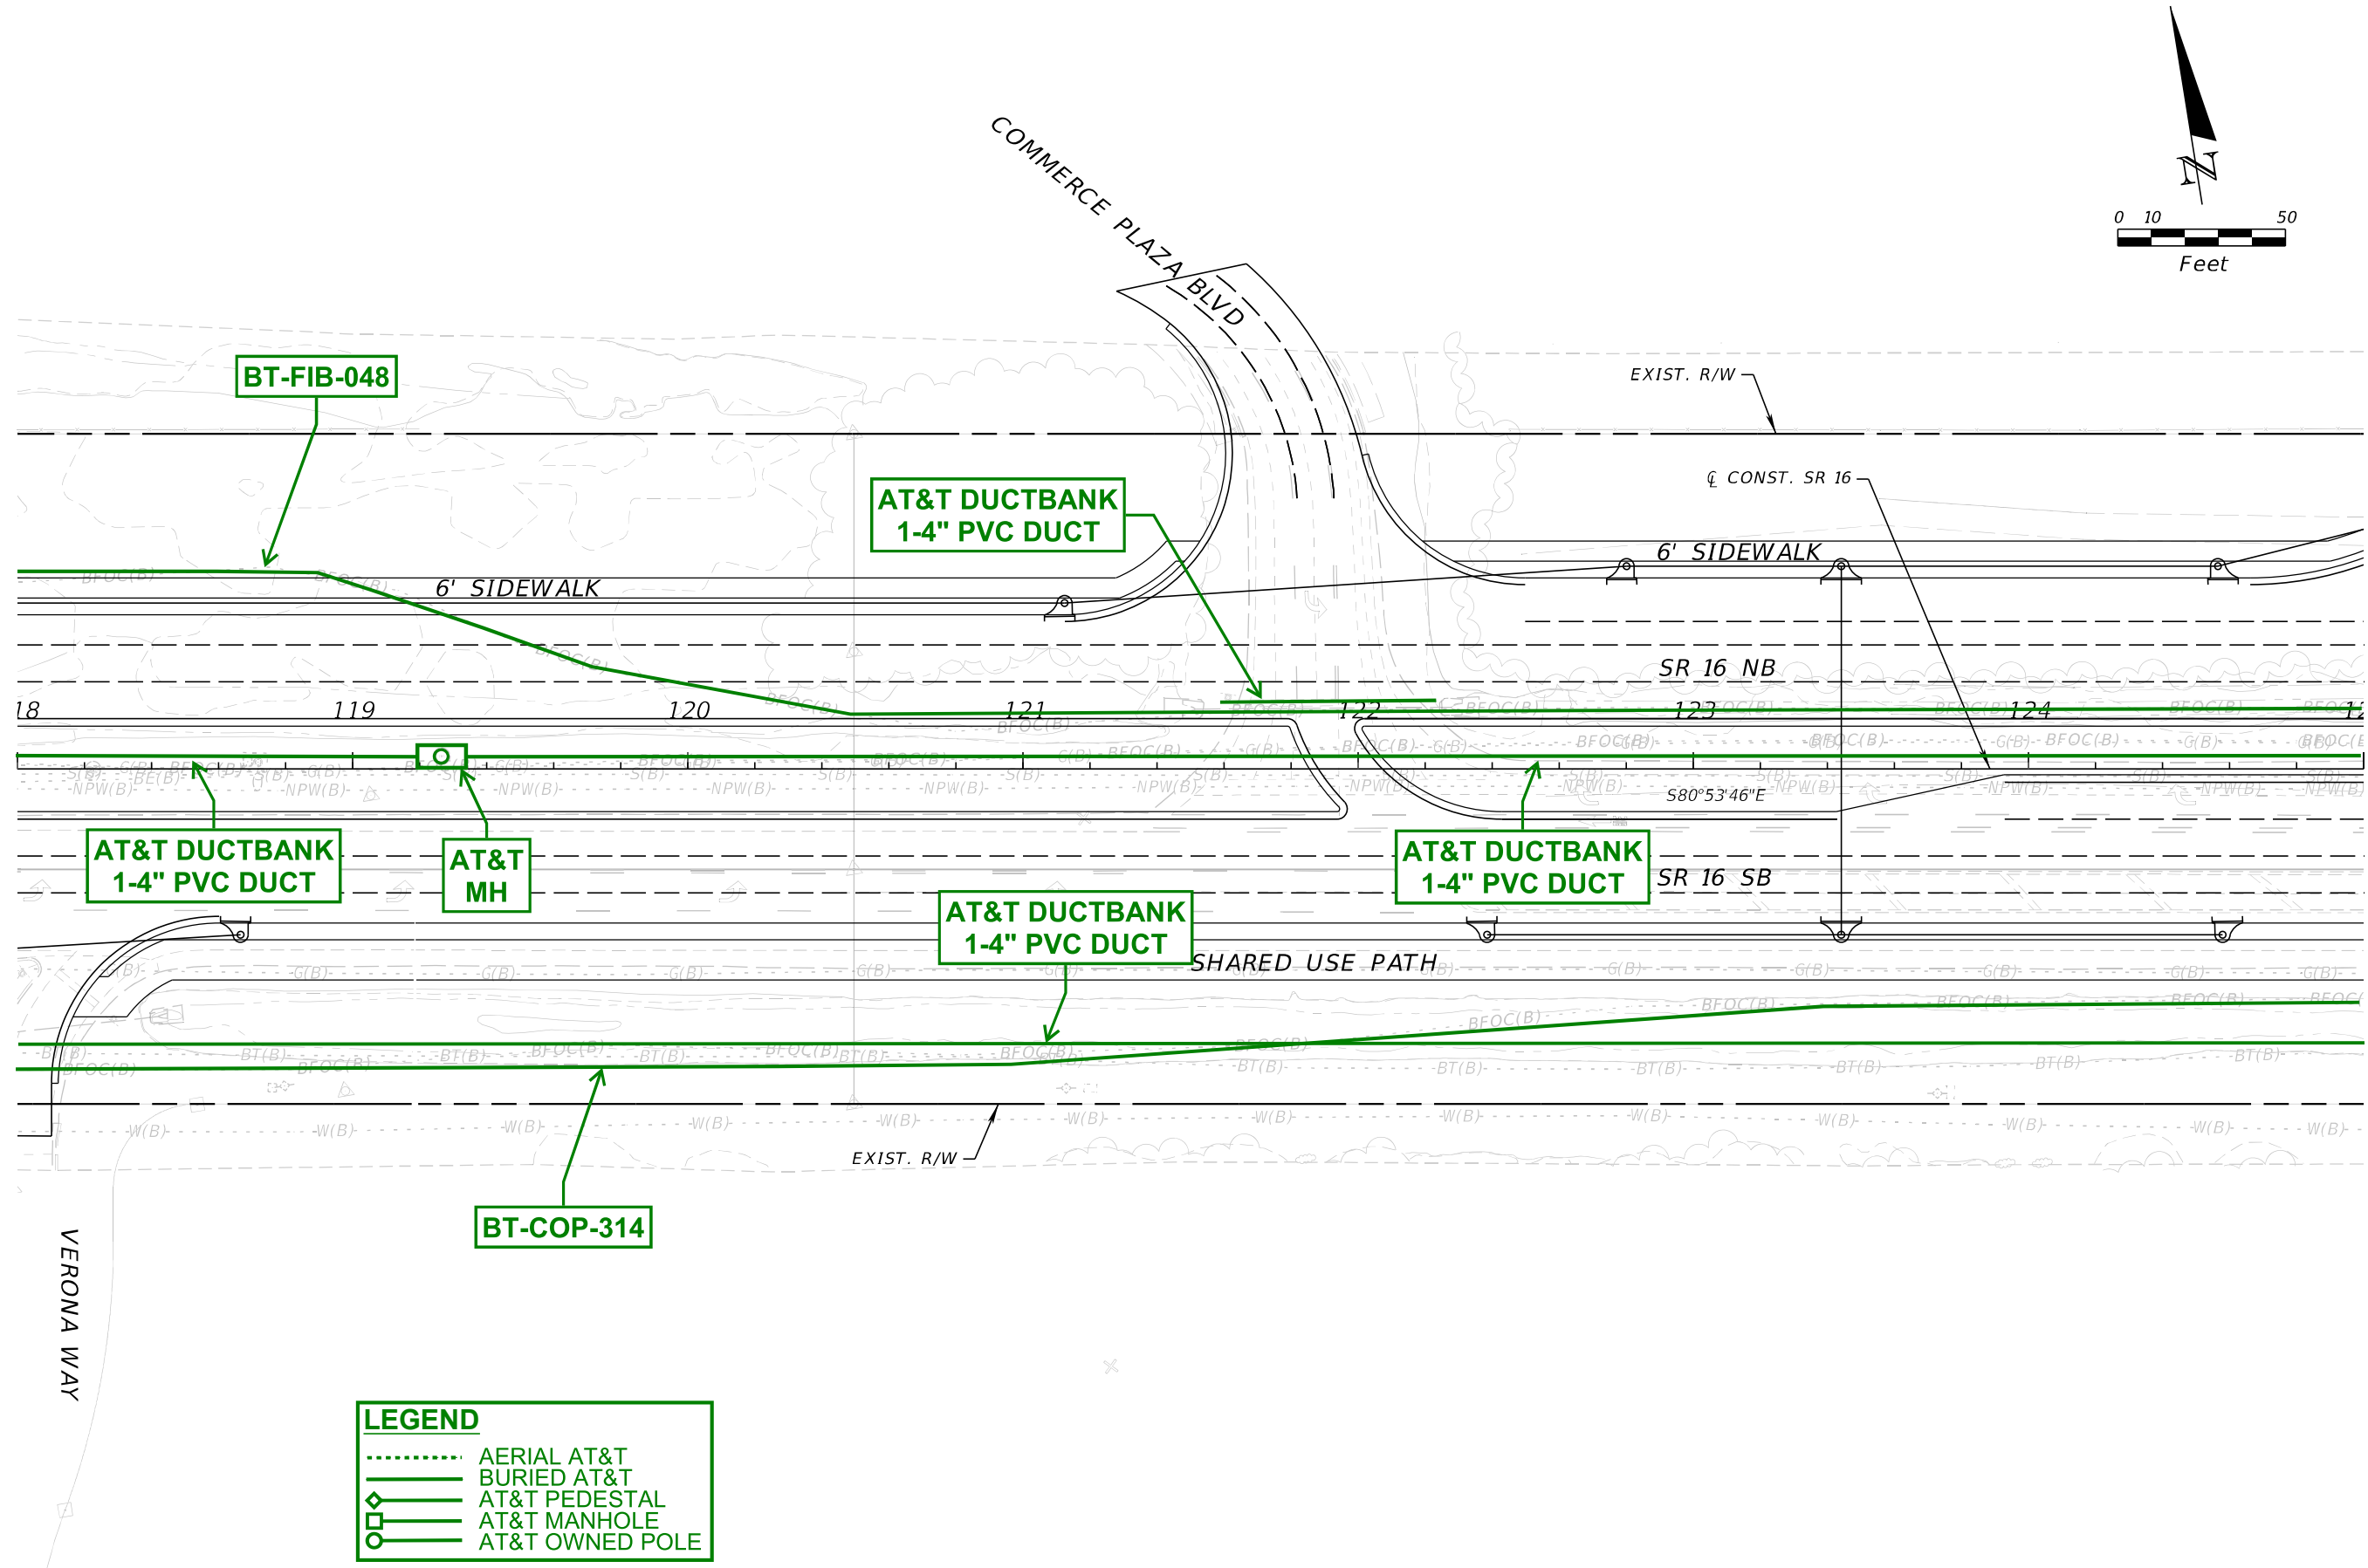


| REVISIONS |             | ENGINEER OF RECORD | STATE OF FLORIDA<br>DEPARTMENT OF TRANSPORTATION |           |                      | ROADWAY PLAN | SHEET NO.             |
|-----------|-------------|--------------------|--------------------------------------------------|-----------|----------------------|--------------|-----------------------|
| DATE      | DESCRIPTION |                    | ROAD NO.                                         | COUNTY    | FINANCIAL PROJECT ID |              |                       |
|           |             |                    | SR 16                                            | ST. JOHNS | 210447-5-52-01       |              | SR 16<br>- PLAN-<br>4 |

|                                                                                                                           |  |
|---------------------------------------------------------------------------------------------------------------------------|--|
| STEPHEN J. PARK, P.E.<br>LICENSE NUMBER: 77656<br>RS&H, INC.<br>10748 DEERWOOD PARK BLVD. SOUTH<br>JACKSONVILLE, FL 32256 |  |
|---------------------------------------------------------------------------------------------------------------------------|--|

THE OFFICIAL RECORD OF THIS SHEET IS THE ELECTRONIC FILE DIGITALLY SIGNED AND SEALED UNDER RULE 61G15-23.004, F.A.C.


8/5/2024 4:28:40 PM BeattyM  
c:\pw\_work\sh\_pw\pw\_user\0439575\PLANRD01.dgn

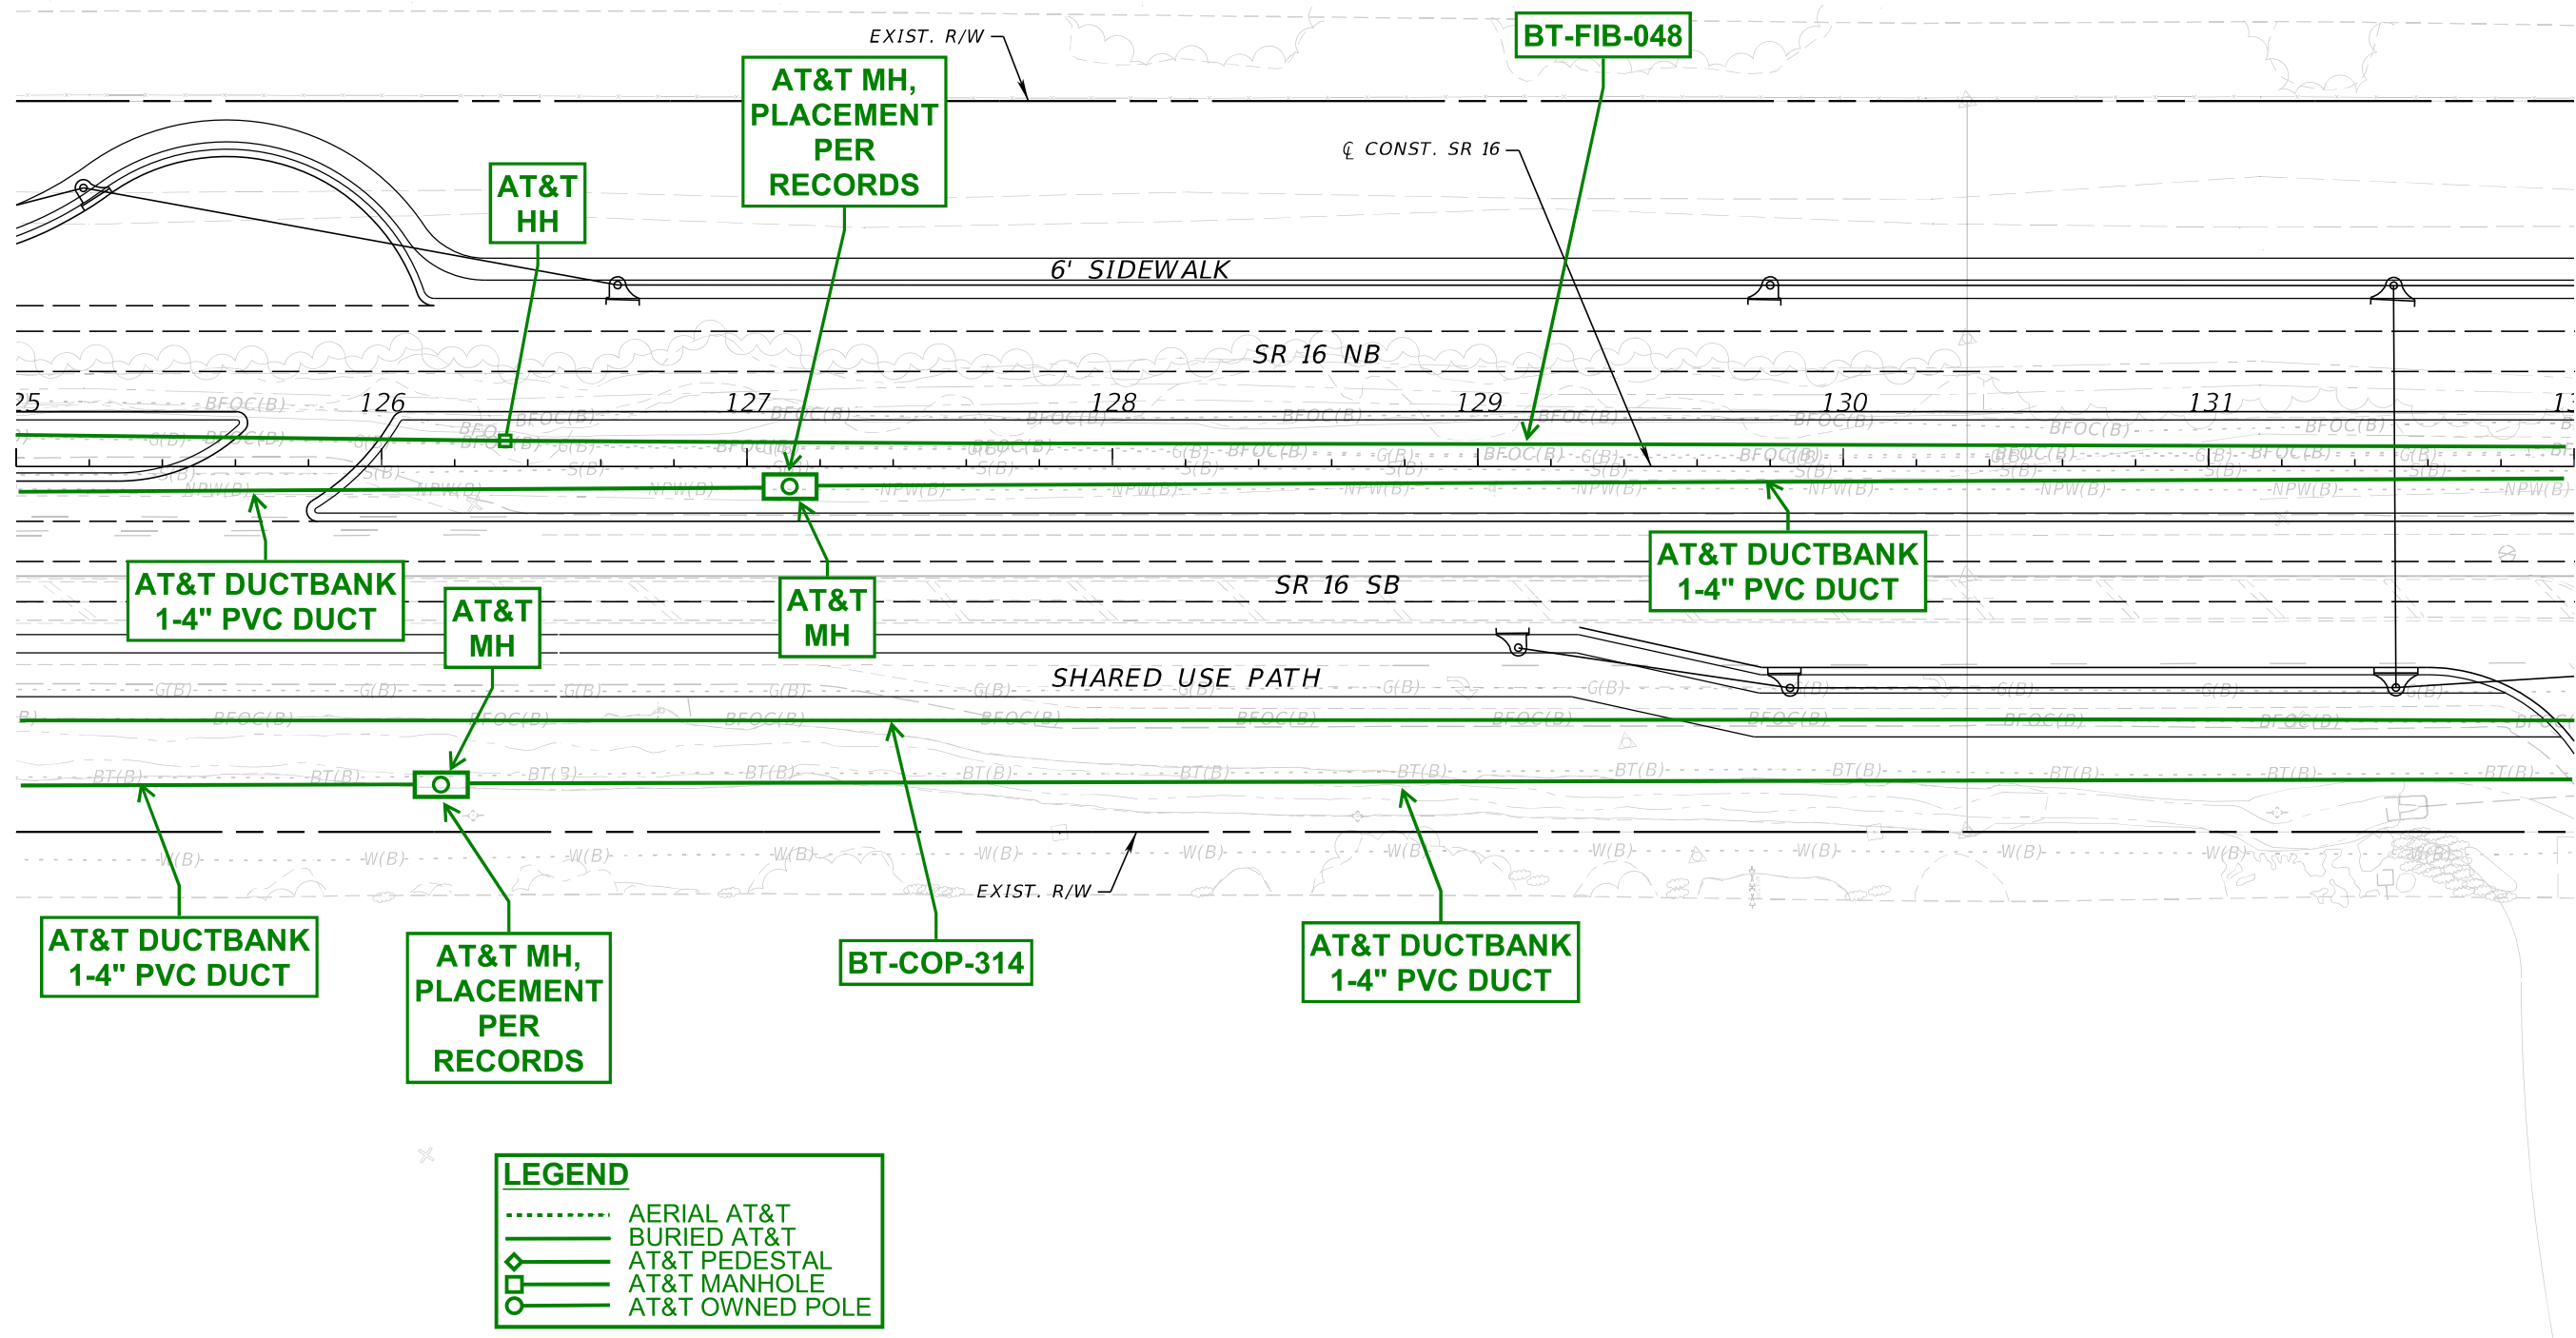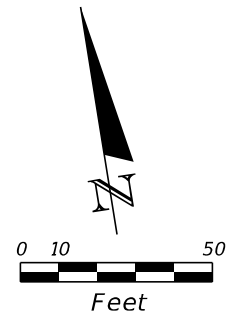

| REVISIONS |             |    | ENGINEER OF RECORD |                                                                                                                           | STATE OF FLORIDA<br>DEPARTMENT OF TRANSPORTATION |           |                      | ROADWAY PLAN | SHEET NO.<br><br>SR 16<br>- PLAN -<br>5 |
|-----------|-------------|----|--------------------|---------------------------------------------------------------------------------------------------------------------------|--------------------------------------------------|-----------|----------------------|--------------|-----------------------------------------|
| DATE      | DESCRIPTION | DA | DESCRIPTION        | STEPHEN J. PARK, P.E.<br>LICENSE NUMBER: 77656<br>RS&H, INC.<br>10748 DEERWOOD PARK BLVD. SOUTH<br>JACKSONVILLE, FL 32256 | ROAD NO.                                         | COUNTY    | FINANCIAL PROJECT ID |              |                                         |
|           |             |    |                    |                                                                                                                           | SR 16                                            | ST. JOHNS | 210447-5-52-01       |              |                                         |

THE OFFICIAL RECORD OF THIS SHEET IS THE ELECTRONIC FILE DIGITALLY SIGNED AND SEALED UNDER RULE 61G15-23.004, F.A.C.

8/5/2024 4:28:41 PM BeattyM  
c:\pw\_work\sh\_pw\pw\_user\0439575\PLANRD01.dgn

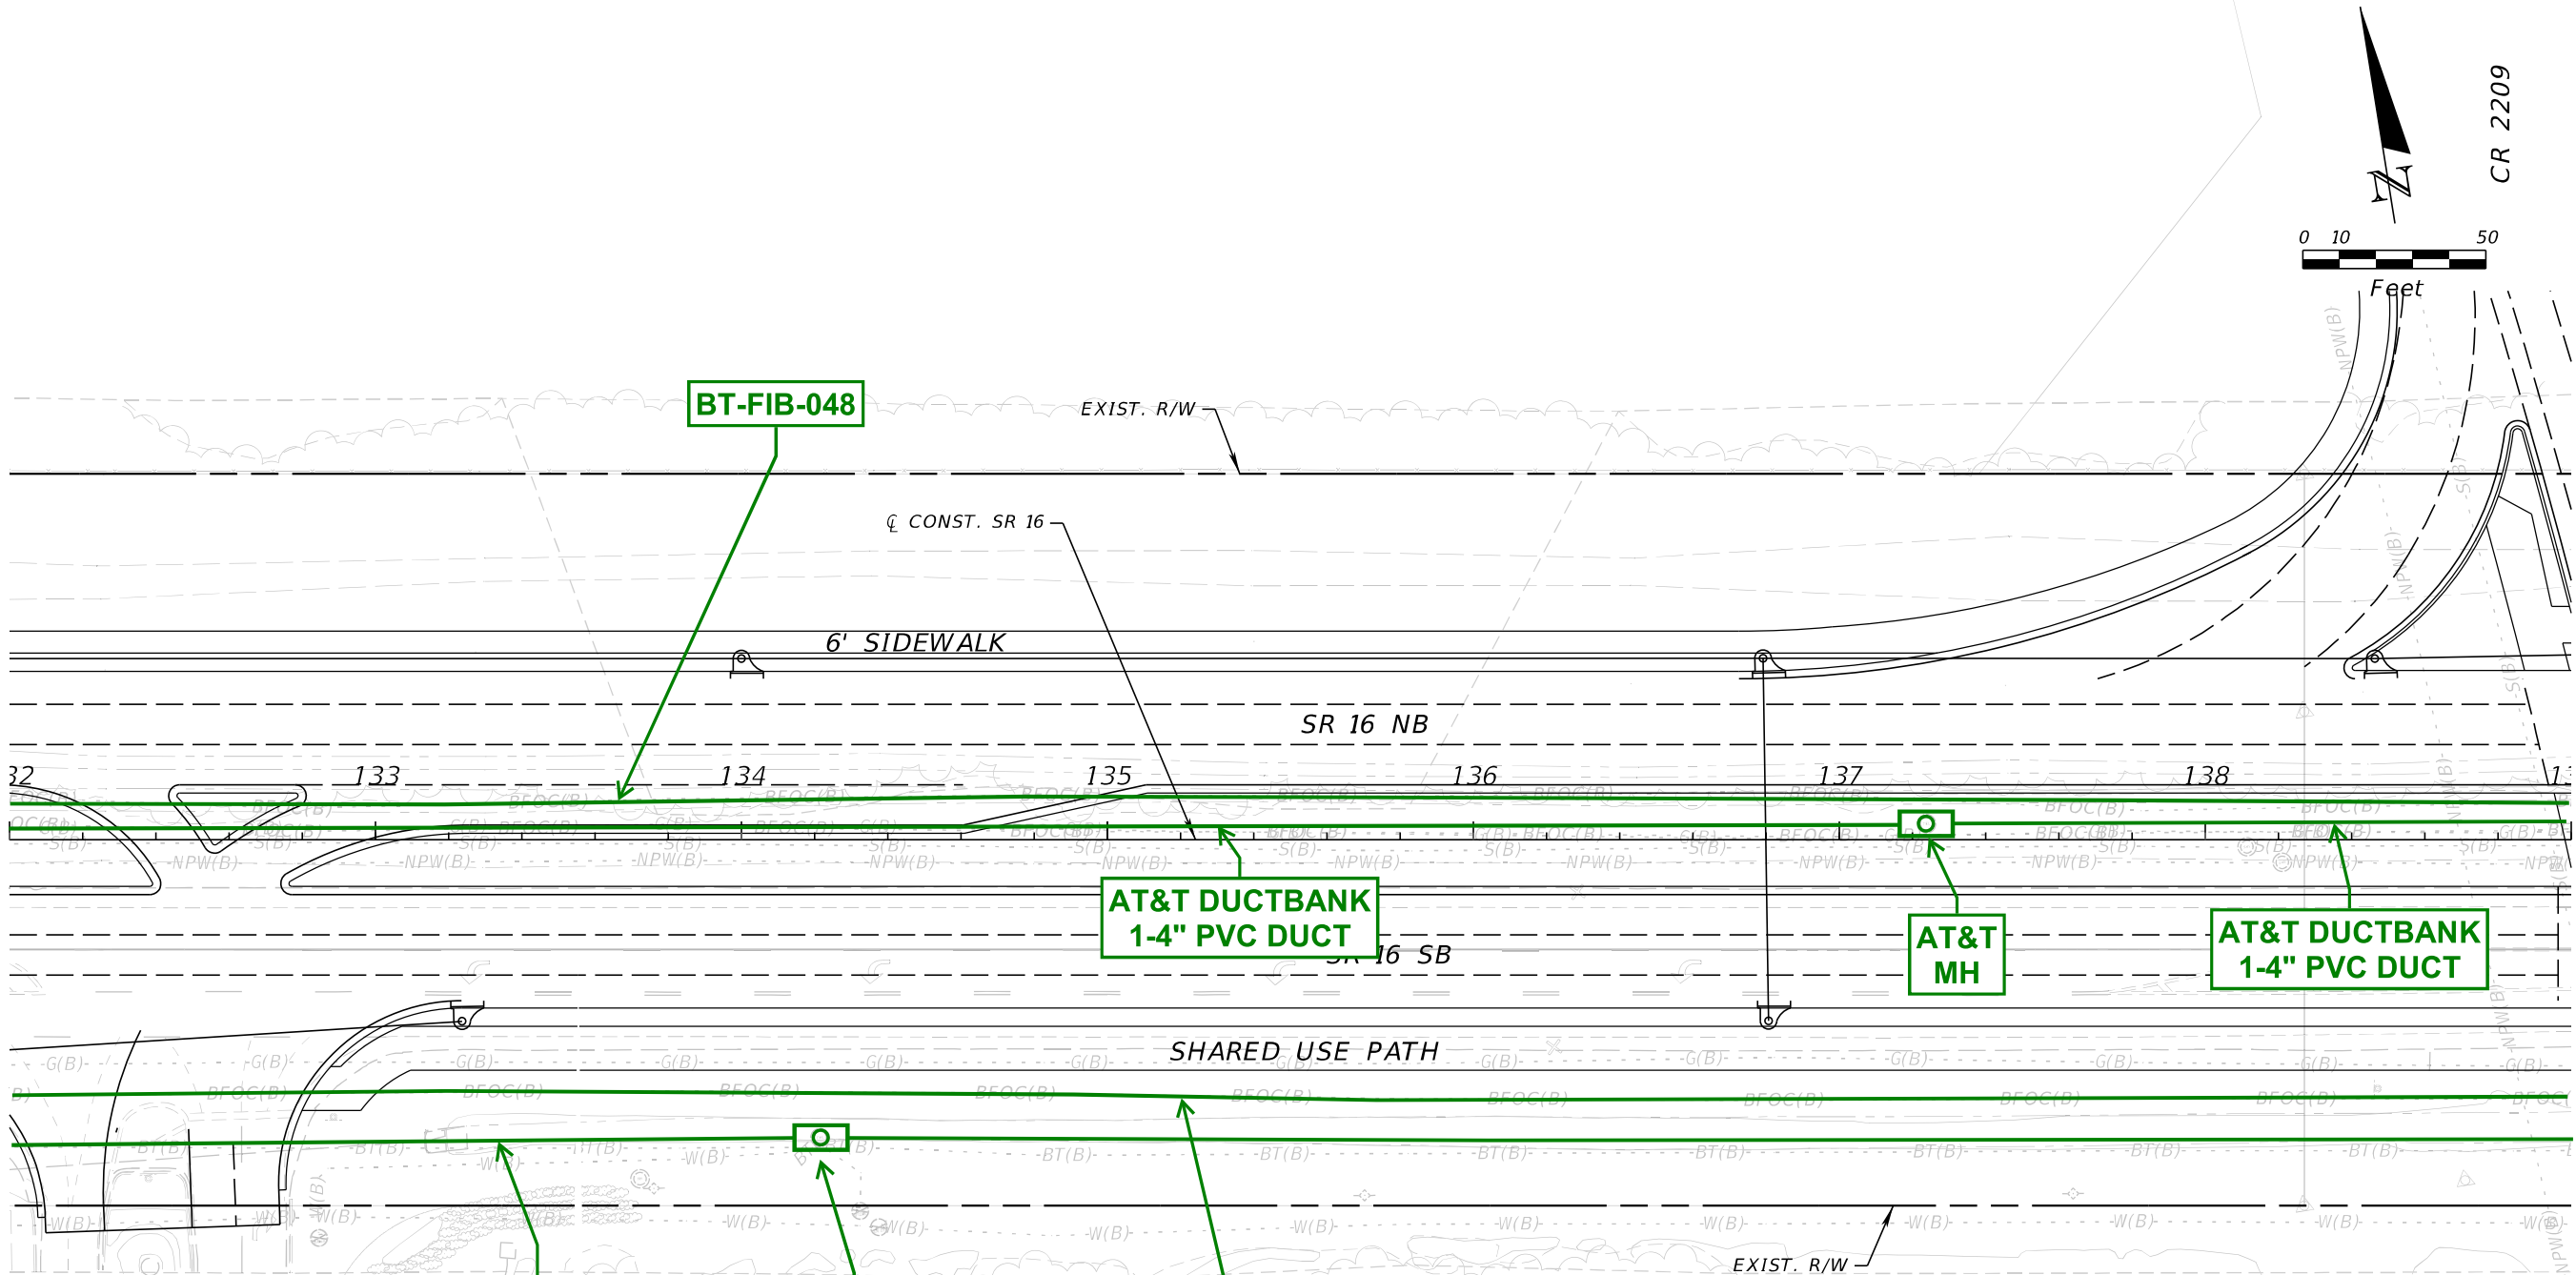

SAN GIACOMO ROAD

| LEGEND |                 |  |
|--------|-----------------|--|
| .....  | AERIAL AT&T     |  |
| ————   | BURIED AT&T     |  |
| ◆      | AT&T PEDESTAL   |  |
| □      | AT&T MANHOLE    |  |
| ○      | AT&T OWNED POLE |  |

| REVISIONS |             |      |
|-----------|-------------|------|
| DATE      | DESCRIPTION | DATE |
|           |             |      |

| DESCRIPTION | ENGINEER OF RECORD                                                                                                        |
|-------------|---------------------------------------------------------------------------------------------------------------------------|
|             | STEPHEN J. PARK, P.E.<br>LICENSE NUMBER: 77656<br>RS&H, INC.<br>10748 DEERWOOD PARK BLVD. SOUTH<br>JACKSONVILLE, FL 32256 |

| STATE OF FLORIDA<br>DEPARTMENT OF TRANSPORTATION |           |                      |
|--------------------------------------------------|-----------|----------------------|
| ROAD NO.                                         | COUNTY    | FINANCIAL PROJECT ID |
| SR 16                                            | ST. JOHNS | 210447-5-52-01       |


| ROADWAY PLAN |  |
|--------------|--|
|              |  |

| SHEET NO.              |
|------------------------|
| SR 16<br>- PLAN -<br>6 |

THE OFFICIAL RECORD OF THIS SHEET IS THE ELECTRONIC FILE DIGITALLY SIGNED AND SEALED UNDER RULE 61G15-23.004, F.A.C.



8/5/2024 4:28:42 PM BeattyM  
c:\pw\_work\sh\_pw\pw\_user\0439575\PLANRD01.dgn

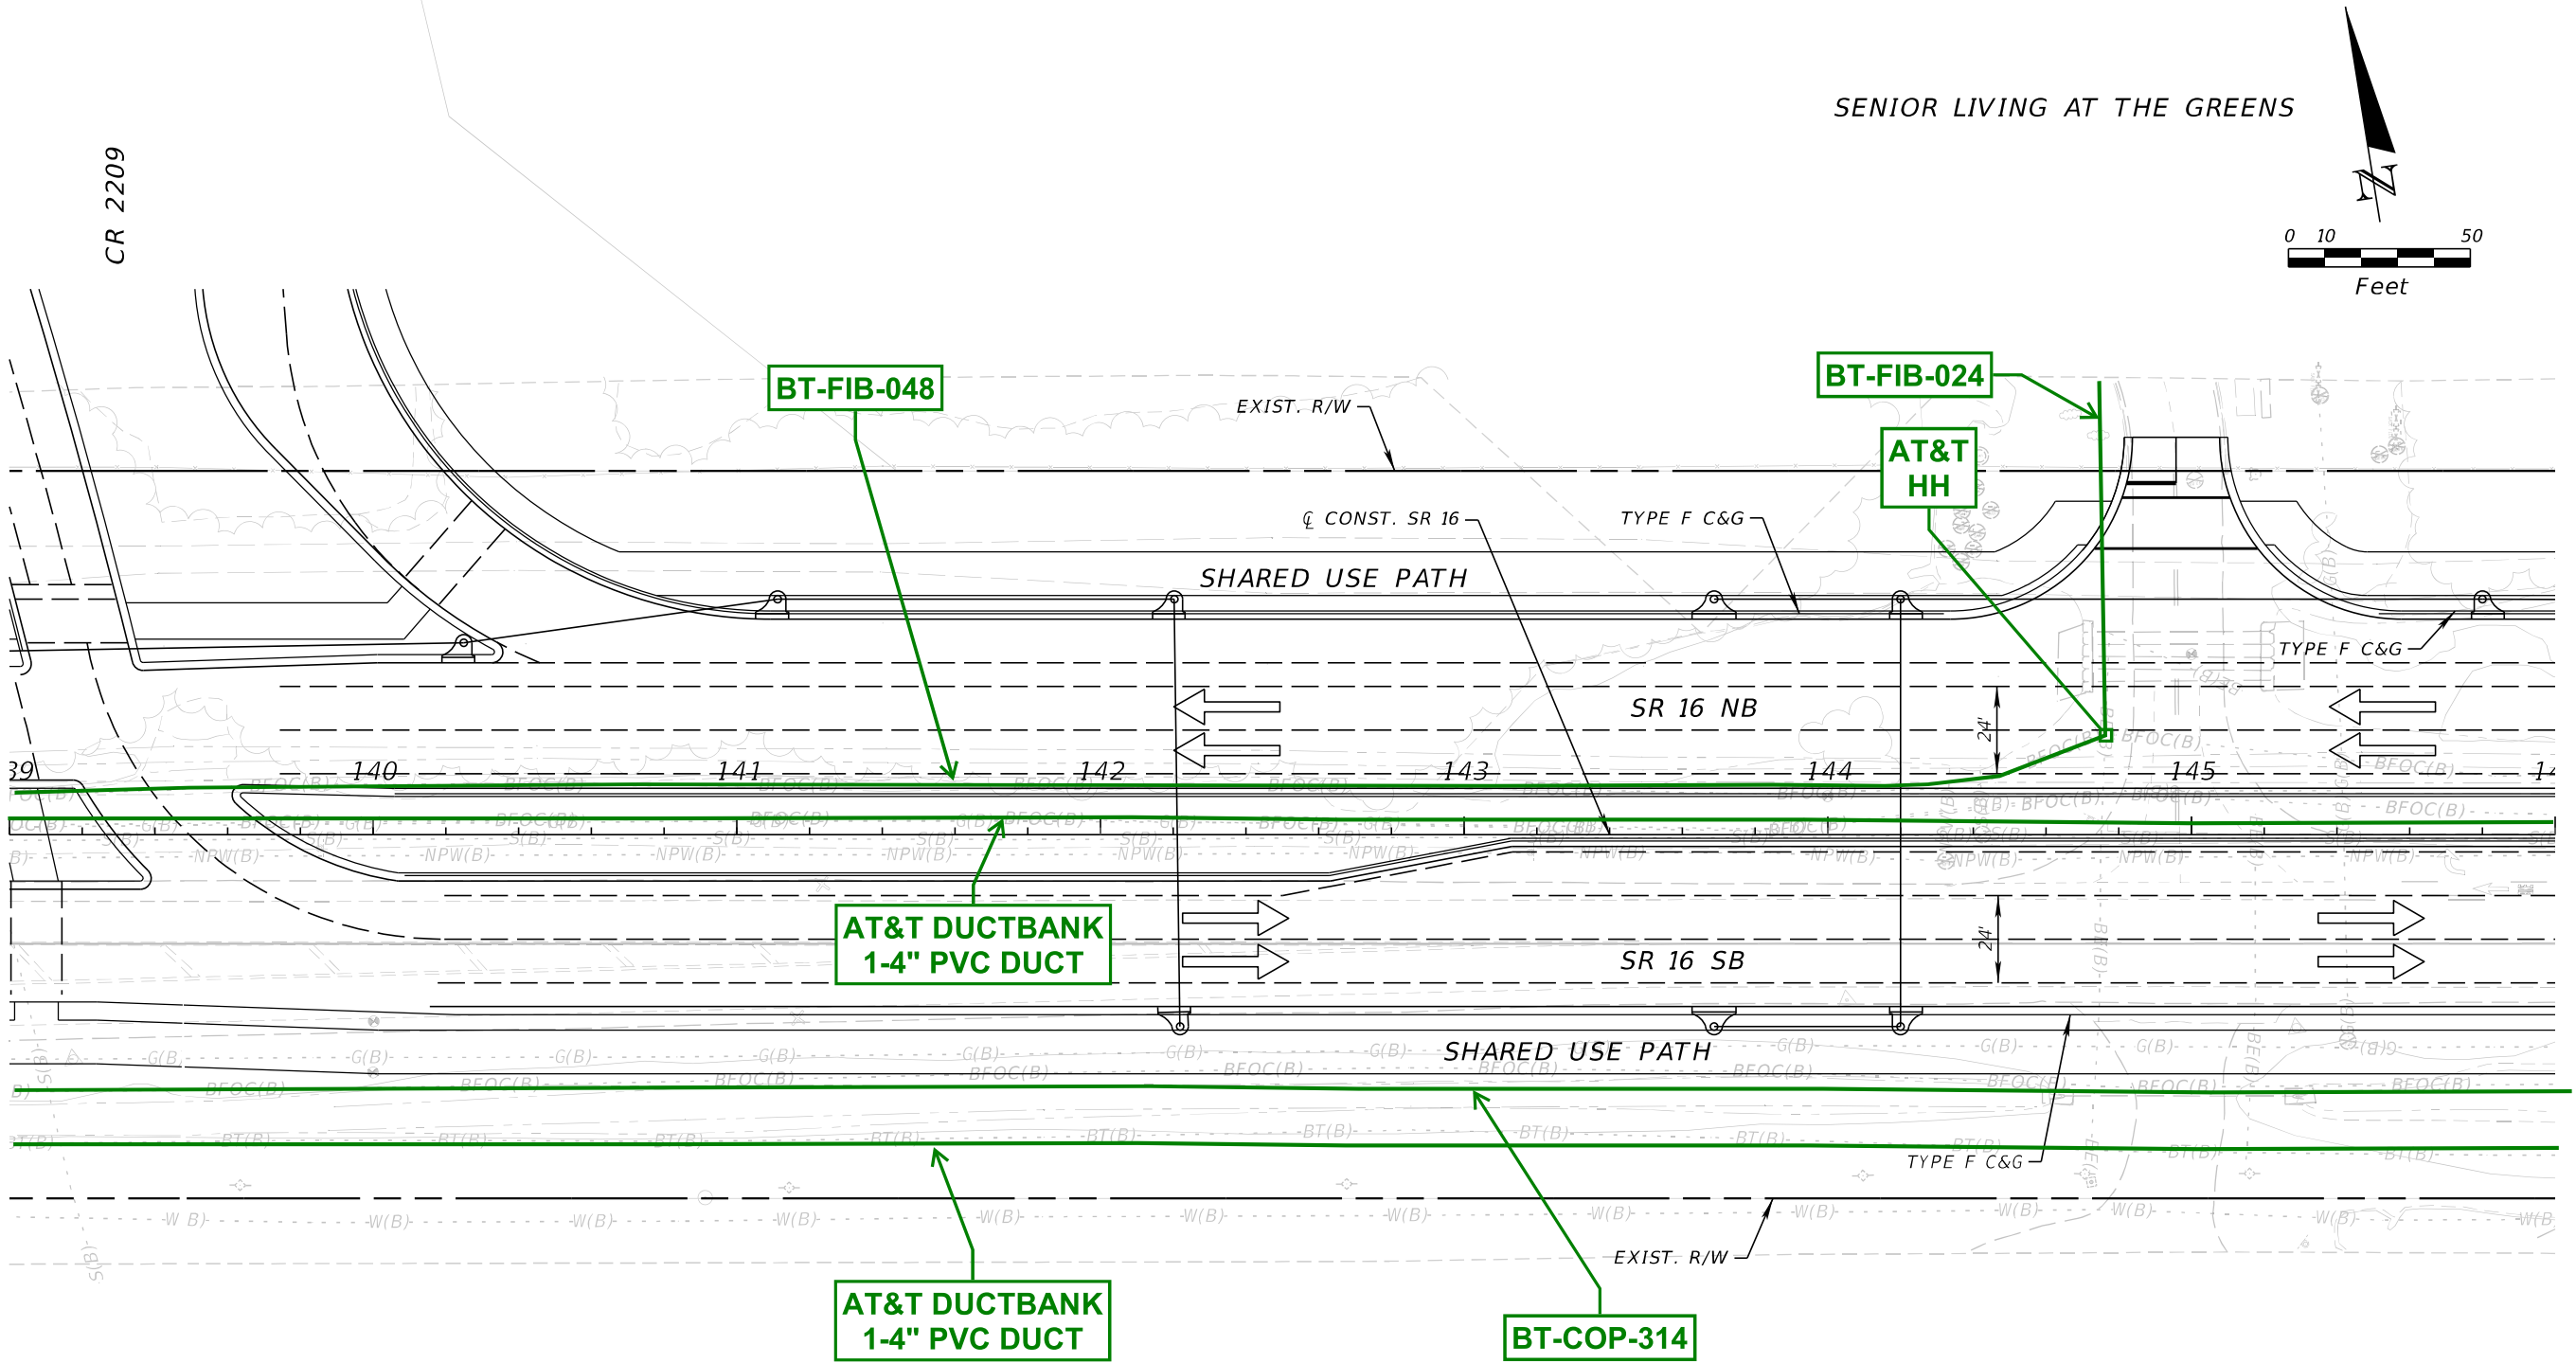



**LEGEND**

- ..... AERIAL AT&T
- BURIED AT&T
- ◆ AT&T PEDESTAL
- AT&T MANHOLE
- AT&T OWNED POLE

| REVISIONS |             | ENGINEER OF RECORD |                                                                                                                           | STATE OF FLORIDA<br>DEPARTMENT OF TRANSPORTATION |           |                      | ROADWAY PLAN | SHEET NO.<br><br>SR 16<br>- PLAN -<br>7 |
|-----------|-------------|--------------------|---------------------------------------------------------------------------------------------------------------------------|--------------------------------------------------|-----------|----------------------|--------------|-----------------------------------------|
| DATE      | DESCRIPTION | DATE               | DESCRIPTION                                                                                                               | ROAD NO.                                         | COUNTY    | FINANCIAL PROJECT ID |              |                                         |
|           |             |                    | STEPHEN J. PARK, P.E.<br>LICENSE NUMBER: 77656<br>RS&H, INC.<br>10748 DEERWOOD PARK BLVD. SOUTH<br>JACKSONVILLE, FL 32256 | SR 16                                            | ST. JOHNS | 210447-5-52-01       |              |                                         |

THE OFFICIAL RECORD OF THIS SHEET IS THE ELECTRONIC FILE DIGITALLY SIGNED AND SEALED UNDER RULE 61G15-23.004, F.A.C.

8/5/2024 4:28:42 PM BeattyM  
c:\pw\_work\sh\_pw\pw\_user\0439575\PLANRD01.dgn

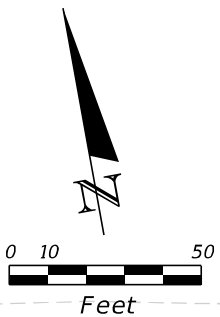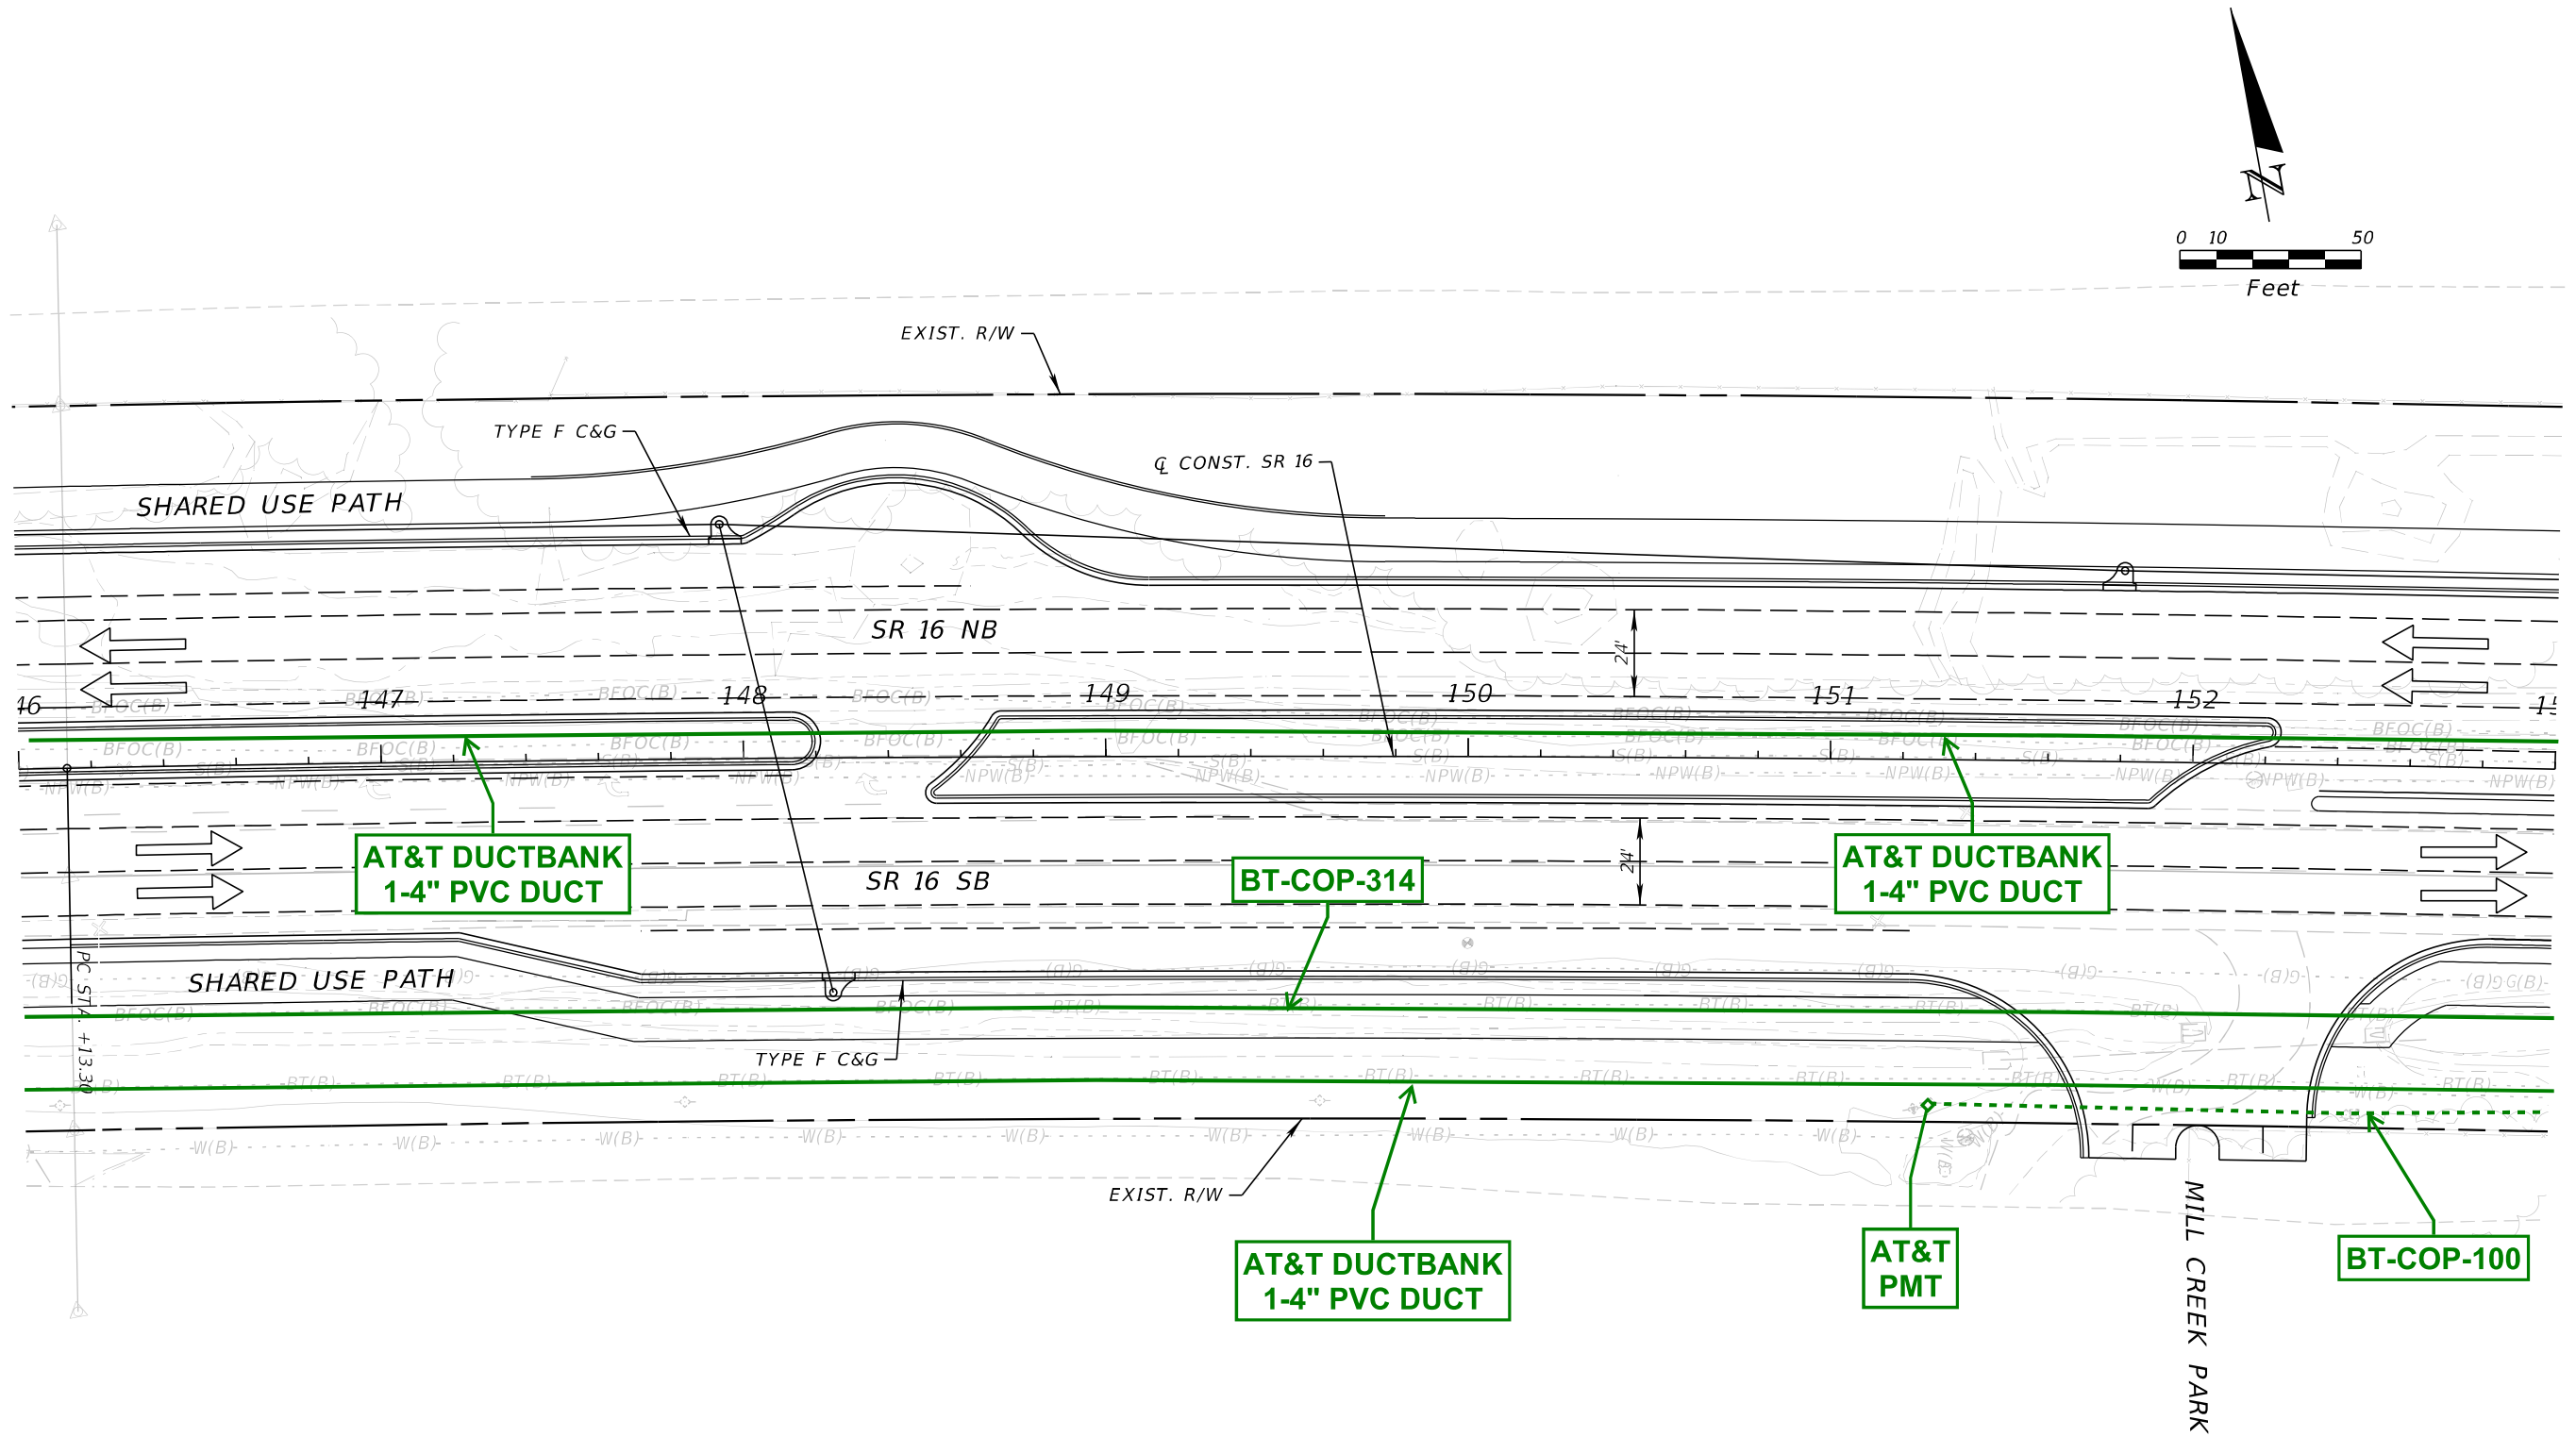


| LEGEND |                 |  |  |
|--------|-----------------|--|--|
| .....  | AERIAL AT&T     |  |  |
| ———    | BURIED AT&T     |  |  |
| ◆      | AT&T PEDESTAL   |  |  |
| □      | AT&T MANHOLE    |  |  |
| ○      | AT&T OWNED POLE |  |  |

| REVISIONS |             |      |             | ENGINEER OF RECORD                                                                                                        |  | STATE OF FLORIDA<br>DEPARTMENT OF TRANSPORTATION |           |                      | ROADWAY PLAN | SHEET NO.<br><br>SR 16<br>- PLAN -<br>8 |
|-----------|-------------|------|-------------|---------------------------------------------------------------------------------------------------------------------------|--|--------------------------------------------------|-----------|----------------------|--------------|-----------------------------------------|
| DATE      | DESCRIPTION | DATE | DESCRIPTION | STEPHEN J. PARK, P.E.<br>LICENSE NUMBER: 77656<br>RS&H, INC.<br>10748 DEERWOOD PARK BLVD. SOUTH<br>JACKSONVILLE, FL 32256 |  | ROAD NO.                                         | COUNTY    | FINANCIAL PROJECT ID |              |                                         |
|           |             |      |             |                                                                                                                           |  | SR 16                                            | ST. JOHNS | 210447-5-52-01       |              |                                         |

THE OFFICIAL RECORD OF THIS SHEET IS THE ELECTRONIC FILE DIGITALLY SIGNED AND SEALED UNDER RULE 61G15-23.004, F.A.C.


8/5/2024 4:28:43 PM BeattyM  
c:\pw\_work\sh\_pw\pw\_user\0439575\PLANRD01.dgn

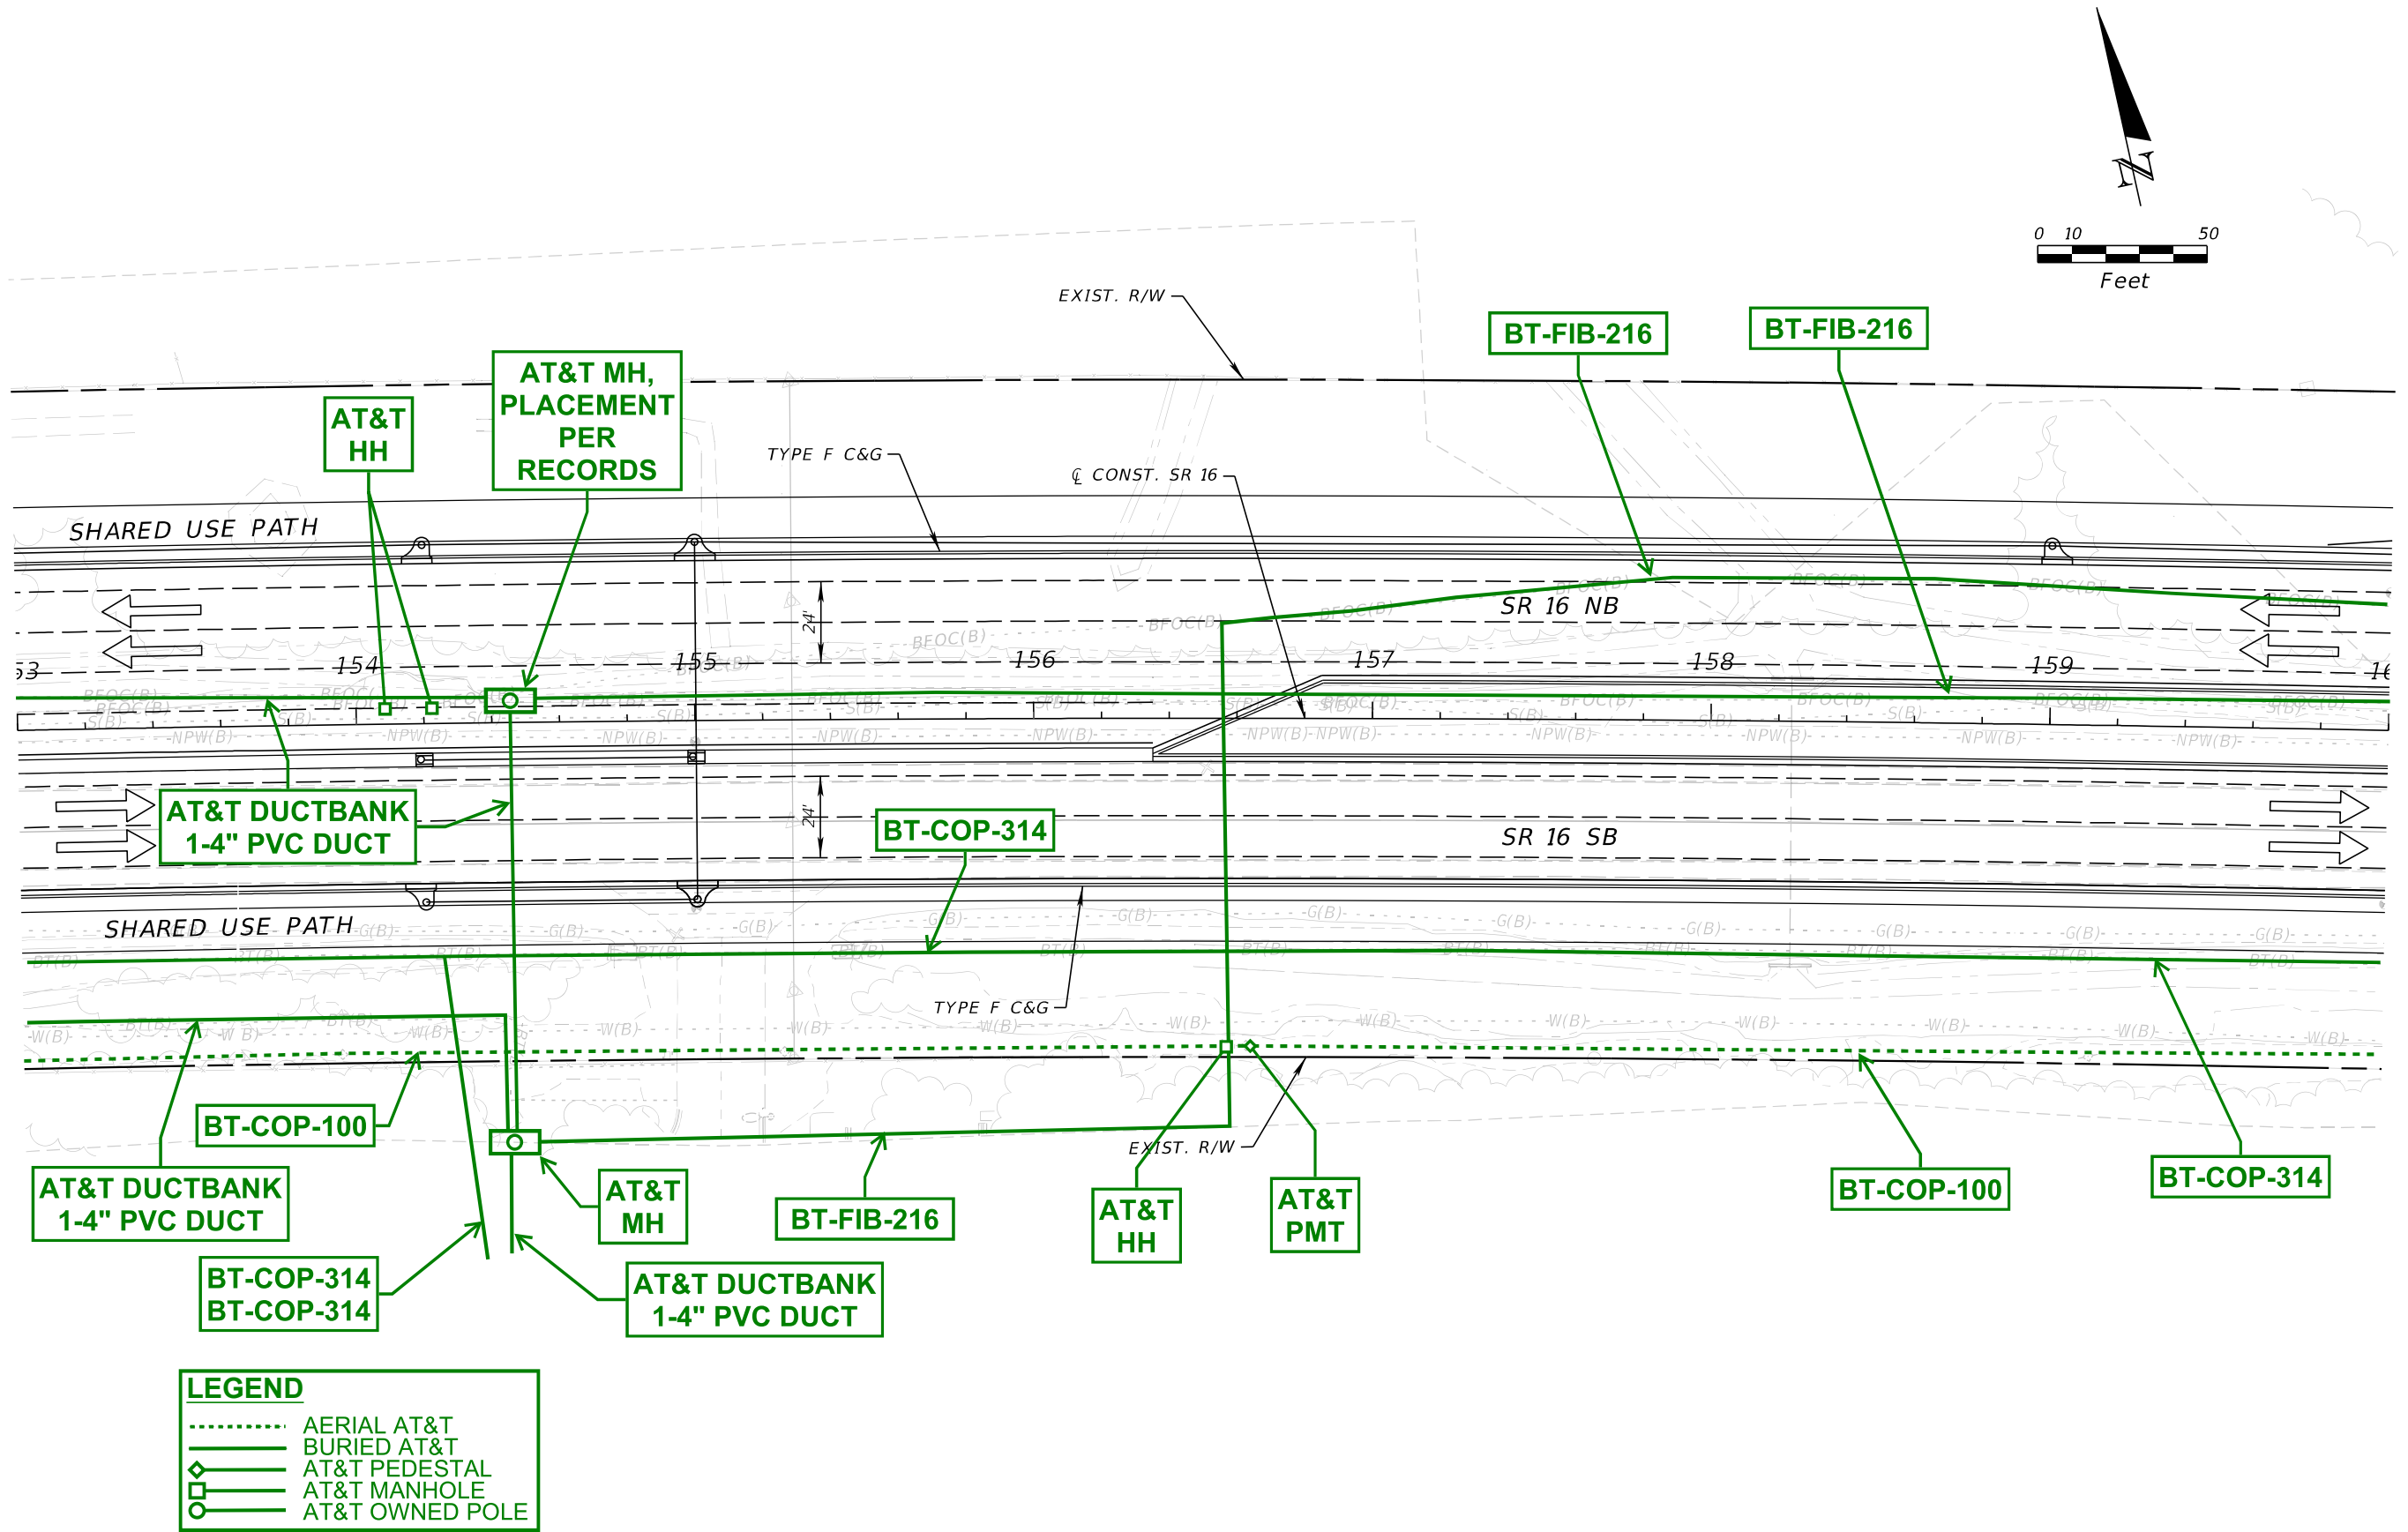

| REVISIONS |    |         |      | ENGINEER OF RECORD                                                                                                        |  |  | STATE OF FLORIDA<br>DEPARTMENT OF TRANSPORTATION |           |                      | ROADWAY PLAN | SHEET NO.<br><br>SR 16<br>- PLAN -<br>9 |
|-----------|----|---------|------|---------------------------------------------------------------------------------------------------------------------------|--|--|--------------------------------------------------|-----------|----------------------|--------------|-----------------------------------------|
| DATE      | DI | CRPTION | DATE | DESCRIPTION                                                                                                               |  |  | ROAD NO.                                         | COUNTY    | FINANCIAL PROJECT ID |              |                                         |
|           |    |         |      | STEPHEN J. PARK, P.E.<br>LICENSE NUMBER: 77656<br>RS&H, INC.<br>10748 DEERWOOD PARK BLVD. SOUTH<br>JACKSONVILLE, FL 32256 |  |  | SR 16                                            | ST. JOHNS | 210447-5-52-01       |              |                                         |

THE OFFICIAL RECORD OF THIS SHEET IS THE ELECTRONIC FILE DIGITALLY SIGNED AND SEALED UNDER RULE 61G15-23.004, F.A.C.

8/5/2024 4:28:43 PM BeattyM  
c:\pw\_work\ysh\_pw\pw\_user\0439575\PLANRD01.dgn

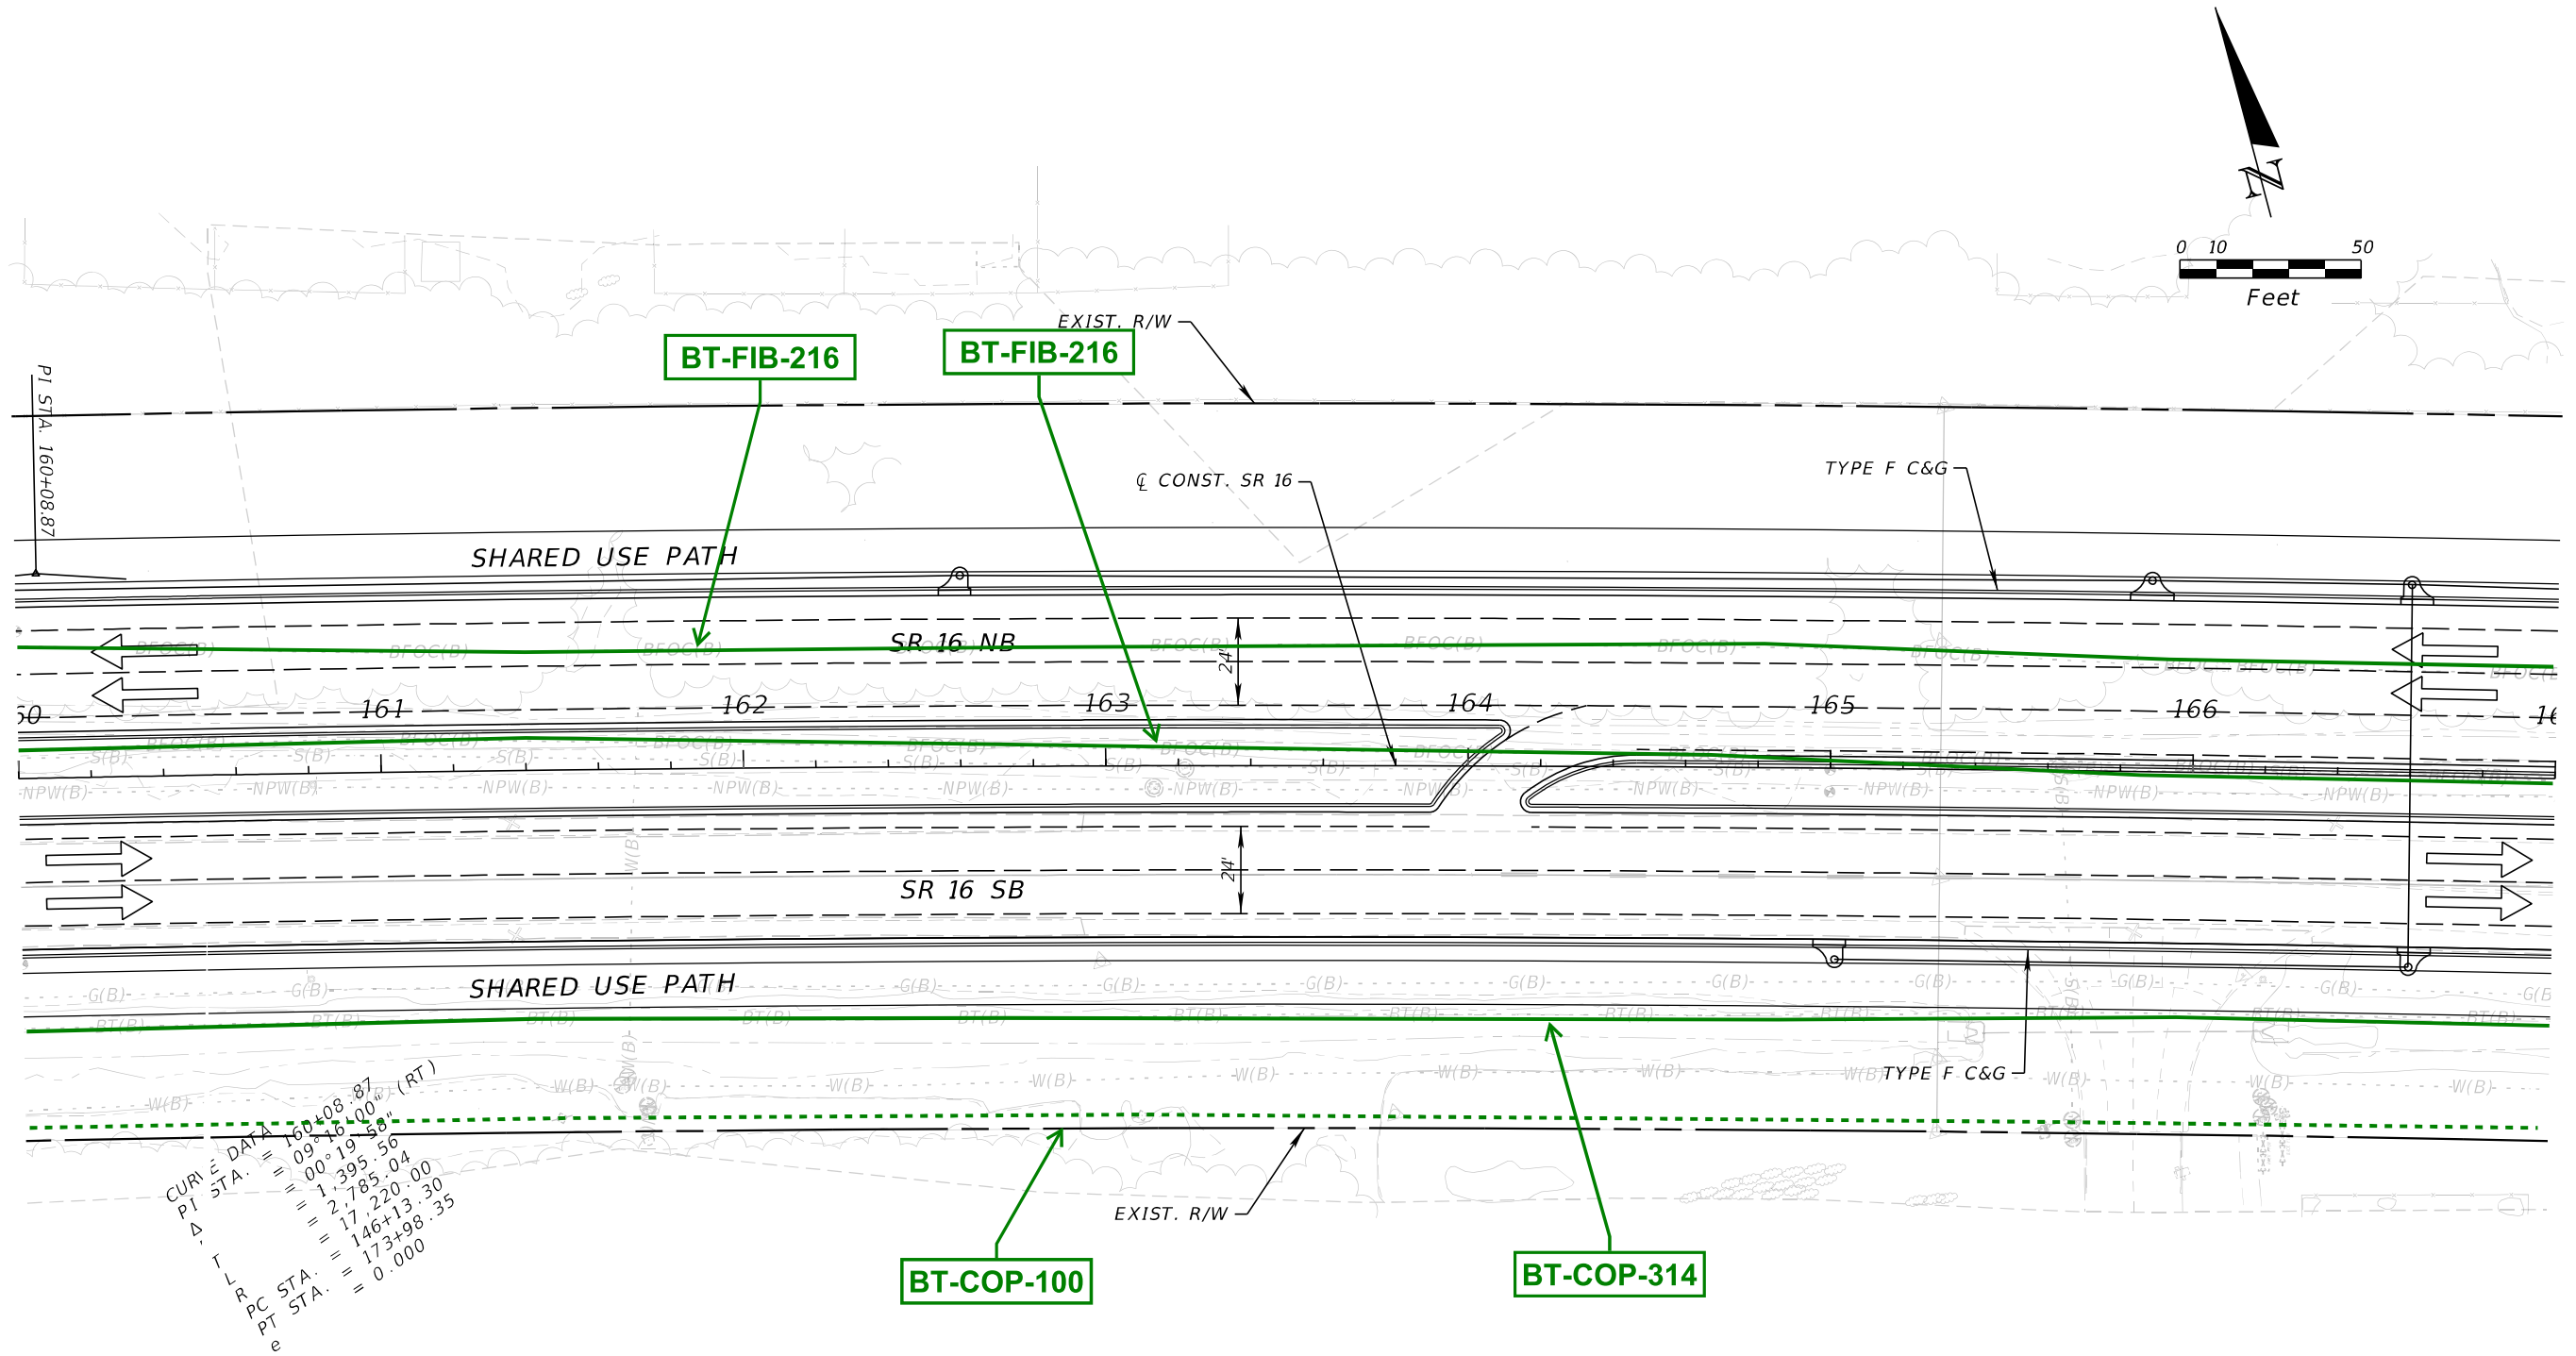


| LEGEND |                 |
|--------|-----------------|
| .....  | AERIAL AT&T     |
| ————   | BURIED AT&T     |
| ◇      | AT&T PEDESTAL   |
| □      | AT&T MANHOLE    |
| ○      | AT&T OWNED POLE |

| REVISIONS |             | ENGINEER OF RECORD |             | STATE OF FLORIDA<br>DEPARTMENT OF TRANSPORTATION |           |                      | ROADWAY PLAN                 |
|-----------|-------------|--------------------|-------------|--------------------------------------------------|-----------|----------------------|------------------------------|
| DATE      | DESCRIPTION | DATE               | DESCRIPTION | ROAD NO.                                         | COUNTY    | FINANCIAL PROJECT ID |                              |
|           |             |                    |             | SR 16                                            | ST. JOHNS | 210447-5-52-01       |                              |
|           |             |                    |             |                                                  |           |                      | SHEET NO.<br>SR 16 - PLAN-10 |

THE OFFICIAL RECORD OF THIS SHEET IS THE ELECTRONIC FILE DIGITALLY SIGNED AND SEALED UNDER RULE 61G15-23.004, F.A.C.

8/5/2024 4:28:44 PM BeattyM  
c:\pw\_work\sh\_pw\pw\_user\0439575\PLANRD01.dgn

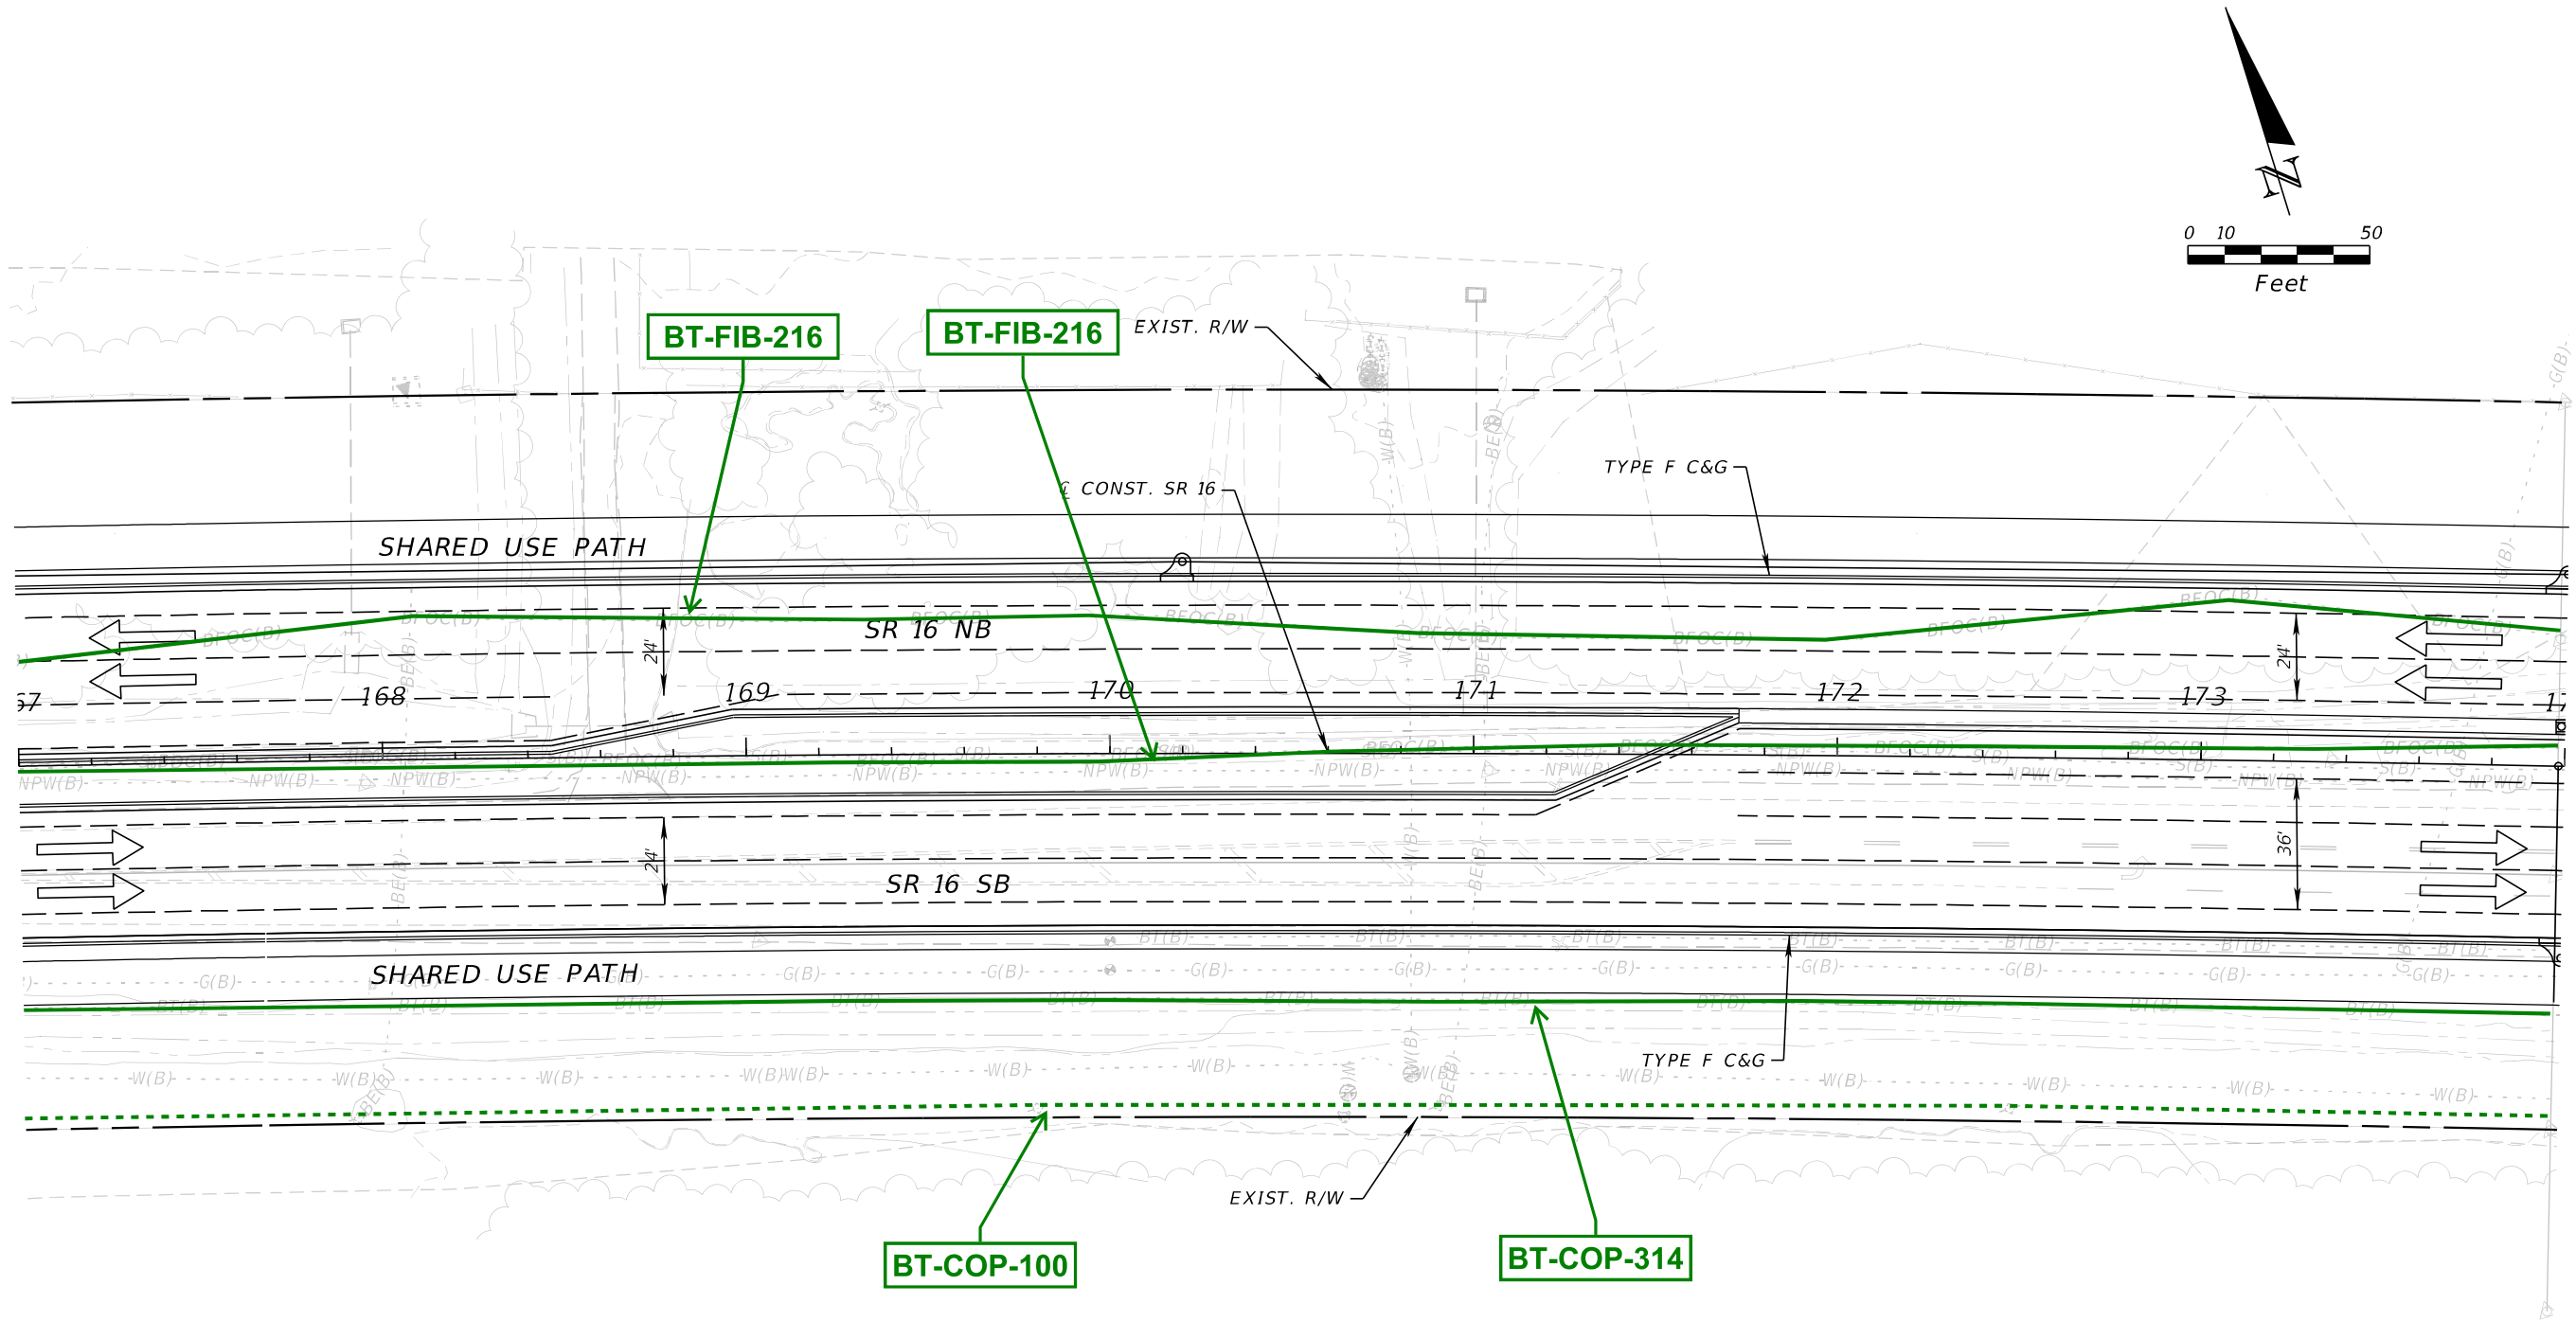



| LEGEND |                 |
|--------|-----------------|
|        | AERIAL AT&T     |
|        | BURIED AT&T     |
|        | AT&T PEDESTAL   |
|        | AT&T MANHOLE    |
|        | AT&T OWNED POLE |

|      |             | REVISIONS |             |                                                                                                                           | ENGINEER OF RECORD | STATE OF FLORIDA<br>DEPARTMENT OF TRANSPORTATION |                      |                         | ROADWAY PLAN | SHEET NO. |
|------|-------------|-----------|-------------|---------------------------------------------------------------------------------------------------------------------------|--------------------|--------------------------------------------------|----------------------|-------------------------|--------------|-----------|
| DATE | DESCRIPTION | DATE      | DESCRIPTION |                                                                                                                           | ROAD NO.           | COUNTY                                           | FINANCIAL PROJECT ID | SR 16<br>- PLAN -<br>11 |              |           |
|      |             |           |             | STEPHEN J. PARK, P.E.<br>LICENSE NUMBER: 77656<br>RS&H, INC.<br>10748 DEERWOOD PARK BLVD. SOUTH<br>JACKSONVILLE, FL 32256 | SR 16              | ST. JOHNS                                        | 210447-5-52-01       |                         |              |           |

THE OFFICIAL RECORD OF THIS SHEET IS THE ELECTRONIC FILE DIGITALLY SIGNED AND SEALED UNDER RULE 61G15-23.004, F.A.C.



8/5/2024 4:28:45 PM BeattyM  
c:\pw\_work\sh\_pw\pw\_user\0439575\PLANRD01.dgn

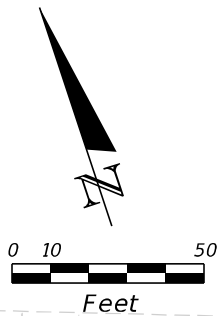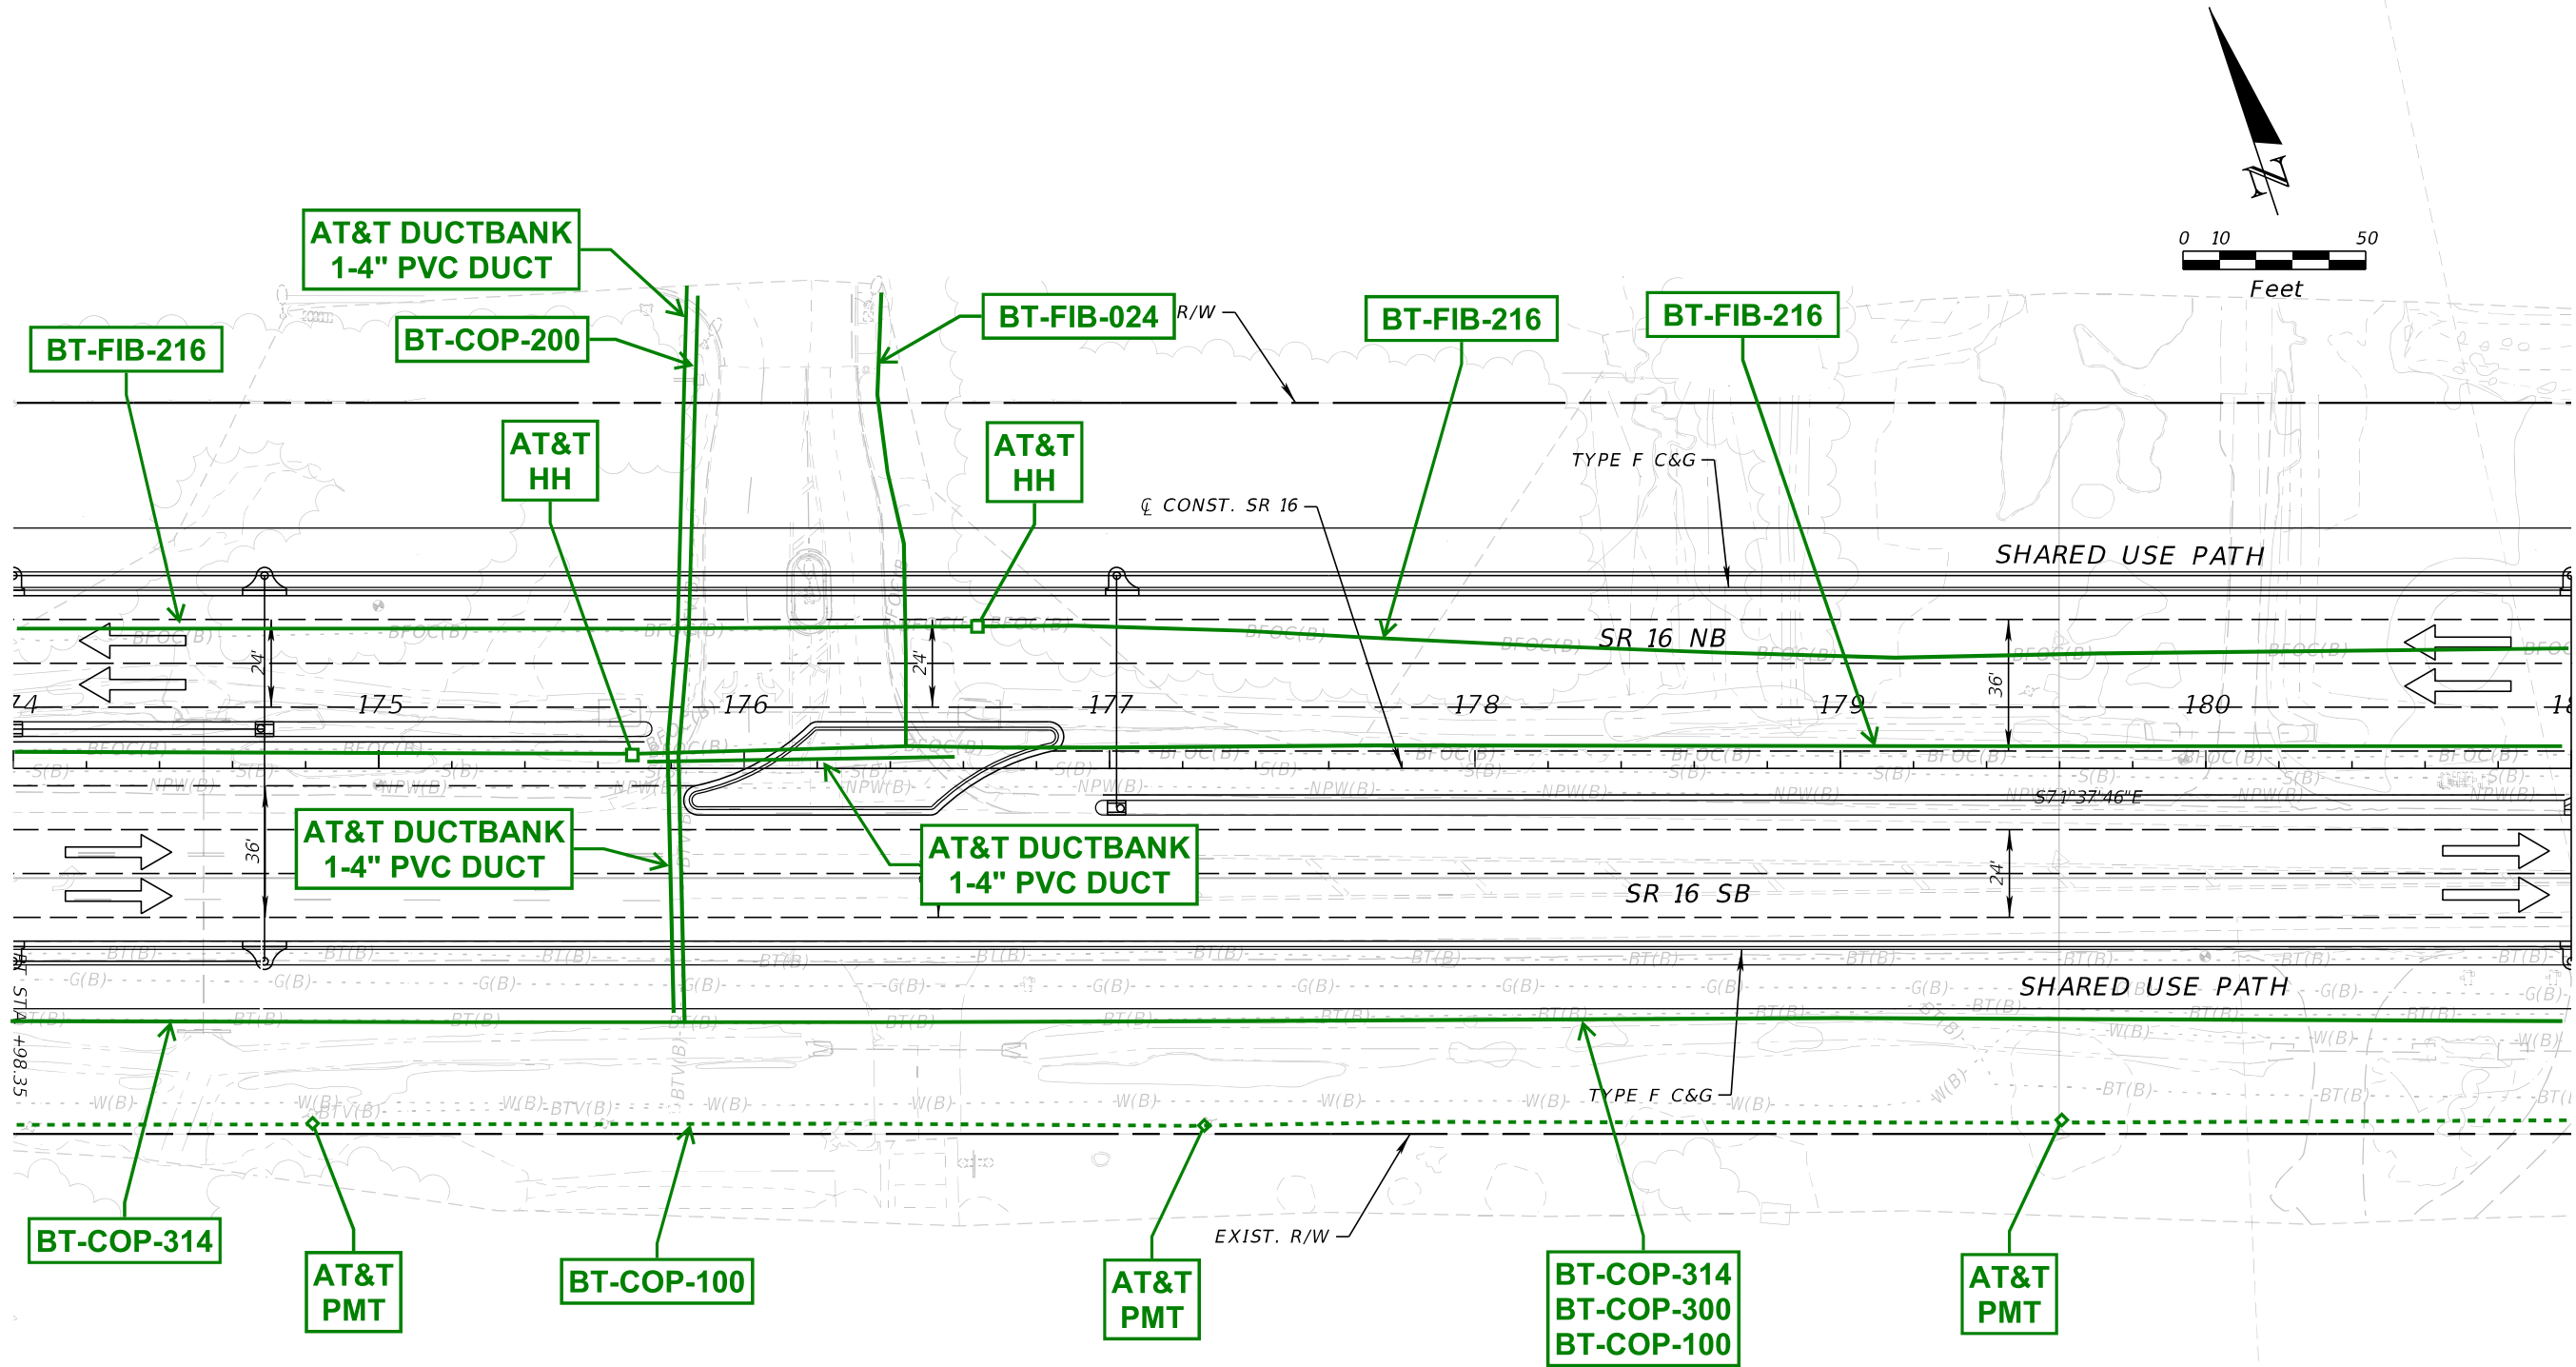


| LEGEND |                 |
|--------|-----------------|
| .....  | AERIAL AT&T     |
| ————   | BURIED AT&T     |
| ◇      | AT&T PEDESTAL   |
| □      | AT&T MANHOLE    |
| ○      | AT&T OWNED POLE |

| REVISIONS |             |      |             | ENGINEER OF RECORD                                                                                                        |  |  | STATE OF FLORIDA<br>DEPARTMENT OF TRANSPORTATION |           |                      | ROADWAY PLAN | SHEET NO.<br><br>SR 16<br>- PLAN -<br>12 |
|-----------|-------------|------|-------------|---------------------------------------------------------------------------------------------------------------------------|--|--|--------------------------------------------------|-----------|----------------------|--------------|------------------------------------------|
| DATE      | DESCRIPTION | DATE | DESCRIPTION | STEPHEN J. PARK, P.E.<br>LICENSE NUMBER: 77656<br>RS&H, INC.<br>10748 DEERWOOD PARK BLVD. SOUTH<br>JACKSONVILLE, FL 32256 |  |  | ROAD NO.                                         | COUNTY    | FINANCIAL PROJECT ID |              |                                          |
|           |             |      |             |                                                                                                                           |  |  | SR 16                                            | ST. JOHNS | 210447-5-52-01       |              |                                          |

THE OFFICIAL RECORD OF THIS SHEET IS THE ELECTRONIC FILE DIGITALLY SIGNED AND SEALED UNDER RULE 61G15-23.004, F.A.C.

8/5/2024 4:28:45 PM BeattyM  
c:\pw\_work\sh\_pw\pw\_user\0439575\PLANRD01.dgn

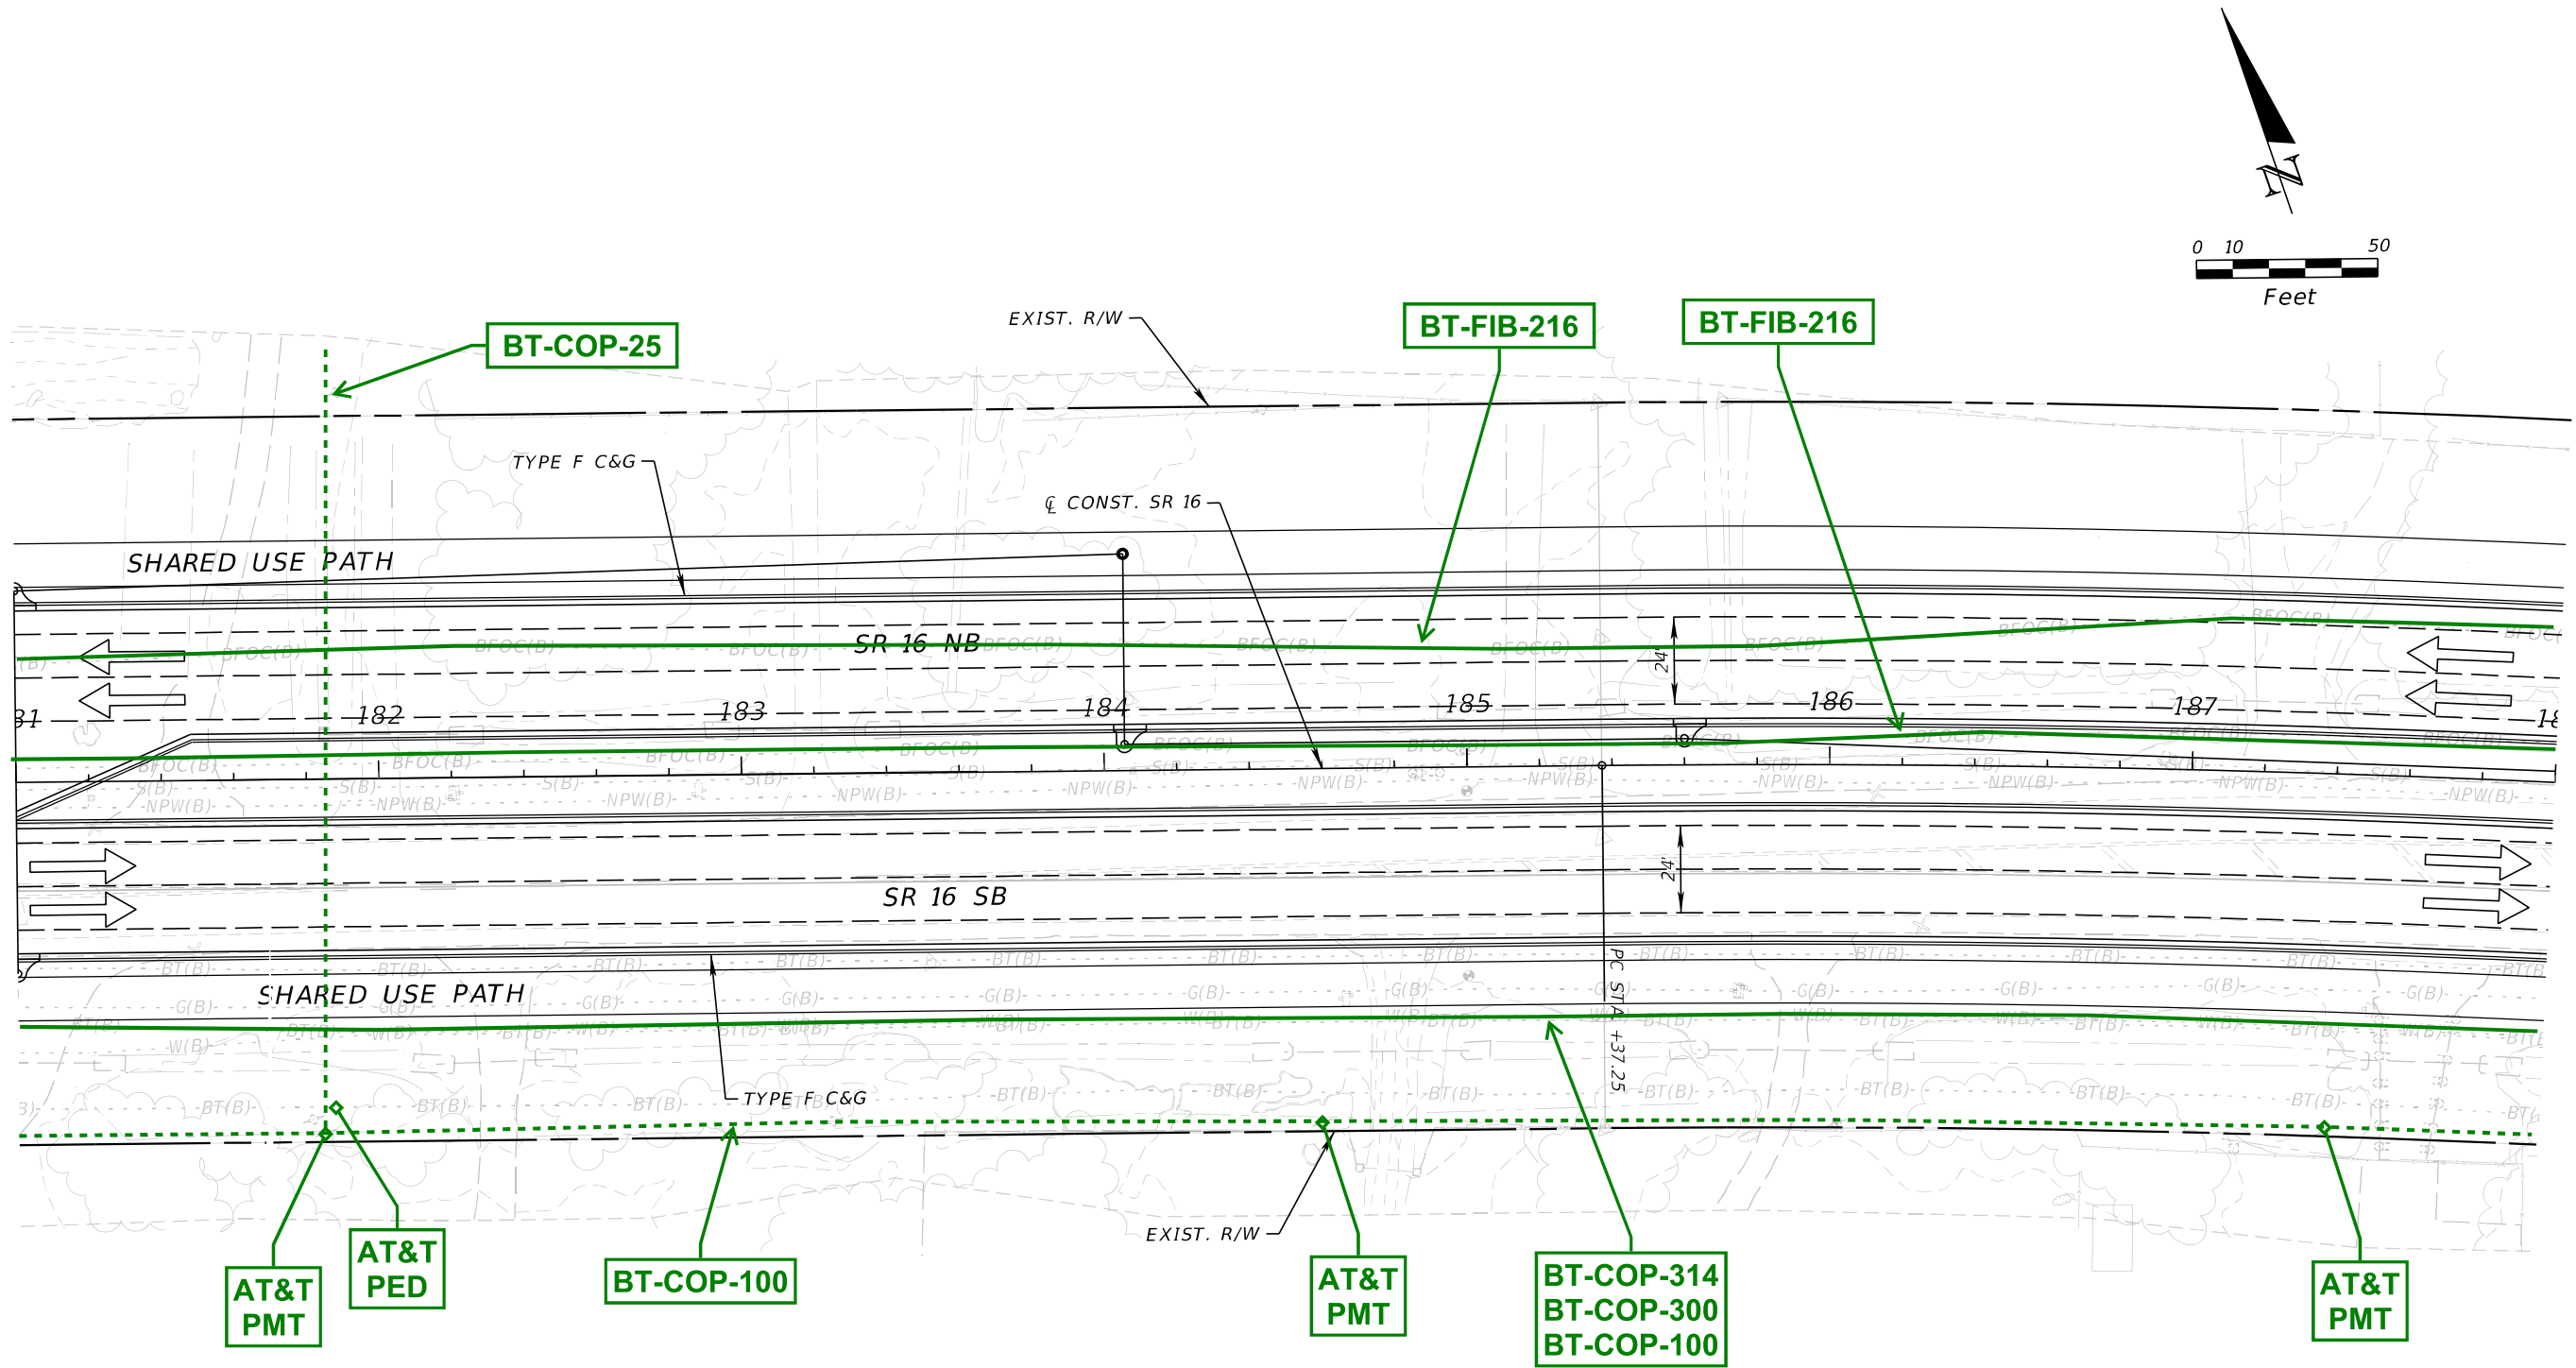


| LEGEND |                 |  |  |  |
|--------|-----------------|--|--|--|
| .....  | AERIAL AT&T     |  |  |  |
| ——     | BURIED AT&T     |  |  |  |
| ◇      | AT&T PEDESTAL   |  |  |  |
| □      | AT&T MANHOLE    |  |  |  |
| ○      | AT&T OWNED POLE |  |  |  |

| REVISIONS |     |         |      | ENGINEER OF RECORD                                                                                                        | STATE OF FLORIDA<br>DEPARTMENT OF TRANSPORTATION |           |                      | SHEET<br>NO.          |
|-----------|-----|---------|------|---------------------------------------------------------------------------------------------------------------------------|--------------------------------------------------|-----------|----------------------|-----------------------|
| DATE      | DES | RIPTION | DATE |                                                                                                                           | ROAD NO.                                         | COUNTY    | FINANCIAL PROJECT ID |                       |
|           |     |         |      |                                                                                                                           | SR 16                                            | ST. JOHNS | 210447-5-52-01       |                       |
|           |     |         |      | STEPHEN J. PARK, P.E.<br>LICENSE NUMBER: 77656<br>RS&H, INC.<br>10748 DEERWOOD PARK BLVD. SOUTH<br>JACKSONVILLE, FL 32256 |                                                  |           |                      | 11x17<br>Plan<br>Only |

THE OFFICIAL RECORD OF THIS SHEET IS THE ELECTRONIC FILE DIGITALLY SIGNED AND SEALED UNDER RULE 61G15-23.004, F.A.C.

8/5/2024 4:28:46 PM BeattyM  
c:\pw\_work\ysh\_pw\pw\_user\0439575\PLANRD01.dgn

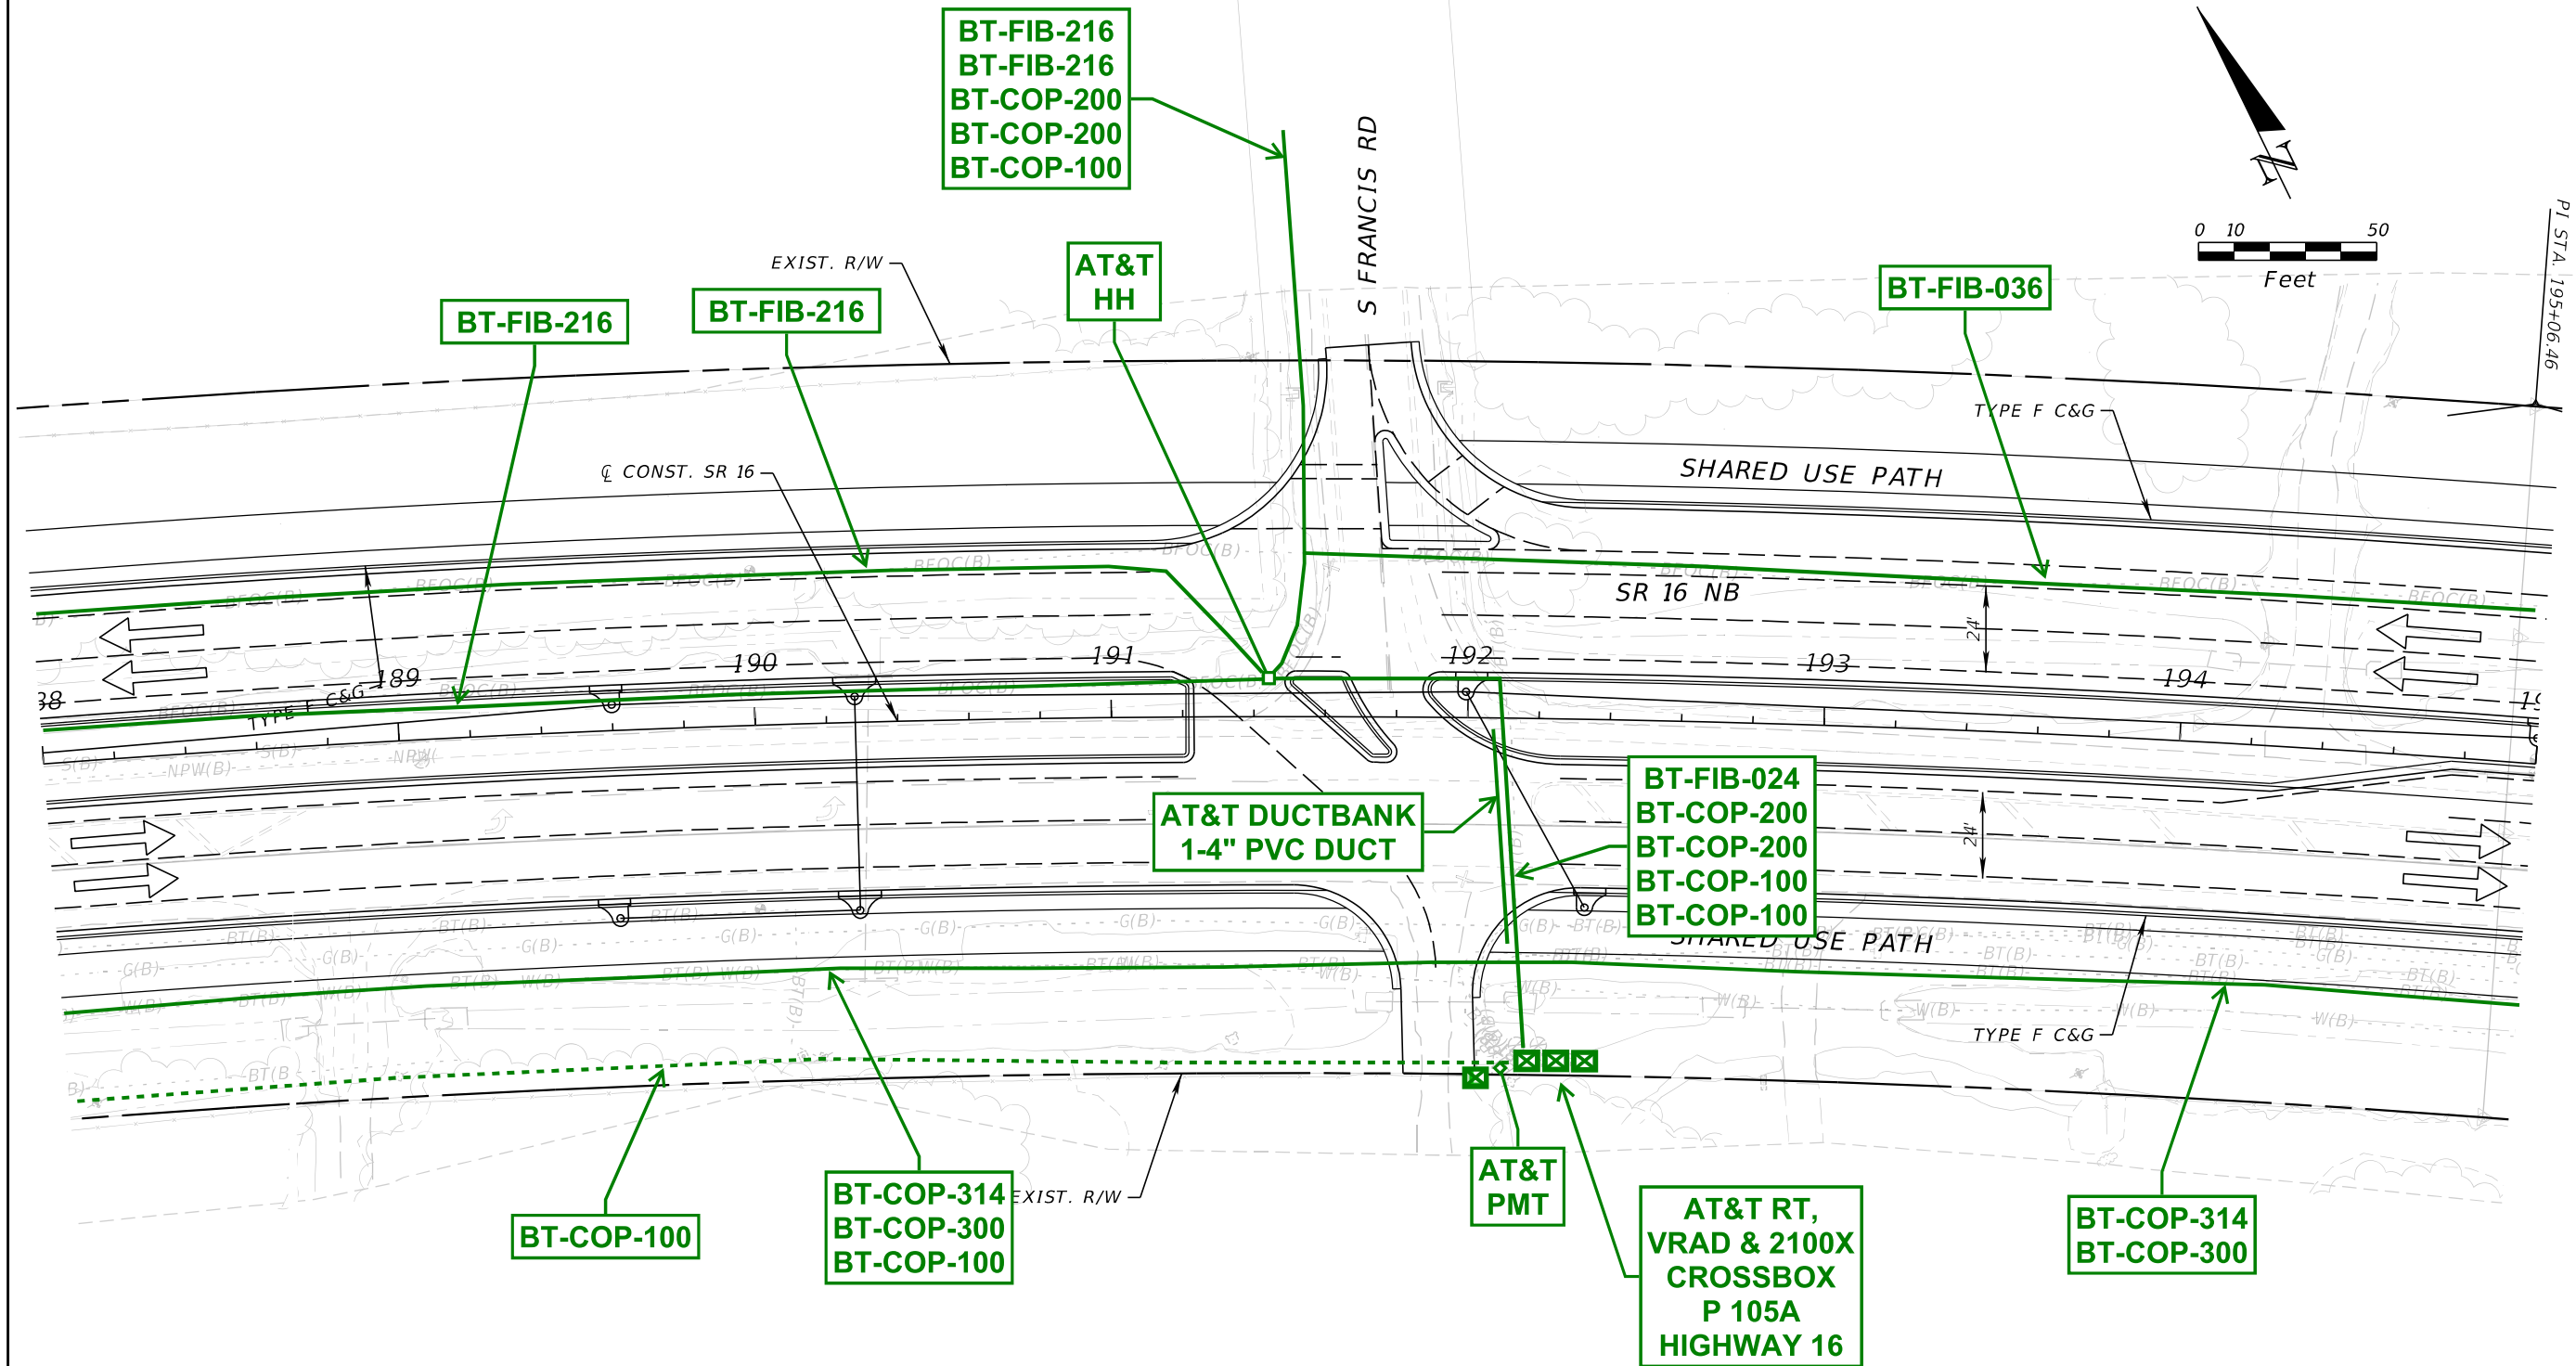


| LEGEND |                 |
|--------|-----------------|
| .....  | AERIAL AT&T     |
| ————   | BURIED AT&T     |
| ◇      | AT&T PEDESTAL   |
| □      | AT&T MANHOLE    |
| ○      | AT&T OWNED POLE |

| REVISIONS |     |         |      | ENGINEER OF RECORD                                                                                                        | STATE OF FLORIDA<br>DEPARTMENT OF TRANSPORTATION |           |                      | SHEET<br>NO.          |
|-----------|-----|---------|------|---------------------------------------------------------------------------------------------------------------------------|--------------------------------------------------|-----------|----------------------|-----------------------|
| DATE      | DES | RIPTION | DATE |                                                                                                                           | ROAD NO.                                         | COUNTY    | FINANCIAL PROJECT ID |                       |
|           |     |         |      |                                                                                                                           | SR 16                                            | ST. JOHNS | 210447-5-52-01       |                       |
|           |     |         |      | STEPHEN J. PARK, P.E.<br>LICENSE NUMBER: 77656<br>RS&H, INC.<br>10748 DEERWOOD PARK BLVD. SOUTH<br>JACKSONVILLE, FL 32256 |                                                  |           |                      | 11x17<br>Plan<br>Only |

THE OFFICIAL RECORD OF THIS SHEET IS THE ELECTRONIC FILE DIGITALLY SIGNED AND SEALED UNDER RULE 61G15-23.004, F.A.C.

8/5/2024 4:28:47 PM BeattyM  
c:\pw\_work\ysh\_pw\pw\_user\0439575\PLAINRD01.dgn

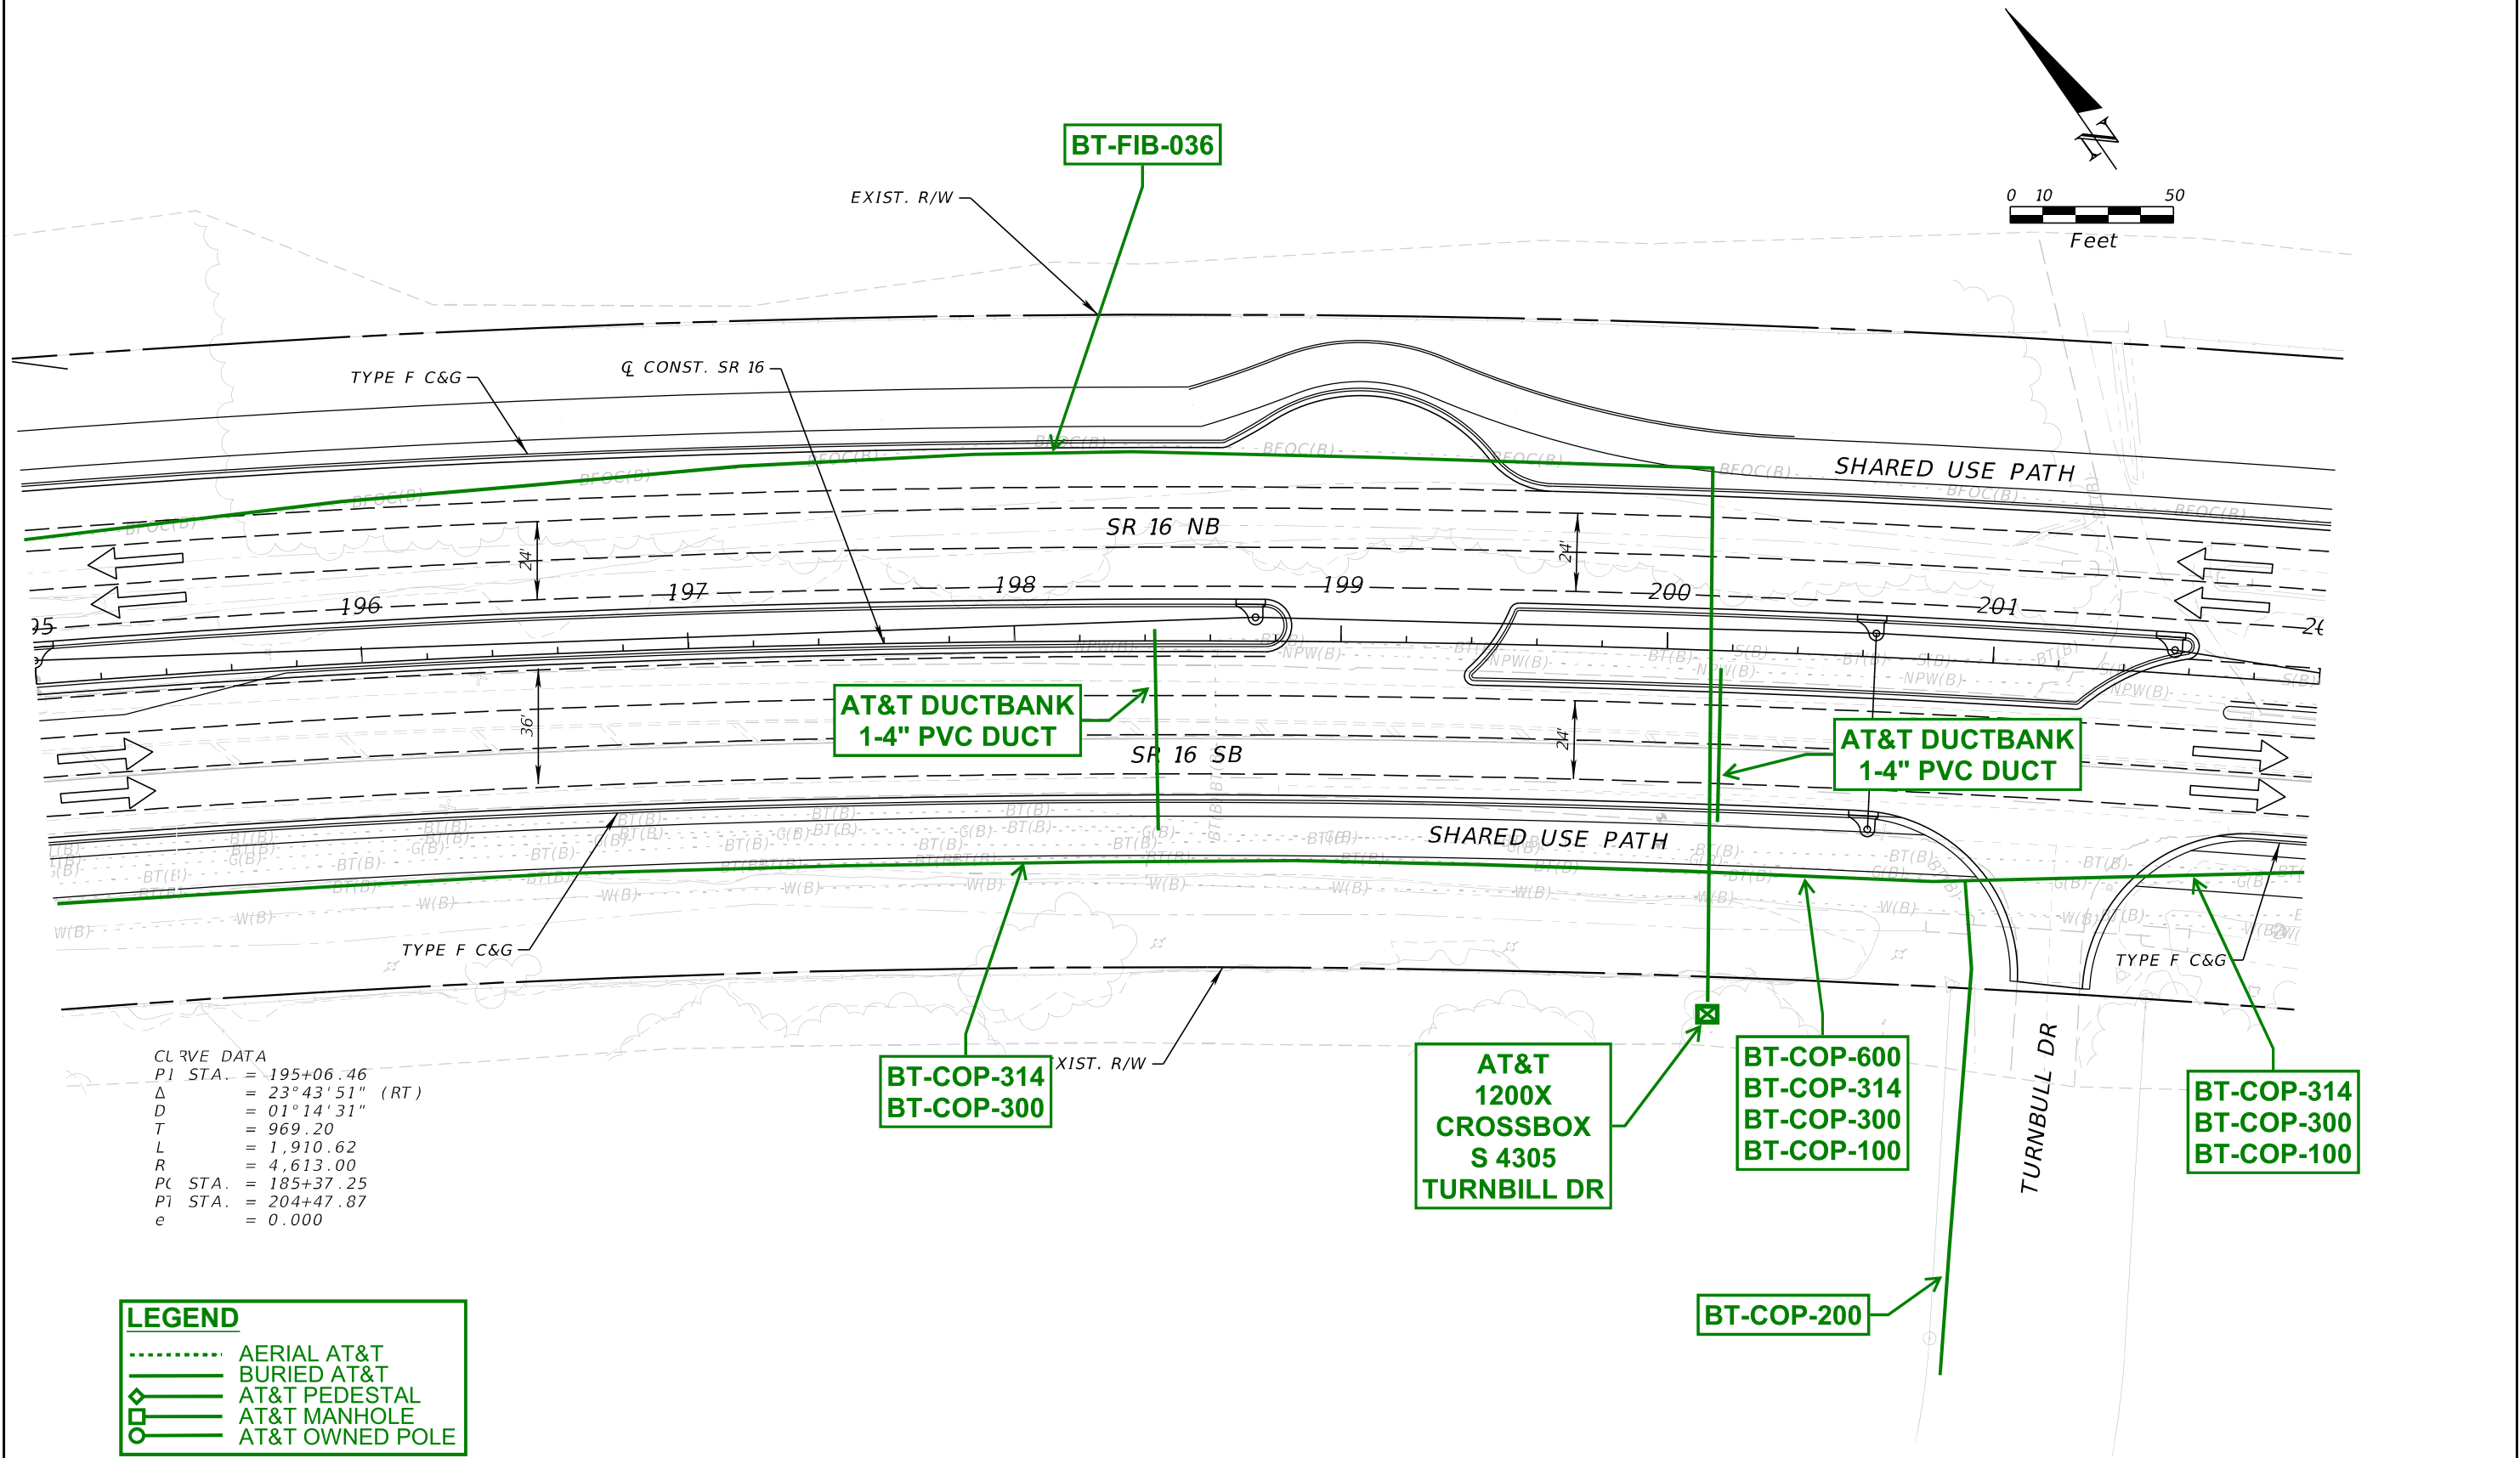


| REVISIONS |             |      |             | ENGINEER OF RECORD | STATE OF FLORIDA<br>DEPARTMENT OF TRANSPORTATION |           |                      | SHEET<br>NO. |
|-----------|-------------|------|-------------|--------------------|--------------------------------------------------|-----------|----------------------|--------------|
| DATE      | DESCRIPTION | DATE | DESCRIPTION |                    | ROAD NO.                                         | COUNTY    | FINANCIAL PROJECT ID |              |
|           |             |      |             |                    | SR 16                                            | ST. JOHNS | 210447-5-52-01       |              |

|                                                                                                                           |  |  |  |                       |  |
|---------------------------------------------------------------------------------------------------------------------------|--|--|--|-----------------------|--|
| STEPHEN J. PARK, P.E.<br>LICENSE NUMBER: 77656<br>RS&H, INC.<br>10748 DEERWOOD PARK BLVD. SOUTH<br>JACKSONVILLE, FL 32256 |  |  |  | 11x17<br>Plan<br>Only |  |
|---------------------------------------------------------------------------------------------------------------------------|--|--|--|-----------------------|--|

THE OFFICIAL RECORD OF THIS SHEET IS THE ELECTRONIC FILE DIGITALLY SIGNED AND SEALED UNDER RULE 61G15-23.004, F.A.C.



8/5/2024 4:28:48 PM BeattyM  
c:\pw\_work\ysh\_pw\pw\_user\0439575\PLANRD01.dgn

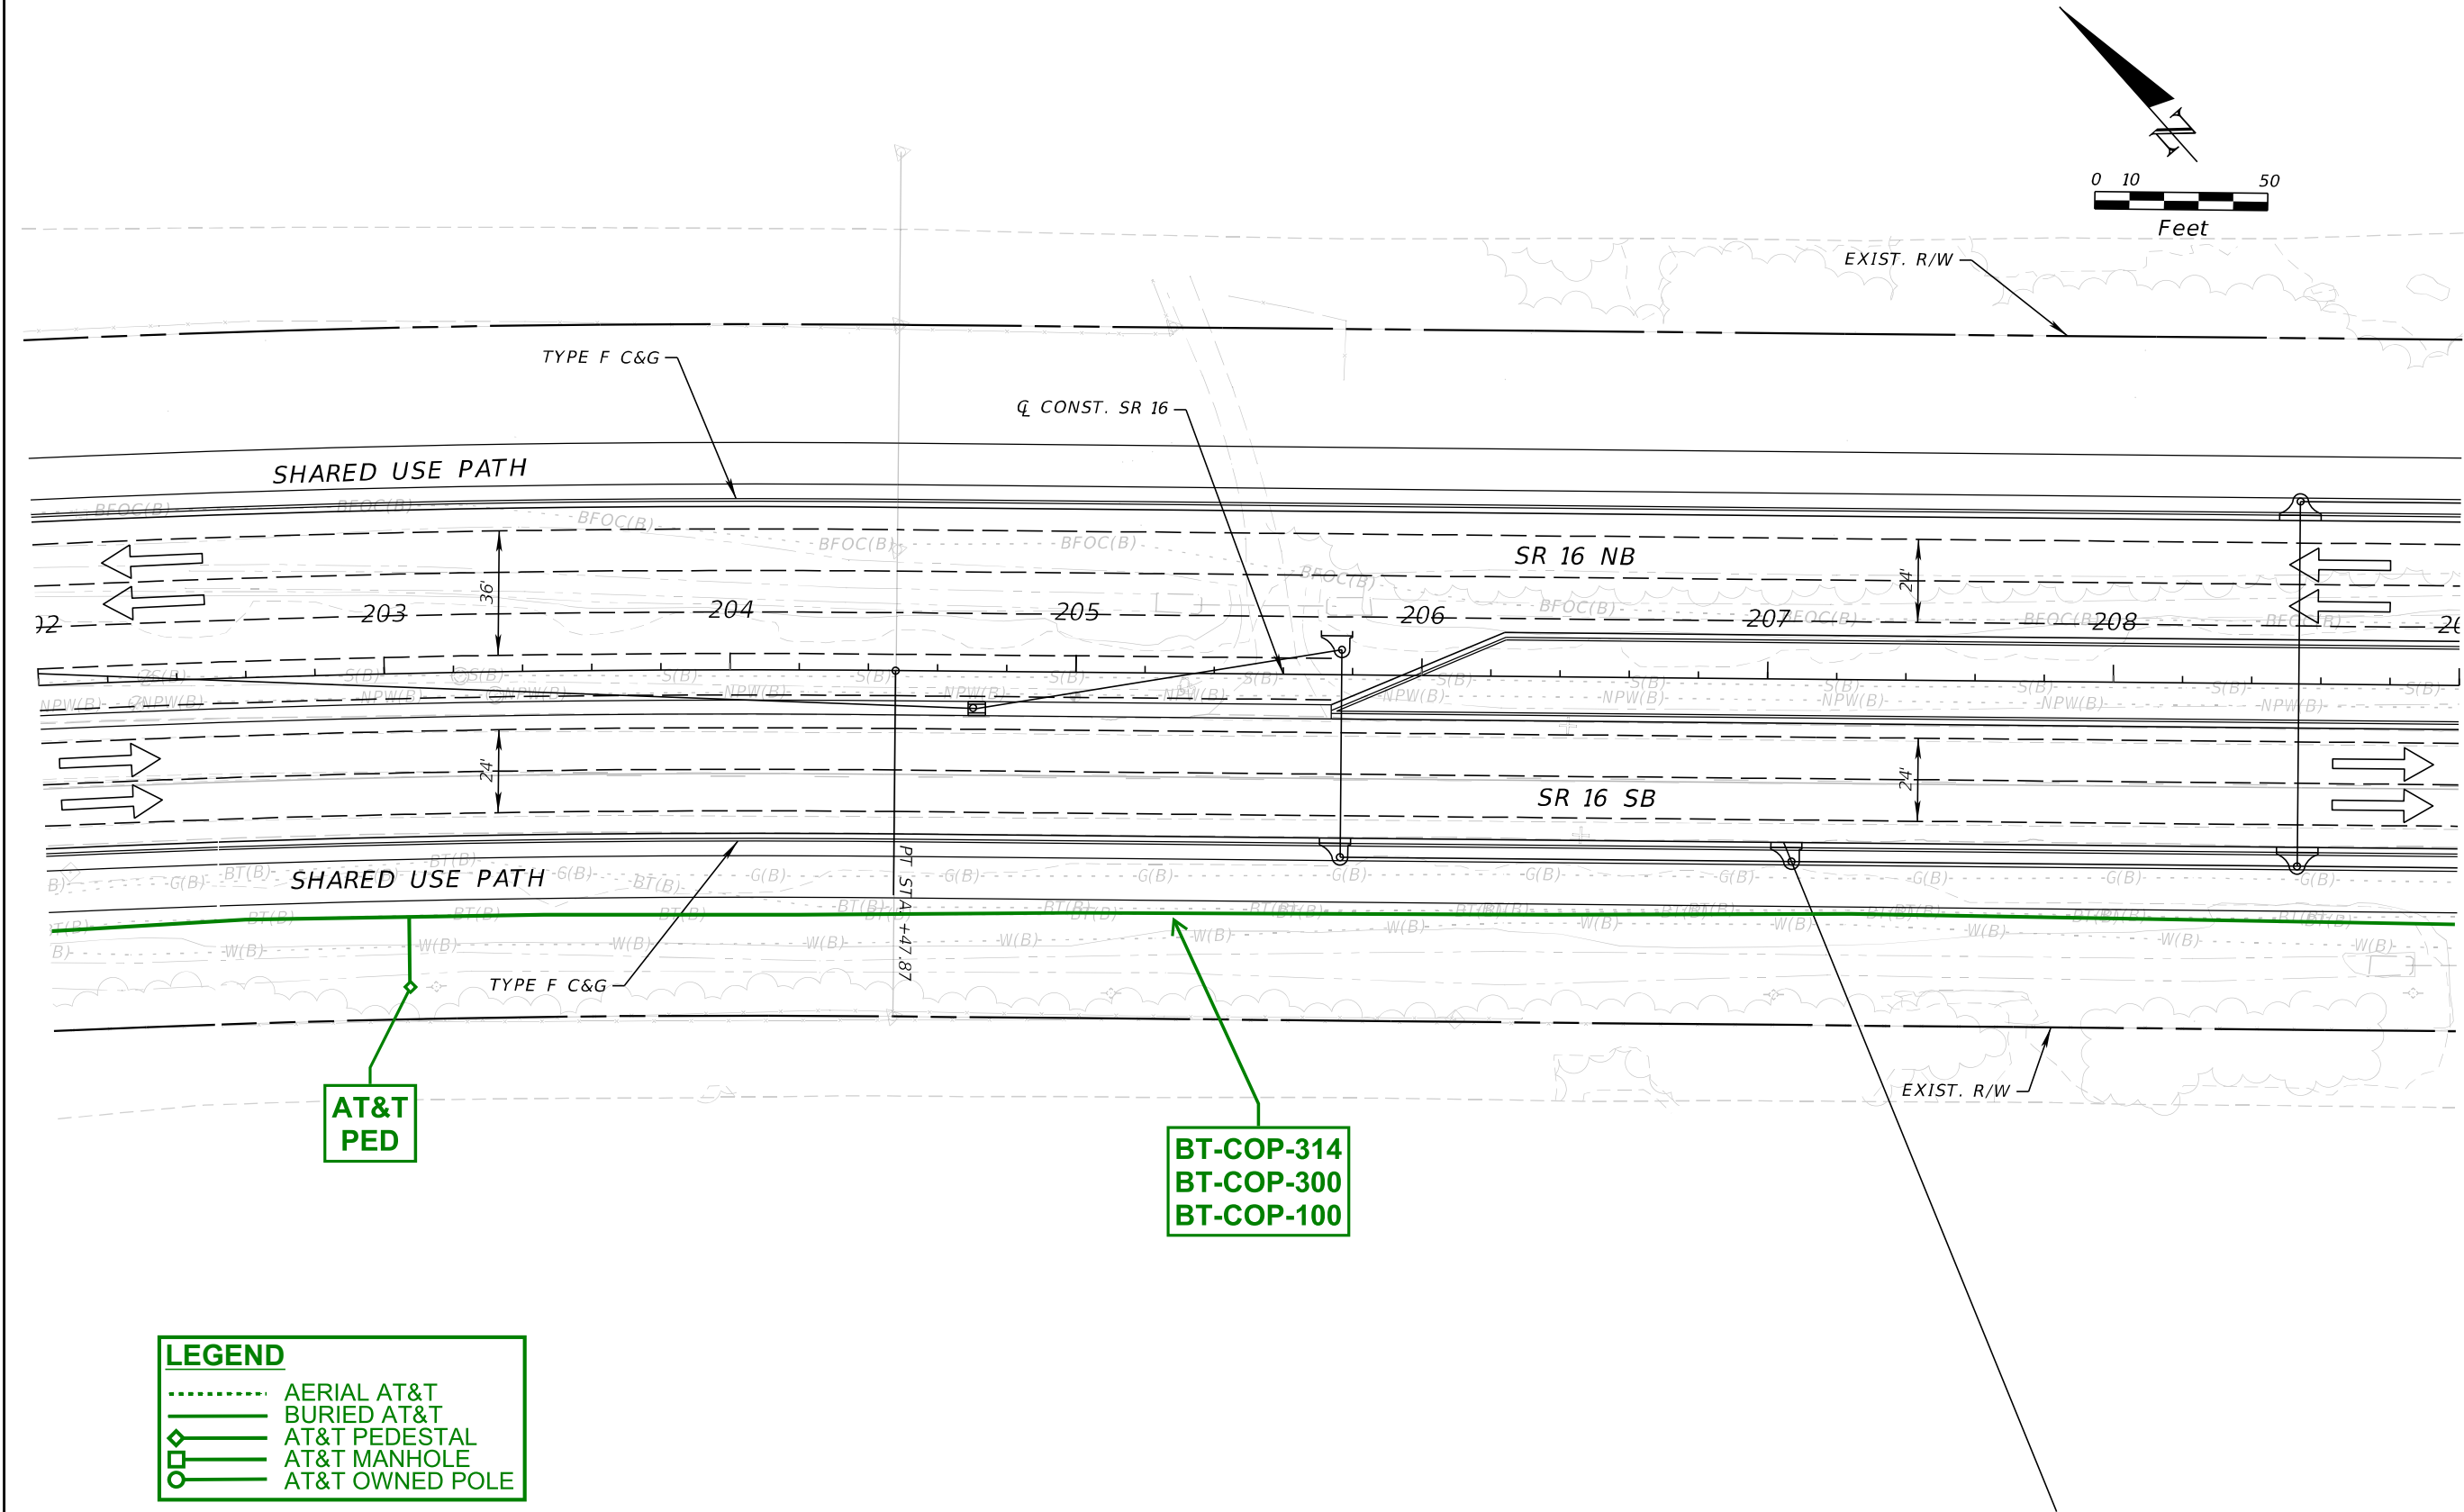



| LEGEND |                 |
|--------|-----------------|
| .....  | AERIAL AT&T     |
| ————   | BURIED AT&T     |
| ◇      | AT&T PEDESTAL   |
| □      | AT&T MANHOLE    |
| ○      | AT&T OWNED POLE |

| REVISIONS                                                                                                                 |             | ENGINEER OF RECORD |             | STATE OF FLORIDA<br>DEPARTMENT OF TRANSPORTATION |           |                      | SHEET<br>NO.          |
|---------------------------------------------------------------------------------------------------------------------------|-------------|--------------------|-------------|--------------------------------------------------|-----------|----------------------|-----------------------|
| DATE                                                                                                                      | DESCRIPTION | DATE               | DESCRIPTION | ROAD NO.                                         | COUNTY    | FINANCIAL PROJECT ID |                       |
|                                                                                                                           |             |                    |             | SR 16                                            | ST. JOHNS | 210447-5-52-01       | 11x17<br>Plan<br>Only |
| STEPHEN J. PARK, P.E.<br>LICENSE NUMBER: 77656<br>RS&H, INC.<br>10748 DEERWOOD PARK BLVD. SOUTH<br>JACKSONVILLE, FL 32256 |             |                    |             |                                                  |           |                      |                       |

THE OFFICIAL RECORD OF THIS SHEET IS THE ELECTRONIC FILE DIGITALLY SIGNED AND SEALED UNDER RULE 61G15-23.004, F.A.C.



8/5/2024 4:28:48 PM BeattyM  
c:\pw\_work\ysh\_pw\pw\_user\0439575\PLANRD01.dgn

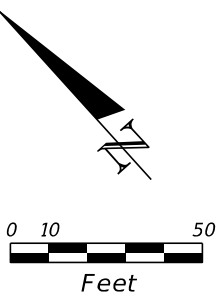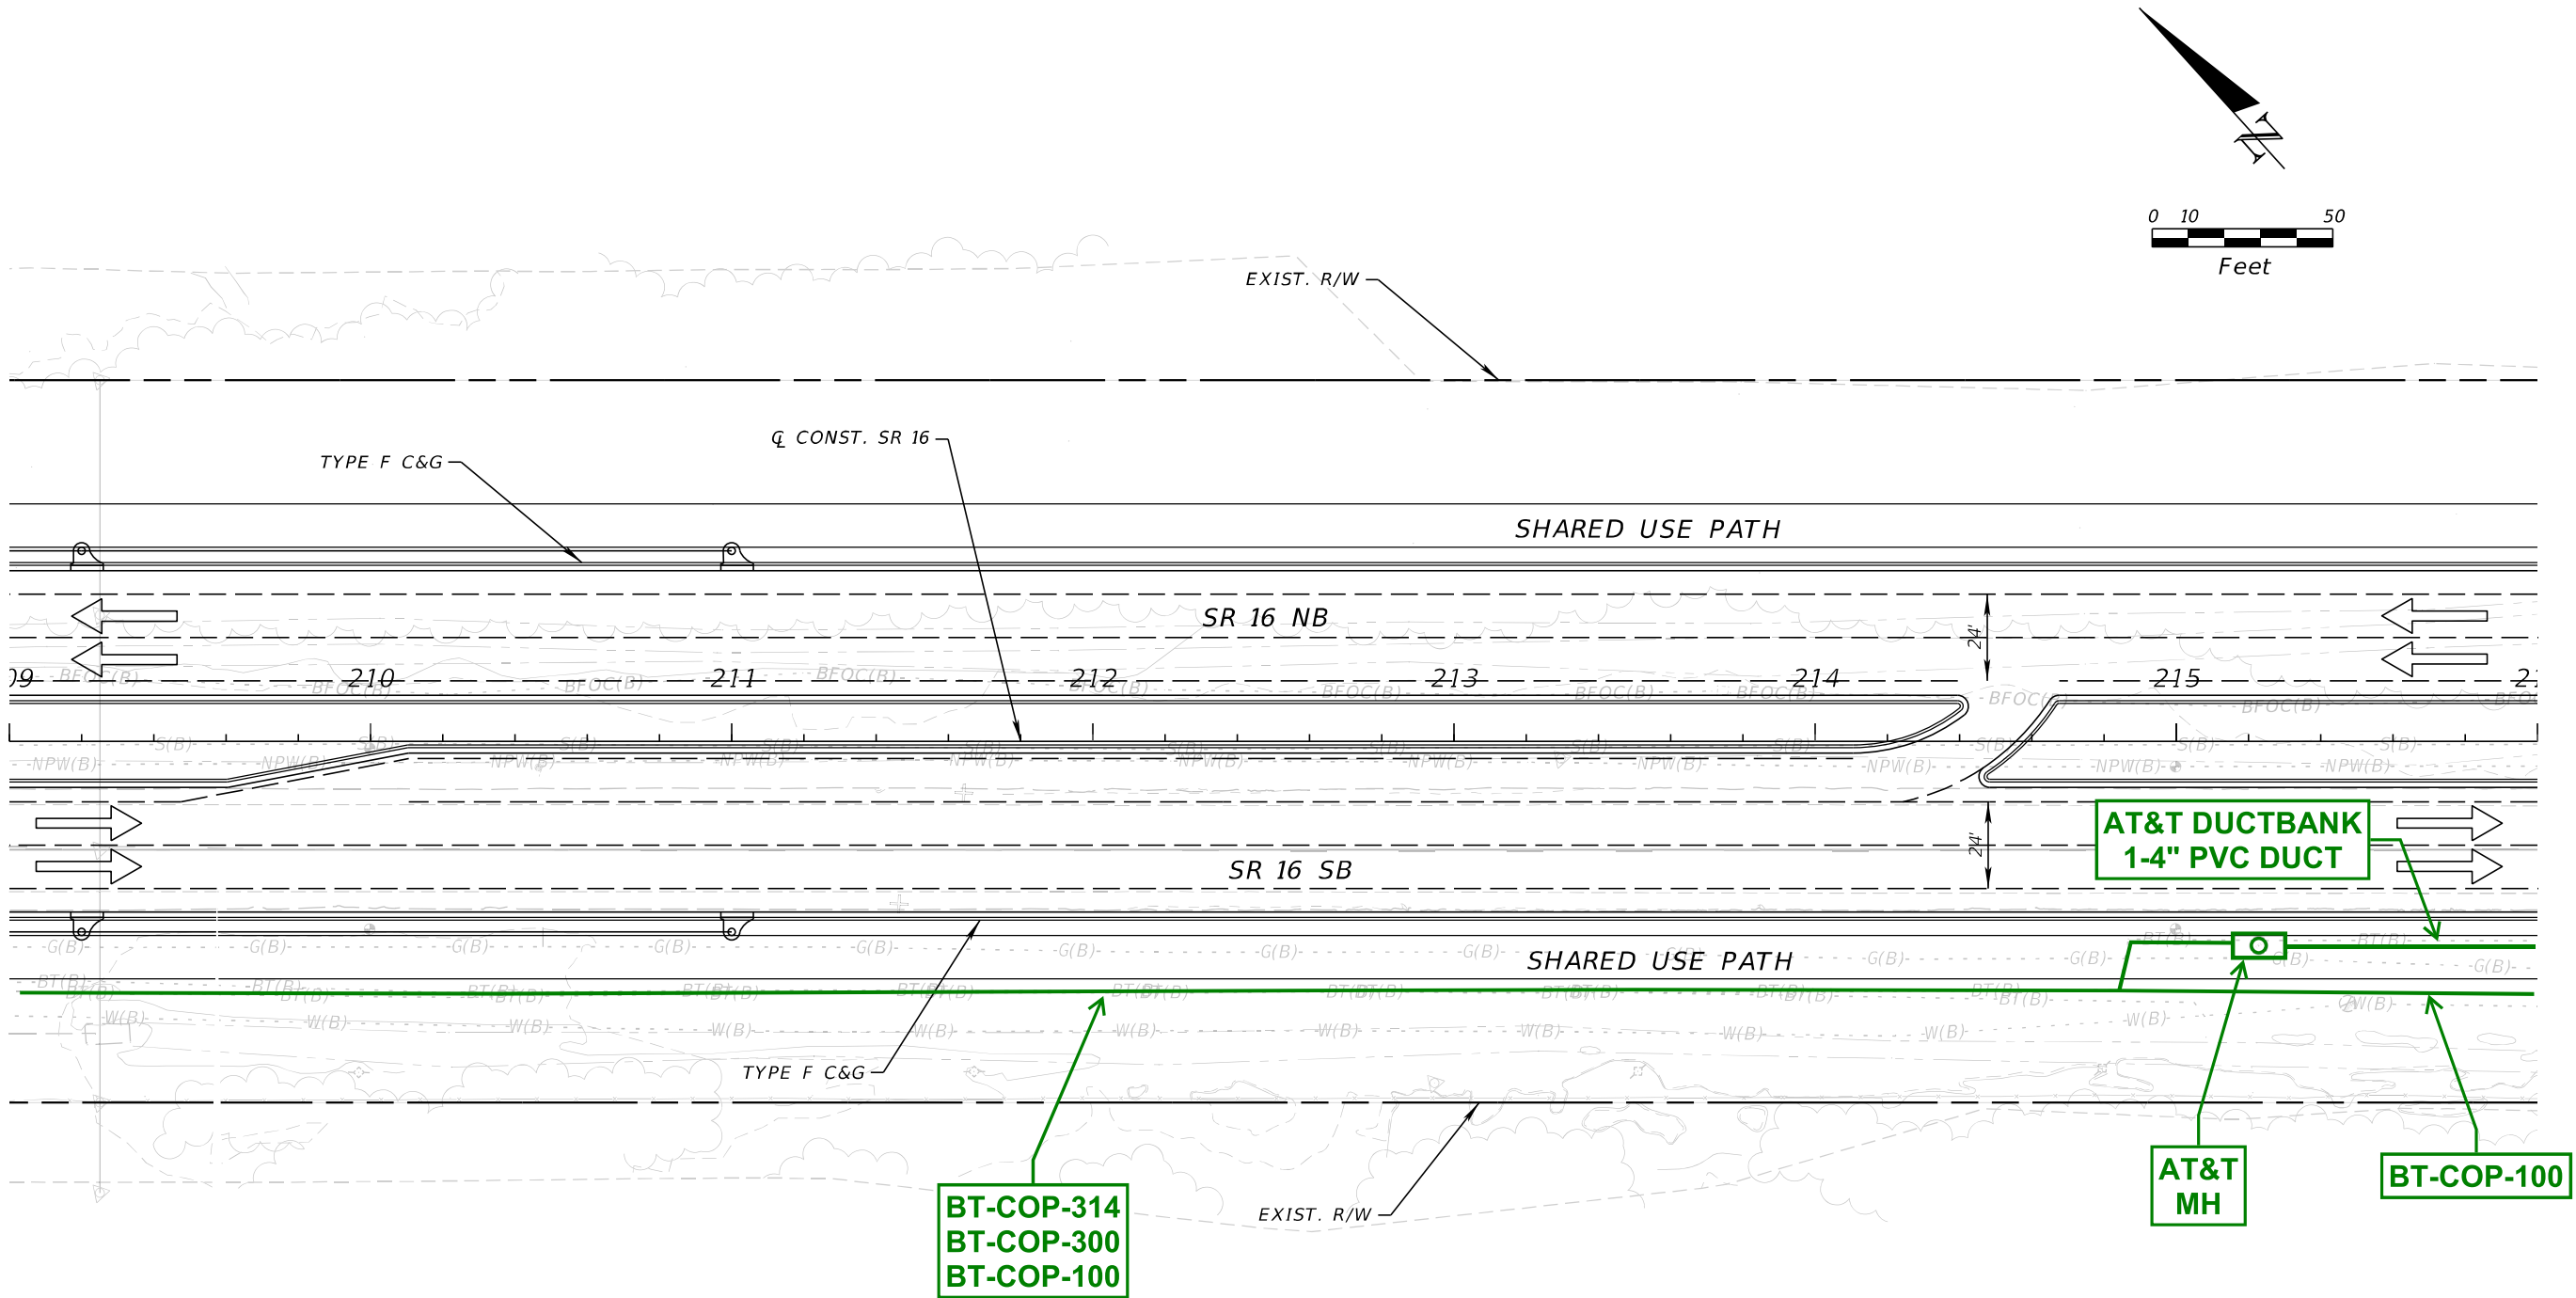


| LEGEND |                 |  |  |  |
|--------|-----------------|--|--|--|
| .....  | AERIAL AT&T     |  |  |  |
| ————   | BURIED AT&T     |  |  |  |
| ◆      | AT&T PEDESTAL   |  |  |  |
| □      | AT&T MANHOLE    |  |  |  |
| ○      | AT&T OWNED POLE |  |  |  |

| REVISIONS                                                                                                                 |             | ENGINEER OF RECORD |             | STATE OF FLORIDA<br>DEPARTMENT OF TRANSPORTATION |           |                      | SHEET<br>NO.          |
|---------------------------------------------------------------------------------------------------------------------------|-------------|--------------------|-------------|--------------------------------------------------|-----------|----------------------|-----------------------|
| DATE                                                                                                                      | DESCRIPTION | DATE               | DESCRIPTION | ROAD NO.                                         | COUNTY    | FINANCIAL PROJECT ID |                       |
|                                                                                                                           |             |                    |             | SR 16                                            | ST. JOHNS | 210447-5-52-01       |                       |
| STEPHEN J. PARK, P.E.<br>LICENSE NUMBER: 77656<br>RS&H, INC.<br>10748 DEERWOOD PARK BLVD. SOUTH<br>JACKSONVILLE, FL 32256 |             |                    |             |                                                  |           |                      | 11x17<br>Plan<br>Only |

THE OFFICIAL RECORD OF THIS SHEET IS THE ELECTRONIC FILE DIGITALLY SIGNED AND SEALED UNDER RULE 61G15-23.004, F.A.C.



8/5/2024 4:28:49 PM BeattyM  
c:\pw\_work\ysh\_pw\pw\_user\00439575\PLANRD01.dgn

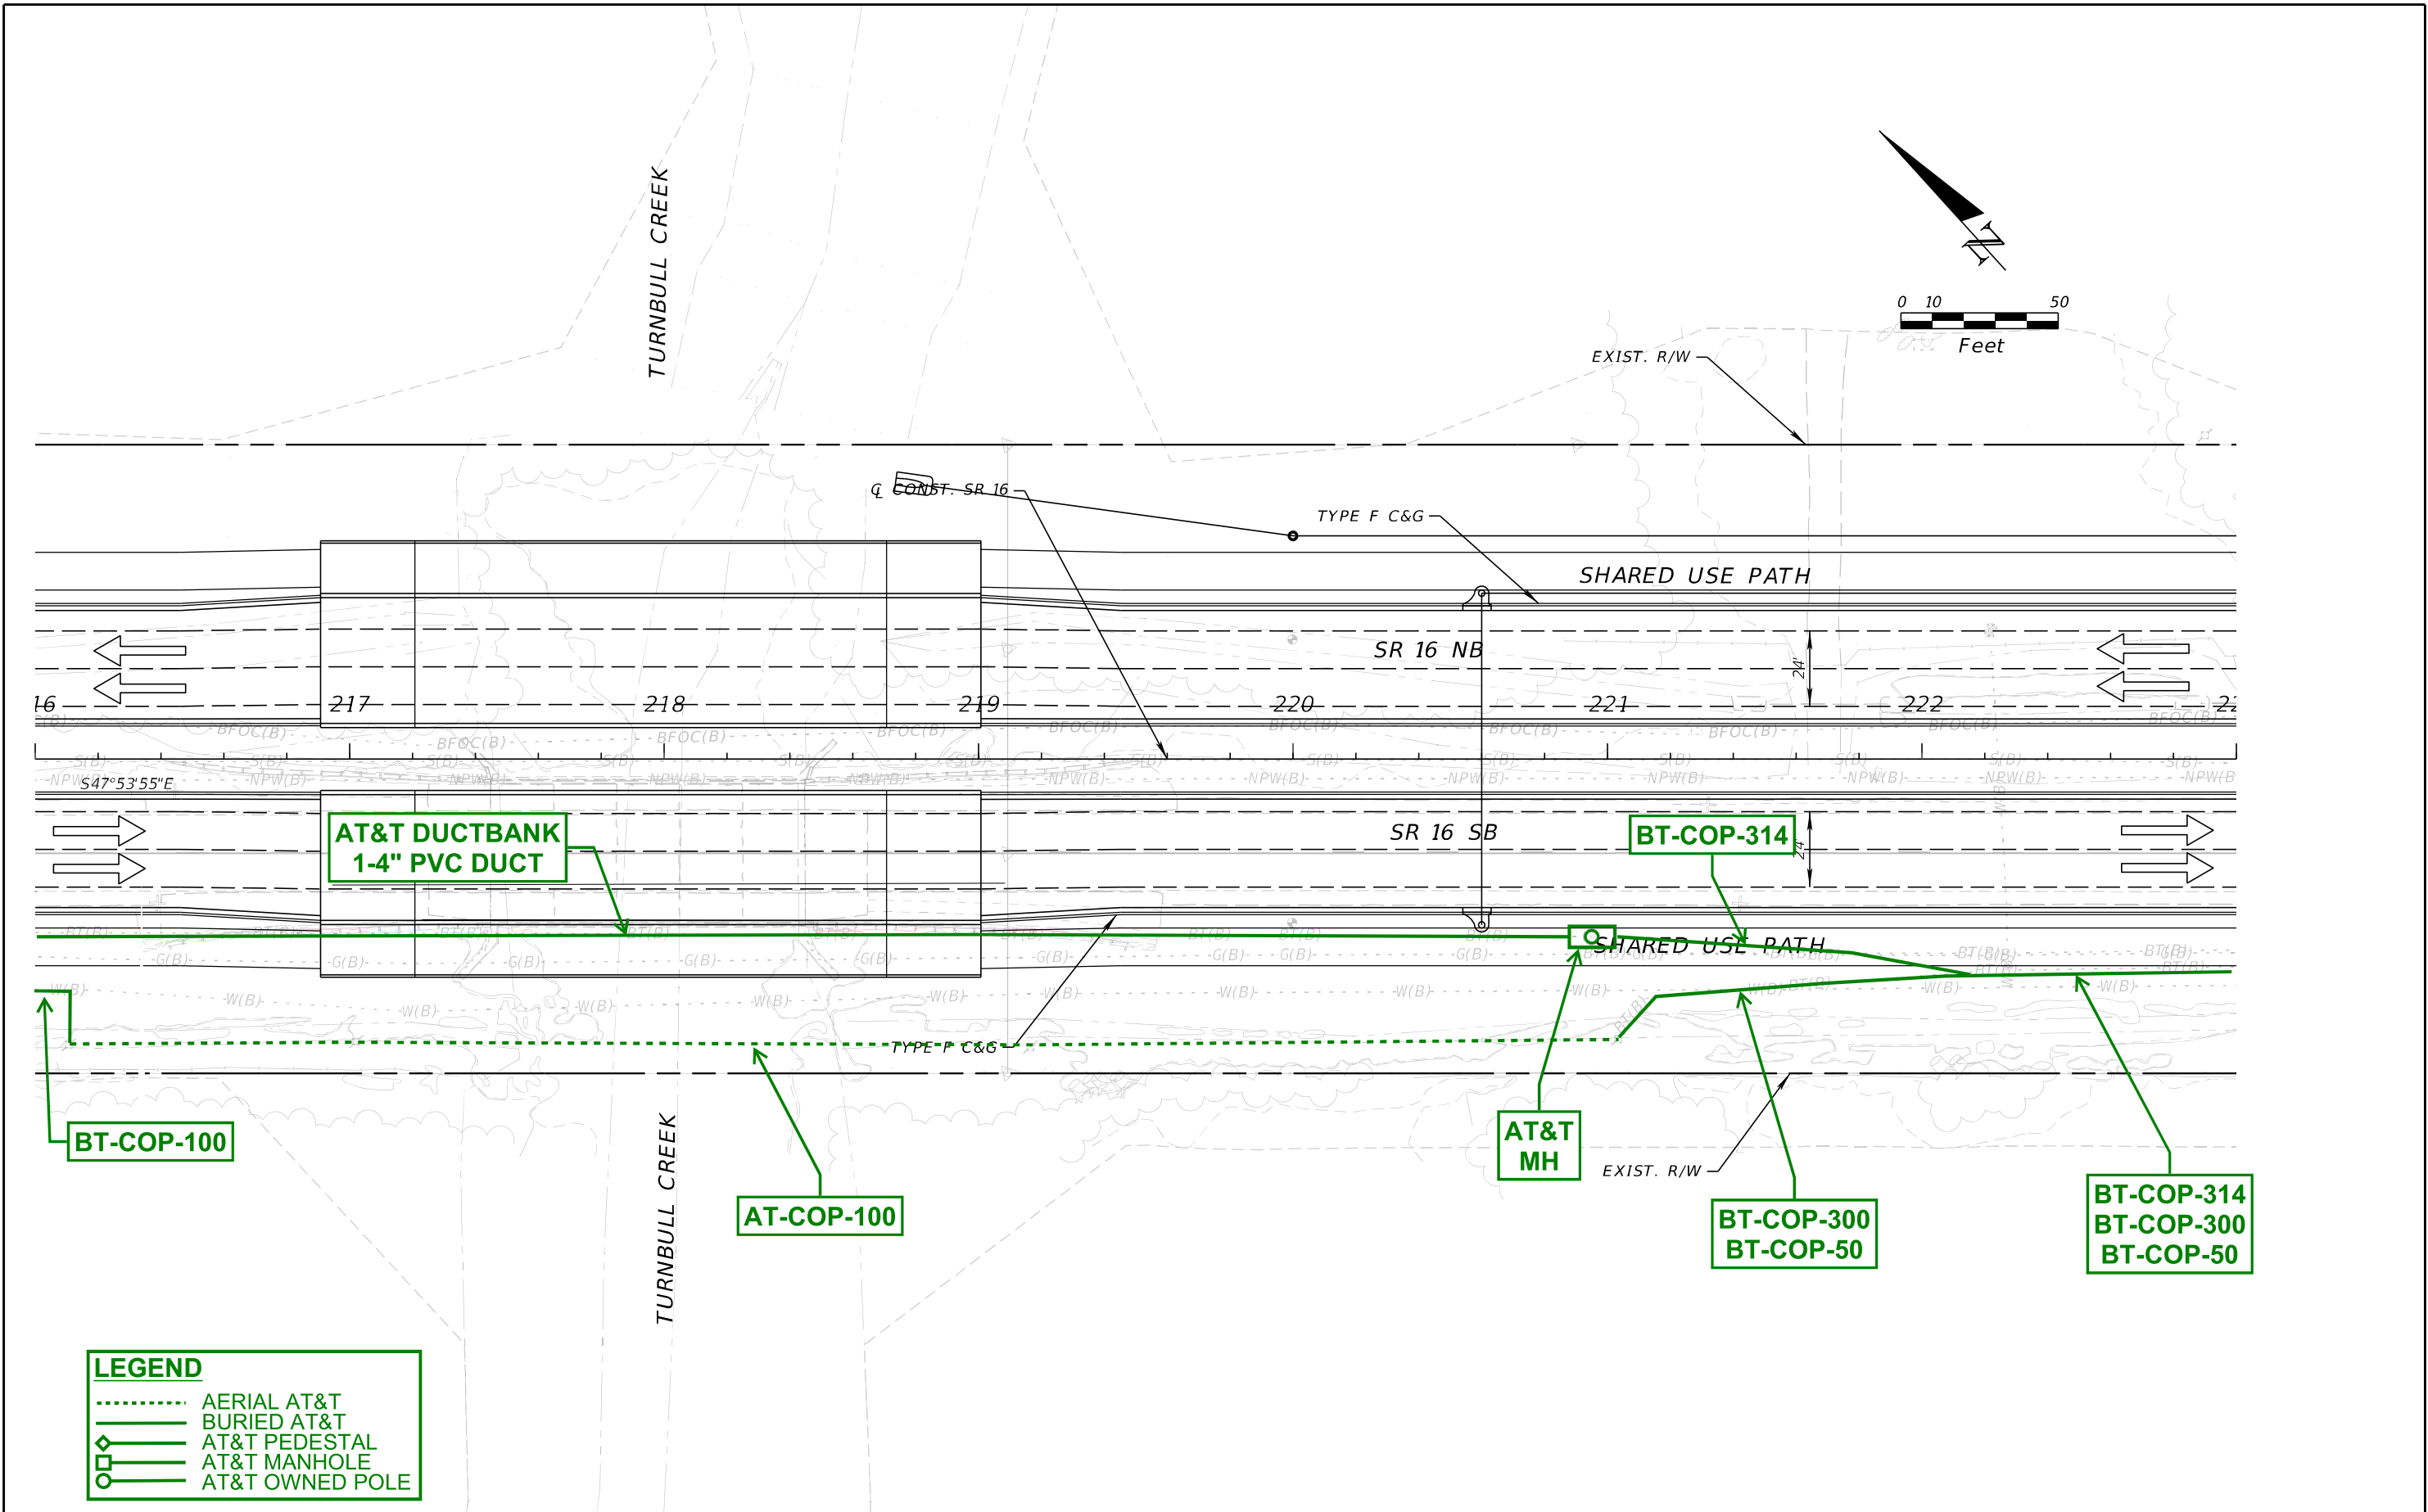

| REVISIONS |             | ENGINEER OF RECORD |                                                                                                                           | STATE OF FLORIDA<br>DEPARTMENT OF TRANSPORTATION |           |                      | SHEET<br>NO.          |
|-----------|-------------|--------------------|---------------------------------------------------------------------------------------------------------------------------|--------------------------------------------------|-----------|----------------------|-----------------------|
| DATE      | DESCRIPTION | DATE               | DESCRIPTION                                                                                                               | ROAD NO.                                         | COUNTY    | FINANCIAL PROJECT ID |                       |
|           |             |                    | STEPHEN J. PARK, P.E.<br>LICENSE NUMBER: 77656<br>RS&H, INC.<br>10748 DEERWOOD PARK BLVD. SOUTH<br>JACKSONVILLE, FL 32256 | SR 16                                            | ST. JOHNS | 210447-5-52-01       | 11x17<br>Plan<br>Only |

THE OFFICIAL RECORD OF THIS SHEET IS THE ELECTRONIC FILE DIGITALLY SIGNED AND SEALED UNDER RULE 61G15-23.004, F.A.C.

8/5/2024 4:28:49 PM BeattyM  
c:\pw\_work\sh\_pw\pw\_user\0439575\PLANRD01.dgn

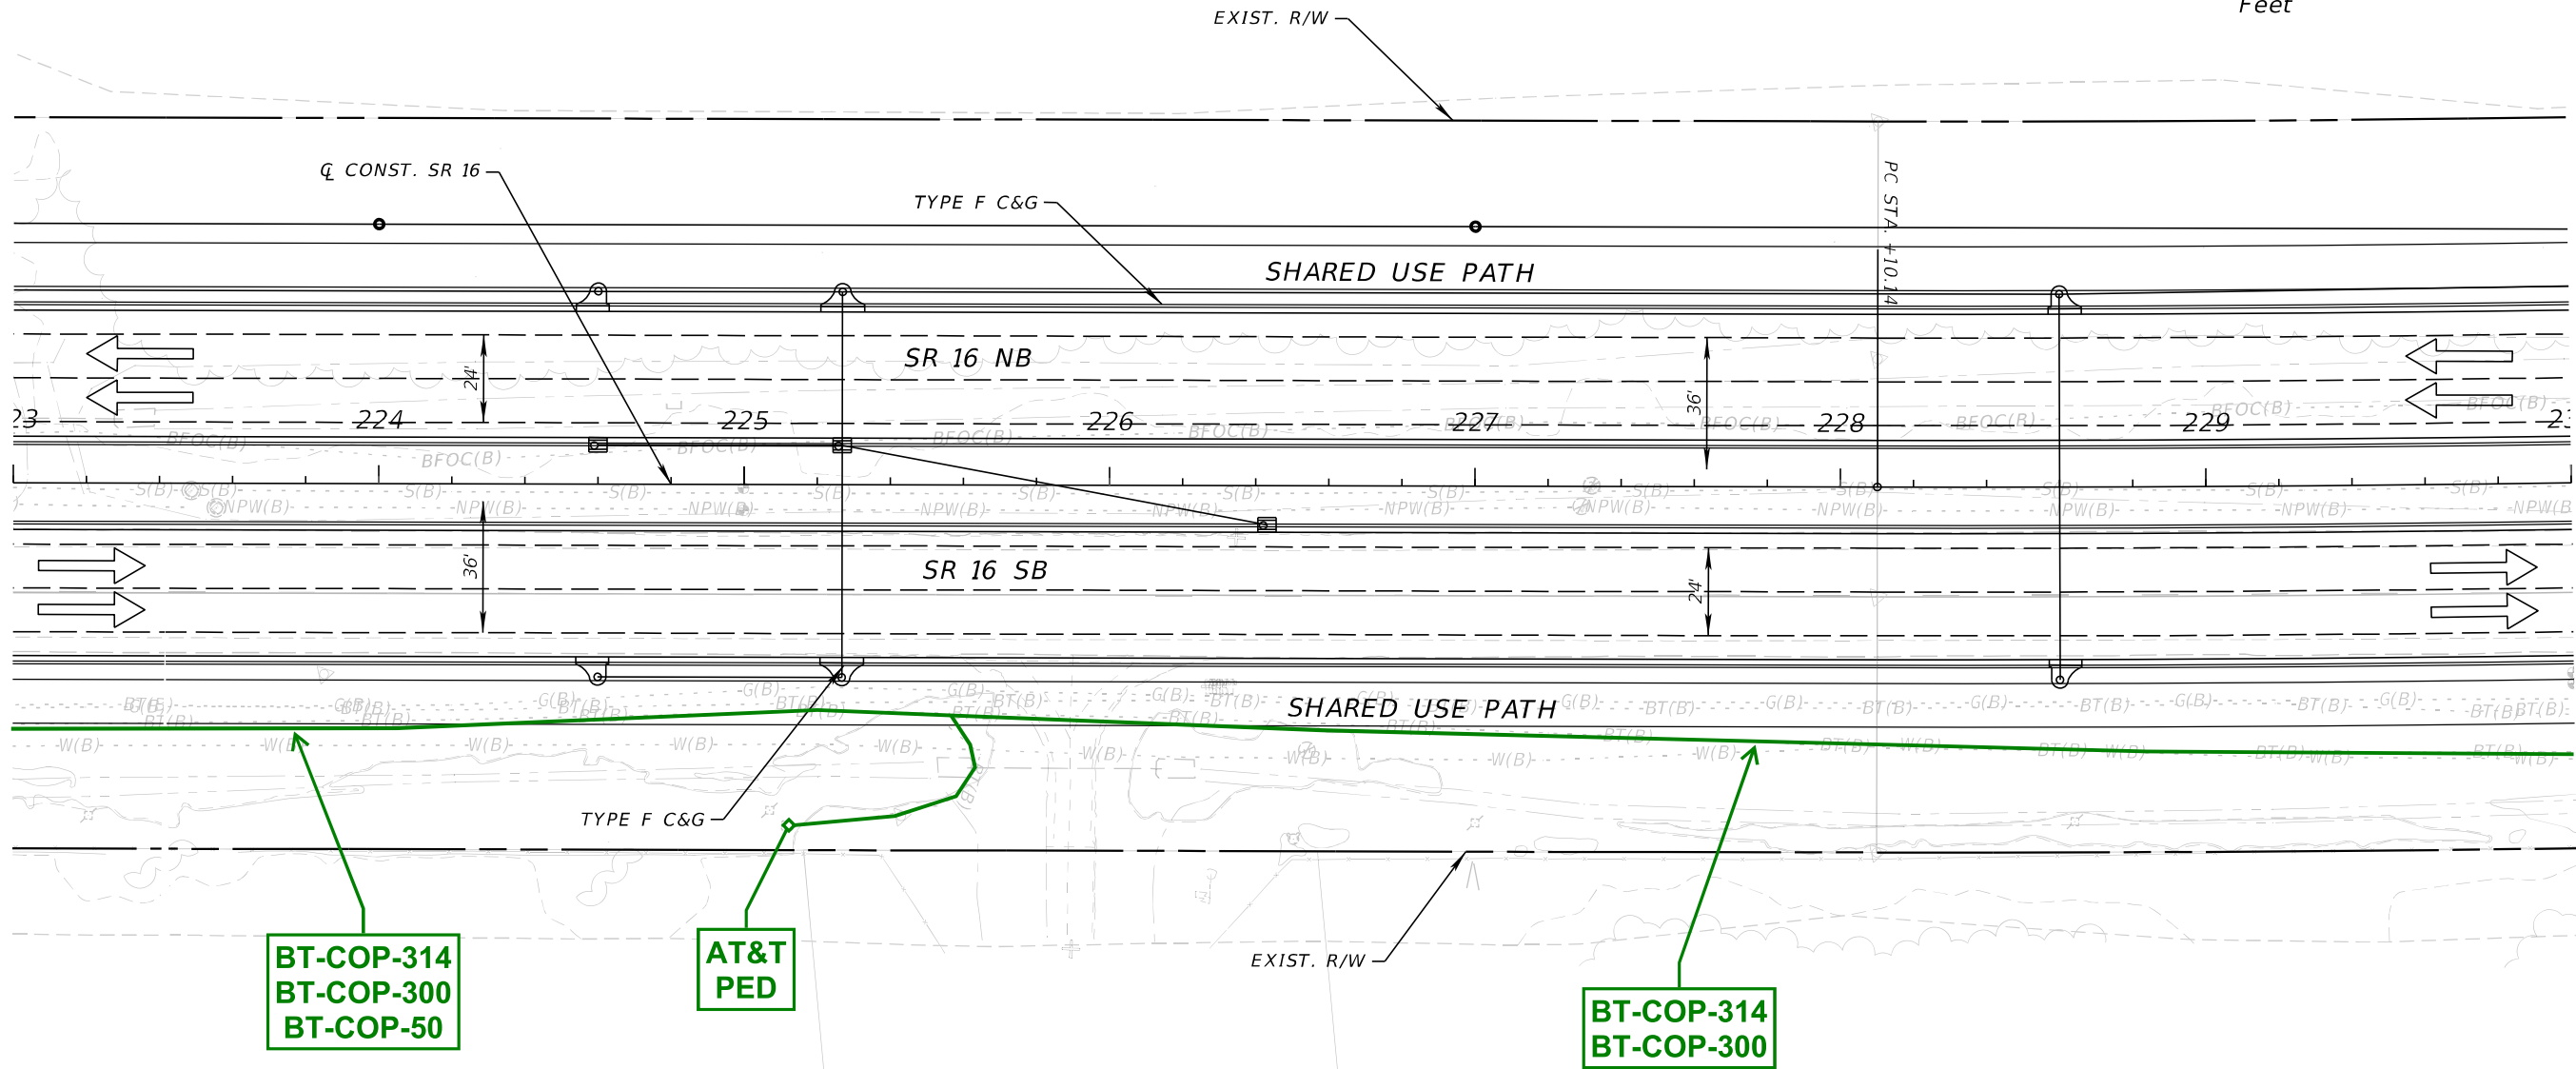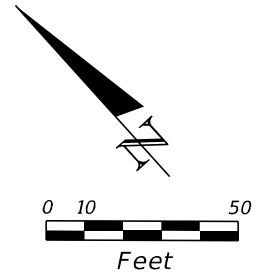


| LEGEND |                 |
|--------|-----------------|
| .....  | AERIAL AT&T     |
| ———    | BURIED AT&T     |
| ◇      | AT&T PEDESTAL   |
| □      | AT&T MANHOLE    |
| ○      | AT&T OWNED POLE |

|      |  | REVISIONS   |      | ENGINEER OF RECORD                                                                                                        | STATE OF FLORIDA<br>DEPARTMENT OF TRANSPORTATION |           |                      | ROADWAY PLAN | SHEET NO.               |
|------|--|-------------|------|---------------------------------------------------------------------------------------------------------------------------|--------------------------------------------------|-----------|----------------------|--------------|-------------------------|
| DATE |  | DESCRIPTION | DATE | DESCRIPTION                                                                                                               | ROAD NO.                                         | COUNTY    | FINANCIAL PROJECT ID |              | SR 16<br>- PLAN -<br>19 |
|      |  |             |      | STEPHEN J. PARK, P.E.<br>LICENSE NUMBER: 77656<br>RS&H, INC.<br>10748 DEERWOOD PARK BLVD. SOUTH<br>JACKSONVILLE, FL 32256 | SR 16                                            | ST. JOHNS | 210447-5-52-01       |              |                         |
|      |  |             |      |                                                                                                                           |                                                  |           |                      |              |                         |

THE OFFICIAL RECORD OF THIS SHEET IS THE ELECTRONIC FILE DIGITALLY SIGNED AND SEALED UNDER RULE 61G15-23.004, F.A.C.

8/5/2024 4:28:50 PM BeattyM  
c:\pw\_work\sh\_pw\pw\_user\0439575\PLANRD01.dgn

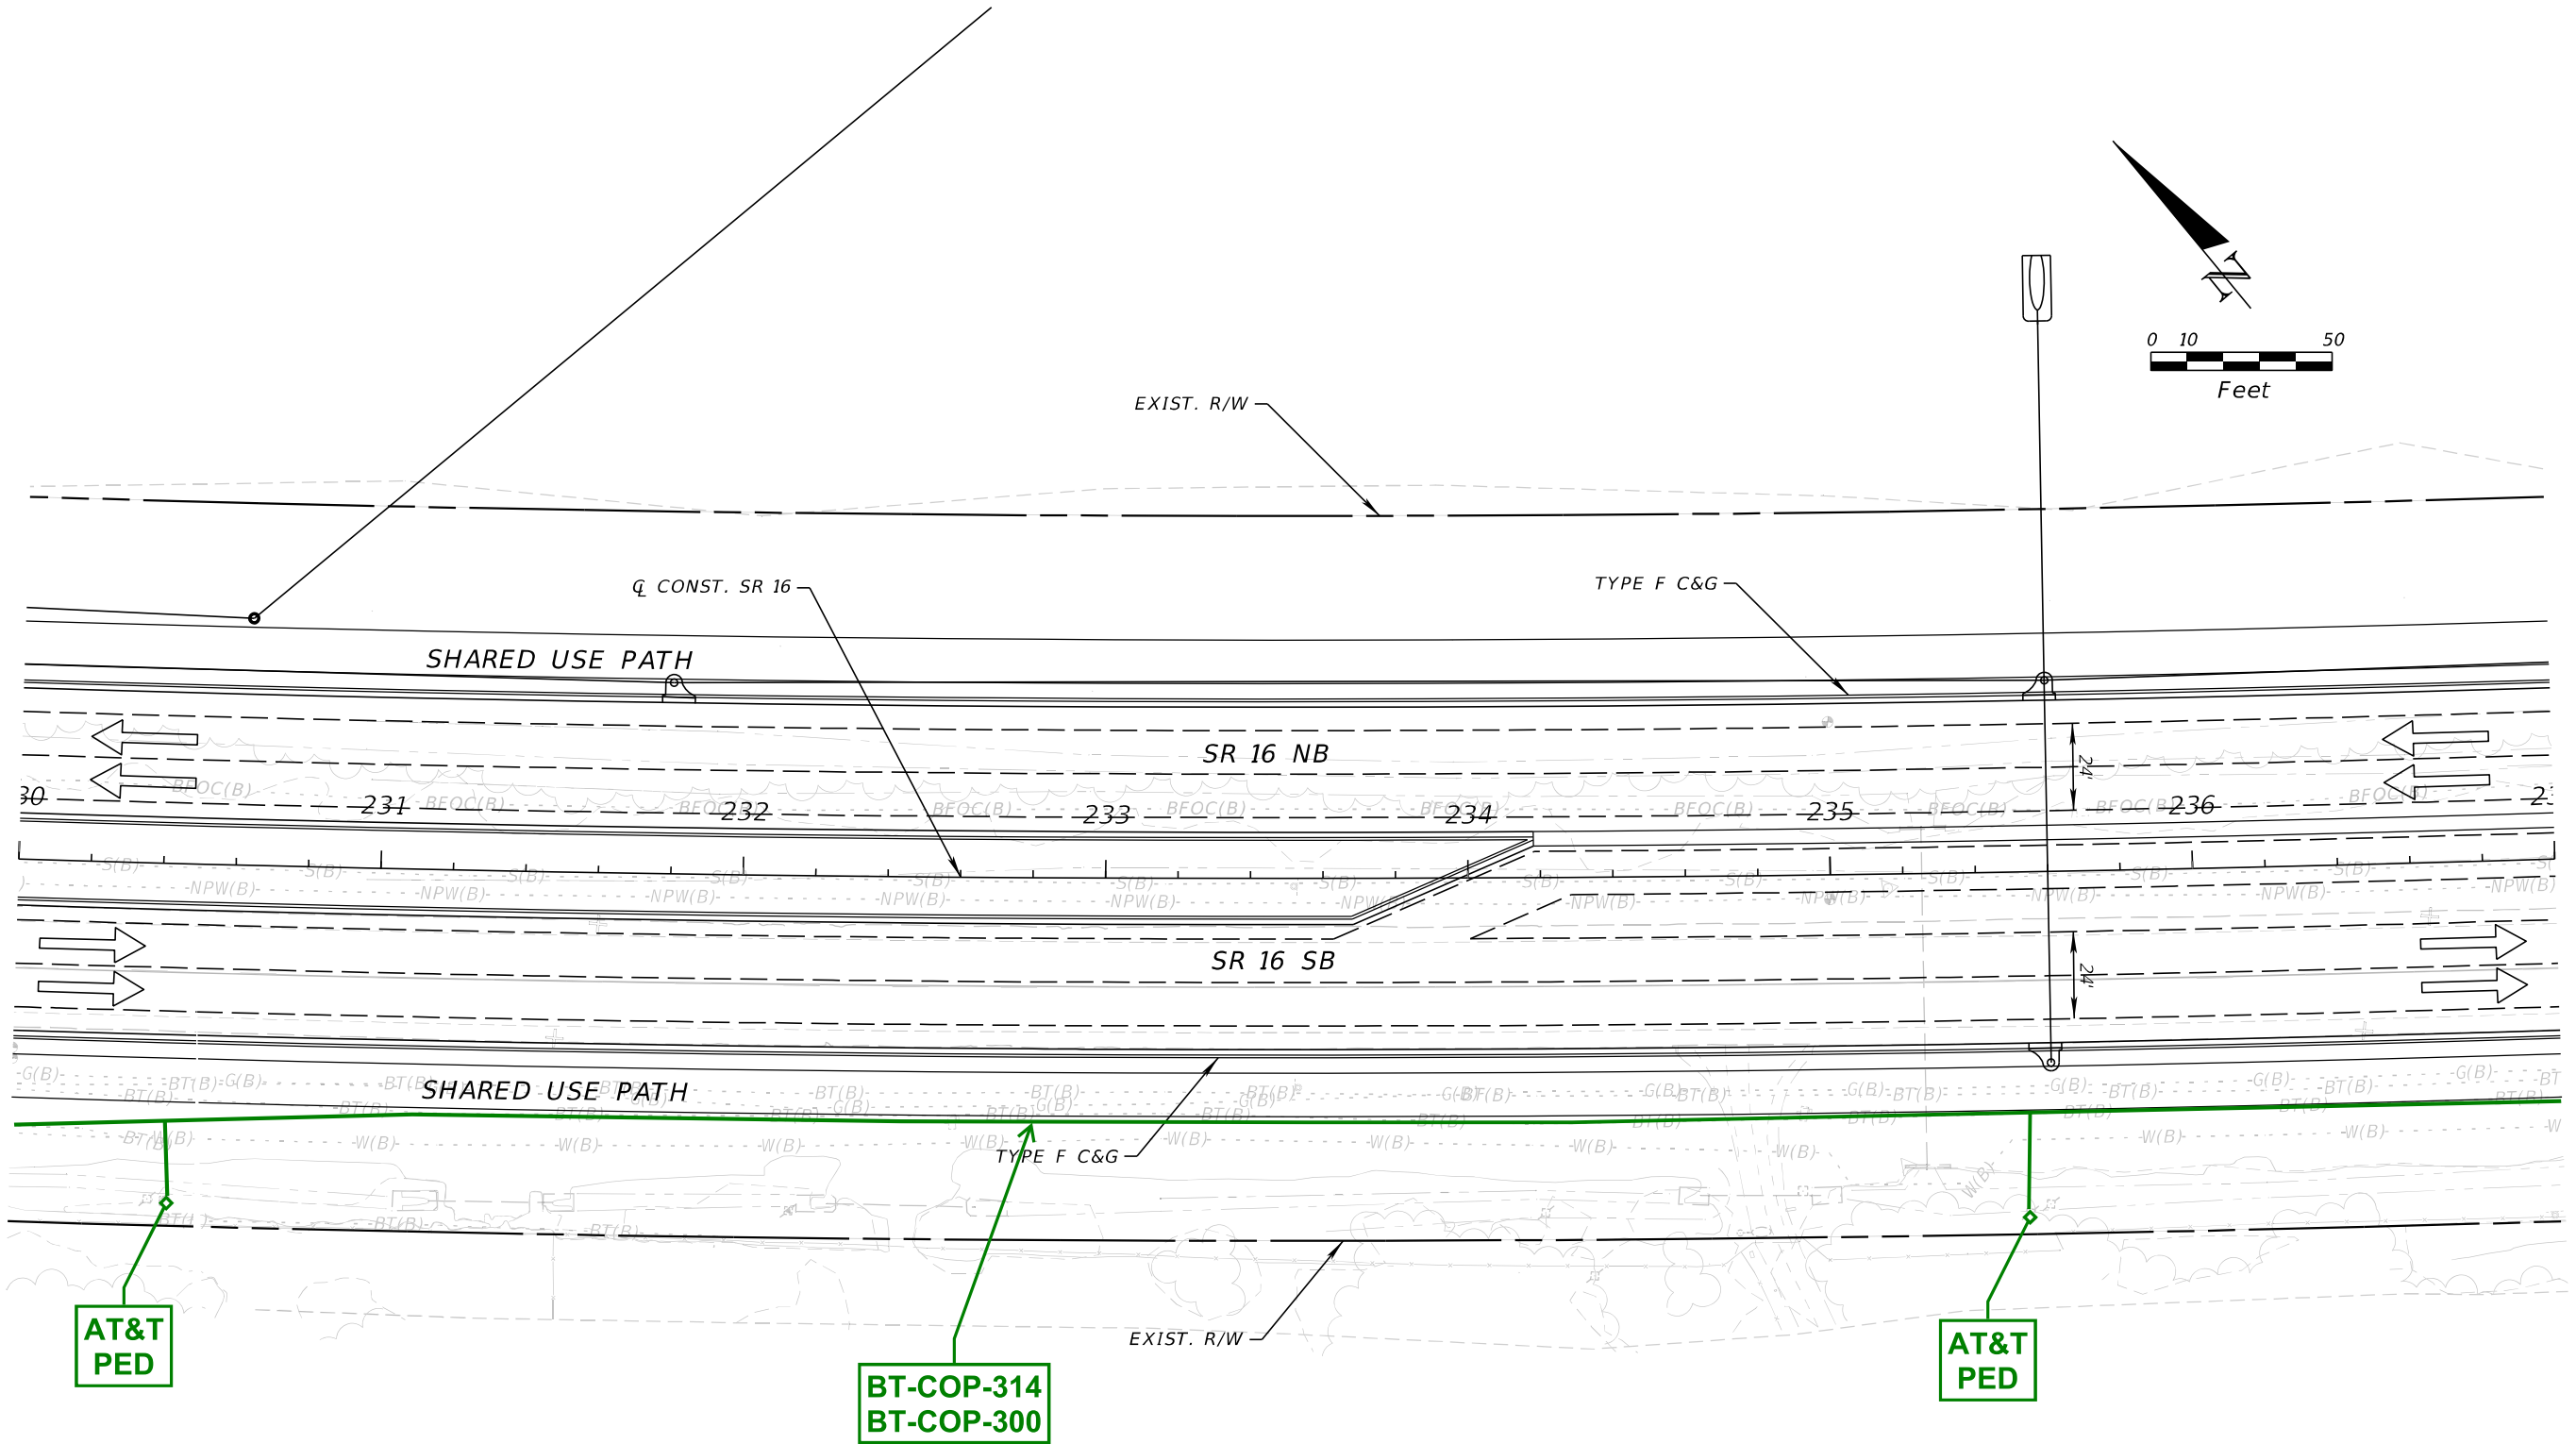



| LEGEND |                 |
|--------|-----------------|
| .....  | AERIAL AT&T     |
| ———    | BURIED AT&T     |
| ◇      | AT&T PEDESTAL   |
| □      | AT&T MANHOLE    |
| ○      | AT&T OWNED POLE |

| REVISIONS |             | ENGINEER OF RECORD |                                                                                                                           | STATE OF FLORIDA<br>DEPARTMENT OF TRANSPORTATION |           |                      | SHEET NO.             |
|-----------|-------------|--------------------|---------------------------------------------------------------------------------------------------------------------------|--------------------------------------------------|-----------|----------------------|-----------------------|
|           |             |                    |                                                                                                                           |                                                  |           |                      |                       |
| DATE      | DESCRIPTION | DATE               | DESCRIPTION                                                                                                               | ROAD NO.                                         | COUNTY    | FINANCIAL PROJECT ID | 11x17<br>Plan<br>Only |
|           |             |                    | STEPHEN J. PARK, P.E.<br>LICENSE NUMBER: 77656<br>RS&H, INC.<br>10748 DEERWOOD PARK BLVD. SOUTH<br>JACKSONVILLE, FL 32256 | SR 16                                            | ST. JOHNS | 210447-5-52-01       |                       |

THE OFFICIAL RECORD OF THIS SHEET IS THE ELECTRONIC FILE DIGITALLY SIGNED AND SEALED UNDER RULE 61G15-23.004, F.A.C.

8/5/2024 4:28:51 PM BeattyM  
c:\pw\_work\sh\_pw\pw\_user\0439575\PLANRD01.dgn

CURVE DATA  
PI STA. = 239+02.25  
 $\Delta$  = 10°55'00" (LT)  
D = 00°30'05"  
T = 1,092.10  
L = 2,177.60  
R = 2,177.60  
PC STA. = 228+10.14  
PT STA. = 249+87.74  
e = 0.000

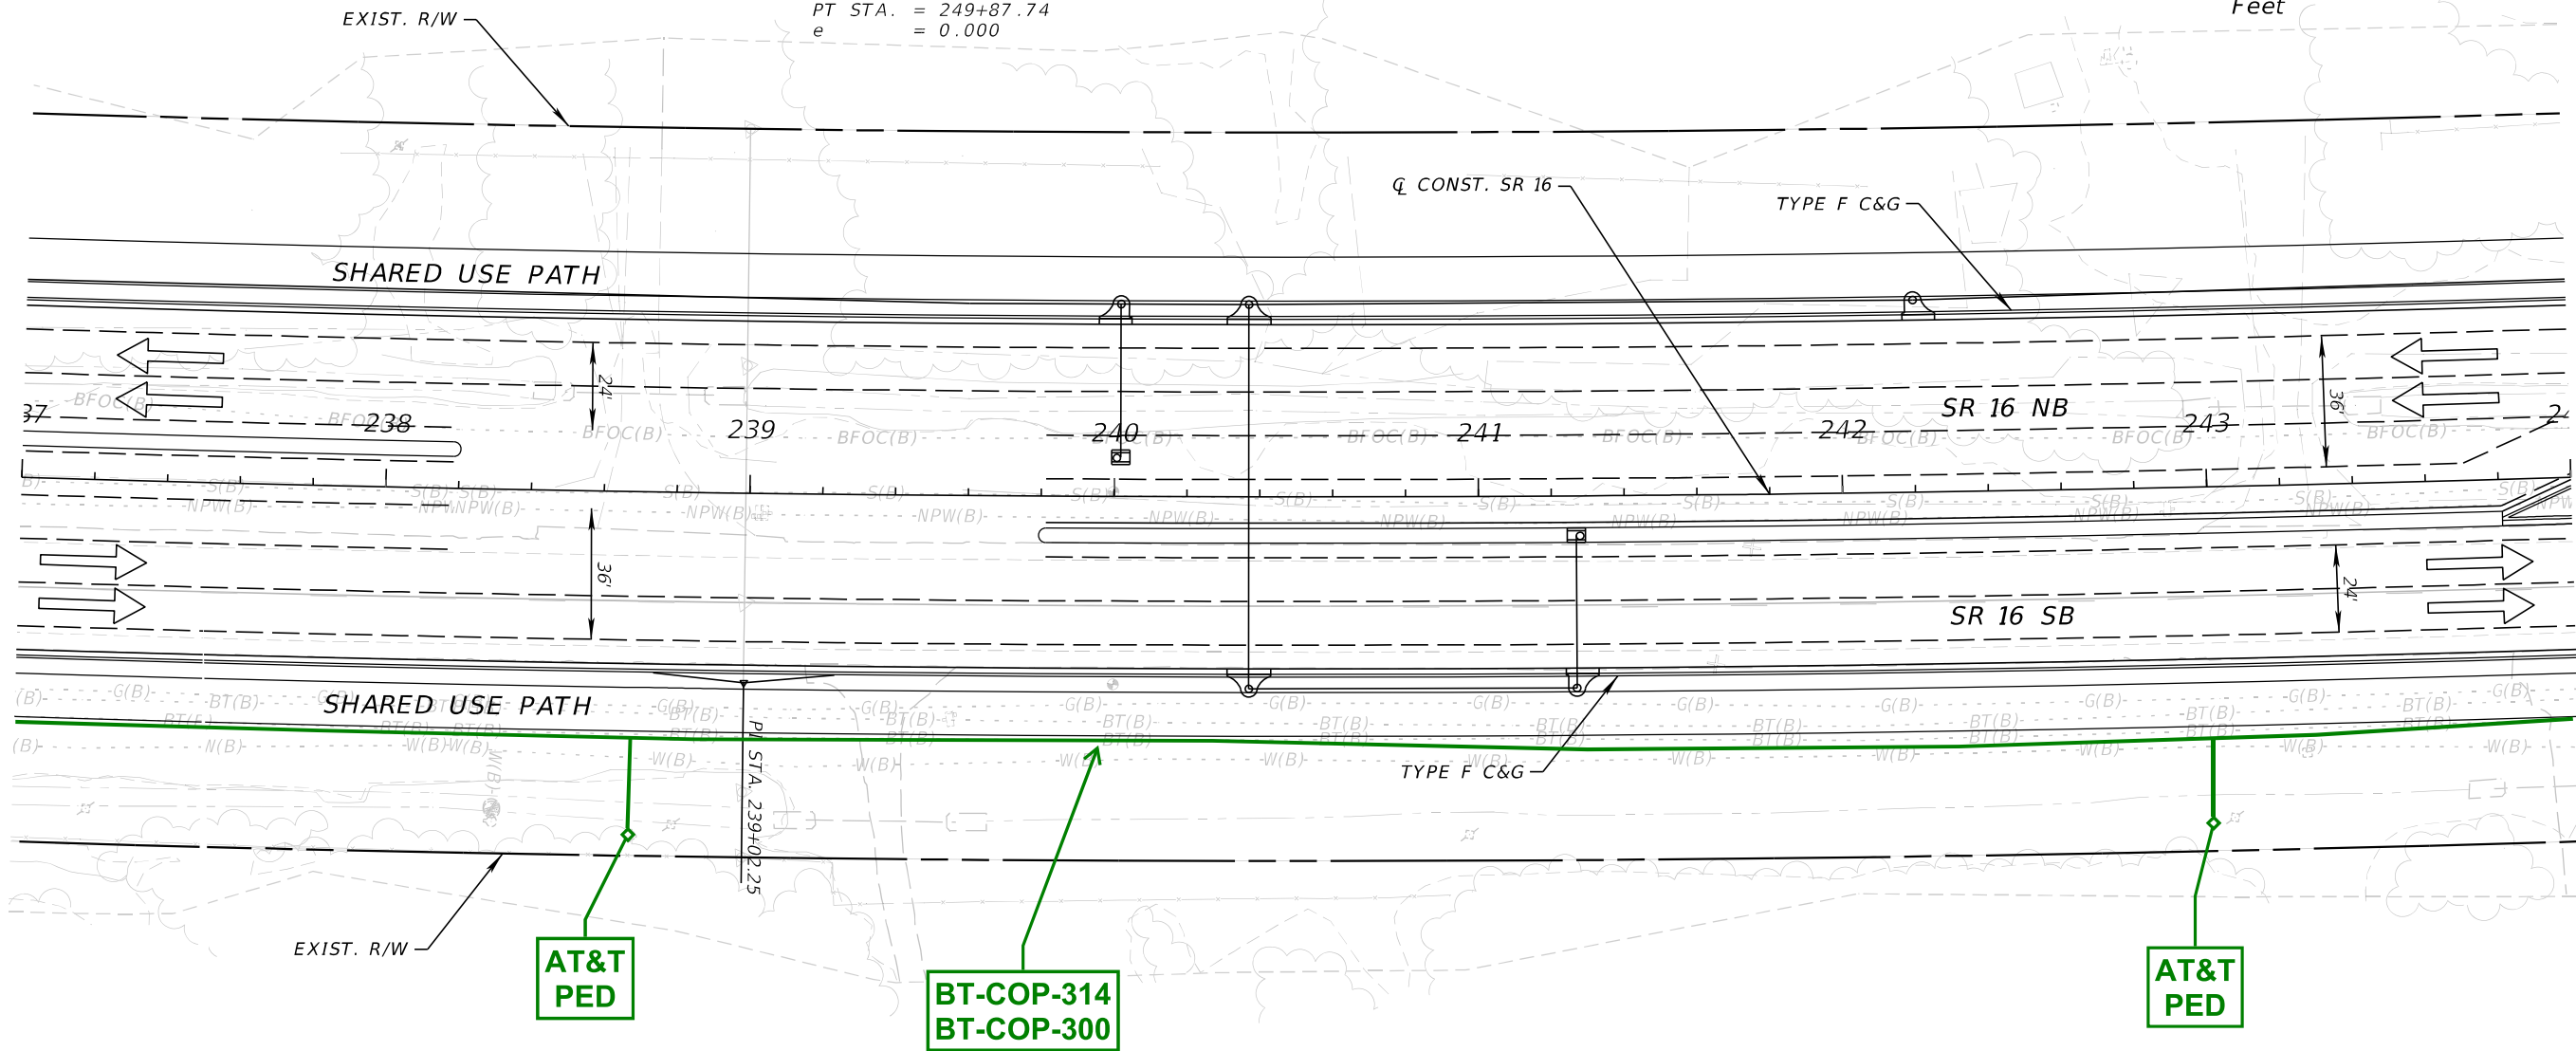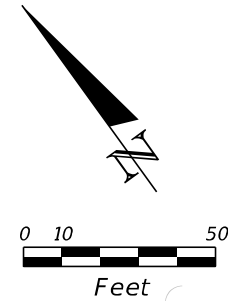


| LEGEND |                 |
|--------|-----------------|
| .....  | AERIAL AT&T     |
| ———    | BURIED AT&T     |
| ◇      | AT&T PEDESTAL   |
| □      | AT&T MANHOLE    |
| ○      | AT&T OWNED POLE |

|      |  | REVISIONS   |      |             |                                                                                                                           | ENGINEER OF RECORD | STATE OF FLORIDA<br>DEPARTMENT OF TRANSPORTATION |                      |                       |  | SHEET<br>NO. |
|------|--|-------------|------|-------------|---------------------------------------------------------------------------------------------------------------------------|--------------------|--------------------------------------------------|----------------------|-----------------------|--|--------------|
| DATE |  | DESCRIPTION | DATE | DESCRIPTION | STEPHEN J. PARK, P.E.<br>LICENSE NUMBER: 77656<br>RS&H, INC.<br>10748 DEERWOOD PARK BLVD. SOUTH<br>JACKSONVILLE, FL 32256 | ROAD NO.           | COUNTY                                           | FINANCIAL PROJECT ID | 11x17<br>Plan<br>Only |  |              |
|      |  |             |      |             |                                                                                                                           | SR 16              | ST. JOHNS                                        | 210447-5-52-01       |                       |  |              |

THE OFFICIAL RECORD OF THIS SHEET IS THE ELECTRONIC FILE DIGITALLY SIGNED AND SEALED UNDER RULE 61G15-23.004, F.A.C.



8/5/2024 4:28:51 PM BeattyM  
c:\pw\_work\ysh\_pw\pw\_user\0439575\PLANRD01.dgn

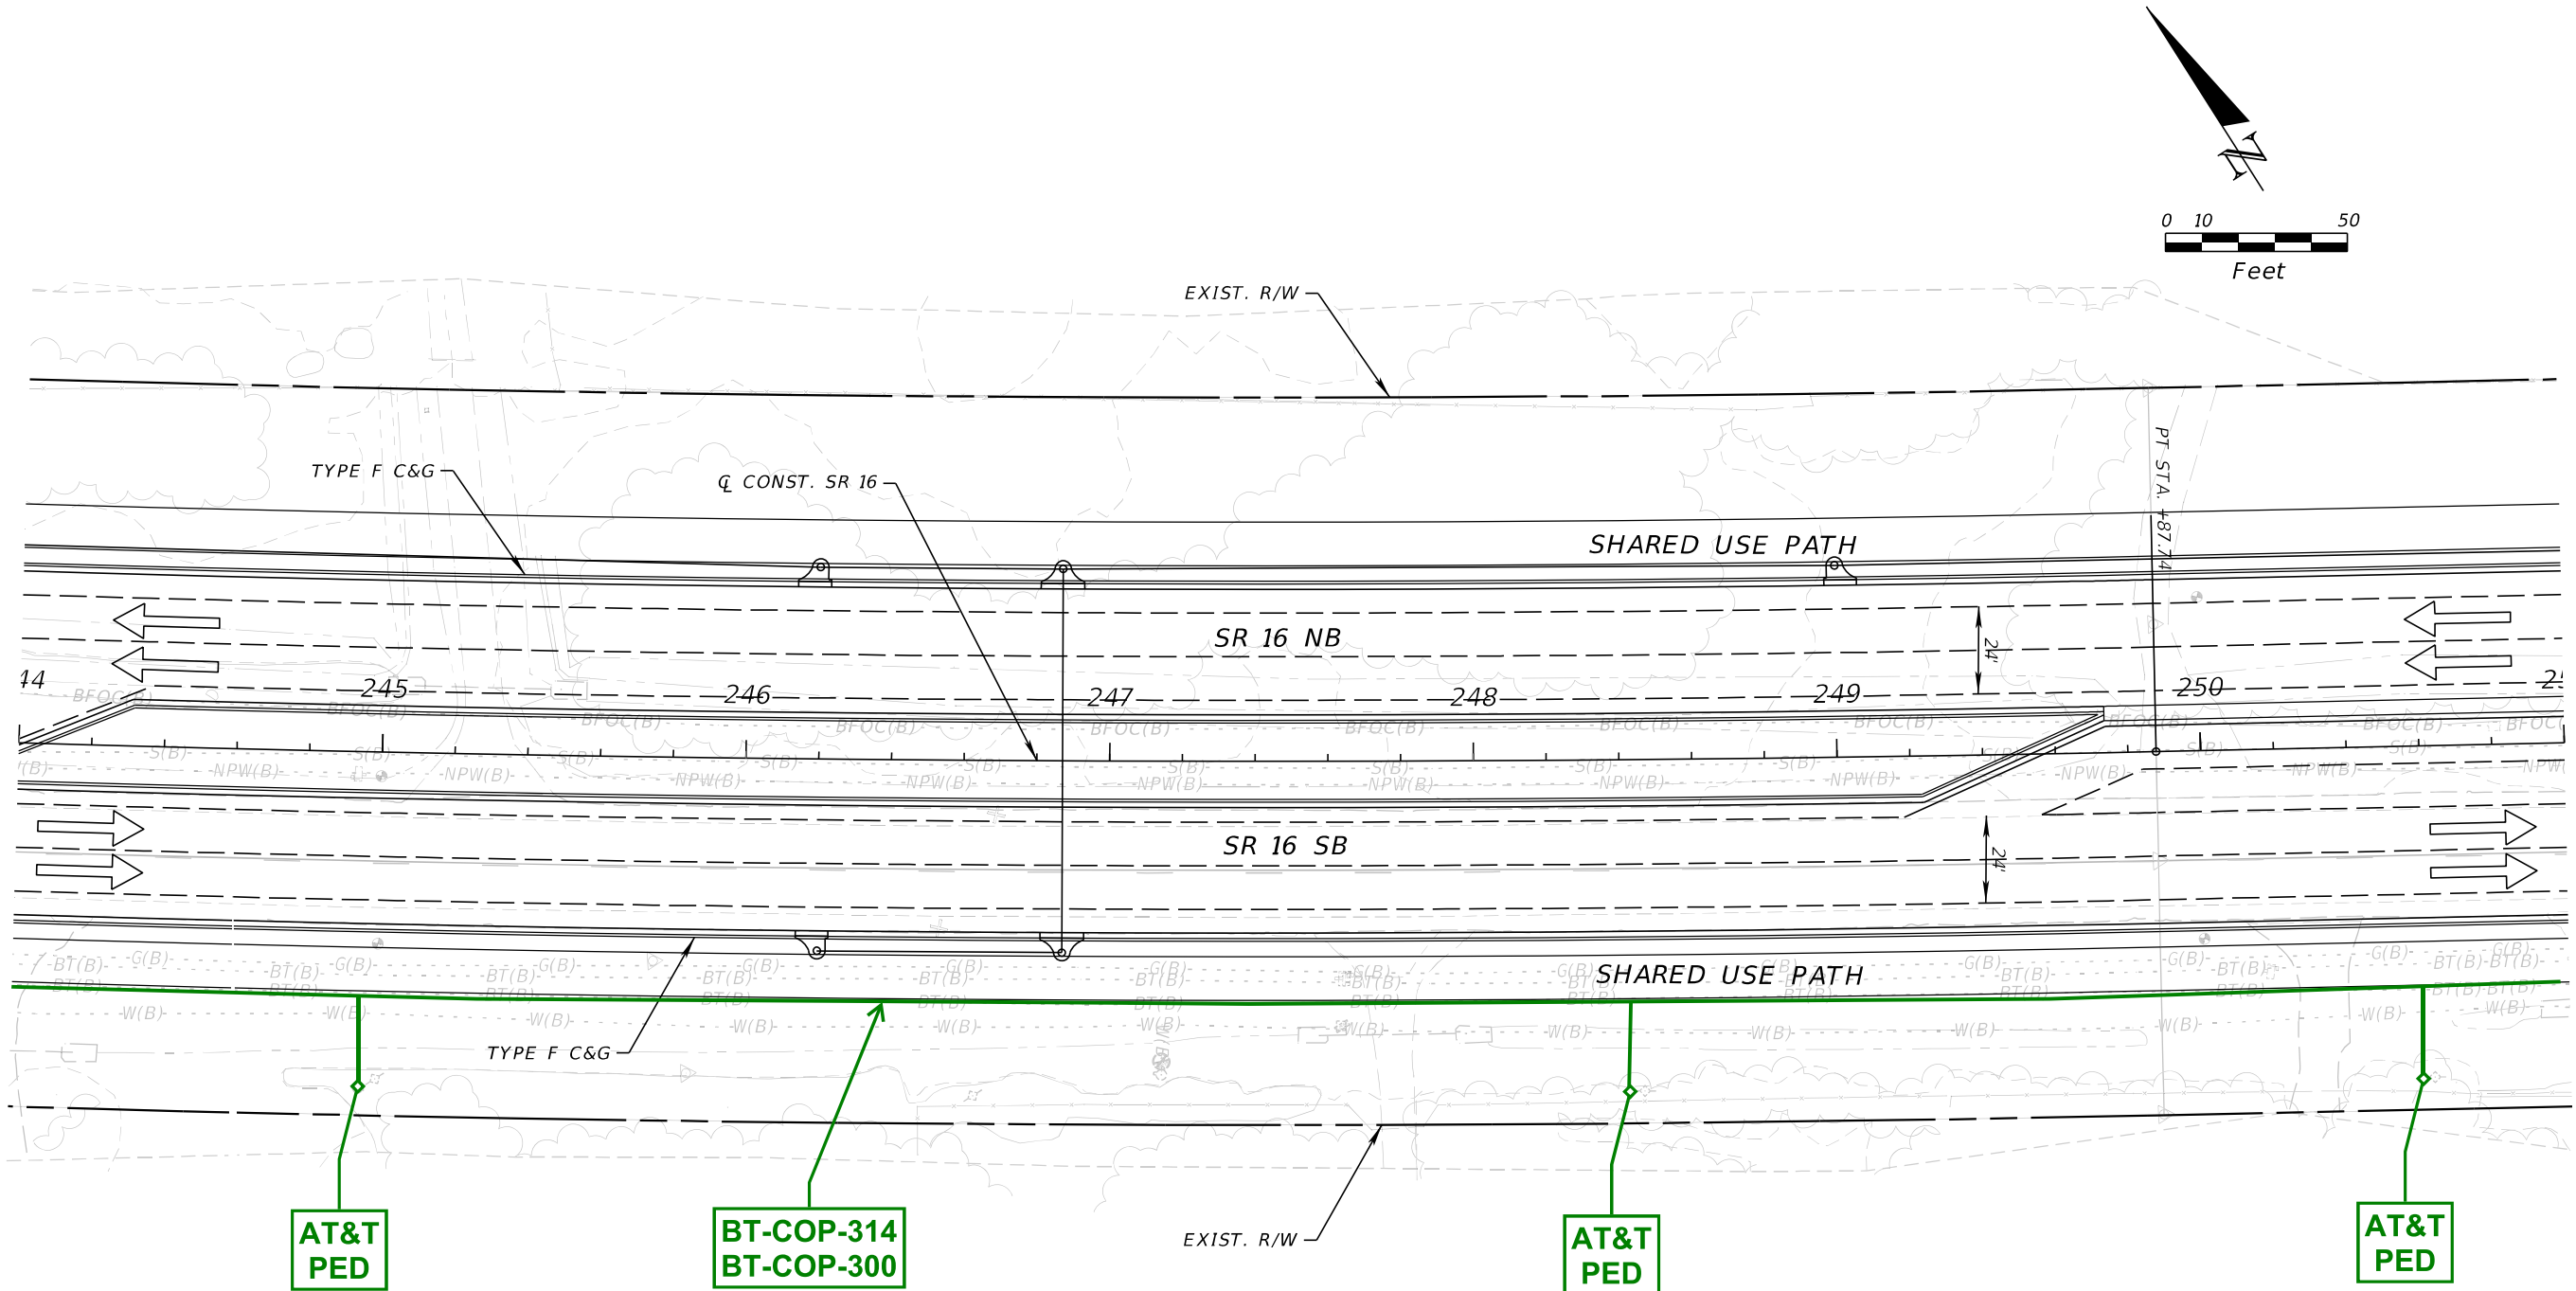


| LEGEND |                 |
|--------|-----------------|
| -----  | AERIAL AT&T     |
| =====  | BURIED AT&T     |
| ◇      | AT&T PEDESTAL   |
| □      | AT&T MANHOLE    |
| ○      | AT&T OWNED POLE |

| REVISIONS |             | ENGINEER OF RECORD |                                                                                                                           | STATE OF FLORIDA<br>DEPARTMENT OF TRANSPORTATION |           |                      | SHEET<br>NO.          |
|-----------|-------------|--------------------|---------------------------------------------------------------------------------------------------------------------------|--------------------------------------------------|-----------|----------------------|-----------------------|
| DATE      | DESCRIPTION | DATE               | DESCRIPTION                                                                                                               | ROAD NO.                                         | COUNTY    | FINANCIAL PROJECT ID |                       |
|           |             |                    | STEPHEN J. PARK, P.E.<br>LICENSE NUMBER: 77656<br>RS&H, INC.<br>10748 DEERWOOD PARK BLVD. SOUTH<br>JACKSONVILLE, FL 32256 | SR 16                                            | ST. JOHNS | 210447-5-52-01       | 11x17<br>Plan<br>Only |

THE OFFICIAL RECORD OF THIS SHEET IS THE ELECTRONIC FILE DIGITALLY SIGNED AND SEALED UNDER RULE 61G15-23.004, F.A.C.

8/5/2024 4:28:52 PM BeattyM  
c:\pw\_work\ysh\_pw\pw\_user\q0439575\PLANRD01.dgn

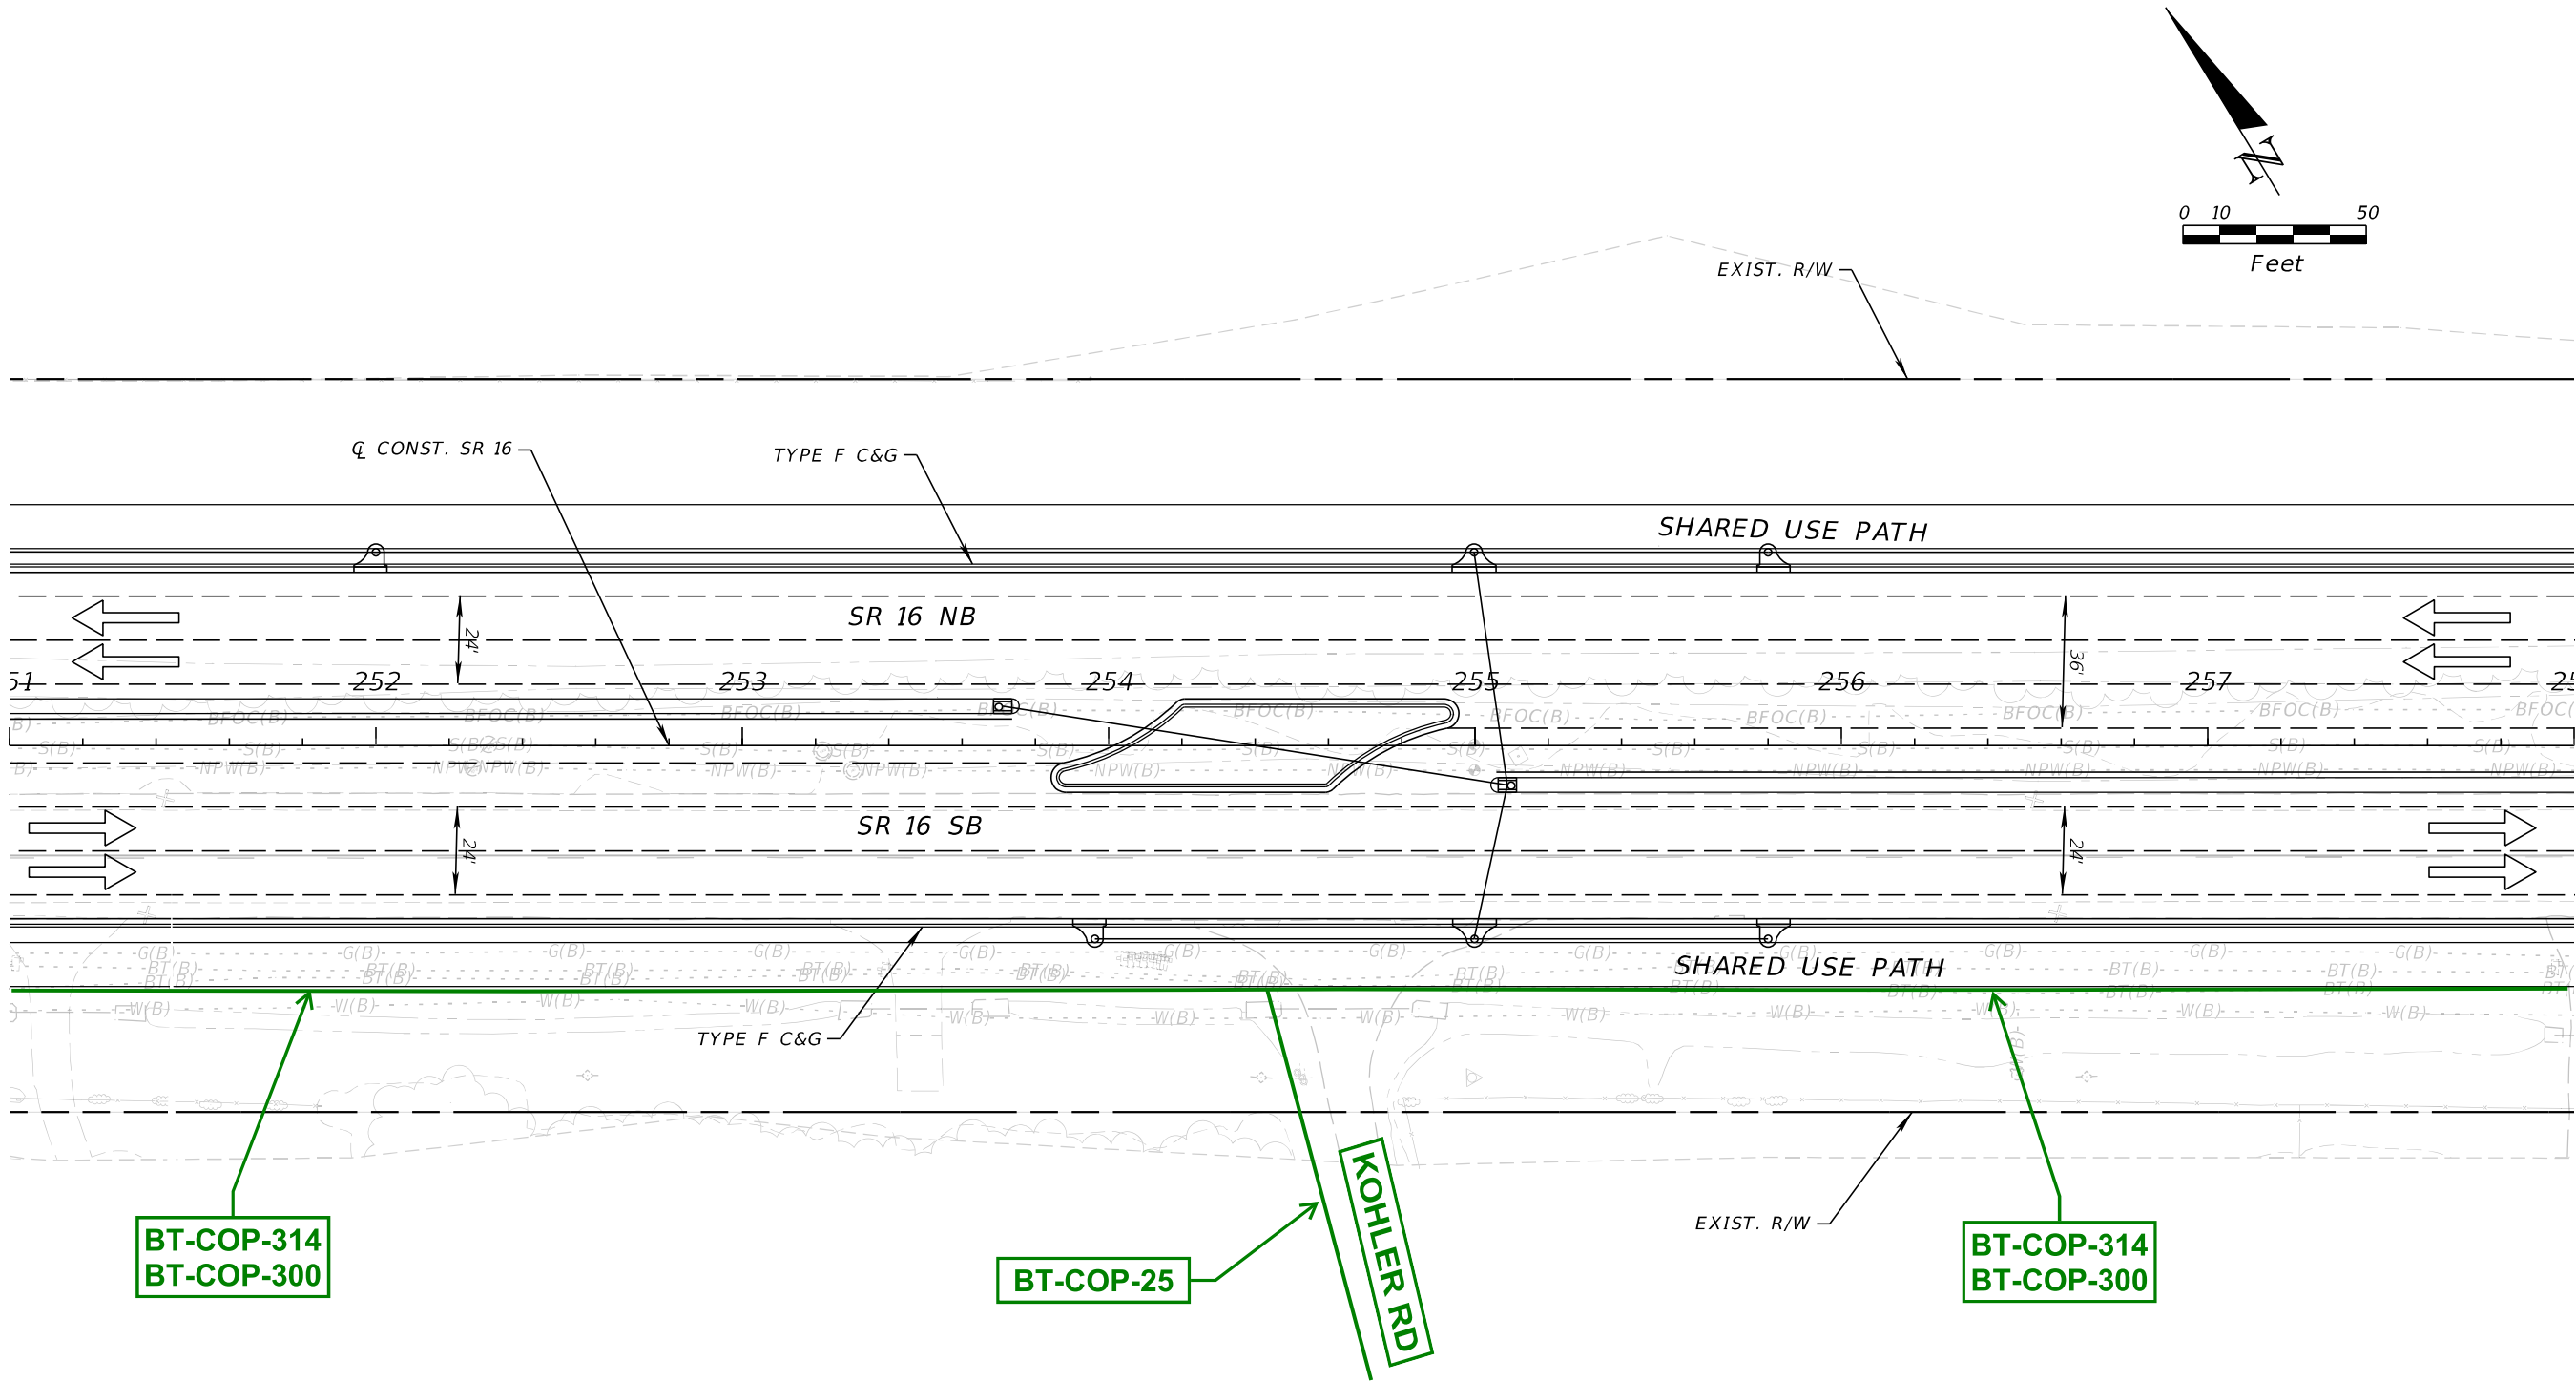


| LEGEND |                 |  |  |  |
|--------|-----------------|--|--|--|
| .....  | AERIAL AT&T     |  |  |  |
| ————   | BURIED AT&T     |  |  |  |
| ◇      | AT&T PEDESTAL   |  |  |  |
| □      | AT&T MANHOLE    |  |  |  |
| ○      | AT&T OWNED POLE |  |  |  |

| DATE        |  | REVISIONS |             | ENGINEER OF RECORD                                                                                                        |  | STATE OF FLORIDA<br>DEPARTMENT OF TRANSPORTATION |           |                      | SHEET<br>NO.          |
|-------------|--|-----------|-------------|---------------------------------------------------------------------------------------------------------------------------|--|--------------------------------------------------|-----------|----------------------|-----------------------|
| DESCRIPTION |  | DATE      | DESCRIPTION | STEPHEN J. PARK, P.E.<br>LICENSE NUMBER: 77656<br>RS&H, INC.<br>10748 DEERWOOD PARK BLVD. SOUTH<br>JACKSONVILLE, FL 32256 |  | ROAD NO.                                         | COUNTY    | FINANCIAL PROJECT ID |                       |
|             |  |           |             |                                                                                                                           |  | SR 16                                            | ST. JOHNS | 210447-5-52-01       | 11x17<br>Plan<br>Only |

THE OFFICIAL RECORD OF THIS SHEET IS THE ELECTRONIC FILE DIGITALLY SIGNED AND SEALED UNDER RULE 61G15-23.004, F.A.C.

8/5/2024 4:28:52 PM BeattyM  
c:\pw\_work\ysh\_pw\pw\_user\q0439575\PLANRD01.dgn

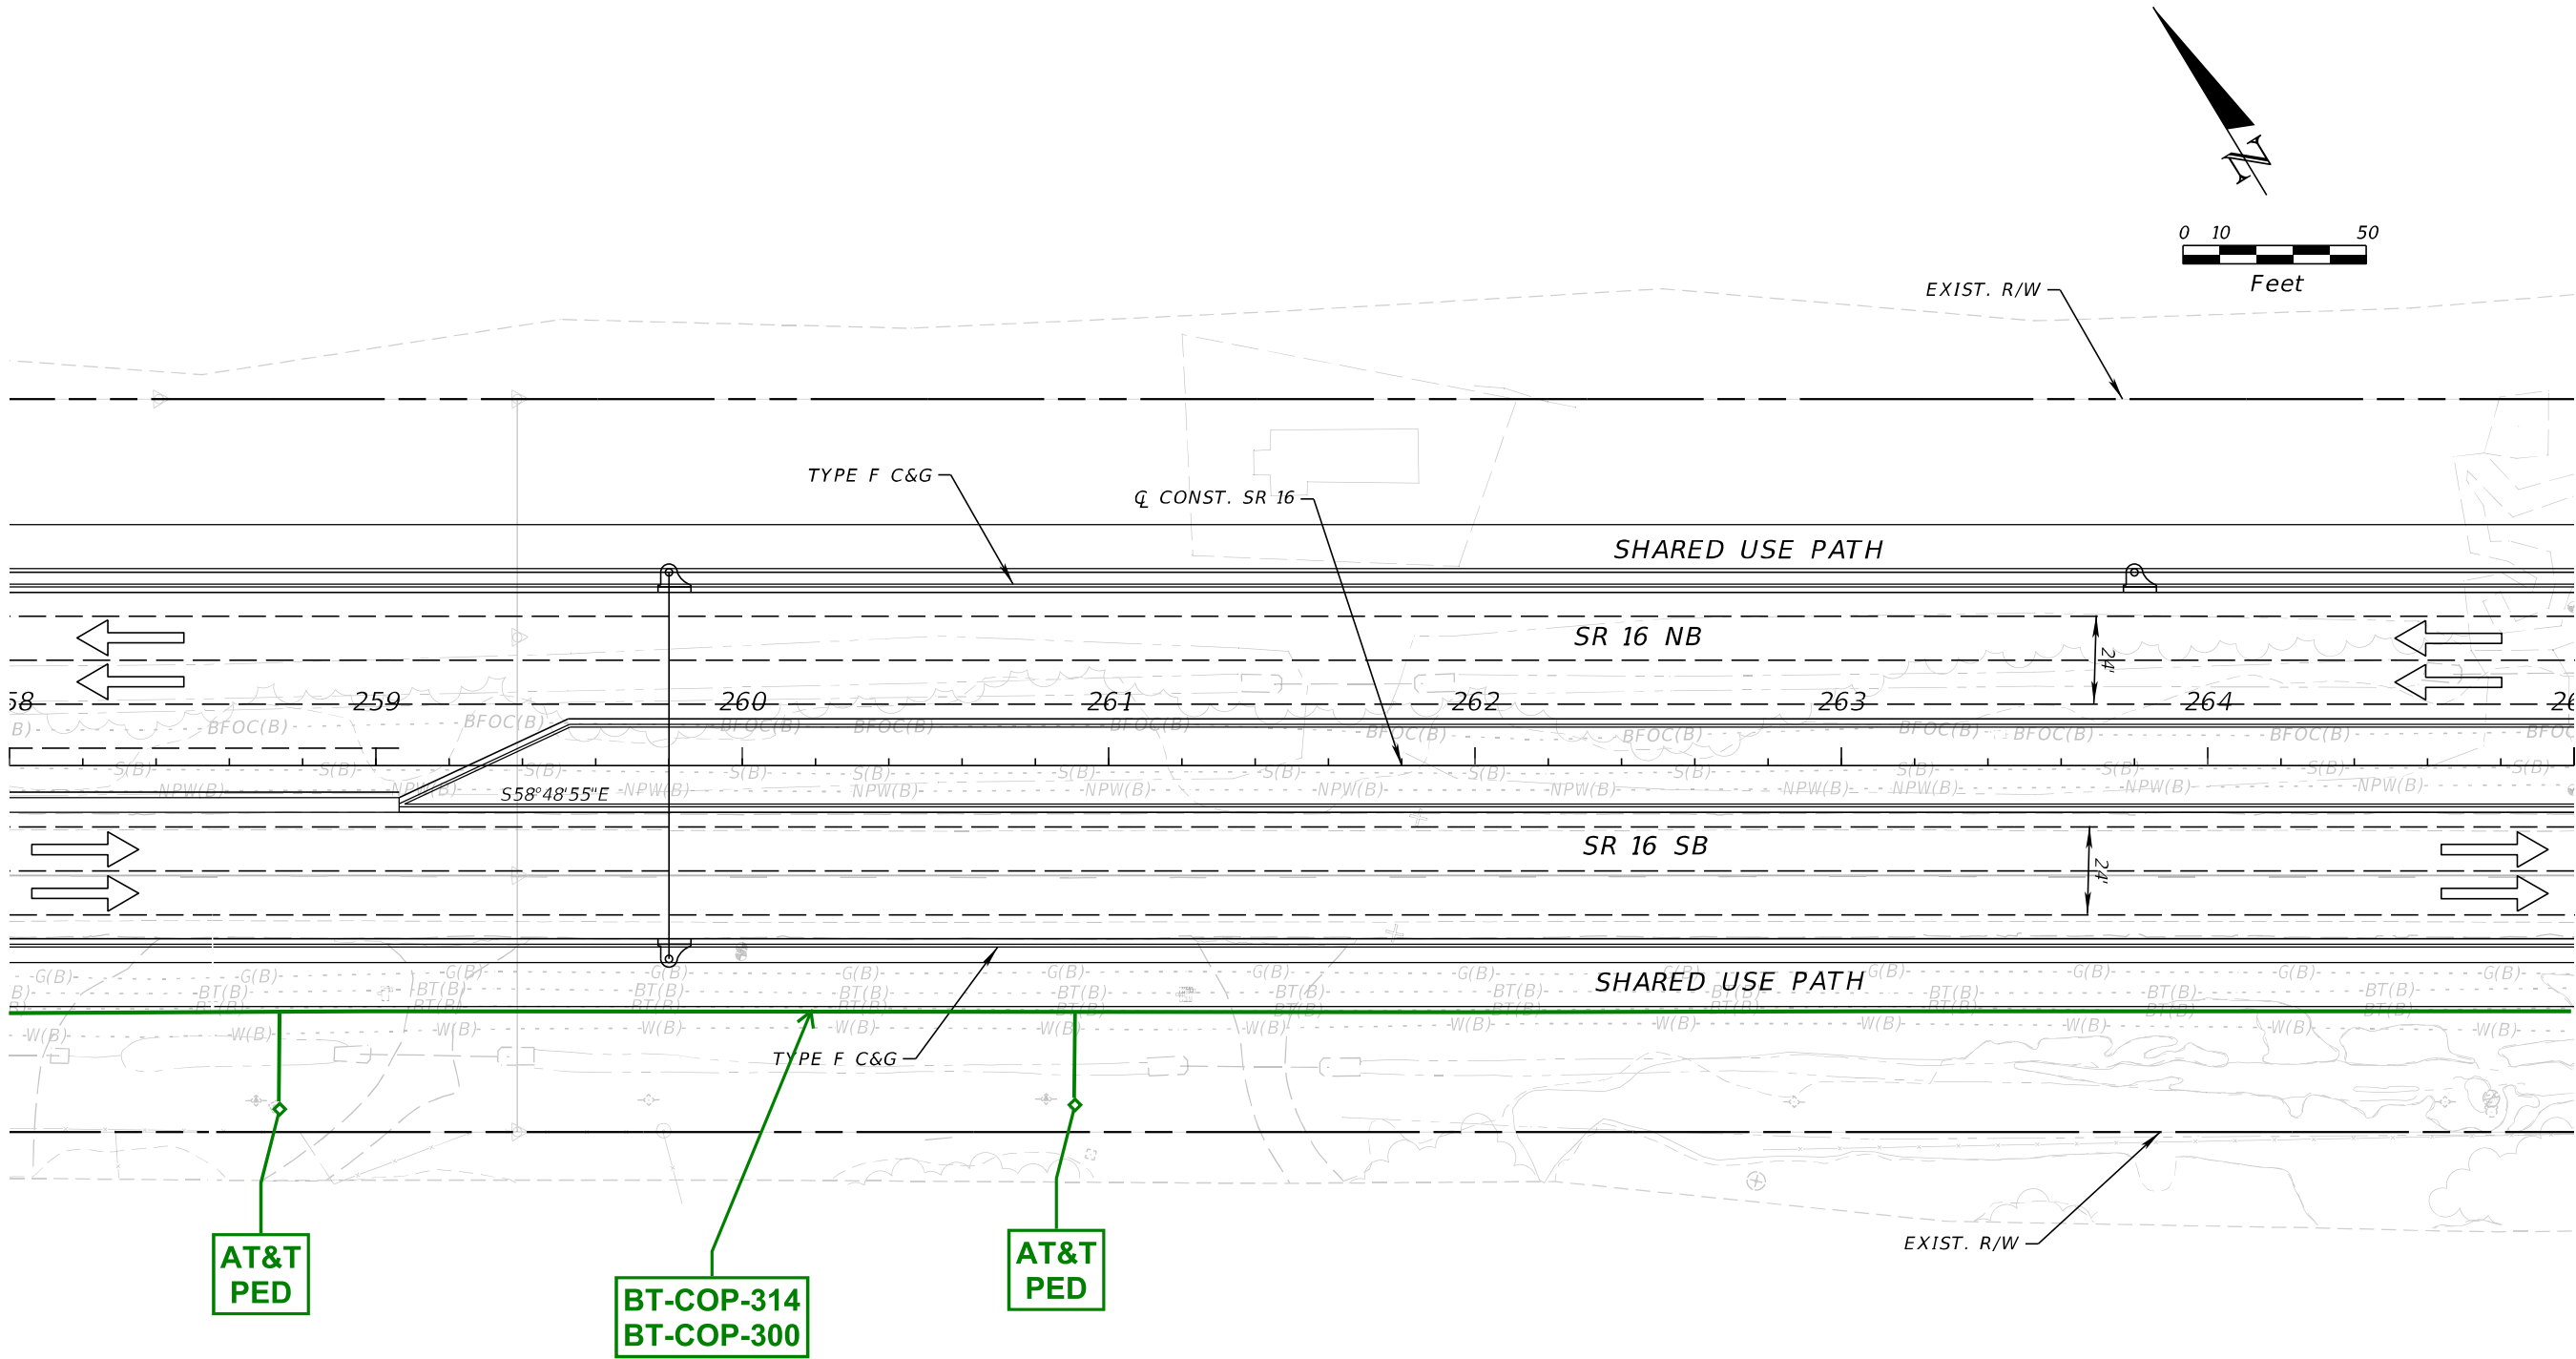


| LEGEND |                 |
|--------|-----------------|
| .....  | AERIAL AT&T     |
| ————   | BURIED AT&T     |
| ◆————  | AT&T PEDESTAL   |
| □————  | AT&T MANHOLE    |
| ○————  | AT&T OWNED POLE |

| REVISIONS |             |      |             | ENGINEER OF RECORD                                                                                                        | STATE OF FLORIDA<br>DEPARTMENT OF TRANSPORTATION |           |                      | SHEET<br>NO.          |
|-----------|-------------|------|-------------|---------------------------------------------------------------------------------------------------------------------------|--------------------------------------------------|-----------|----------------------|-----------------------|
| DATE      | DESCRIPTION | DATE | DESCRIPTION |                                                                                                                           | ROAD NO.                                         | COUNTY    | FINANCIAL PROJECT ID |                       |
|           |             |      |             |                                                                                                                           | SR 16                                            | ST. JOHNS | 210447-5-52-01       |                       |
|           |             |      |             | STEPHEN J. PARK, P.E.<br>LICENSE NUMBER: 77656<br>RS&H, INC.<br>10748 DEERWOOD PARK BLVD. SOUTH<br>JACKSONVILLE, FL 32256 |                                                  |           |                      | 11x17<br>Plan<br>Only |

THE OFFICIAL RECORD OF THIS SHEET IS THE ELECTRONIC FILE DIGITALLY SIGNED AND SEALED UNDER RULE 61G15-23.004, F.A.C.

8/5/2024 4:28:53 PM BeattyM  
c:\pw\_work\sh\_pw\pw\_user\0439575\PLANRD01.dgn

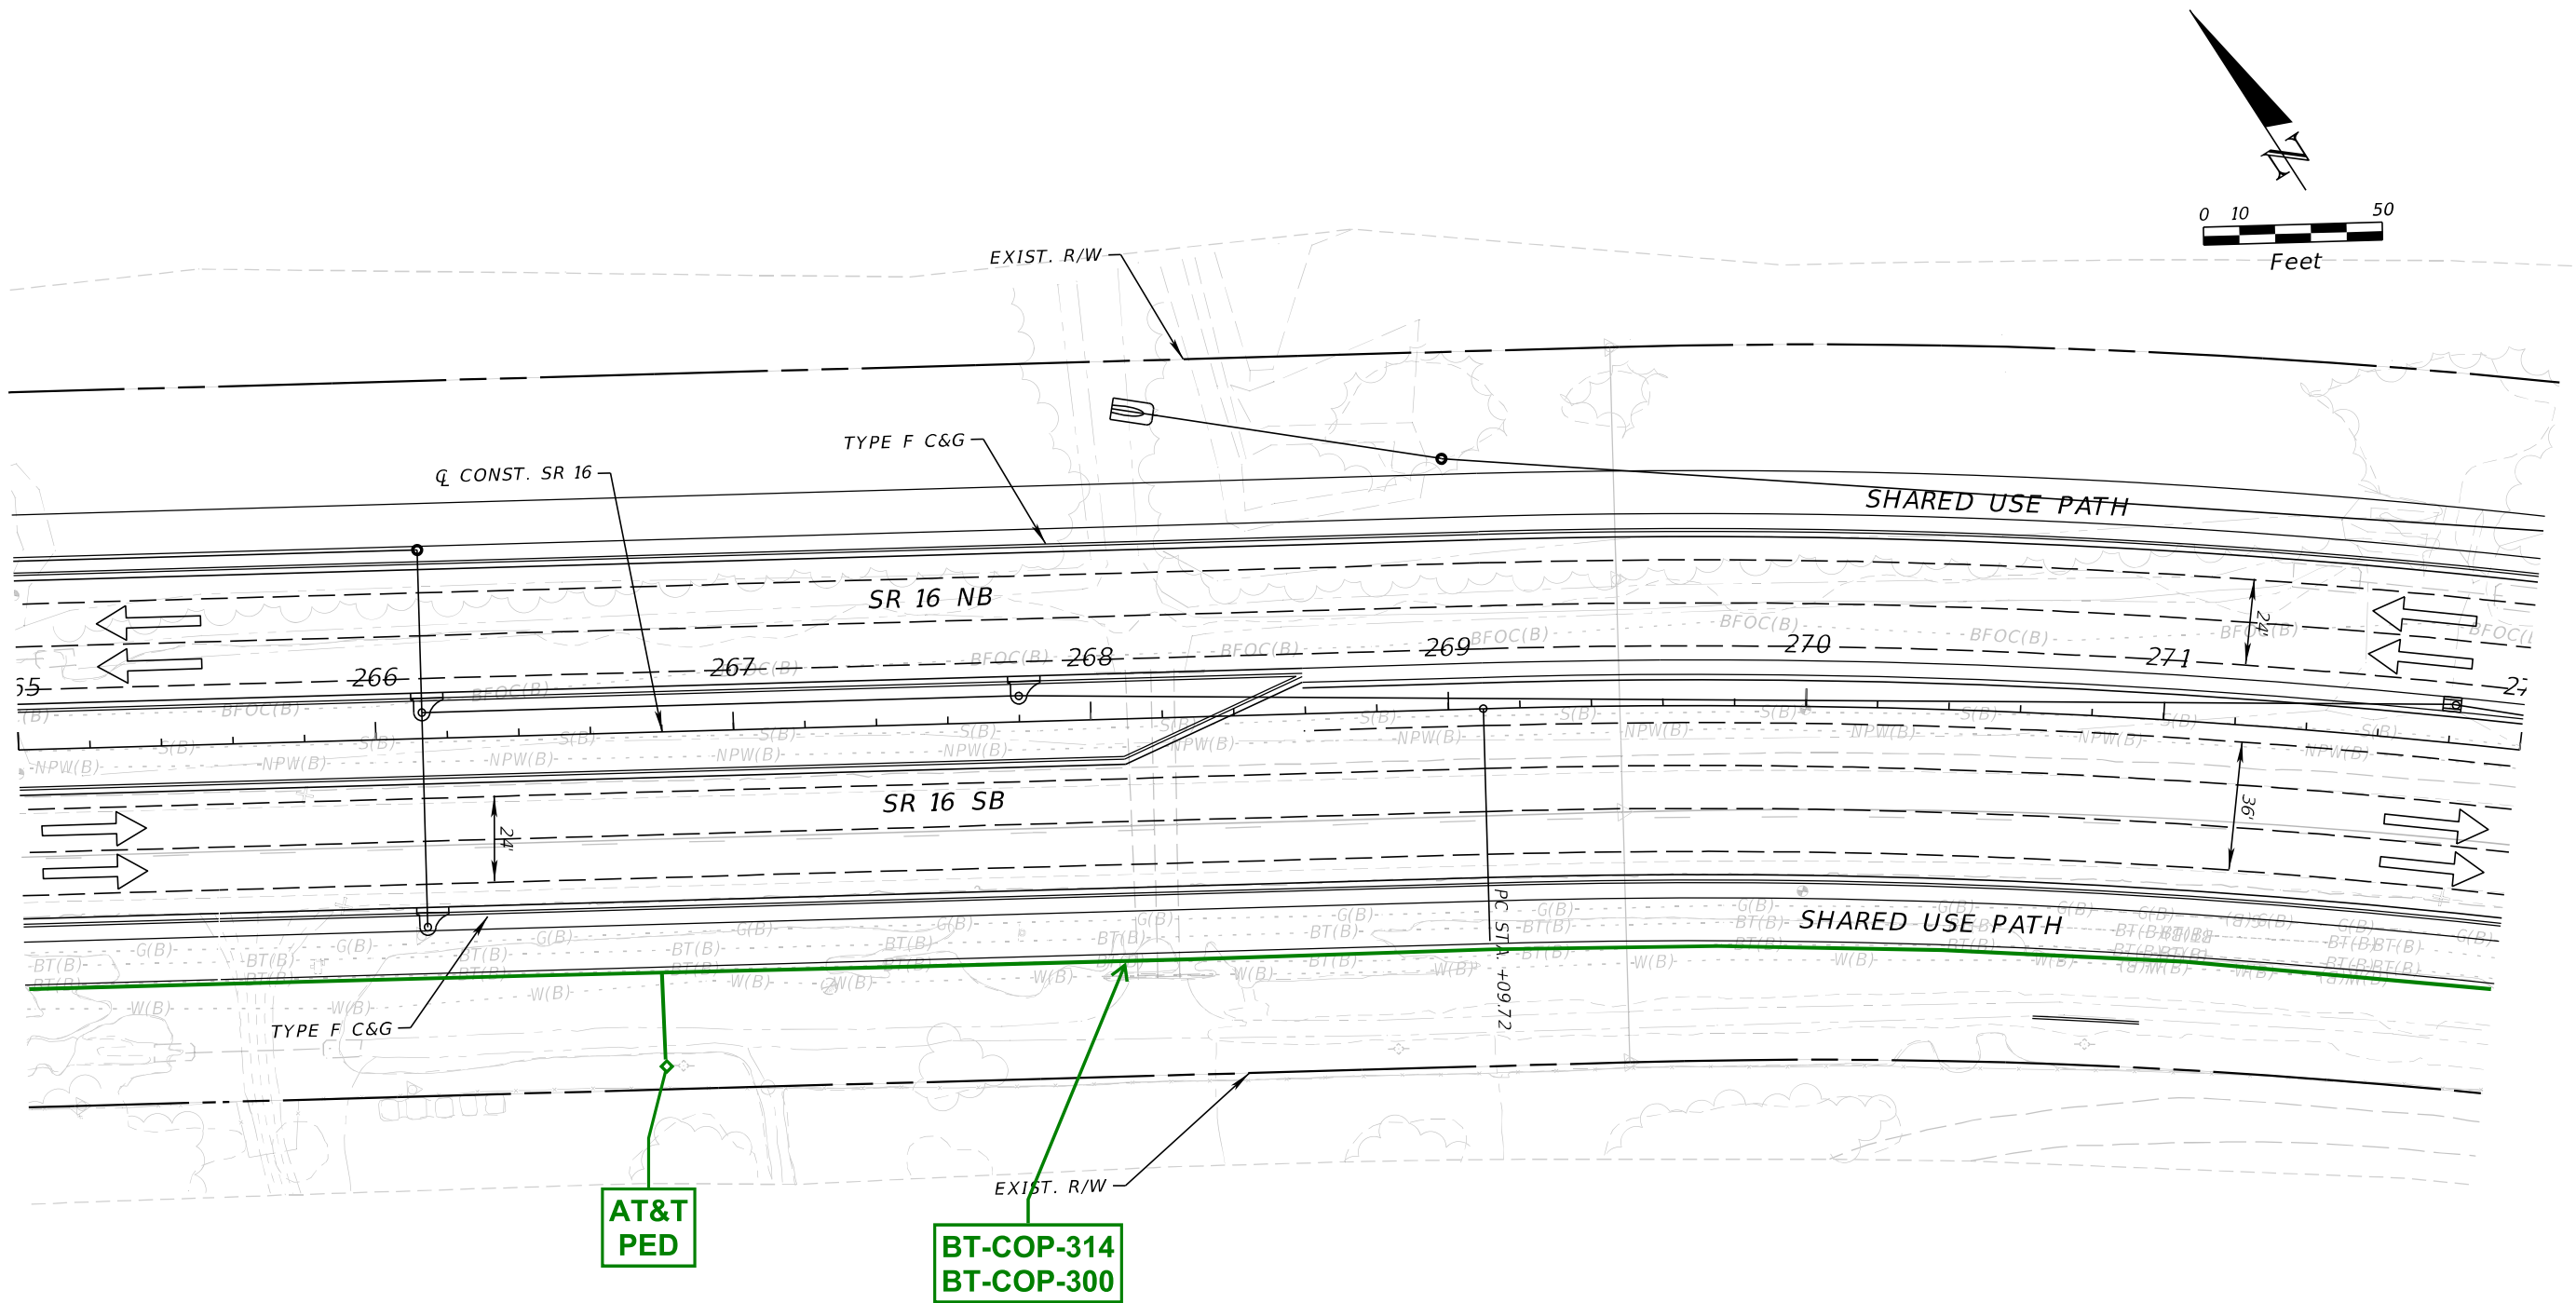


**LEGEND**

- ..... AERIAL AT&T
- BURIED AT&T
- ◇ AT&T PEDESTAL
- AT&T MANHOLE
- AT&T OWNED POLE

| DATE |  | REVISIONS   |      | ENGINEER OF RECORD                                                                                                        |  | STATE OF FLORIDA<br>DEPARTMENT OF TRANSPORTATION |           |                      | SHEET NO.             |
|------|--|-------------|------|---------------------------------------------------------------------------------------------------------------------------|--|--------------------------------------------------|-----------|----------------------|-----------------------|
|      |  | DESCRIPTION | DATE |                                                                                                                           |  | ROAD NO.                                         | COUNTY    | FINANCIAL PROJECT ID |                       |
|      |  |             |      | STEPHEN J. PARK, P.E.<br>LICENSE NUMBER: 77656<br>RS&H, INC.<br>10748 DEERWOOD PARK BLVD. SOUTH<br>JACKSONVILLE, FL 32256 |  | SR 16                                            | ST. JOHNS | 210447-5-52-01       | 11x17<br>Plan<br>Only |

THE OFFICIAL RECORD OF THIS SHEET IS THE ELECTRONIC FILE DIGITALLY SIGNED AND SEALED UNDER RULE 61G15-23.004, F.A.C.

8/5/2024 4:28:54 PM BeattyM  
c:\pw\_work\ysh\_pw\pw\_user\0439575\PLANRD01.dgn

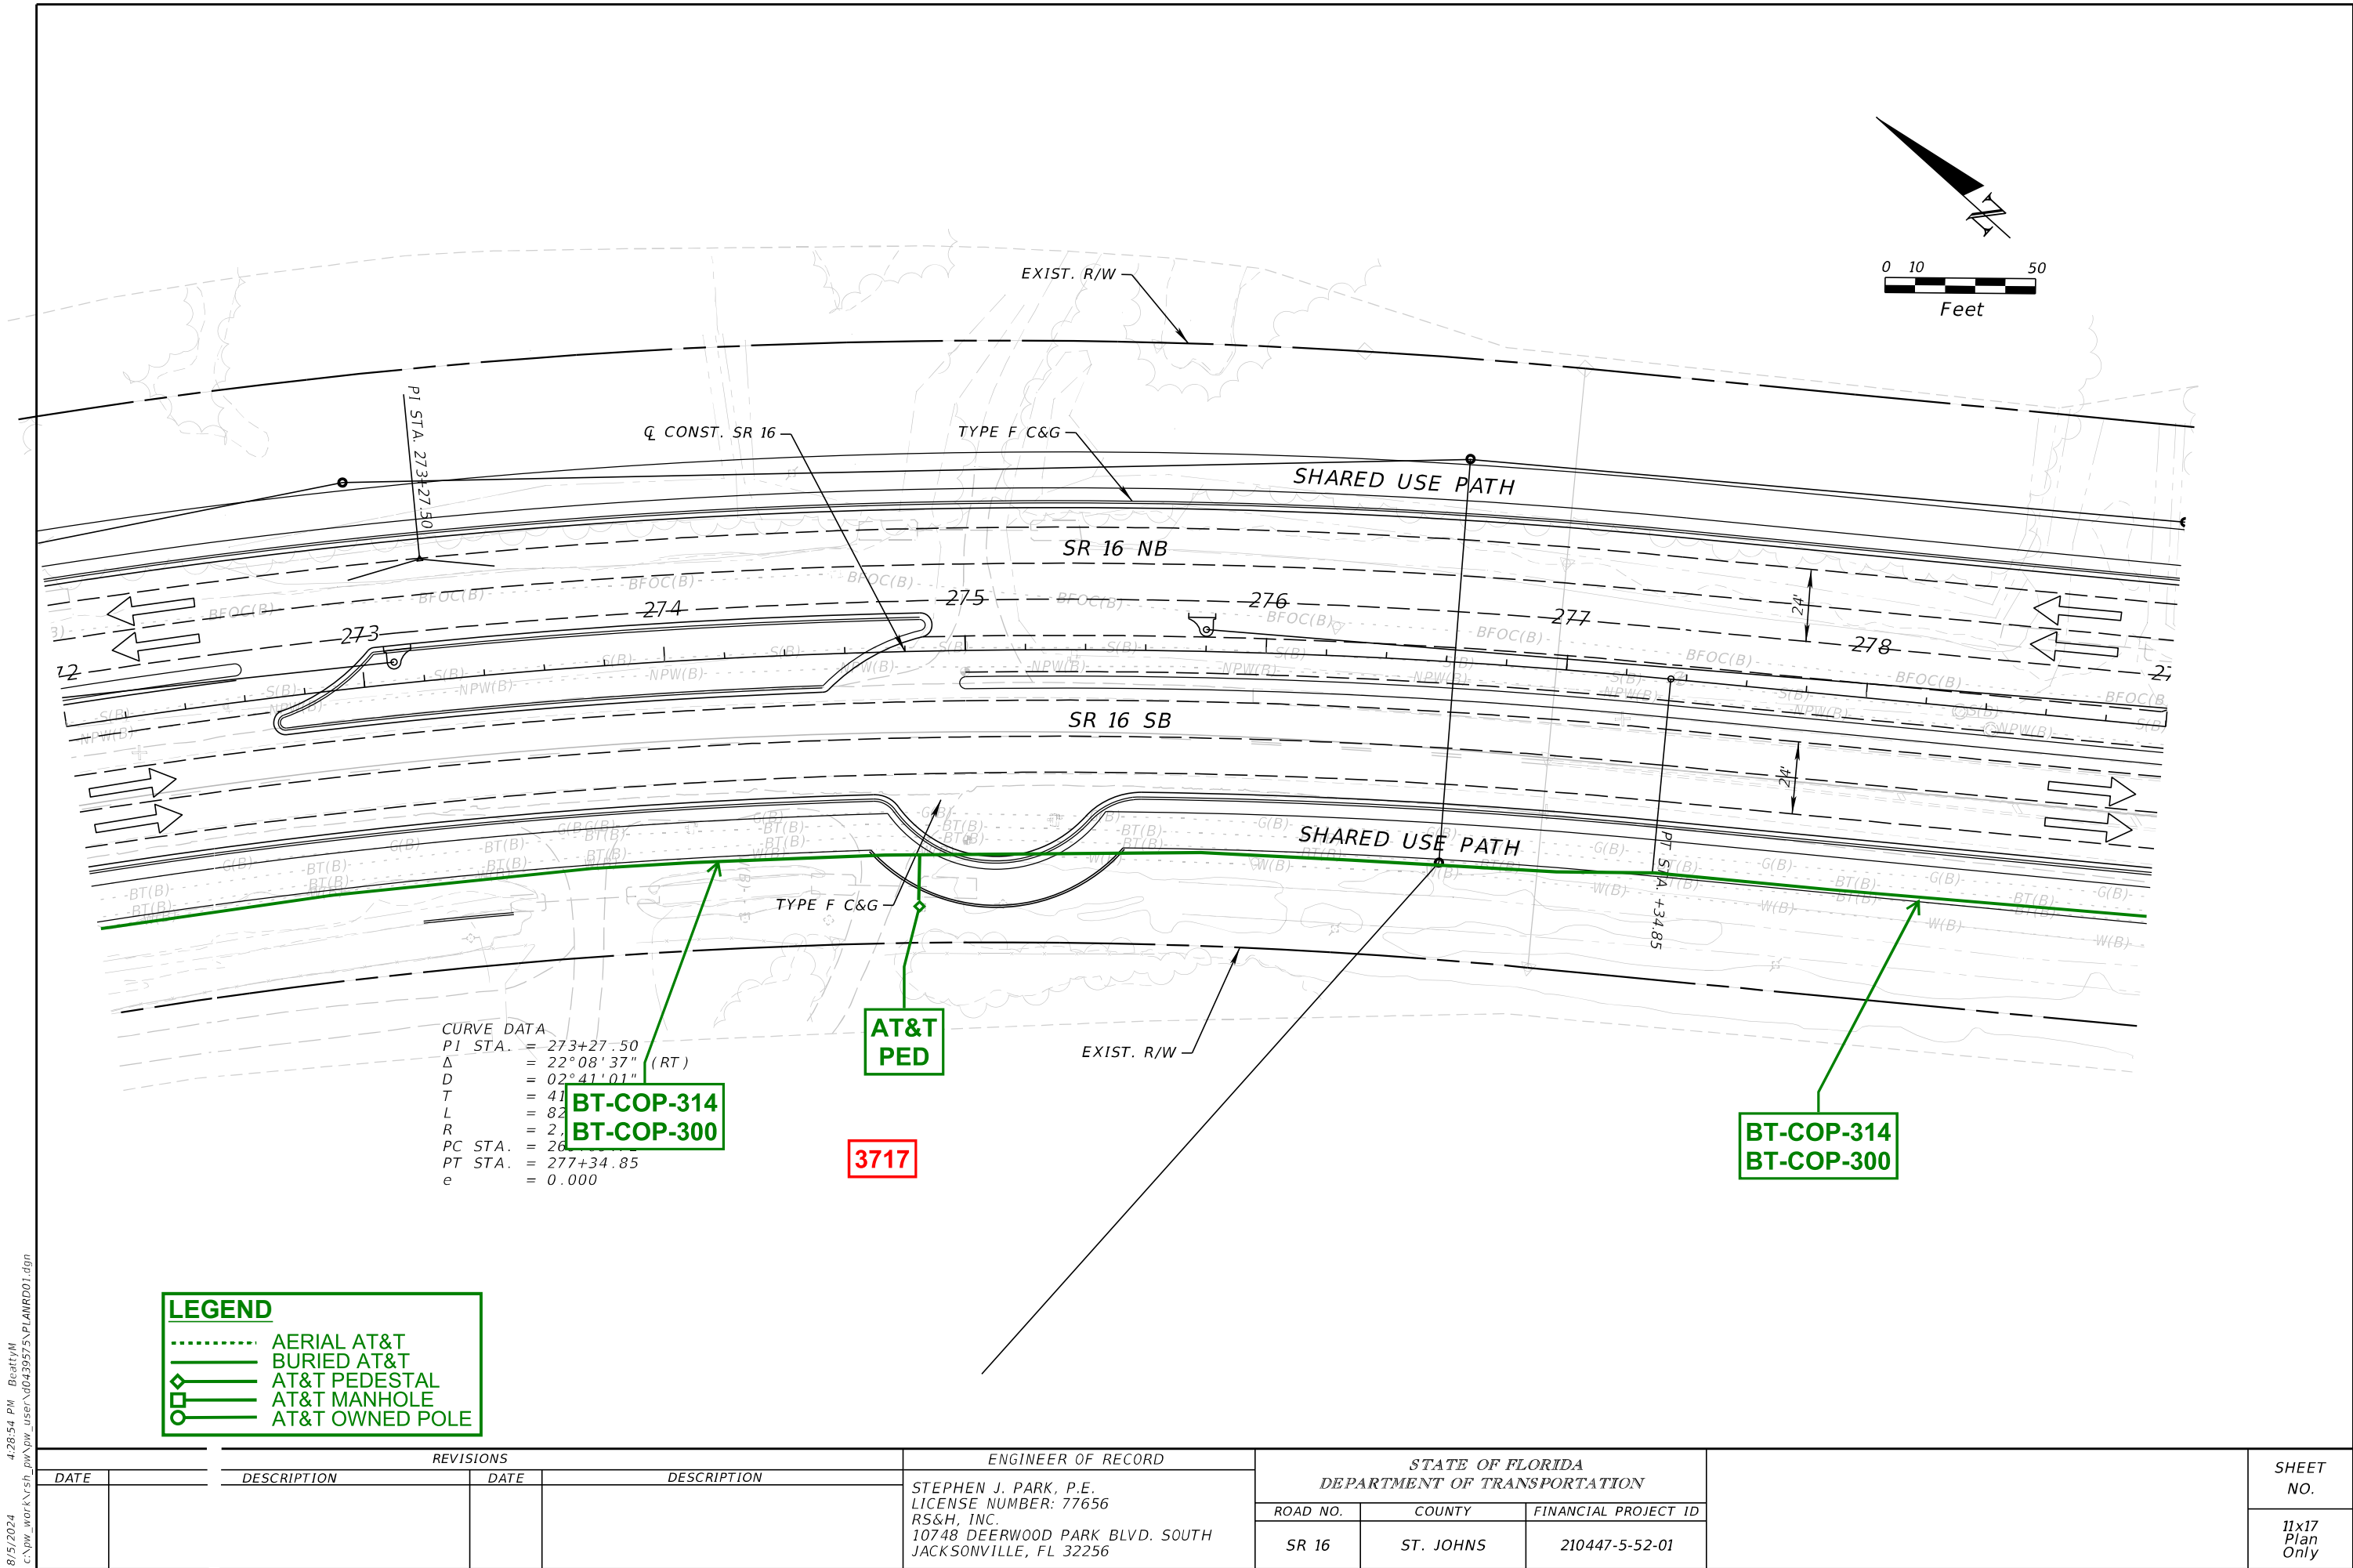


| REVISIONS |             | ENGINEER OF RECORD |                                                                                                                           | STATE OF FLORIDA<br>DEPARTMENT OF TRANSPORTATION |           |                      | SHEET<br>NO.          |
|-----------|-------------|--------------------|---------------------------------------------------------------------------------------------------------------------------|--------------------------------------------------|-----------|----------------------|-----------------------|
| DATE      | DESCRIPTION | DATE               | DESCRIPTION                                                                                                               | ROAD NO.                                         | COUNTY    | FINANCIAL PROJECT ID |                       |
|           |             |                    | STEPHEN J. PARK, P.E.<br>LICENSE NUMBER: 77656<br>RS&H, INC.<br>10748 DEERWOOD PARK BLVD. SOUTH<br>JACKSONVILLE, FL 32256 | SR 16                                            | ST. JOHNS | 210447-5-52-01       | 11x17<br>Plan<br>Only |

THE OFFICIAL RECORD OF THIS SHEET IS THE ELECTRONIC FILE DIGITALLY SIGNED AND SEALED UNDER RULE 61G15-23.004, F.A.C.



8/5/2024 4:28:54 PM BeattyM  
c:\pw\_work\sh\_pw\pw\_user\0439575\PLANRD01.dgn

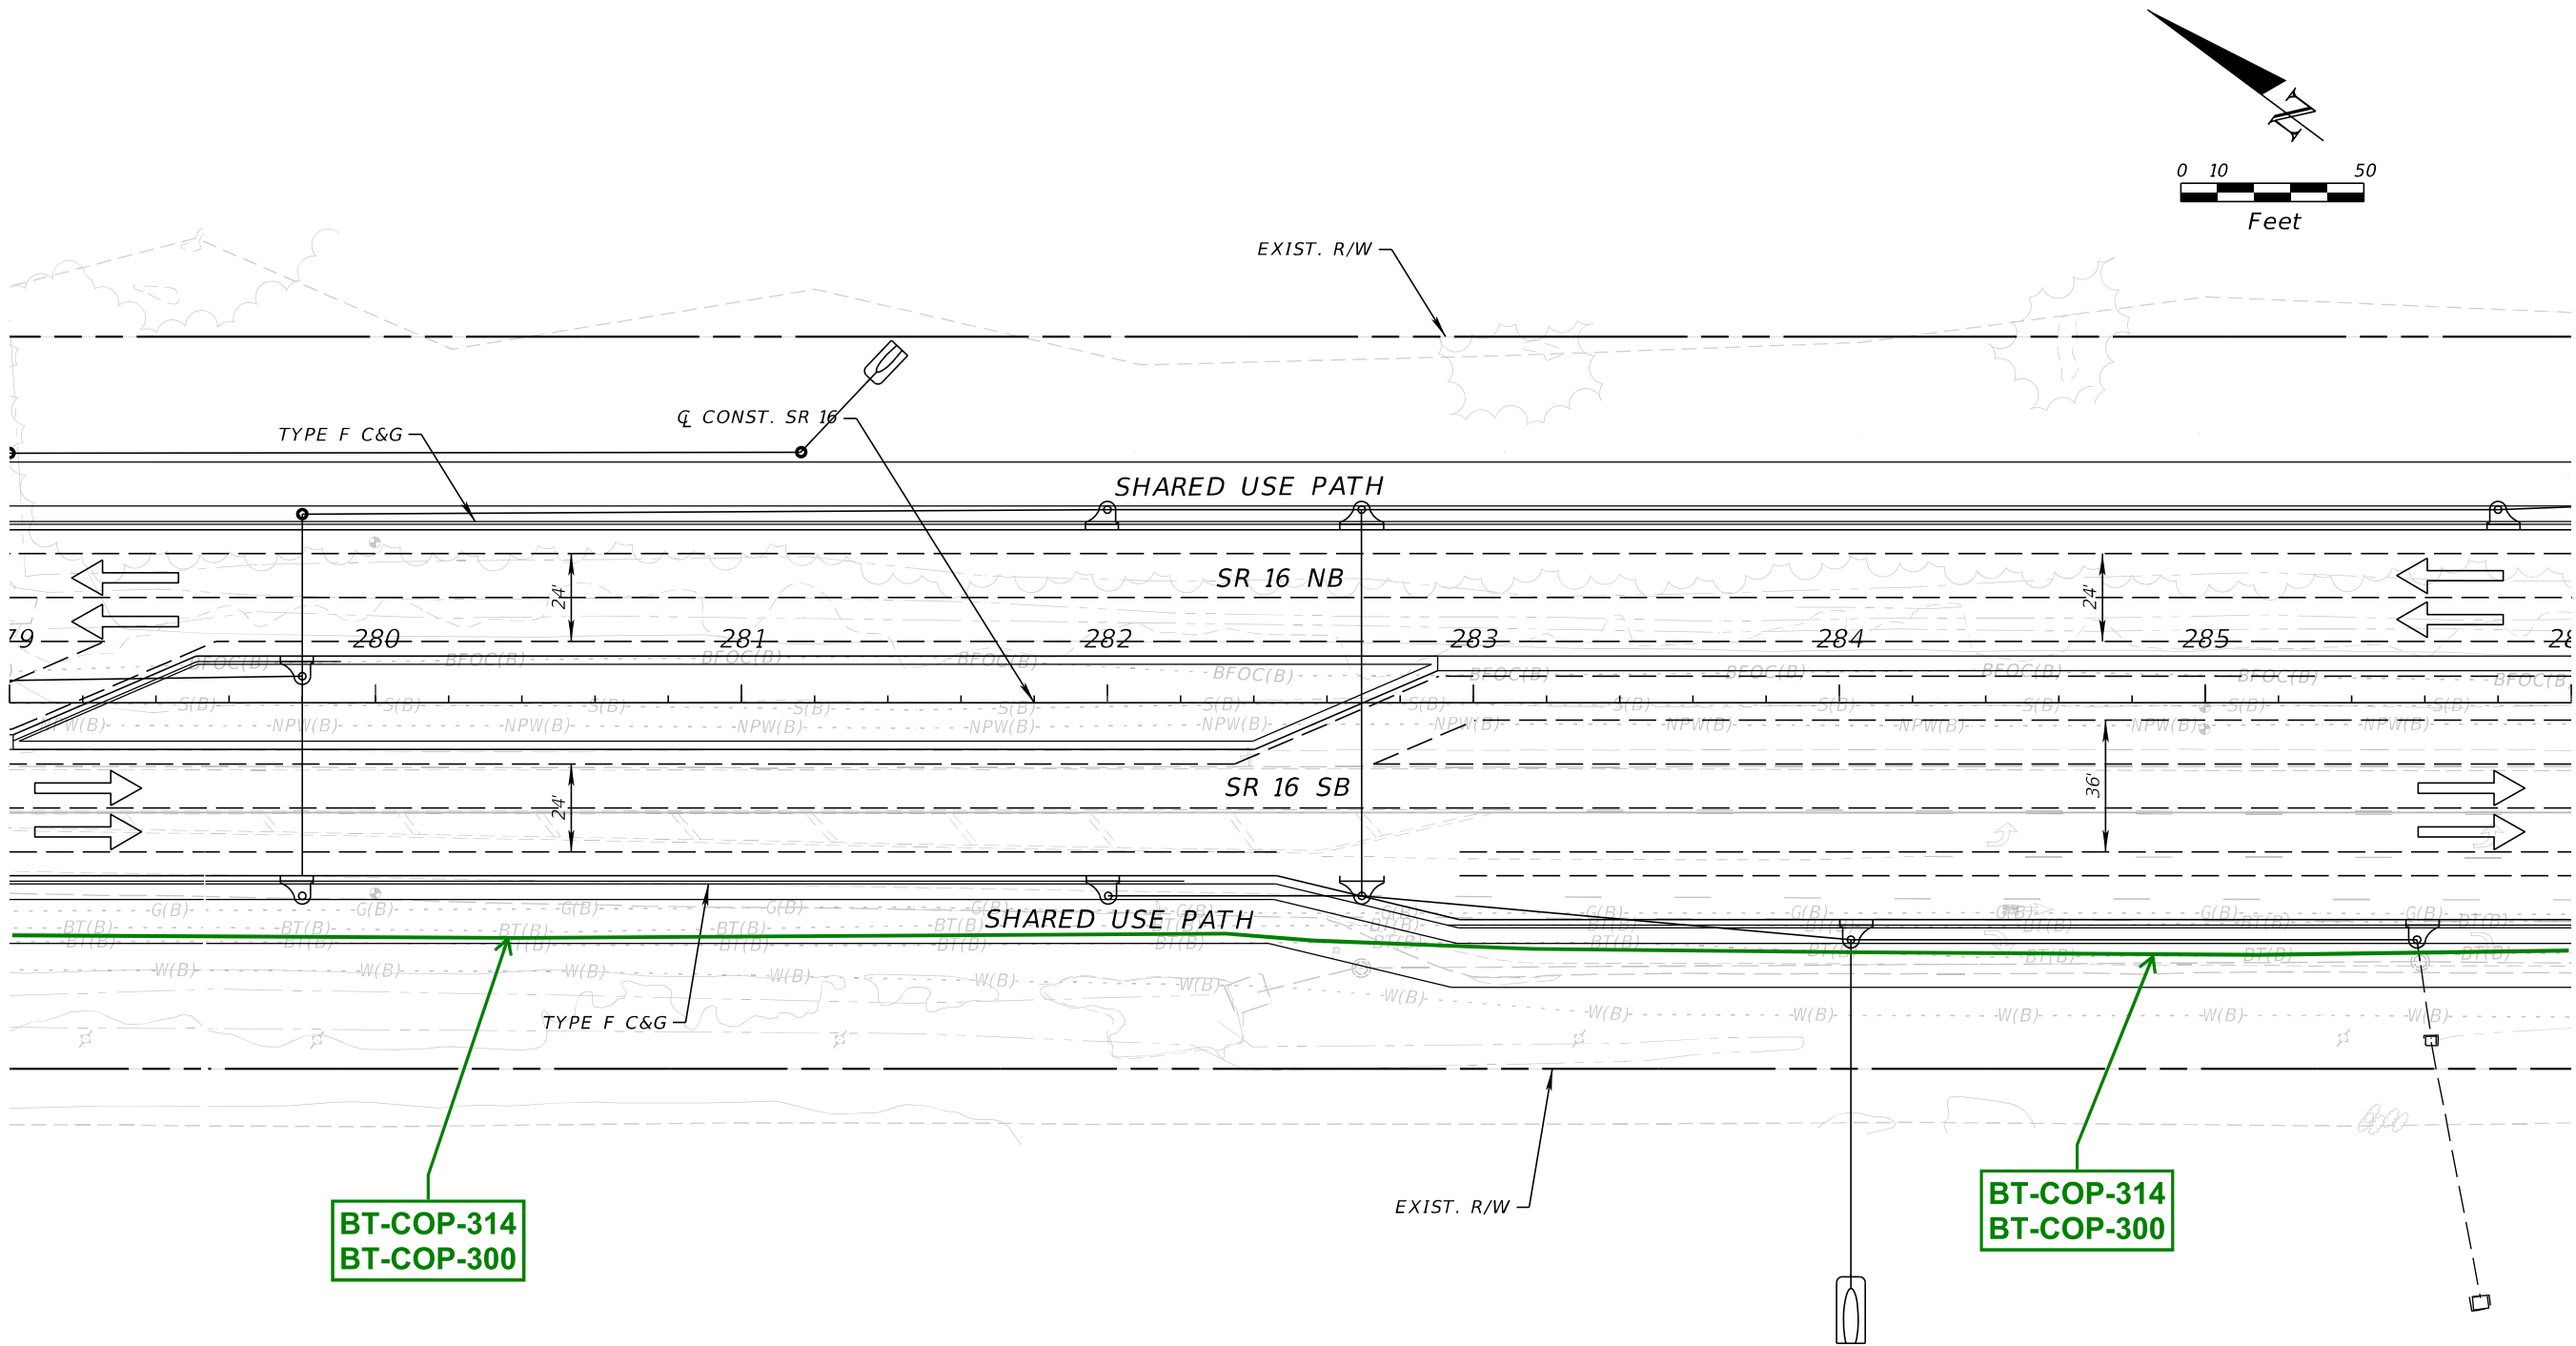

BT-COP-314  
BT-COP-300


BT-COP-314  
BT-COP-300

| LEGEND |                 |  |  |
|--------|-----------------|--|--|
| .....  | AERIAL AT&T     |  |  |
| ————   | BURIED AT&T     |  |  |
| ◇      | AT&T PEDESTAL   |  |  |
| □      | AT&T MANHOLE    |  |  |
| ○      | AT&T OWNED POLE |  |  |

| REVISIONS |             | ENGINEER OF RECORD |                                                                                                                           | STATE OF FLORIDA<br>DEPARTMENT OF TRANSPORTATION |           |                      | SHEET<br>NO.          |
|-----------|-------------|--------------------|---------------------------------------------------------------------------------------------------------------------------|--------------------------------------------------|-----------|----------------------|-----------------------|
| DATE      | DESCRIPTION | DATE               | DESCRIPTION                                                                                                               | ROAD NO.                                         | COUNTY    | FINANCIAL PROJECT ID |                       |
|           |             |                    | STEPHEN J. PARK, P.E.<br>LICENSE NUMBER: 77656<br>RS&H, INC.<br>10748 DEERWOOD PARK BLVD. SOUTH<br>JACKSONVILLE, FL 32256 | SR 16                                            | ST. JOHNS | 210447-5-52-01       | 11x17<br>Plan<br>Only |

THE OFFICIAL RECORD OF THIS SHEET IS THE ELECTRONIC FILE DIGITALLY SIGNED AND SEALED UNDER RULE 61G15-23.004, F.A.C.

8/5/2024 4:28:55 PM BeattyM  
c:\pw\_work\ysh\_pw\pw\_user\q0439575\PLAINRD01.dgn

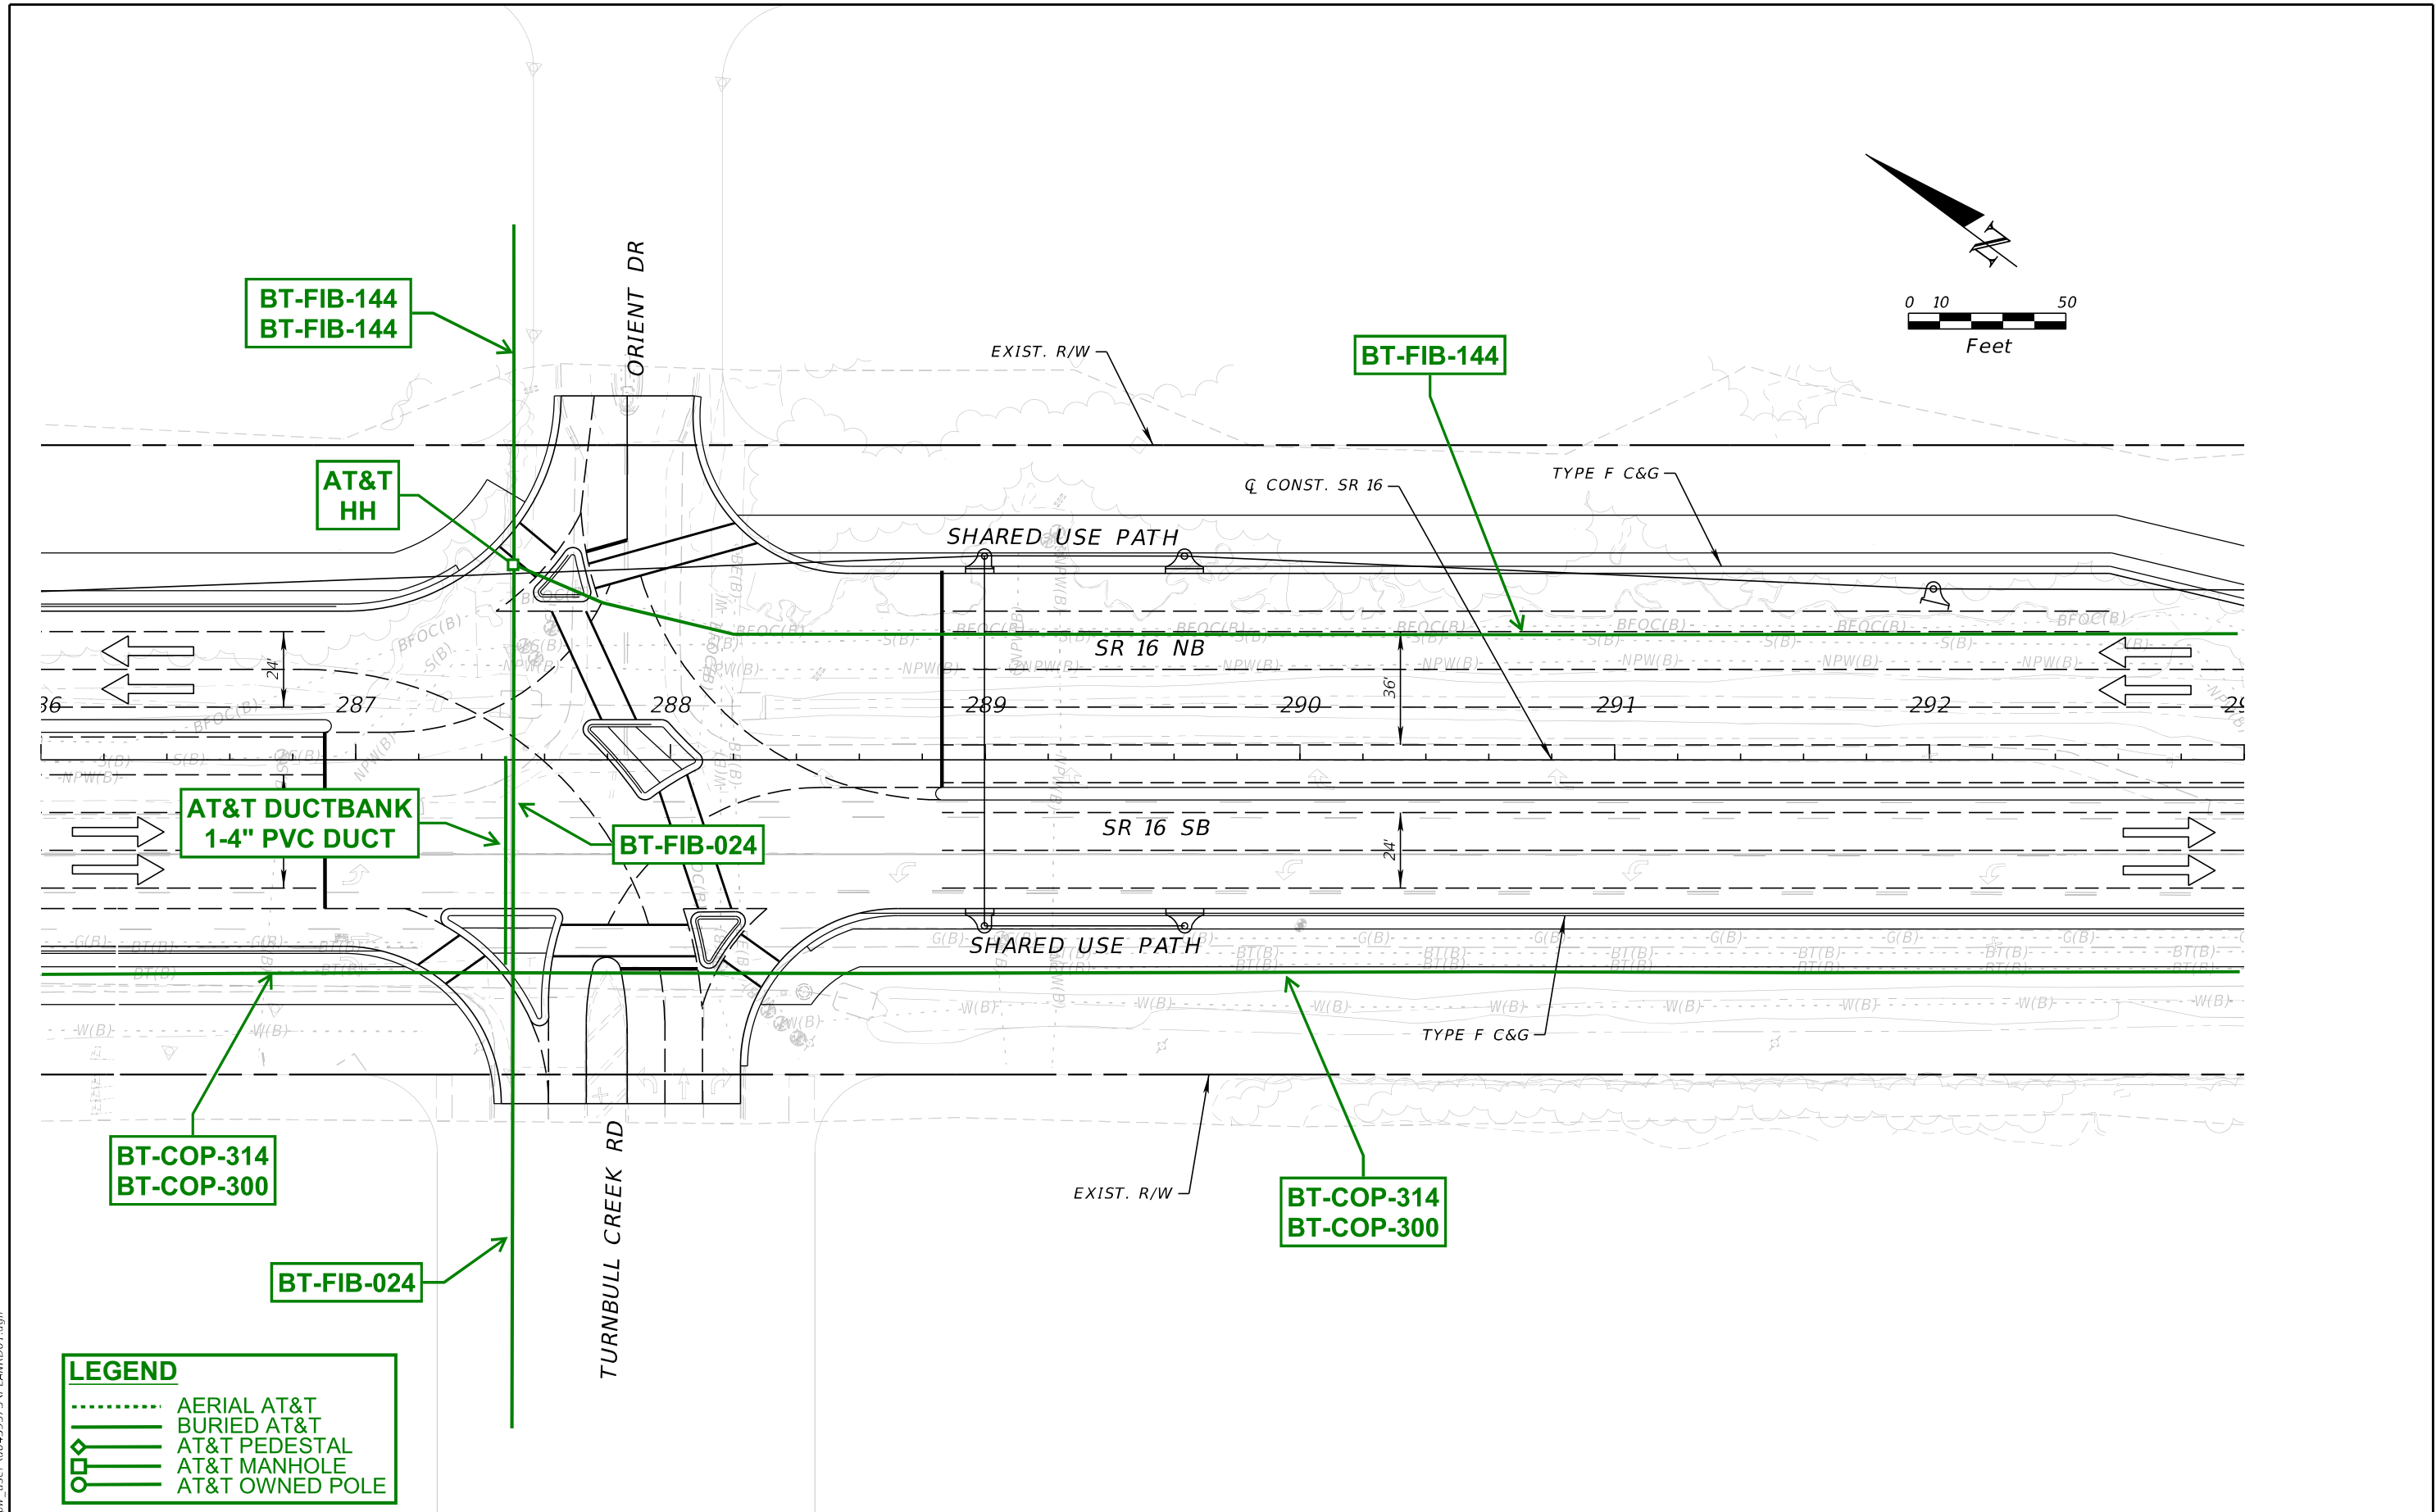


| REVISIONS |             |      |             | ENGINEER OF RECORD | STATE OF FLORIDA<br>DEPARTMENT OF TRANSPORTATION |           |                      | SHEET<br>NO. |
|-----------|-------------|------|-------------|--------------------|--------------------------------------------------|-----------|----------------------|--------------|
| DATE      | DESCRIPTION | DATE | DESCRIPTION |                    | ROAD NO.                                         | COUNTY    | FINANCIAL PROJECT ID |              |
|           |             |      |             |                    | SR 16                                            | ST. JOHNS | 210447-5-52-01       |              |

STEPHEN J. PARK, P.E.  
LICENSE NUMBER: 77656  
RS&H, INC.  
10748 DEERWOOD PARK BLVD. SOUTH  
JACKSONVILLE, FL 32256

11x17  
Plan  
Only

THE OFFICIAL RECORD OF THIS SHEET IS THE ELECTRONIC FILE DIGITALLY SIGNED AND SEALED UNDER RULE 61G15-23.004, F.A.C.

8/5/2024 4:28:55 PM BeattyM  
c:\pw\_work\sh\_pw\pw\_user\q0439575\PLANRD01.dgn

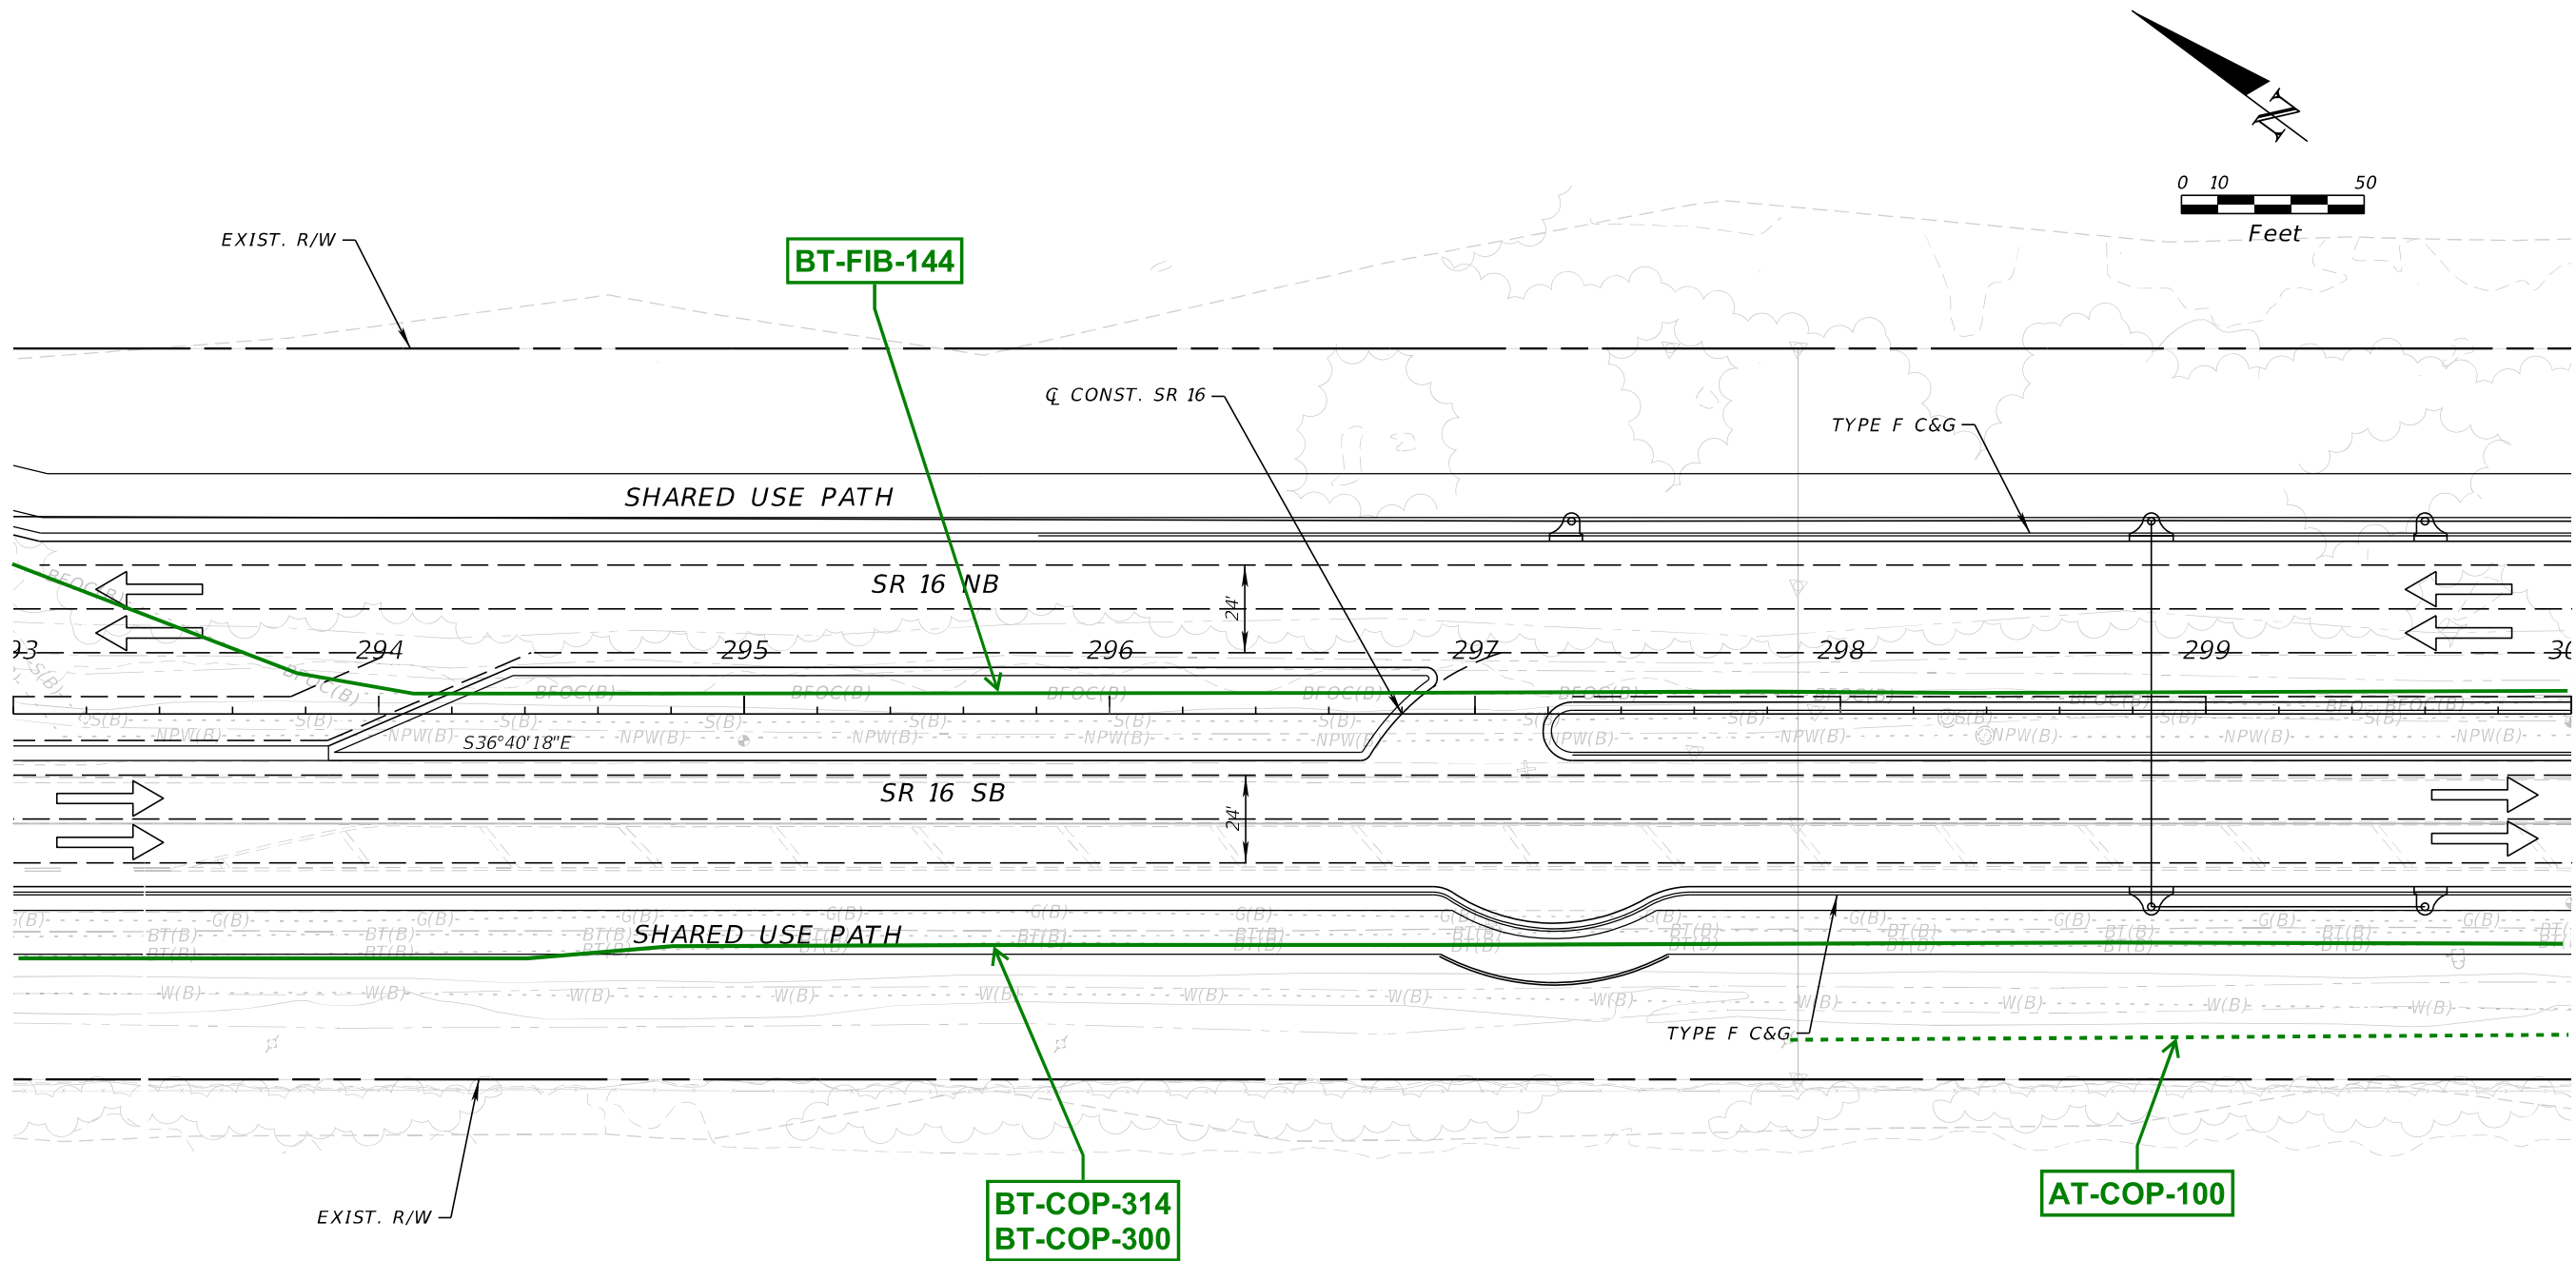


| LEGEND |                 |
|--------|-----------------|
| .....  | AERIAL AT&T     |
| ———    | BURIED AT&T     |
| ◆      | AT&T PEDESTAL   |
| □      | AT&T MANHOLE    |
| ○      | AT&T OWNED POLE |

| REVISIONS |             | ENGINEER OF RECORD |                                                                                                                           | STATE OF FLORIDA<br>DEPARTMENT OF TRANSPORTATION |           |                      | SHEET<br>NO.          |
|-----------|-------------|--------------------|---------------------------------------------------------------------------------------------------------------------------|--------------------------------------------------|-----------|----------------------|-----------------------|
| DATE      | DESCRIPTION | DATE               | DESCRIPTION                                                                                                               | ROAD NO.                                         | COUNTY    | FINANCIAL PROJECT ID |                       |
|           |             |                    | STEPHEN J. PARK, P.E.<br>LICENSE NUMBER: 77656<br>RS&H, INC.<br>10748 DEERWOOD PARK BLVD. SOUTH<br>JACKSONVILLE, FL 32256 | SR 16                                            | ST. JOHNS | 210447-5-52-01       | 11x17<br>Plan<br>Only |

THE OFFICIAL RECORD OF THIS SHEET IS THE ELECTRONIC FILE DIGITALLY SIGNED AND SEALED UNDER RULE 61G15-23.004, F.A.C.

8/5/2024 4:28:56 PM BeattyM  
c:\pw\_work\ysh\_pw\pw\_user\00439575\PLANRD01.dgn

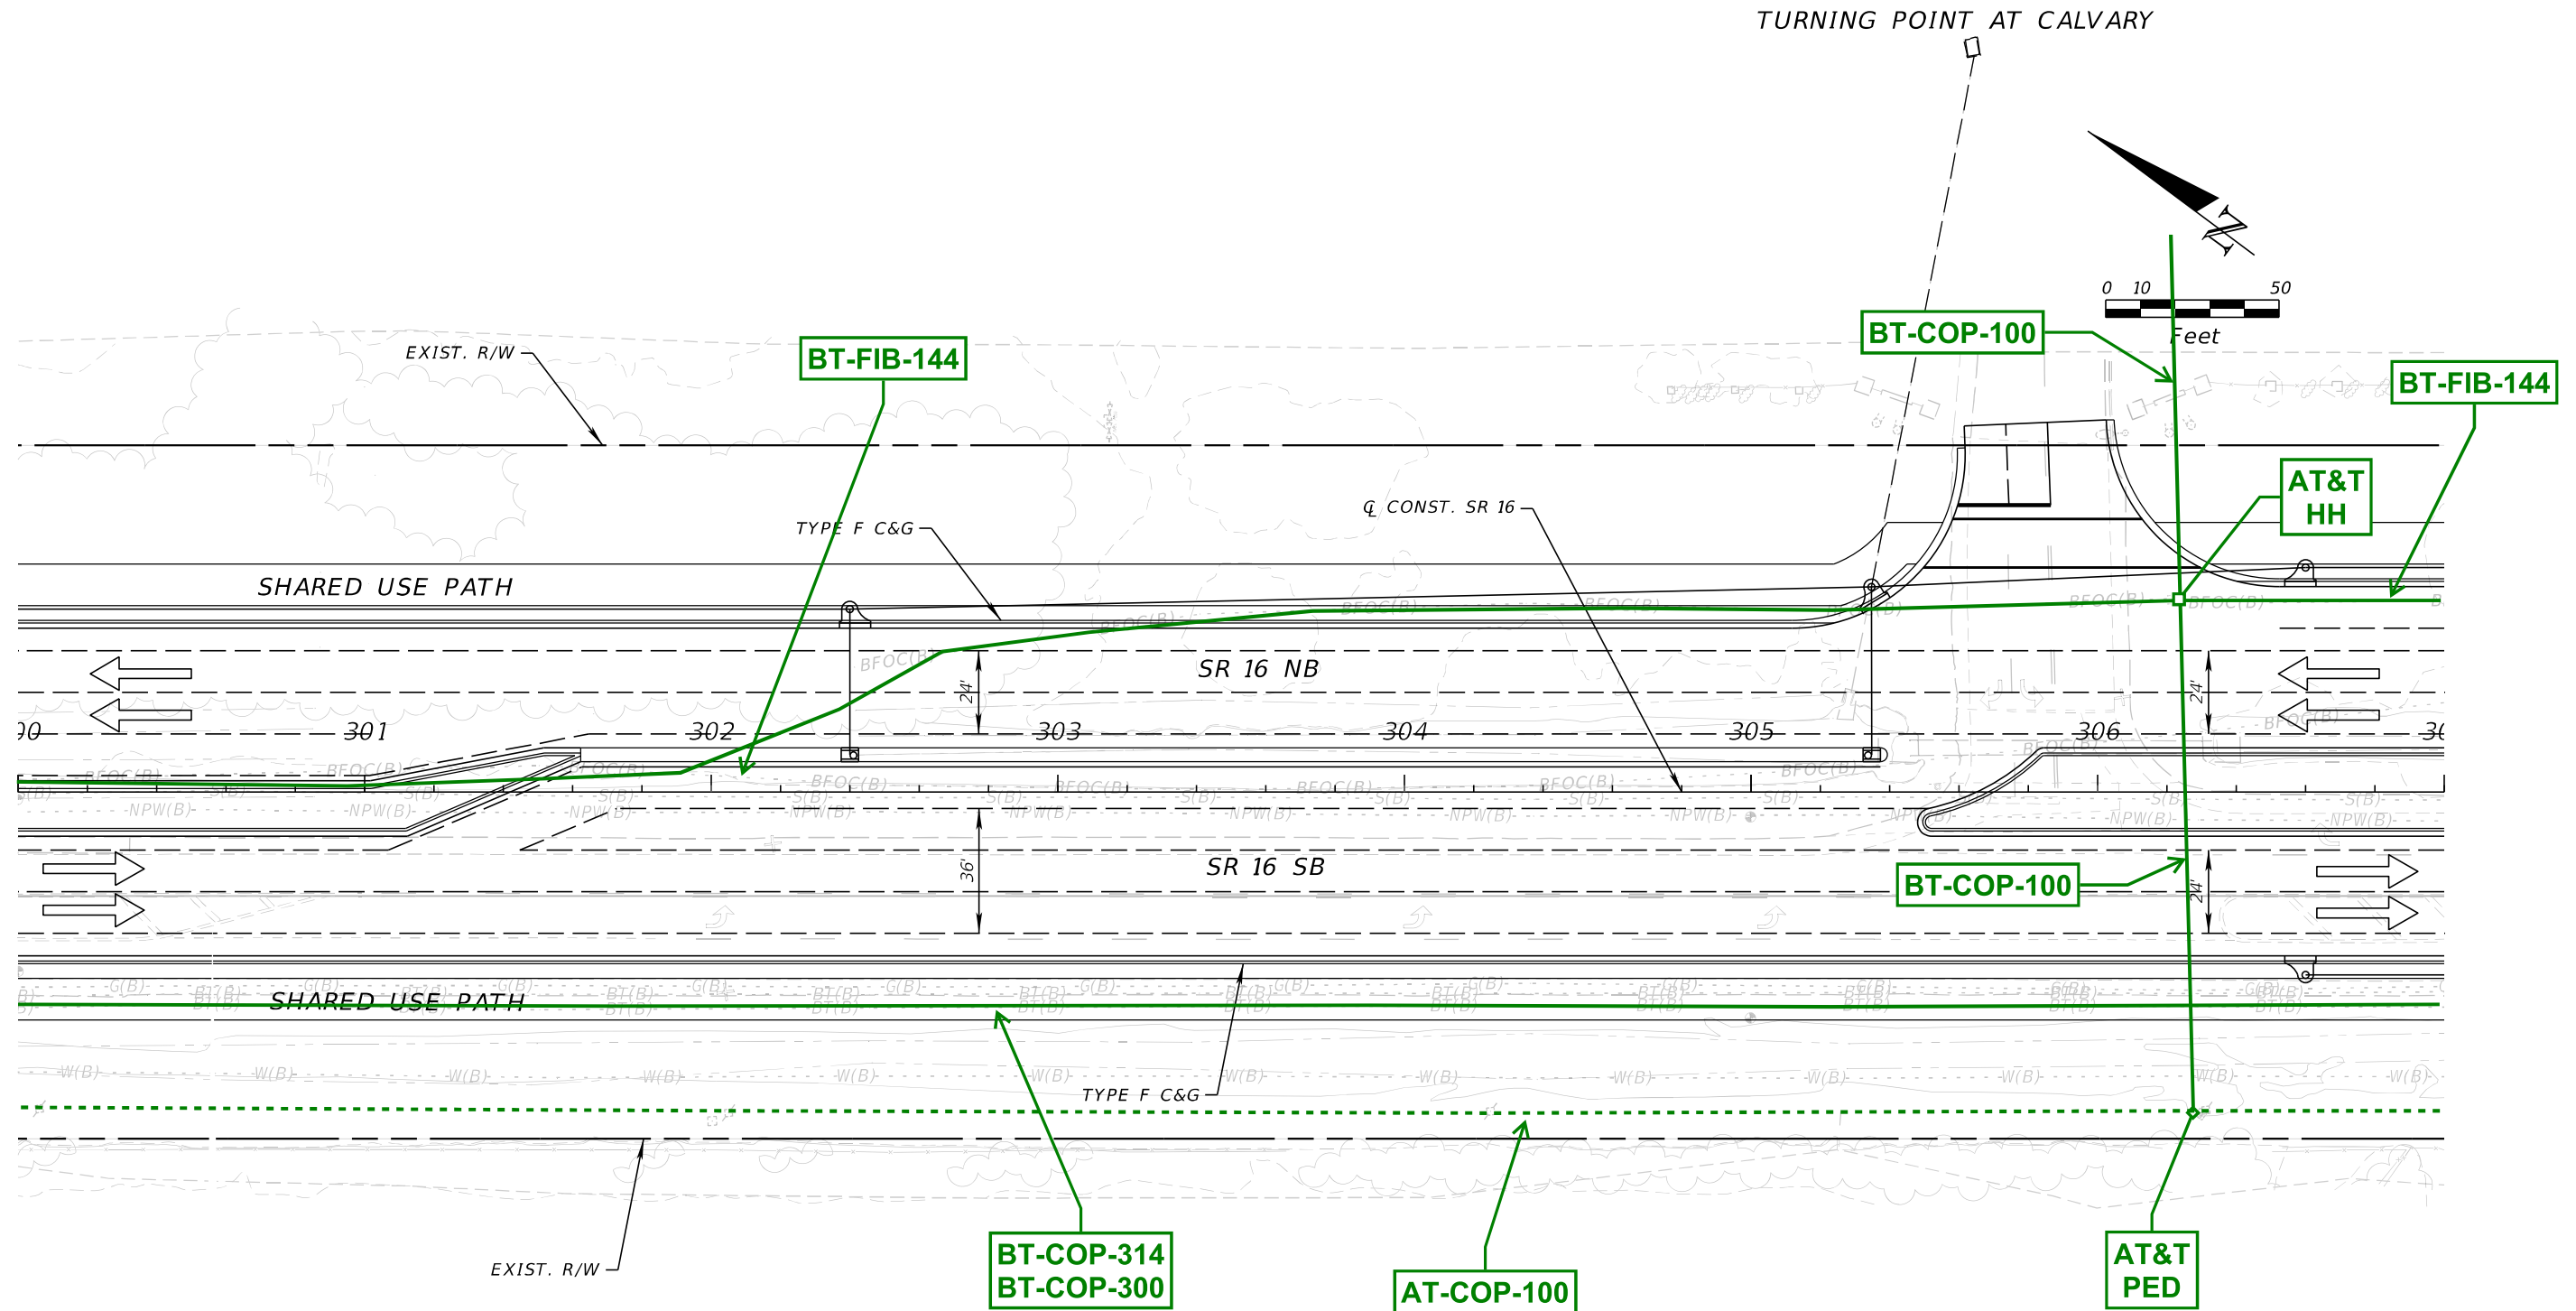


| LEGEND |                 |  |  |  |
|--------|-----------------|--|--|--|
| .....  | AERIAL AT&T     |  |  |  |
| ———    | BURIED AT&T     |  |  |  |
| ◇      | AT&T PEDESTAL   |  |  |  |
| □      | AT&T MANHOLE    |  |  |  |
| ○      | AT&T OWNED POLE |  |  |  |

| REVISIONS                                                                                                                 |             | ENGINEER OF RECORD |             | STATE OF FLORIDA<br>DEPARTMENT OF TRANSPORTATION |           |                      | SHEET<br>NO.          |
|---------------------------------------------------------------------------------------------------------------------------|-------------|--------------------|-------------|--------------------------------------------------|-----------|----------------------|-----------------------|
| DATE                                                                                                                      | DESCRIPTION | DATE               | DESCRIPTION | ROAD NO.                                         | COUNTY    | FINANCIAL PROJECT ID |                       |
|                                                                                                                           |             |                    |             | SR 16                                            | ST. JOHNS | 210447-5-52-01       |                       |
| STEPHEN J. PARK, P.E.<br>LICENSE NUMBER: 77656<br>RS&H, INC.<br>10748 DEERWOOD PARK BLVD. SOUTH<br>JACKSONVILLE, FL 32256 |             |                    |             |                                                  |           |                      | 11x17<br>Plan<br>Only |

THE OFFICIAL RECORD OF THIS SHEET IS THE ELECTRONIC FILE DIGITALLY SIGNED AND SEALED UNDER RULE 61G15-23.004, F.A.C.

8/5/2024 4:28:57 PM BeattyM  
c:\pw\_work\sh\_pw\pw\_user\0439575\PLANRD01.dgn

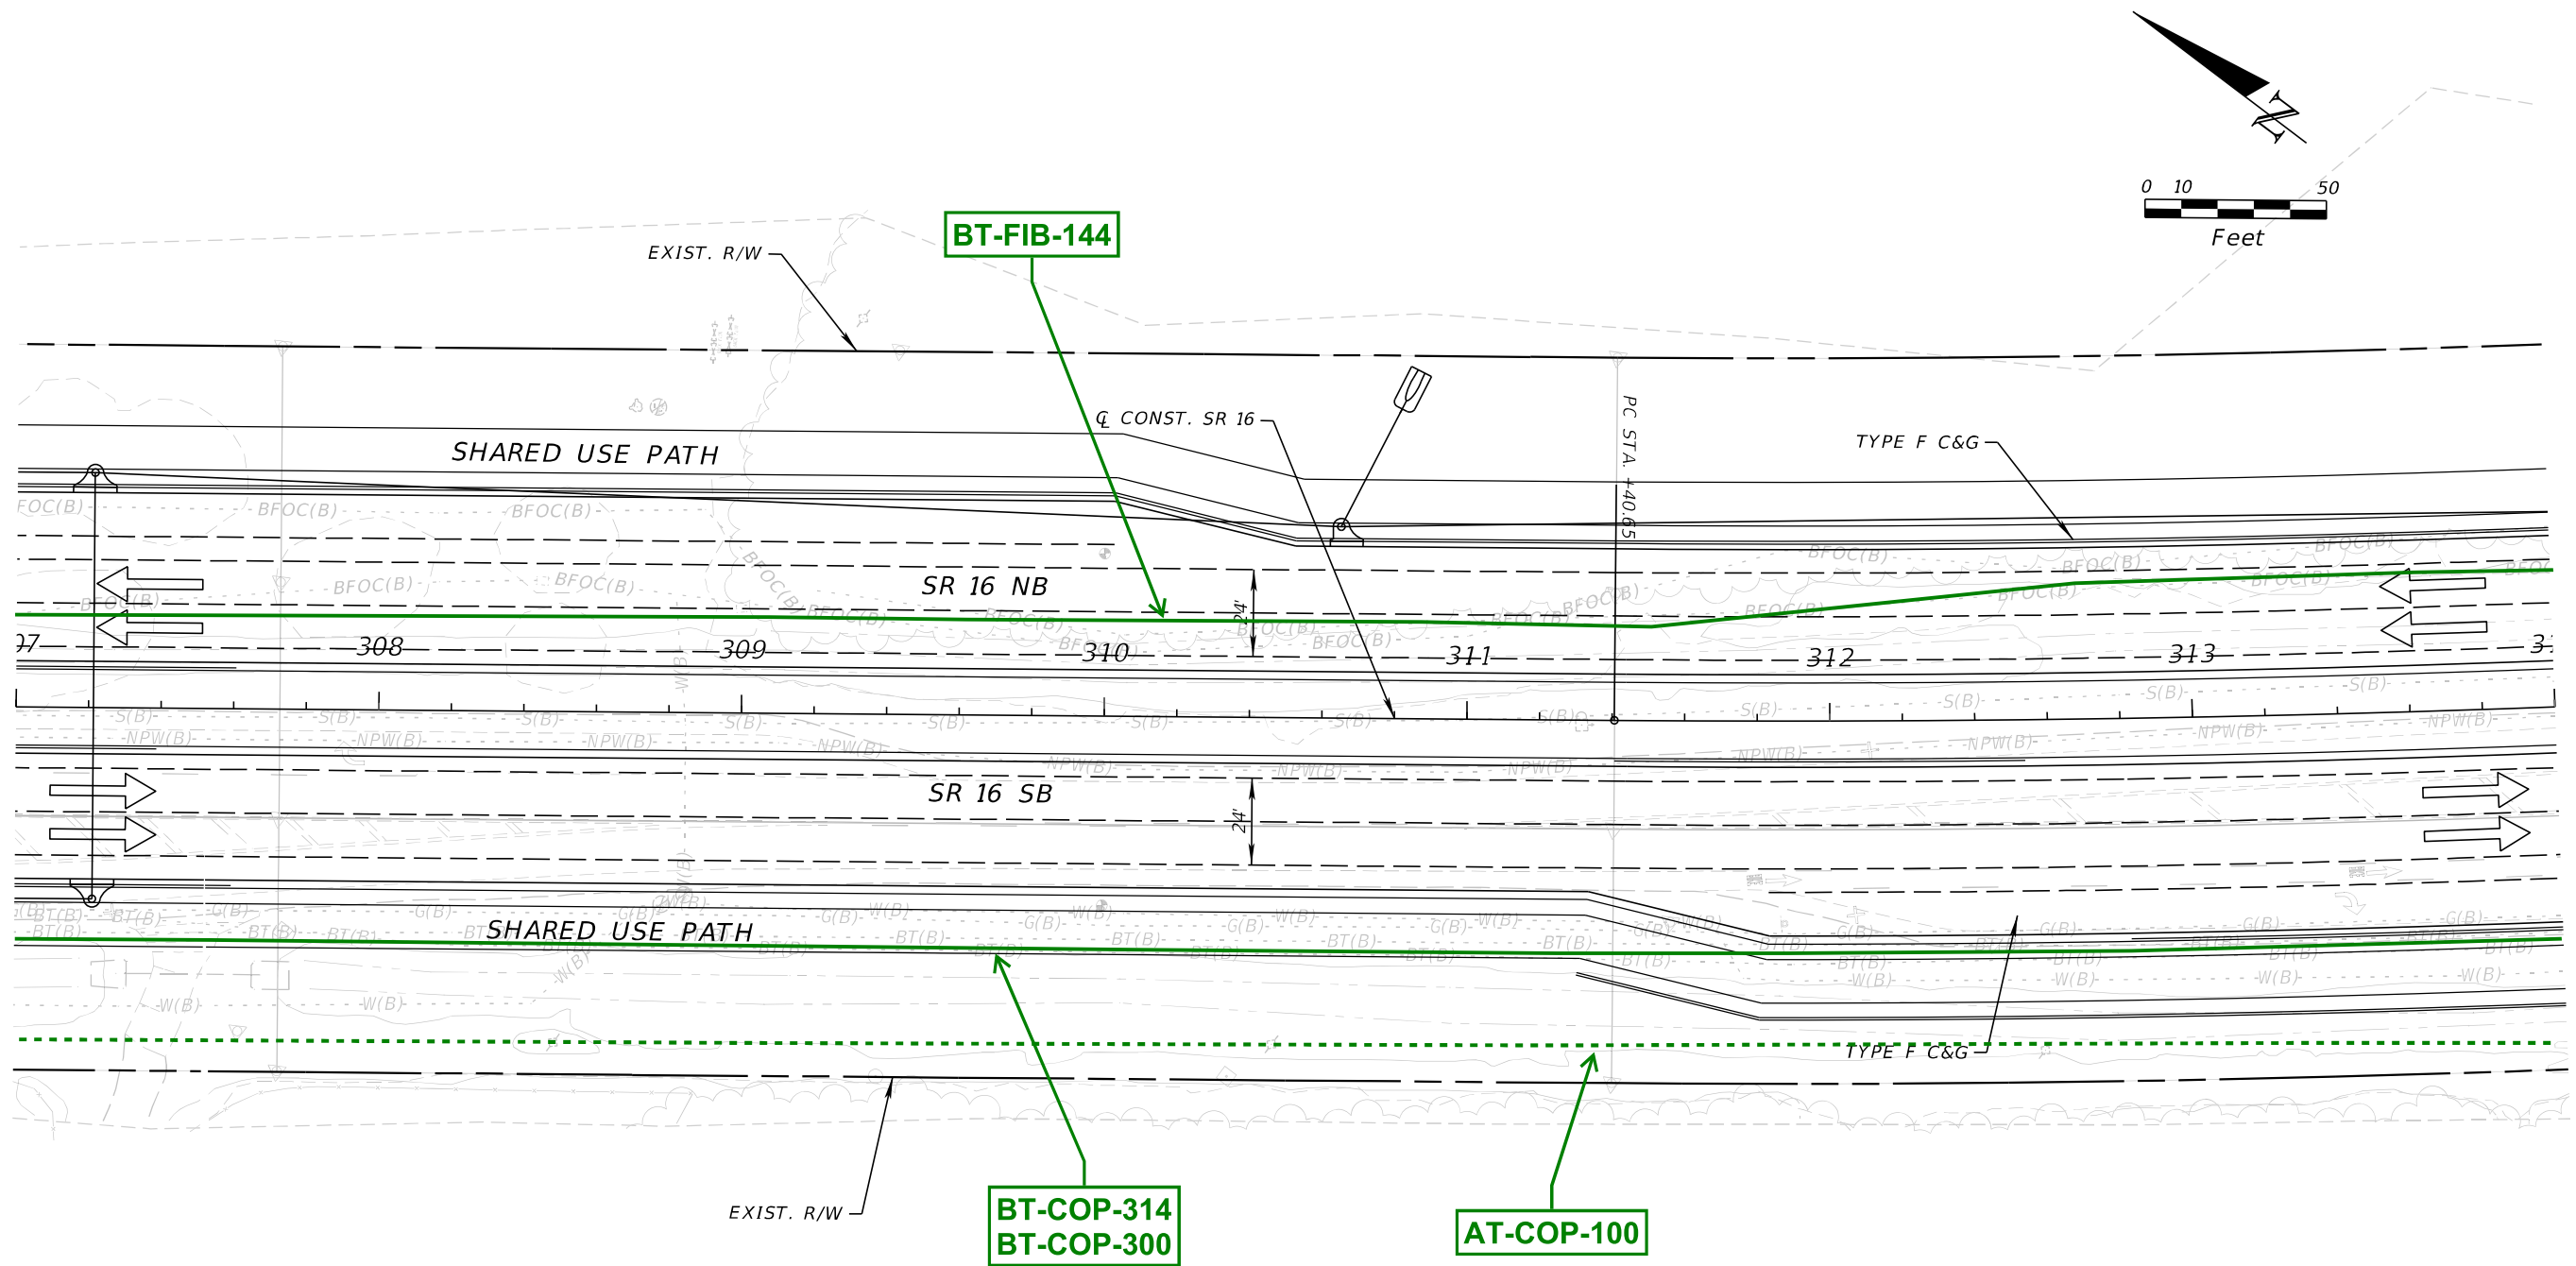


| LEGEND |                 |
|--------|-----------------|
| .....  | AERIAL AT&T     |
| ————   | BURIED AT&T     |
| ◆      | AT&T PEDESTAL   |
| □      | AT&T MANHOLE    |
| ○      | AT&T OWNED POLE |

| REVISIONS |             |      |             | ENGINEER OF RECORD                                                                                                        | STATE OF FLORIDA<br>DEPARTMENT OF TRANSPORTATION |           |                      | SHEET<br>NO.          |
|-----------|-------------|------|-------------|---------------------------------------------------------------------------------------------------------------------------|--------------------------------------------------|-----------|----------------------|-----------------------|
| DATE      | DESCRIPTION | DATE | DESCRIPTION |                                                                                                                           | ROAD NO.                                         | COUNTY    | FINANCIAL PROJECT ID |                       |
|           |             |      |             |                                                                                                                           | SR 16                                            | ST. JOHNS | 210447-5-52-01       |                       |
|           |             |      |             | STEPHEN J. PARK, P.E.<br>LICENSE NUMBER: 77656<br>RS&H, INC.<br>10748 DEERWOOD PARK BLVD. SOUTH<br>JACKSONVILLE, FL 32256 |                                                  |           |                      | 11x17<br>Plan<br>Only |

THE OFFICIAL RECORD OF THIS SHEET IS THE ELECTRONIC FILE DIGITALLY SIGNED AND SEALED UNDER RULE 61G15-23.004, F.A.C.



8/5/2024 4:28:57 PM BeattyM  
c:\pw\_work\ysh\_pw\pw\_user\0439575\PLAINRD01.dgn

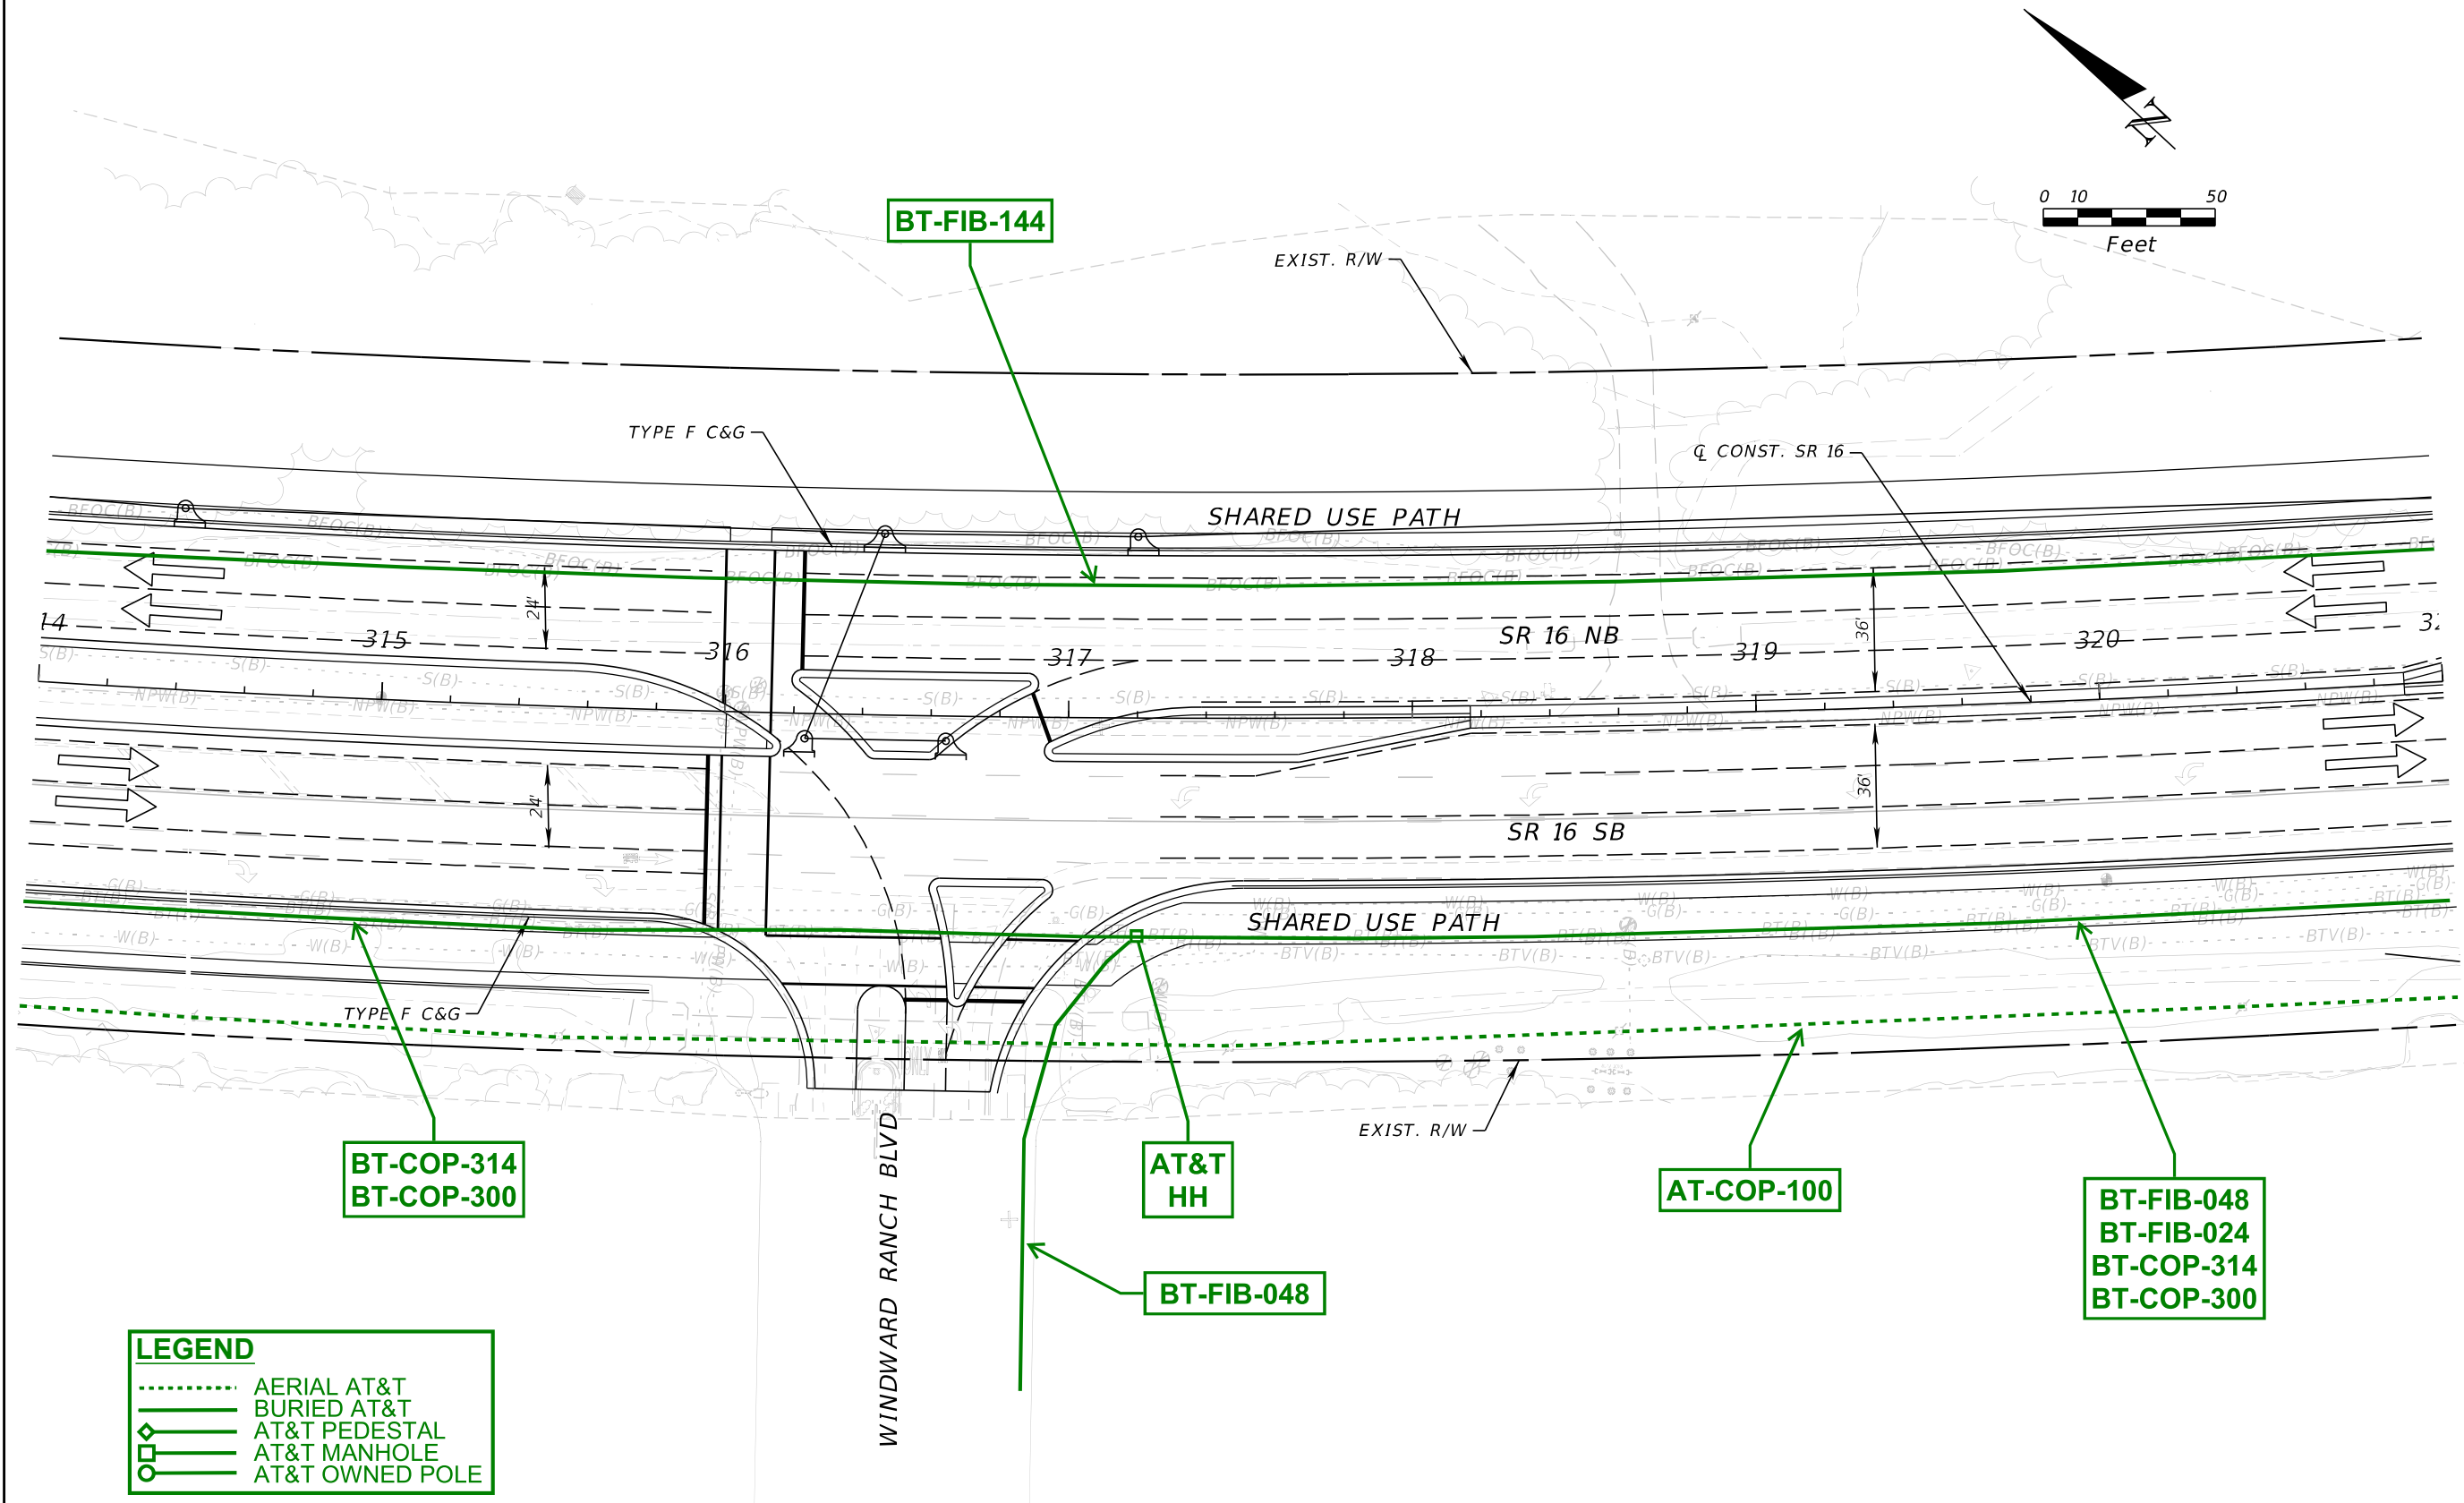

| LEGEND |                 |  |  |
|--------|-----------------|--|--|
| .....  | AERIAL AT&T     |  |  |
| ————   | BURIED AT&T     |  |  |
| ◇      | AT&T PEDESTAL   |  |  |
| □      | AT&T MANHOLE    |  |  |
| ○      | AT&T OWNED POLE |  |  |

| REVISIONS |             | ENGINEER OF RECORD |                                                                                                                           | STATE OF FLORIDA<br>DEPARTMENT OF TRANSPORTATION |           |                      | SHEET<br>NO.          |
|-----------|-------------|--------------------|---------------------------------------------------------------------------------------------------------------------------|--------------------------------------------------|-----------|----------------------|-----------------------|
| DATE      | DESCRIPTION | DATE               | DESCRIPTION                                                                                                               | ROAD NO.                                         | COUNTY    | FINANCIAL PROJECT ID |                       |
|           |             |                    | STEPHEN J. PARK, P.E.<br>LICENSE NUMBER: 77656<br>RS&H, INC.<br>10748 DEERWOOD PARK BLVD. SOUTH<br>JACKSONVILLE, FL 32256 | SR 16                                            | ST. JOHNS | 210447-5-52-01       | 11x17<br>Plan<br>Only |

THE OFFICIAL RECORD OF THIS SHEET IS THE ELECTRONIC FILE DIGITALLY SIGNED AND SEALED UNDER RULE 61G15-23.004, F.A.C.

8/5/2024 4:28:58 PM BeattyM  
c:\pw\_work\ysh\_pw\pw\_user\0439575\PLANRD01.dgn

CURVE DATA  
PI STA. = 321+12.24  
Δ = 19°20'48" (LT)  
D = 01°00'19"  
T = 971.59  
L = 1,924.68  
R = 1,924.68  
PC STA. = 311+40.65  
PT STA. = 321+15.33

BT-FIB-144

BT-FIB-144  
BT-FIB-024

AT&T  
HH

AT&T DUCTBANK  
1-4" PVC DUCT

BT-FIB-024

AT&T DUCTBANK  
1-4" PVC DUCT



BT-FIB-048  
BT-FIB-024  
BT-COP-314  
BT-COP-300

AT-COP-100

BT-FIB-048  
BT-COP-314  
BT-COP-300



#### LEGEND

- ..... AERIAL AT&T
- BURIED AT&T
- ◇ AT&T PEDESTAL
- AT&T MANHOLE
- AT&T OWNED POLE

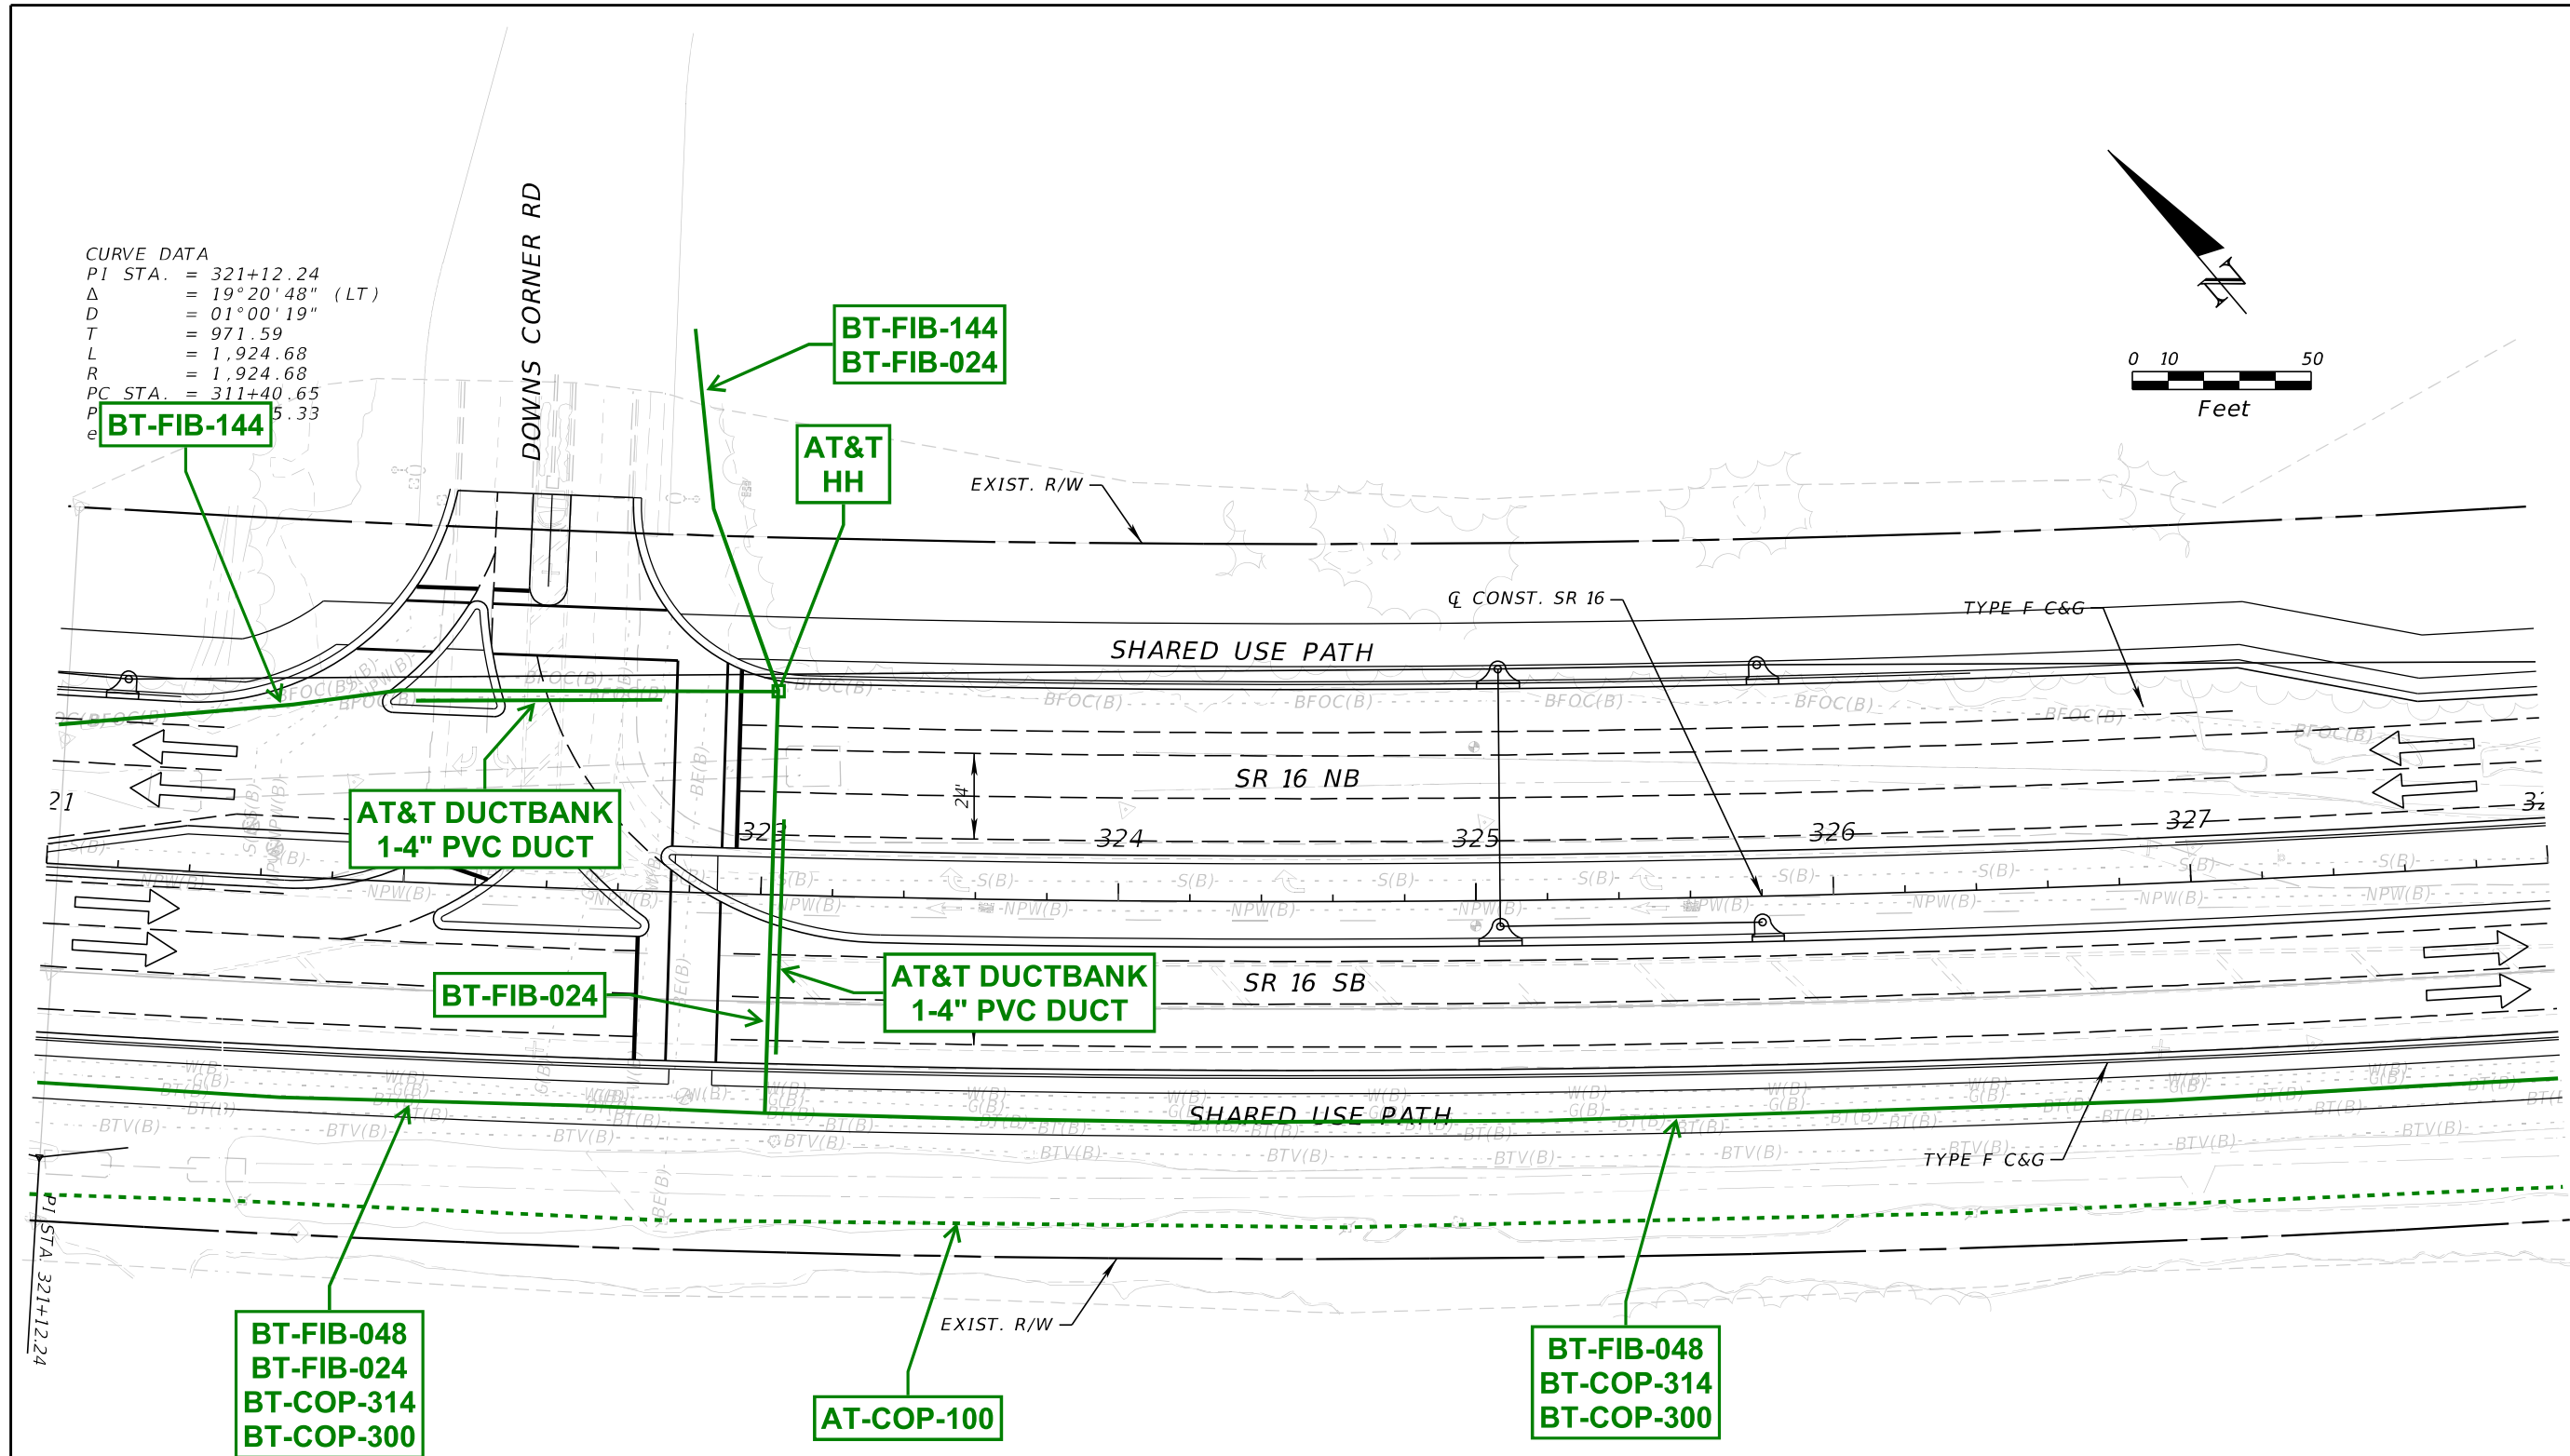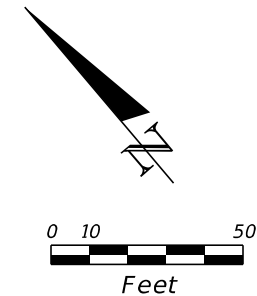

| DATE |  | REVISIONS   |      | ENGINEER OF RECORD                                                                                                        | STATE OF FLORIDA<br>DEPARTMENT OF TRANSPORTATION |           |                      | SHEET<br>NO.          |
|------|--|-------------|------|---------------------------------------------------------------------------------------------------------------------------|--------------------------------------------------|-----------|----------------------|-----------------------|
|      |  | DESCRIPTION | DATE |                                                                                                                           | ROAD NO.                                         | COUNTY    | FINANCIAL PROJECT ID |                       |
|      |  |             |      | STEPHEN J. PARK, P.E.<br>LICENSE NUMBER: 77656<br>RS&H, INC.<br>10748 DEERWOOD PARK BLVD. SOUTH<br>JACKSONVILLE, FL 32256 | SR 16                                            | ST. JOHNS | 210447-5-52-01       | 11x17<br>Plan<br>Only |

8/5/2024 4:28:59 PM BeattyM  
c:\pw\_work\ysh\_pw\pw\_user\40439575\PLANRD01.dgn

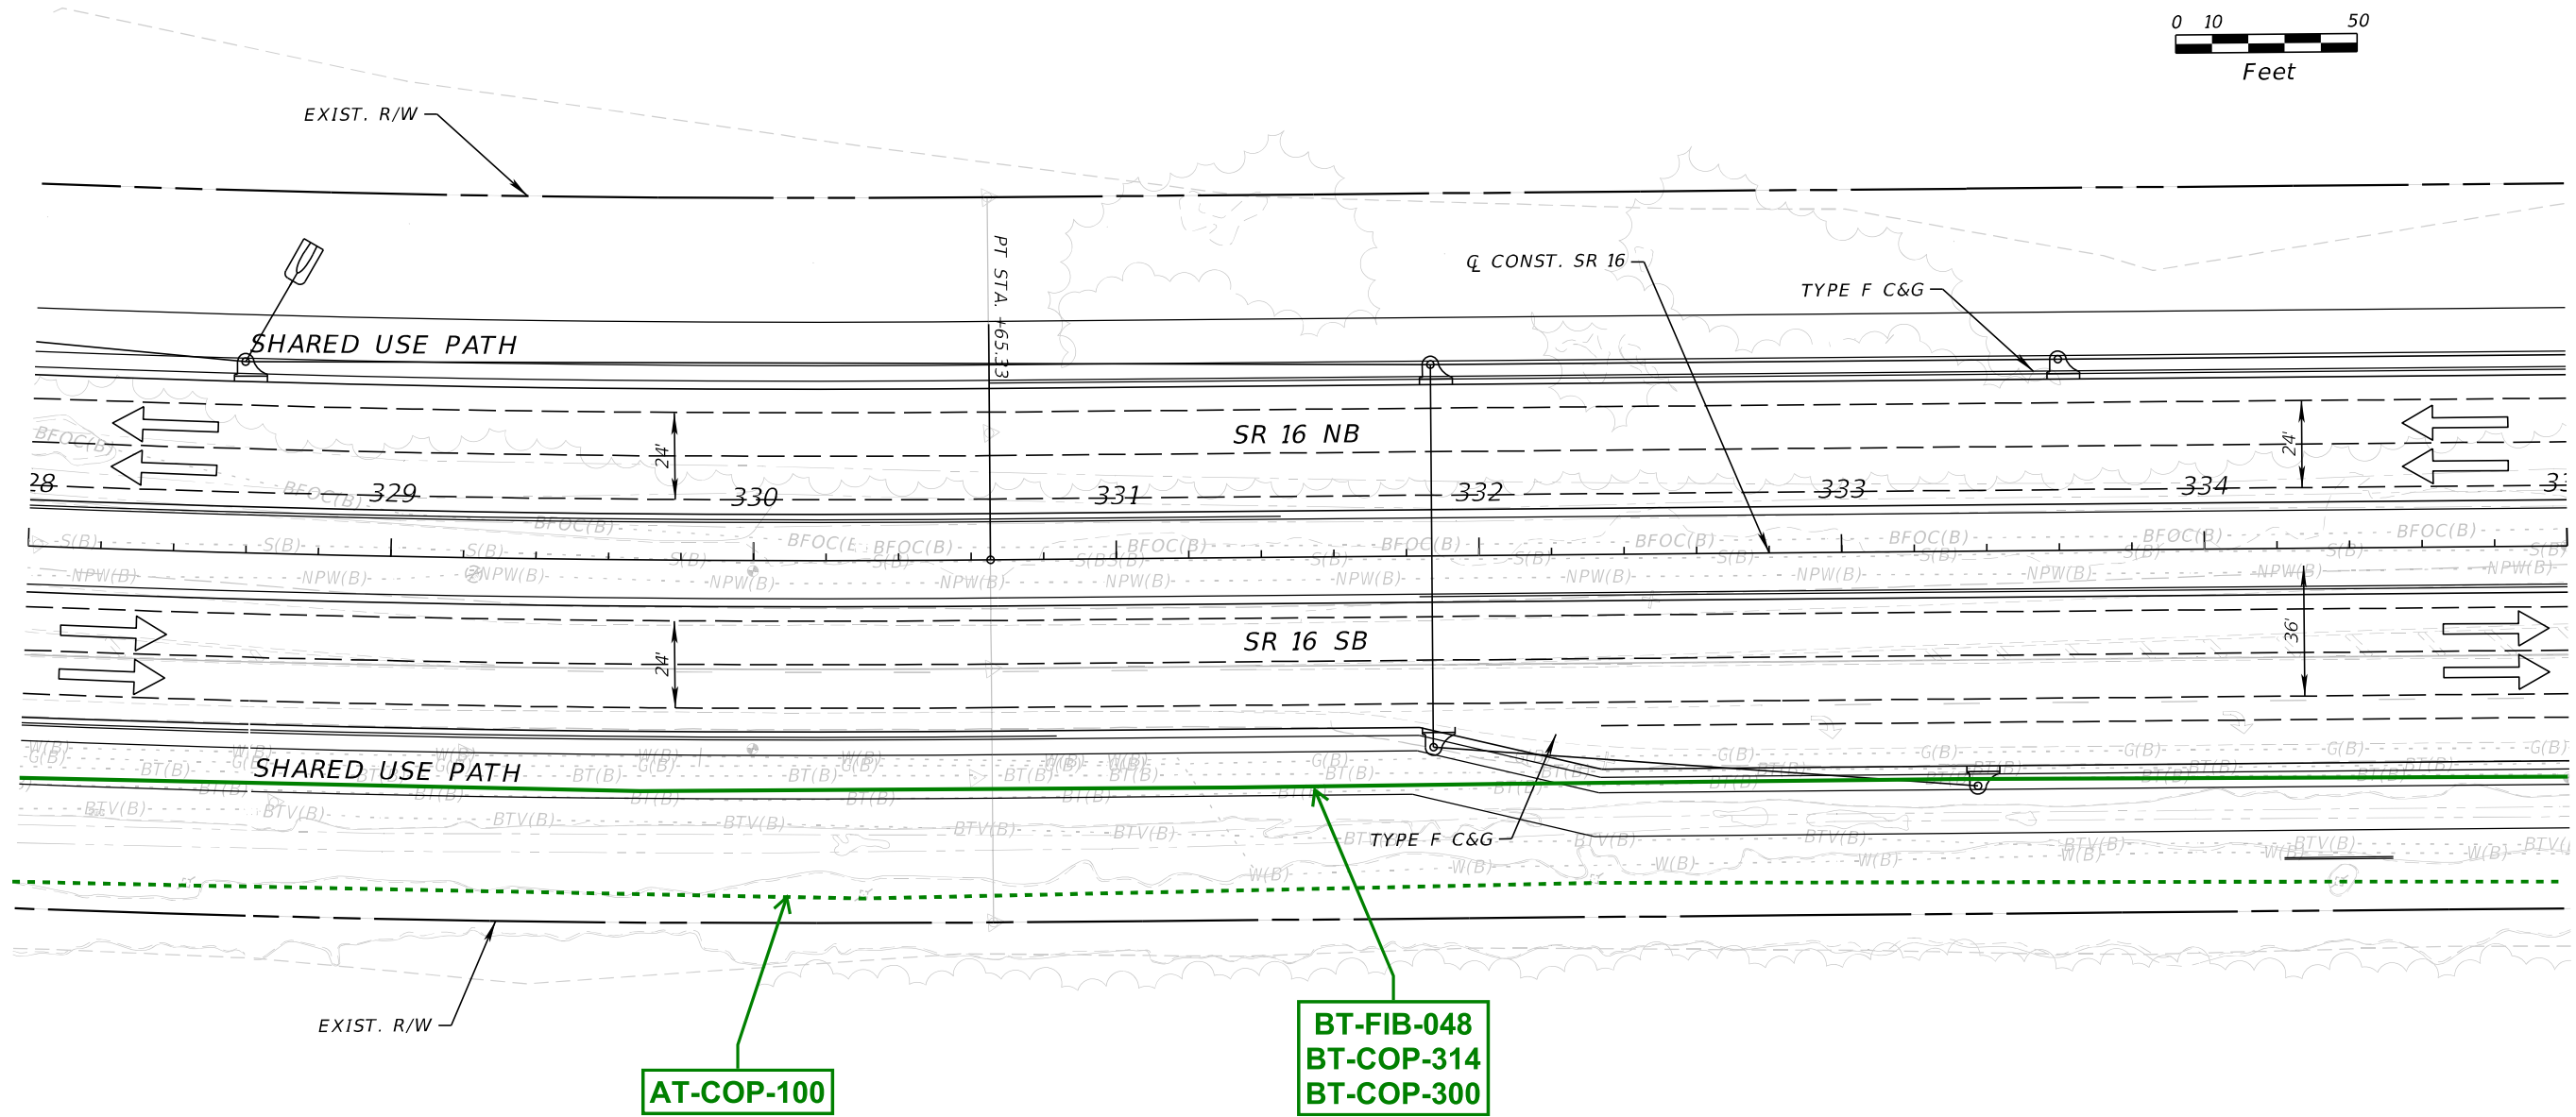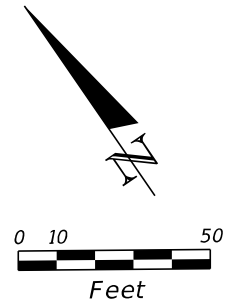


| LEGEND |                 |  |  |  |
|--------|-----------------|--|--|--|
| .....  | AERIAL AT&T     |  |  |  |
| ————   | BURIED AT&T     |  |  |  |
| ◇      | AT&T PEDESTAL   |  |  |  |
| □      | AT&T MANHOLE    |  |  |  |
| ○      | AT&T OWNED POLE |  |  |  |

| DATE |  | REVISIONS |  | DESCRIPTION |  | ENGINEER OF RECORD                                                                                                        |  | STATE OF FLORIDA<br>DEPARTMENT OF TRANSPORTATION |           |                      | SHEET<br>NO. |
|------|--|-----------|--|-------------|--|---------------------------------------------------------------------------------------------------------------------------|--|--------------------------------------------------|-----------|----------------------|--------------|
| DATE |  | REVISIONS |  | DESCRIPTION |  | STEPHEN J. PARK, P.E.<br>LICENSE NUMBER: 77656<br>RS&H, INC.<br>10748 DEERWOOD PARK BLVD. SOUTH<br>JACKSONVILLE, FL 32256 |  | ROAD NO.                                         | COUNTY    | FINANCIAL PROJECT ID |              |
|      |  |           |  |             |  |                                                                                                                           |  | SR 16                                            | ST. JOHNS | 210447-5-52-01       |              |

11x17  
Plan  
Only

8/5/2024 4:28:59 PM BeattyM  
c:\pw\_work\ysh\_pw\pw\_user\q0439575\PLANRD01.dgn

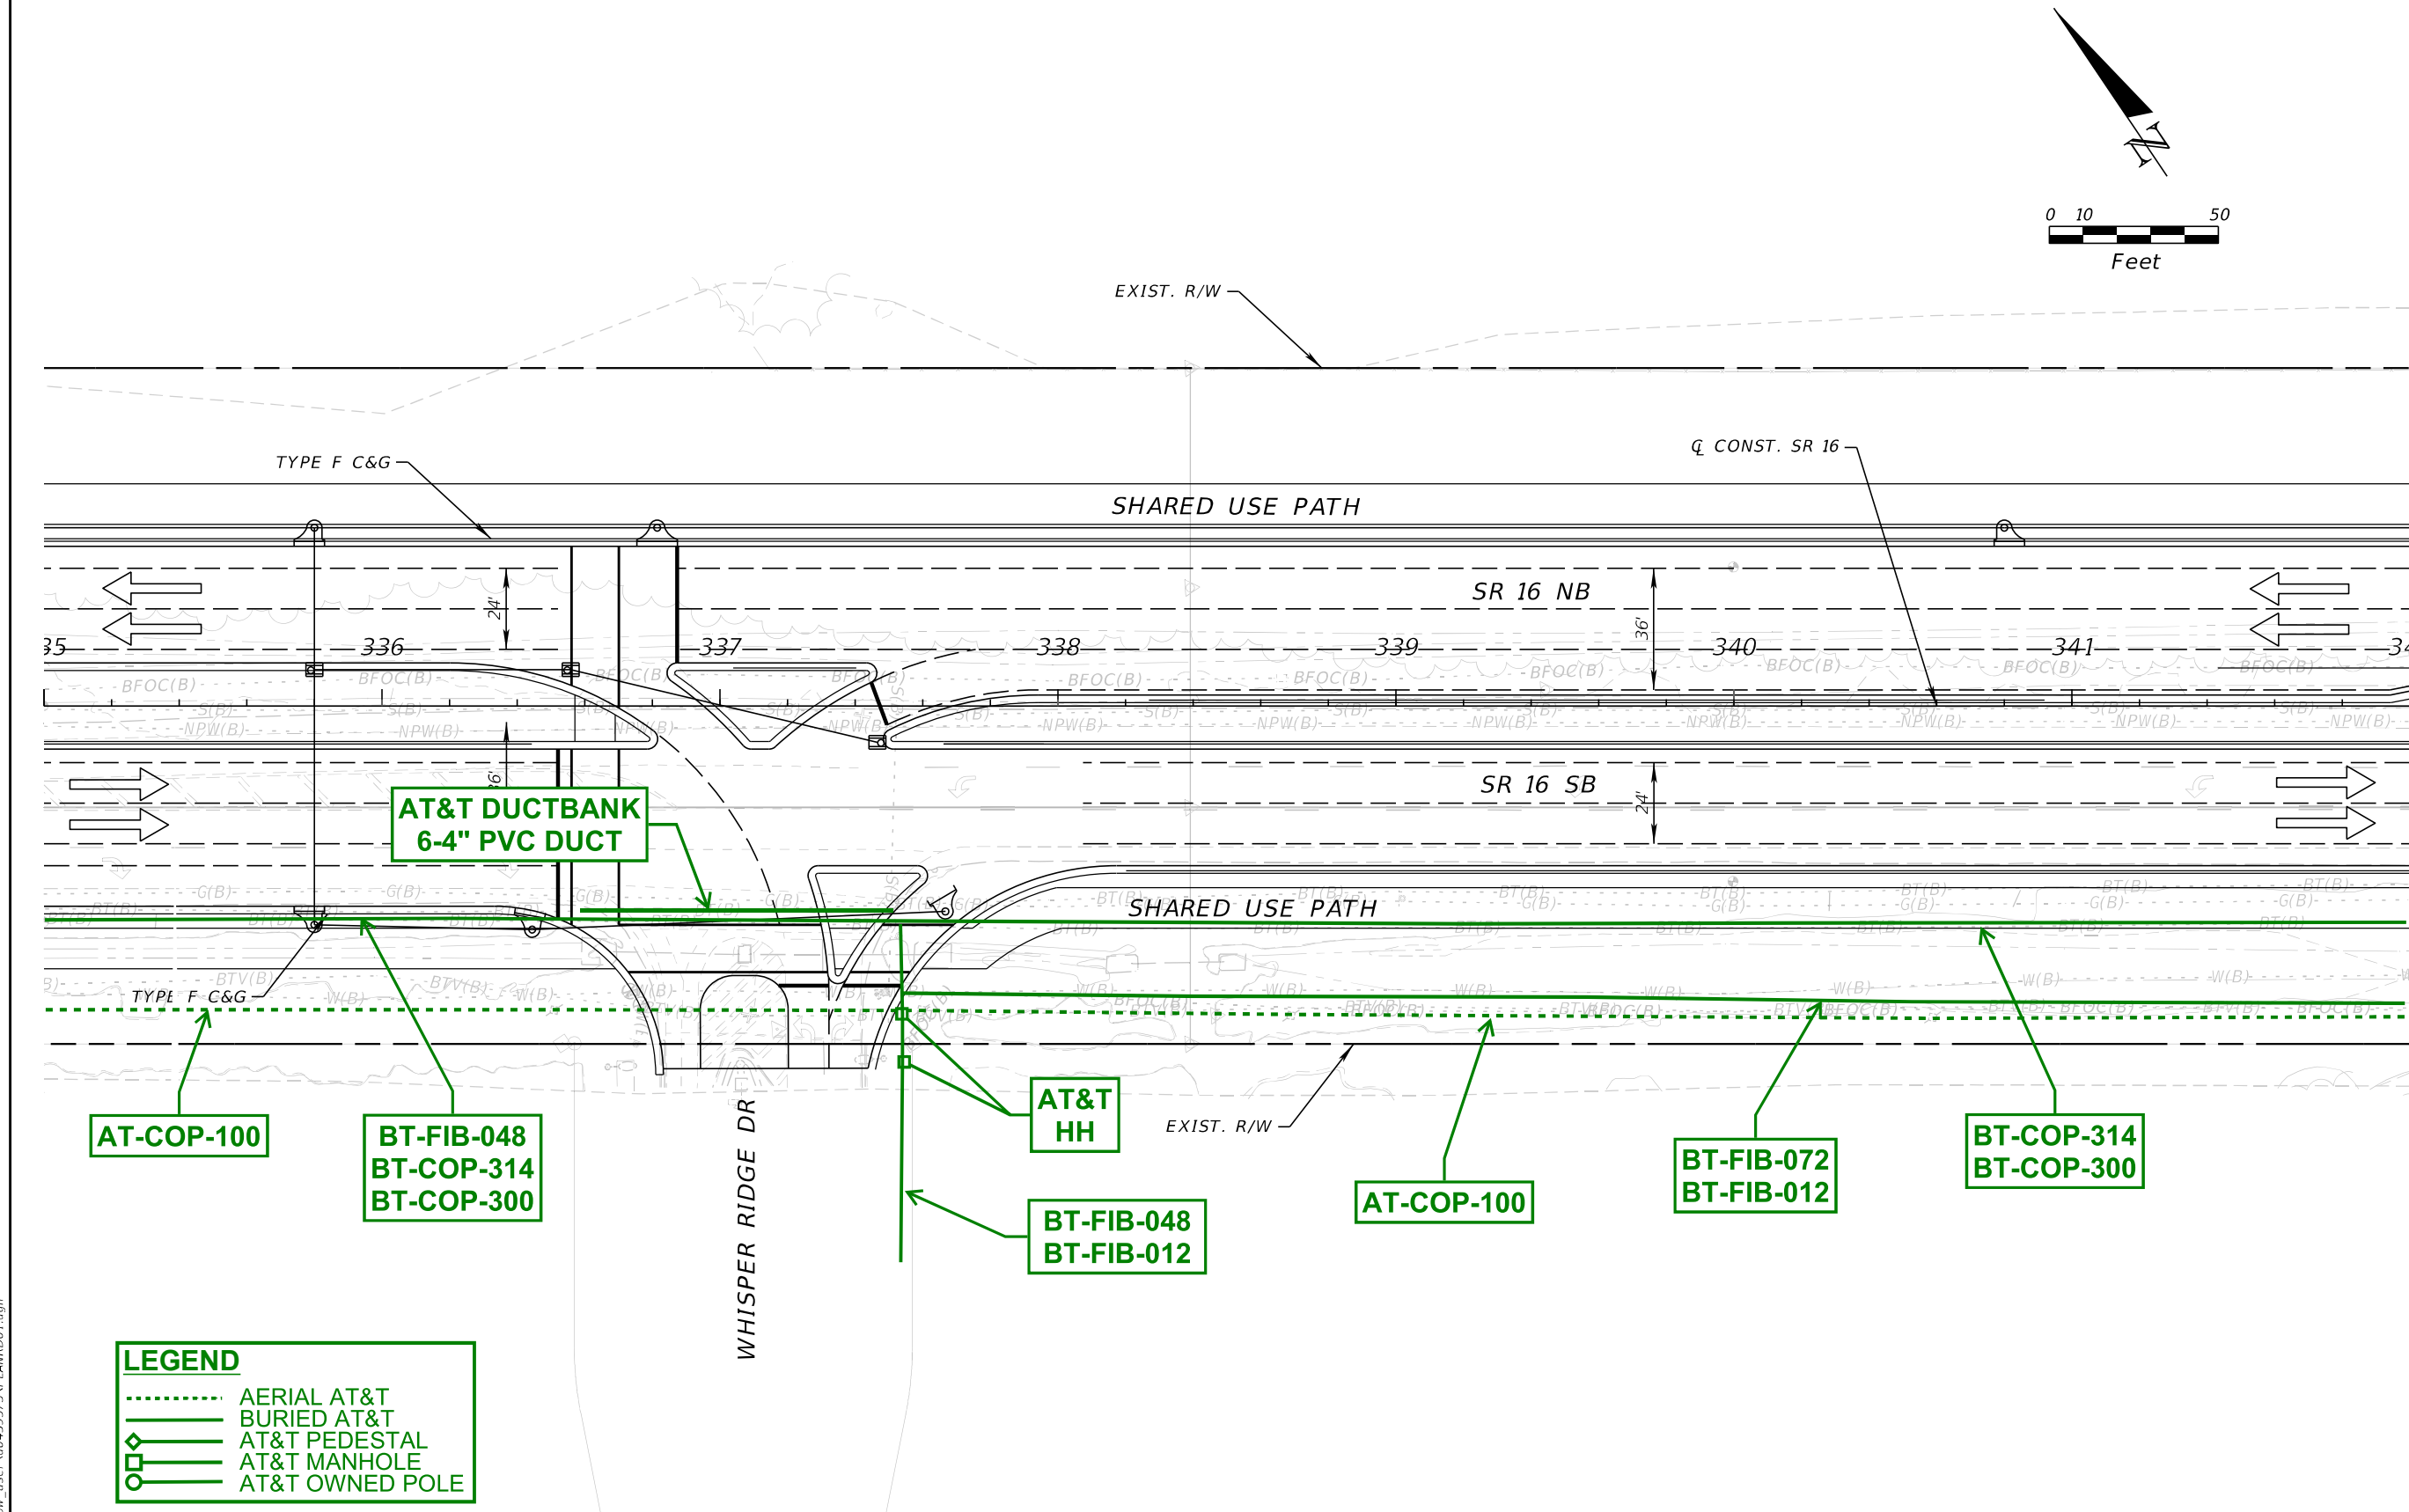


| LEGEND |                 |  |  |  |
|--------|-----------------|--|--|--|
| .....  | AERIAL AT&T     |  |  |  |
| ——     | BURIED AT&T     |  |  |  |
| ◆      | AT&T PEDESTAL   |  |  |  |
| □      | AT&T MANHOLE    |  |  |  |
| ○      | AT&T OWNED POLE |  |  |  |

| REVISIONS |             |      |             | ENGINEER OF RECORD                                                                                                        | STATE OF FLORIDA<br>DEPARTMENT OF TRANSPORTATION |           |                      | SHEET<br>NO.          |
|-----------|-------------|------|-------------|---------------------------------------------------------------------------------------------------------------------------|--------------------------------------------------|-----------|----------------------|-----------------------|
| DATE      | DESCRIPTION | DATE | DESCRIPTION |                                                                                                                           | ROAD NO.                                         | COUNTY    | FINANCIAL PROJECT ID |                       |
|           |             |      |             |                                                                                                                           | SR 16                                            | ST. JOHNS | 210447-5-52-01       |                       |
|           |             |      |             | STEPHEN J. PARK, P.E.<br>LICENSE NUMBER: 77656<br>RS&H, INC.<br>10748 DEERWOOD PARK BLVD. SOUTH<br>JACKSONVILLE, FL 32256 |                                                  |           |                      | 11x17<br>Plan<br>Only |

THE OFFICIAL RECORD OF THIS SHEET IS THE ELECTRONIC FILE DIGITALLY SIGNED AND SEALED UNDER RULE 61G15-23.004, F.A.C.

8/5/2024 4:29:00 PM BeattyM  
c:\pw\_work\ysh\_pw\pw\_user\0439575\PLANRD01.dgn

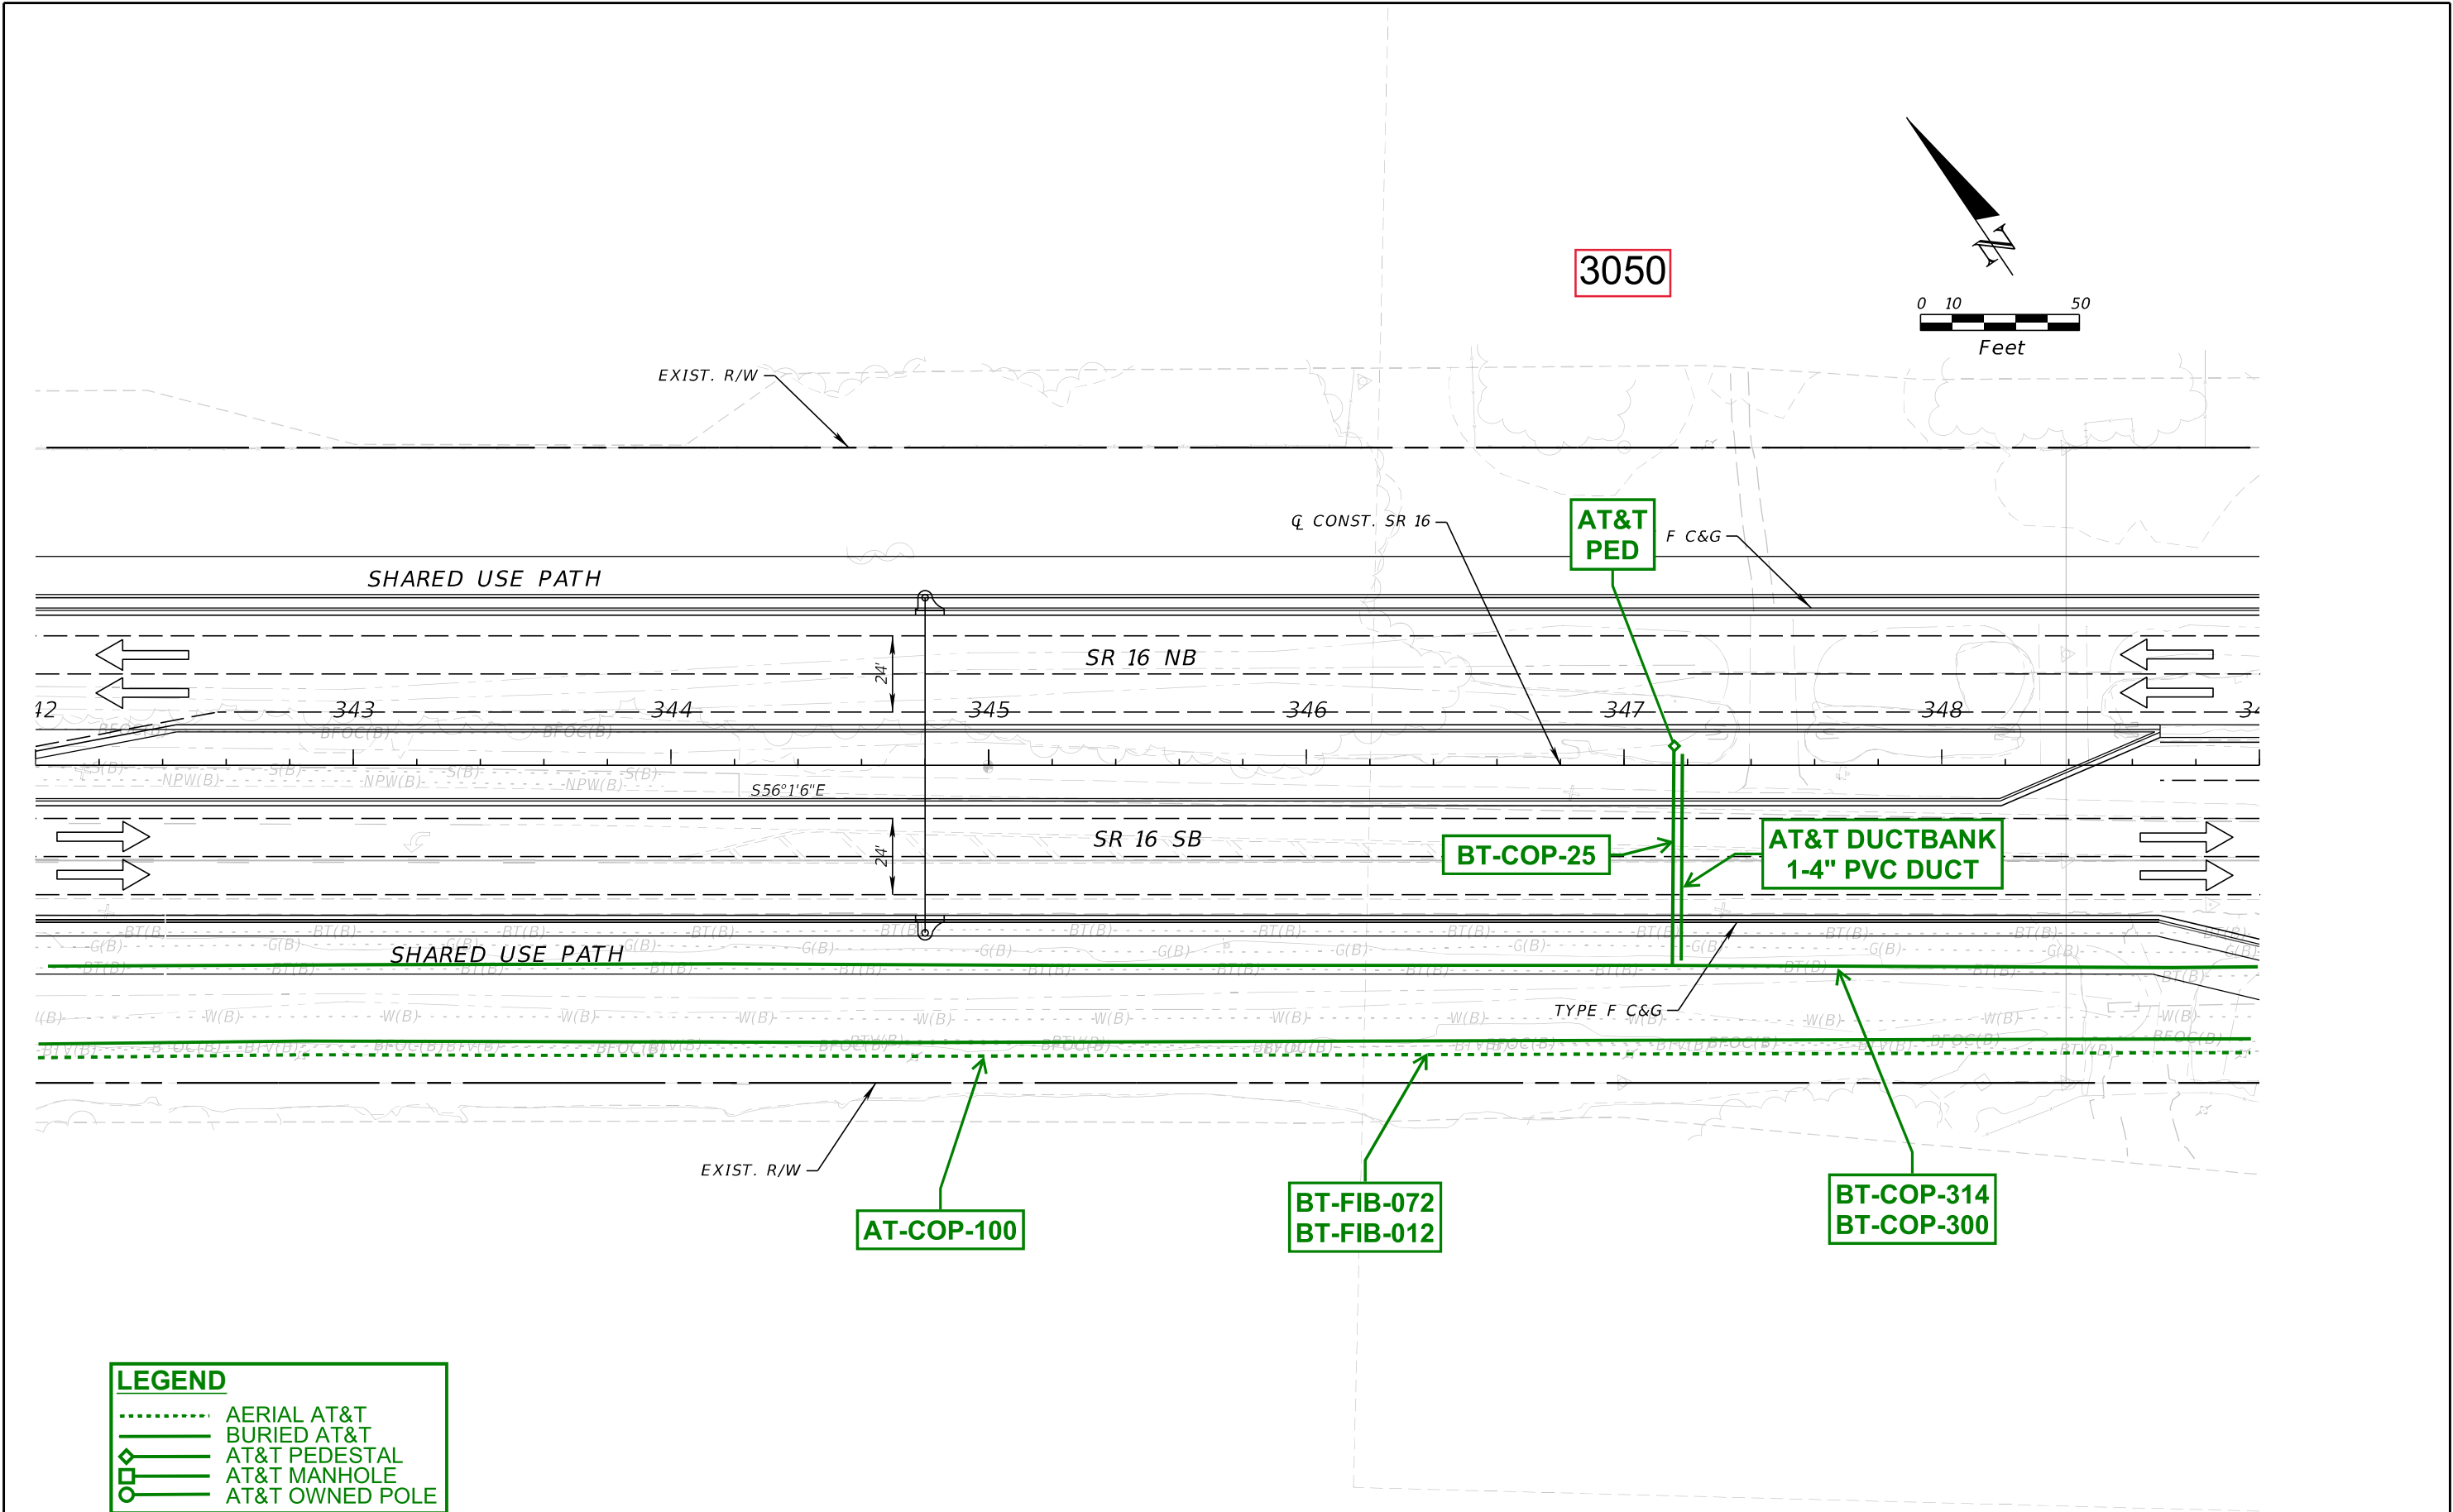

| LEGEND |                 |  |  |
|--------|-----------------|--|--|
| -----  | AERIAL AT&T     |  |  |
| ————   | BURIED AT&T     |  |  |
| ◆      | AT&T PEDESTAL   |  |  |
| □      | AT&T MANHOLE    |  |  |
| ○      | AT&T OWNED POLE |  |  |

|      |  | REVISIONS   |  |      |             | ENGINEER OF RECORD                                                                                                        | STATE OF FLORIDA<br>DEPARTMENT OF TRANSPORTATION |           |                      | SHEET<br>NO.          |
|------|--|-------------|--|------|-------------|---------------------------------------------------------------------------------------------------------------------------|--------------------------------------------------|-----------|----------------------|-----------------------|
| DATE |  | DESCRIPTION |  | DATE | DESCRIPTION | STEPHEN J. PARK, P.E.<br>LICENSE NUMBER: 77656<br>RS&H, INC.<br>10748 DEERWOOD PARK BLVD. SOUTH<br>JACKSONVILLE, FL 32256 |                                                  |           |                      |                       |
|      |  |             |  |      |             |                                                                                                                           |                                                  |           |                      |                       |
|      |  |             |  |      |             |                                                                                                                           | ROAD NO.                                         | COUNTY    | FINANCIAL PROJECT ID |                       |
|      |  |             |  |      |             |                                                                                                                           | SR 16                                            | ST. JOHNS | 210447-5-52-01       | 11x17<br>Plan<br>Only |



THE OFFICIAL RECORD OF THIS SHEET IS THE ELECTRONIC FILE DIGITALLY SIGNED AND SEALED UNDER RULE 61G15-23.004, F.A.C.



8/5/2024 4:29:01 PM BeattyM  
c:\pw\_work\sh\_pw\pw\_user\0439575\PLANRD01.dgn

TADPOLE PREP

2980

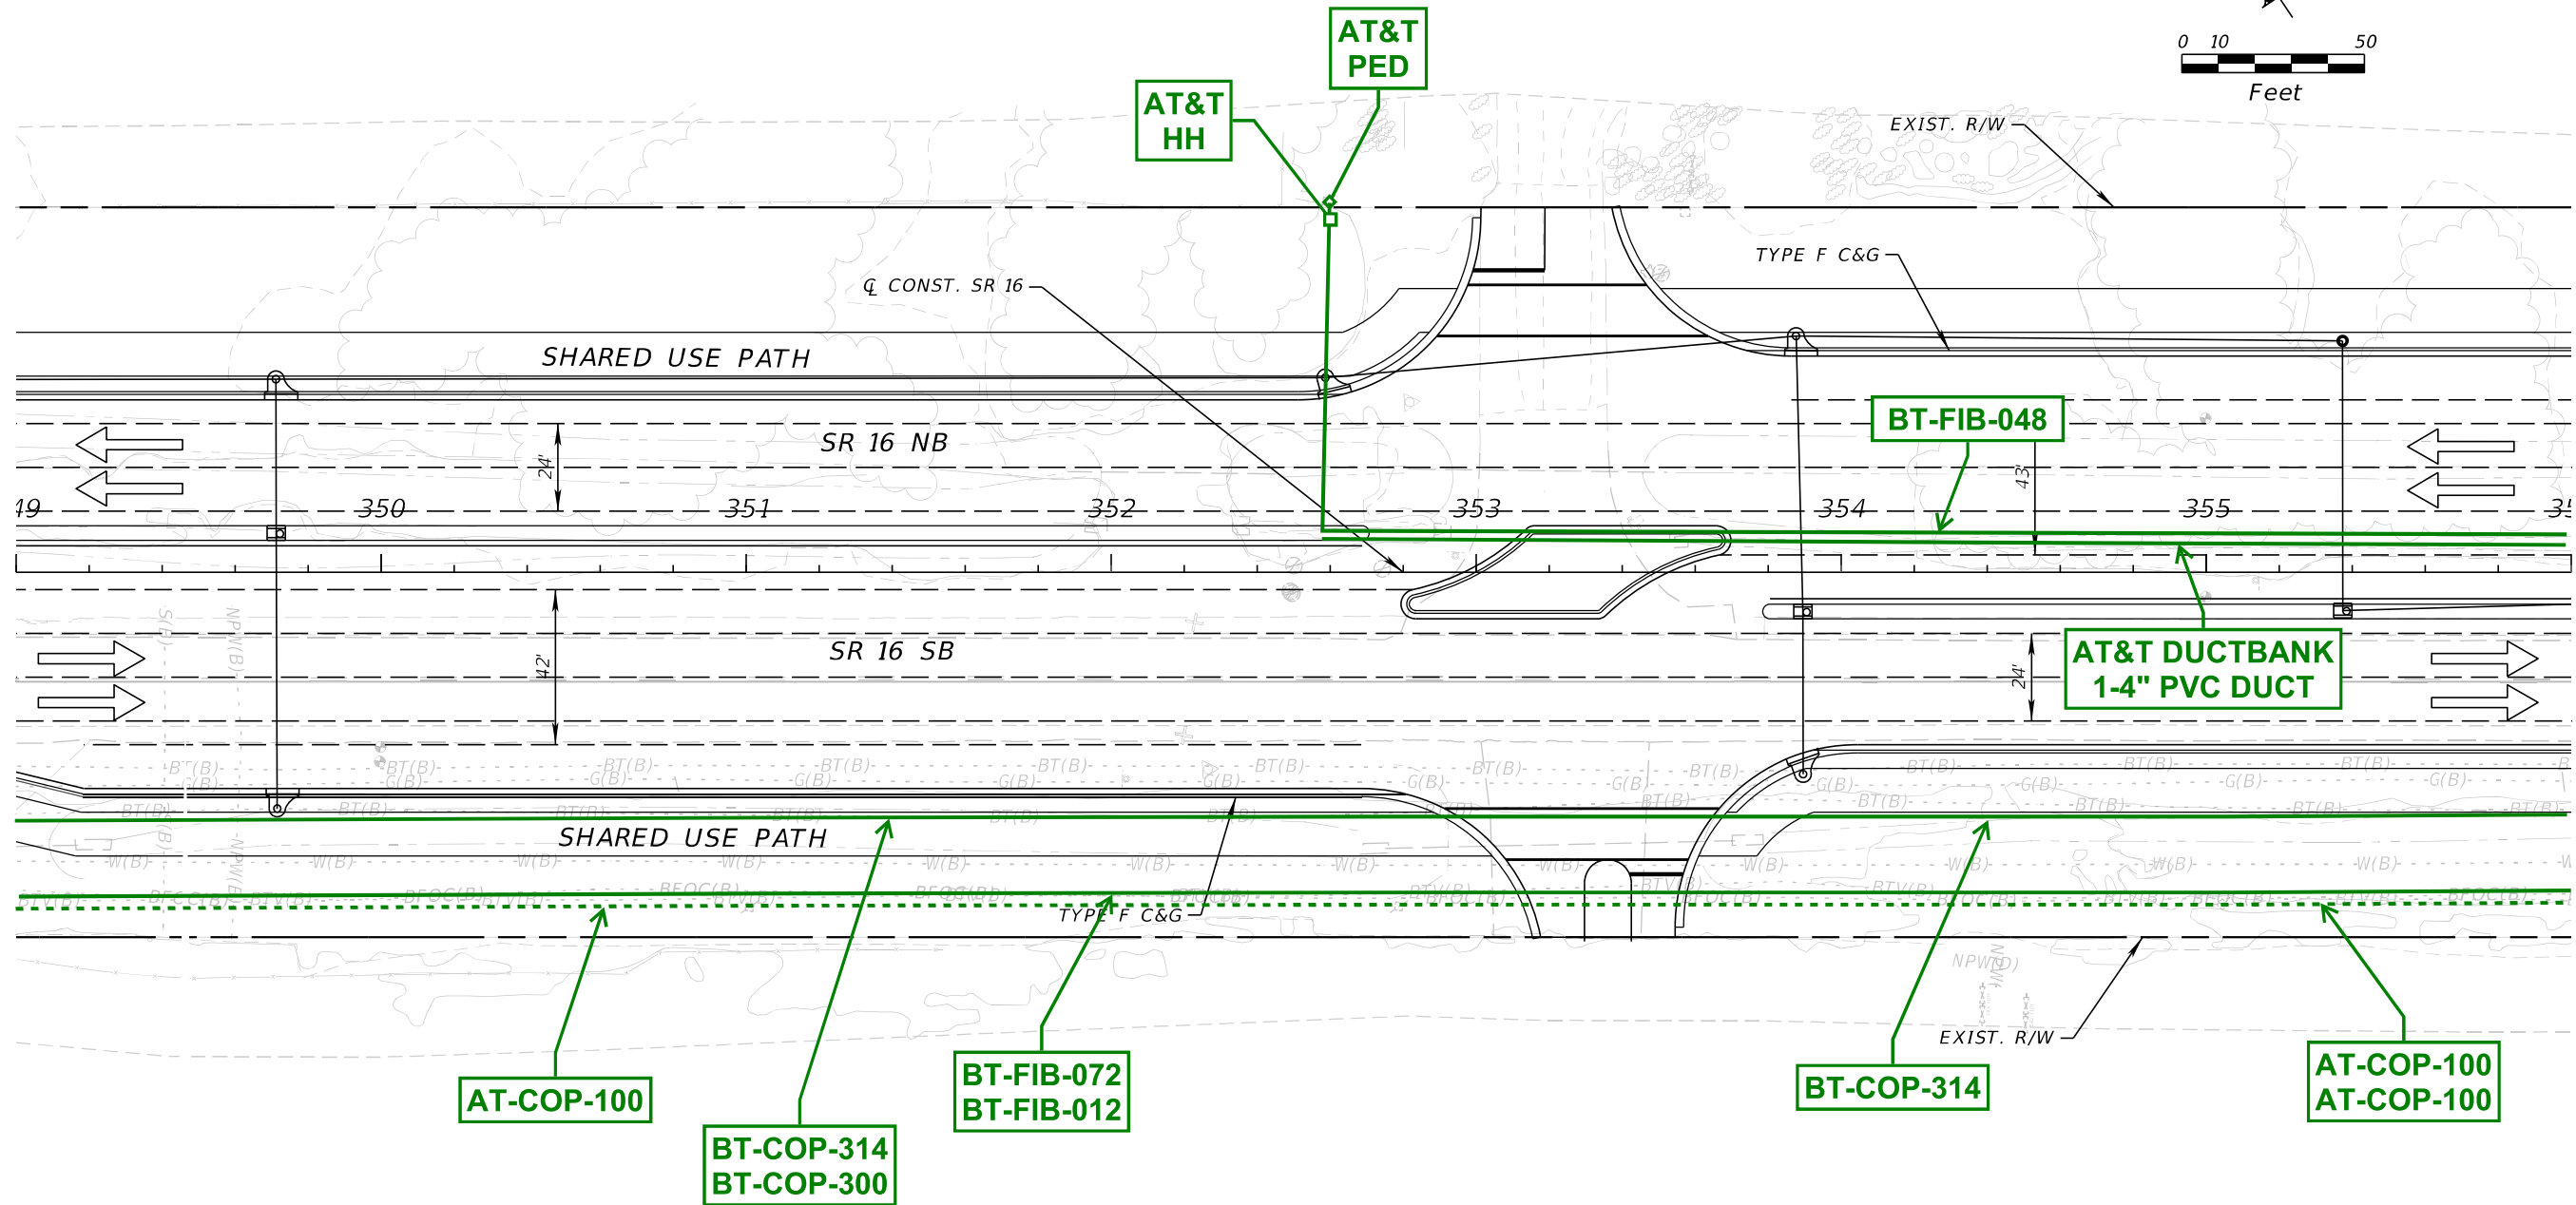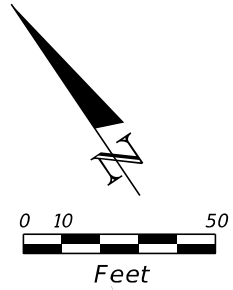

| LEGEND |                 |
|--------|-----------------|
|        | AERIAL AT&T     |
|        | BURIED AT&T     |
|        | AT&T PEDESTAL   |
|        | AT&T MANHOLE    |
|        | AT&T OWNED POLE |



SOLUNA (UNDER CONSTRUCTION)

|      |  | REVISIONS   |      |             | ENGINEER OF RECORD                                                                                                        | STATE OF FLORIDA<br>DEPARTMENT OF TRANSPORTATION |        |                      | SHEET<br>NO.   |
|------|--|-------------|------|-------------|---------------------------------------------------------------------------------------------------------------------------|--------------------------------------------------|--------|----------------------|----------------|
| DATE |  | DESCRIPTION | DATE | DESCRIPTION | STEPHEN J. PARK, P.E.<br>LICENSE NUMBER: 77656<br>RS&H, INC.<br>10748 DEERWOOD PARK BLVD. SOUTH<br>JACKSONVILLE, FL 32256 | ROAD NO.                                         | COUNTY | FINANCIAL PROJECT ID |                |
|      |  |             |      |             |                                                                                                                           |                                                  | SR 16  | ST. JOHNS            | 210447-5-52-01 |

THE OFFICIAL RECORD OF THIS SHEET IS THE ELECTRONIC FILE DIGITALLY SIGNED AND SEALED UNDER RULE 61G15-23.004, F.A.C.

KINGDOM HALL OF  
JEHOVA'S WITNESSES

2924

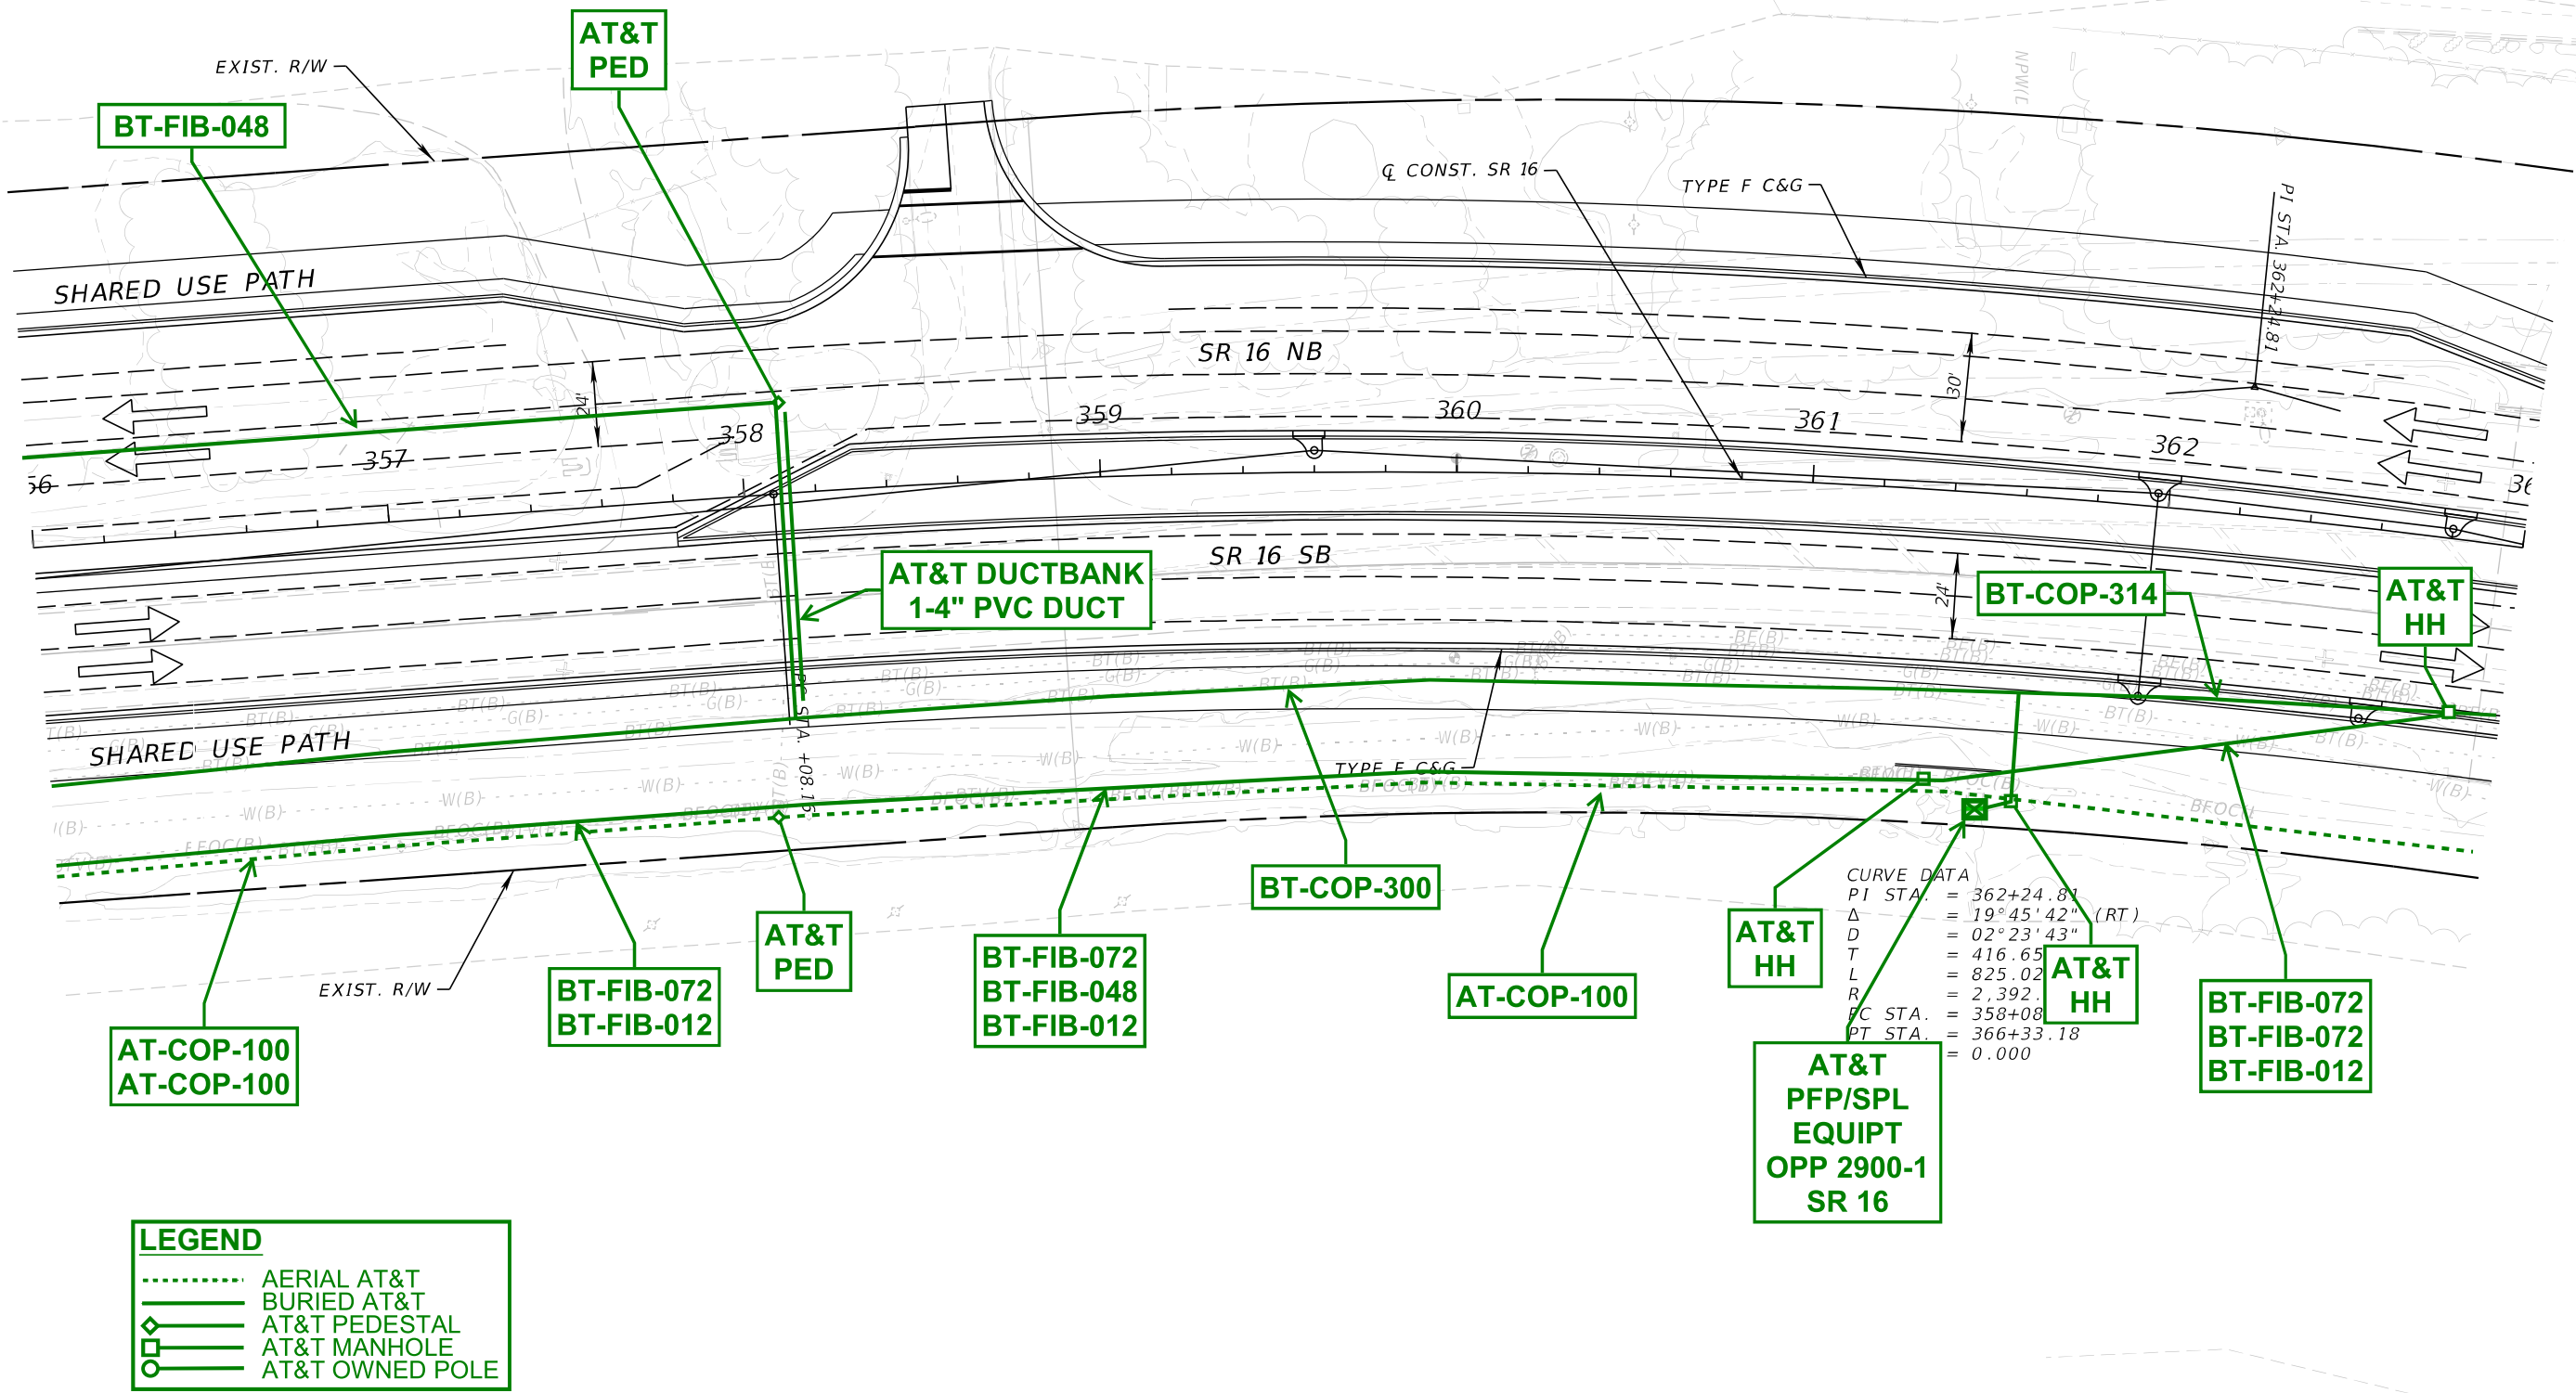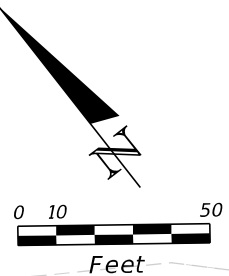

8/5/2024 4:29:01 PM BeattyM  
c:\pw\_work\sh\_pw\pw\_user\0439575\PLANRD01.dgn

| REVISIONS |             | ENGINEER OF RECORD |                                                                                                                           | STATE OF FLORIDA<br>DEPARTMENT OF TRANSPORTATION |           |                      | SHEET<br>NO.          |
|-----------|-------------|--------------------|---------------------------------------------------------------------------------------------------------------------------|--------------------------------------------------|-----------|----------------------|-----------------------|
| DATE      | DESCRIPTION | DATE               | DESCRIPTION                                                                                                               | ROAD NO.                                         | COUNTY    | FINANCIAL PROJECT ID |                       |
|           |             |                    | STEPHEN J. PARK, P.E.<br>LICENSE NUMBER: 77656<br>RS&H, INC.<br>10748 DEERWOOD PARK BLVD. SOUTH<br>JACKSONVILLE, FL 32256 | SR 16                                            | ST. JOHNS | 210447-5-52-01       | 11x17<br>Plan<br>Only |

THE OFFICIAL RECORD OF THIS SHEET IS THE ELECTRONIC FILE DIGITALLY SIGNED AND SEALED UNDER RULE 61G15-23.004, F.A.C.

ATLANTIC SELF STORAGE

2900

BT-COP-25

AT&T  
PED

AT&T  
HH

AT&T DUCTBANK  
1-4" PVC DUCT


AT&T  
HH

AT-COP-100

BT-FIB-072  
BT-FIB-012  
BT-COP-314

LEGEND

- ..... AERIAL AT&T
- BURIED AT&T
- ◇ AT&T PEDESTAL
- AT&T MANHOLE
- AT&T OWNED POLE

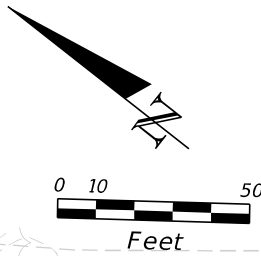

EXIST. R/W

C&G

TYPE F C&G


EXIST. R/W

8/5/2024 4:29:02 PM BeattyM  
c:\pw\_work\ysh\_pw\pw\_user\0439575\PLANRD01.dgn

| REVISIONS |             | ENGINEER OF RECORD |                                                                                                                           | STATE OF FLORIDA<br>DEPARTMENT OF TRANSPORTATION |           |                      | SHEET<br>NO.          |
|-----------|-------------|--------------------|---------------------------------------------------------------------------------------------------------------------------|--------------------------------------------------|-----------|----------------------|-----------------------|
| DATE      | DESCRIPTION | DATE               | DESCRIPTION                                                                                                               | ROAD NO.                                         | COUNTY    | FINANCIAL PROJECT ID |                       |
|           |             |                    | STEPHEN J. PARK, P.E.<br>LICENSE NUMBER: 77656<br>RS&H, INC.<br>10748 DEERWOOD PARK BLVD. SOUTH<br>JACKSONVILLE, FL 32256 | SR 16                                            | ST. JOHNS | 210447-5-52-01       | 11x17<br>Plan<br>Only |

THE OFFICIAL RECORD OF THIS SHEET IS THE ELECTRONIC FILE DIGITALLY SIGNED AND SEALED UNDER RULE 61G15-23.004, F.A.C.

8/5/2024 4:29:03 PM BeattyM  
c:\pw\_work\ysh\_pw\pw\_user\40439575\PLAINRD01.dgn

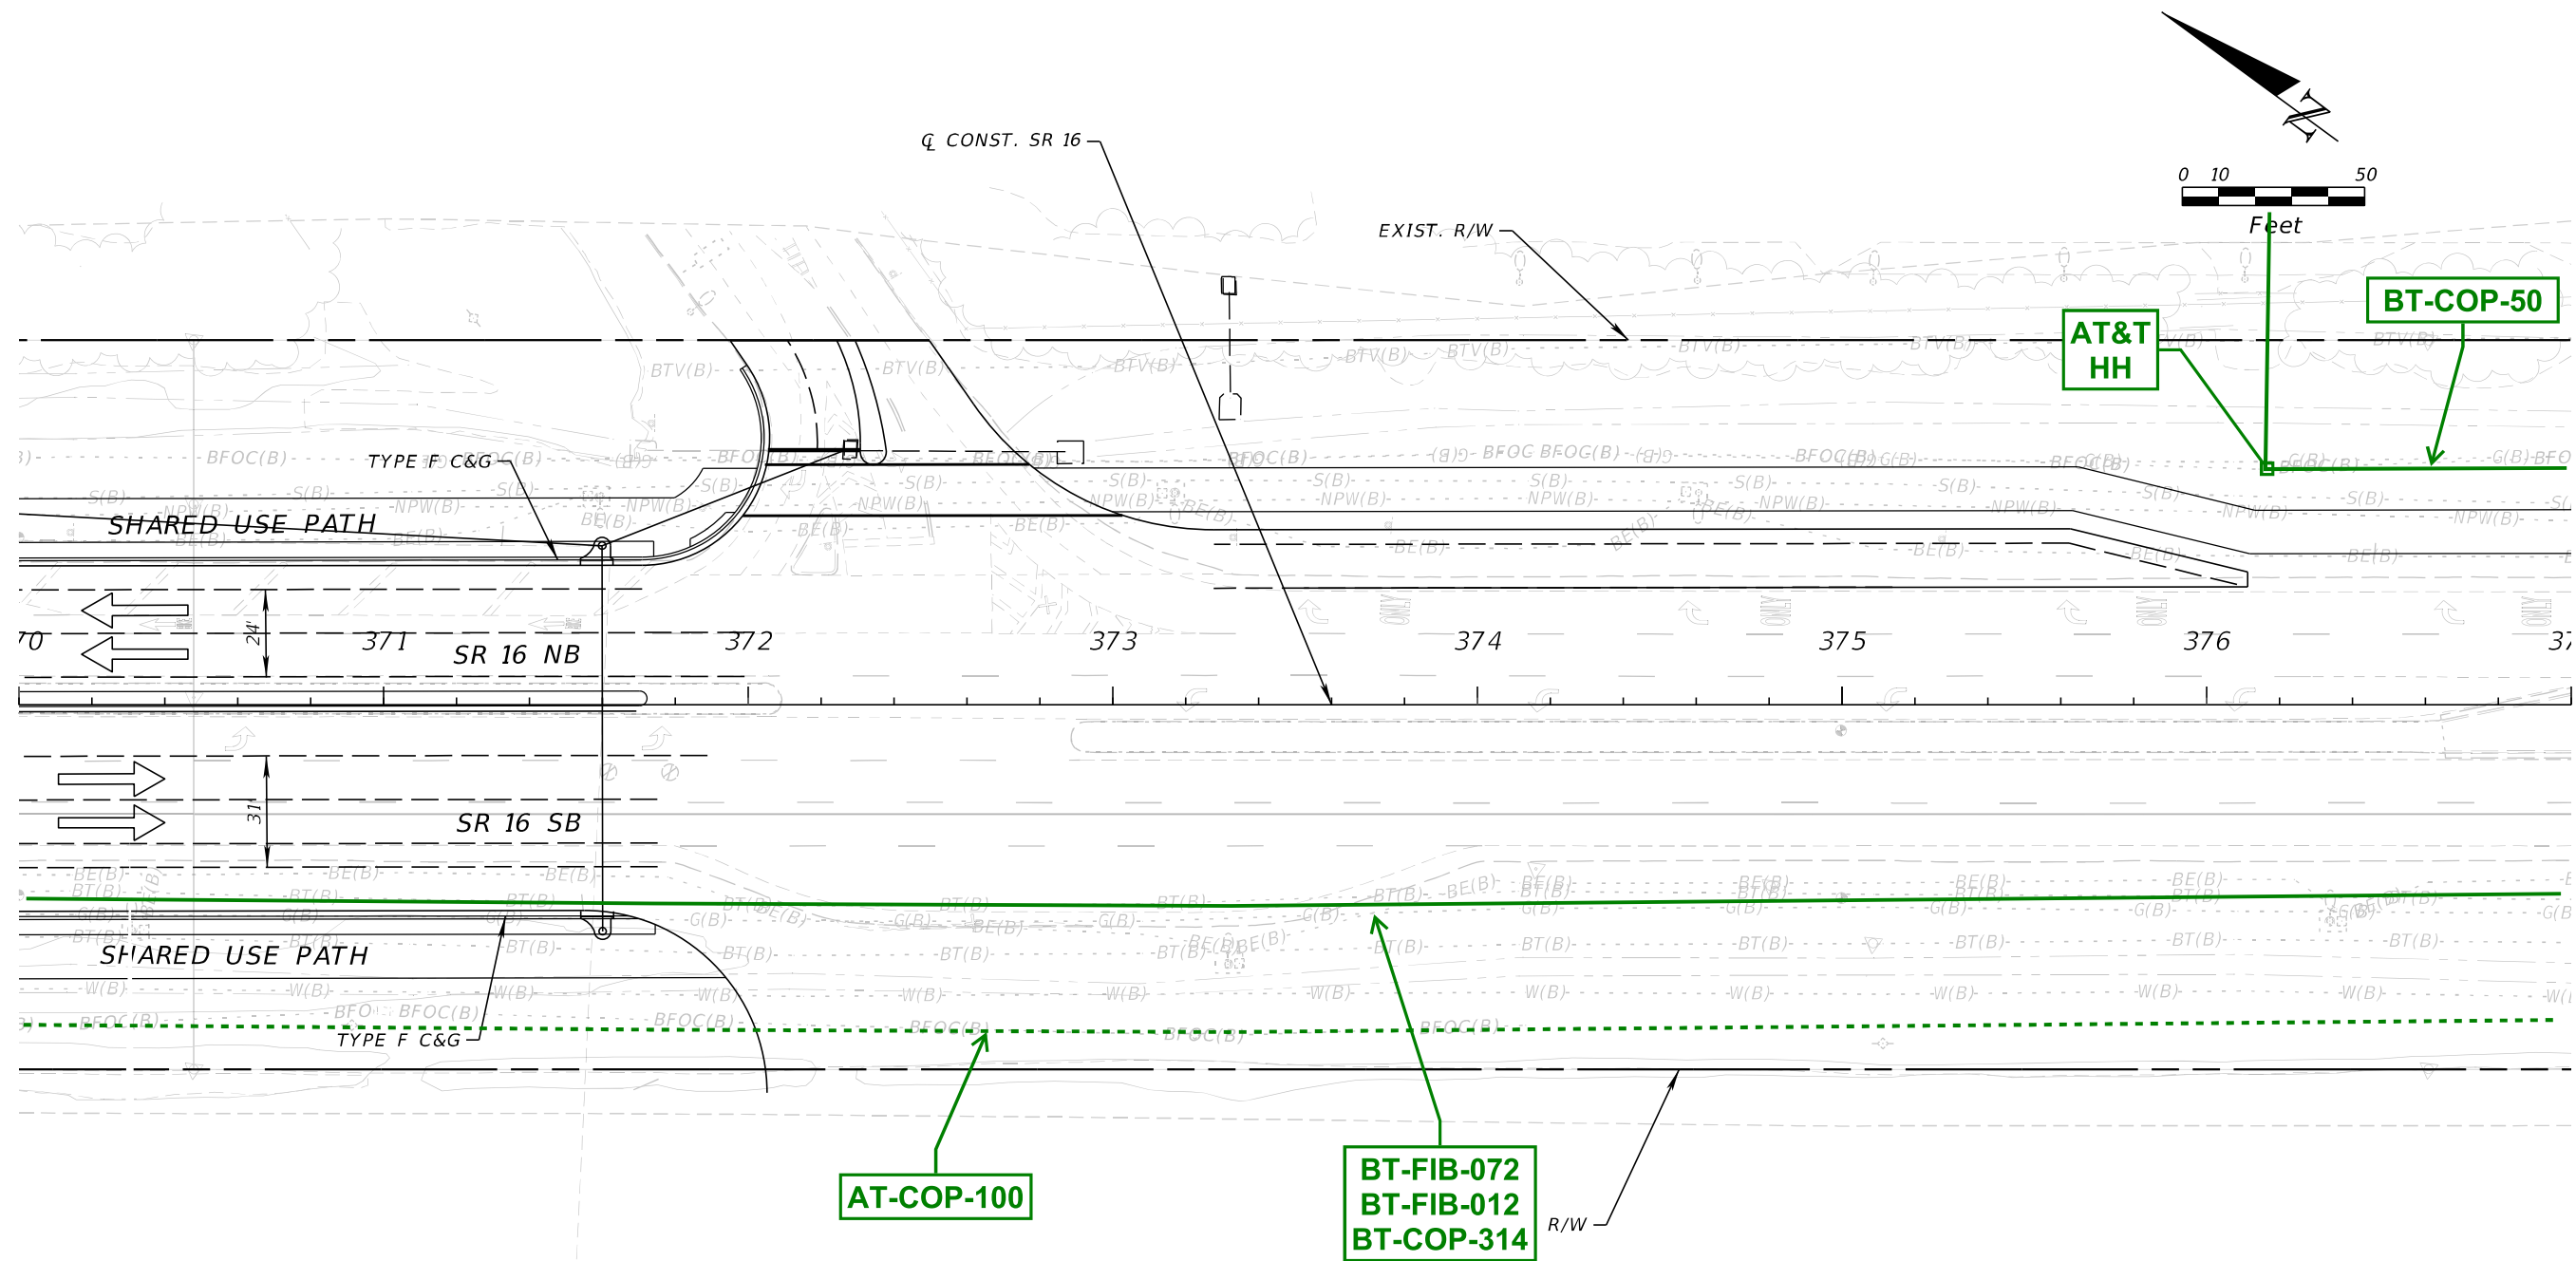


| LEGEND |                 |
|--------|-----------------|
| -----  | AERIAL AT&T     |
| ————   | BURIED AT&T     |
| ◆      | AT&T PEDESTAL   |
| □      | AT&T MANHOLE    |
| ○      | AT&T OWNED POLE |

| REVISIONS |             | ENGINEER OF RECORD |                                                                                                                           | STATE OF FLORIDA<br>DEPARTMENT OF TRANSPORTATION |           |                      | SHEET<br>NO.          |
|-----------|-------------|--------------------|---------------------------------------------------------------------------------------------------------------------------|--------------------------------------------------|-----------|----------------------|-----------------------|
| DATE      | DESCRIPTION | DATE               | DESCRIPTION                                                                                                               | ROAD NO.                                         | COUNTY    | FINANCIAL PROJECT ID |                       |
|           |             |                    | STEPHEN J. PARK, P.E.<br>LICENSE NUMBER: 77656<br>RS&H, INC.<br>10748 DEERWOOD PARK BLVD. SOUTH<br>JACKSONVILLE, FL 32256 | SR 16                                            | ST. JOHNS | 210447-5-52-01       | 11x17<br>Plan<br>Only |

THE OFFICIAL RECORD OF THIS SHEET IS THE ELECTRONIC FILE DIGITALLY SIGNED AND SEALED UNDER RULE 61G15-23.004, F.A.C.



8/5/2024 4:29:03 PM BeattyM  
c:\pw\_work\sh\_pw\pw\_user\00439575\PLANRD01.dgn

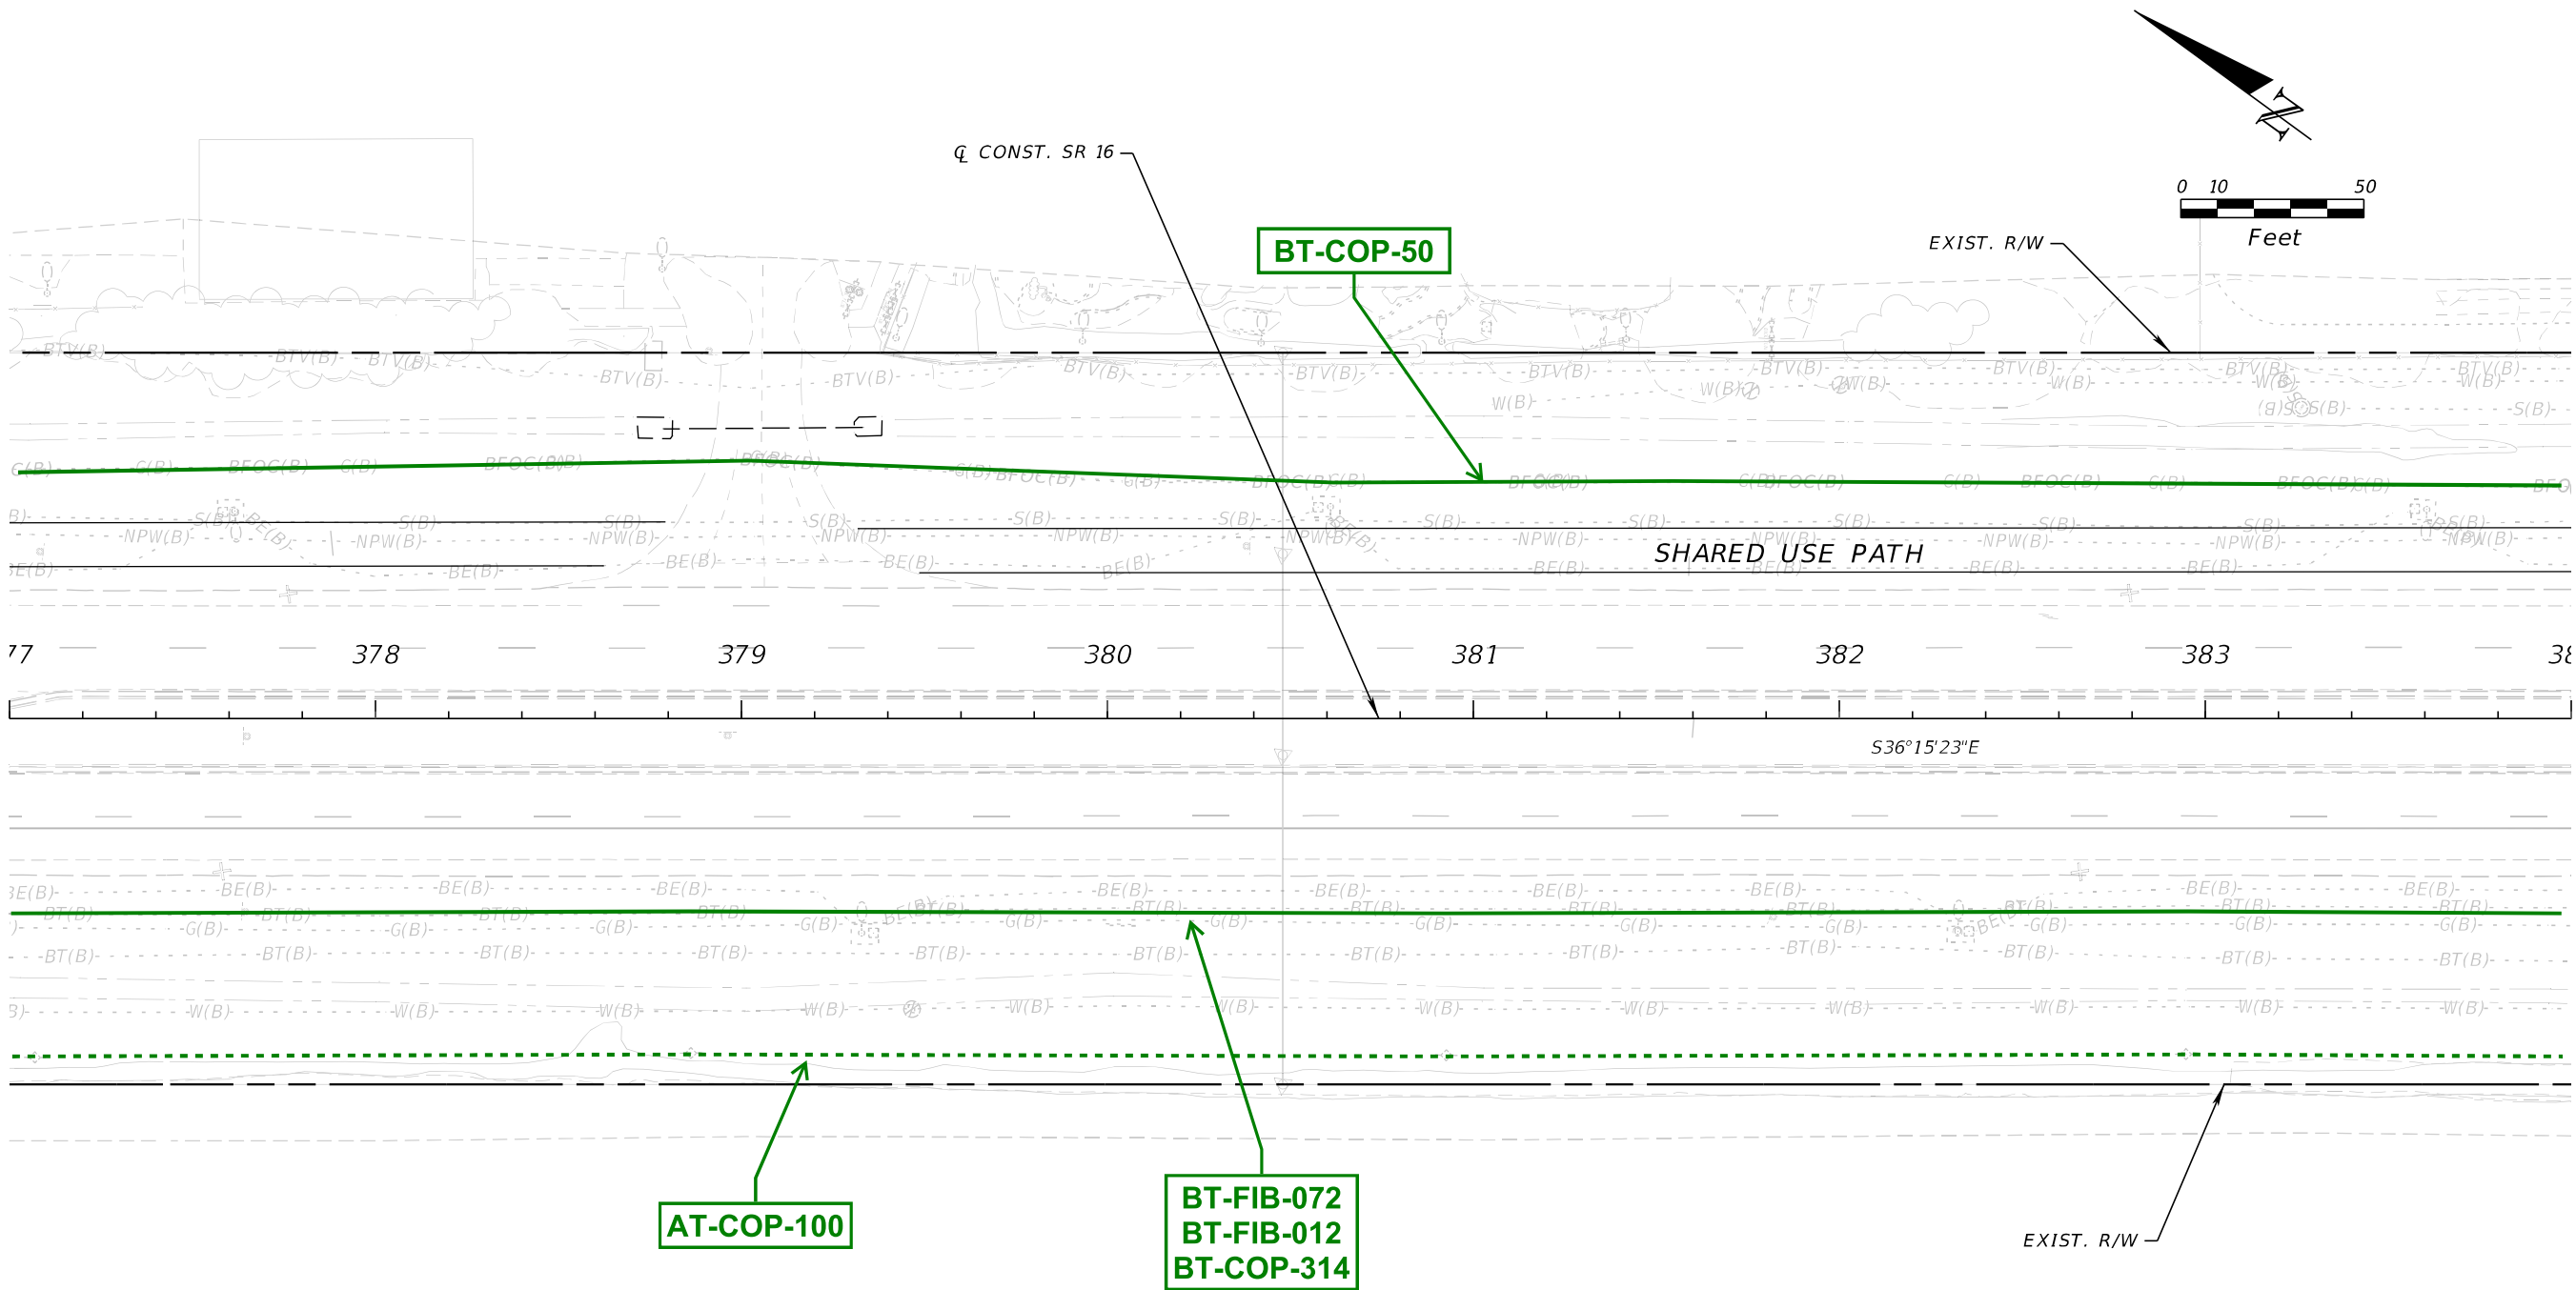




| LEGEND |                 |
|--------|-----------------|
| -----  | AERIAL AT&T     |
| ————   | BURIED AT&T     |
| ◆      | AT&T PEDESTAL   |
| □      | AT&T MANHOLE    |
| ○      | AT&T OWNED POLE |

|                       |  | REVISIONS   |      |             |                                                                                                                           | ENGINEER OF RECORD | STATE OF FLORIDA<br>DEPARTMENT OF TRANSPORTATION |                      |  | SHEET<br>NO. |
|-----------------------|--|-------------|------|-------------|---------------------------------------------------------------------------------------------------------------------------|--------------------|--------------------------------------------------|----------------------|--|--------------|
| DATE                  |  | DESCRIPTION | DATE | DESCRIPTION | STEPHEN J. PARK, P.E.<br>LICENSE NUMBER: 77656<br>RS&H, INC.<br>10748 DEERWOOD PARK BLVD. SOUTH<br>JACKSONVILLE, FL 32256 | ROAD NO.           | COUNTY                                           | FINANCIAL PROJECT ID |  |              |
|                       |  |             |      |             |                                                                                                                           | SR 16              | ST. JOHNS                                        | 210447-5-52-01       |  |              |
| 11x17<br>Plan<br>Only |  |             |      |             |                                                                                                                           |                    |                                                  |                      |  |              |

THE OFFICIAL RECORD OF THIS SHEET IS THE ELECTRONIC FILE DIGITALLY SIGNED AND SEALED UNDER RULE 61G15-23.004, F.A.C.



SHOPPES AT MILL CREEK

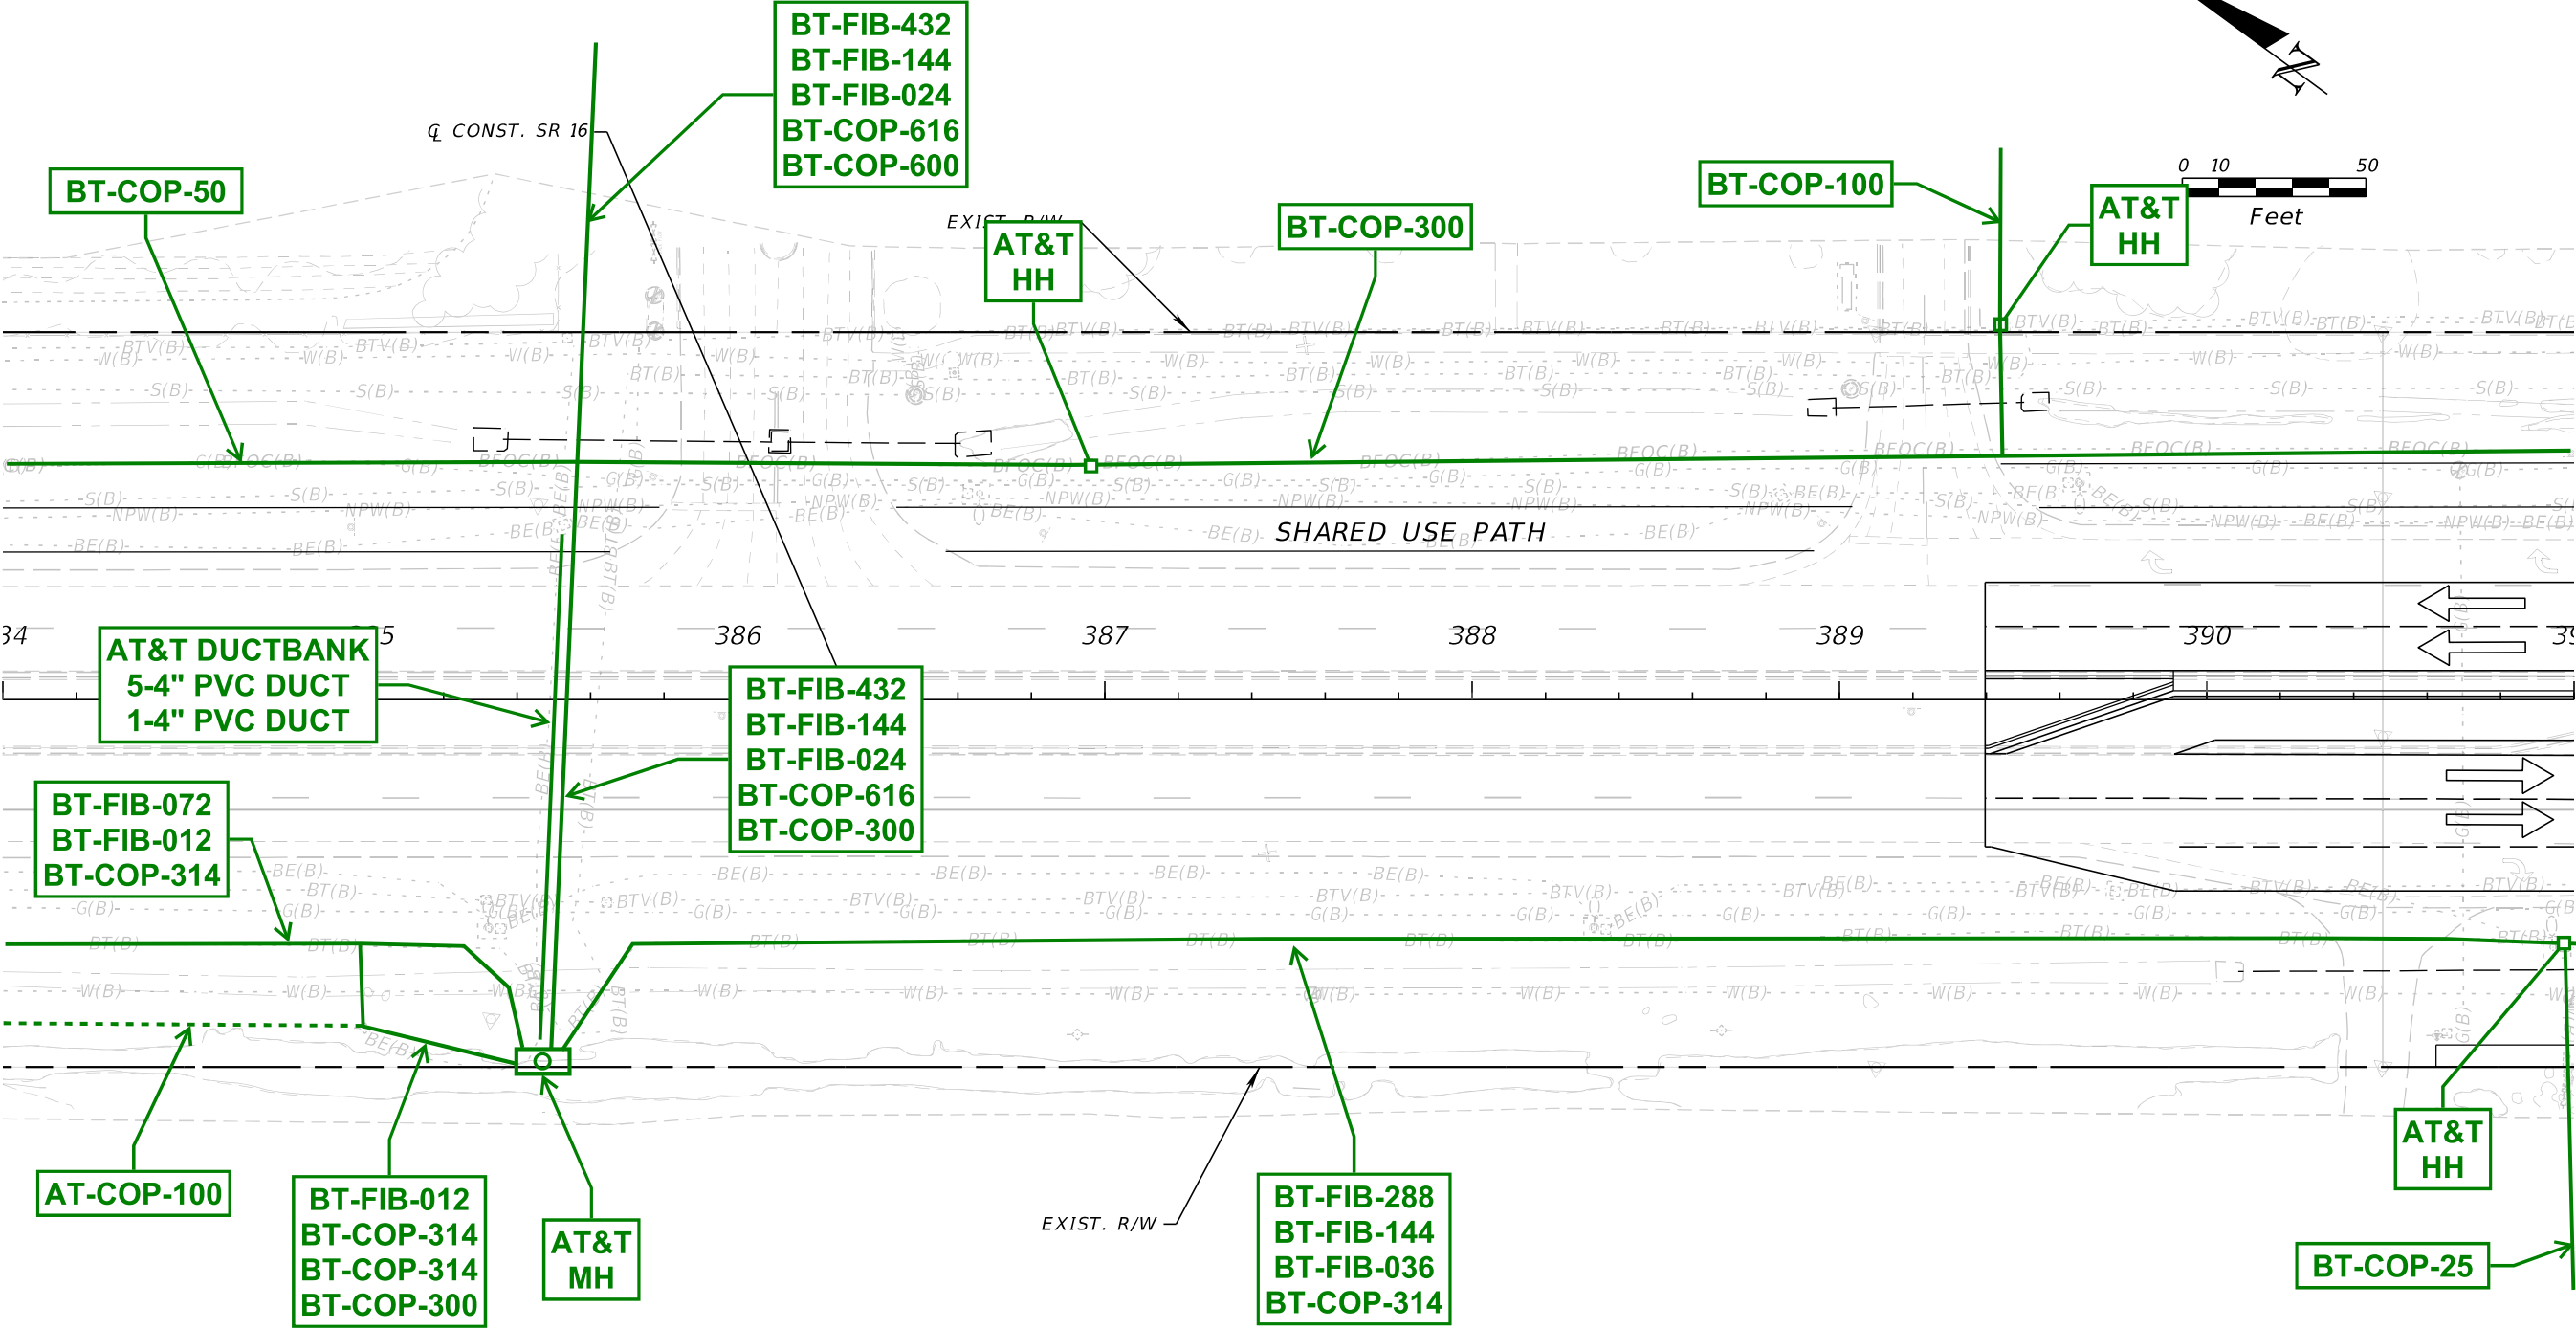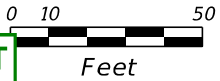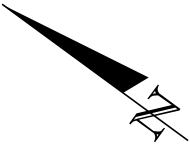


| LEGEND |                 |  |  |
|--------|-----------------|--|--|
| .....  | AERIAL AT&T     |  |  |
| ————   | BURIED AT&T     |  |  |
| ◆      | AT&T PEDESTAL   |  |  |
| □      | AT&T MANHOLE    |  |  |
| ○      | AT&T OWNED POLE |  |  |

| REVISIONS |             | ENGINEER OF RECORD |                                                                                                                           | STATE OF FLORIDA<br>DEPARTMENT OF TRANSPORTATION |           |                      | SHEET<br>NO.          |
|-----------|-------------|--------------------|---------------------------------------------------------------------------------------------------------------------------|--------------------------------------------------|-----------|----------------------|-----------------------|
| DATE      | DESCRIPTION | DATE               | DESCRIPTION                                                                                                               | ROAD NO.                                         | COUNTY    | FINANCIAL PROJECT ID |                       |
|           |             |                    | STEPHEN J. PARK, P.E.<br>LICENSE NUMBER: 77656<br>RS&H, INC.<br>10748 DEERWOOD PARK BLVD. SOUTH<br>JACKSONVILLE, FL 32256 | SR 16                                            | ST. JOHNS | 210447-5-52-01       | 11x17<br>Plan<br>Only |

8/5/2024 4:29:04 PM BeattyM  
c:\pw\_work\ysh\_pw\pw\_user\40439575\PLANRD01.dgn

THE OFFICIAL RECORD OF THIS SHEET IS THE ELECTRONIC FILE DIGITALLY SIGNED AND SEALED UNDER RULE 61G15-23.004, F.A.C.

8/5/2024 4:29:04 PM BeattyM  
c:\pw\_work\sh\_pw\pw\_user\0439575\PLANRD01.dgn

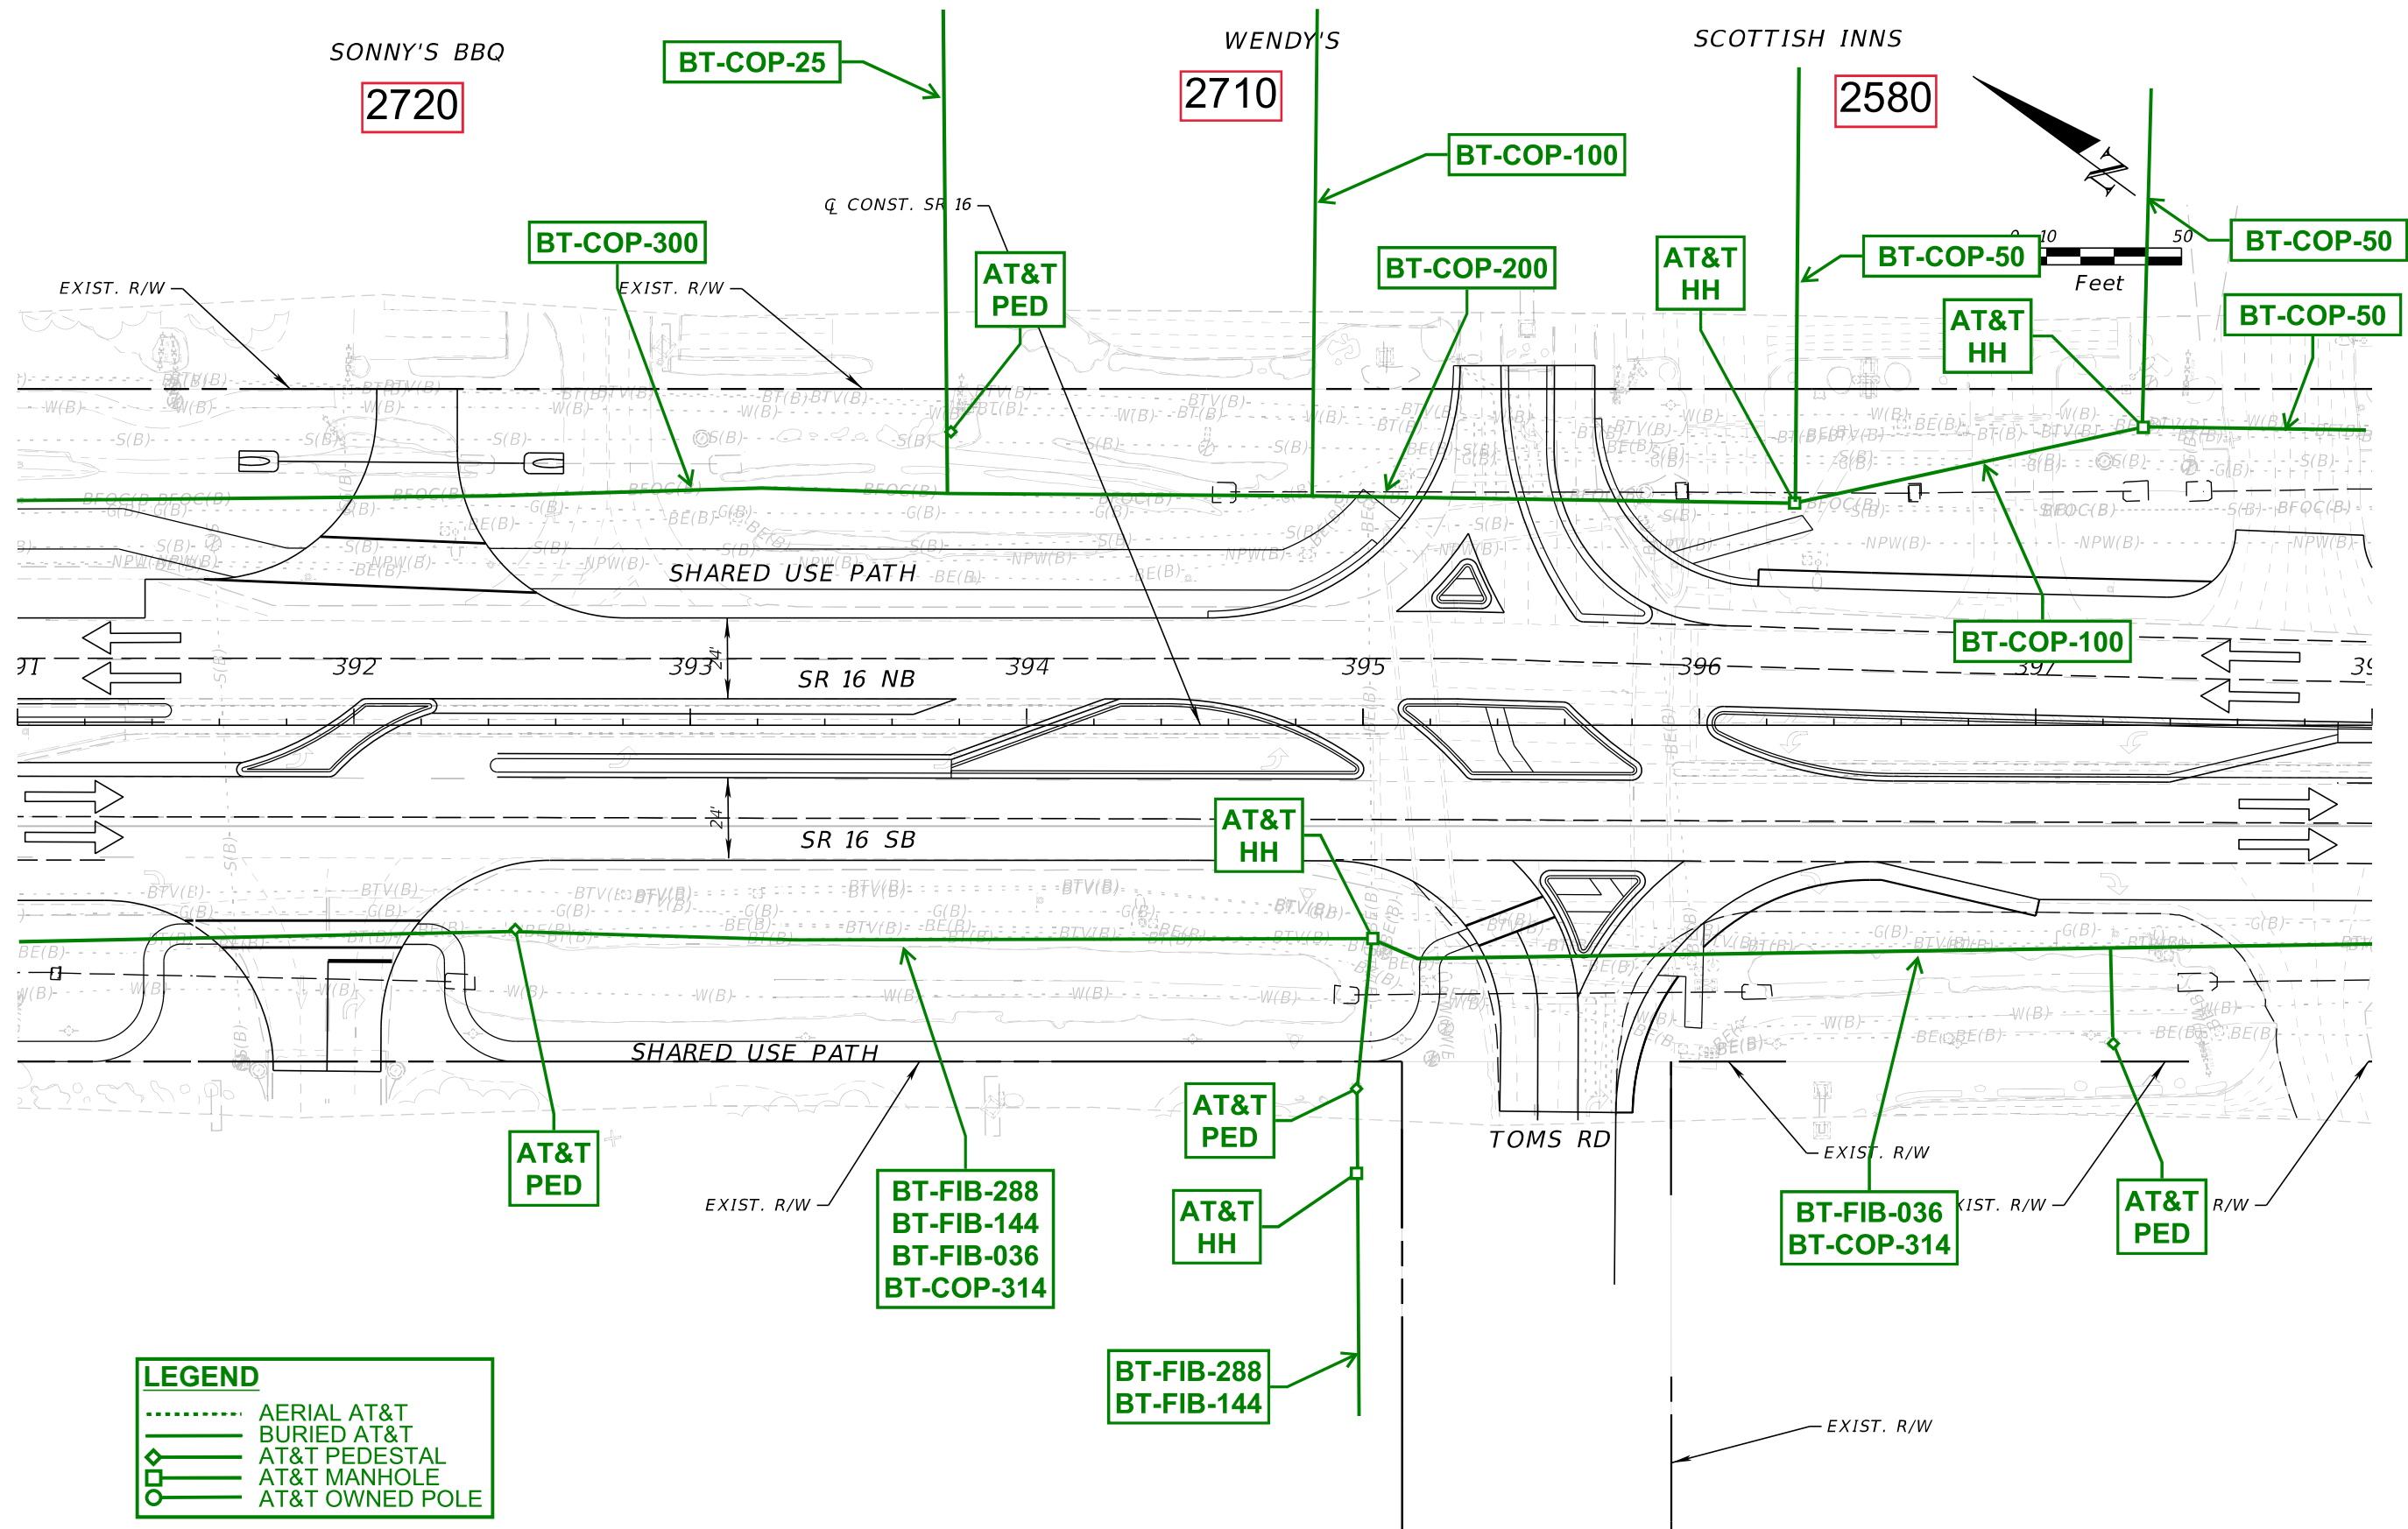

| LEGEND |                 |
|--------|-----------------|
| .....  | AERIAL AT&T     |
| ————   | BURIED AT&T     |
| ◇      | AT&T PEDESTAL   |
| □      | AT&T MANHOLE    |
| ○      | AT&T OWNED POLE |

| REVISIONS |             |      |             | ENGINEER OF RECORD                                                                                                        |  |  | STATE OF FLORIDA<br>DEPARTMENT OF TRANSPORTATION |           |                      | SHEET<br>NO. |
|-----------|-------------|------|-------------|---------------------------------------------------------------------------------------------------------------------------|--|--|--------------------------------------------------|-----------|----------------------|--------------|
| DATE      | DESCRIPTION | DATE | DESCRIPTION | STEPHEN J. PARK, P.E.<br>LICENSE NUMBER: 77656<br>RS&H, INC.<br>10748 DEERWOOD PARK BLVD. SOUTH<br>JACKSONVILLE, FL 32256 |  |  | ROAD NO.                                         | COUNTY    | FINANCIAL PROJECT ID |              |
|           |             |      |             |                                                                                                                           |  |  | SR 16                                            | ST. JOHNS | 210447-5-52-01       |              |



THE OFFICIAL RECORD OF THIS SHEET IS THE ELECTRONIC FILE DIGITALLY SIGNED AND SEALED UNDER RULE 61G15-23.004, F.A.C.

DAYS INN  
2560

IHOP  
2560

BT-COP-50

AT&T  
PED

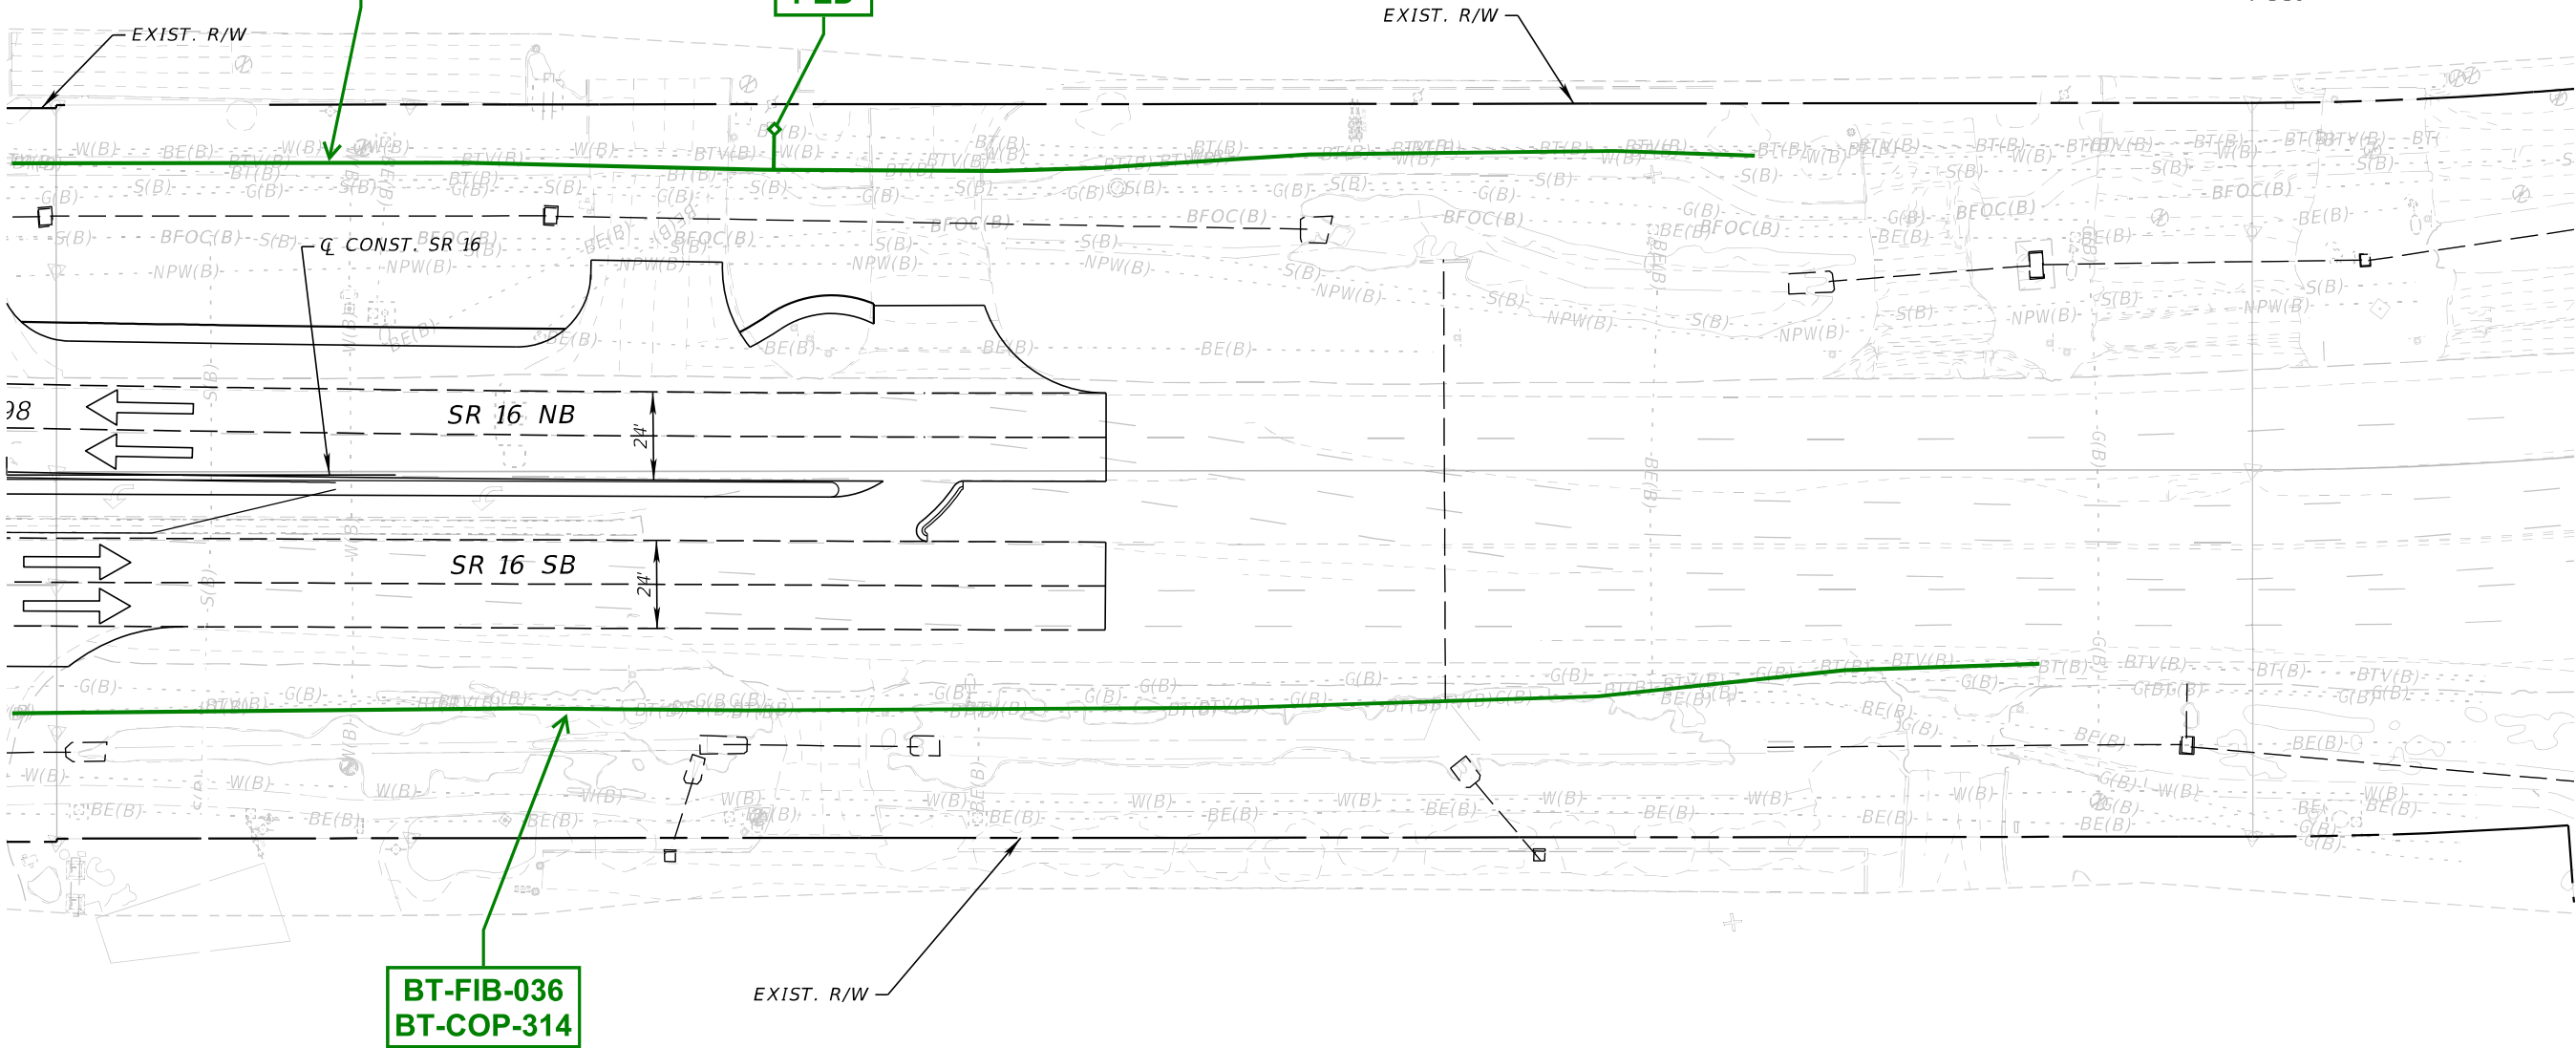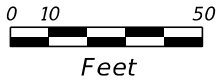

| LEGEND |                 |  |  |  |
|--------|-----------------|--|--|--|
| .....  | AERIAL AT&T     |  |  |  |
| —      | BURIED AT&T     |  |  |  |
| ◇      | AT&T PEDESTAL   |  |  |  |
| □      | AT&T MANHOLE    |  |  |  |
| ○      | AT&T OWNED POLE |  |  |  |

| DATE        |  | REVISIONS   |  | ENGINEER OF RECORD                                                                                                        |  | STATE OF FLORIDA<br>DEPARTMENT OF TRANSPORTATION |           |                      | SHEET<br>NO.            |
|-------------|--|-------------|--|---------------------------------------------------------------------------------------------------------------------------|--|--------------------------------------------------|-----------|----------------------|-------------------------|
| DESCRIPTION |  | DESCRIPTION |  |                                                                                                                           |  | ROAD NO.                                         | COUNTY    | FINANCIAL PROJECT ID |                         |
|             |  |             |  | STEPHEN J. PARK, P.E.<br>LICENSE NUMBER: 77656<br>RS&H, INC.<br>10748 DEERWOOD PARK BLVD. SOUTH<br>JACKSONVILLE, FL 32256 |  | SR 16                                            | ST. JOHNS | 210447-5-52-01       | SR 16<br>- PLAN -<br>44 |

8/5/2024 4:29:05 PM BeattyM  
c:\pw\_work\ysh\_pw\pw\_user\0439575\PLANRD01.dgn

THE OFFICIAL RECORD OF THIS SHEET IS THE ELECTRONIC FILE DIGITALLY SIGNED AND SEALED UNDER RULE 61G15-23.004, F.A.C.

# Comcast

## Forms and Figures





## District 2 Utility Contact Form

**Please Fill Out Completely**

|                                                |                                                                                        |
|------------------------------------------------|----------------------------------------------------------------------------------------|
| Date:                                          | 9/9/24                                                                                 |
| Company Name:                                  | COMCAST                                                                                |
| Phone Number:                                  | 9045096472                                                                             |
| Email Address:                                 | JAMES_GRAHAM@CABLE.COMCAST.COM                                                         |
| FPI:                                           | 210447-5-52-01 SR16 St. Johns Co. Roadway Plan Sheets Dtd 8/5/24 Add Lanes/Reconstruct |
| Emergency number<br>to be inserted on<br>plans |                                                                                        |

Existing facilities are located:

- ☐ Within existing FDOT Right-of-Way (between Station: \_\_\_\_\_ to Station: \_\_\_\_\_)
- ☐ Within existing County/City Right-of-Way (between Station: \_\_\_\_\_ to Station: \_\_\_\_\_)
- ☐ Within railroad Right-of-Way (between Station: \_\_\_\_\_ to Station: \_\_\_\_\_)
- ☐ Within an easement or fee title property (Has compensable interest and may claim reimbursement for required relocation) \*
- ☐ Not within project limits (Has no facilities within limits)
- ☒ No Utility Work Schedule (Has facilities within limits but is not affected)
- ☐ There will not be a claim for reimbursement
- ☐ There will be a claim for reimbursement \*

\* Please provide any document(s) [i.e. fee title property deed or easement document(s)] within the project limits that formulates the basis for your entitlement to be reimbursed for your utility work. NOTE: A preliminary cost estimate for any utility work within this entitled area is required.

Enclosed please find:

|                                                          |                                                    |
|----------------------------------------------------------|----------------------------------------------------|
| <input checked="" type="checkbox"/> Marked Roadway Plans | <input type="checkbox"/> Company Utility Plans     |
| <input type="checkbox"/> Legal Documents                 | <input type="checkbox"/> Preliminary Cost Estimate |

**POLE OWNERS: List Joint Pole Users**

### COMMENTS:

NO CONFLICTS AT THIS TIME

Signed:


Title:

JGRAHAM PC

(Signature is not required if uploading directly in PSEE)




210447-5 FDOT Plan Sheets (Roadway - Dtd 8/5/24) 081224

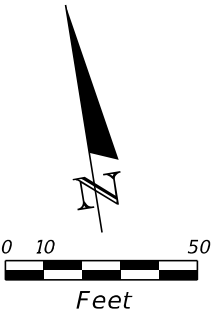

COMCAST MARK UP

OVERHEAD 

UNDERGROUND 

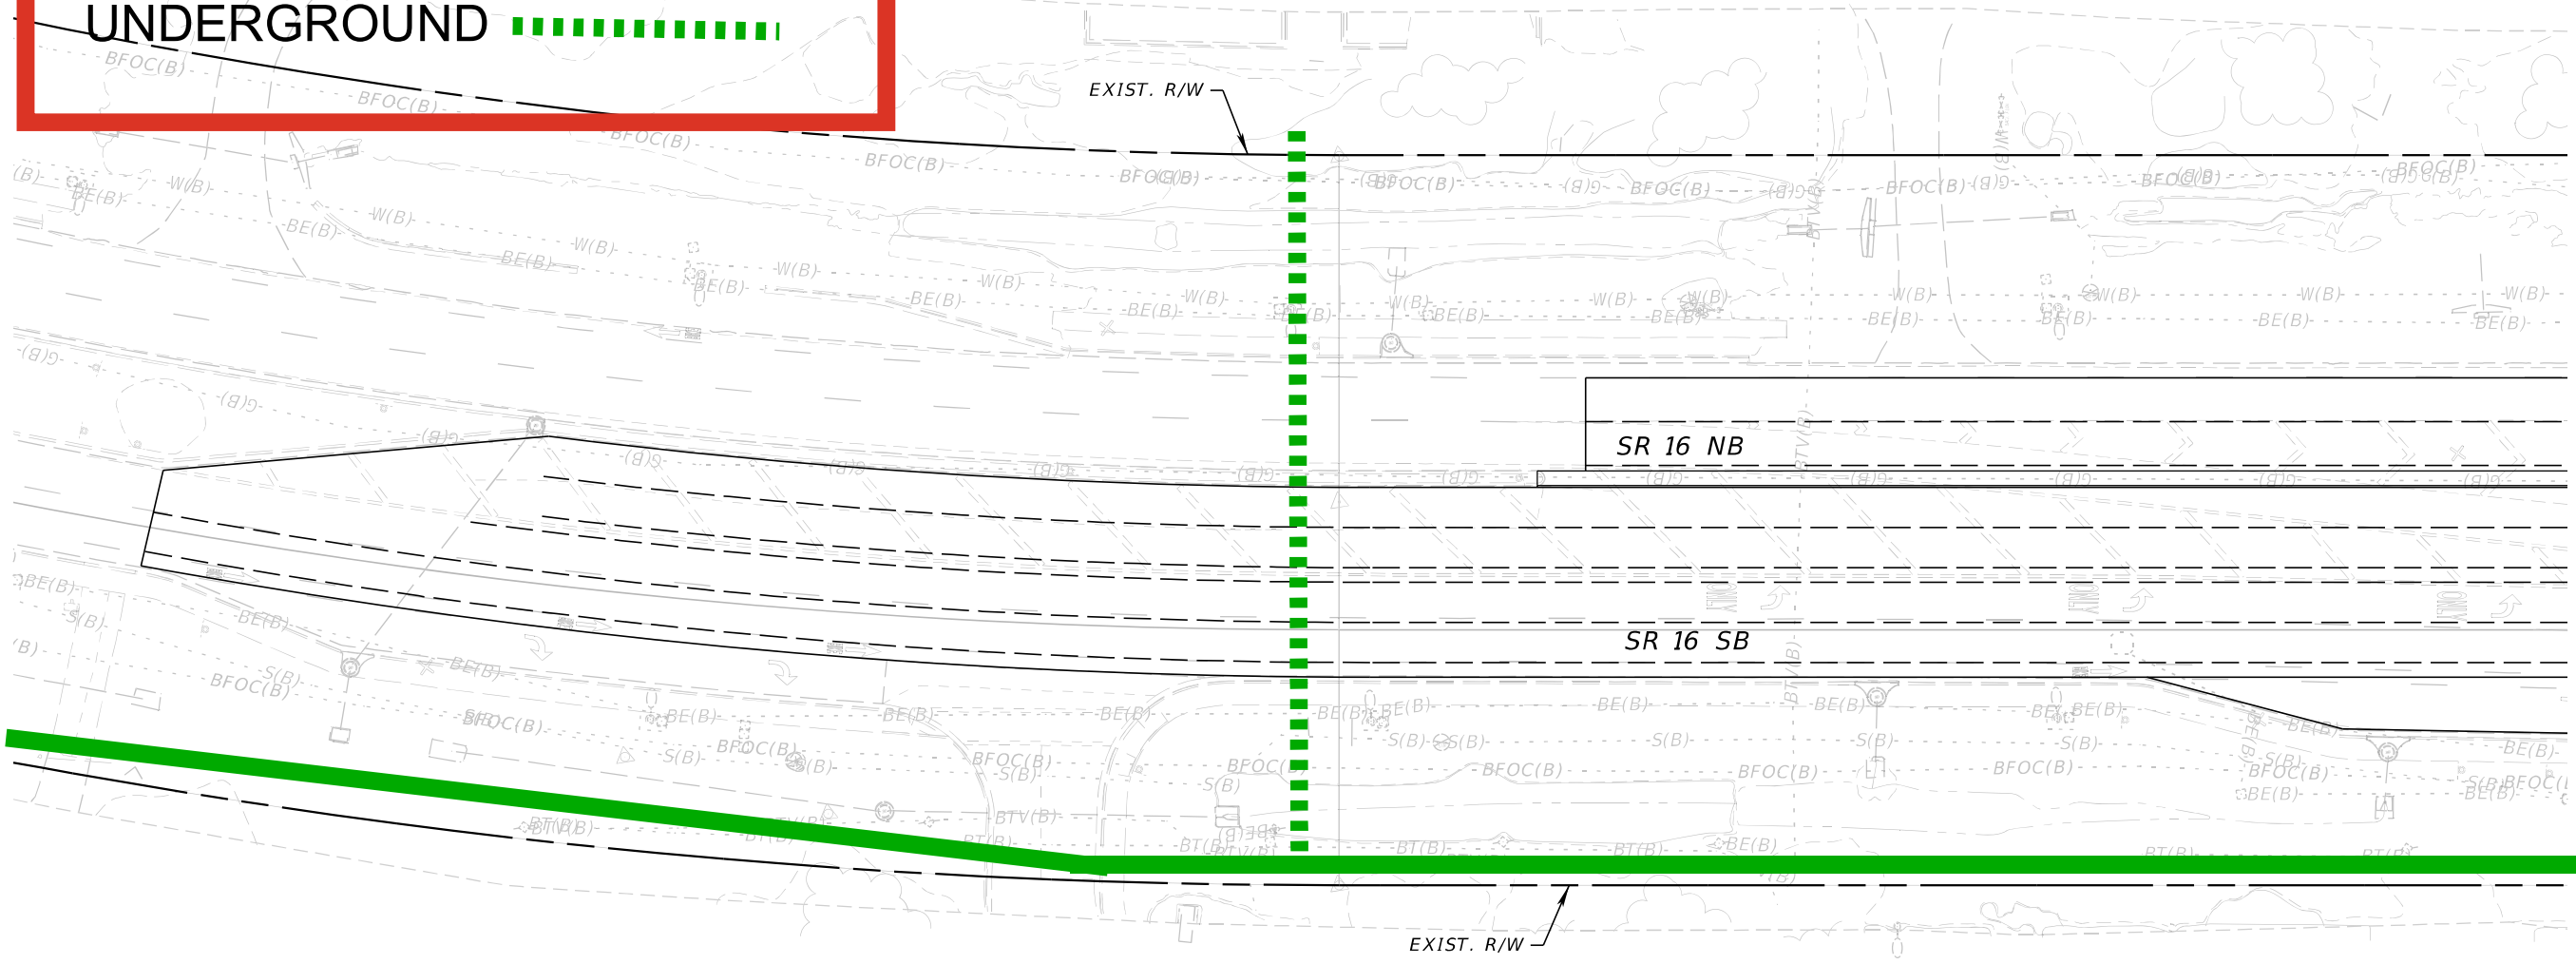


| REVISIONS |             |      |             | ENGINEER OF RECORD                                                                                                        |  | STATE OF FLORIDA<br>DEPARTMENT OF TRANSPORTATION |           |                      | ROADWAY PLAN | SHEET NO.<br><br>SR 16<br>- PLAN |
|-----------|-------------|------|-------------|---------------------------------------------------------------------------------------------------------------------------|--|--------------------------------------------------|-----------|----------------------|--------------|----------------------------------|
| DATE      | DESCRIPTION | DATE | DESCRIPTION | STEPHEN J. PARK, P.E.<br>LICENSE NUMBER: 77656<br>RS&H, INC.<br>10748 DEERWOOD PARK BLVD. SOUTH<br>JACKSONVILLE, FL 32256 |  | ROAD NO.                                         | COUNTY    | FINANCIAL PROJECT ID |              |                                  |
|           |             |      |             |                                                                                                                           |  | SR 16                                            | ST. JOHNS | 210447-5-52-01       |              |                                  |

8/5/2024 4:28:36 PM BeattyM c:\pw\_work\ysh\_pw\pw\_user\0439575\PLANRD01.dgn

THE OFFICIAL RECORD OF THIS SHEET IS THE ELECTRONIC FILE DIGITALLY SIGNED AND SEALED UNDER RULE 61G15-23.004, F.A.C.


8/5/2024 4:28:37 PM BeattyM  
c:\pw\_work\sh\_pw\pw\_user\0439575\PLANRD01.dgn

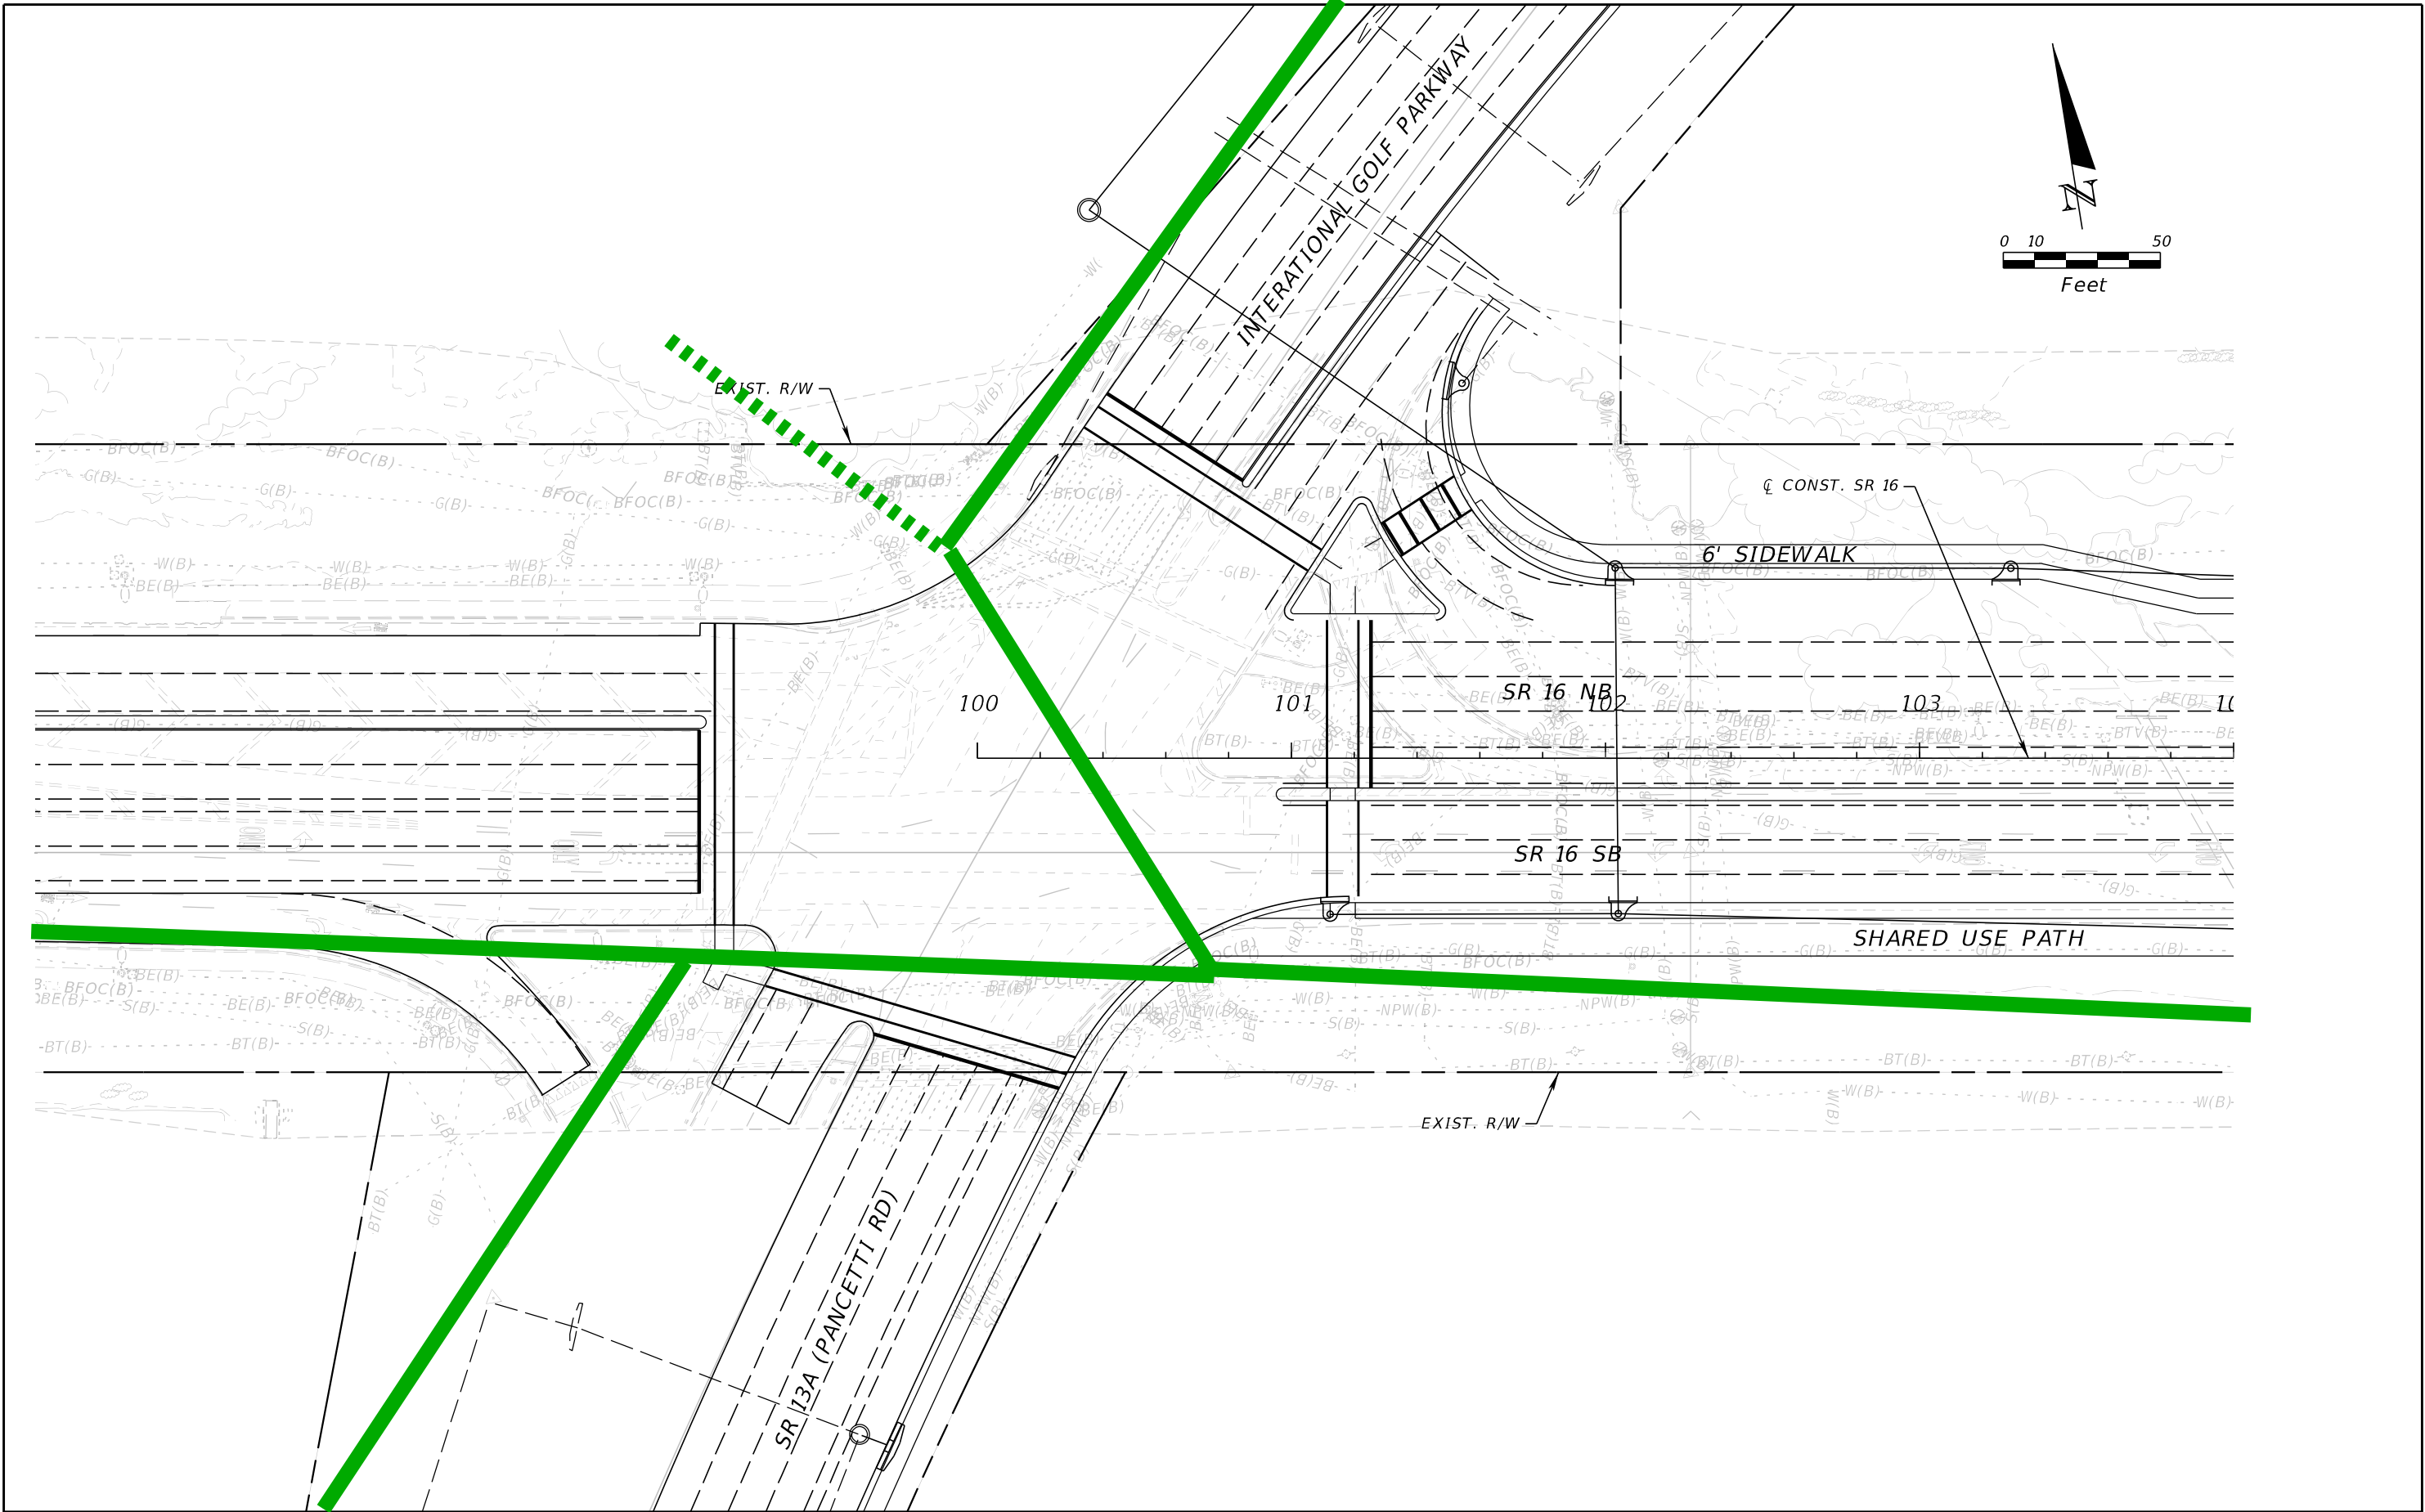

| REVISIONS |             |      |             | ENGINEER OF RECORD                                                                                                        |  | STATE OF FLORIDA<br>DEPARTMENT OF TRANSPORTATION |           |                      | ROADWAY PLAN | SHEET NO.<br><br>SR 16<br>- PLAN -<br>1 |
|-----------|-------------|------|-------------|---------------------------------------------------------------------------------------------------------------------------|--|--------------------------------------------------|-----------|----------------------|--------------|-----------------------------------------|
| DATE      | DESCRIPTION | DATE | DESCRIPTION | STEPHEN J. PARK, P.E.<br>LICENSE NUMBER: 77656<br>RS&H, INC.<br>10748 DEERWOOD PARK BLVD. SOUTH<br>JACKSONVILLE, FL 32256 |  | ROAD NO.                                         | COUNTY    | FINANCIAL PROJECT ID |              |                                         |
|           |             |      |             |                                                                                                                           |  | SR 16                                            | ST. JOHNS | 210447-5-52-01       |              |                                         |

THE OFFICIAL RECORD OF THIS SHEET IS THE ELECTRONIC FILE DIGITALLY SIGNED AND SEALED UNDER RULE 61G15-23.004, F.A.C.



8/5/2024 4:28:38 PM BeattyM  
c:\pw\_work\ysh\_pw\pw\_user\0439575\PLAINRD01.dgn

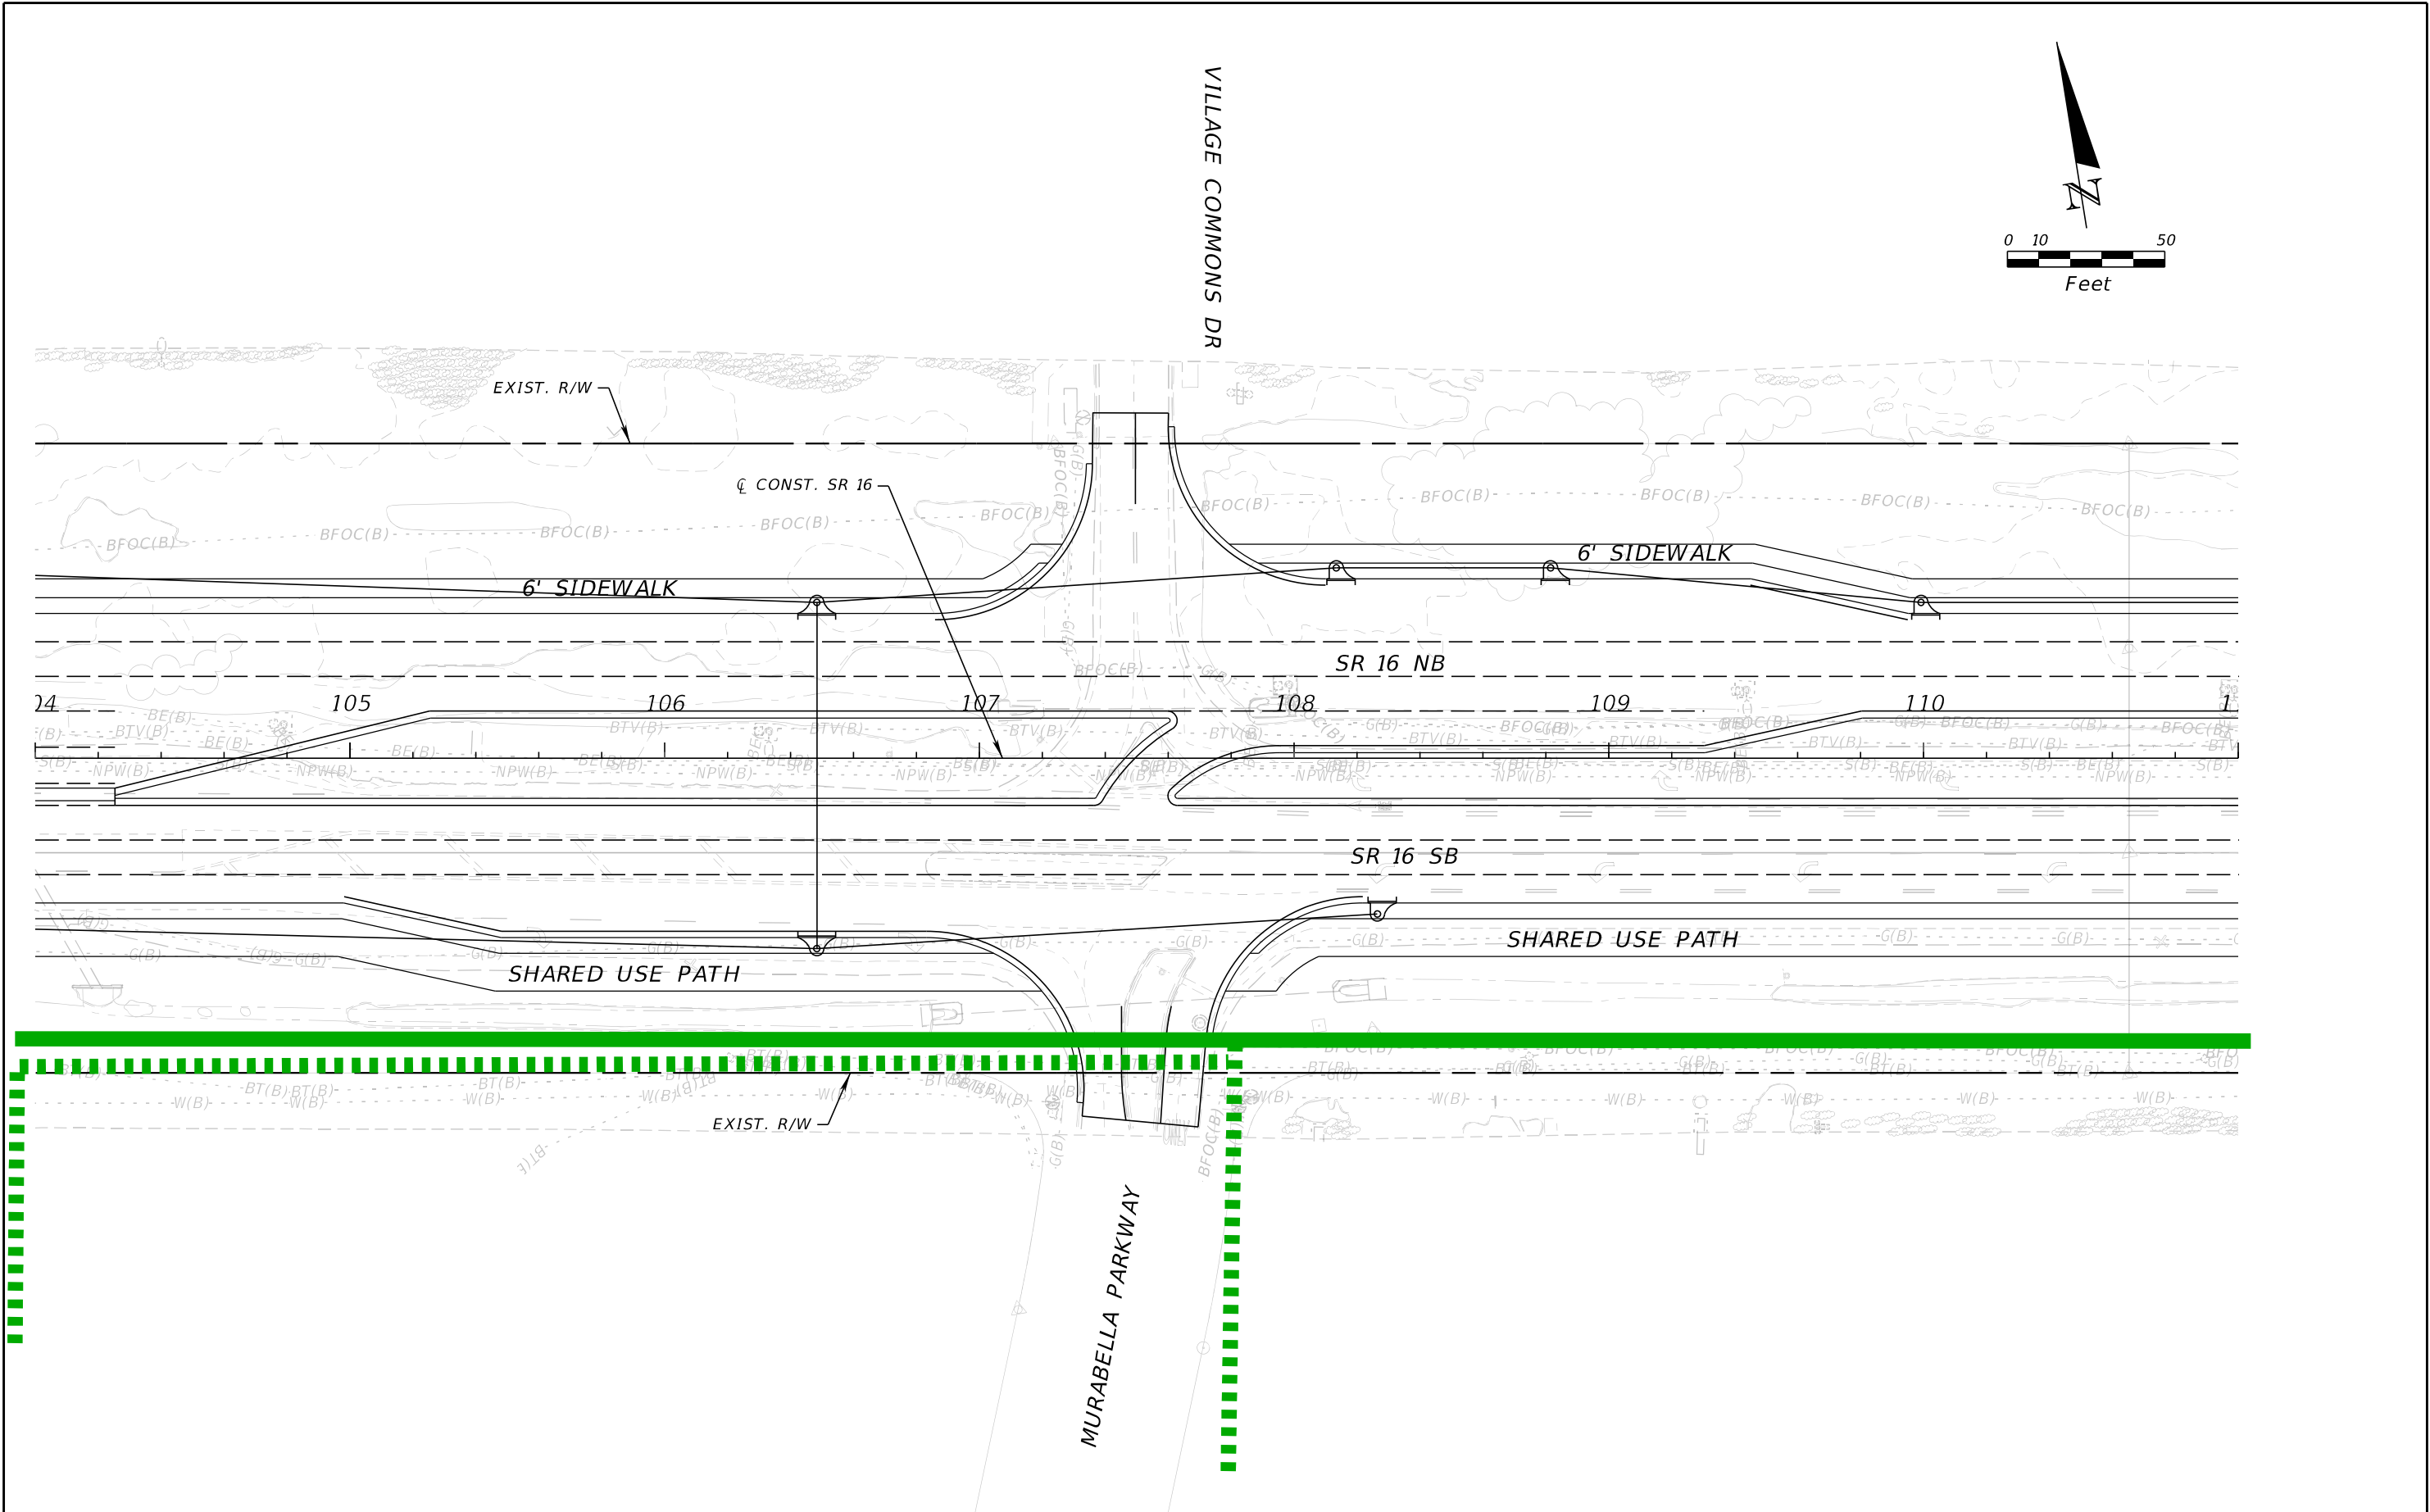

| REVISIONS |             |      |             | ENGINEER OF RECORD                                                                                                        | STATE OF FLORIDA<br>DEPARTMENT OF TRANSPORTATION |           |                      | ROADWAY PLAN | SHEET NO.              |
|-----------|-------------|------|-------------|---------------------------------------------------------------------------------------------------------------------------|--------------------------------------------------|-----------|----------------------|--------------|------------------------|
| DATE      | DESCRIPTION | DATE | DESCRIPTION |                                                                                                                           | ROAD NO.                                         | COUNTY    | FINANCIAL PROJECT ID |              |                        |
|           |             |      |             | STEPHEN J. PARK, P.E.<br>LICENSE NUMBER: 77656<br>RS&H, INC.<br>10748 DEERWOOD PARK BLVD. SOUTH<br>JACKSONVILLE, FL 32256 | SR 16                                            | ST. JOHNS | 210447-5-52-01       |              | SR 16<br>- PLAN -<br>2 |

THE OFFICIAL RECORD OF THIS SHEET IS THE ELECTRONIC FILE DIGITALLY SIGNED AND SEALED UNDER RULE 61G15-23.004, F.A.C.


8/5/2024 4:28:39 PM BeattyM  
c:\pw\_work\ysh\_pw\pw\_user\00439575\PLAINRD01.dgn

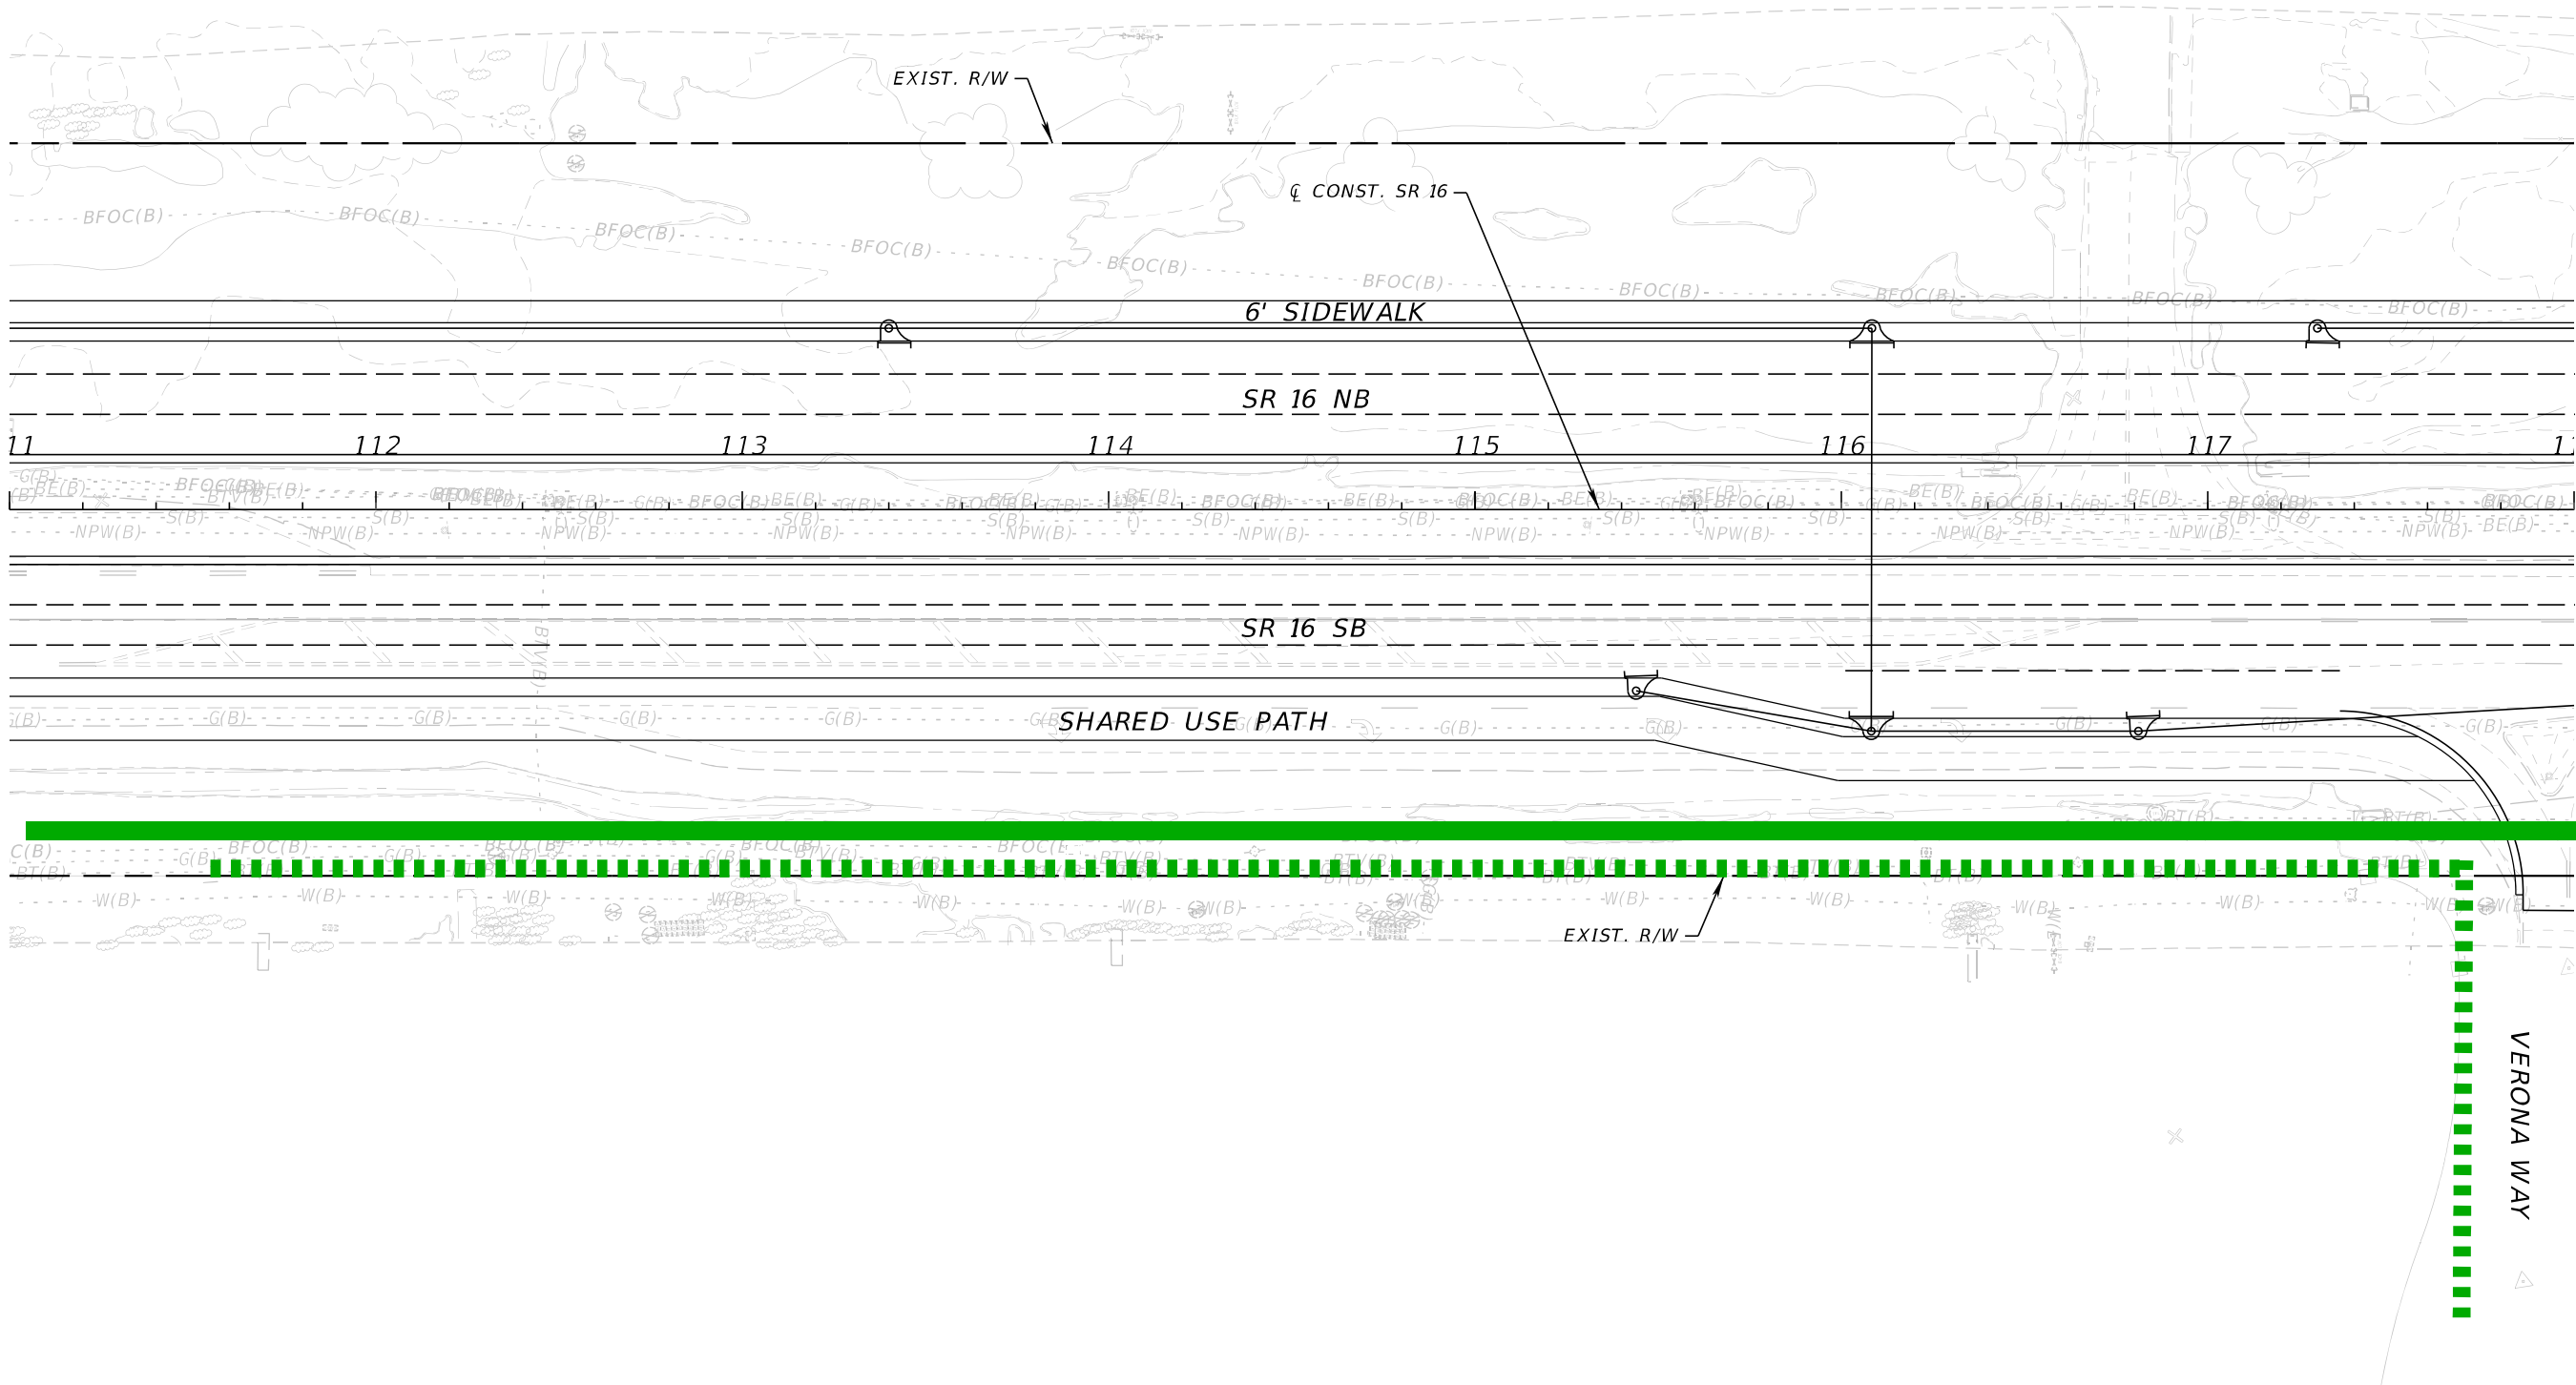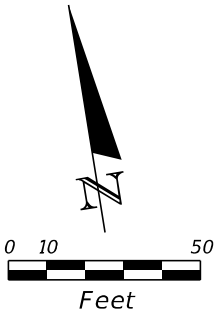

| REVISIONS |             |      |             | ENGINEER OF RECORD                                                                                                        | STATE OF FLORIDA<br>DEPARTMENT OF TRANSPORTATION |           |                      | SHEET<br>NO.          |
|-----------|-------------|------|-------------|---------------------------------------------------------------------------------------------------------------------------|--------------------------------------------------|-----------|----------------------|-----------------------|
| DATE      | DESCRIPTION | DATE | DESCRIPTION |                                                                                                                           | ROAD NO.                                         | COUNTY    | FINANCIAL PROJECT ID |                       |
|           |             |      |             |                                                                                                                           | SR 16                                            | ST. JOHNS | 210447-5-52-01       |                       |
|           |             |      |             | STEPHEN J. PARK, P.E.<br>LICENSE NUMBER: 77656<br>RS&H, INC.<br>10748 DEERWOOD PARK BLVD. SOUTH<br>JACKSONVILLE, FL 32256 |                                                  |           |                      | 11x17<br>Plan<br>Only |



8/5/2024 4:28:40 PM BeattyM  
c:\pw\_work\sh\_pw\pw\_user\0439575\PLANRD01.dgn

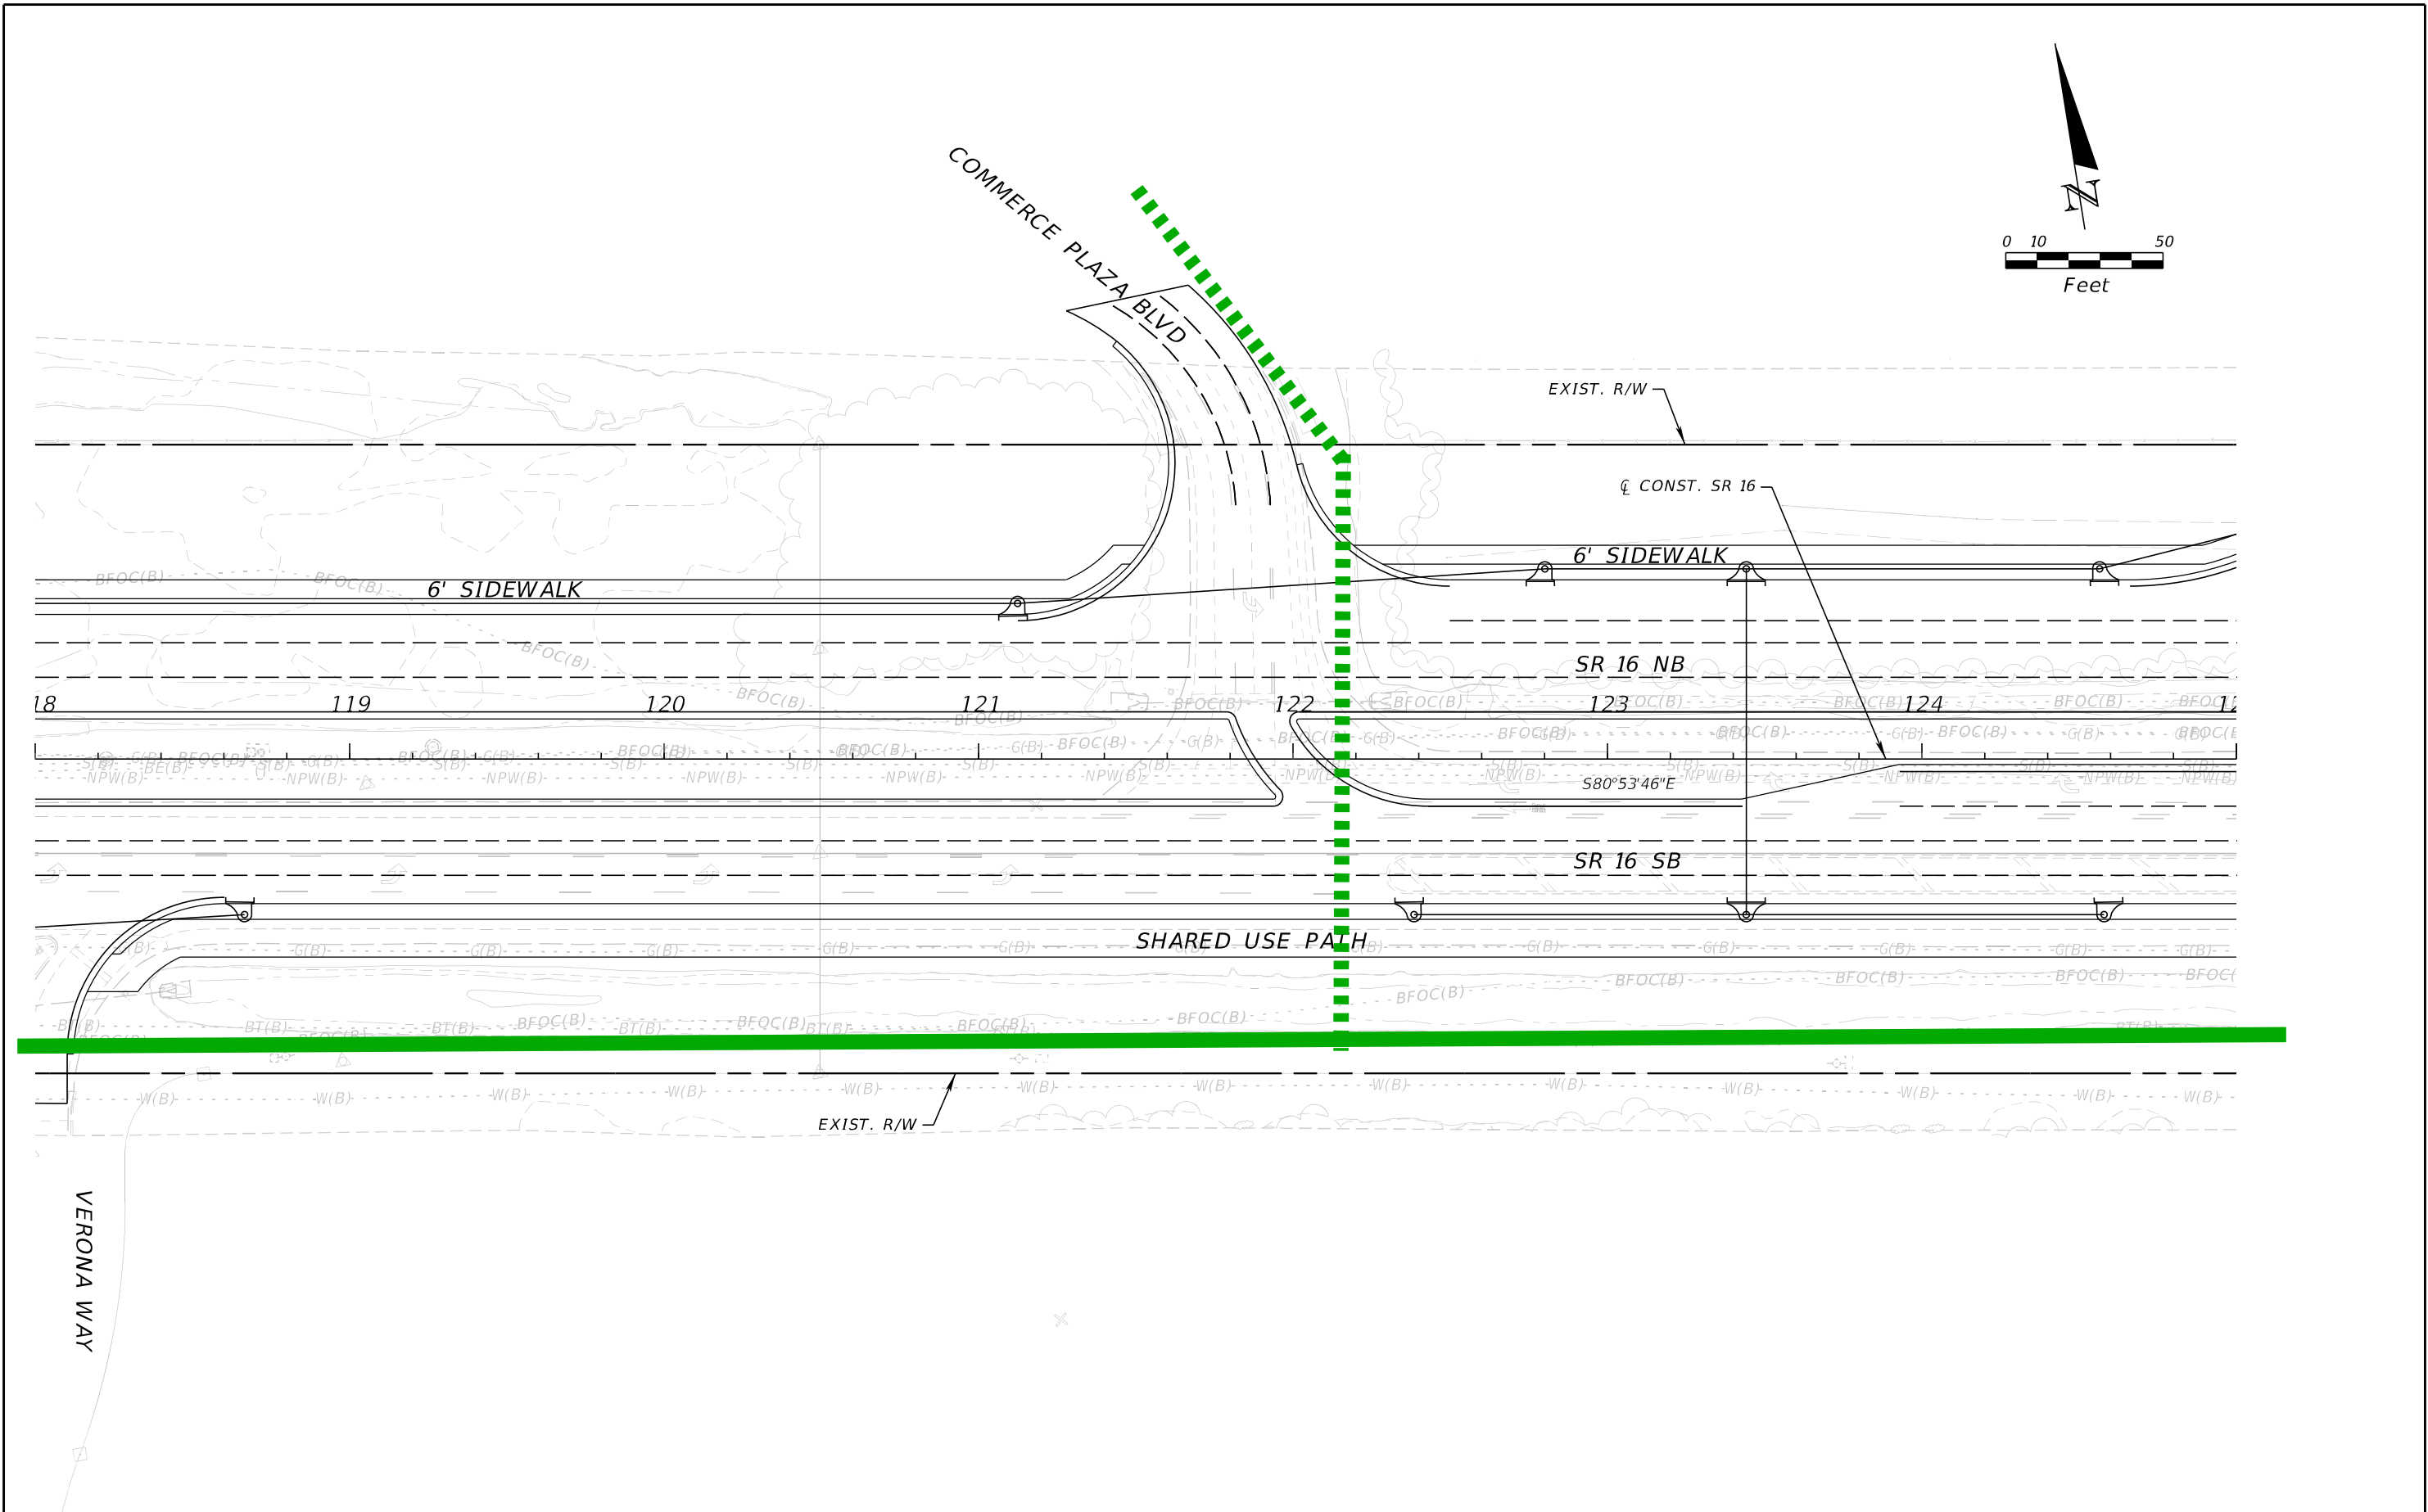



| REVISIONS |             |      |             | ENGINEER OF RECORD | STATE OF FLORIDA<br>DEPARTMENT OF TRANSPORTATION |           |                      | ROADWAY PLAN | SHEET NO.             |
|-----------|-------------|------|-------------|--------------------|--------------------------------------------------|-----------|----------------------|--------------|-----------------------|
| DATE      | DESCRIPTION | DATE | DESCRIPTION |                    | ROAD NO.                                         | COUNTY    | FINANCIAL PROJECT ID |              |                       |
|           |             |      |             |                    | SR 16                                            | ST. JOHNS | 210447-5-52-01       |              | SR 16<br>- PLAN-<br>4 |

STEPHEN J. PARK, P.E.  
LICENSE NUMBER: 77656  
RS&H, INC.  
10748 DEERWOOD PARK BLVD. SOUTH  
JACKSONVILLE, FL 32256

THE OFFICIAL RECORD OF THIS SHEET IS THE ELECTRONIC FILE DIGITALLY SIGNED AND SEALED UNDER RULE 61G15-23.004, F.A.C.




8/5/2024 4:28:40 PM BeattyM  
c:\pw\_work\sh\_pw\pw\_user\0439575\PLANRD01.dgn

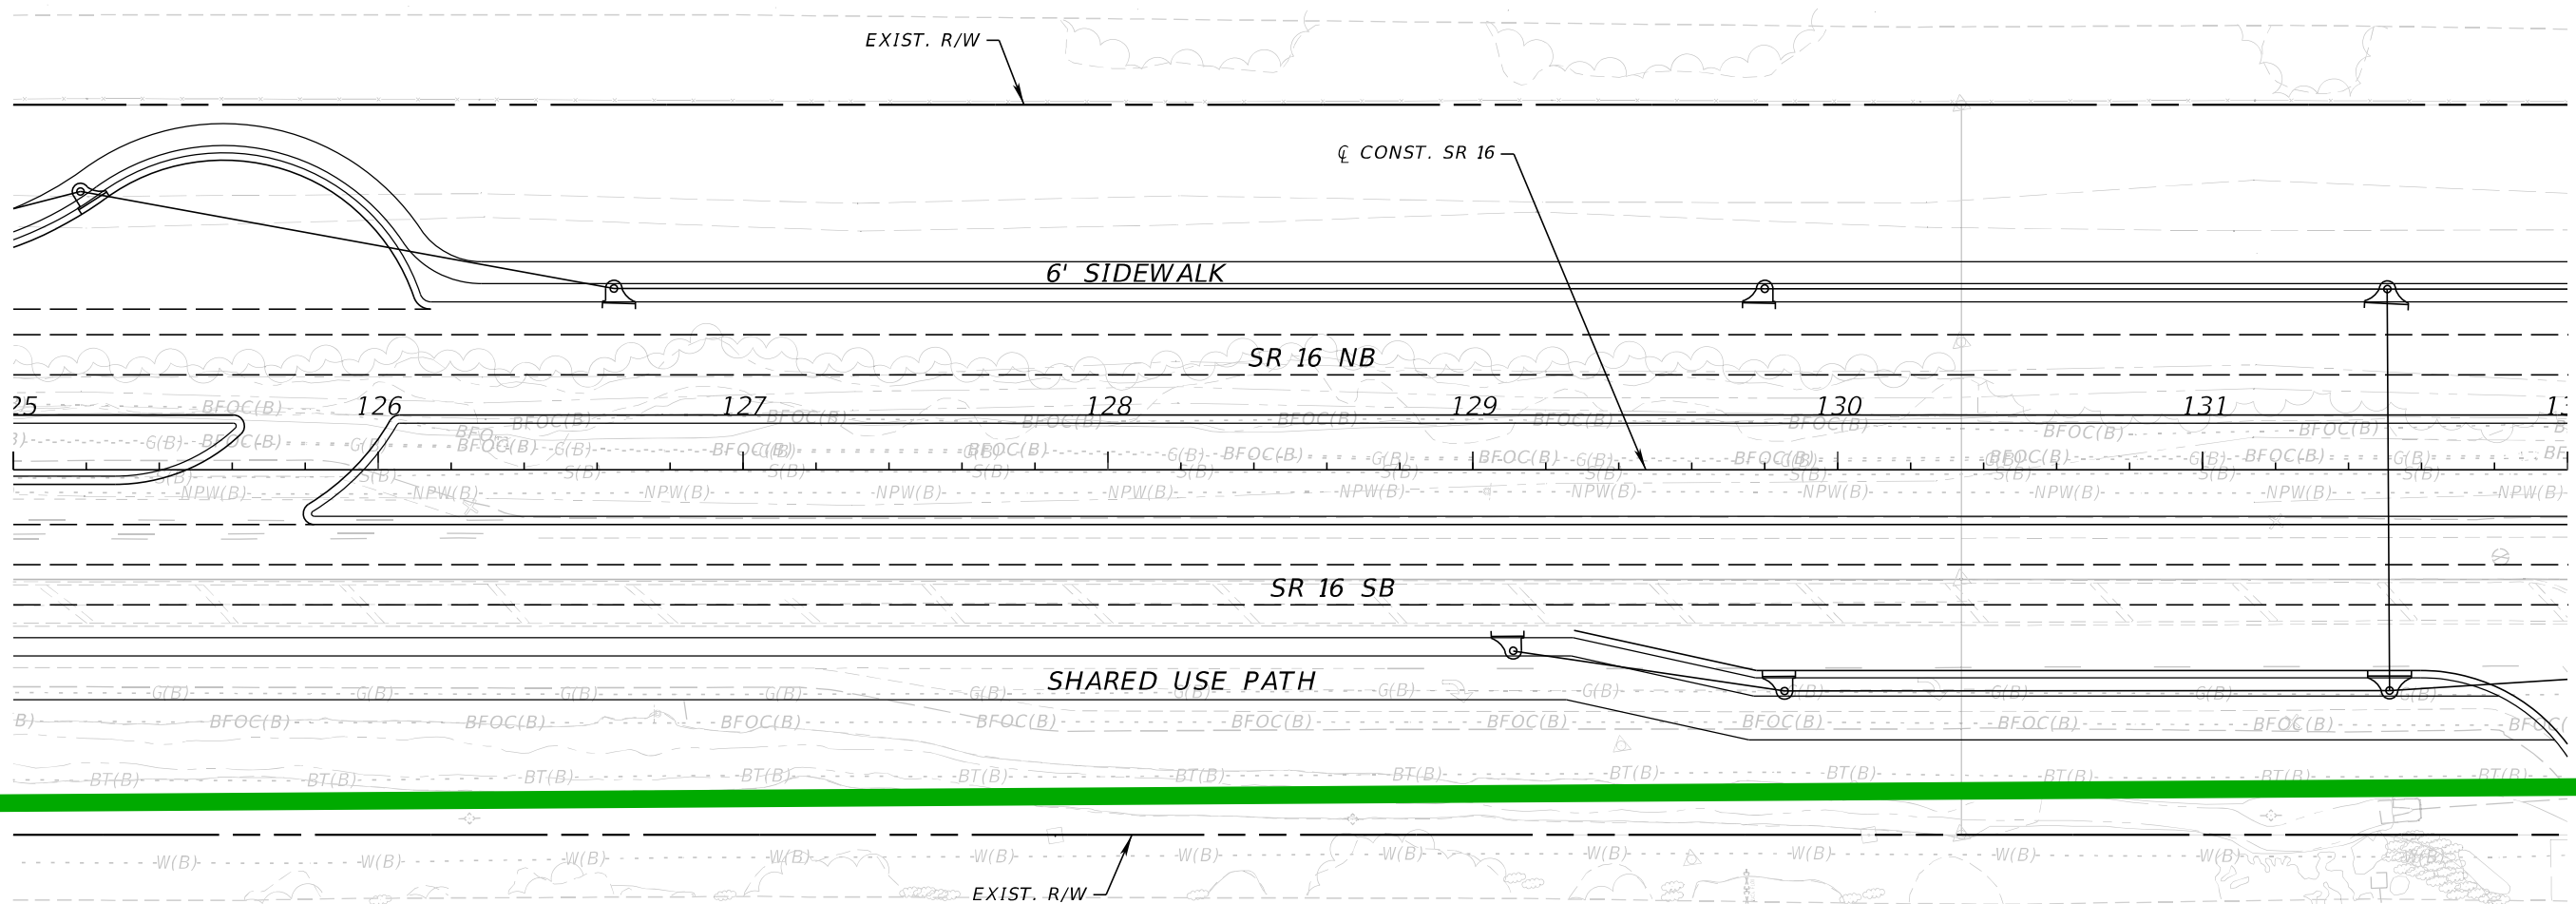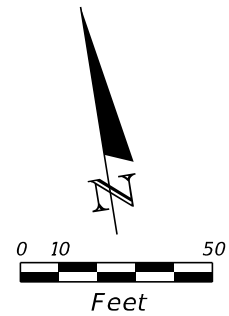

| REVISIONS |             |      |             | ENGINEER OF RECORD                                                                                                        |  | STATE OF FLORIDA<br>DEPARTMENT OF TRANSPORTATION |           |                      | ROADWAY PLAN | SHEET NO.             |
|-----------|-------------|------|-------------|---------------------------------------------------------------------------------------------------------------------------|--|--------------------------------------------------|-----------|----------------------|--------------|-----------------------|
| DATE      | DESCRIPTION | DATE | DESCRIPTION | STEPHEN J. PARK, P.E.<br>LICENSE NUMBER: 77656<br>RS&H, INC.<br>10748 DEERWOOD PARK BLVD. SOUTH<br>JACKSONVILLE, FL 32256 |  | ROAD NO.                                         | COUNTY    | FINANCIAL PROJECT ID |              |                       |
|           |             |      |             |                                                                                                                           |  | SR 16                                            | ST. JOHNS | 210447-5-52-01       |              | SR 16<br>- PLAN-<br>5 |


THE OFFICIAL RECORD OF THIS SHEET IS THE ELECTRONIC FILE DIGITALLY SIGNED AND SEALED UNDER RULE 61G15-23.004, F.A.C.

8/5/2024 4:28:41 PM BeattyM  
c:\pw\_work\sh\_pw\pw\_user\0439575\PLANRD01.dgn

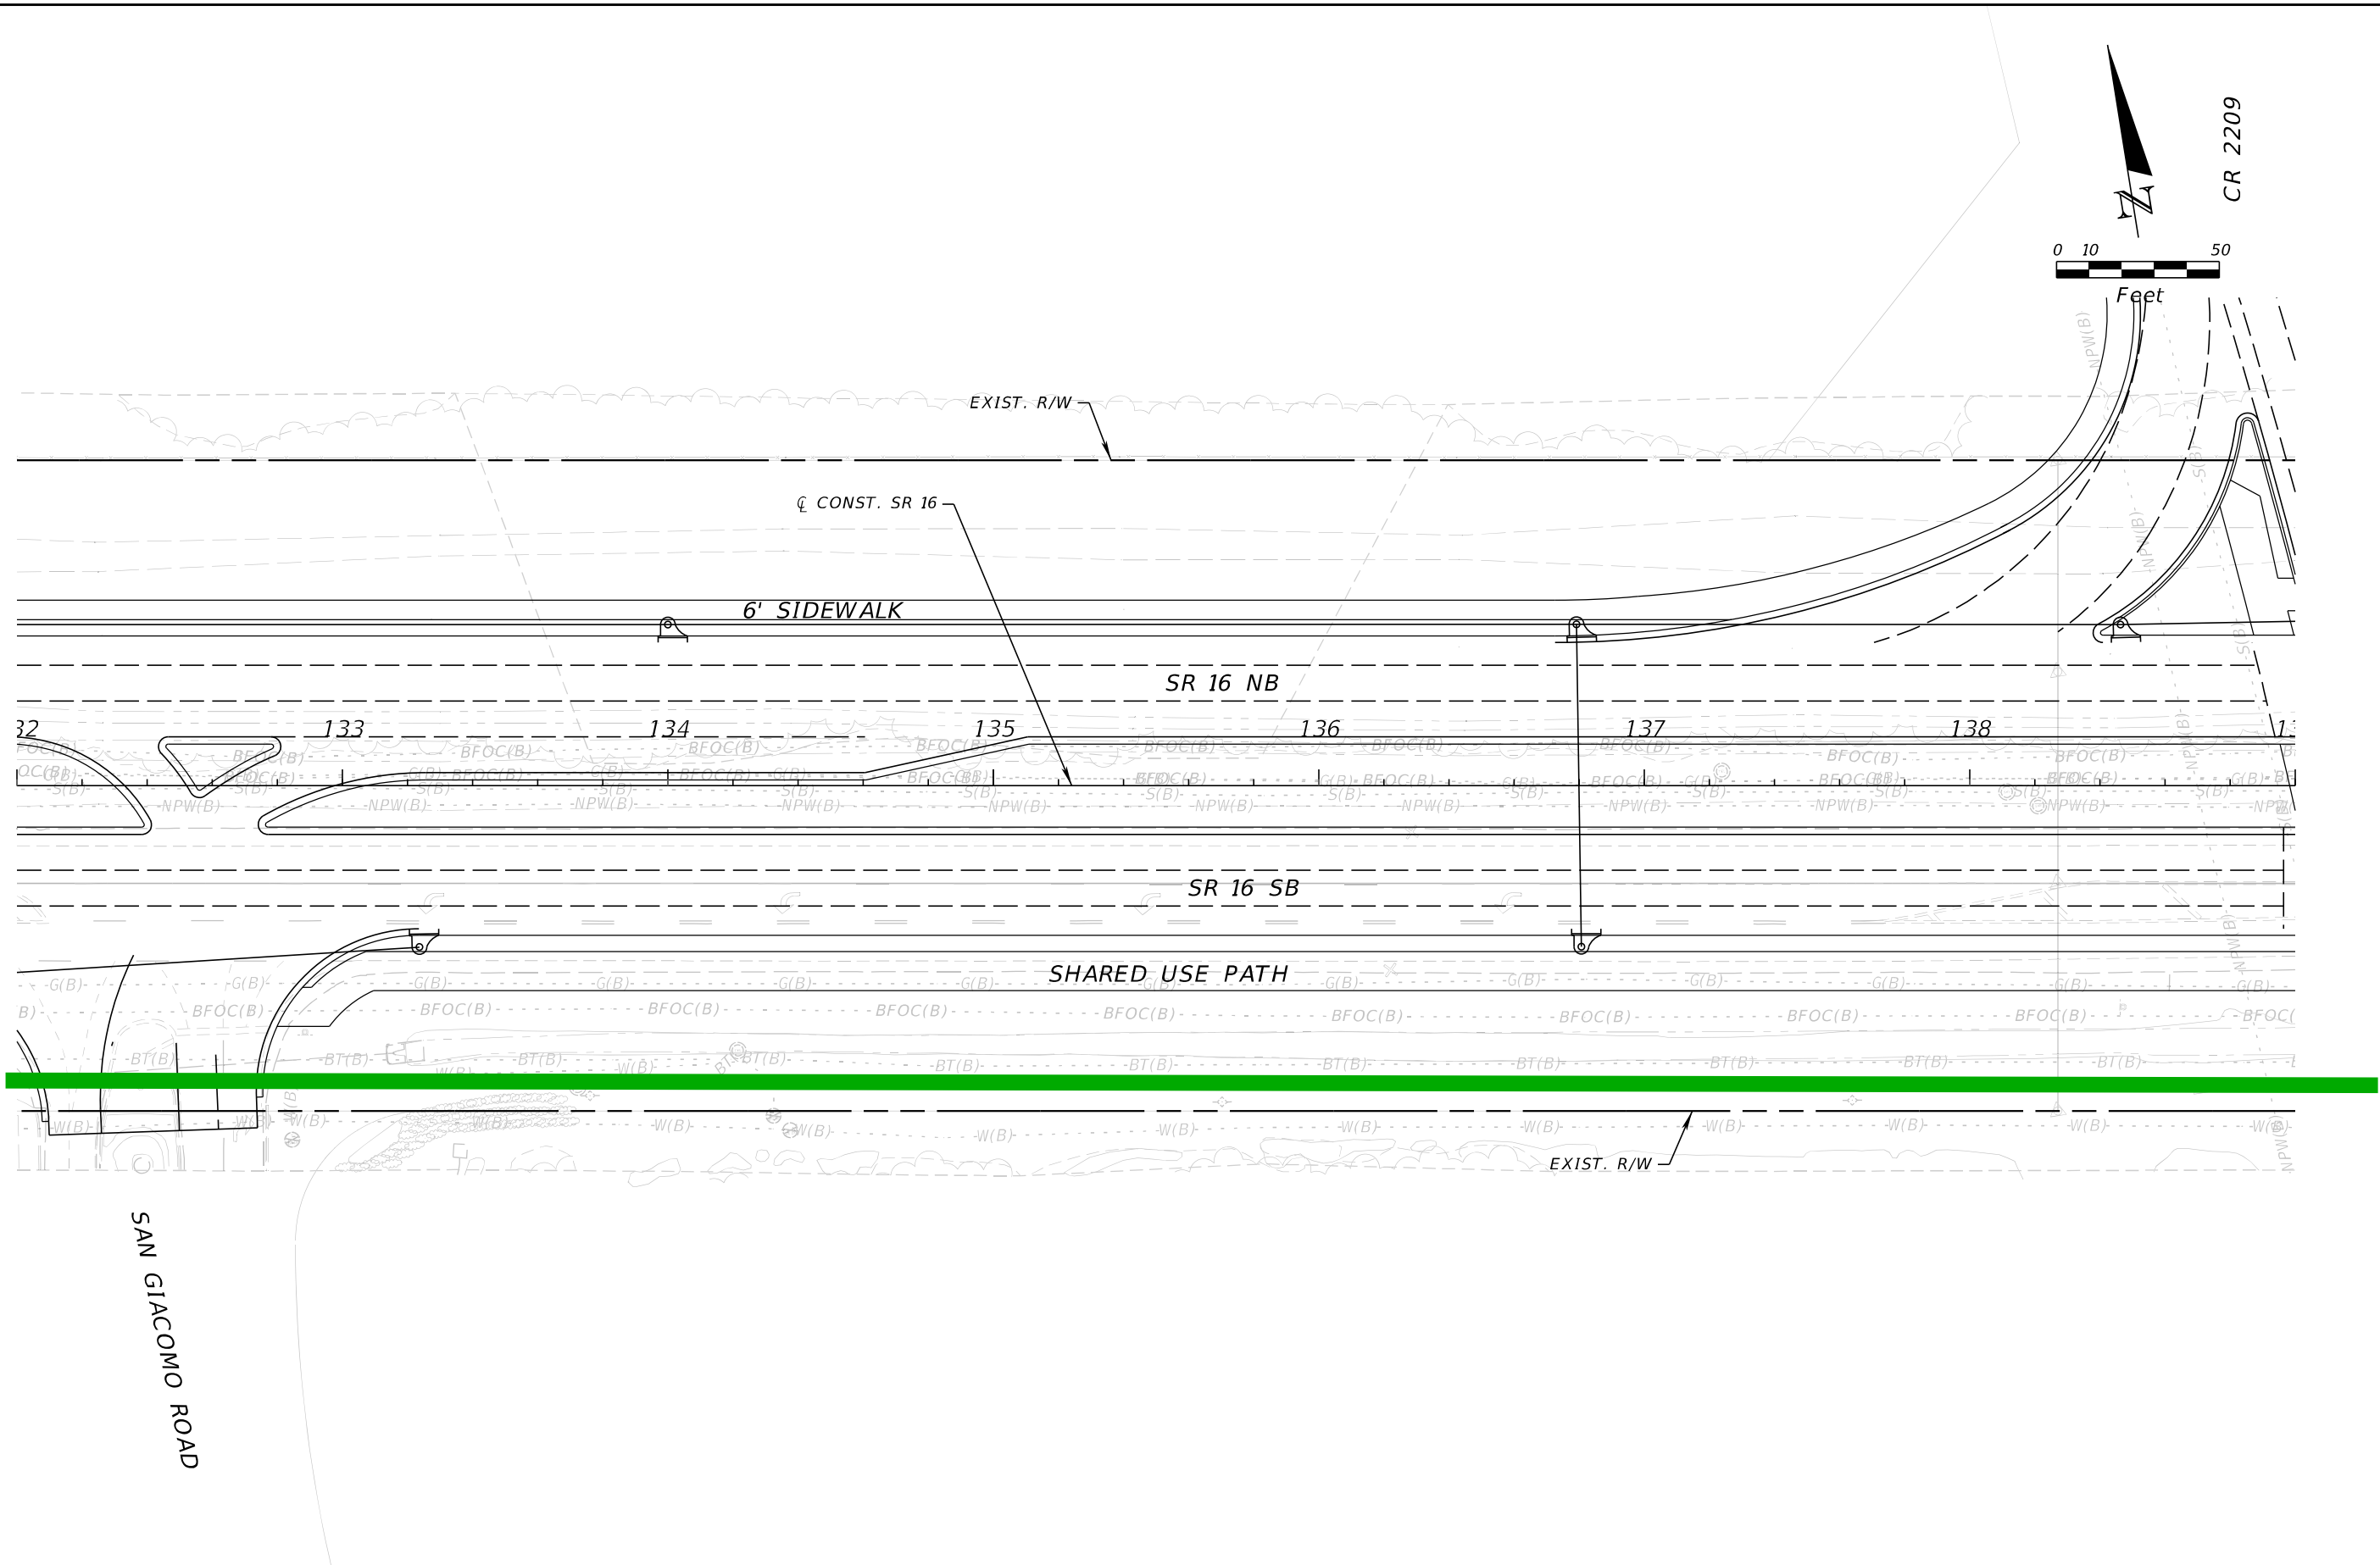

| REVISIONS |             |      |             | ENGINEER OF RECORD                                                                                                        |  | STATE OF FLORIDA<br>DEPARTMENT OF TRANSPORTATION |           | ROADWAY PLAN                           | SHEET NO.<br><br>SR 16<br>- PLAN -<br>6 |
|-----------|-------------|------|-------------|---------------------------------------------------------------------------------------------------------------------------|--|--------------------------------------------------|-----------|----------------------------------------|-----------------------------------------|
| DATE      | DESCRIPTION | DATE | DESCRIPTION | STEPHEN J. PARK, P.E.<br>LICENSE NUMBER: 77656<br>RS&H, INC.<br>10748 DEERWOOD PARK BLVD. SOUTH<br>JACKSONVILLE, FL 32256 |  | ROAD NO.                                         | COUNTY    |                                        |                                         |
|           |             |      |             |                                                                                                                           |  | SR 16                                            | ST. JOHNS | FINANCIAL PROJECT ID<br>210447-5-52-01 |                                         |


8/5/2024 4:28:42 PM BeattyM  
c:\pw\_work\sh\_pw\pw\_user\0439575\PLAINRD01.dgn

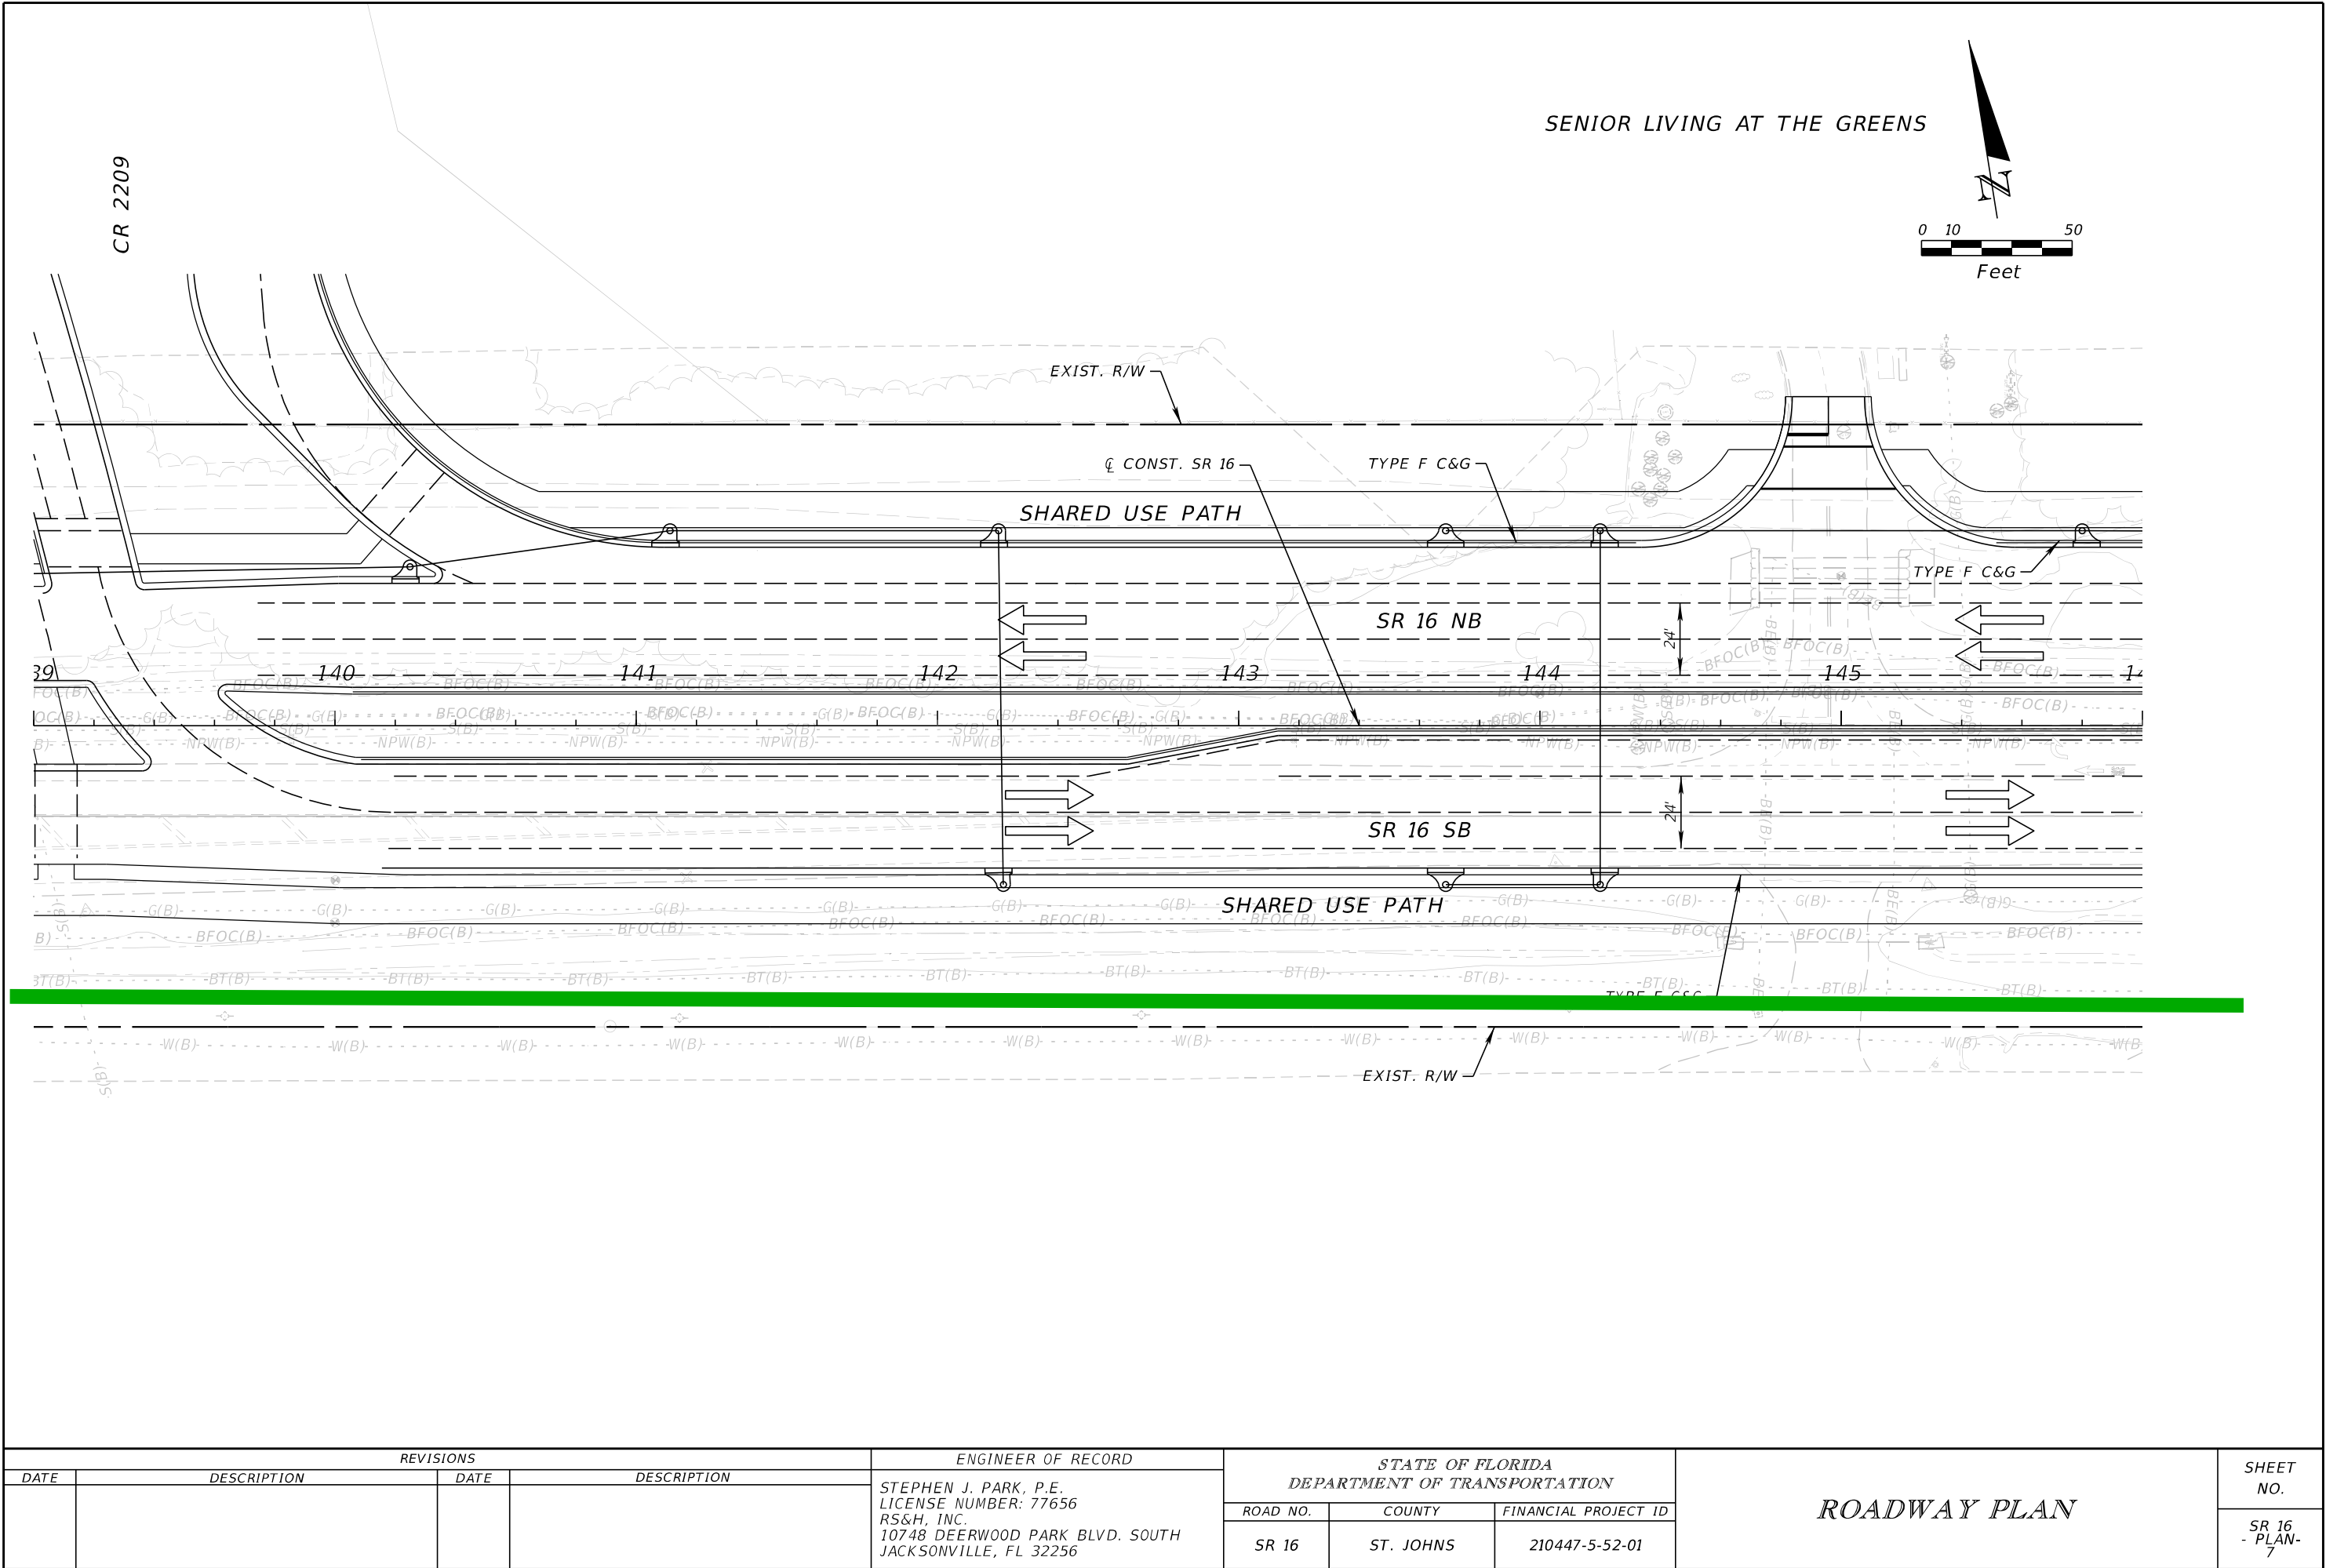

| REVISIONS |             |      |             | ENGINEER OF RECORD                                                                                                        |  | STATE OF FLORIDA<br>DEPARTMENT OF TRANSPORTATION |           |                      | ROADWAY PLAN | SHEET NO.<br><br>SR 16<br>- PLAN -<br>7 |
|-----------|-------------|------|-------------|---------------------------------------------------------------------------------------------------------------------------|--|--------------------------------------------------|-----------|----------------------|--------------|-----------------------------------------|
| DATE      | DESCRIPTION | DATE | DESCRIPTION | STEPHEN J. PARK, P.E.<br>LICENSE NUMBER: 77656<br>RS&H, INC.<br>10748 DEERWOOD PARK BLVD. SOUTH<br>JACKSONVILLE, FL 32256 |  | ROAD NO.                                         | COUNTY    | FINANCIAL PROJECT ID |              |                                         |
|           |             |      |             |                                                                                                                           |  | SR 16                                            | ST. JOHNS | 210447-5-52-01       |              |                                         |

THE OFFICIAL RECORD OF THIS SHEET IS THE ELECTRONIC FILE DIGITALLY SIGNED AND SEALED UNDER RULE 61G15-23.004, F.A.C.



8/5/2024 4:28:42 PM BeattyM  
c:\pw\_work\sh\_pw\pw\_user\0439575\PLANRD01.dgn

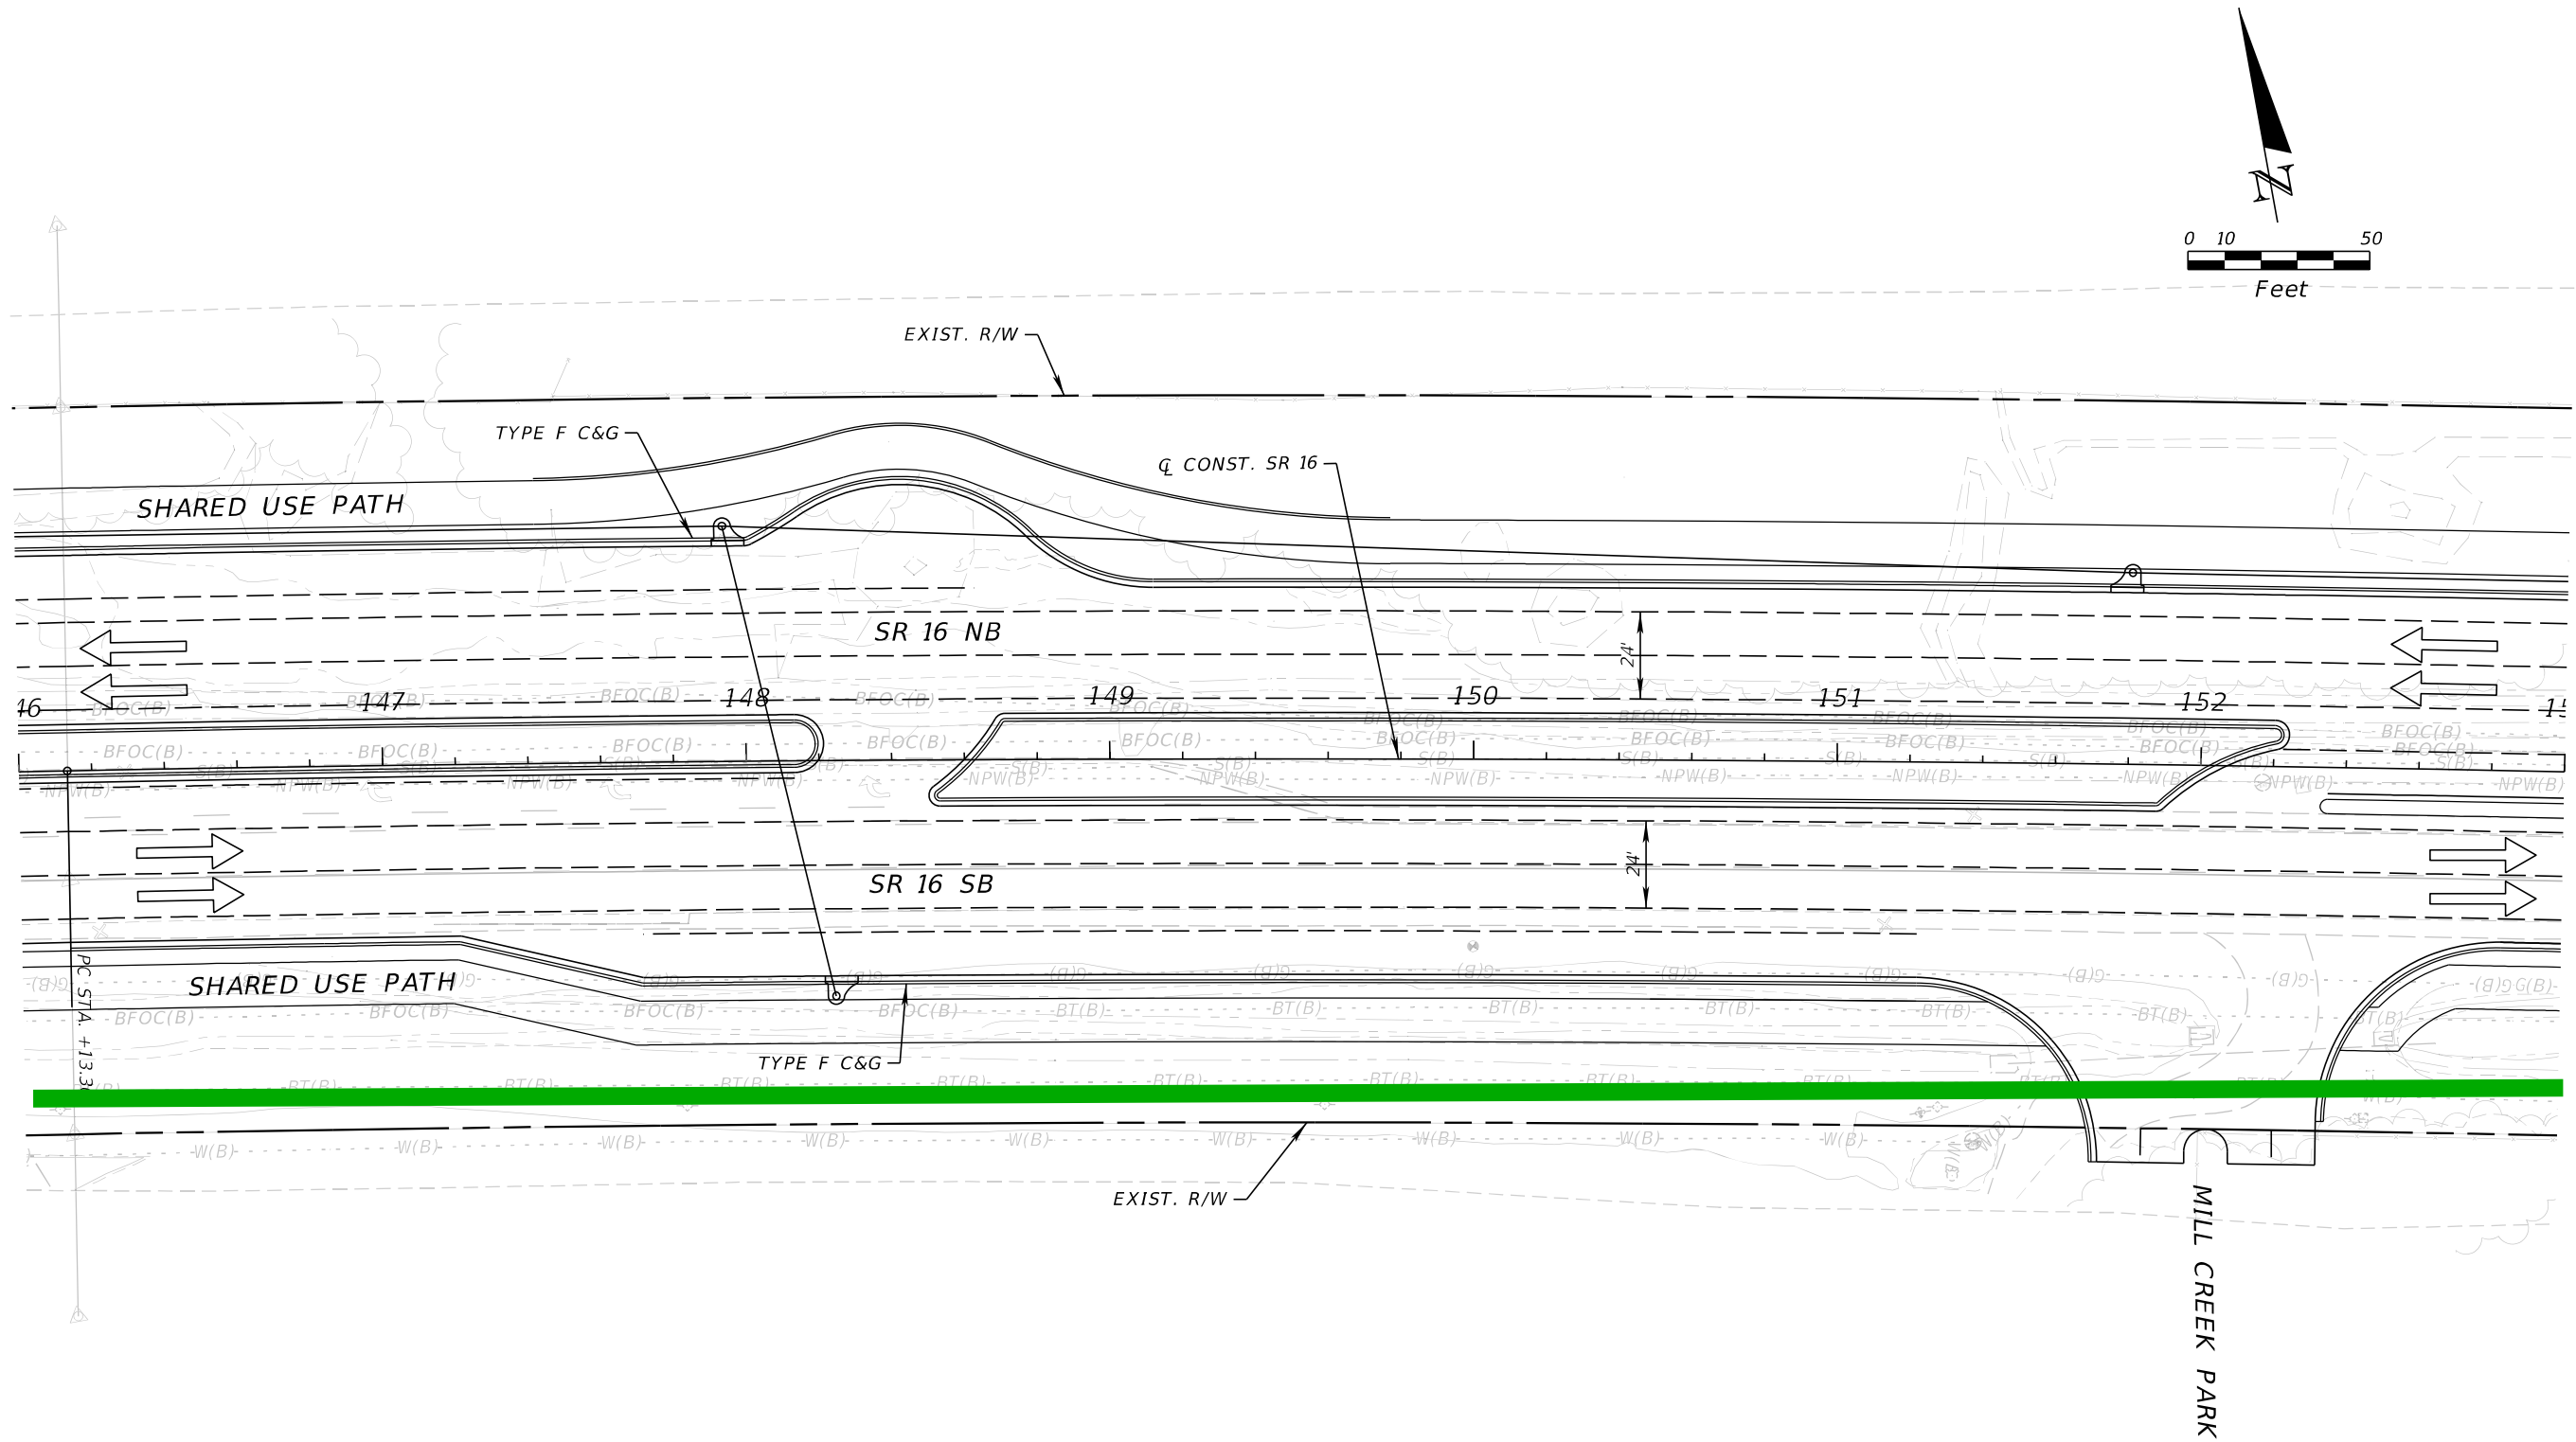

| REVISIONS |             |      |             | ENGINEER OF RECORD                                                                                                        | STATE OF FLORIDA<br>DEPARTMENT OF TRANSPORTATION |           |                      | ROADWAY PLAN | SHEET NO.<br>SR 16<br>PLAN-8 |
|-----------|-------------|------|-------------|---------------------------------------------------------------------------------------------------------------------------|--------------------------------------------------|-----------|----------------------|--------------|------------------------------|
| DATE      | DESCRIPTION | DATE | DESCRIPTION |                                                                                                                           | ROAD NO.                                         | COUNTY    | FINANCIAL PROJECT ID |              |                              |
|           |             |      |             | STEPHEN J. PARK, P.E.<br>LICENSE NUMBER: 77656<br>RS&H, INC.<br>10748 DEERWOOD PARK BLVD. SOUTH<br>JACKSONVILLE, FL 32256 | SR 16                                            | ST. JOHNS | 210447-5-52-01       |              |                              |

THE OFFICIAL RECORD OF THIS SHEET IS THE ELECTRONIC FILE DIGITALLY SIGNED AND SEALED UNDER RULE 61G15-23.004, F.A.C.

8/5/2024 4:28:43 PM BeattyM  
c:\pw\_work\sh\_pw\pw\_user\0439575\PLANRD01.dgn

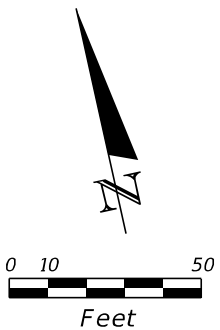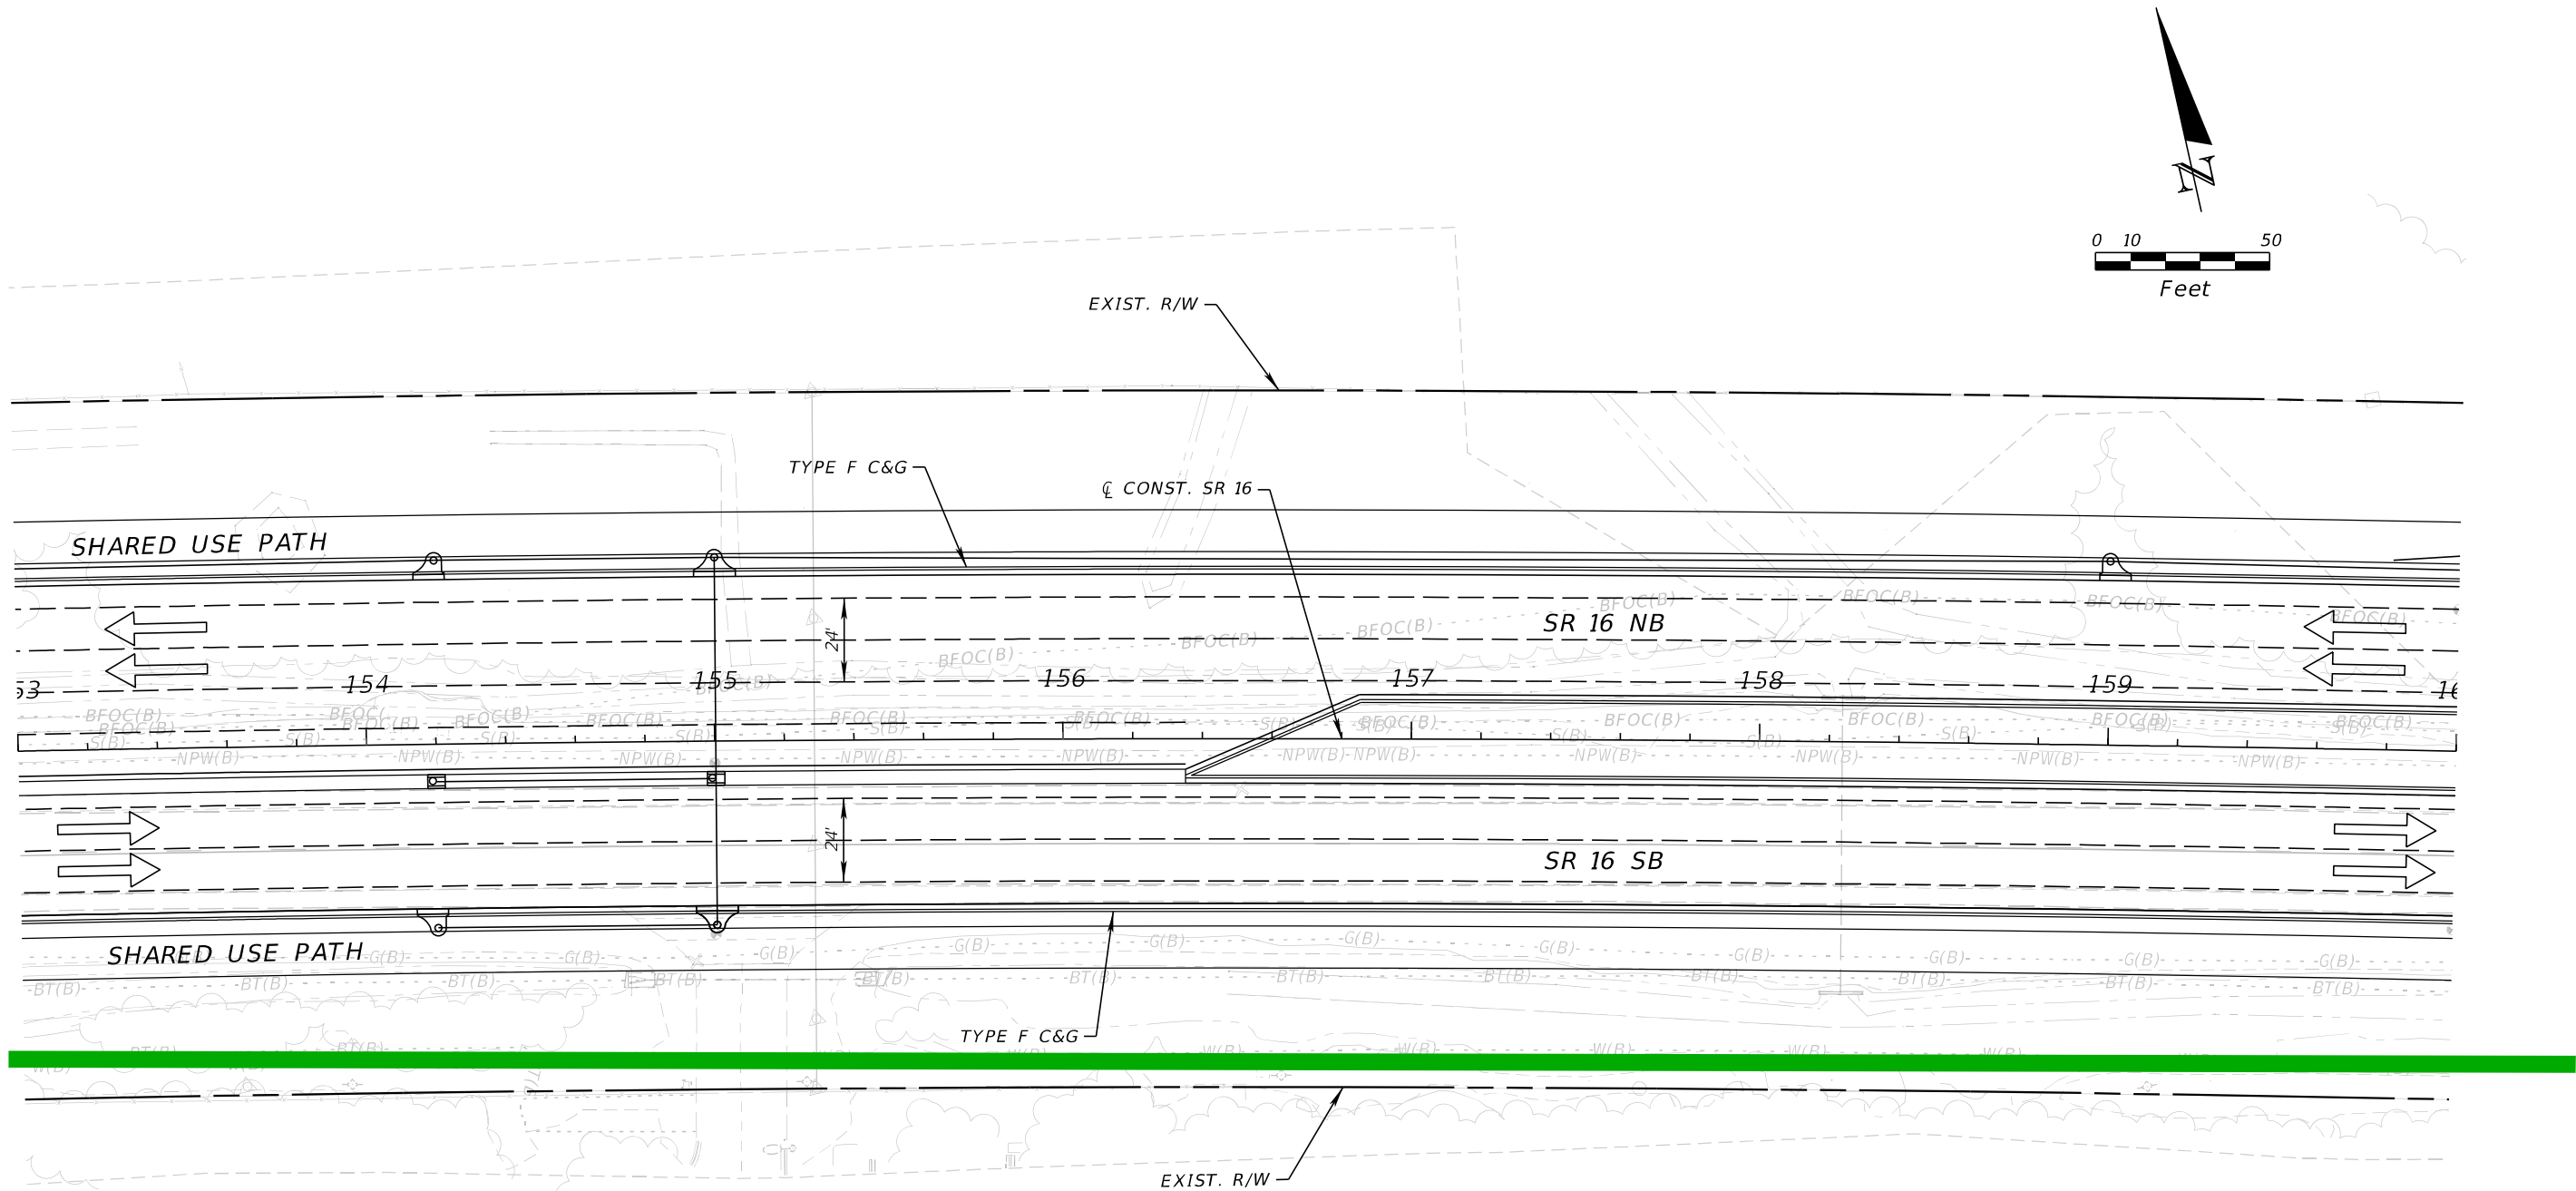


| REVISIONS |             |      |             | ENGINEER OF RECORD                                                                                                        |  | STATE OF FLORIDA<br>DEPARTMENT OF TRANSPORTATION |           |                      | ROADWAY PLAN | SHEET NO.<br><br>SR 16<br>- PLAN -<br>9 |
|-----------|-------------|------|-------------|---------------------------------------------------------------------------------------------------------------------------|--|--------------------------------------------------|-----------|----------------------|--------------|-----------------------------------------|
| DATE      | DESCRIPTION | DATE | DESCRIPTION | STEPHEN J. PARK, P.E.<br>LICENSE NUMBER: 77656<br>RS&H, INC.<br>10748 DEERWOOD PARK BLVD. SOUTH<br>JACKSONVILLE, FL 32256 |  | ROAD NO.                                         | COUNTY    | FINANCIAL PROJECT ID |              |                                         |
|           |             |      |             |                                                                                                                           |  | SR 16                                            | ST. JOHNS | 210447-5-52-01       |              |                                         |

THE OFFICIAL RECORD OF THIS SHEET IS THE ELECTRONIC FILE DIGITALLY SIGNED AND SEALED UNDER RULE 61G15-23.004, F.A.C.




8/5/2024 4:28:43 PM BeattyM  
c:\pw\_work\ysh\_pw\pw\_user\0439575\PLANRD01.dgn

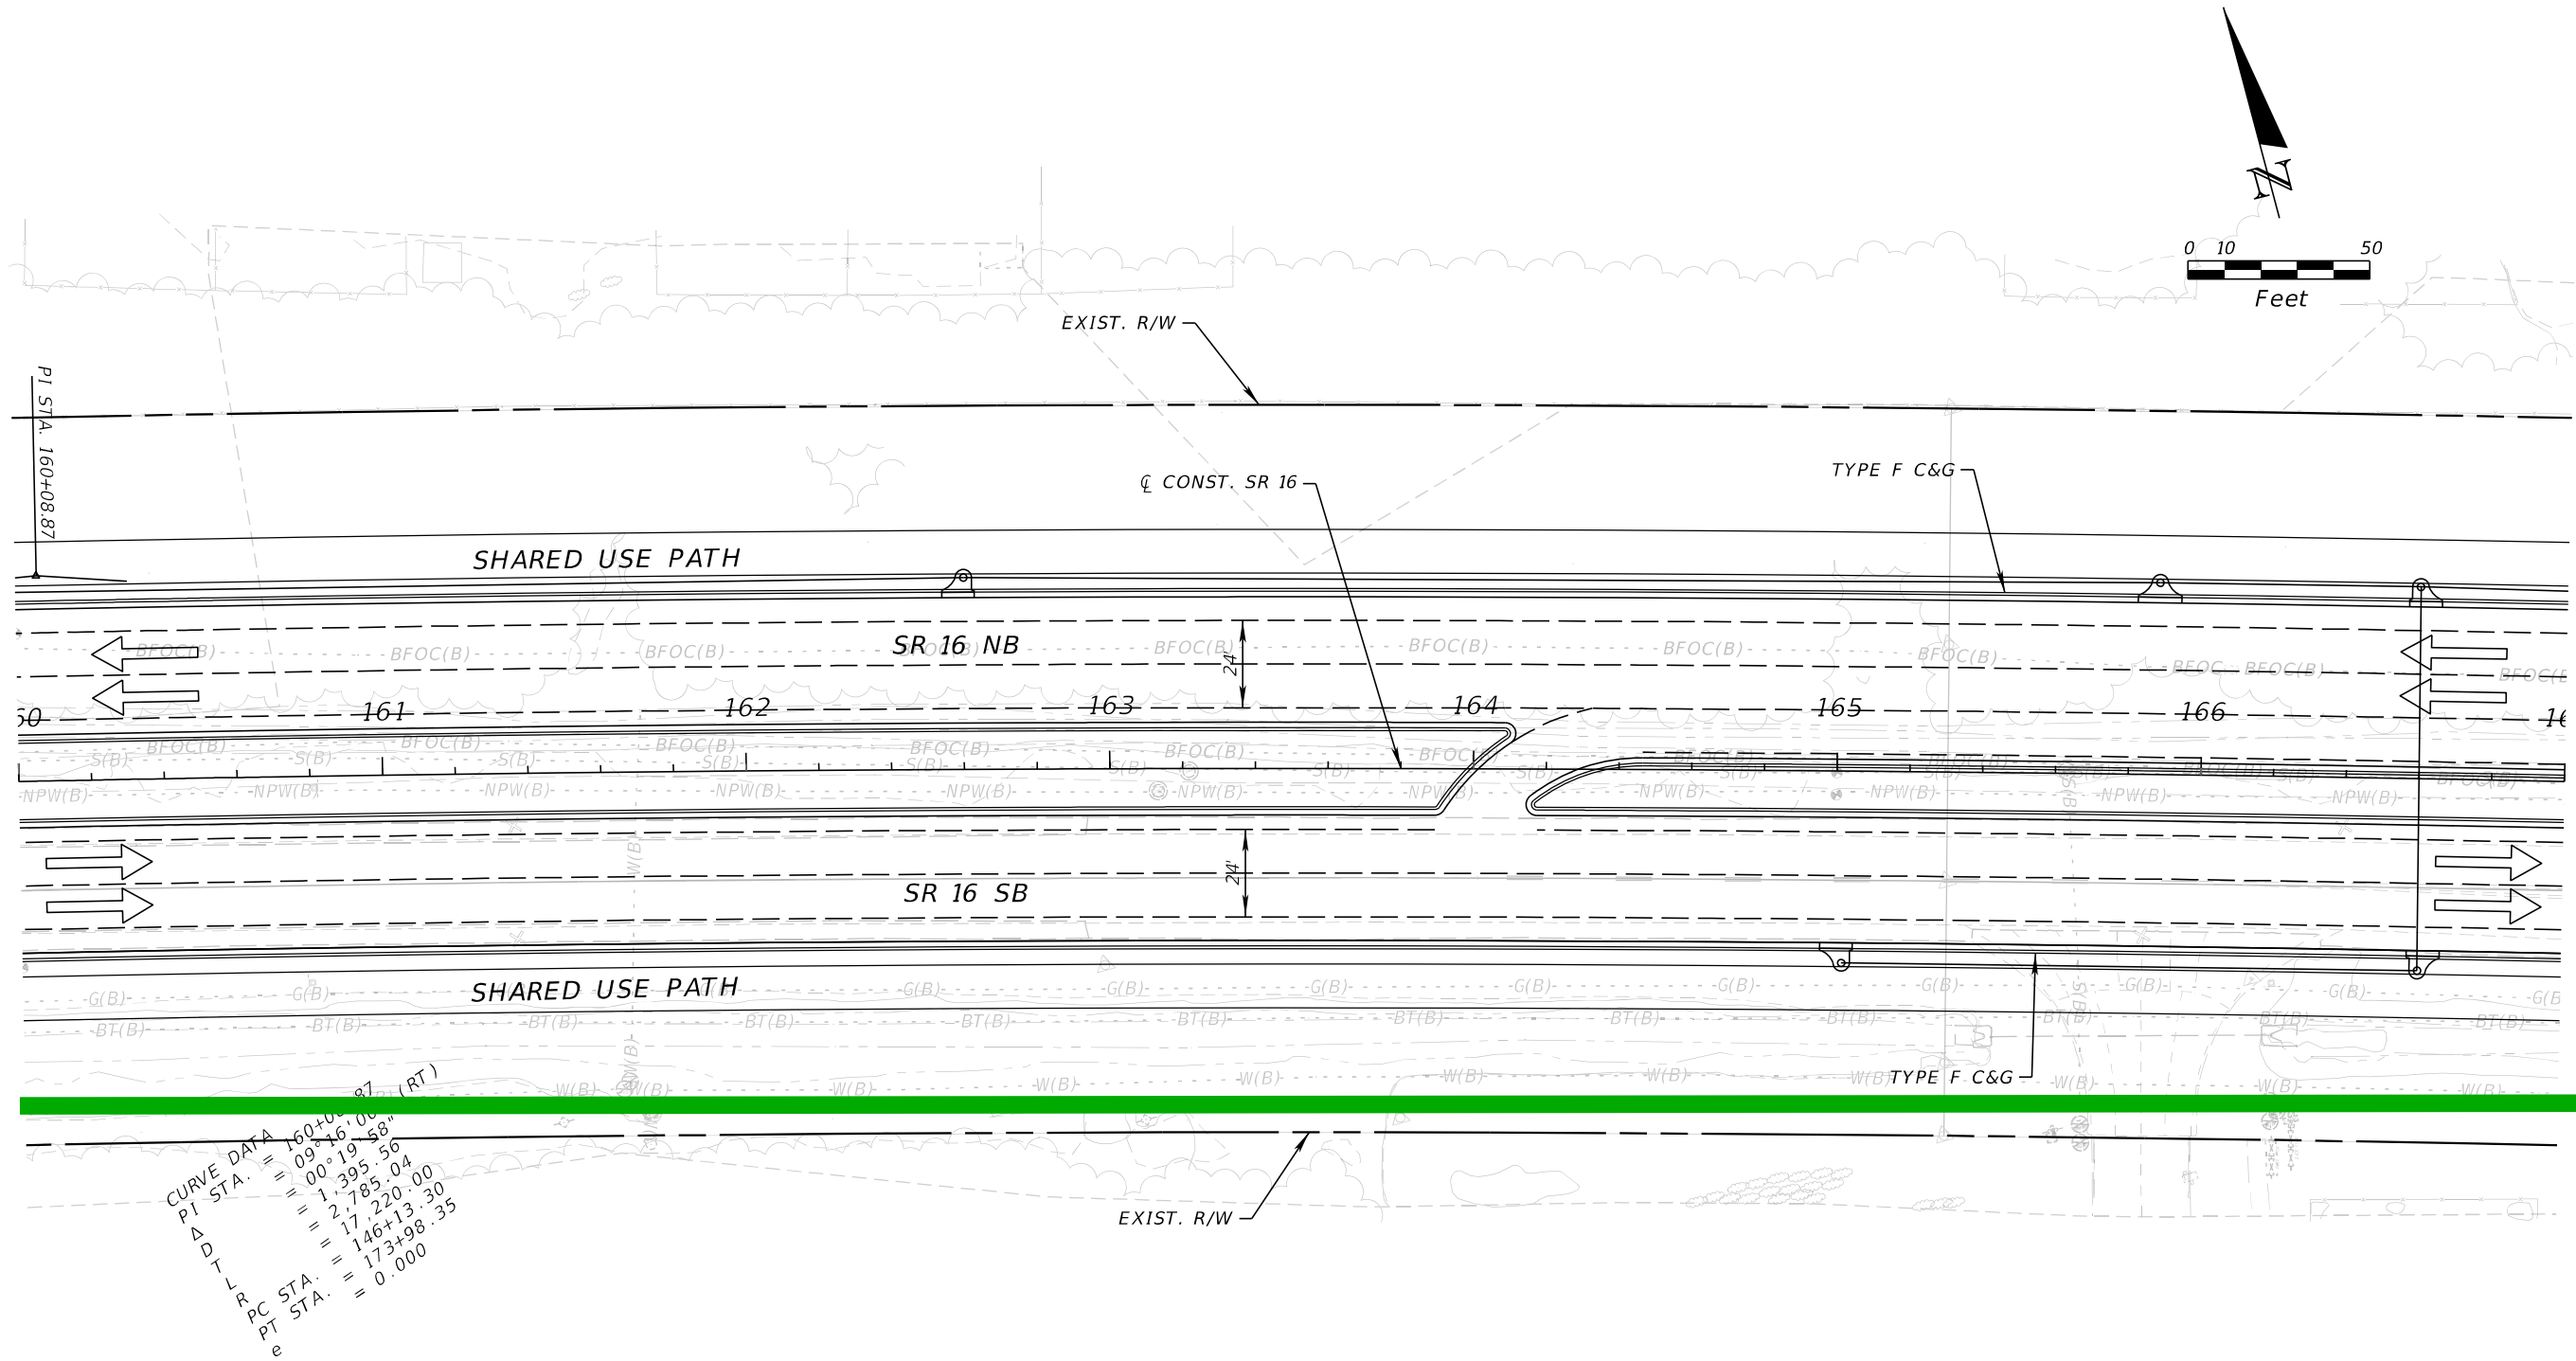

| REVISIONS |             |      |             | ENGINEER OF RECORD                                                                                                        |  | STATE OF FLORIDA<br>DEPARTMENT OF TRANSPORTATION |           |                      | ROADWAY PLAN | SHEET NO.<br><br>SR 16<br>- PLAN-<br>10 |
|-----------|-------------|------|-------------|---------------------------------------------------------------------------------------------------------------------------|--|--------------------------------------------------|-----------|----------------------|--------------|-----------------------------------------|
| DATE      | DESCRIPTION | DATE | DESCRIPTION | STEPHEN J. PARK, P.E.<br>LICENSE NUMBER: 77656<br>RS&H, INC.<br>10748 DEERWOOD PARK BLVD. SOUTH<br>JACKSONVILLE, FL 32256 |  | ROAD NO.                                         | COUNTY    | FINANCIAL PROJECT ID |              |                                         |
|           |             |      |             |                                                                                                                           |  | SR 16                                            | ST. JOHNS | 210447-5-52-01       |              |                                         |

THE OFFICIAL RECORD OF THIS SHEET IS THE ELECTRONIC FILE DIGITALLY SIGNED AND SEALED UNDER RULE 61G15-23.004, F.A.C.

8/5/2024 4:28:44 PM BeattyM  
c:\pw\_work\sh\_pw\pw\_user\0439575\PLAINRD01.dgn

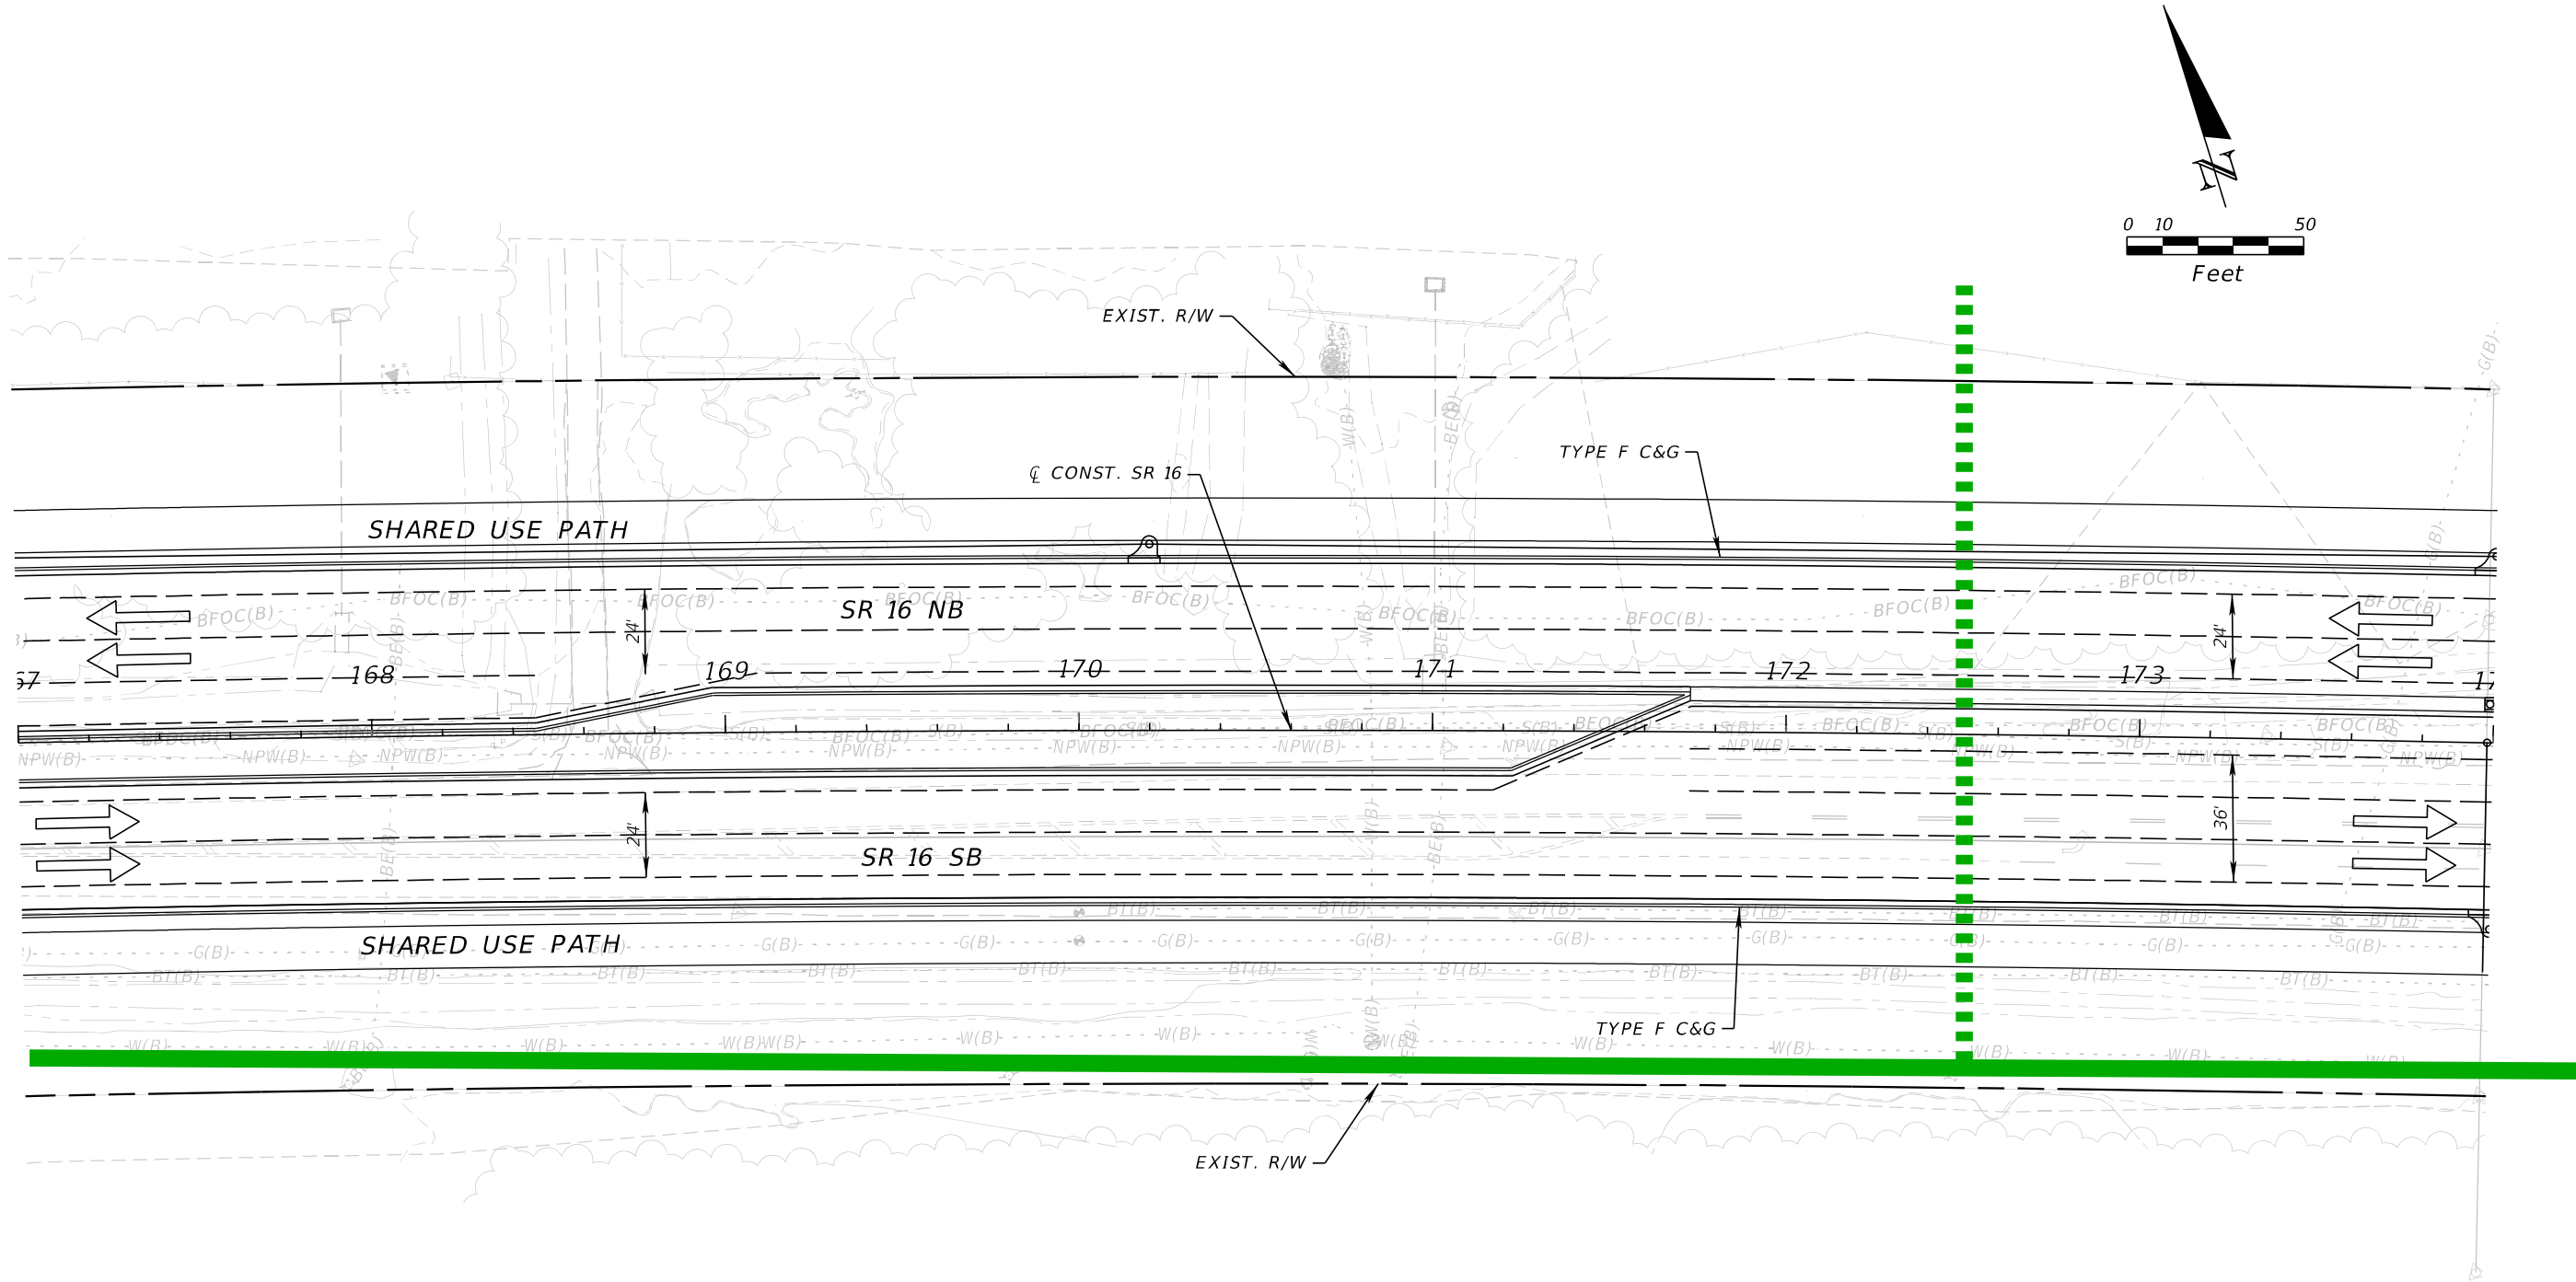


| REVISIONS |             |      |             | ENGINEER OF RECORD                                                                                                        | STATE OF FLORIDA<br>DEPARTMENT OF TRANSPORTATION |           |                      | ROADWAY PLAN | SHEET NO.              |
|-----------|-------------|------|-------------|---------------------------------------------------------------------------------------------------------------------------|--------------------------------------------------|-----------|----------------------|--------------|------------------------|
| DATE      | DESCRIPTION | DATE | DESCRIPTION | STEPHEN J. PARK, P.E.<br>LICENSE NUMBER: 77656<br>RS&H, INC.<br>10748 DEERWOOD PARK BLVD. SOUTH<br>JACKSONVILLE, FL 32256 | ROAD NO.                                         | COUNTY    | FINANCIAL PROJECT ID |              | SR 16<br>- PLAN-<br>11 |
|           |             |      |             |                                                                                                                           | SR 16                                            | ST. JOHNS | 210447-5-52-01       |              |                        |

STEPHEN J. PARK, P.E.  
LICENSE NUMBER: 77656  
RS&H, INC.  
10748 DEERWOOD PARK BLVD. SOUTH  
JACKSONVILLE, FL 32256

THE OFFICIAL RECORD OF THIS SHEET IS THE ELECTRONIC FILE DIGITALLY SIGNED AND SEALED UNDER RULE 61G15-23.004, F.A.C.

8/5/2024 4:28:45 PM BeattyM  
c:\pw\_work\ysh\_pw\pw\_user\0439575\PLANRD01.dgn

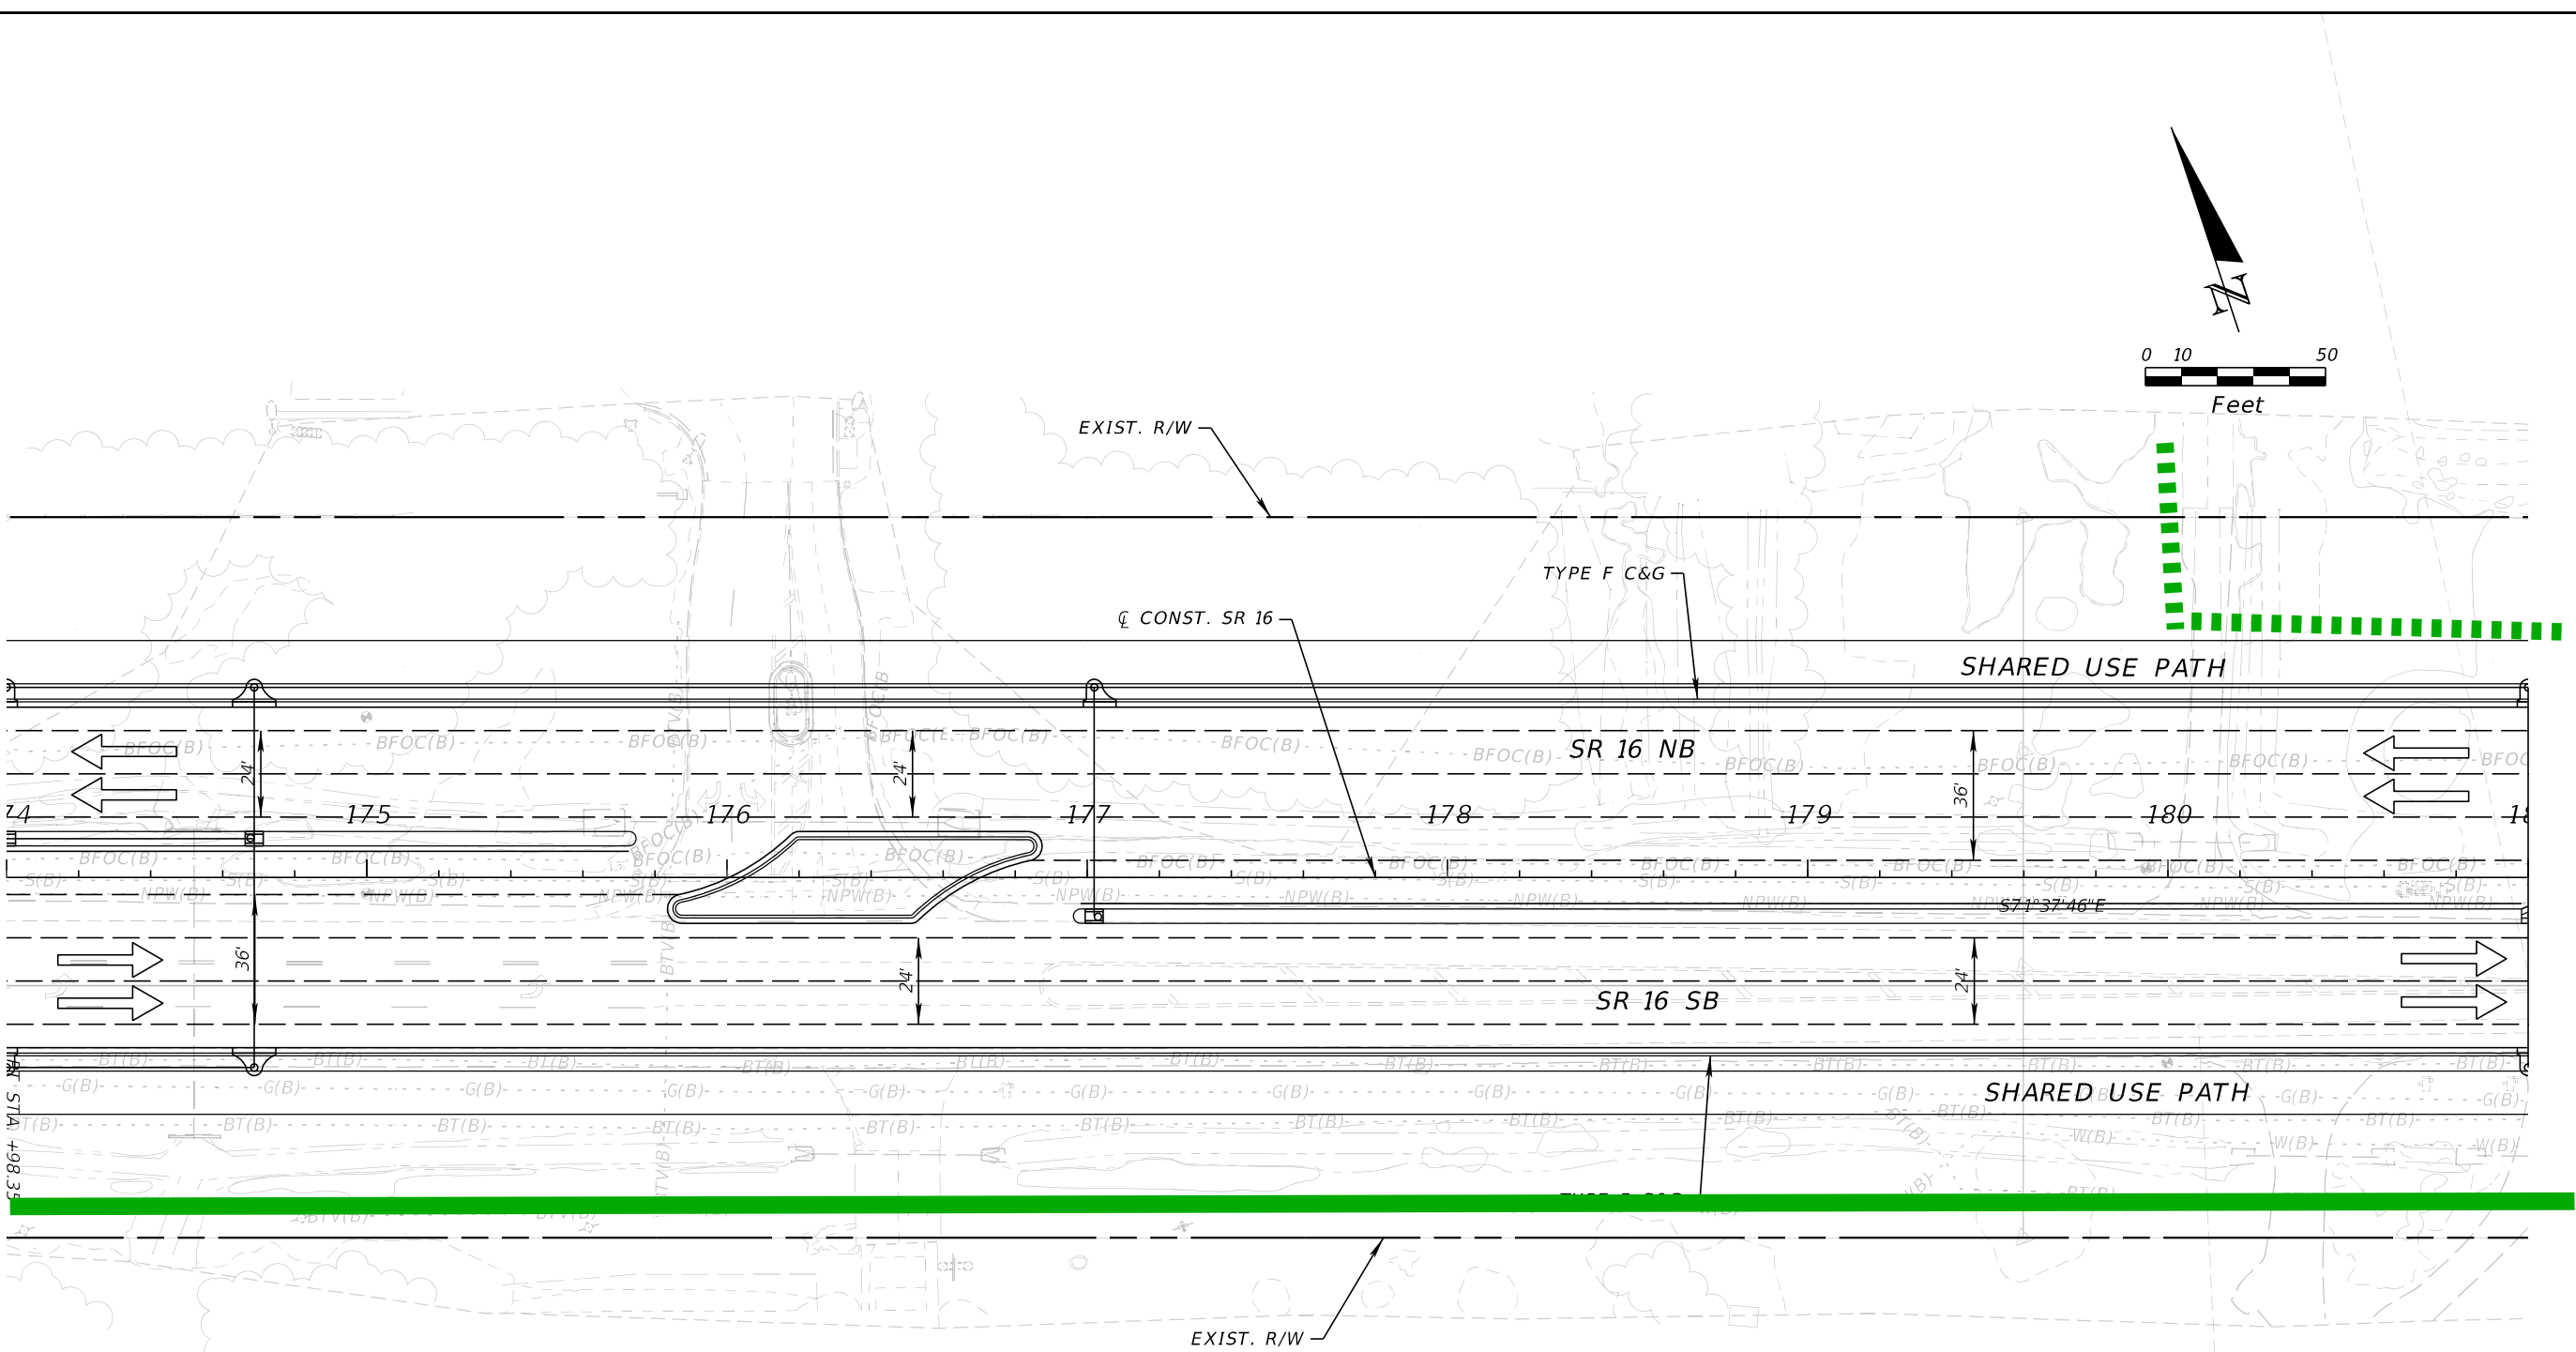

| REVISIONS |             |      |             |
|-----------|-------------|------|-------------|
| DATE      | DESCRIPTION | DATE | DESCRIPTION |
|           |             |      |             |

| ENGINEER OF RECORD                                                                                                        |  |
|---------------------------------------------------------------------------------------------------------------------------|--|
| STEPHEN J. PARK, P.E.<br>LICENSE NUMBER: 77656<br>RS&H, INC.<br>10748 DEERWOOD PARK BLVD. SOUTH<br>JACKSONVILLE, FL 32256 |  |


| STATE OF FLORIDA<br>DEPARTMENT OF TRANSPORTATION |           |                      |
|--------------------------------------------------|-----------|----------------------|
| ROAD NO.                                         | COUNTY    | FINANCIAL PROJECT ID |
| SR 16                                            | ST. JOHNS | 210447-5-52-01       |

| ROADWAY PLAN |  |
|--------------|--|
|              |  |

| SHEET NO.               |
|-------------------------|
| SR 16<br>- PLAN -<br>12 |

THE OFFICIAL RECORD OF THIS SHEET IS THE ELECTRONIC FILE DIGITALLY SIGNED AND SEALED UNDER RULE 61G15-23.004, F.A.C.


8/5/2024 4:28:45 PM BeattyM  
c:\pw\_work\sh\_pw\pw\_user\0439575\PLANRD01.dgn

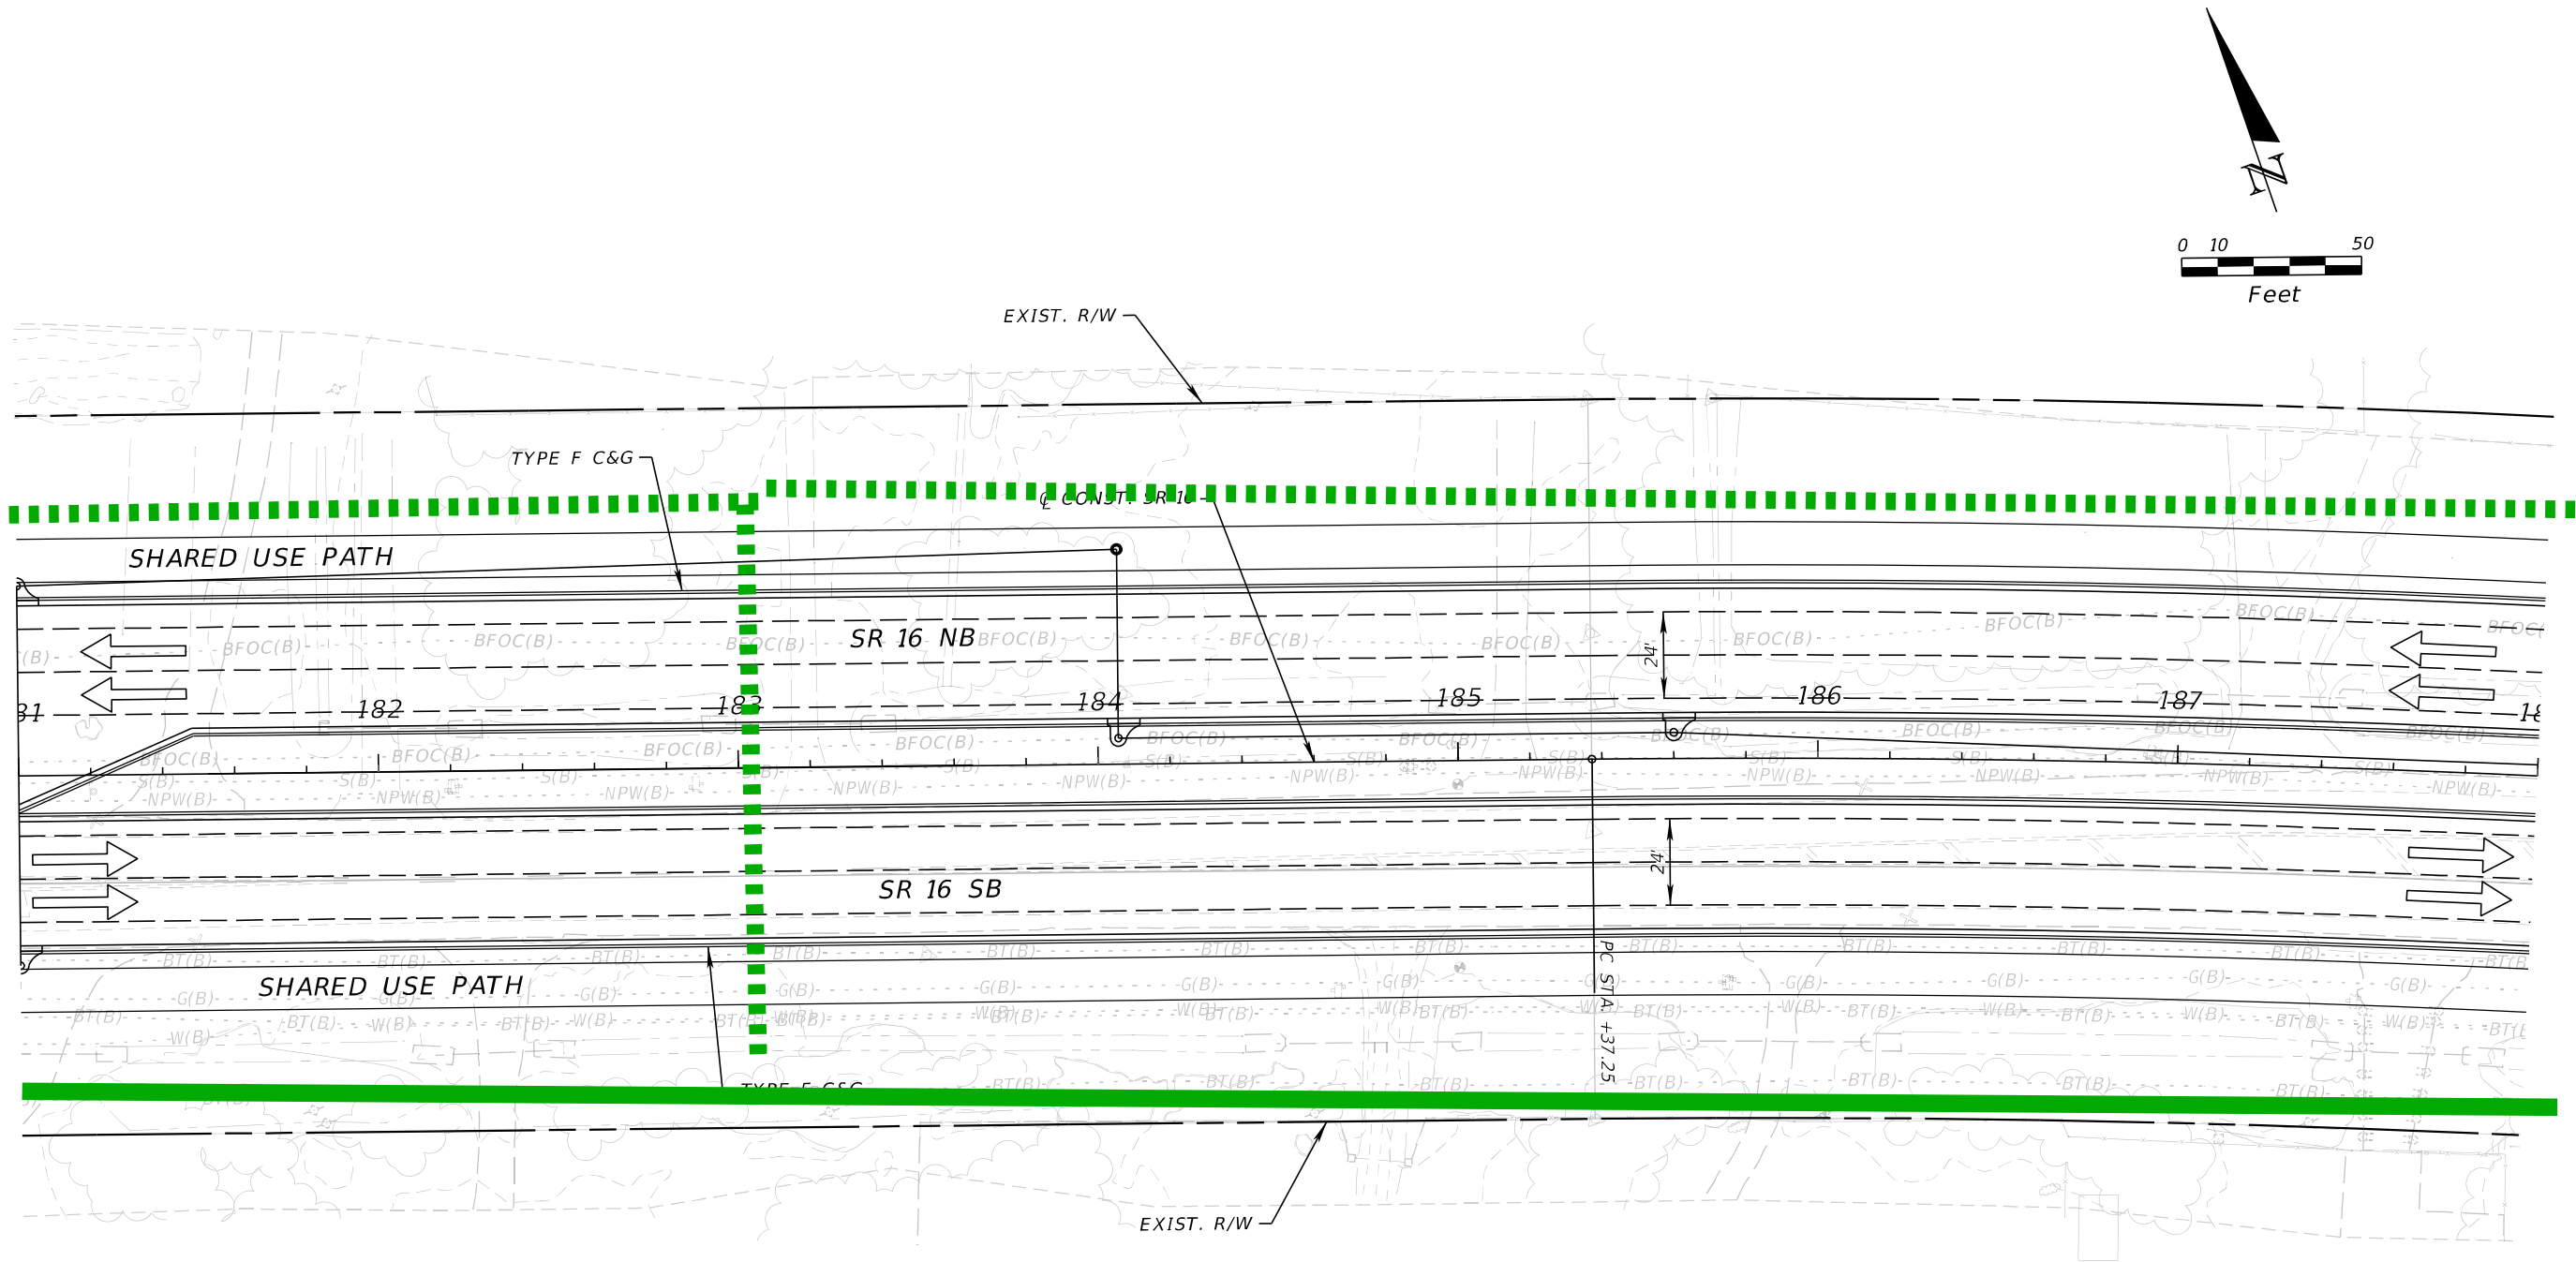

| REVISIONS |             |      |             | ENGINEER OF RECORD                                                                                                        | STATE OF FLORIDA<br>DEPARTMENT OF TRANSPORTATION |           |                      | SHEET<br>NO.          |
|-----------|-------------|------|-------------|---------------------------------------------------------------------------------------------------------------------------|--------------------------------------------------|-----------|----------------------|-----------------------|
| DATE      | DESCRIPTION | DATE | DESCRIPTION |                                                                                                                           | ROAD NO.                                         | COUNTY    | FINANCIAL PROJECT ID |                       |
|           |             |      |             |                                                                                                                           | SR 16                                            | ST. JOHNS | 210447-5-52-01       |                       |
|           |             |      |             | STEPHEN J. PARK, P.E.<br>LICENSE NUMBER: 77656<br>RS&H, INC.<br>10748 DEERWOOD PARK BLVD. SOUTH<br>JACKSONVILLE, FL 32256 |                                                  |           |                      | 11x17<br>Plan<br>Only |

THE OFFICIAL RECORD OF THIS SHEET IS THE ELECTRONIC FILE DIGITALLY SIGNED AND SEALED UNDER RULE 61G15-23.004, F.A.C.


8/5/2024 4:28:46 PM BeattyM  
c:\pw\_work\ysh\_pw\pw\_user\0439575\PLANRD01.dgn

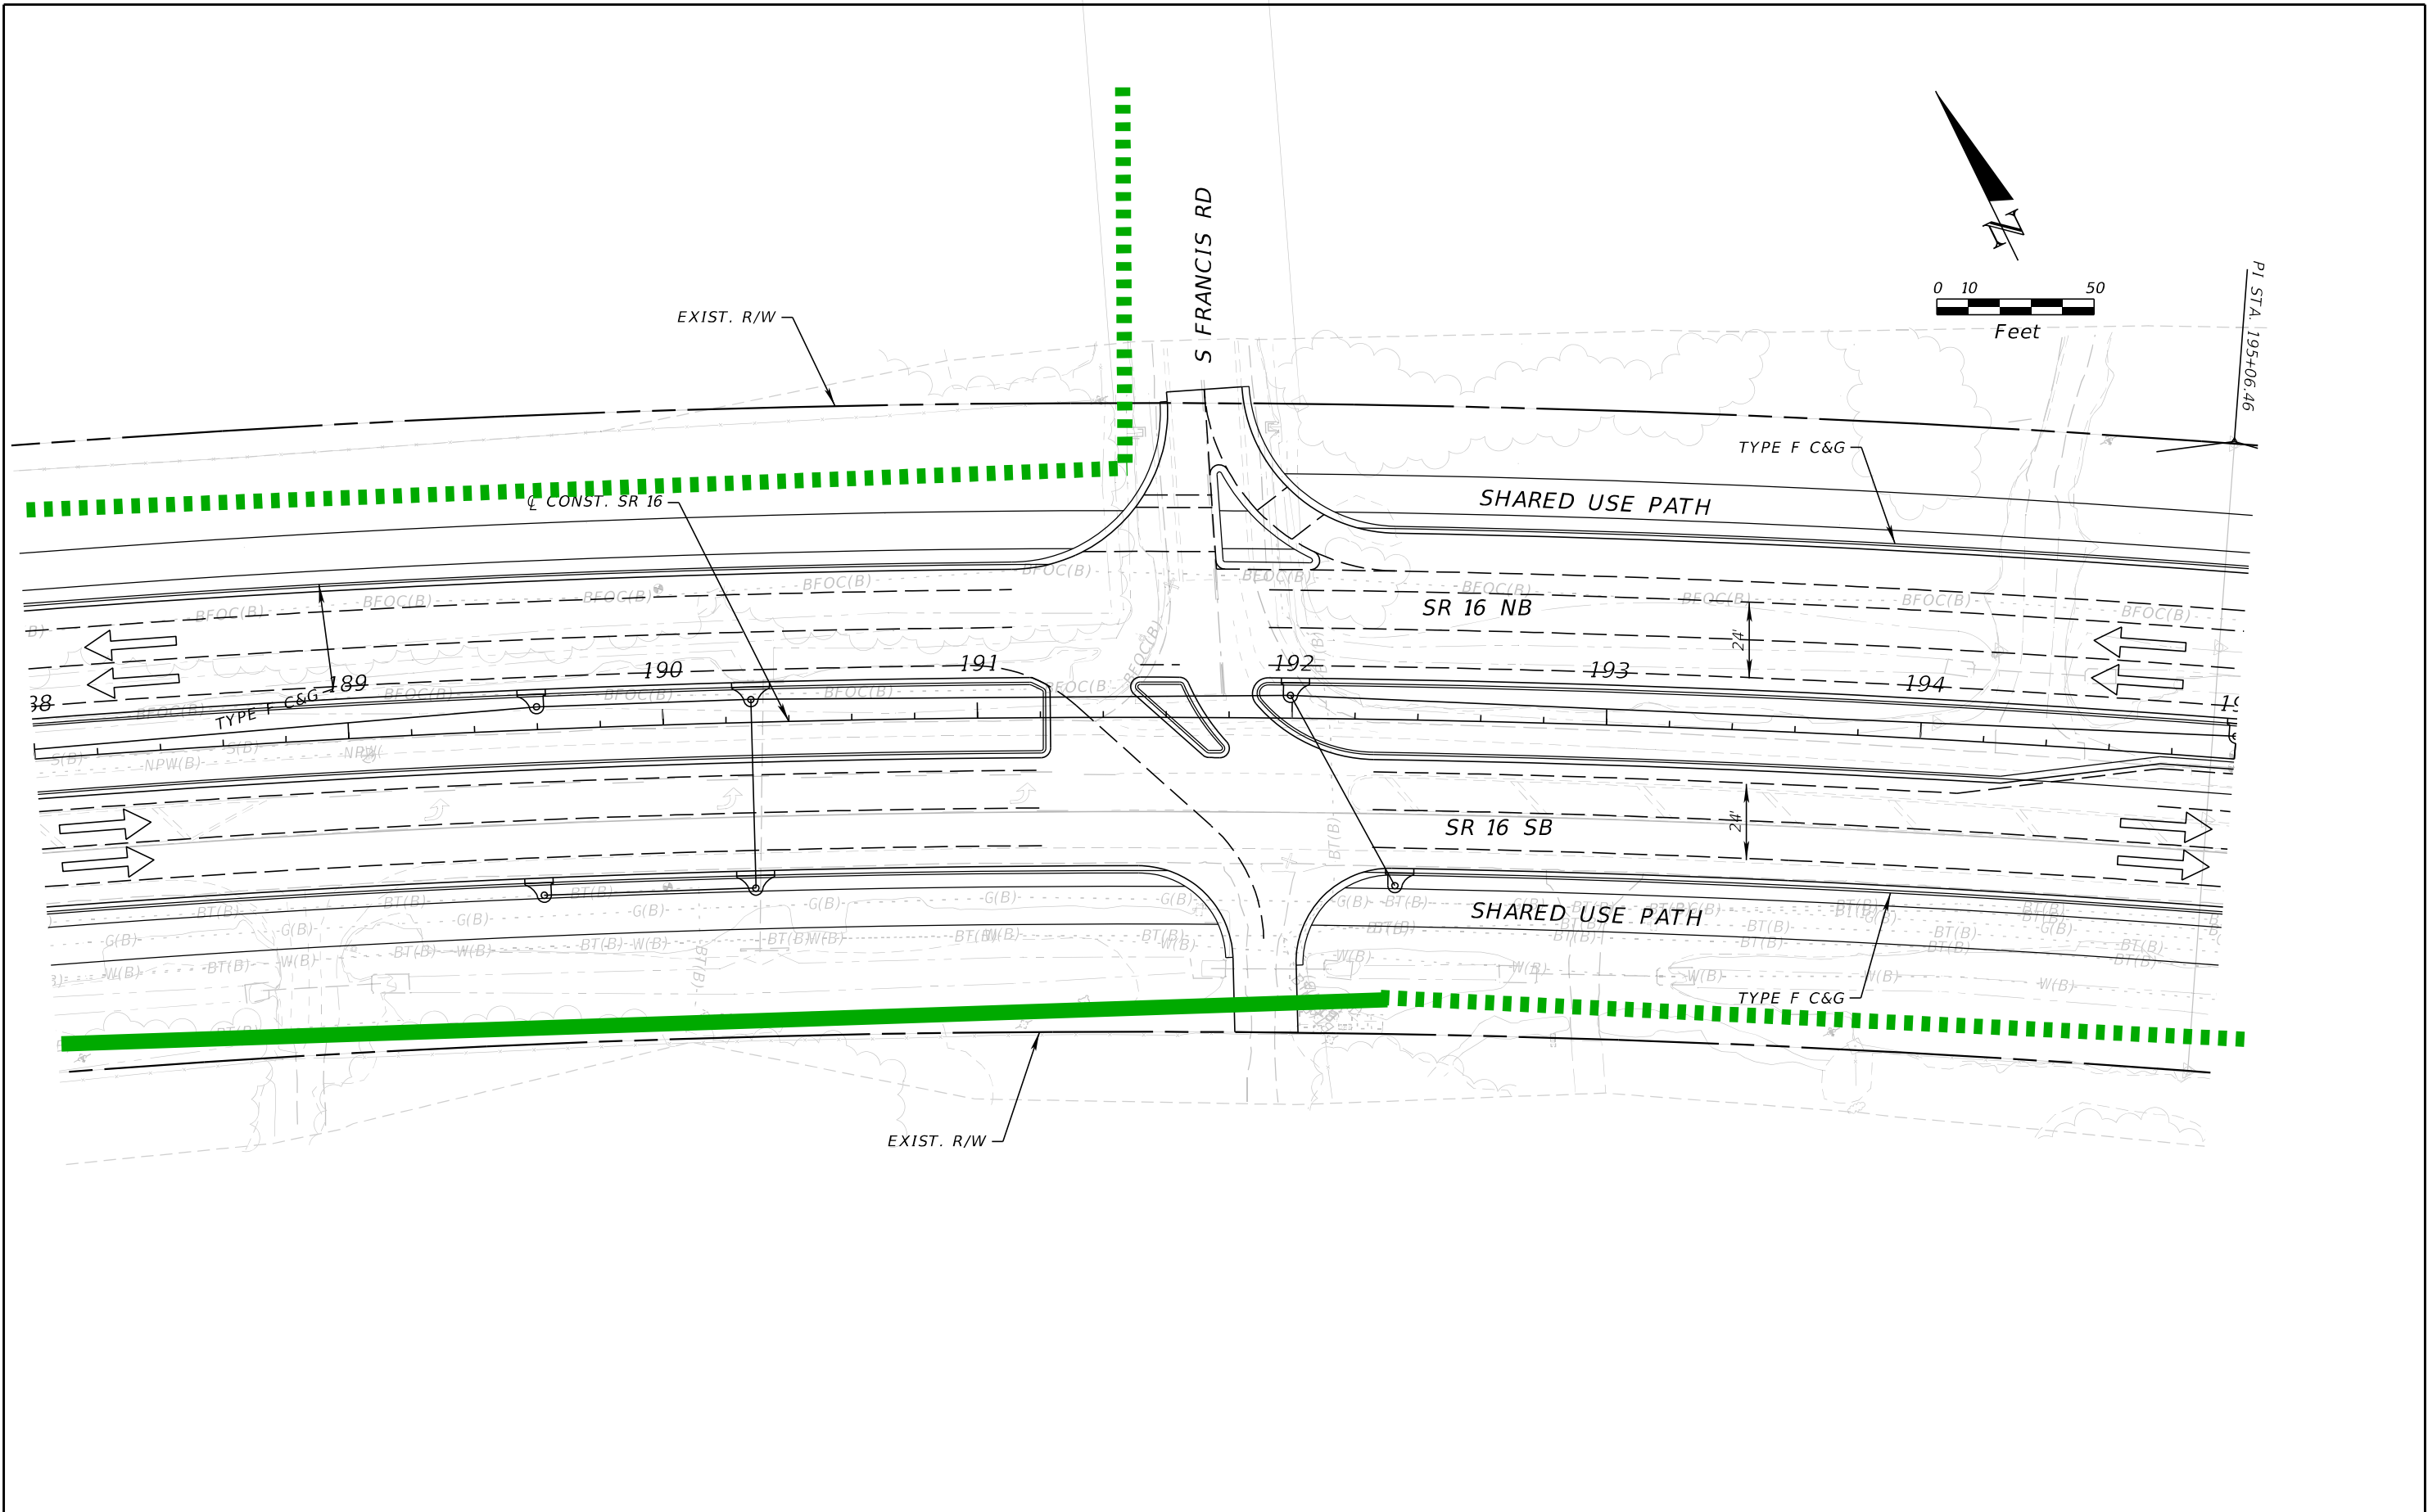

| REVISIONS |             |      |             | ENGINEER OF RECORD                                                                                                        |  | STATE OF FLORIDA<br>DEPARTMENT OF TRANSPORTATION |           |                      | SHEET<br>NO. |
|-----------|-------------|------|-------------|---------------------------------------------------------------------------------------------------------------------------|--|--------------------------------------------------|-----------|----------------------|--------------|
| DATE      | DESCRIPTION | DATE | DESCRIPTION | STEPHEN J. PARK, P.E.<br>LICENSE NUMBER: 77656<br>RS&H, INC.<br>10748 DEERWOOD PARK BLVD. SOUTH<br>JACKSONVILLE, FL 32256 |  | ROAD NO.                                         | COUNTY    | FINANCIAL PROJECT ID |              |
|           |             |      |             |                                                                                                                           |  | SR 16                                            | ST. JOHNS | 210447-5-52-01       |              |



8/5/2024 4:28:47 PM BeattyM  
c:\pw\_work\ysh\_pw\pw\_user\00439575\PLANRD01.dgn

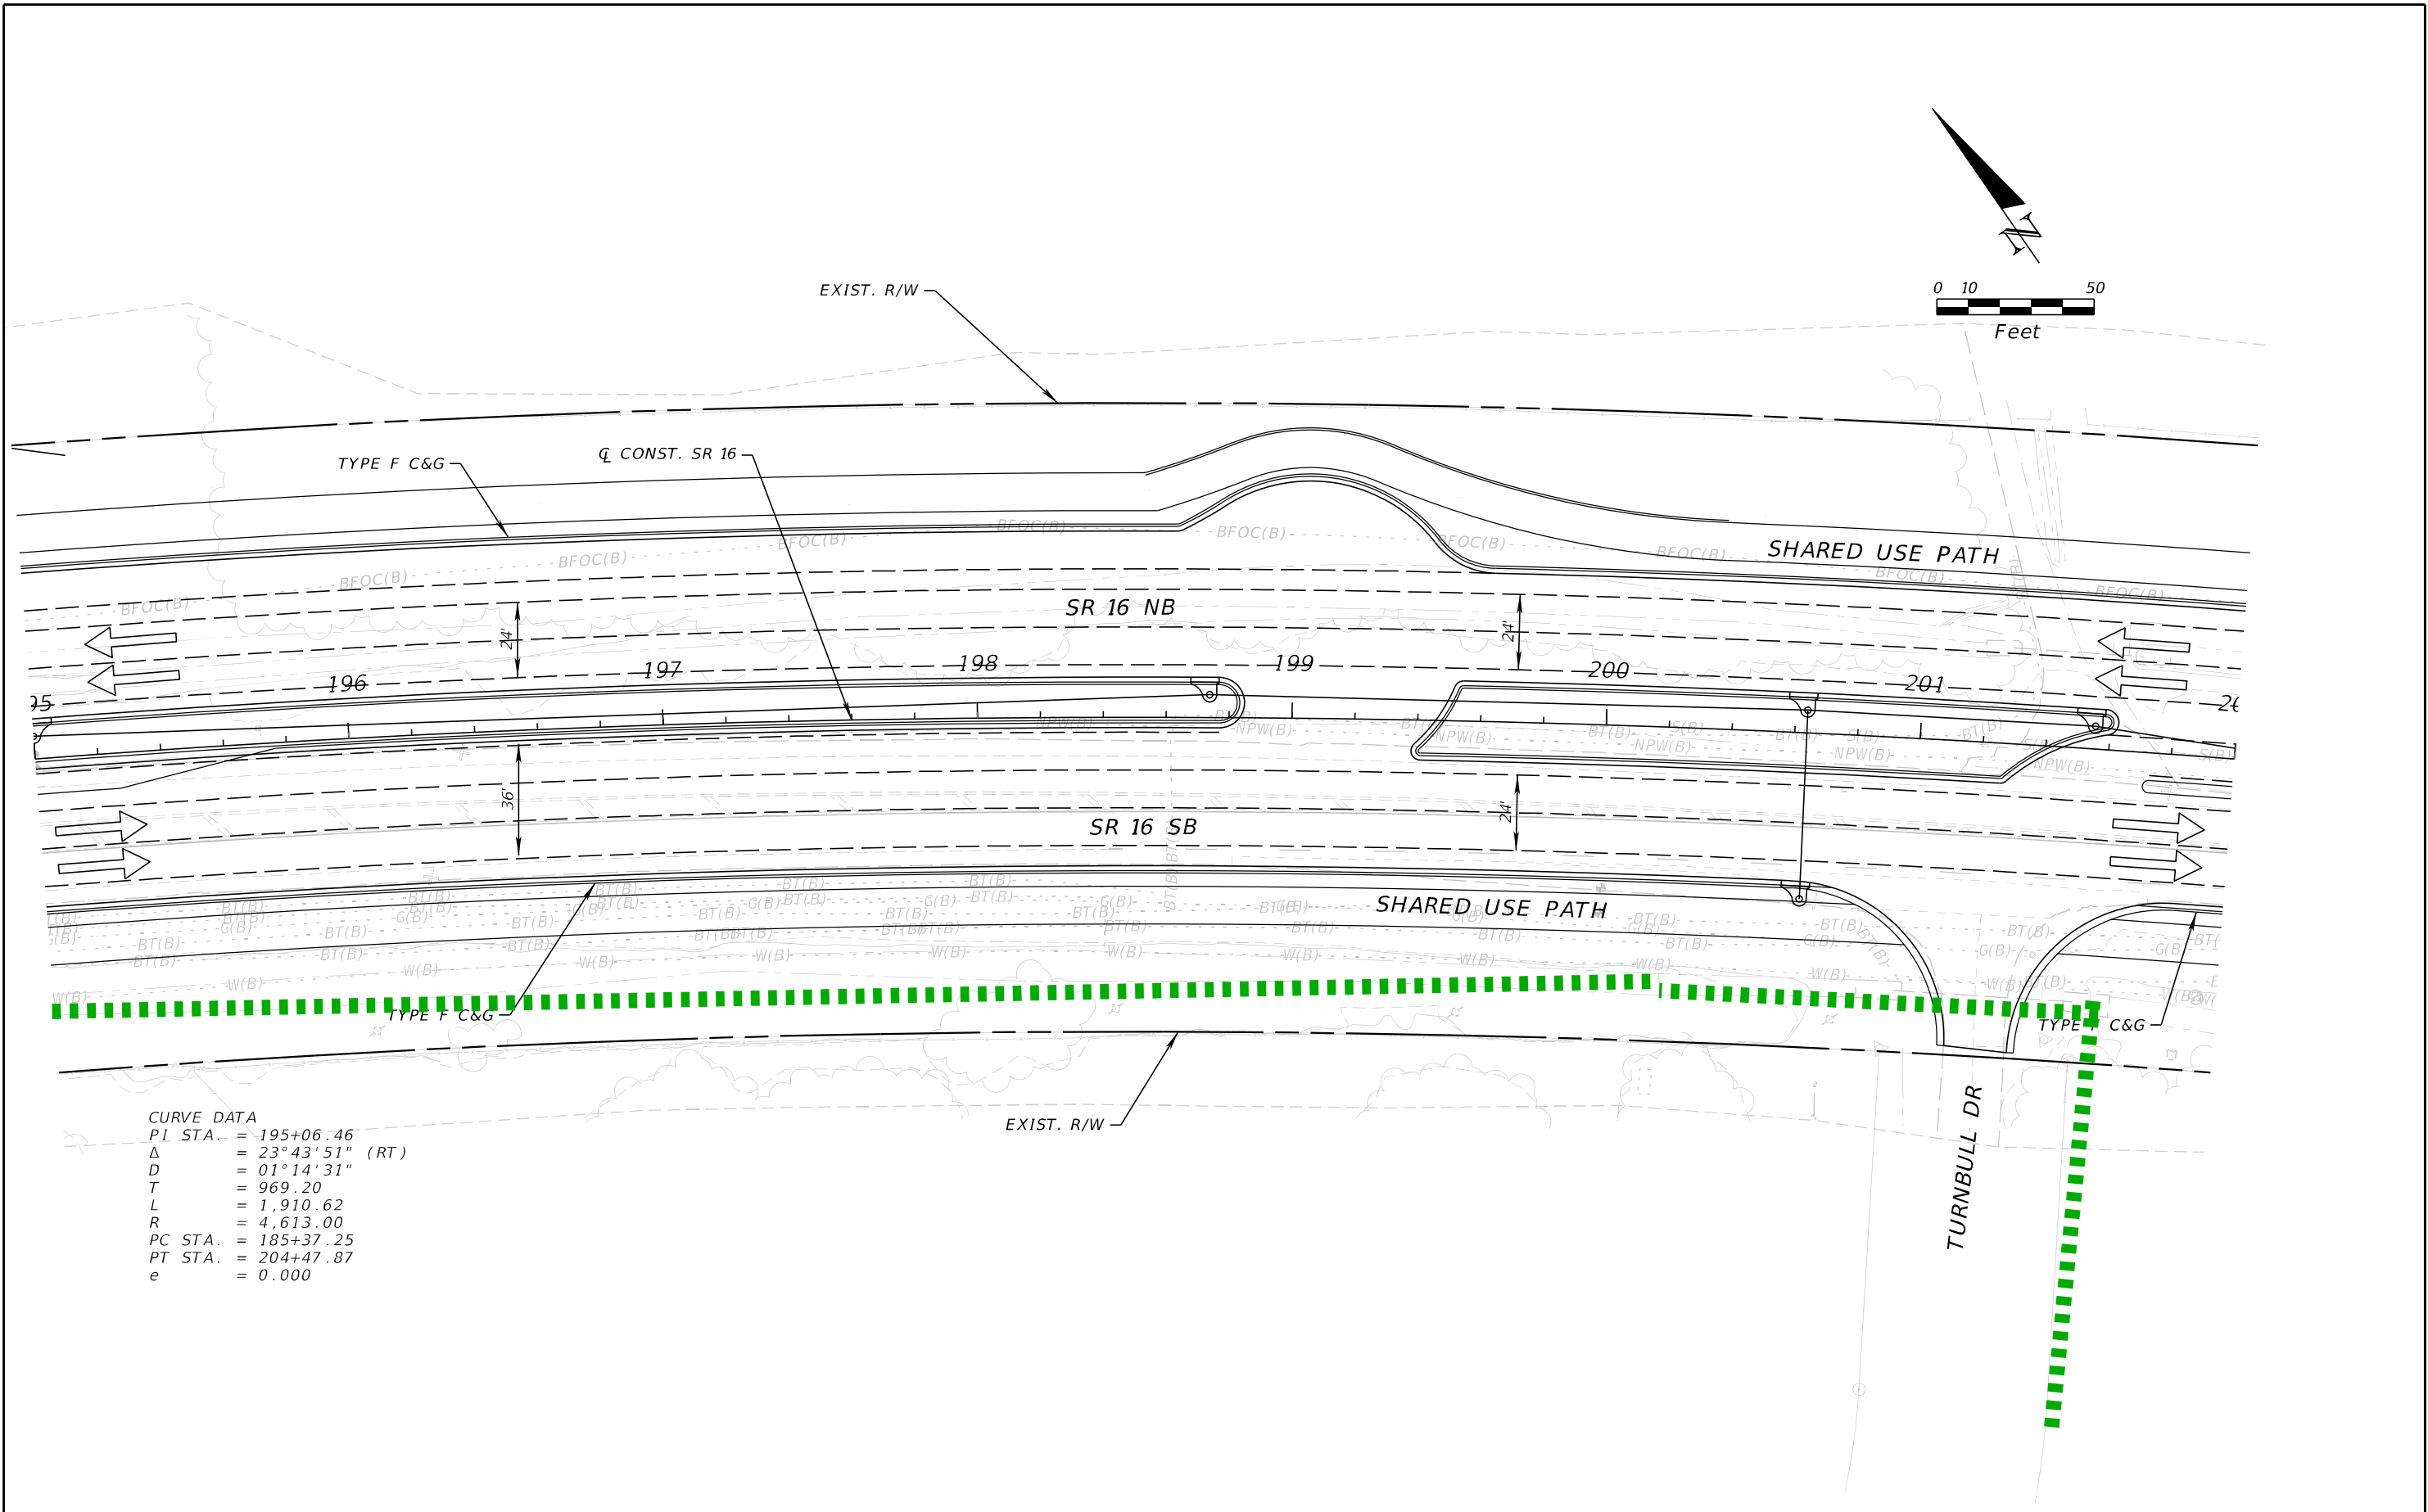


CURVE DATA  
PI STA. = 195+06.46  
Δ = 23°43'51" (RT)  
D = 01°14'31"  
T = 969.20  
L = 1,910.62  
R = 4,613.00  
PC STA. = 185+37.25  
PT STA. = 204+47.87  
e = 0.000

| REVISIONS |             |      |             | ENGINEER OF RECORD                                                                                                        |  | STATE OF FLORIDA<br>DEPARTMENT OF TRANSPORTATION |           |                      | SHEET<br>NO. |
|-----------|-------------|------|-------------|---------------------------------------------------------------------------------------------------------------------------|--|--------------------------------------------------|-----------|----------------------|--------------|
| DATE      | DESCRIPTION | DATE | DESCRIPTION | STEPHEN J. PARK, P.E.<br>LICENSE NUMBER: 77656<br>RS&H, INC.<br>10748 DEERWOOD PARK BLVD. SOUTH<br>JACKSONVILLE, FL 32256 |  | ROAD NO.                                         | COUNTY    | FINANCIAL PROJECT ID |              |
|           |             |      |             |                                                                                                                           |  | SR 16                                            | ST. JOHNS | 210447-5-52-01       |              |

THE OFFICIAL RECORD OF THIS SHEET IS THE ELECTRONIC FILE DIGITALLY SIGNED AND SEALED UNDER RULE 61G15-23.004, F.A.C.


8/5/2024 4:28:48 PM BeattyM  
c:\pw\_work\ysh\_pw\pw\_user\0439575\PLANRD01.dgn

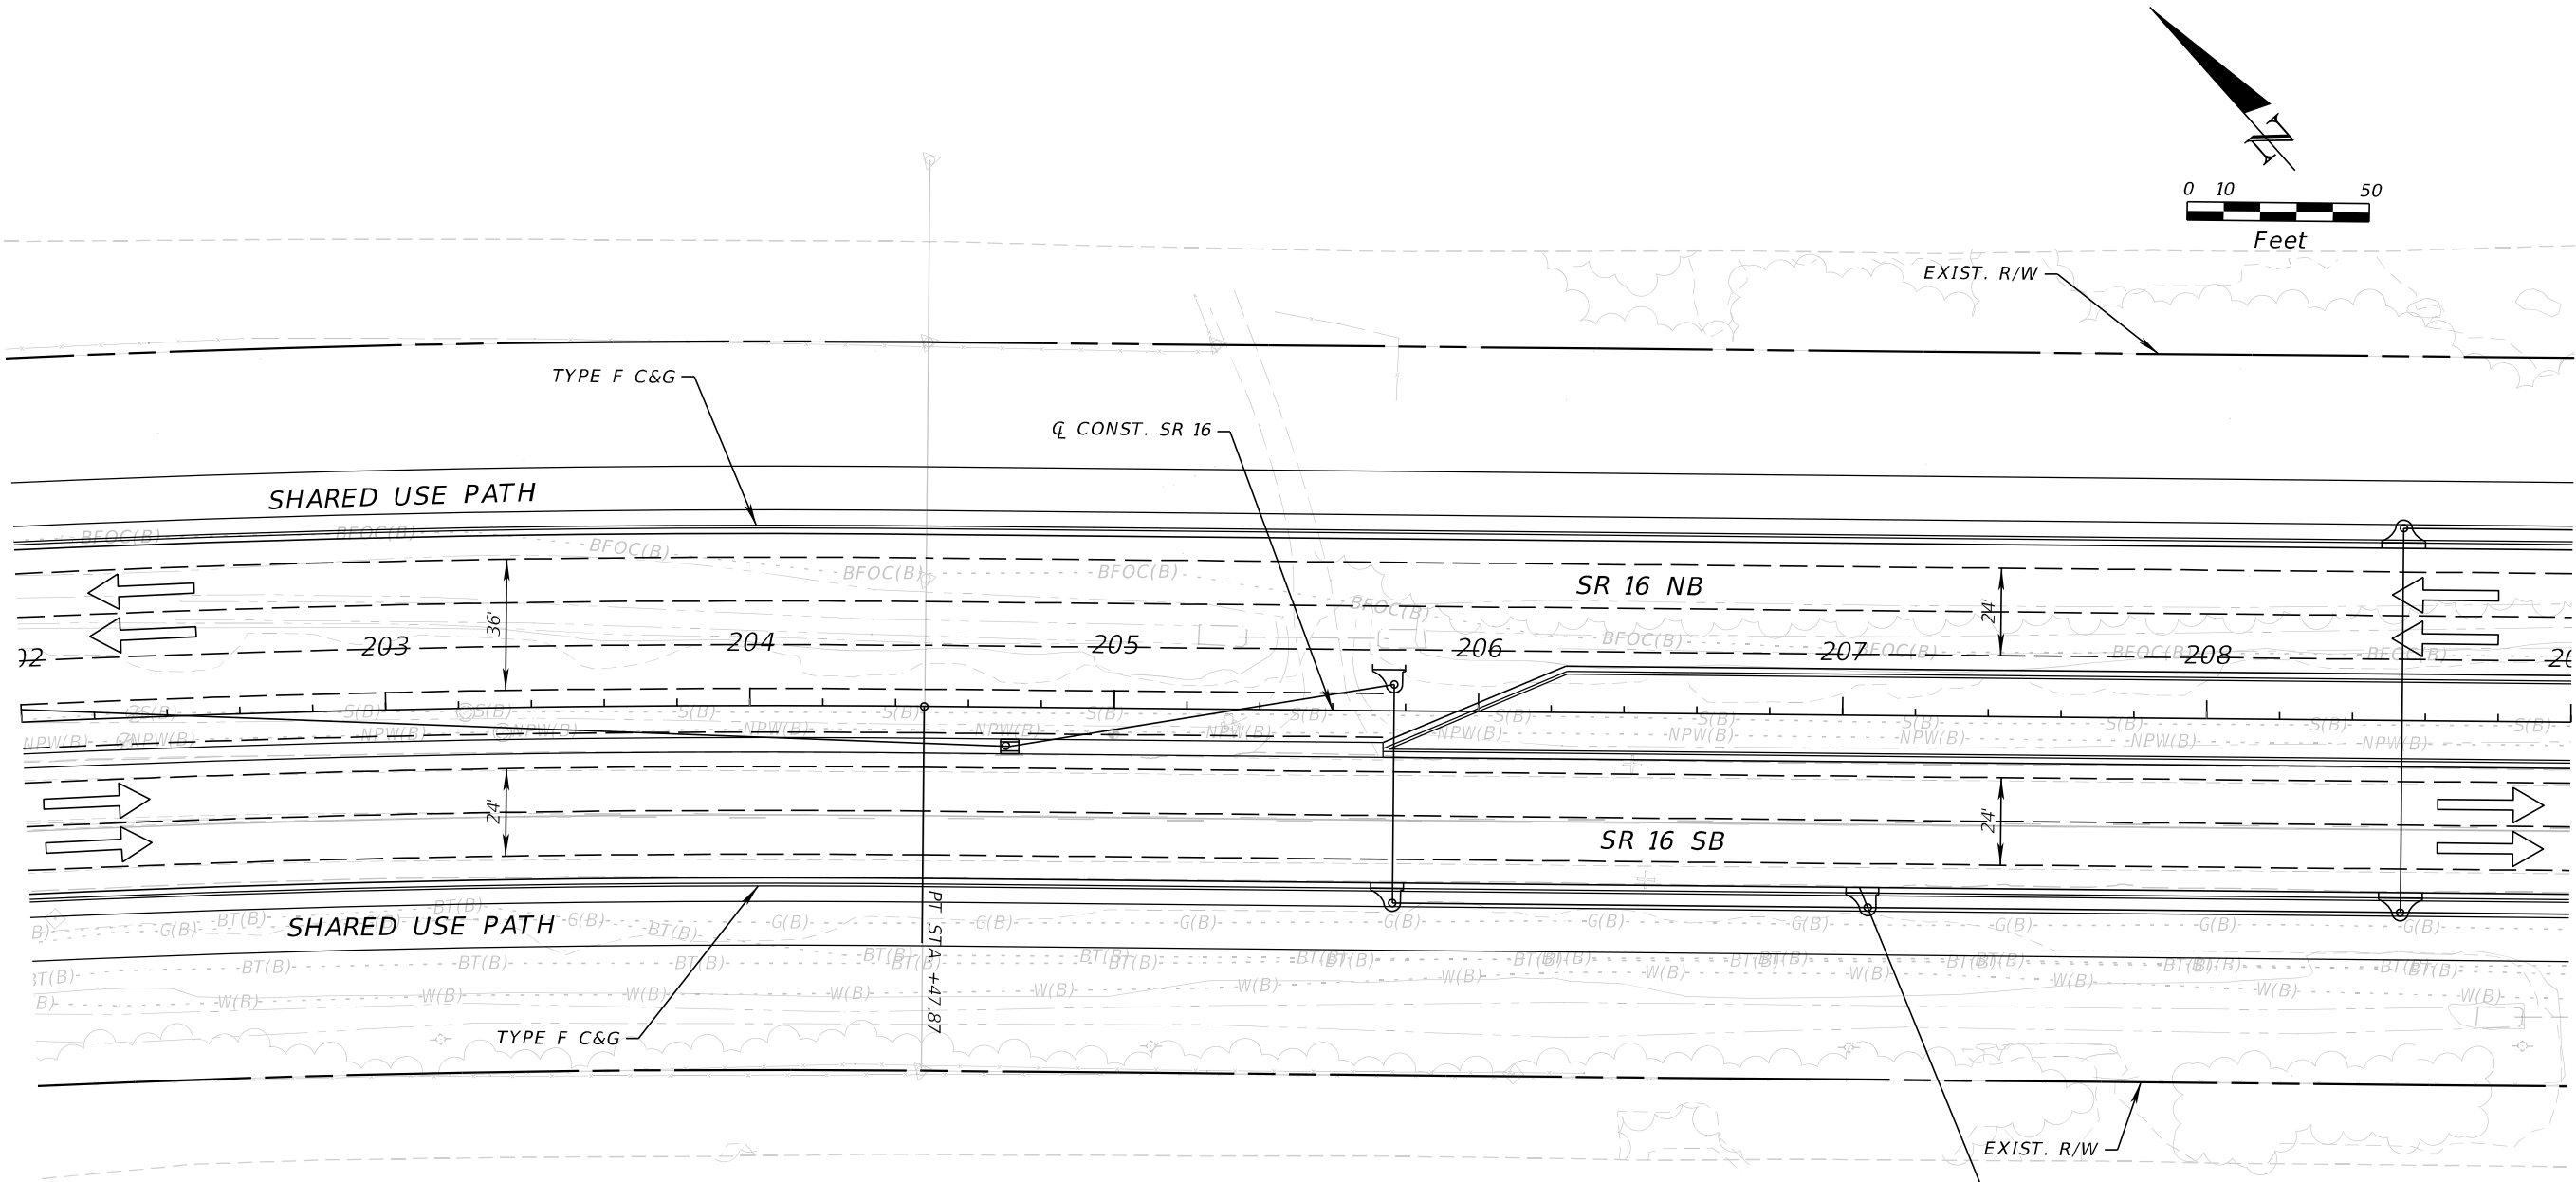

| REVISIONS |             |      |             | ENGINEER OF RECORD                                                                                                        | STATE OF FLORIDA<br>DEPARTMENT OF TRANSPORTATION |           |                      | SHEET<br>NO.          |
|-----------|-------------|------|-------------|---------------------------------------------------------------------------------------------------------------------------|--------------------------------------------------|-----------|----------------------|-----------------------|
| DATE      | DESCRIPTION | DATE | DESCRIPTION | STEPHEN J. PARK, P.E.<br>LICENSE NUMBER: 77656<br>RS&H, INC.<br>10748 DEERWOOD PARK BLVD. SOUTH<br>JACKSONVILLE, FL 32256 | ROAD NO.                                         | COUNTY    | FINANCIAL PROJECT ID |                       |
|           |             |      |             |                                                                                                                           | SR 16                                            | ST. JOHNS | 210447-5-52-01       |                       |
|           |             |      |             |                                                                                                                           |                                                  |           |                      | 11x17<br>Plan<br>Only |

THE OFFICIAL RECORD OF THIS SHEET IS THE ELECTRONIC FILE DIGITALLY SIGNED AND SEALED UNDER RULE 61G15-23.004, F.A.C.


8/5/2024 4:28:48 PM BeattyM  
c:\pw\_work\ysh\_pw\pw\_user\00439575\PLANRD01.dgn

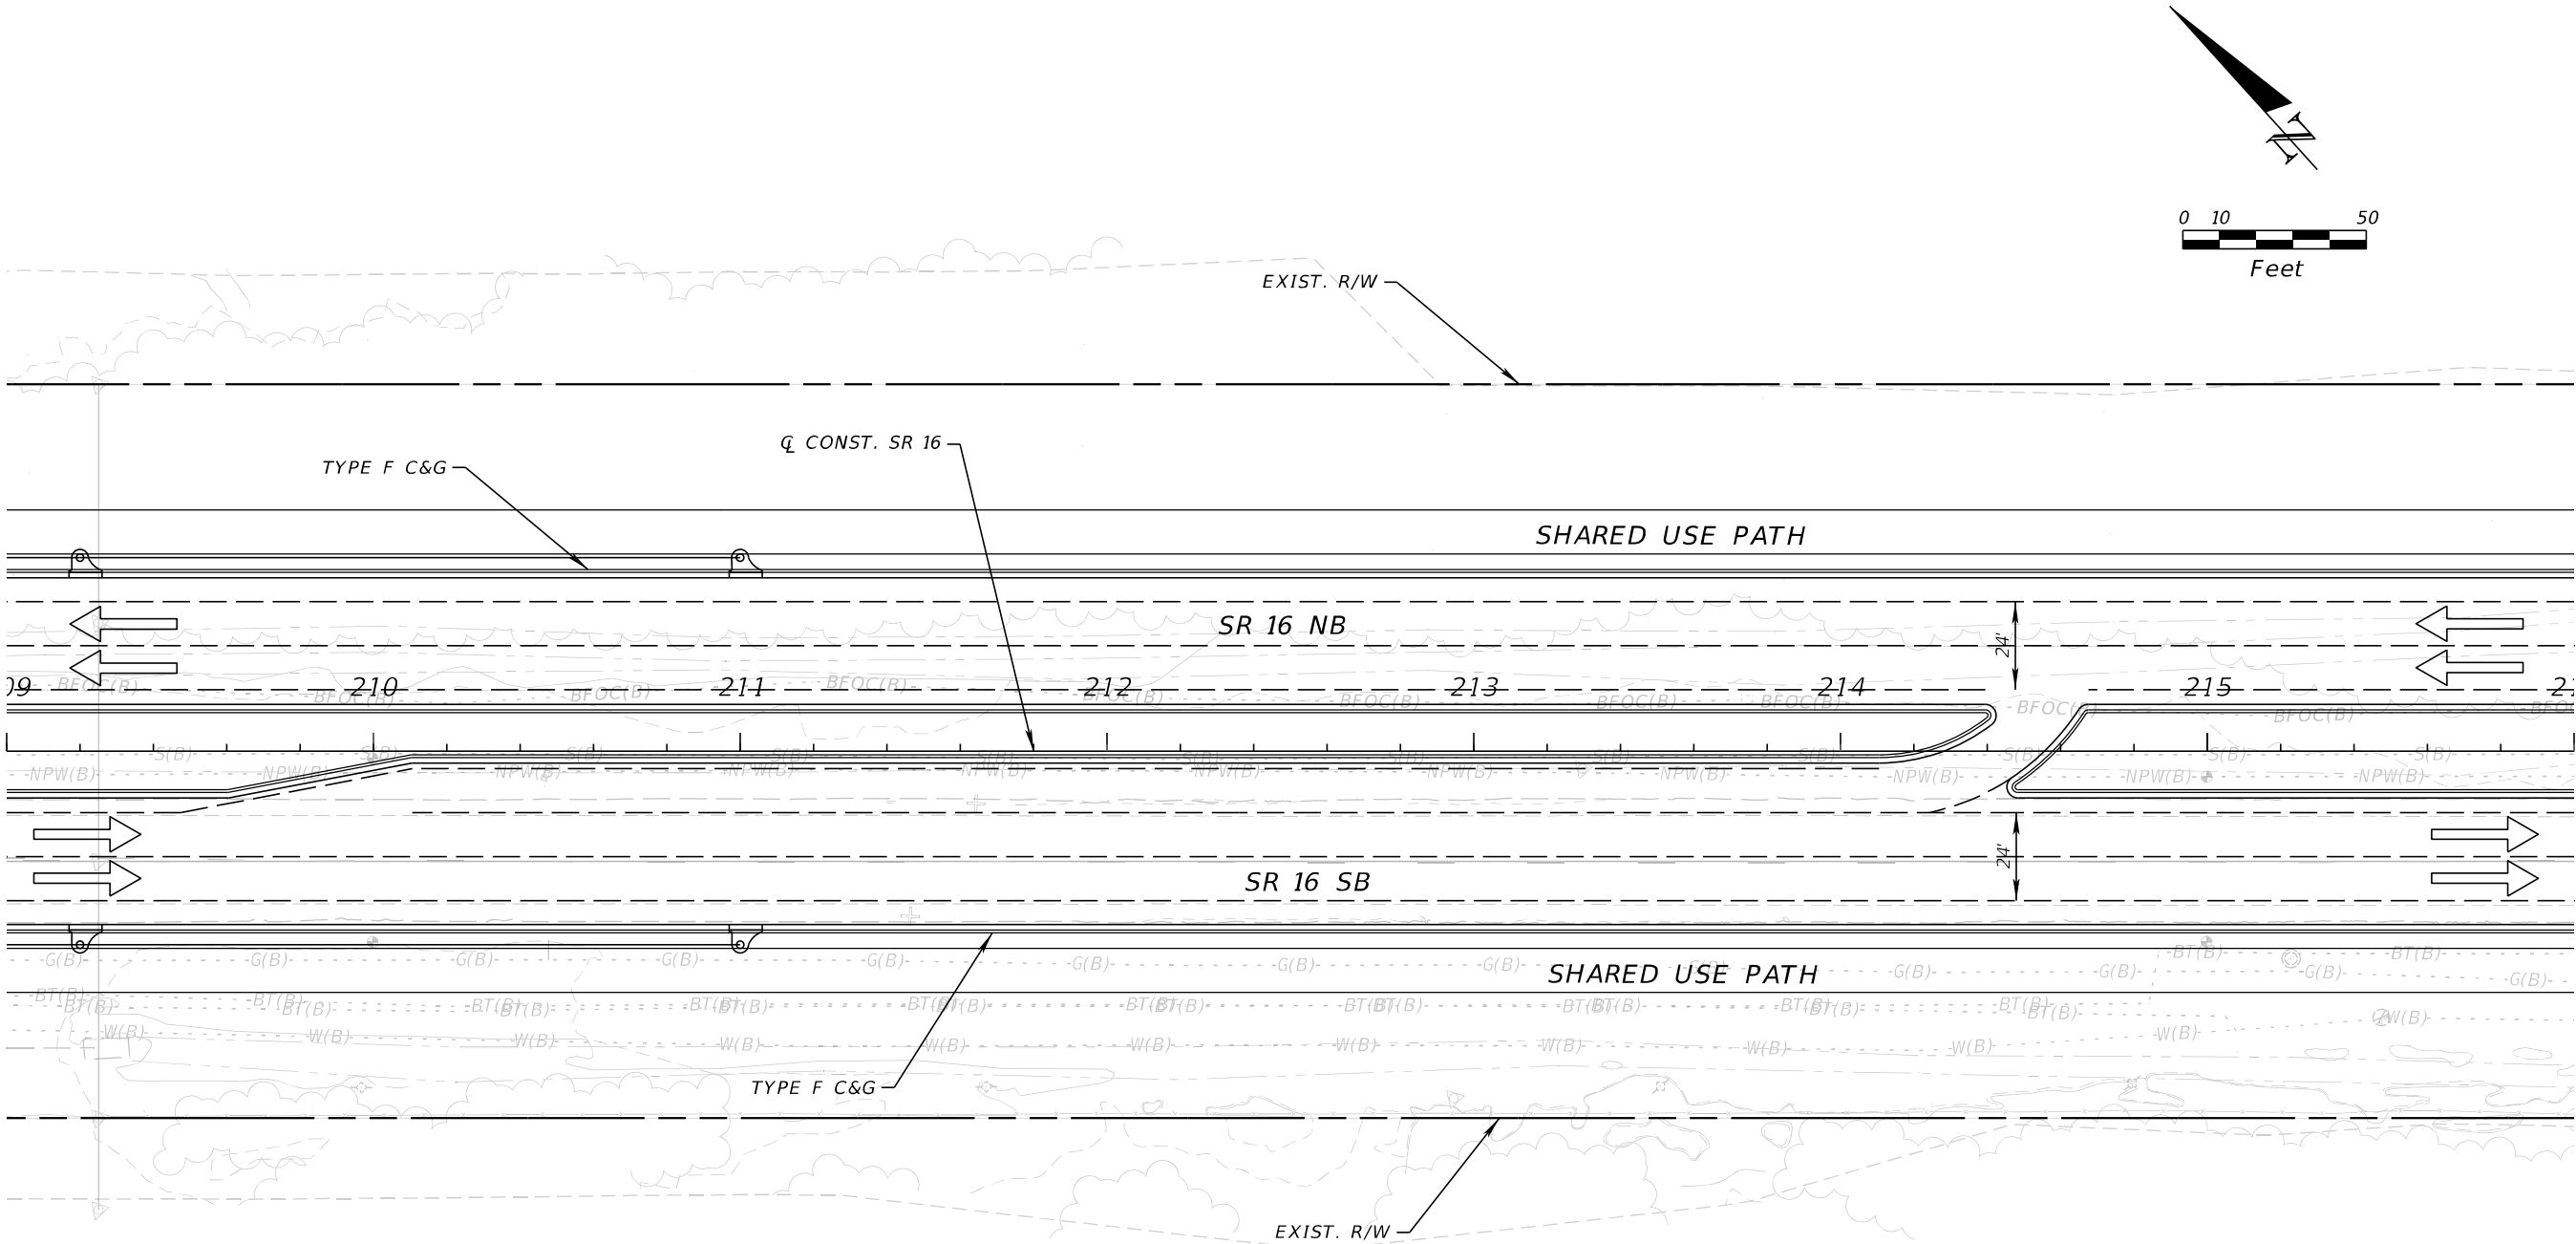

| REVISIONS |             |      |             | ENGINEER OF RECORD                                                                                                        |  | STATE OF FLORIDA<br>DEPARTMENT OF TRANSPORTATION |           |                      | SHEET<br>NO. |
|-----------|-------------|------|-------------|---------------------------------------------------------------------------------------------------------------------------|--|--------------------------------------------------|-----------|----------------------|--------------|
| DATE      | DESCRIPTION | DATE | DESCRIPTION | STEPHEN J. PARK, P.E.<br>LICENSE NUMBER: 77656<br>RS&H, INC.<br>10748 DEERWOOD PARK BLVD. SOUTH<br>JACKSONVILLE, FL 32256 |  | ROAD NO.                                         | COUNTY    | FINANCIAL PROJECT ID |              |
|           |             |      |             |                                                                                                                           |  | SR 16                                            | ST. JOHNS | 210447-5-52-01       |              |

THE OFFICIAL RECORD OF THIS SHEET IS THE ELECTRONIC FILE DIGITALLY SIGNED AND SEALED UNDER RULE 61G15-23.004, F.A.C.



8/5/2024 4:28:49 PM BeattyM  
c:\pw\_work\sh\_pw\pw\_user\0439575\PLANRD01.dgn

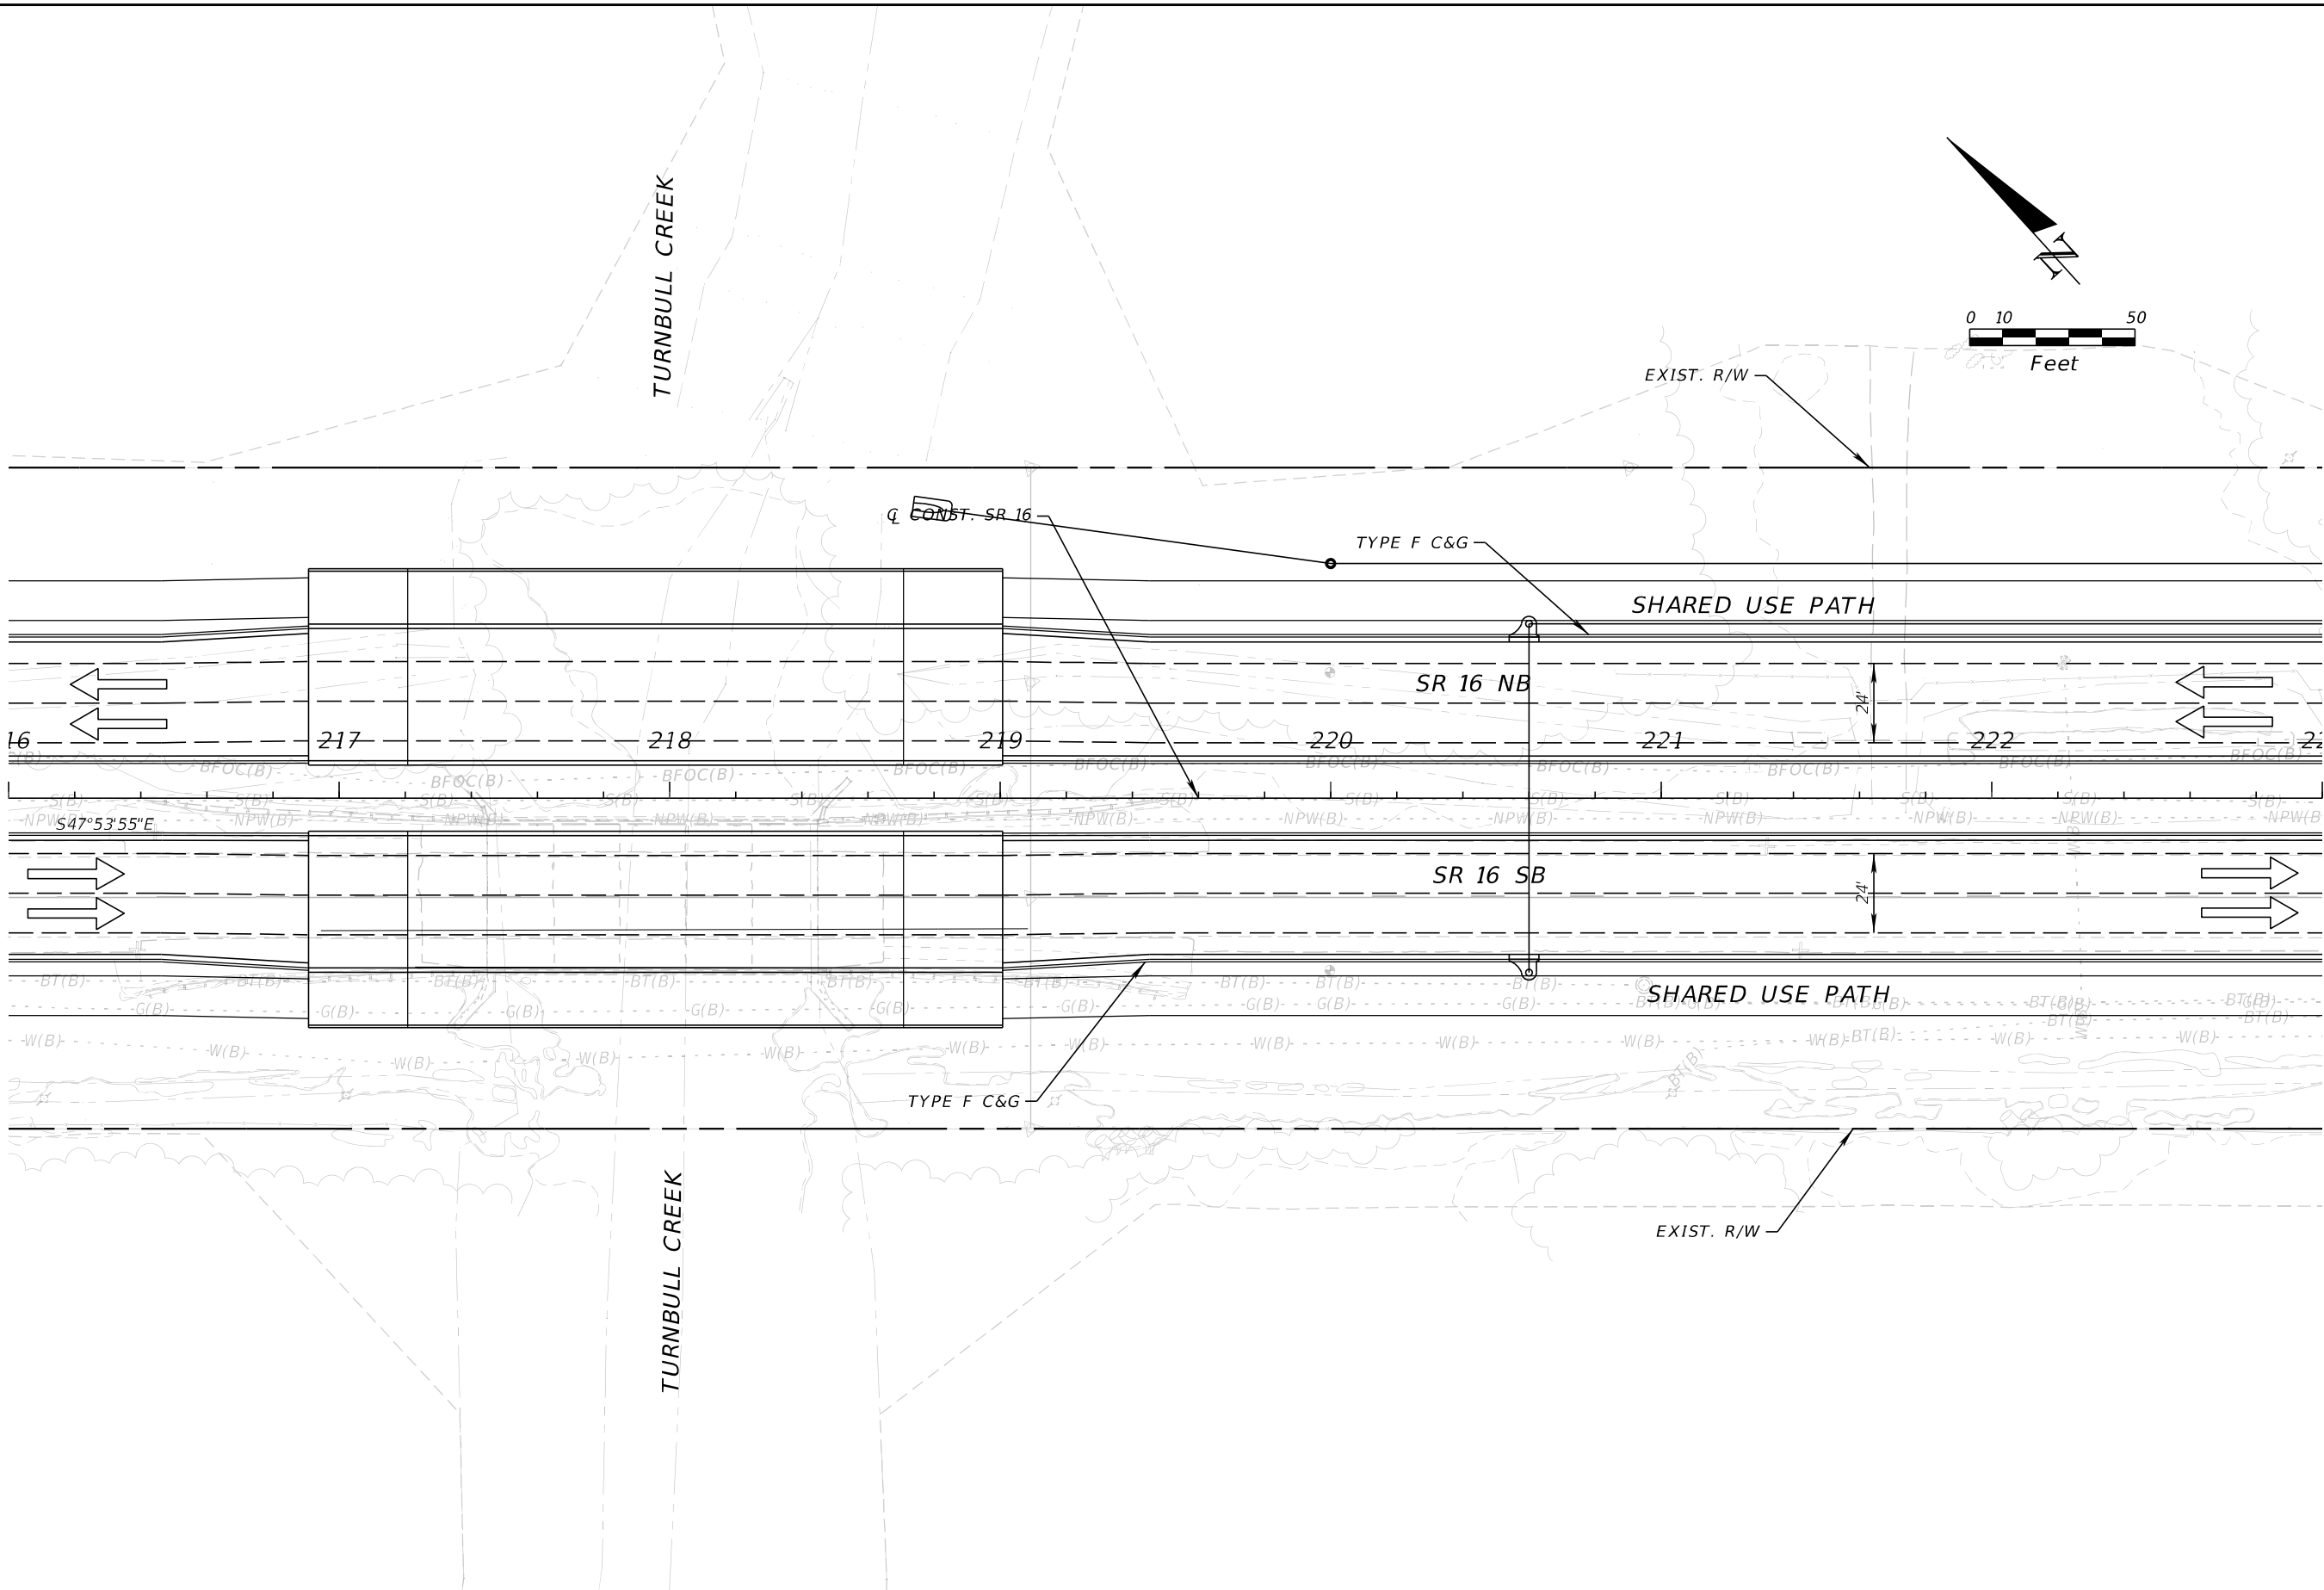

| REVISIONS |             |      |             | ENGINEER OF RECORD                                                                                                        | STATE OF FLORIDA<br>DEPARTMENT OF TRANSPORTATION |           |                      | SHEET<br>NO.          |
|-----------|-------------|------|-------------|---------------------------------------------------------------------------------------------------------------------------|--------------------------------------------------|-----------|----------------------|-----------------------|
| DATE      | DESCRIPTION | DATE | DESCRIPTION | STEPHEN J. PARK, P.E.<br>LICENSE NUMBER: 77656<br>RS&H, INC.<br>10748 DEERWOOD PARK BLVD. SOUTH<br>JACKSONVILLE, FL 32256 | ROAD NO.                                         | COUNTY    | FINANCIAL PROJECT ID |                       |
|           |             |      |             |                                                                                                                           | SR 16                                            | ST. JOHNS | 210447-5-52-01       |                       |
|           |             |      |             |                                                                                                                           |                                                  |           |                      | 11x17<br>Plan<br>Only |

THE OFFICIAL RECORD OF THIS SHEET IS THE ELECTRONIC FILE DIGITALLY SIGNED AND SEALED UNDER RULE 61G15-23.004, F.A.C.

8/5/2024 4:28:49 PM BeattyM  
c:\pw\_work\sh\_pw\pw\_user\00439575\PLANRD01.dgn

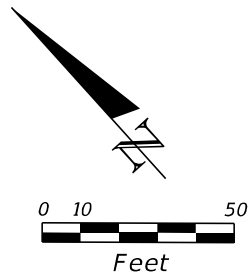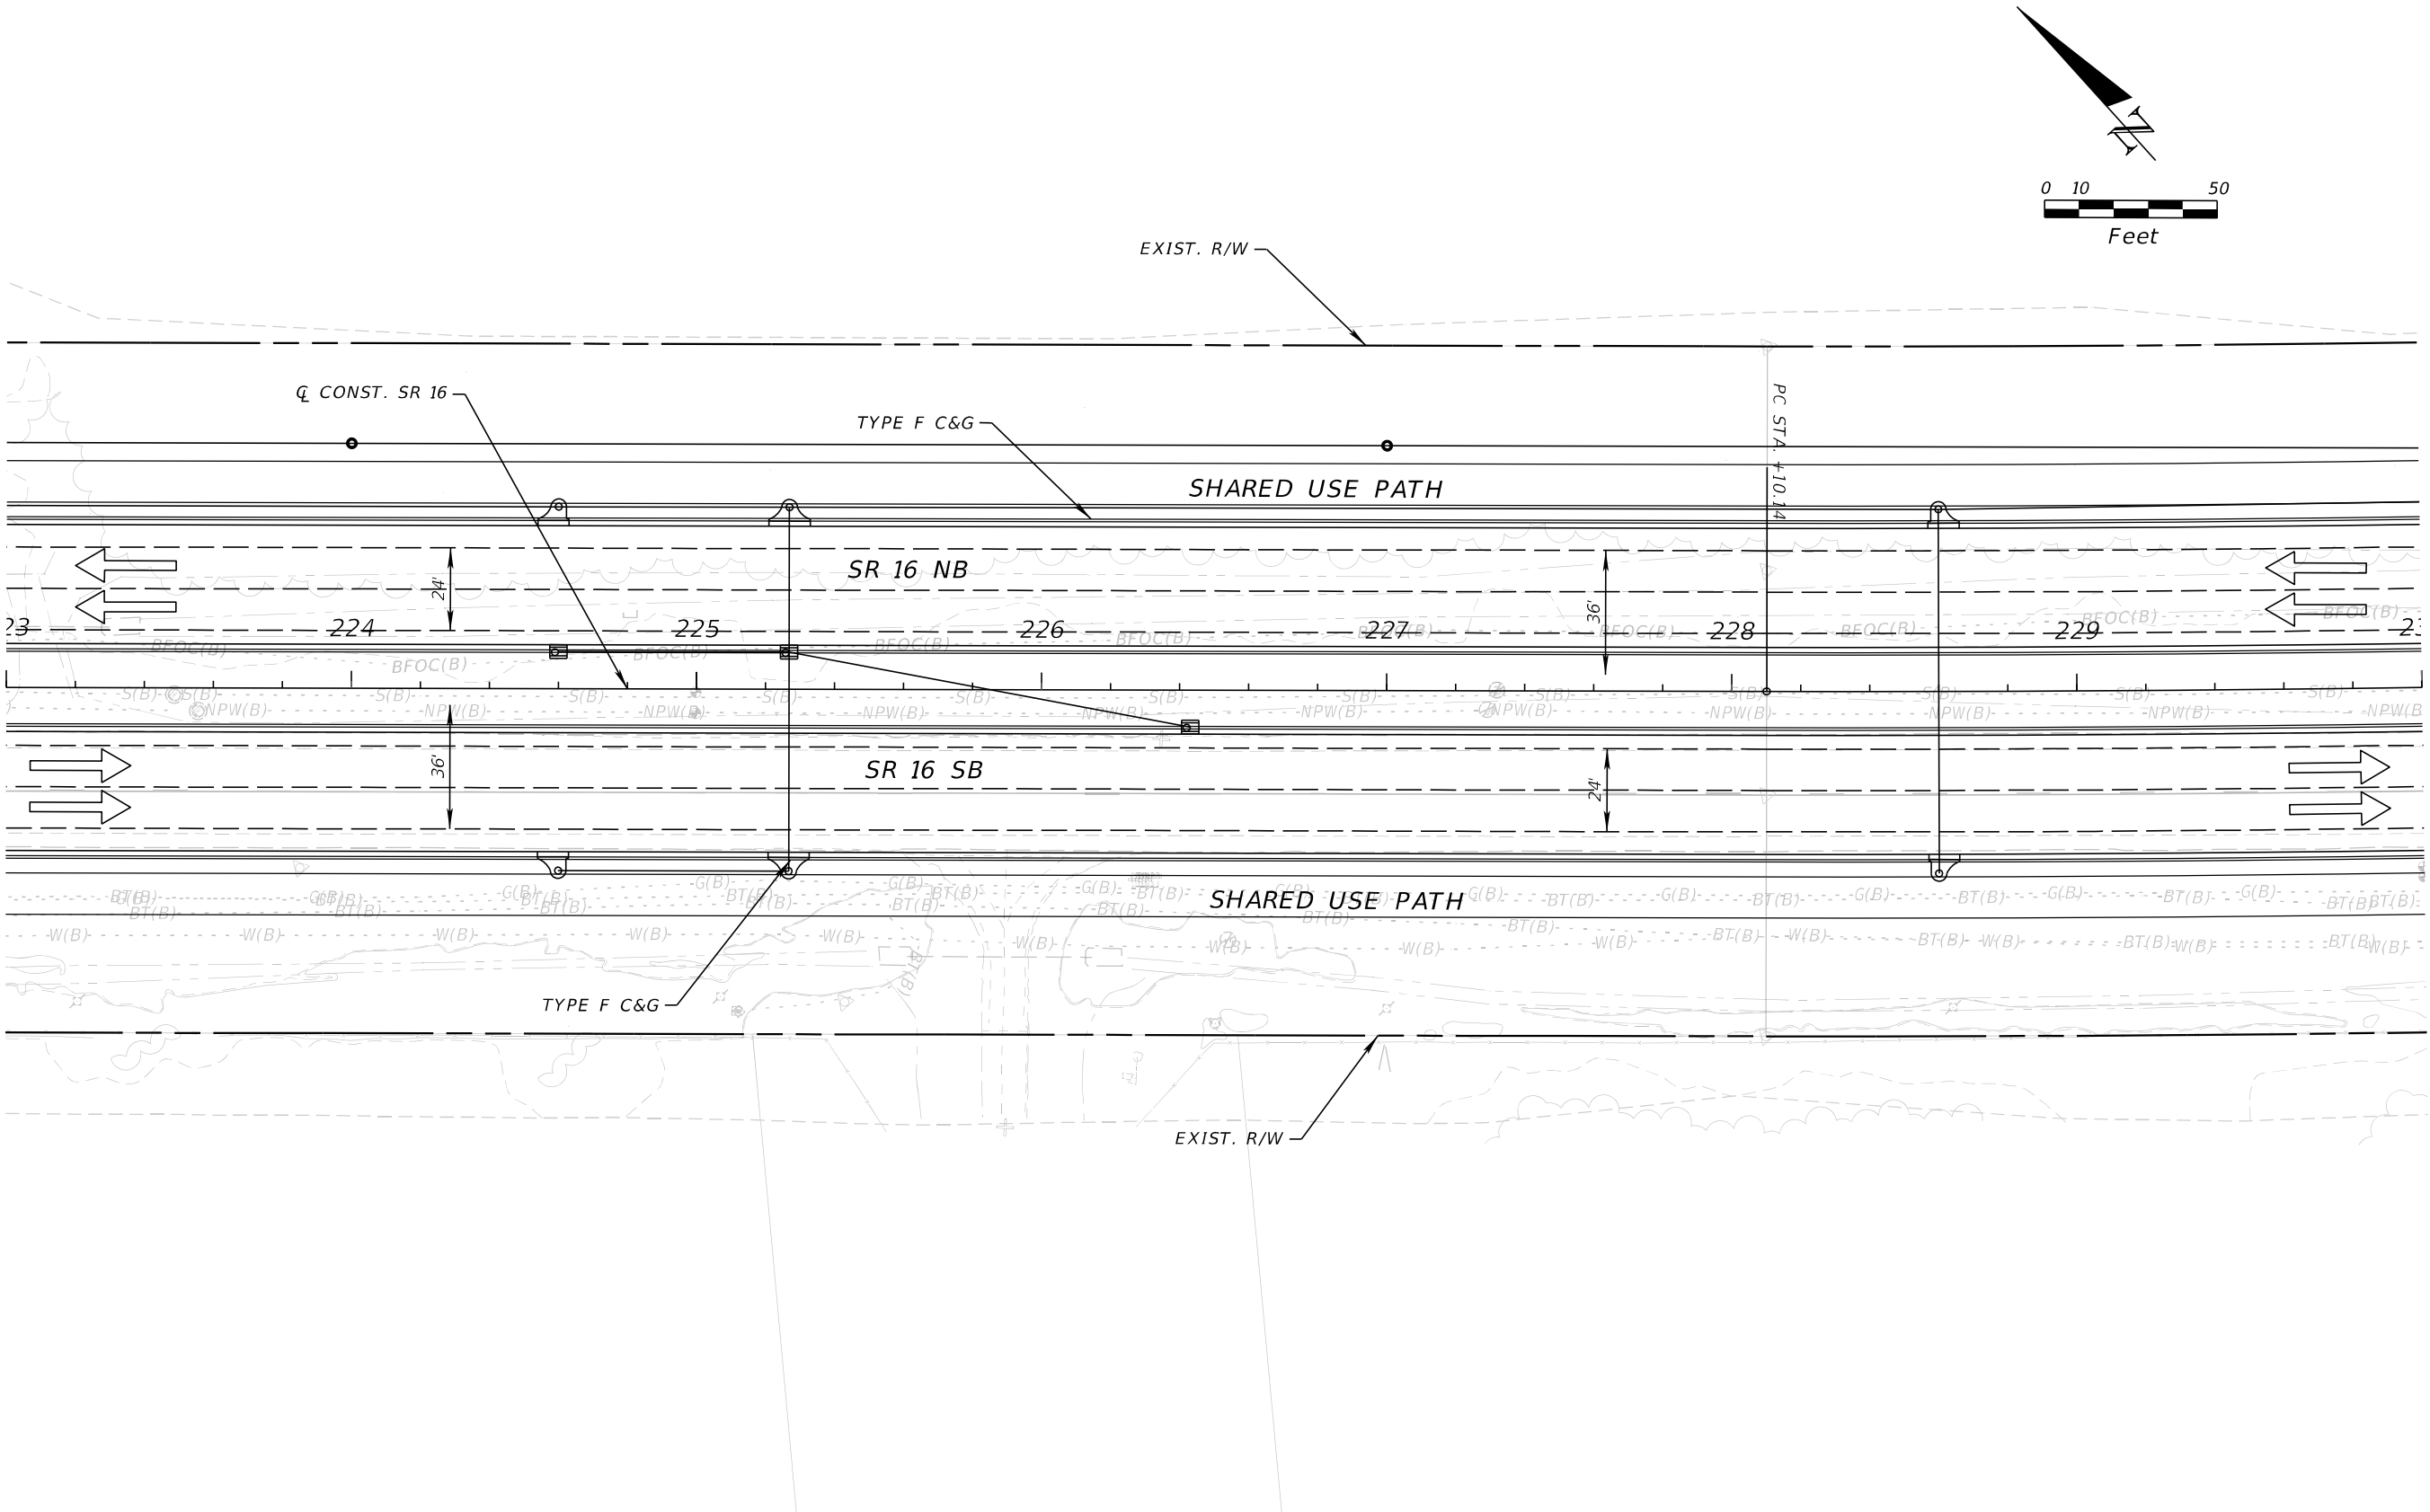


| REVISIONS |             |      |             | ENGINEER OF RECORD                                                                                                        |  | STATE OF FLORIDA<br>DEPARTMENT OF TRANSPORTATION |           |                      | ROADWAY PLAN | SHEET NO.<br><br>SR 16<br>- PLAN-<br>19 |
|-----------|-------------|------|-------------|---------------------------------------------------------------------------------------------------------------------------|--|--------------------------------------------------|-----------|----------------------|--------------|-----------------------------------------|
| DATE      | DESCRIPTION | DATE | DESCRIPTION | STEPHEN J. PARK, P.E.<br>LICENSE NUMBER: 77656<br>RS&H, INC.<br>10748 DEERWOOD PARK BLVD. SOUTH<br>JACKSONVILLE, FL 32256 |  | ROAD NO.                                         | COUNTY    | FINANCIAL PROJECT ID |              |                                         |
|           |             |      |             |                                                                                                                           |  | SR 16                                            | ST. JOHNS | 210447-5-52-01       |              |                                         |

THE OFFICIAL RECORD OF THIS SHEET IS THE ELECTRONIC FILE DIGITALLY SIGNED AND SEALED UNDER RULE 61G15-23.004, F.A.C.



8/5/2024 4:28:50 PM BeattyM  
c:\pw\_work\ysh\_pw\pw\_user\0439575\PLAINRD01.dgn


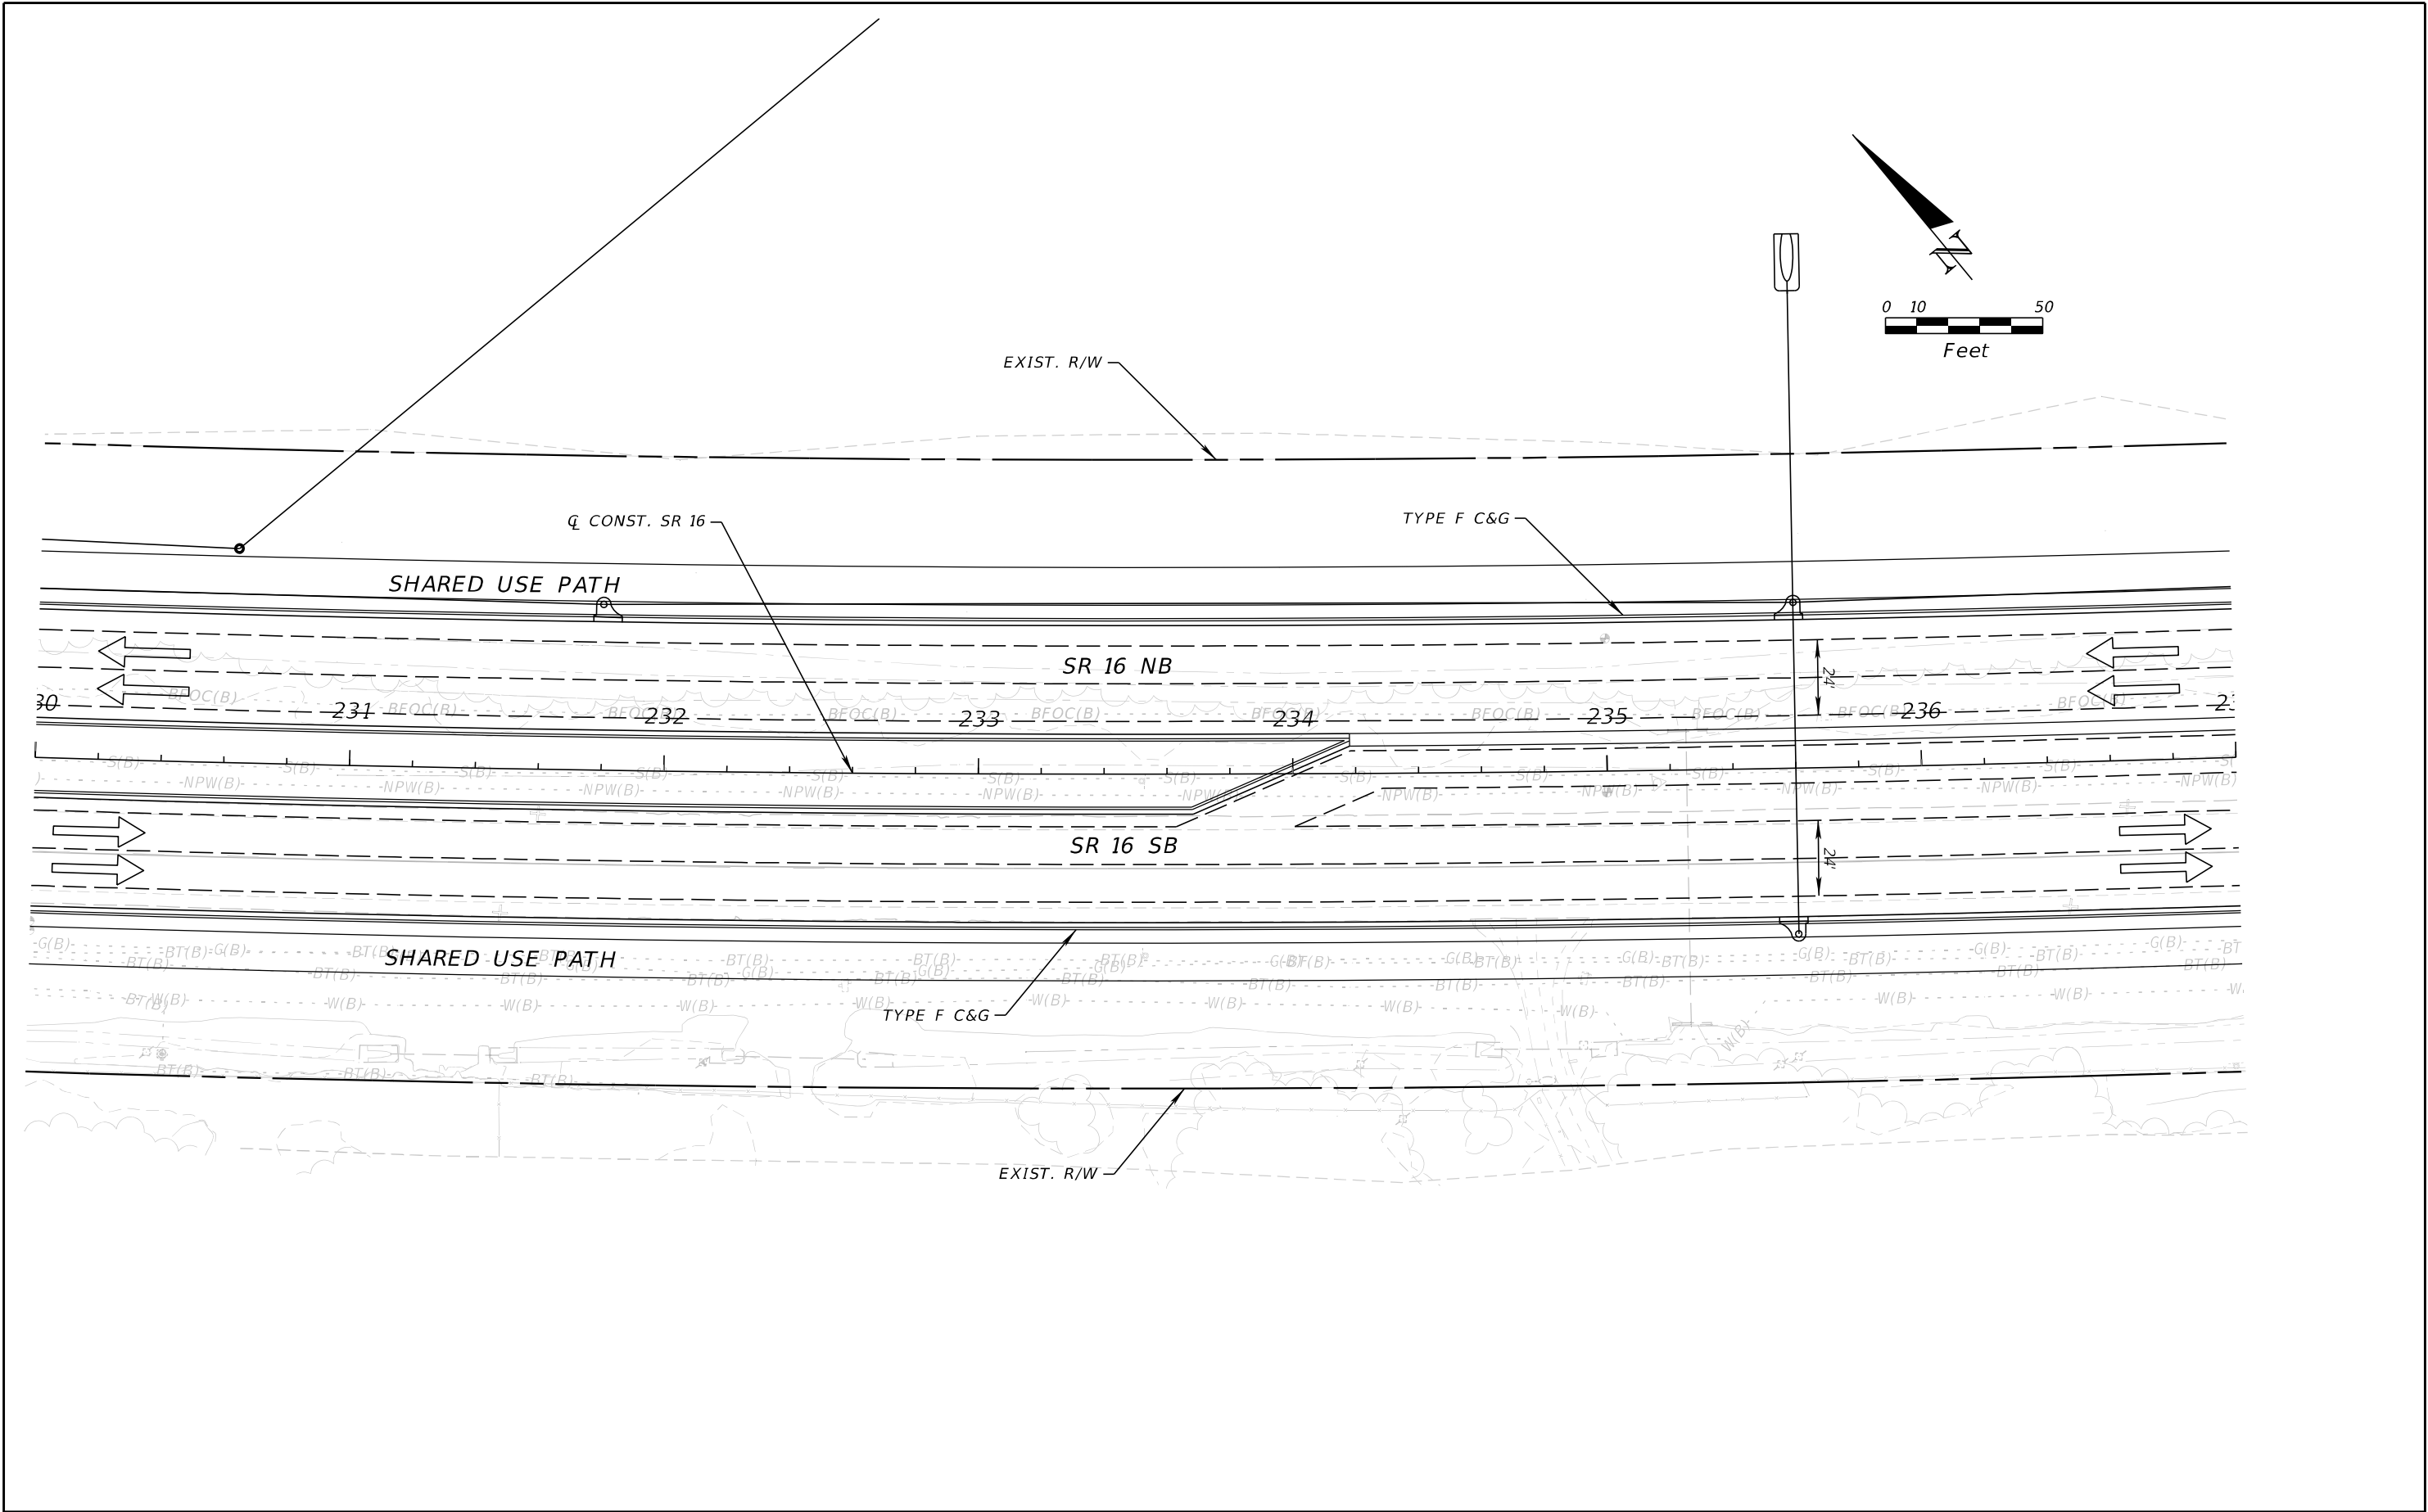


| REVISIONS |             |      |             | ENGINEER OF RECORD                                                                                                        | STATE OF FLORIDA<br>DEPARTMENT OF TRANSPORTATION |        |                      | SHEET<br>NO.   |
|-----------|-------------|------|-------------|---------------------------------------------------------------------------------------------------------------------------|--------------------------------------------------|--------|----------------------|----------------|
| DATE      | DESCRIPTION | DATE | DESCRIPTION | STEPHEN J. PARK, P.E.<br>LICENSE NUMBER: 77656<br>RS&H, INC.<br>10748 DEERWOOD PARK BLVD. SOUTH<br>JACKSONVILLE, FL 32256 | ROAD NO.                                         | COUNTY | FINANCIAL PROJECT ID |                |
|           |             |      |             |                                                                                                                           |                                                  | SR 16  | ST. JOHNS            | 210447-5-52-01 |

THE OFFICIAL RECORD OF THIS SHEET IS THE ELECTRONIC FILE DIGITALLY SIGNED AND SEALED UNDER RULE 61G15-23.004, F.A.C.

8/5/2024 4:28:51 PM BeattyM  
c:\pw\_work\ysh\_pw\pw\_user\0439575\PLANRD01.dgn


CURVE DATA  
PI STA. = 239+02.25  
 $\Delta$  = 10°55'00" (LT)  
D = 00°30'05"  
T = 1,092.10  
L = 2,177.60  
R = 2,177.60  
PC STA. = 228+10.14  
PT STA. = 249+87.74  
e = 0.000

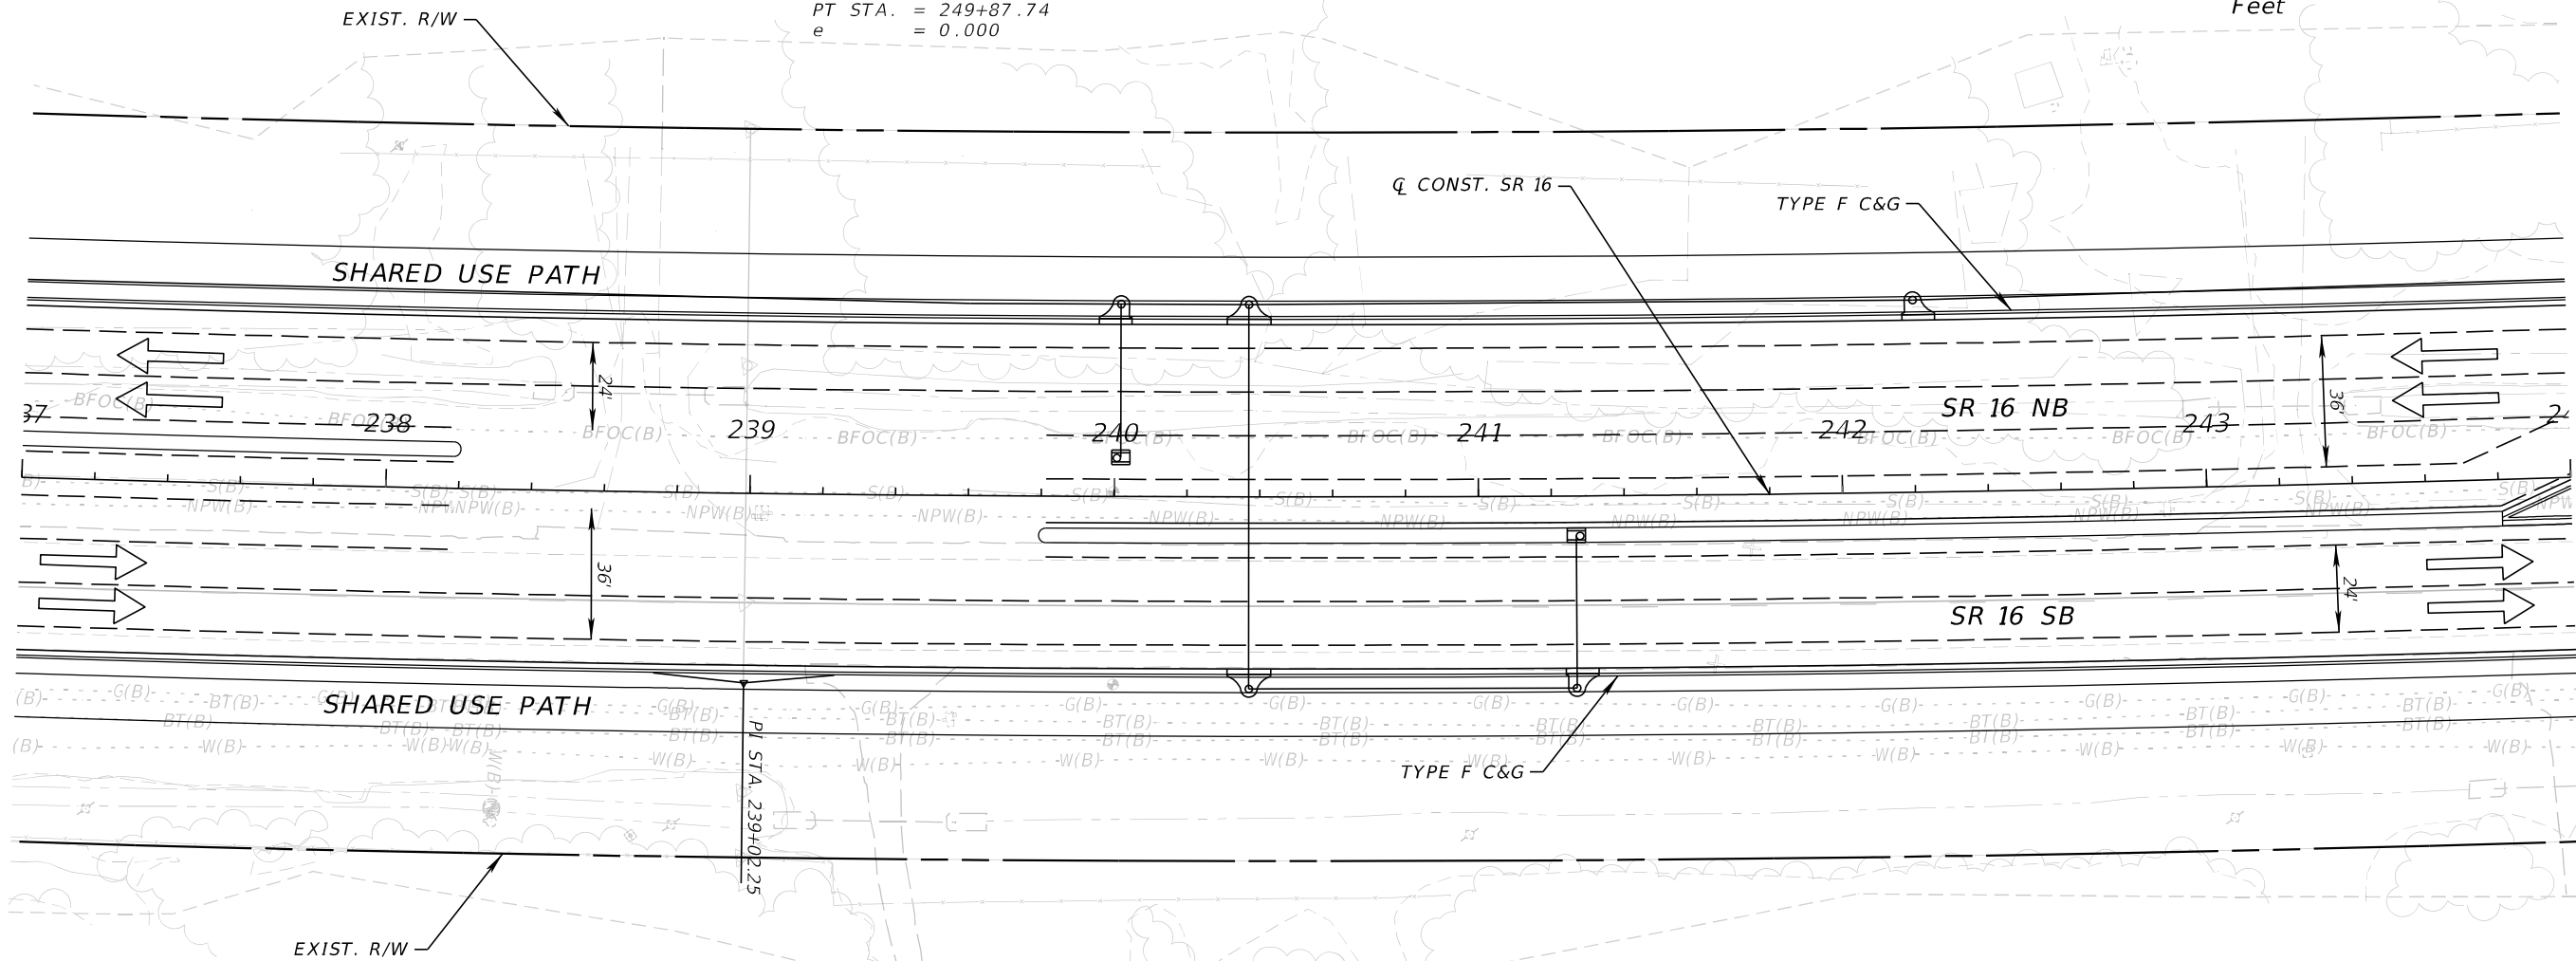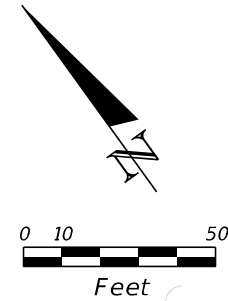

| REVISIONS |             |      |             | ENGINEER OF RECORD                                                                                                        |  | STATE OF FLORIDA<br>DEPARTMENT OF TRANSPORTATION |           |                      | SHEET<br>NO. |
|-----------|-------------|------|-------------|---------------------------------------------------------------------------------------------------------------------------|--|--------------------------------------------------|-----------|----------------------|--------------|
| DATE      | DESCRIPTION | DATE | DESCRIPTION | STEPHEN J. PARK, P.E.<br>LICENSE NUMBER: 77656<br>RS&H, INC.<br>10748 DEERWOOD PARK BLVD. SOUTH<br>JACKSONVILLE, FL 32256 |  | ROAD NO.                                         | COUNTY    | FINANCIAL PROJECT ID |              |
|           |             |      |             |                                                                                                                           |  | SR 16                                            | ST. JOHNS | 210447-5-52-01       |              |

THE OFFICIAL RECORD OF THIS SHEET IS THE ELECTRONIC FILE DIGITALLY SIGNED AND SEALED UNDER RULE 61G15-23.004, F.A.C.


8/5/2024 4:28:51 PM BeattyM  
c:\pw\_work\ysh\_pw\pw\_user\0439575\PLAINRD01.dgn

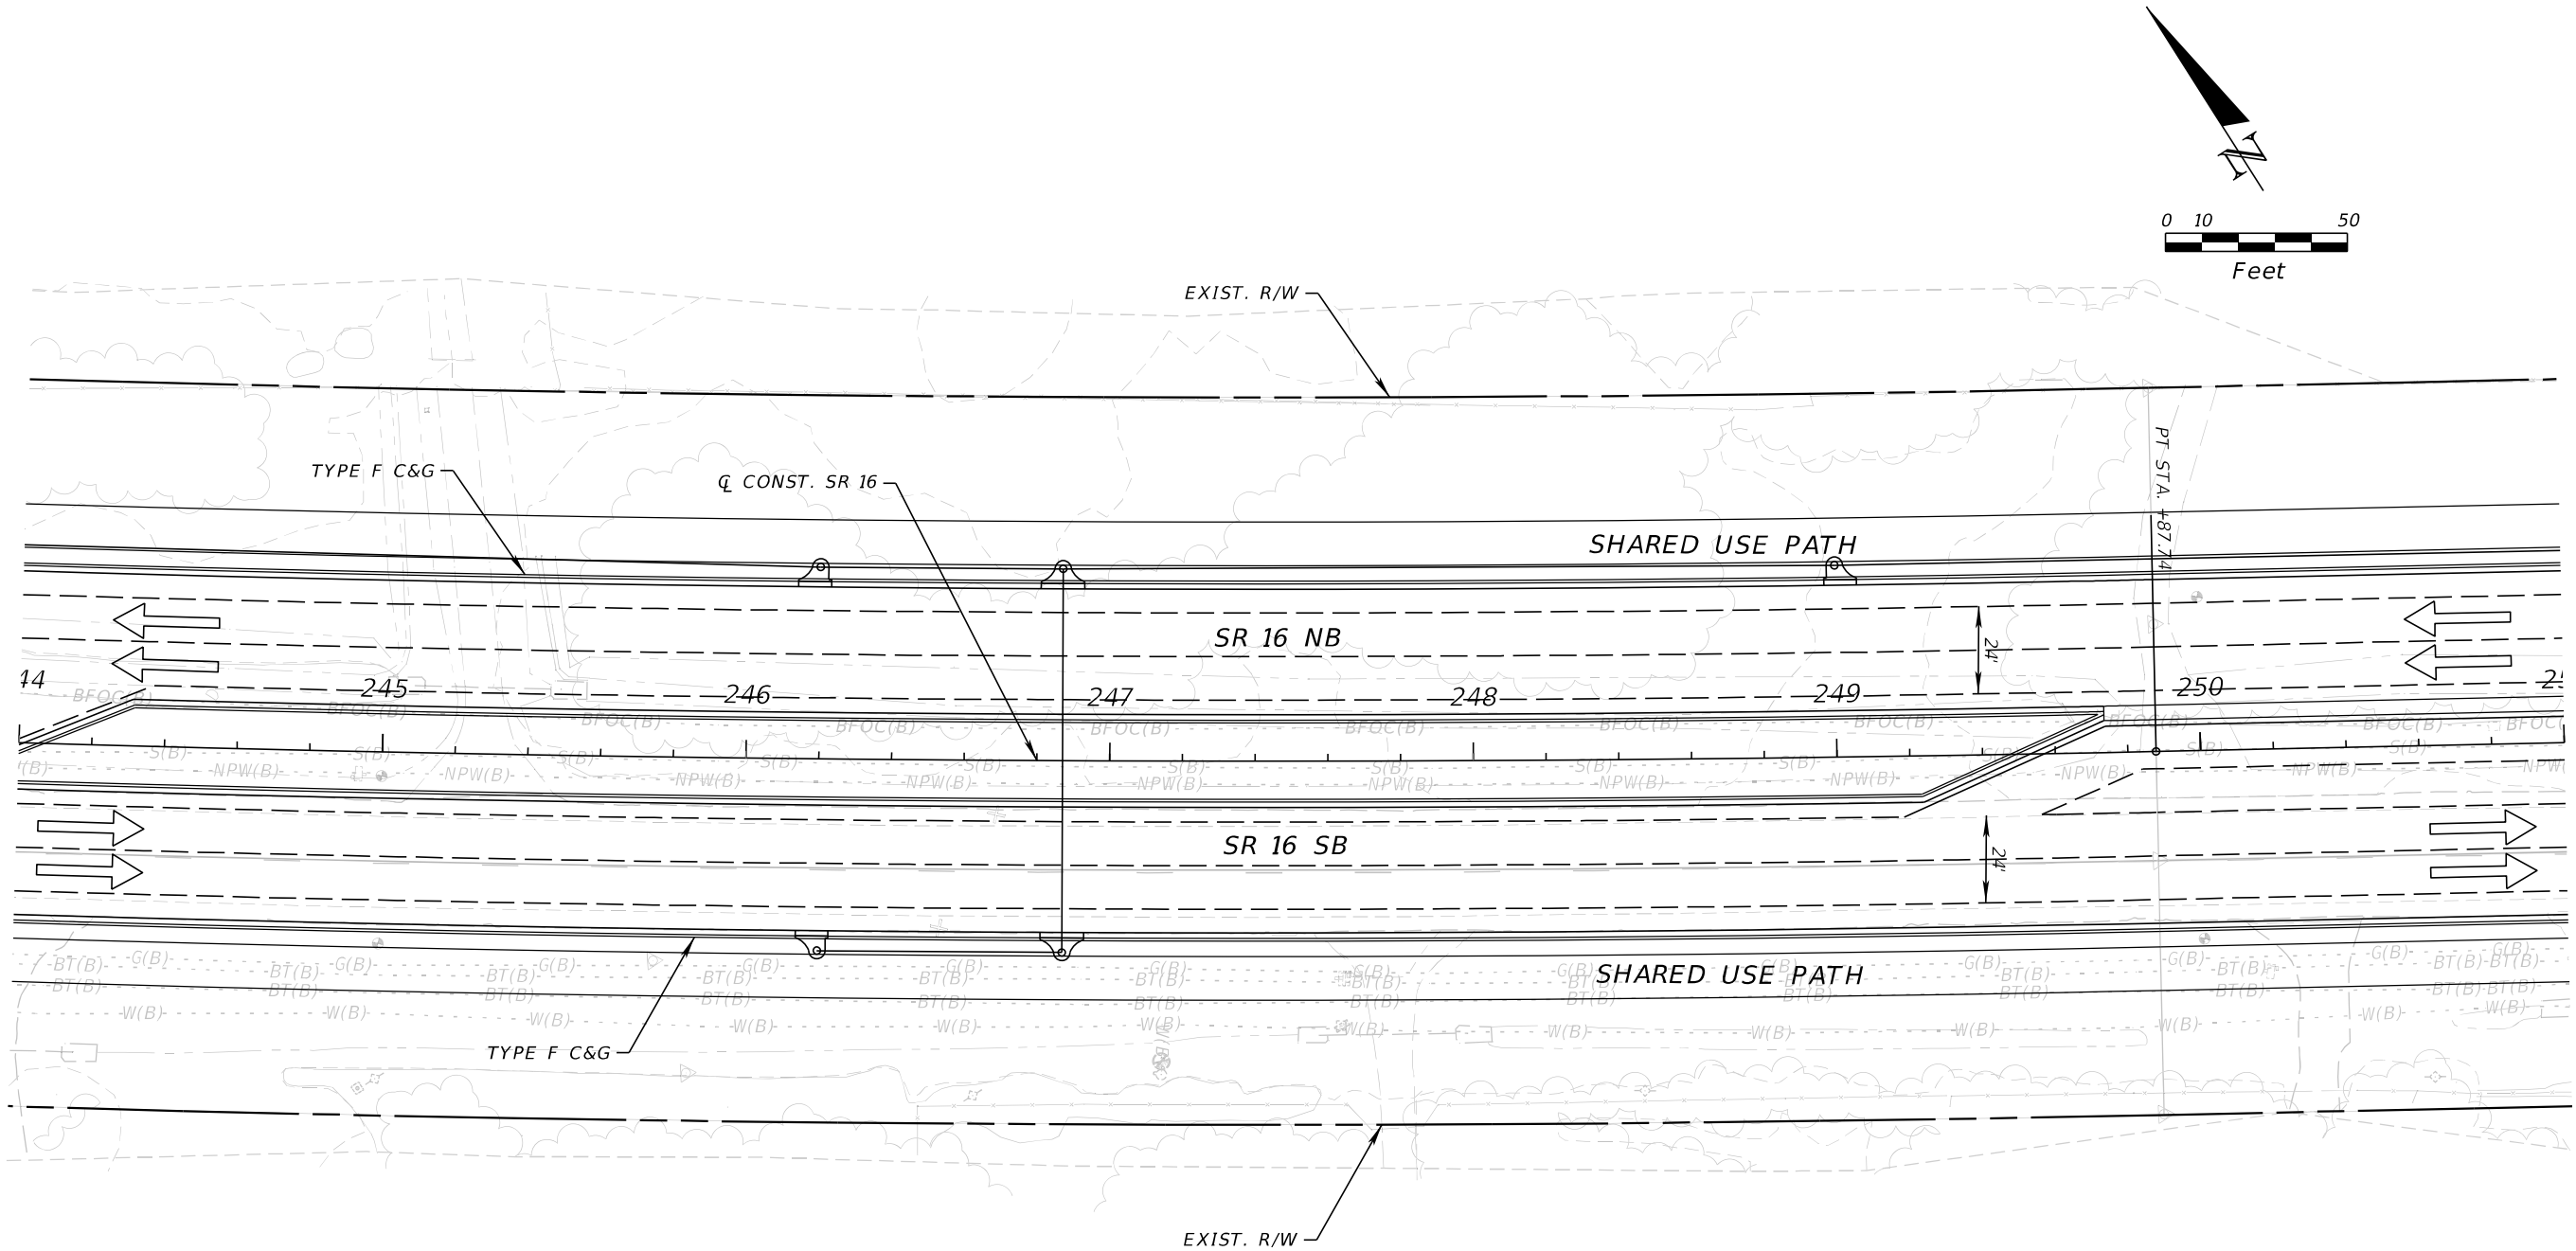

| REVISIONS |             |      |             | ENGINEER OF RECORD                                                                                                        | STATE OF FLORIDA<br>DEPARTMENT OF TRANSPORTATION |           |                      | SHEET<br>NO.          |
|-----------|-------------|------|-------------|---------------------------------------------------------------------------------------------------------------------------|--------------------------------------------------|-----------|----------------------|-----------------------|
| DATE      | DESCRIPTION | DATE | DESCRIPTION |                                                                                                                           | ROAD NO.                                         | COUNTY    | FINANCIAL PROJECT ID |                       |
|           |             |      |             | STEPHEN J. PARK, P.E.<br>LICENSE NUMBER: 77656<br>RS&H, INC.<br>10748 DEERWOOD PARK BLVD. SOUTH<br>JACKSONVILLE, FL 32256 | SR 16                                            | ST. JOHNS | 210447-5-52-01       | 11x17<br>Plan<br>Only |

THE OFFICIAL RECORD OF THIS SHEET IS THE ELECTRONIC FILE DIGITALLY SIGNED AND SEALED UNDER RULE 61G15-23.004, F.A.C.


8/5/2024 4:28:52 PM BeattyM  
c:\pw\_work\ysh\_pw\pw\_user\00439575\PLANRD01.dgn

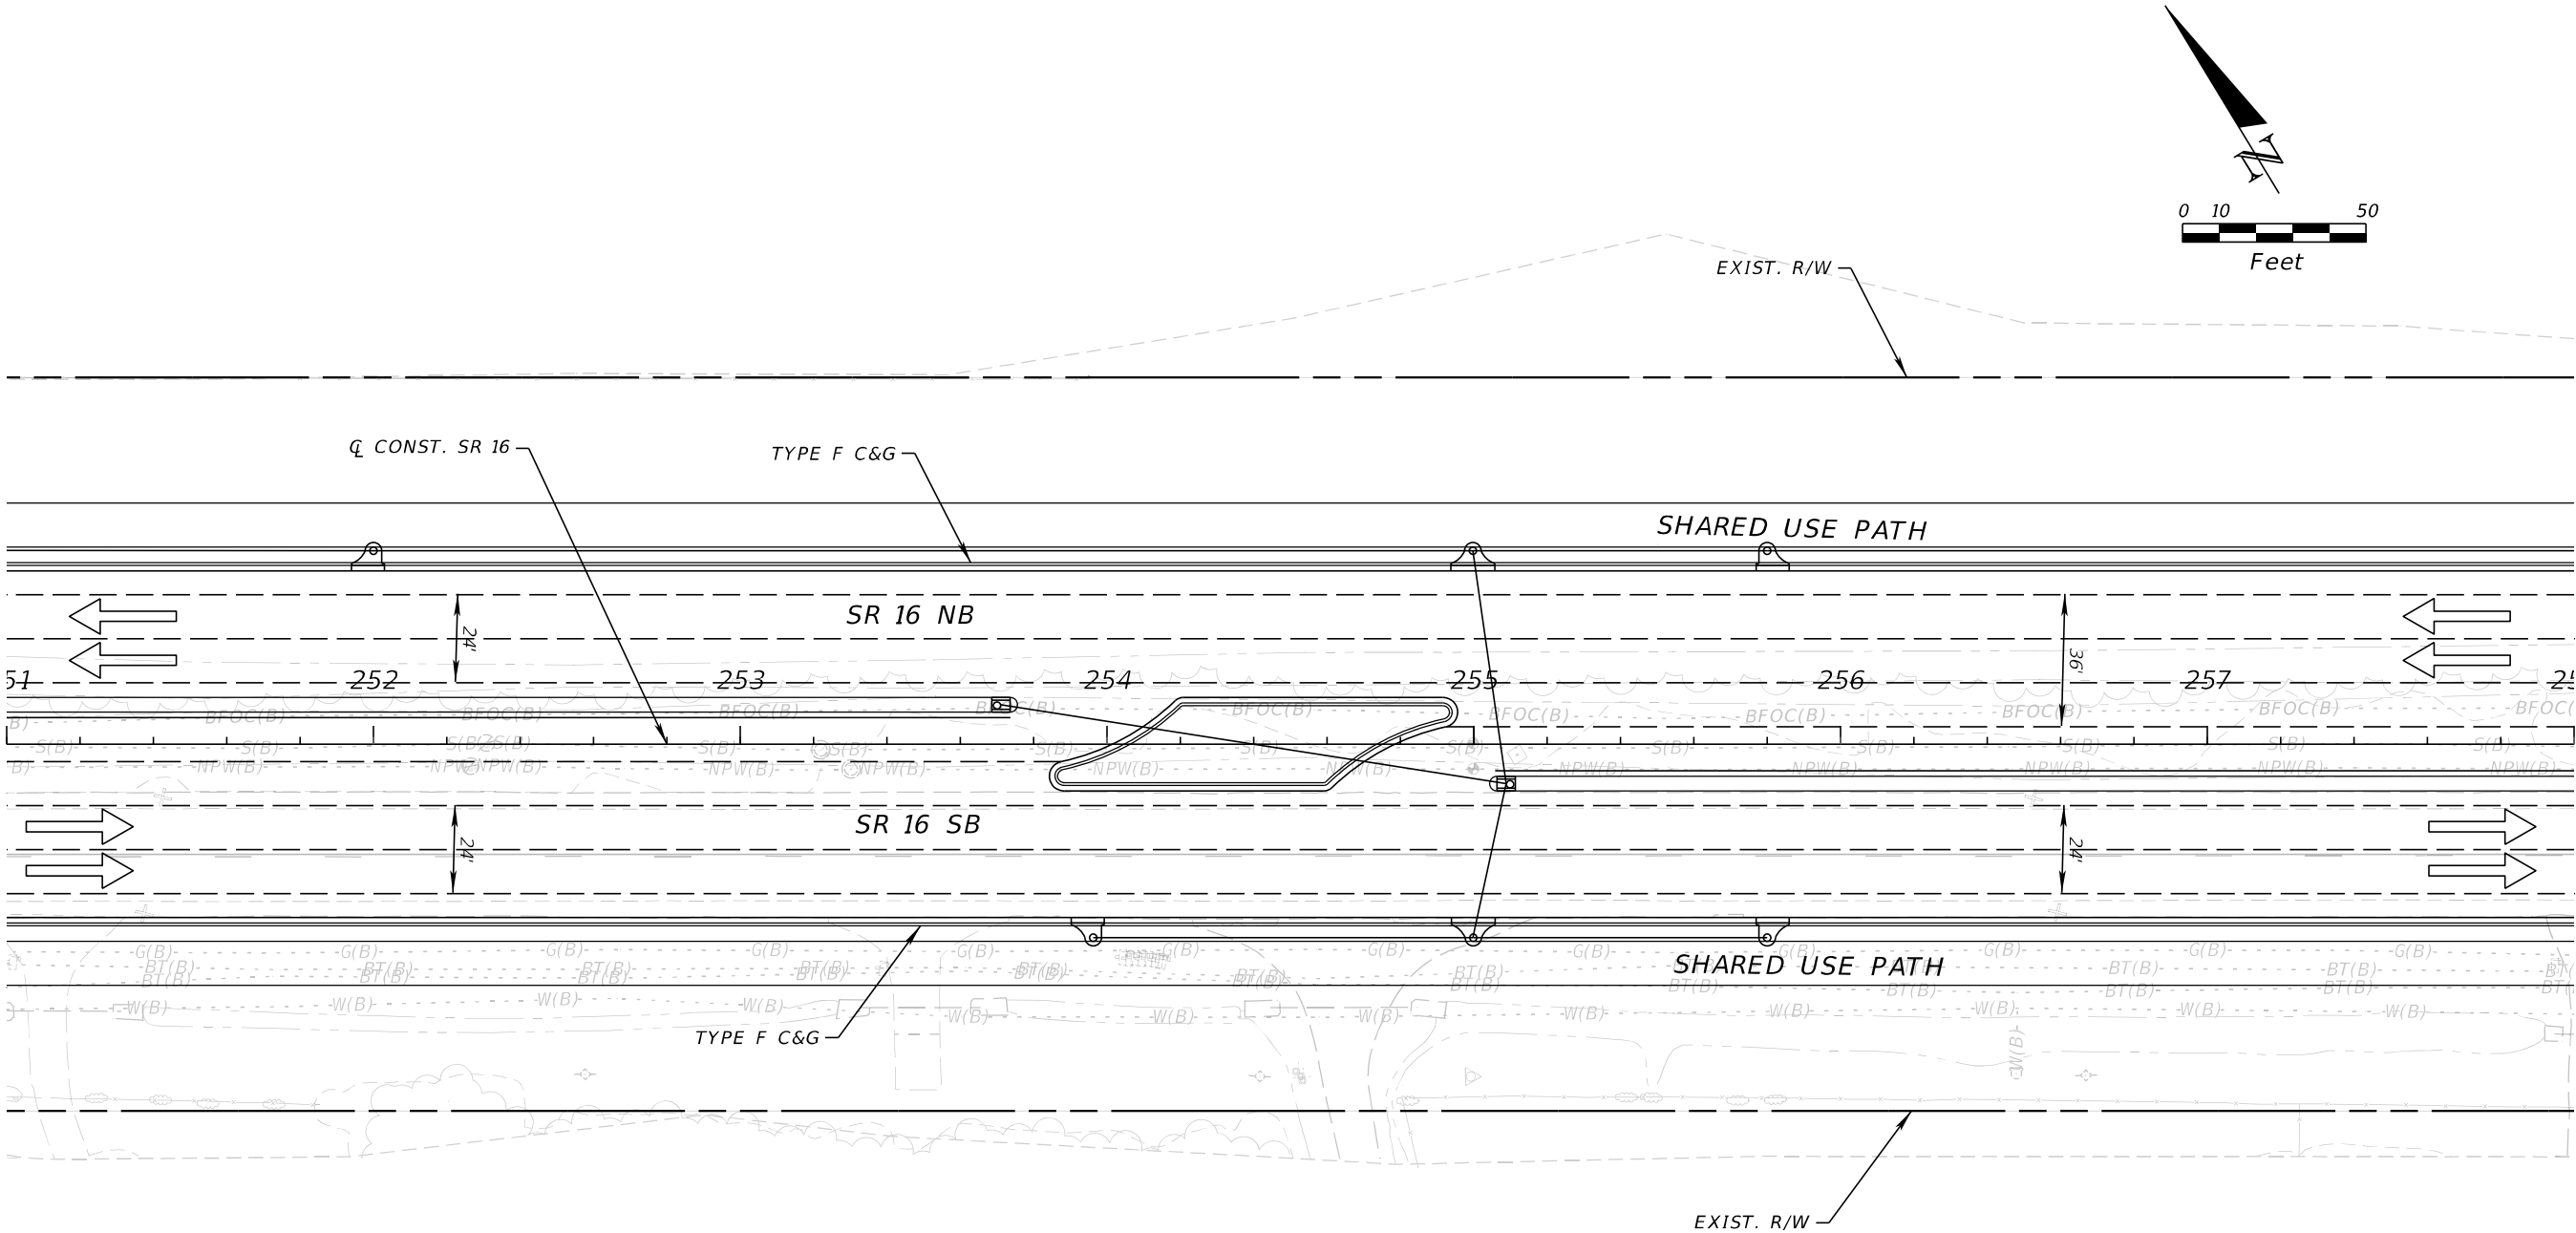

| REVISIONS |             |      |             | ENGINEER OF RECORD                                                                                                        | STATE OF FLORIDA<br>DEPARTMENT OF TRANSPORTATION |           |                      | SHEET<br>NO.          |
|-----------|-------------|------|-------------|---------------------------------------------------------------------------------------------------------------------------|--------------------------------------------------|-----------|----------------------|-----------------------|
| DATE      | DESCRIPTION | DATE | DESCRIPTION | STEPHEN J. PARK, P.E.<br>LICENSE NUMBER: 77656<br>RS&H, INC.<br>10748 DEERWOOD PARK BLVD. SOUTH<br>JACKSONVILLE, FL 32256 | ROAD NO.                                         | COUNTY    | FINANCIAL PROJECT ID |                       |
|           |             |      |             |                                                                                                                           | SR 16                                            | ST. JOHNS | 210447-5-52-01       |                       |
|           |             |      |             |                                                                                                                           |                                                  |           |                      | 11x17<br>Plan<br>Only |

THE OFFICIAL RECORD OF THIS SHEET IS THE ELECTRONIC FILE DIGITALLY SIGNED AND SEALED UNDER RULE 61G15-23.004, F.A.C.

8/5/2024 4:28:52 PM BeattyM  
c:\pw\_work\ysh\_pw\pw\_user\00439575\PLANRD01.dgn

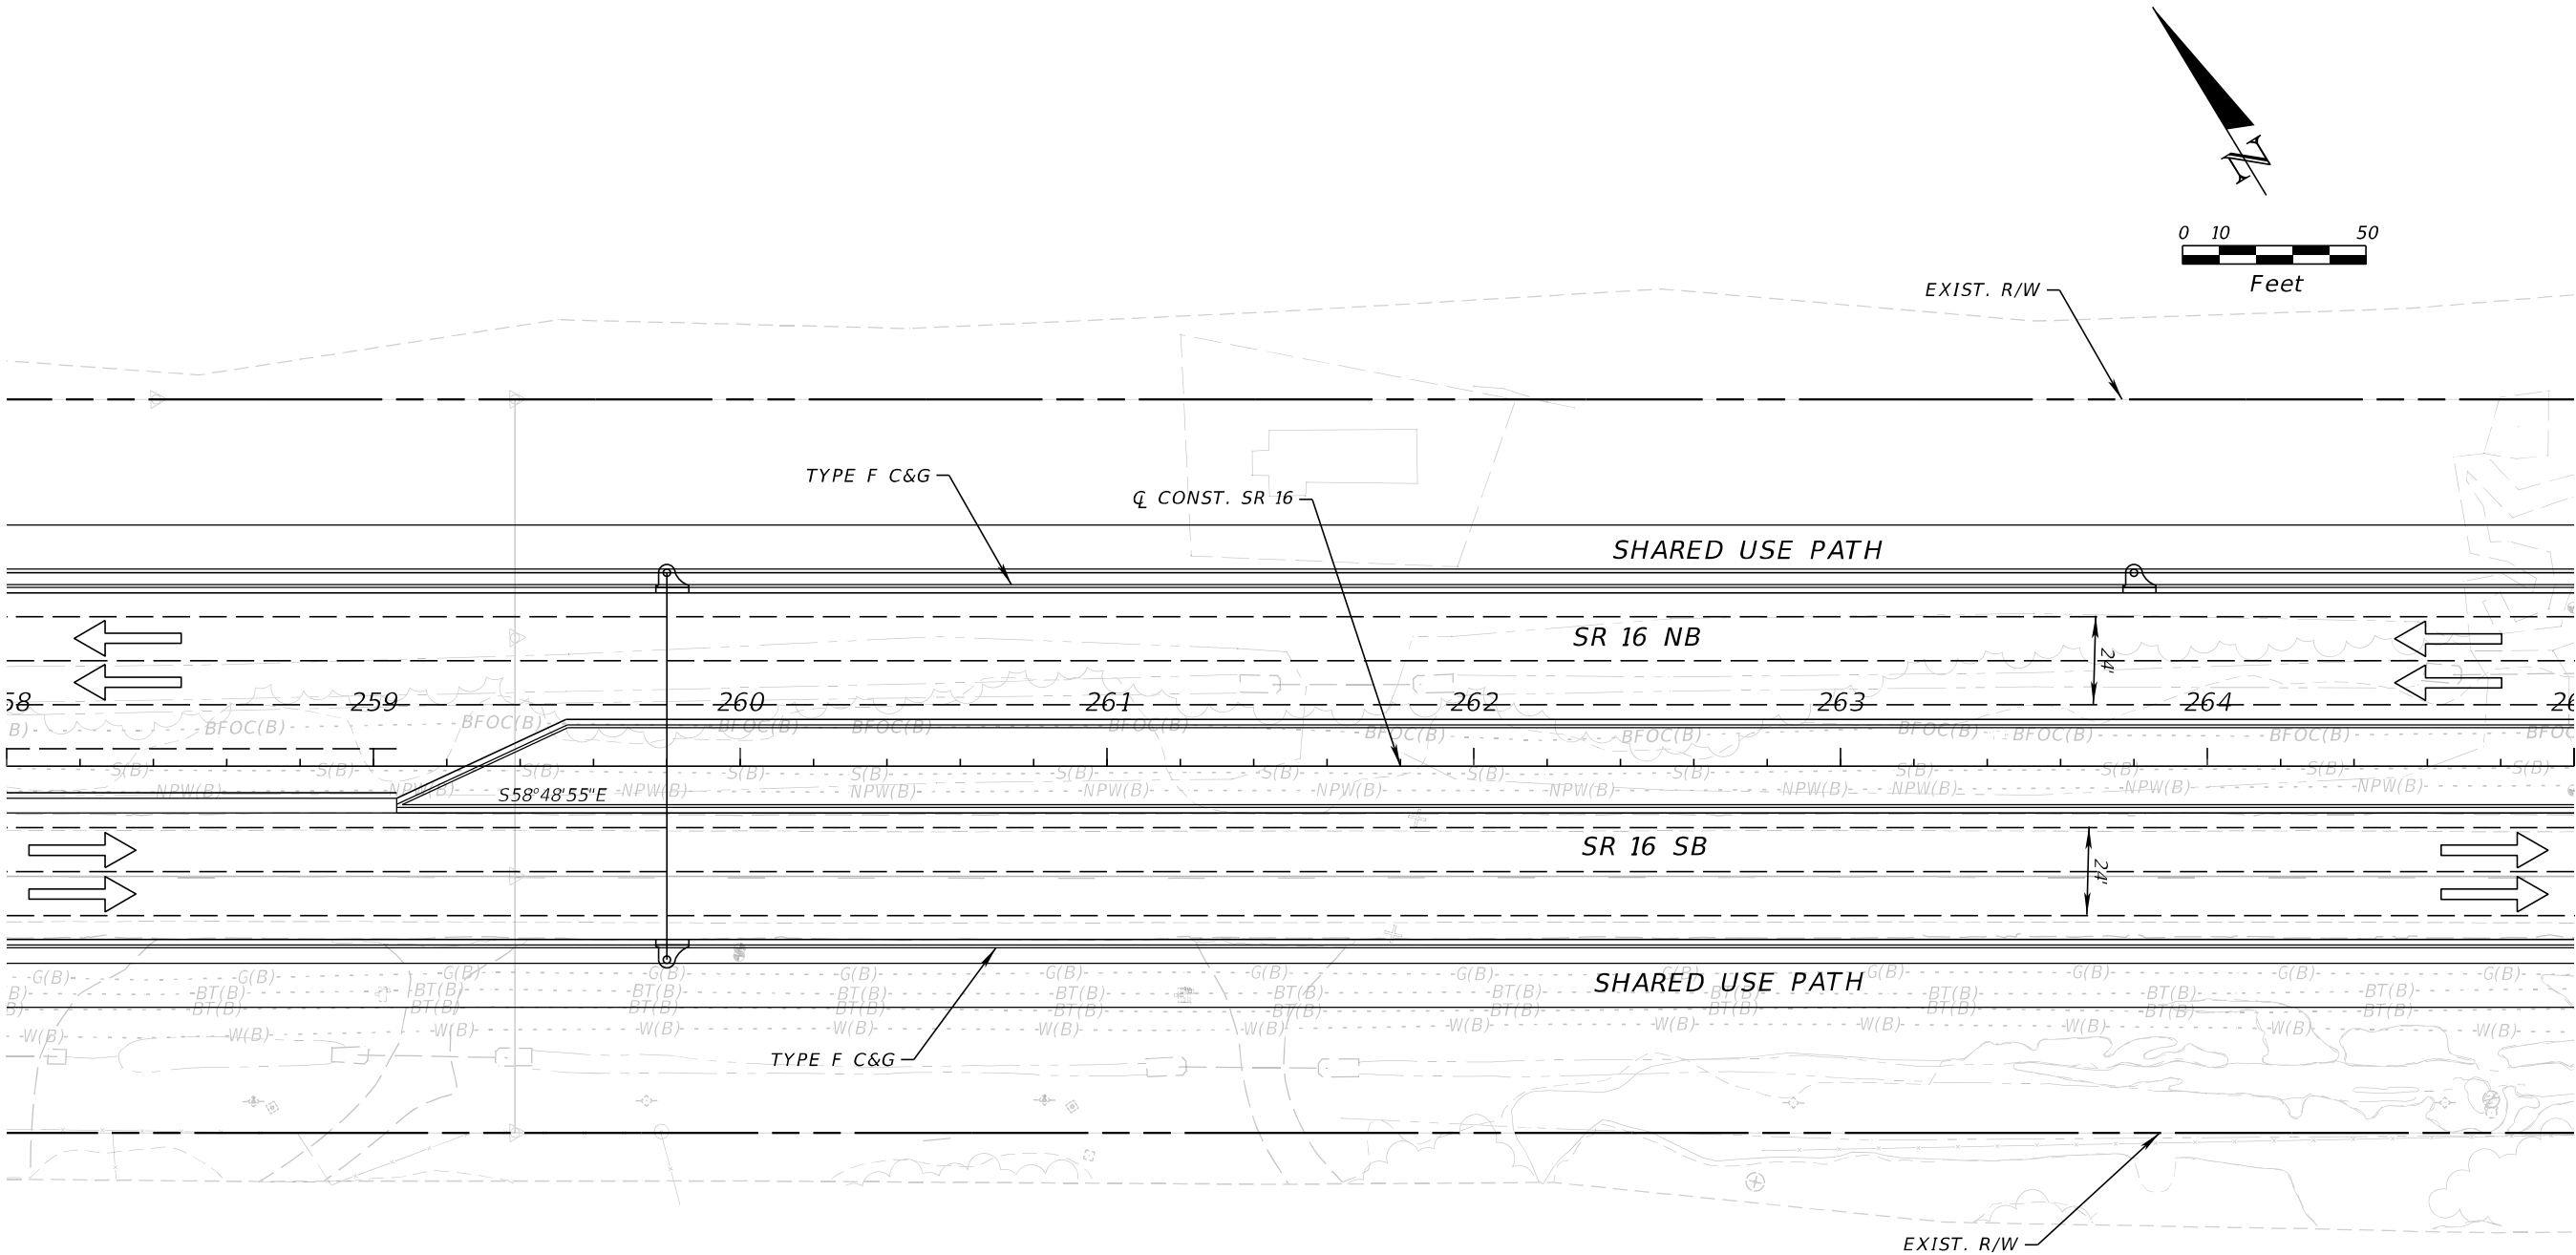


| REVISIONS |             |      |             | ENGINEER OF RECORD                                                                                                        | STATE OF FLORIDA<br>DEPARTMENT OF TRANSPORTATION |           |                      | SHEET<br>NO.          |
|-----------|-------------|------|-------------|---------------------------------------------------------------------------------------------------------------------------|--------------------------------------------------|-----------|----------------------|-----------------------|
| DATE      | DESCRIPTION | DATE | DESCRIPTION | STEPHEN J. PARK, P.E.<br>LICENSE NUMBER: 77656<br>RS&H, INC.<br>10748 DEERWOOD PARK BLVD. SOUTH<br>JACKSONVILLE, FL 32256 | ROAD NO.                                         | COUNTY    | FINANCIAL PROJECT ID |                       |
|           |             |      |             |                                                                                                                           | SR 16                                            | ST. JOHNS | 210447-5-52-01       |                       |
|           |             |      |             |                                                                                                                           |                                                  |           |                      | 11x17<br>Plan<br>Only |

THE OFFICIAL RECORD OF THIS SHEET IS THE ELECTRONIC FILE DIGITALLY SIGNED AND SEALED UNDER RULE 61G15-23.004, F.A.C.




8/5/2024 4:28:53 PM BeattyM  
c:\pw\_work\ysh\_pw\pw\_user\0439575\PLANRD01.dgn

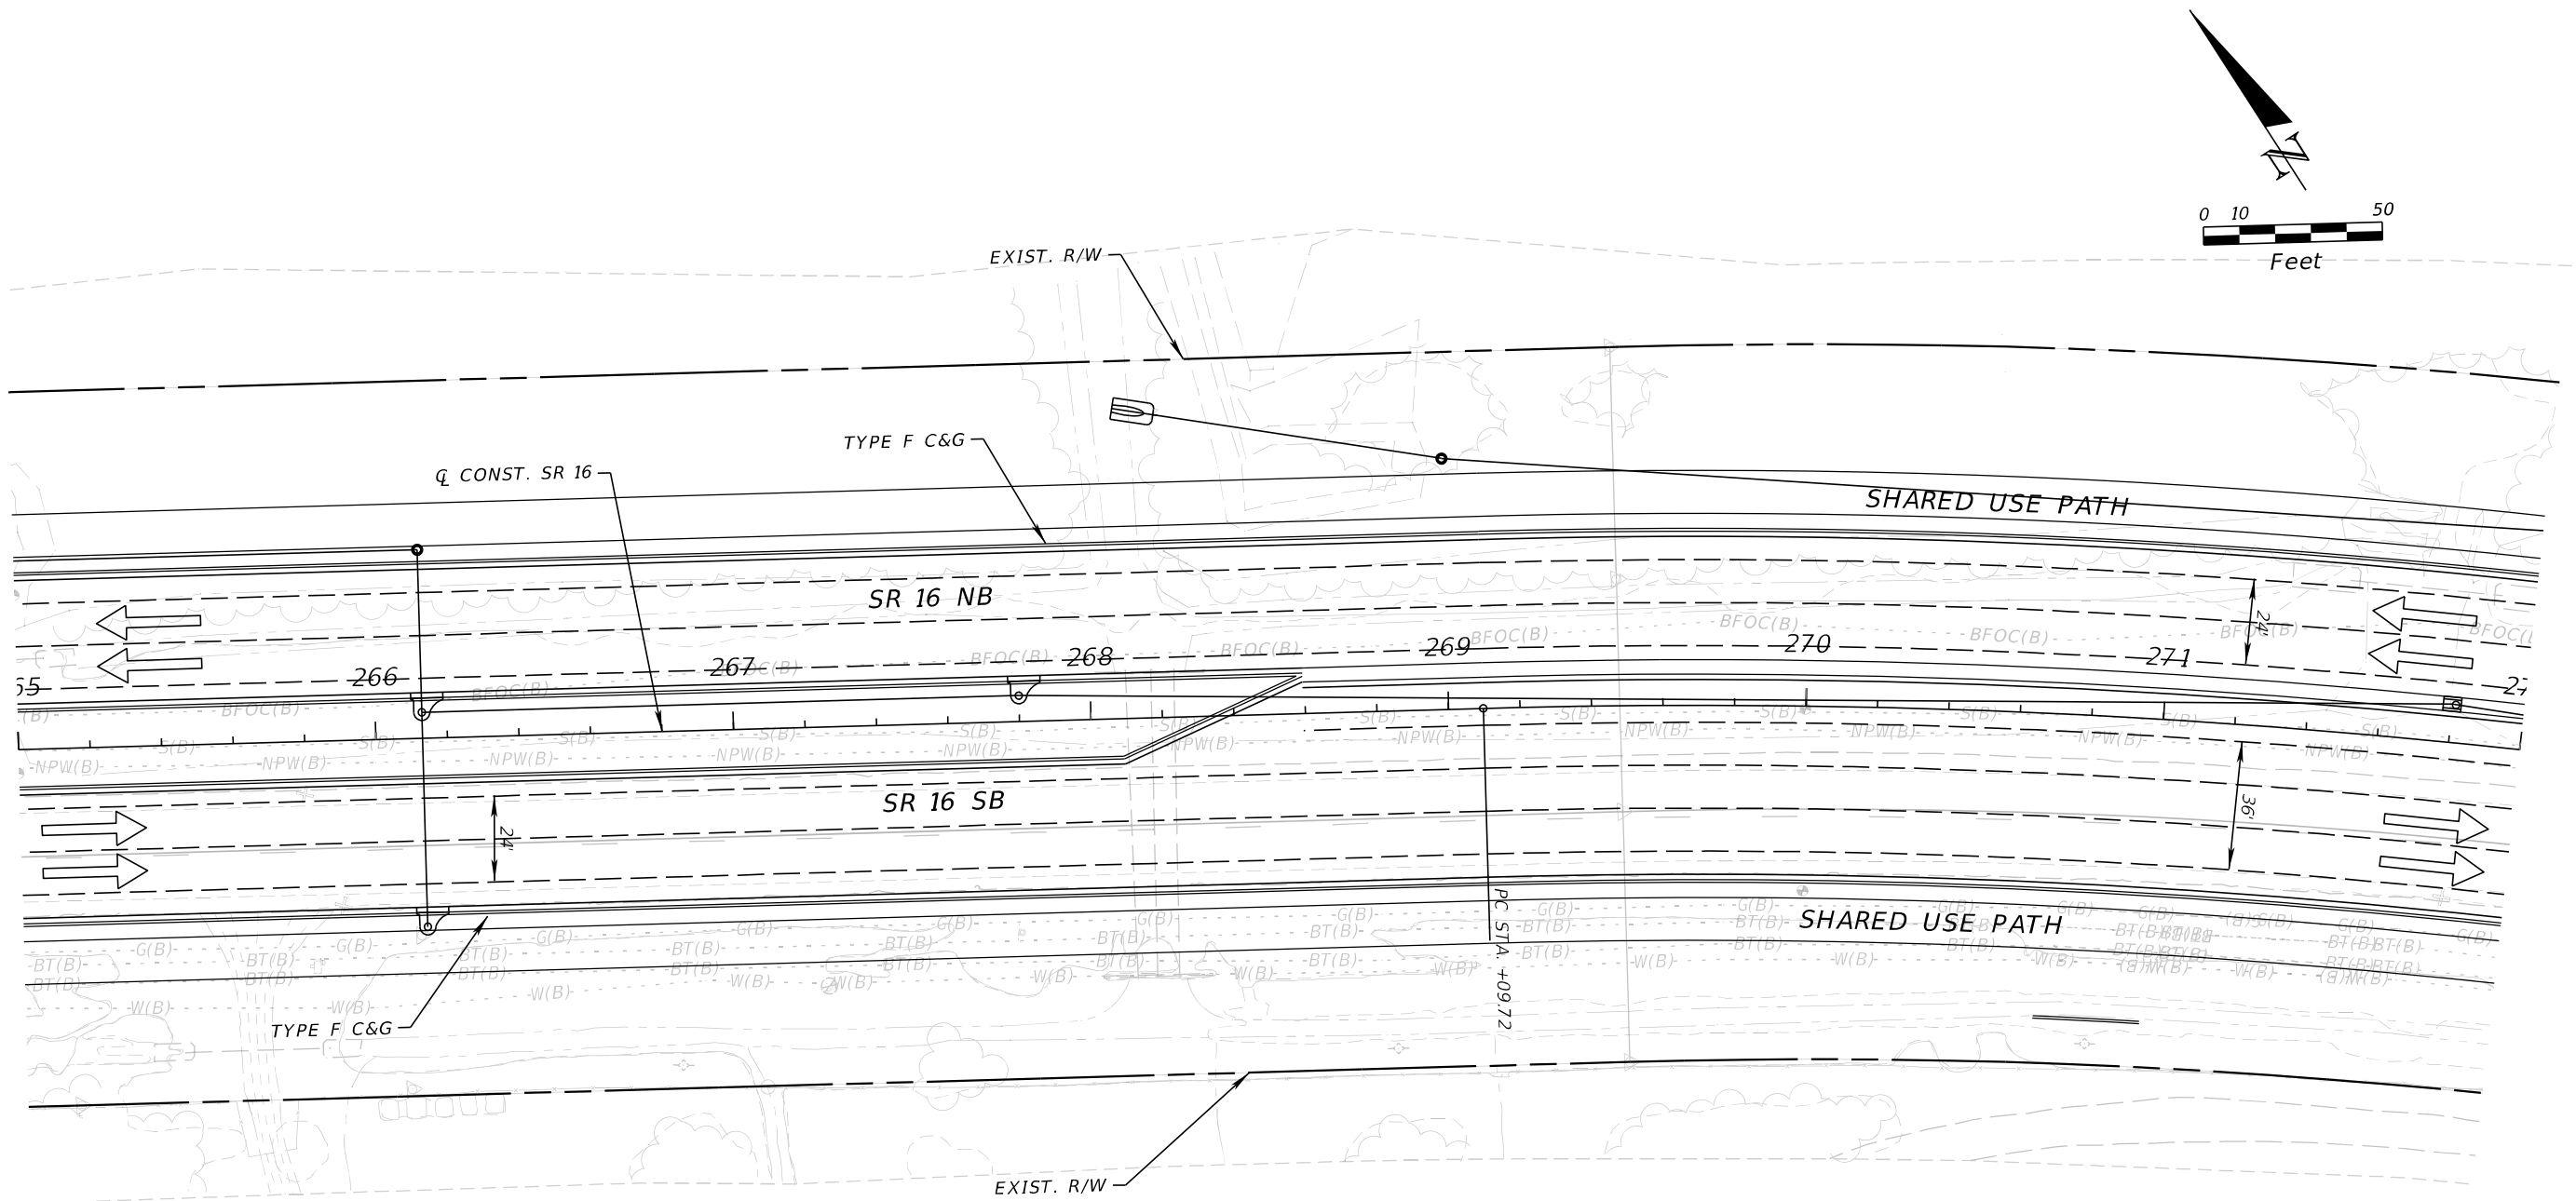

| REVISIONS |             |      |             | ENGINEER OF RECORD                                                                                                        |  | STATE OF FLORIDA<br>DEPARTMENT OF TRANSPORTATION |           |                      | SHEET<br>NO. |
|-----------|-------------|------|-------------|---------------------------------------------------------------------------------------------------------------------------|--|--------------------------------------------------|-----------|----------------------|--------------|
| DATE      | DESCRIPTION | DATE | DESCRIPTION | STEPHEN J. PARK, P.E.<br>LICENSE NUMBER: 77656<br>RS&H, INC.<br>10748 DEERWOOD PARK BLVD. SOUTH<br>JACKSONVILLE, FL 32256 |  | ROAD NO.                                         | COUNTY    | FINANCIAL PROJECT ID |              |
|           |             |      |             |                                                                                                                           |  | SR 16                                            | ST. JOHNS | 210447-5-52-01       |              |

THE OFFICIAL RECORD OF THIS SHEET IS THE ELECTRONIC FILE DIGITALLY SIGNED AND SEALED UNDER RULE 61G15-23.004, F.A.C.

8/5/2024 4:28:54 PM BeattyM  
c:\pw\_work\ysh\_pw\pw\_user\00439575\PLANRD01.dgn

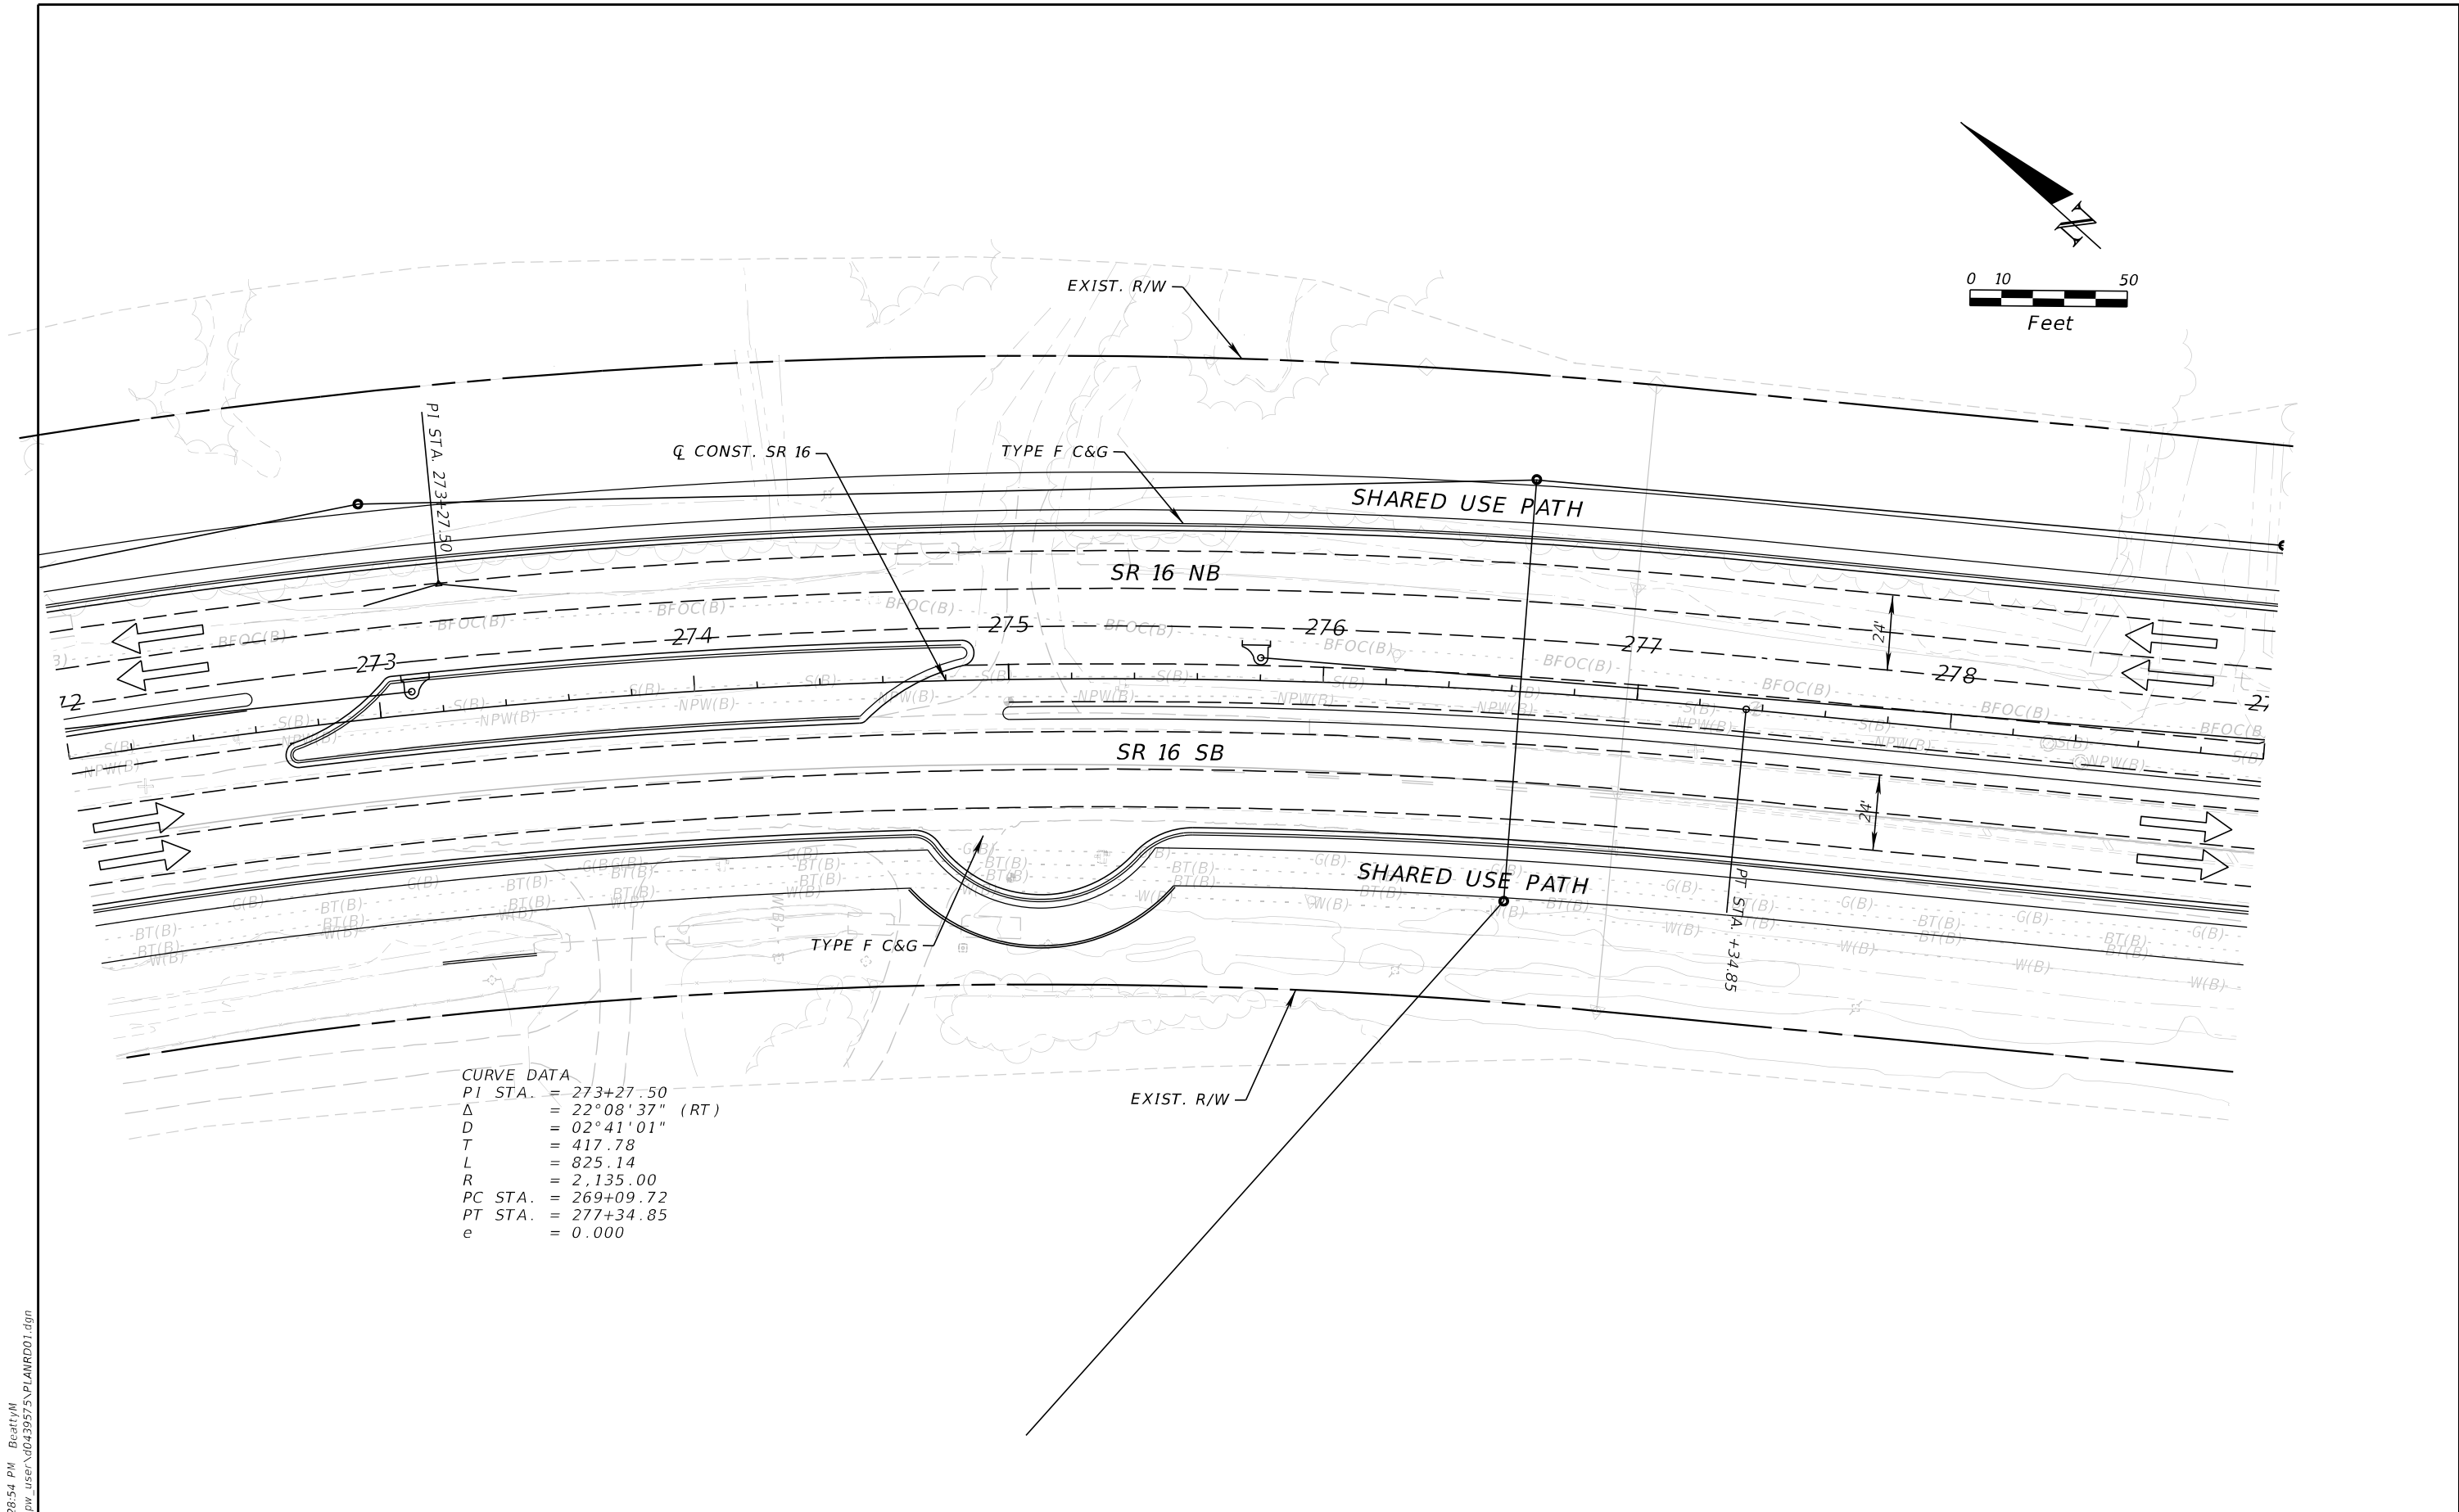


CURVE DATA  
PI STA. = 273+27.50  
Δ = 22°08'37" (RT)  
D = 02°41'01"  
T = 417.78  
L = 825.14  
R = 2,135.00  
PC STA. = 269+09.72  
PT STA. = 277+34.85  
e = 0.000

| REVISIONS |             |      |             | ENGINEER OF RECORD                                                                                                        |  | STATE OF FLORIDA<br>DEPARTMENT OF TRANSPORTATION |           |                      | SHEET<br>NO. |
|-----------|-------------|------|-------------|---------------------------------------------------------------------------------------------------------------------------|--|--------------------------------------------------|-----------|----------------------|--------------|
| DATE      | DESCRIPTION | DATE | DESCRIPTION | STEPHEN J. PARK, P.E.<br>LICENSE NUMBER: 77656<br>RS&H, INC.<br>10748 DEERWOOD PARK BLVD. SOUTH<br>JACKSONVILLE, FL 32256 |  | ROAD NO.                                         | COUNTY    | FINANCIAL PROJECT ID |              |
|           |             |      |             |                                                                                                                           |  | SR 16                                            | ST. JOHNS | 210447-5-52-01       |              |

THE OFFICIAL RECORD OF THIS SHEET IS THE ELECTRONIC FILE DIGITALLY SIGNED AND SEALED UNDER RULE 61G15-23.004, F.A.C.


8/5/2024 4:28:54 PM BeattyM  
c:\pw\_work\sh\_pw\pw\_user\0439575\PLANRD01.dgn

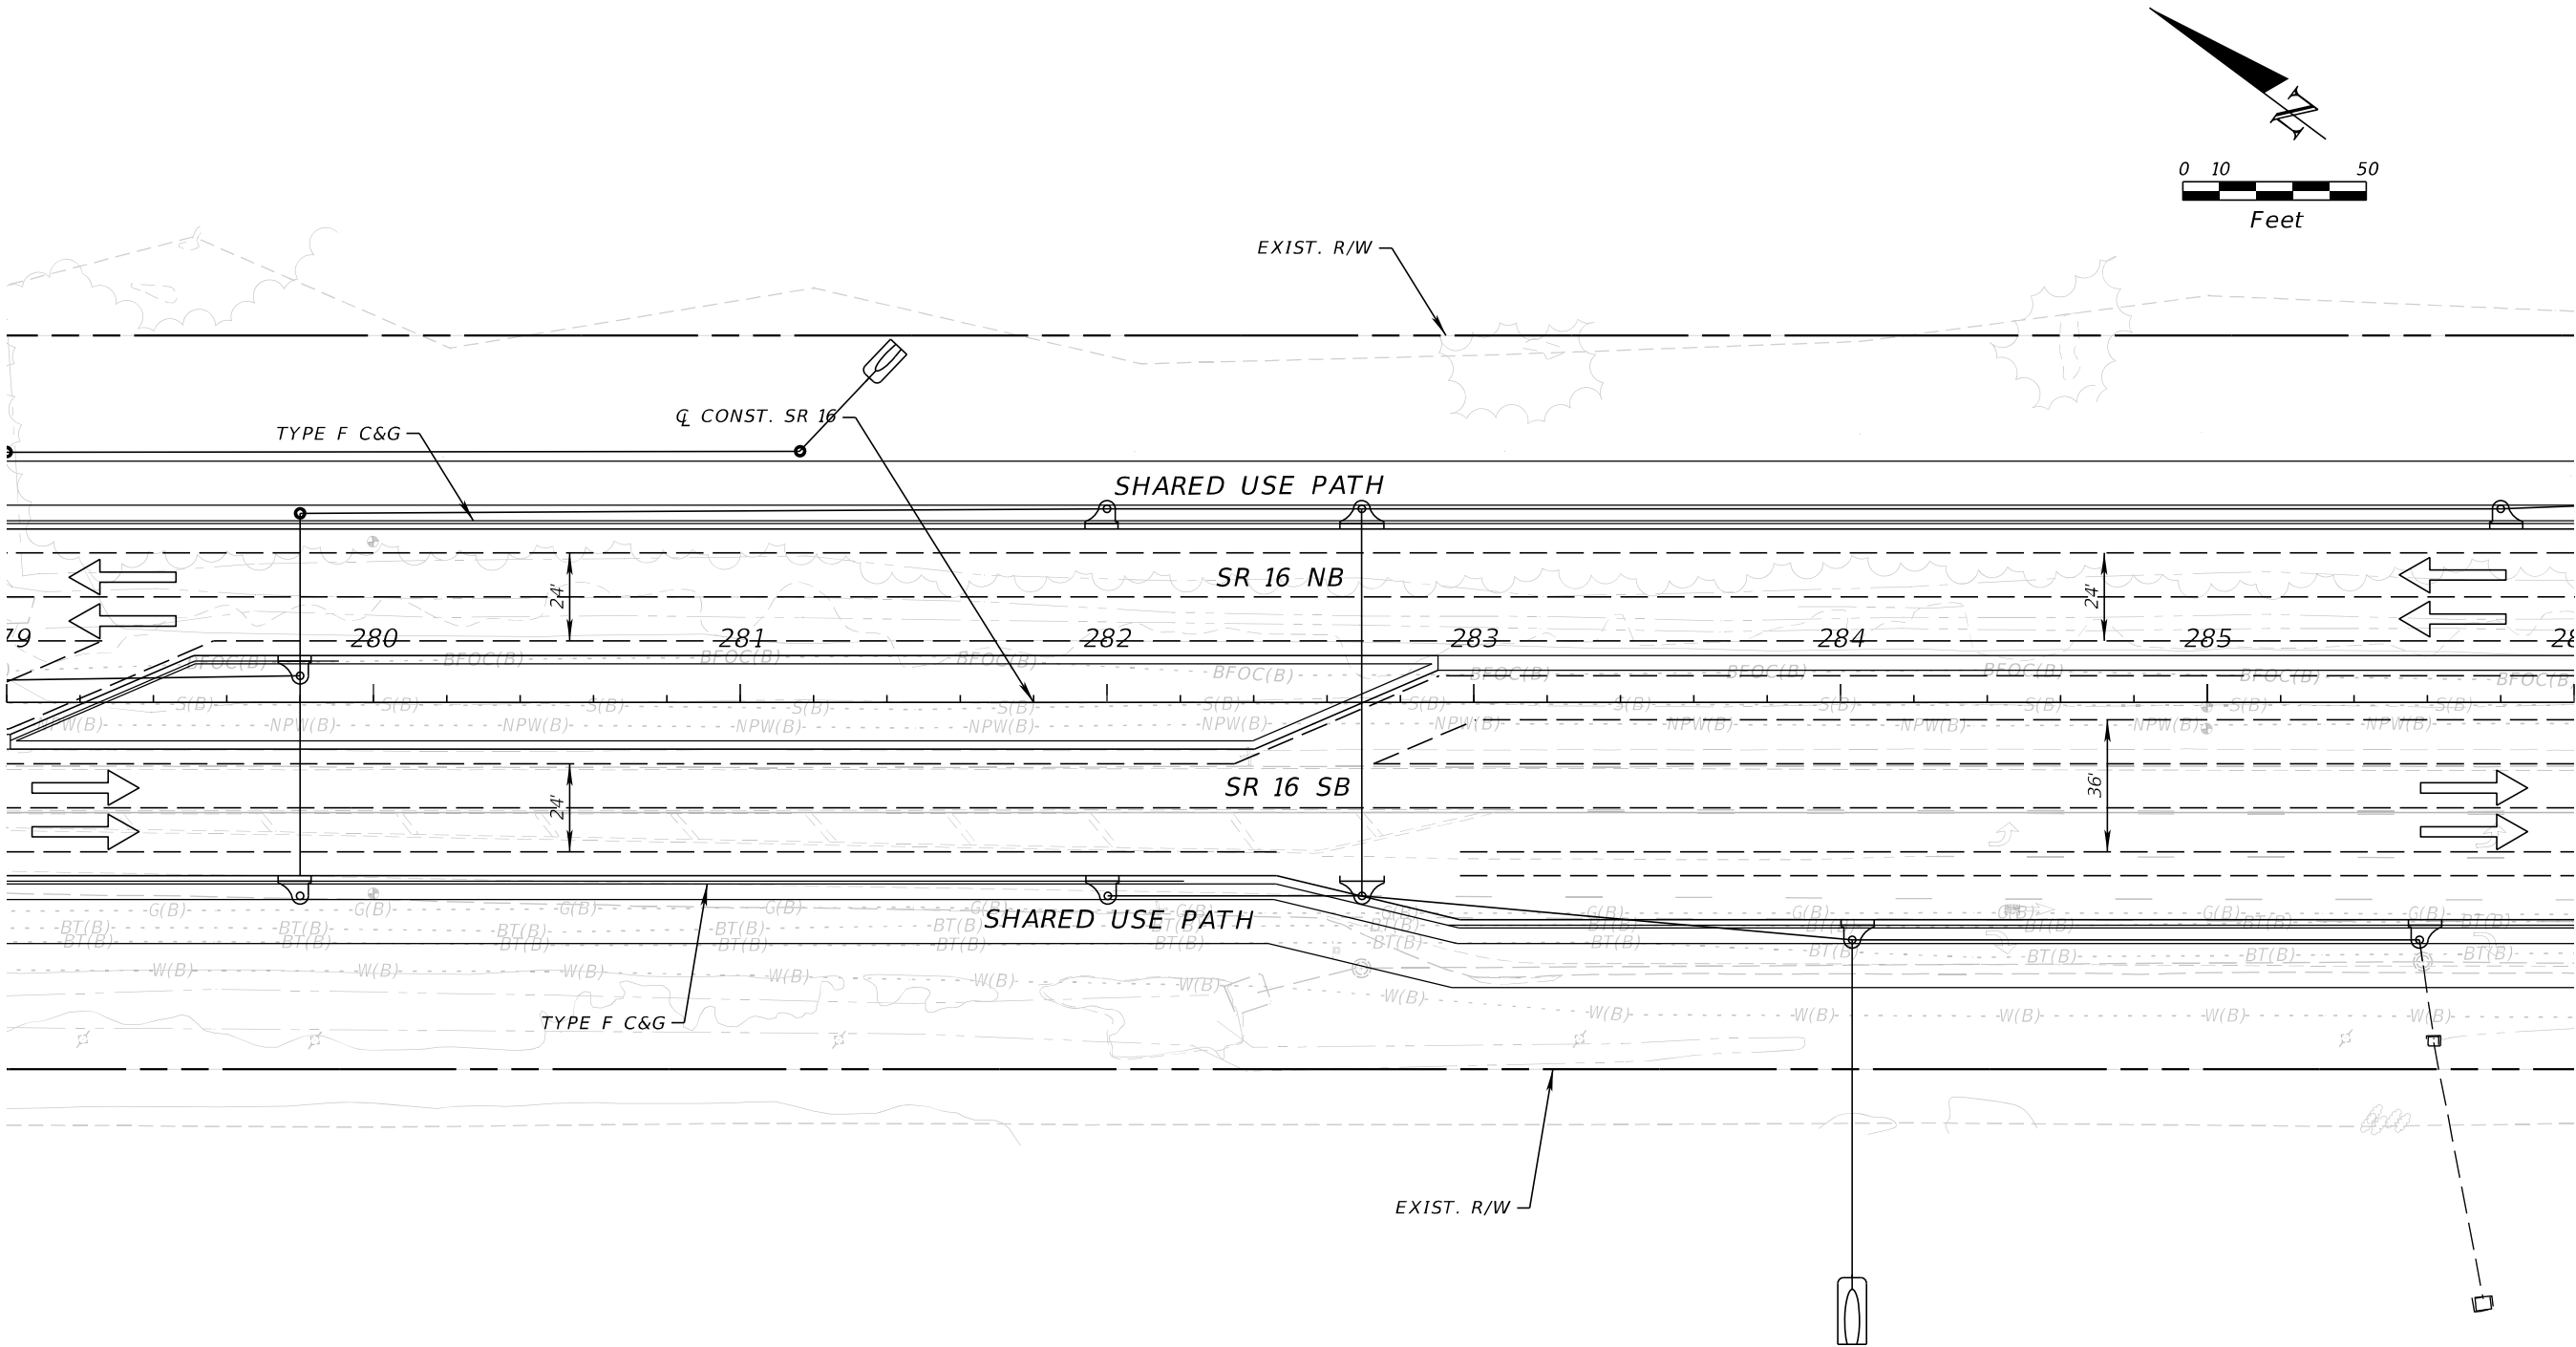

| REVISIONS |             |      |             | ENGINEER OF RECORD                                                                                                        | STATE OF FLORIDA<br>DEPARTMENT OF TRANSPORTATION |           |                      | SHEET<br>NO.          |
|-----------|-------------|------|-------------|---------------------------------------------------------------------------------------------------------------------------|--------------------------------------------------|-----------|----------------------|-----------------------|
| DATE      | DESCRIPTION | DATE | DESCRIPTION |                                                                                                                           | ROAD NO.                                         | COUNTY    | FINANCIAL PROJECT ID |                       |
|           |             |      |             | STEPHEN J. PARK, P.E.<br>LICENSE NUMBER: 77656<br>RS&H, INC.<br>10748 DEERWOOD PARK BLVD. SOUTH<br>JACKSONVILLE, FL 32256 | SR 16                                            | ST. JOHNS | 210447-5-52-01       | 11x17<br>Plan<br>Only |

THE OFFICIAL RECORD OF THIS SHEET IS THE ELECTRONIC FILE DIGITALLY SIGNED AND SEALED UNDER RULE 61G15-23.004, F.A.C.


8/5/2024 4:28:55 PM BeattyM  
c:\pw\_work\ysh\_pw\pw\_user\0439575\PLAINRD01.dgn

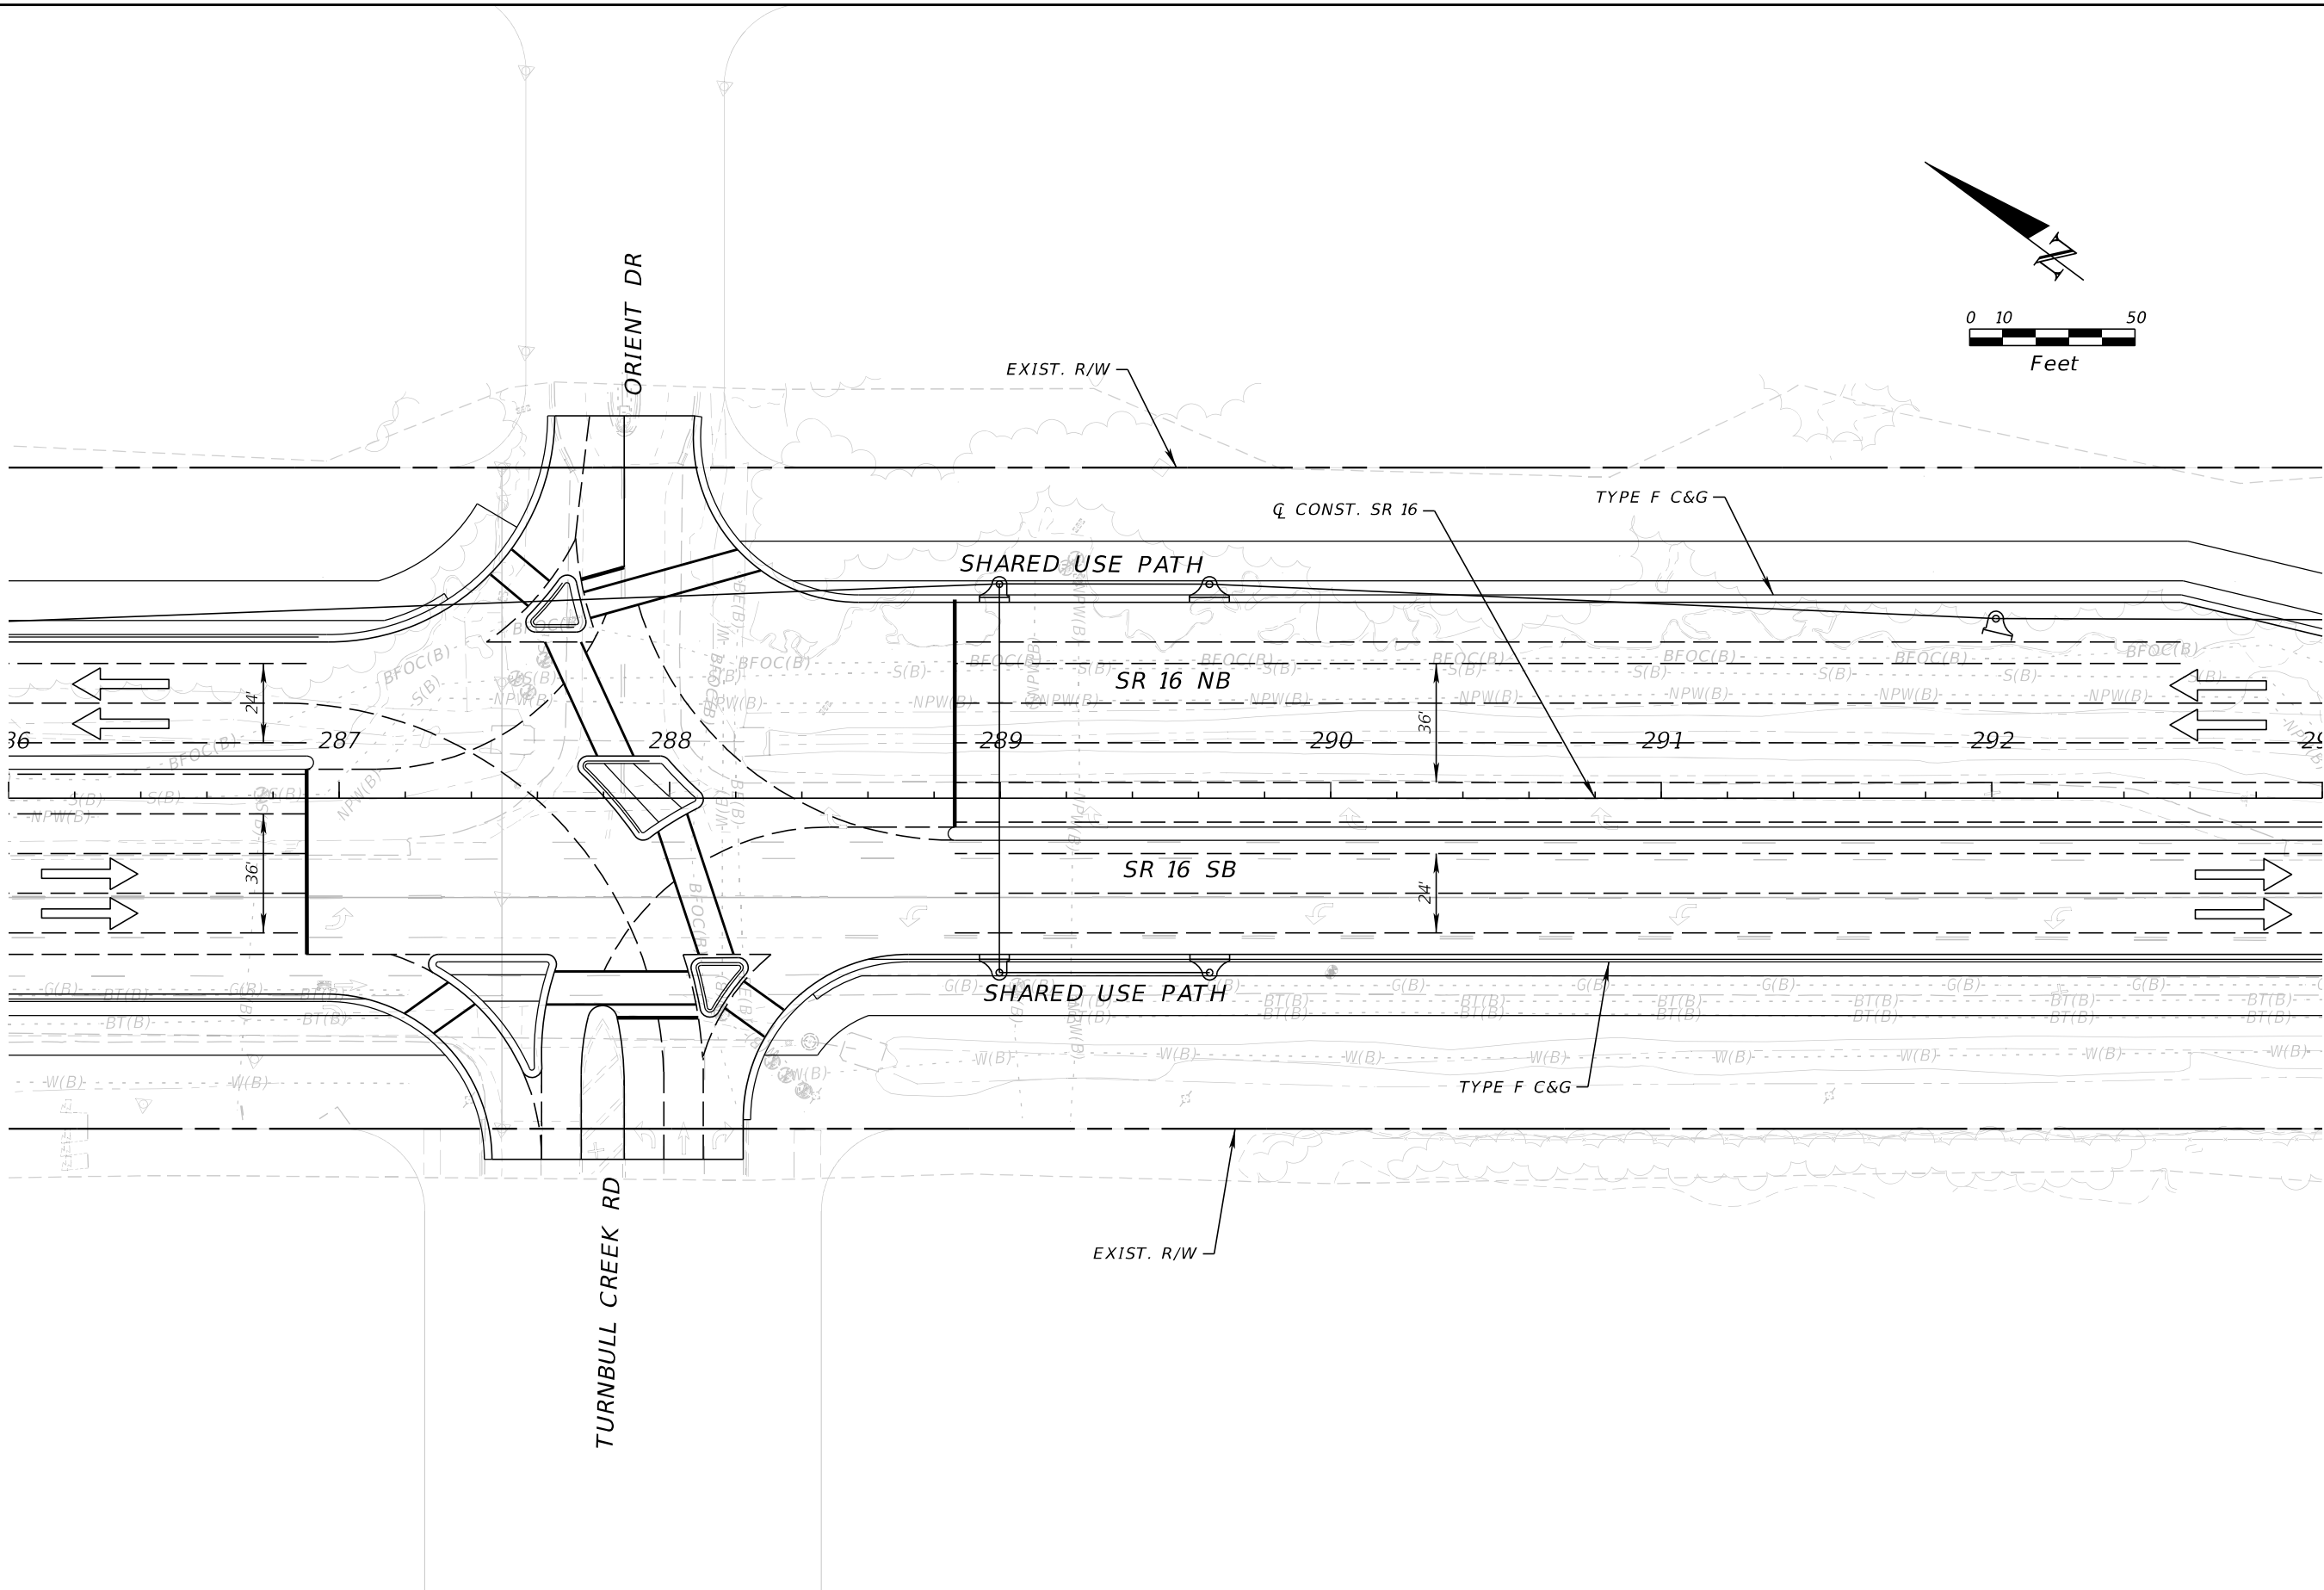

| REVISIONS |             |      |             | ENGINEER OF RECORD                                                                                                        | STATE OF FLORIDA<br>DEPARTMENT OF TRANSPORTATION |           |                      | SHEET<br>NO.          |
|-----------|-------------|------|-------------|---------------------------------------------------------------------------------------------------------------------------|--------------------------------------------------|-----------|----------------------|-----------------------|
| DATE      | DESCRIPTION | DATE | DESCRIPTION |                                                                                                                           | ROAD NO.                                         | COUNTY    | FINANCIAL PROJECT ID |                       |
|           |             |      |             |                                                                                                                           | SR 16                                            | ST. JOHNS | 210447-5-52-01       |                       |
|           |             |      |             | STEPHEN J. PARK, P.E.<br>LICENSE NUMBER: 77656<br>RS&H, INC.<br>10748 DEERWOOD PARK BLVD. SOUTH<br>JACKSONVILLE, FL 32256 |                                                  |           |                      | 11x17<br>Plan<br>Only |

THE OFFICIAL RECORD OF THIS SHEET IS THE ELECTRONIC FILE DIGITALLY SIGNED AND SEALED UNDER RULE 61G15-23.004, F.A.C.

8/5/2024 4:28:55 PM BeattyM  
c:\pw\_work\ysh\_pw\pw\_user\00439575\PLANRD01.dgn

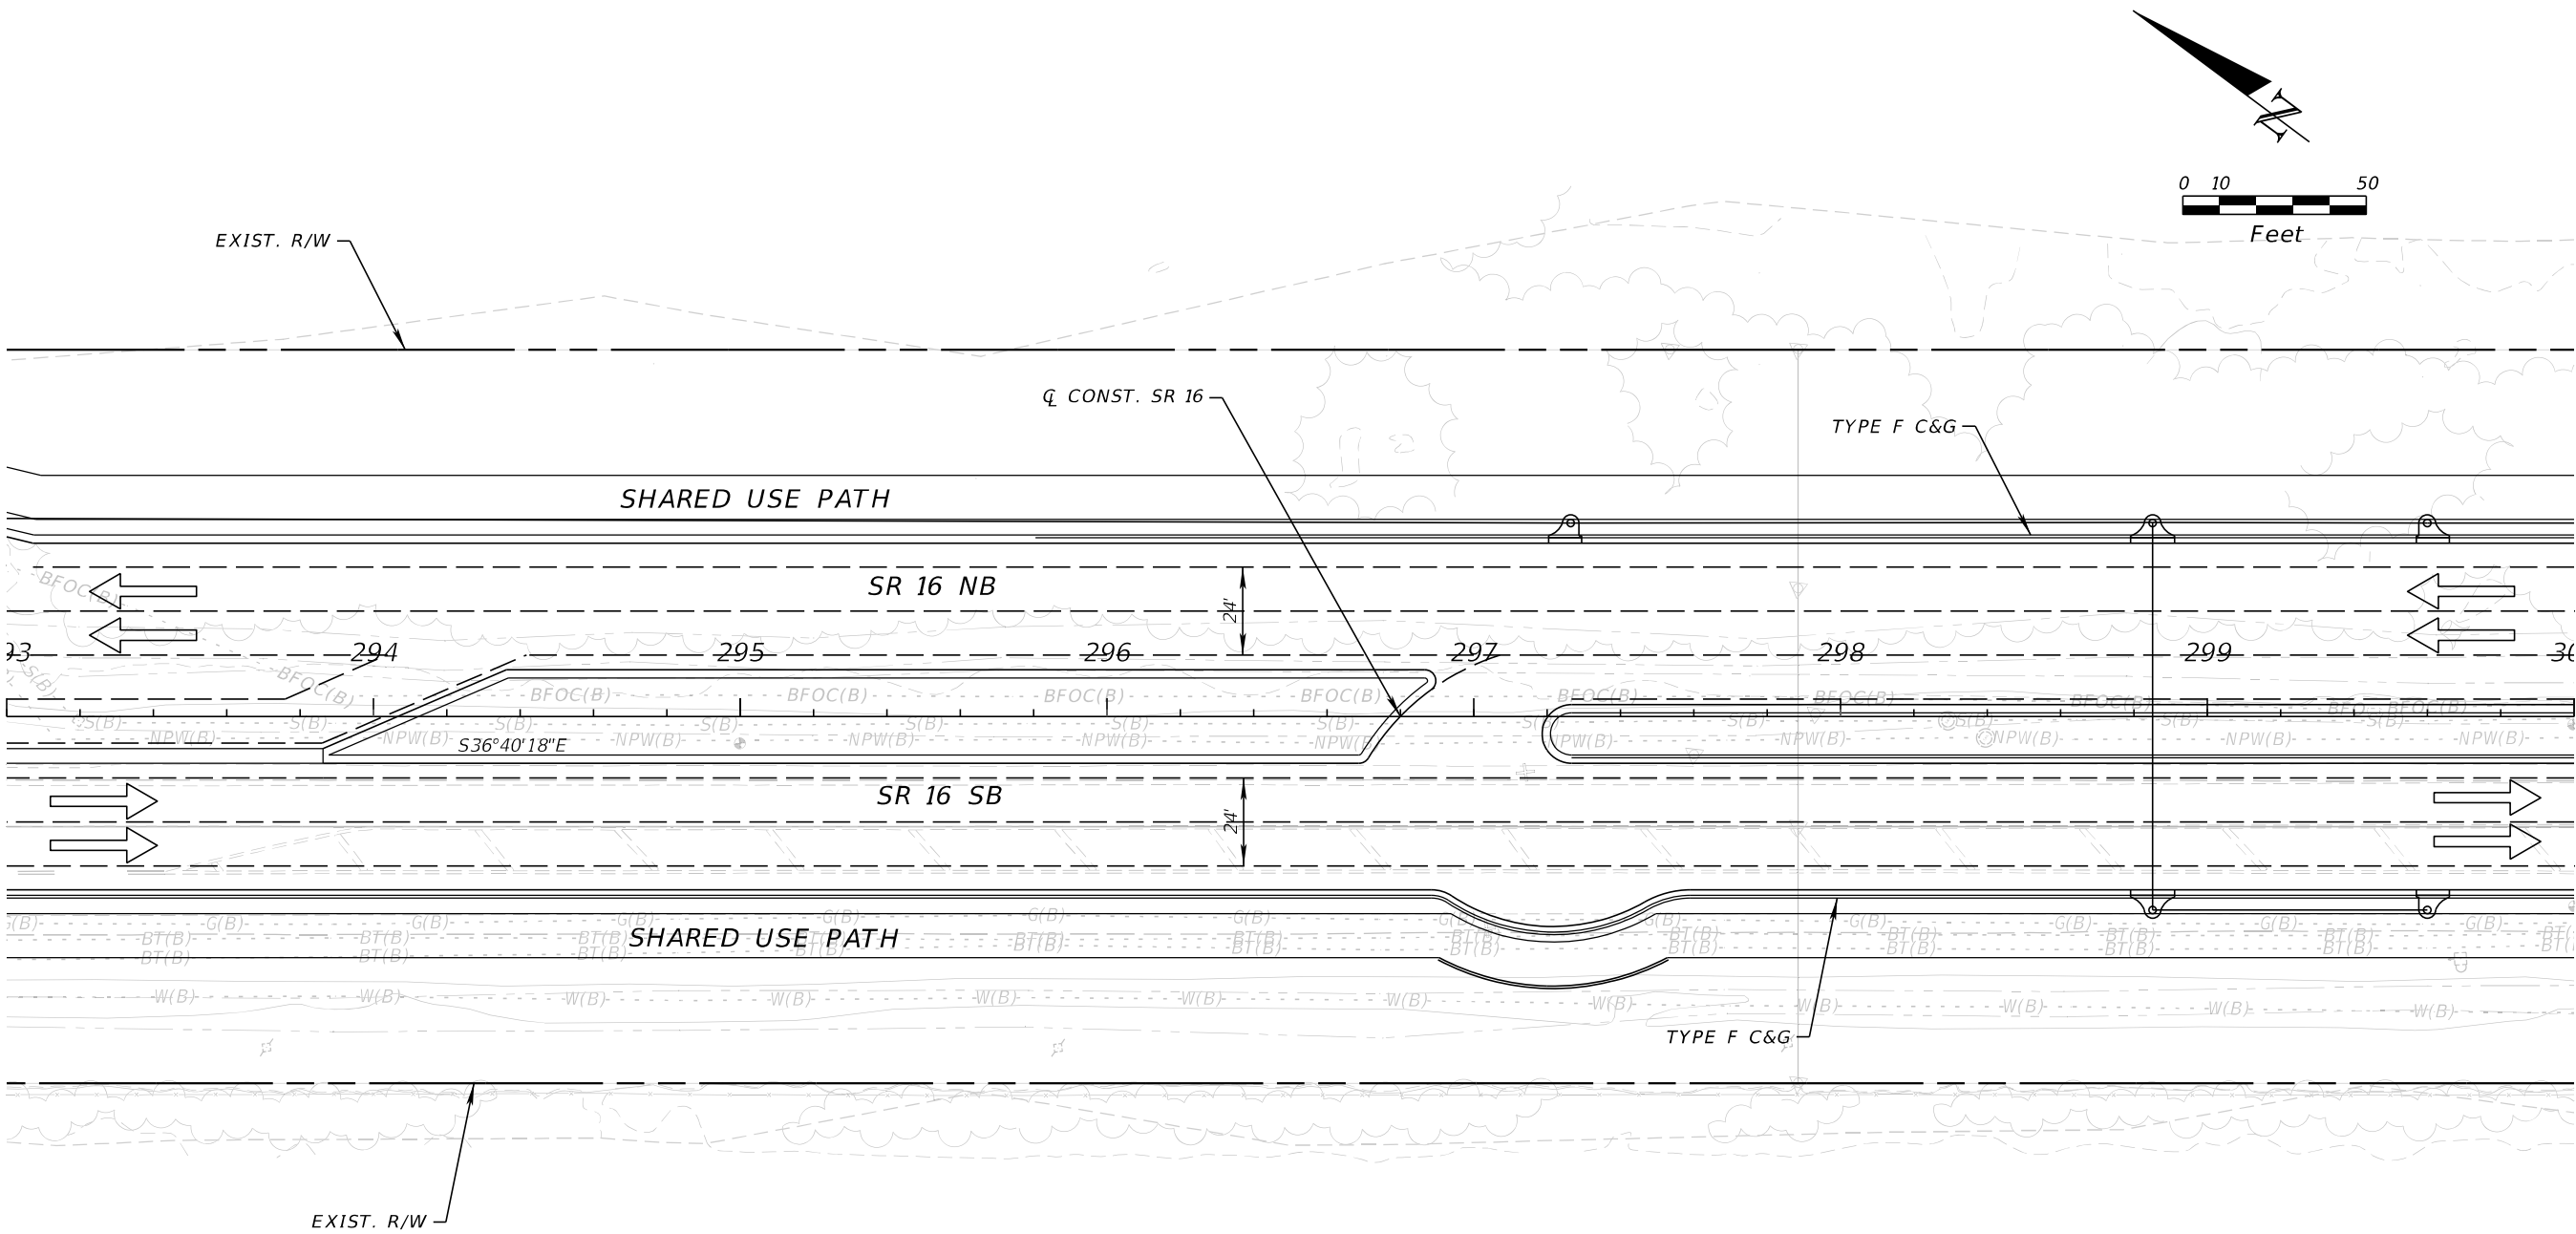


| REVISIONS |             |      |             | ENGINEER OF RECORD                                                                                                        | STATE OF FLORIDA<br>DEPARTMENT OF TRANSPORTATION |           |                      | SHEET<br>NO.          |
|-----------|-------------|------|-------------|---------------------------------------------------------------------------------------------------------------------------|--------------------------------------------------|-----------|----------------------|-----------------------|
| DATE      | DESCRIPTION | DATE | DESCRIPTION |                                                                                                                           | ROAD NO.                                         | COUNTY    | FINANCIAL PROJECT ID |                       |
|           |             |      |             |                                                                                                                           | SR 16                                            | ST. JOHNS | 210447-5-52-01       |                       |
|           |             |      |             | STEPHEN J. PARK, P.E.<br>LICENSE NUMBER: 77656<br>RS&H, INC.<br>10748 DEERWOOD PARK BLVD. SOUTH<br>JACKSONVILLE, FL 32256 |                                                  |           |                      | 11x17<br>Plan<br>Only |

THE OFFICIAL RECORD OF THIS SHEET IS THE ELECTRONIC FILE DIGITALLY SIGNED AND SEALED UNDER RULE 61G15-23.004, F.A.C.




8/5/2024 4:28:56 PM BeattyM  
c:\pw\_work\sh\_pw\pw\_user\0439575\PLANRD01.dgn

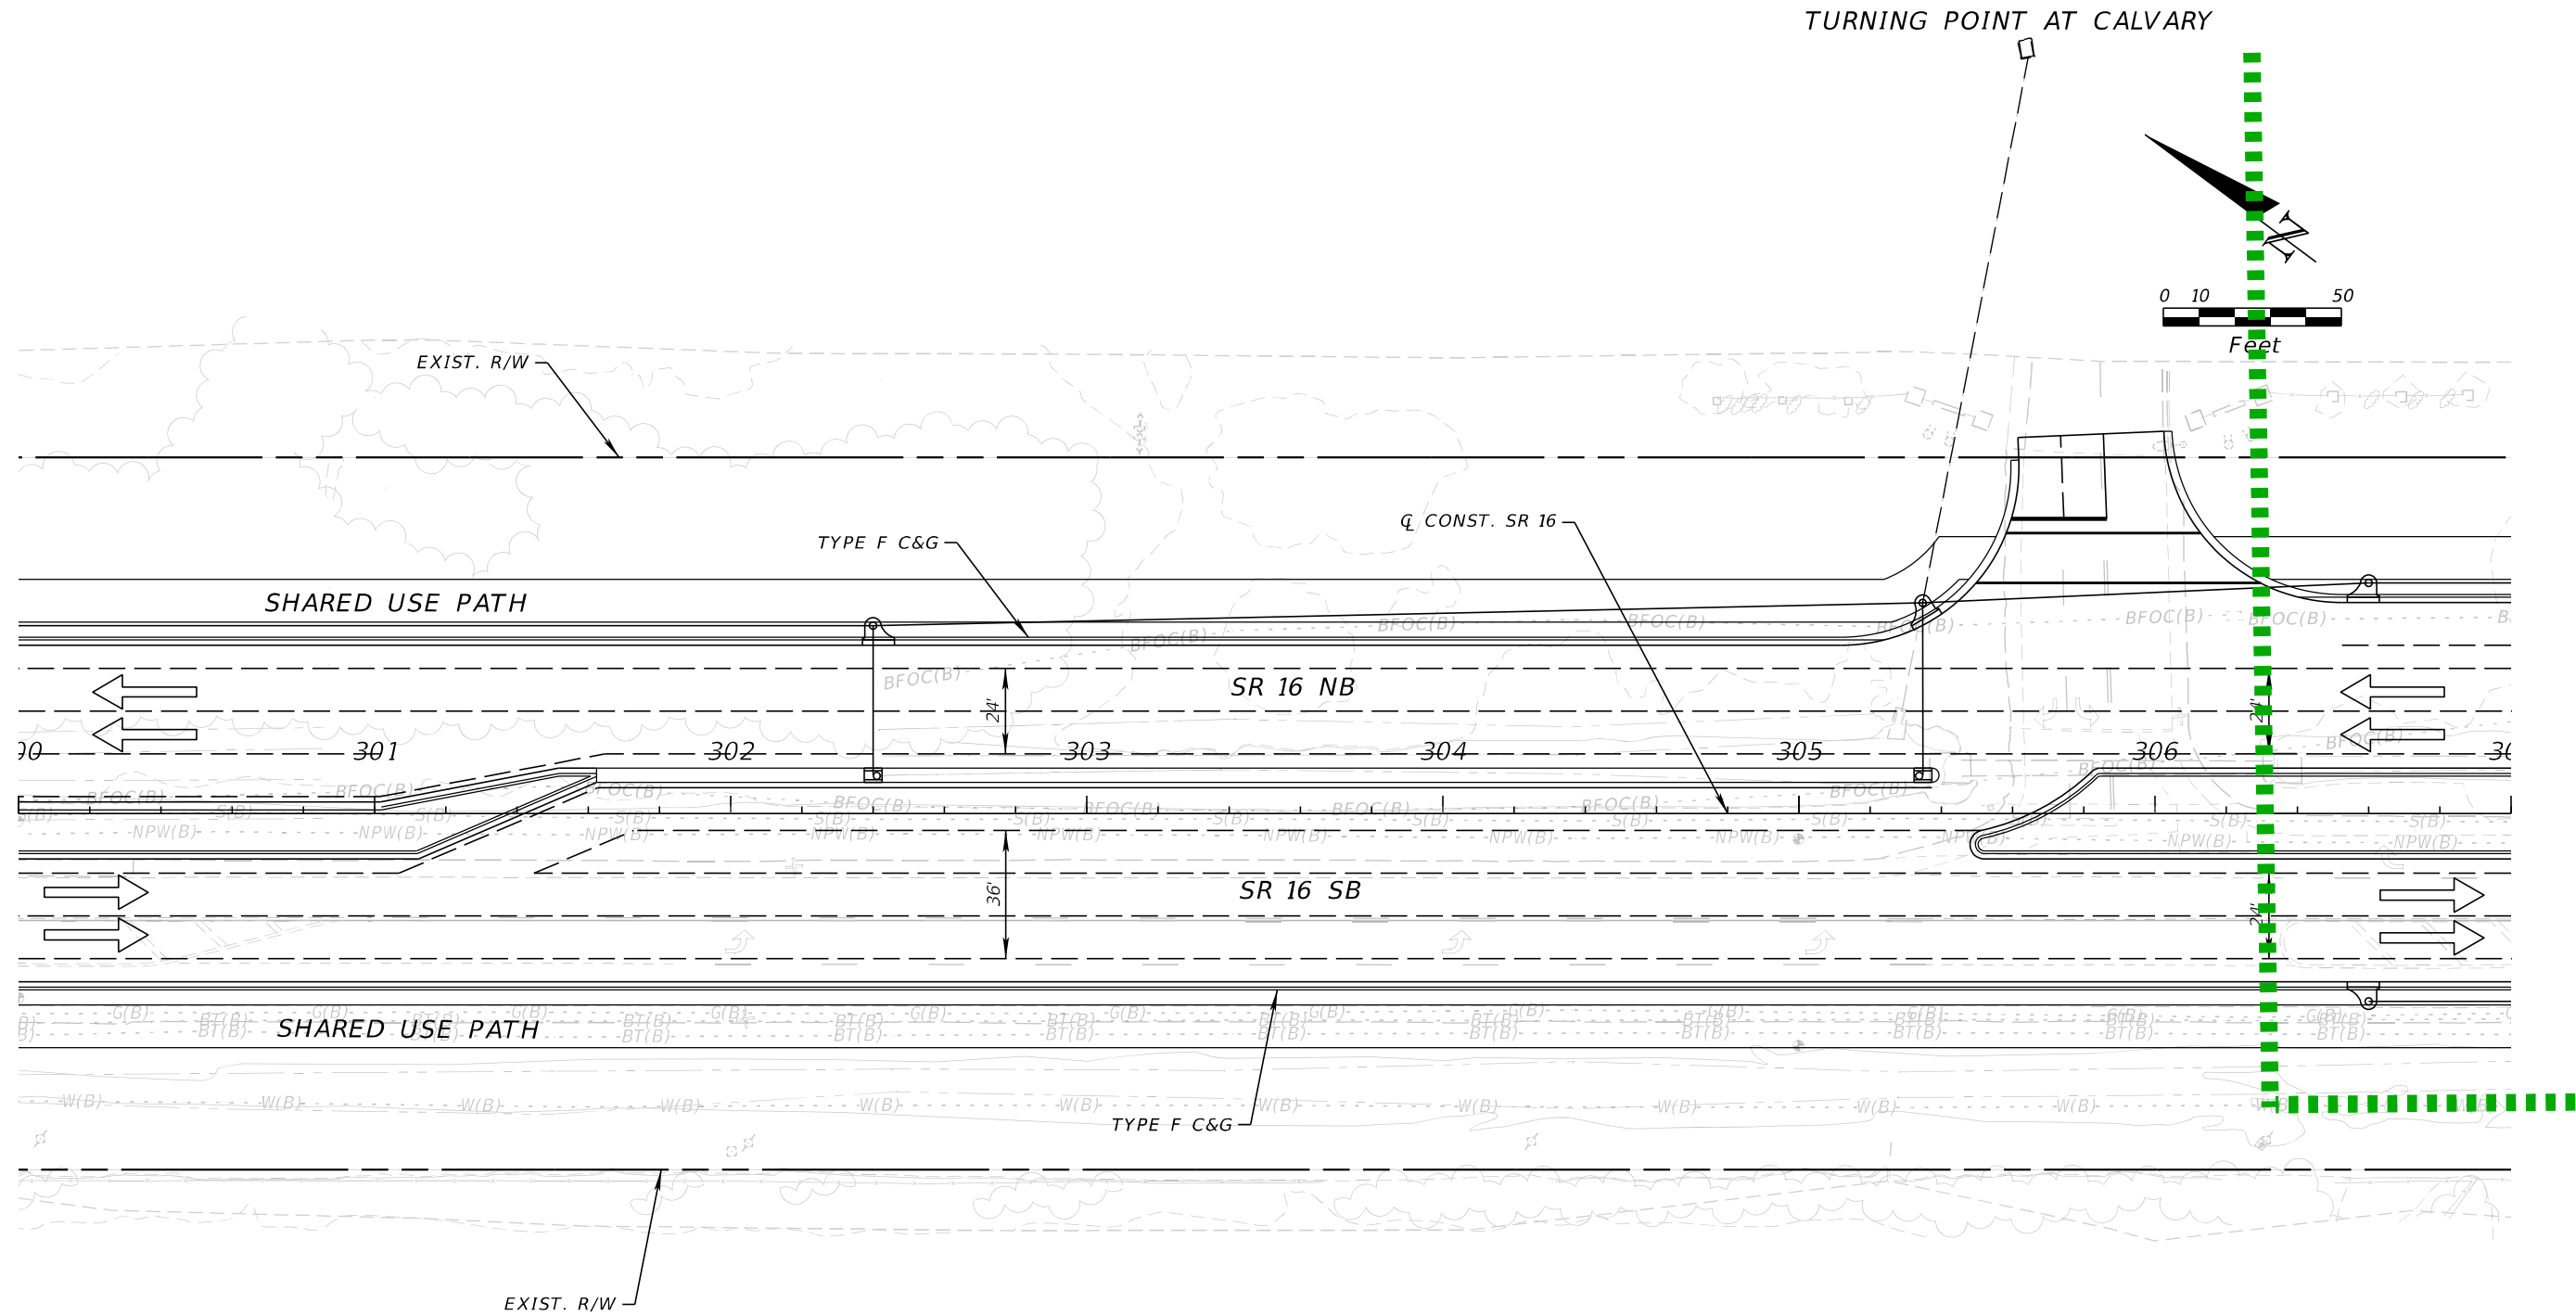

| REVISIONS |             |      |             | ENGINEER OF RECORD                                                                                                        |  | STATE OF FLORIDA<br>DEPARTMENT OF TRANSPORTATION |           |                      | SHEET<br>NO. |
|-----------|-------------|------|-------------|---------------------------------------------------------------------------------------------------------------------------|--|--------------------------------------------------|-----------|----------------------|--------------|
| DATE      | DESCRIPTION | DATE | DESCRIPTION | STEPHEN J. PARK, P.E.<br>LICENSE NUMBER: 77656<br>RS&H, INC.<br>10748 DEERWOOD PARK BLVD. SOUTH<br>JACKSONVILLE, FL 32256 |  | ROAD NO.                                         | COUNTY    | FINANCIAL PROJECT ID |              |
|           |             |      |             |                                                                                                                           |  | SR 16                                            | ST. JOHNS | 210447-5-52-01       |              |

THE OFFICIAL RECORD OF THIS SHEET IS THE ELECTRONIC FILE DIGITALLY SIGNED AND SEALED UNDER RULE 61G15-23.004, F.A.C.


8/5/2024 4:28:57 PM BeattyM  
c:\pw\_work\sh\_pw\pw\_user\0439575\PLANRD01.dgn

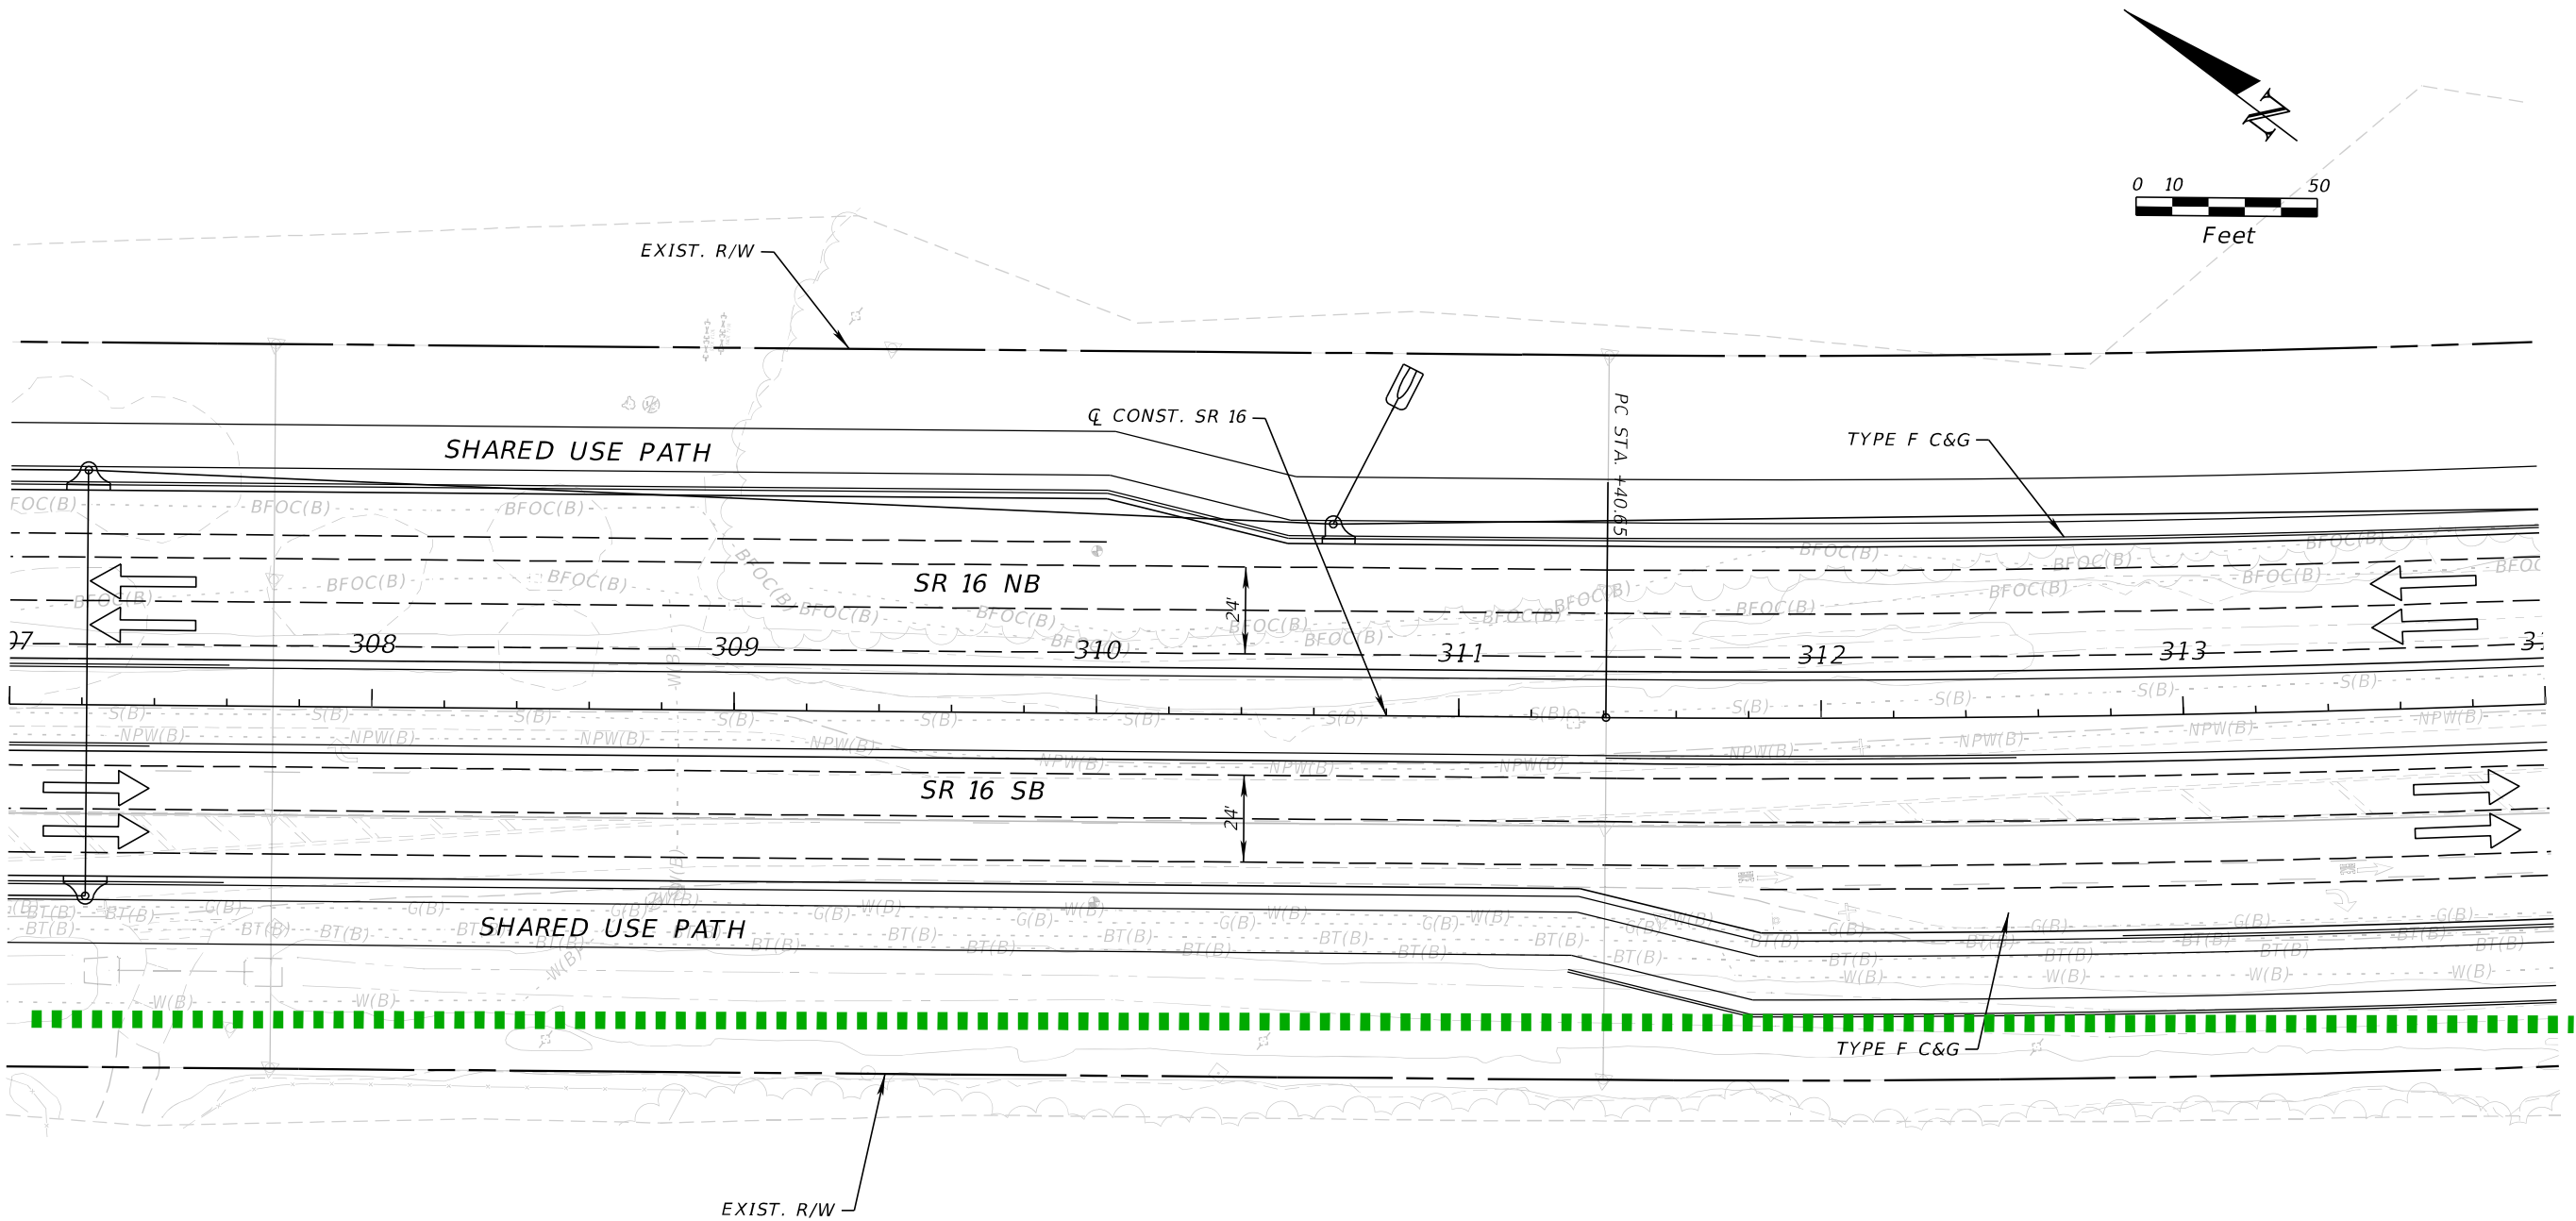

| REVISIONS |             |      |             | ENGINEER OF RECORD                                                                                                        | STATE OF FLORIDA<br>DEPARTMENT OF TRANSPORTATION |           |                      | SHEET<br>NO.          |
|-----------|-------------|------|-------------|---------------------------------------------------------------------------------------------------------------------------|--------------------------------------------------|-----------|----------------------|-----------------------|
| DATE      | DESCRIPTION | DATE | DESCRIPTION | STEPHEN J. PARK, P.E.<br>LICENSE NUMBER: 77656<br>RS&H, INC.<br>10748 DEERWOOD PARK BLVD. SOUTH<br>JACKSONVILLE, FL 32256 | ROAD NO.                                         | COUNTY    | FINANCIAL PROJECT ID |                       |
|           |             |      |             |                                                                                                                           | SR 16                                            | ST. JOHNS | 210447-5-52-01       |                       |
|           |             |      |             |                                                                                                                           |                                                  |           |                      | 11x17<br>Plan<br>Only |

THE OFFICIAL RECORD OF THIS SHEET IS THE ELECTRONIC FILE DIGITALLY SIGNED AND SEALED UNDER RULE 61G15-23.004, F.A.C.



8/5/2024 4:28:57 PM BeattyM  
c:\pw\_work\ysh\_pw\pw\_user\00439575\PLAINRD01.dgn

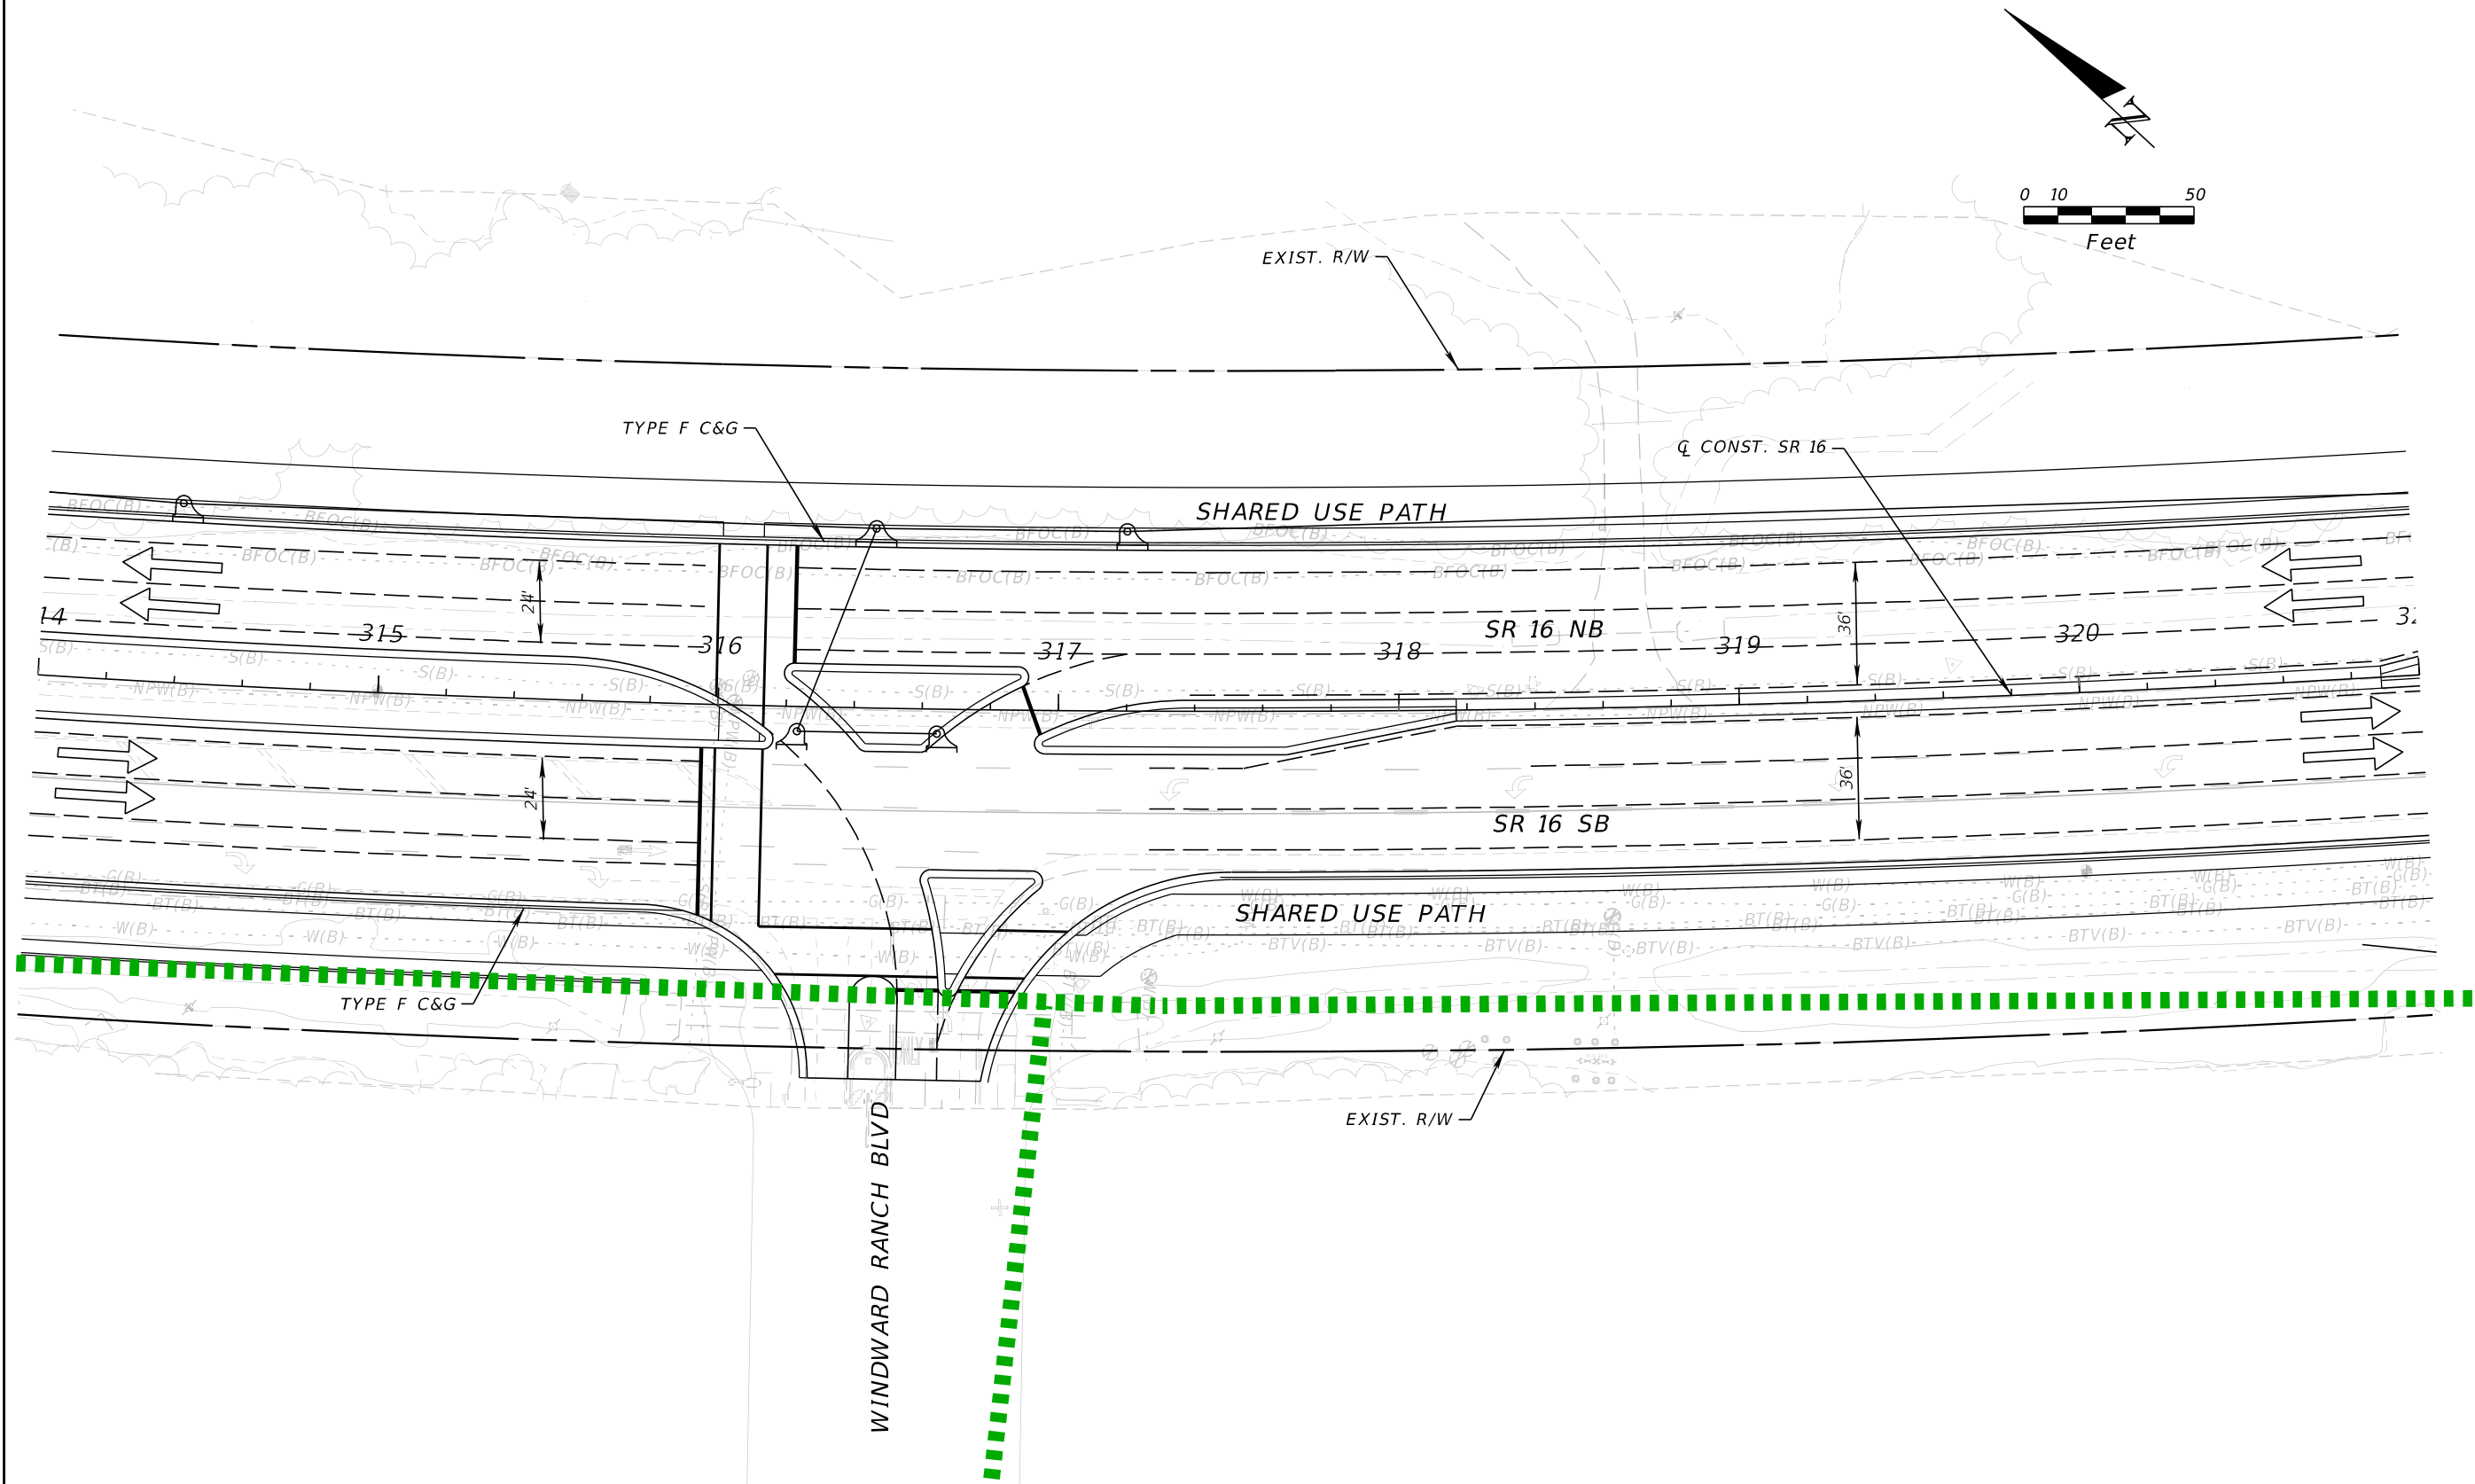

| REVISIONS |             |      |             | ENGINEER OF RECORD                                                                                                        | STATE OF FLORIDA<br>DEPARTMENT OF TRANSPORTATION |           |                      | SHEET<br>NO.          |
|-----------|-------------|------|-------------|---------------------------------------------------------------------------------------------------------------------------|--------------------------------------------------|-----------|----------------------|-----------------------|
| DATE      | DESCRIPTION | DATE | DESCRIPTION |                                                                                                                           | ROAD NO.                                         | COUNTY    | FINANCIAL PROJECT ID |                       |
|           |             |      |             |                                                                                                                           | SR 16                                            | ST. JOHNS | 210447-5-52-01       |                       |
|           |             |      |             | STEPHEN J. PARK, P.E.<br>LICENSE NUMBER: 77656<br>RS&H, INC.<br>10748 DEERWOOD PARK BLVD. SOUTH<br>JACKSONVILLE, FL 32256 |                                                  |           |                      | 11x17<br>Plan<br>Only |

THE OFFICIAL RECORD OF THIS SHEET IS THE ELECTRONIC FILE DIGITALLY SIGNED AND SEALED UNDER RULE 61G15-23.004, F.A.C.

CURVE DATA  
PI STA. = 321+12.24  
Δ = 19°20'48" (LT)  
D = 01°00'19"  
T = 971.59  
L = 1,924.68  
R = 1,924.68  
PC STA. = 311+40.65  
PT STA. = 330+65.33  
e = 0.000

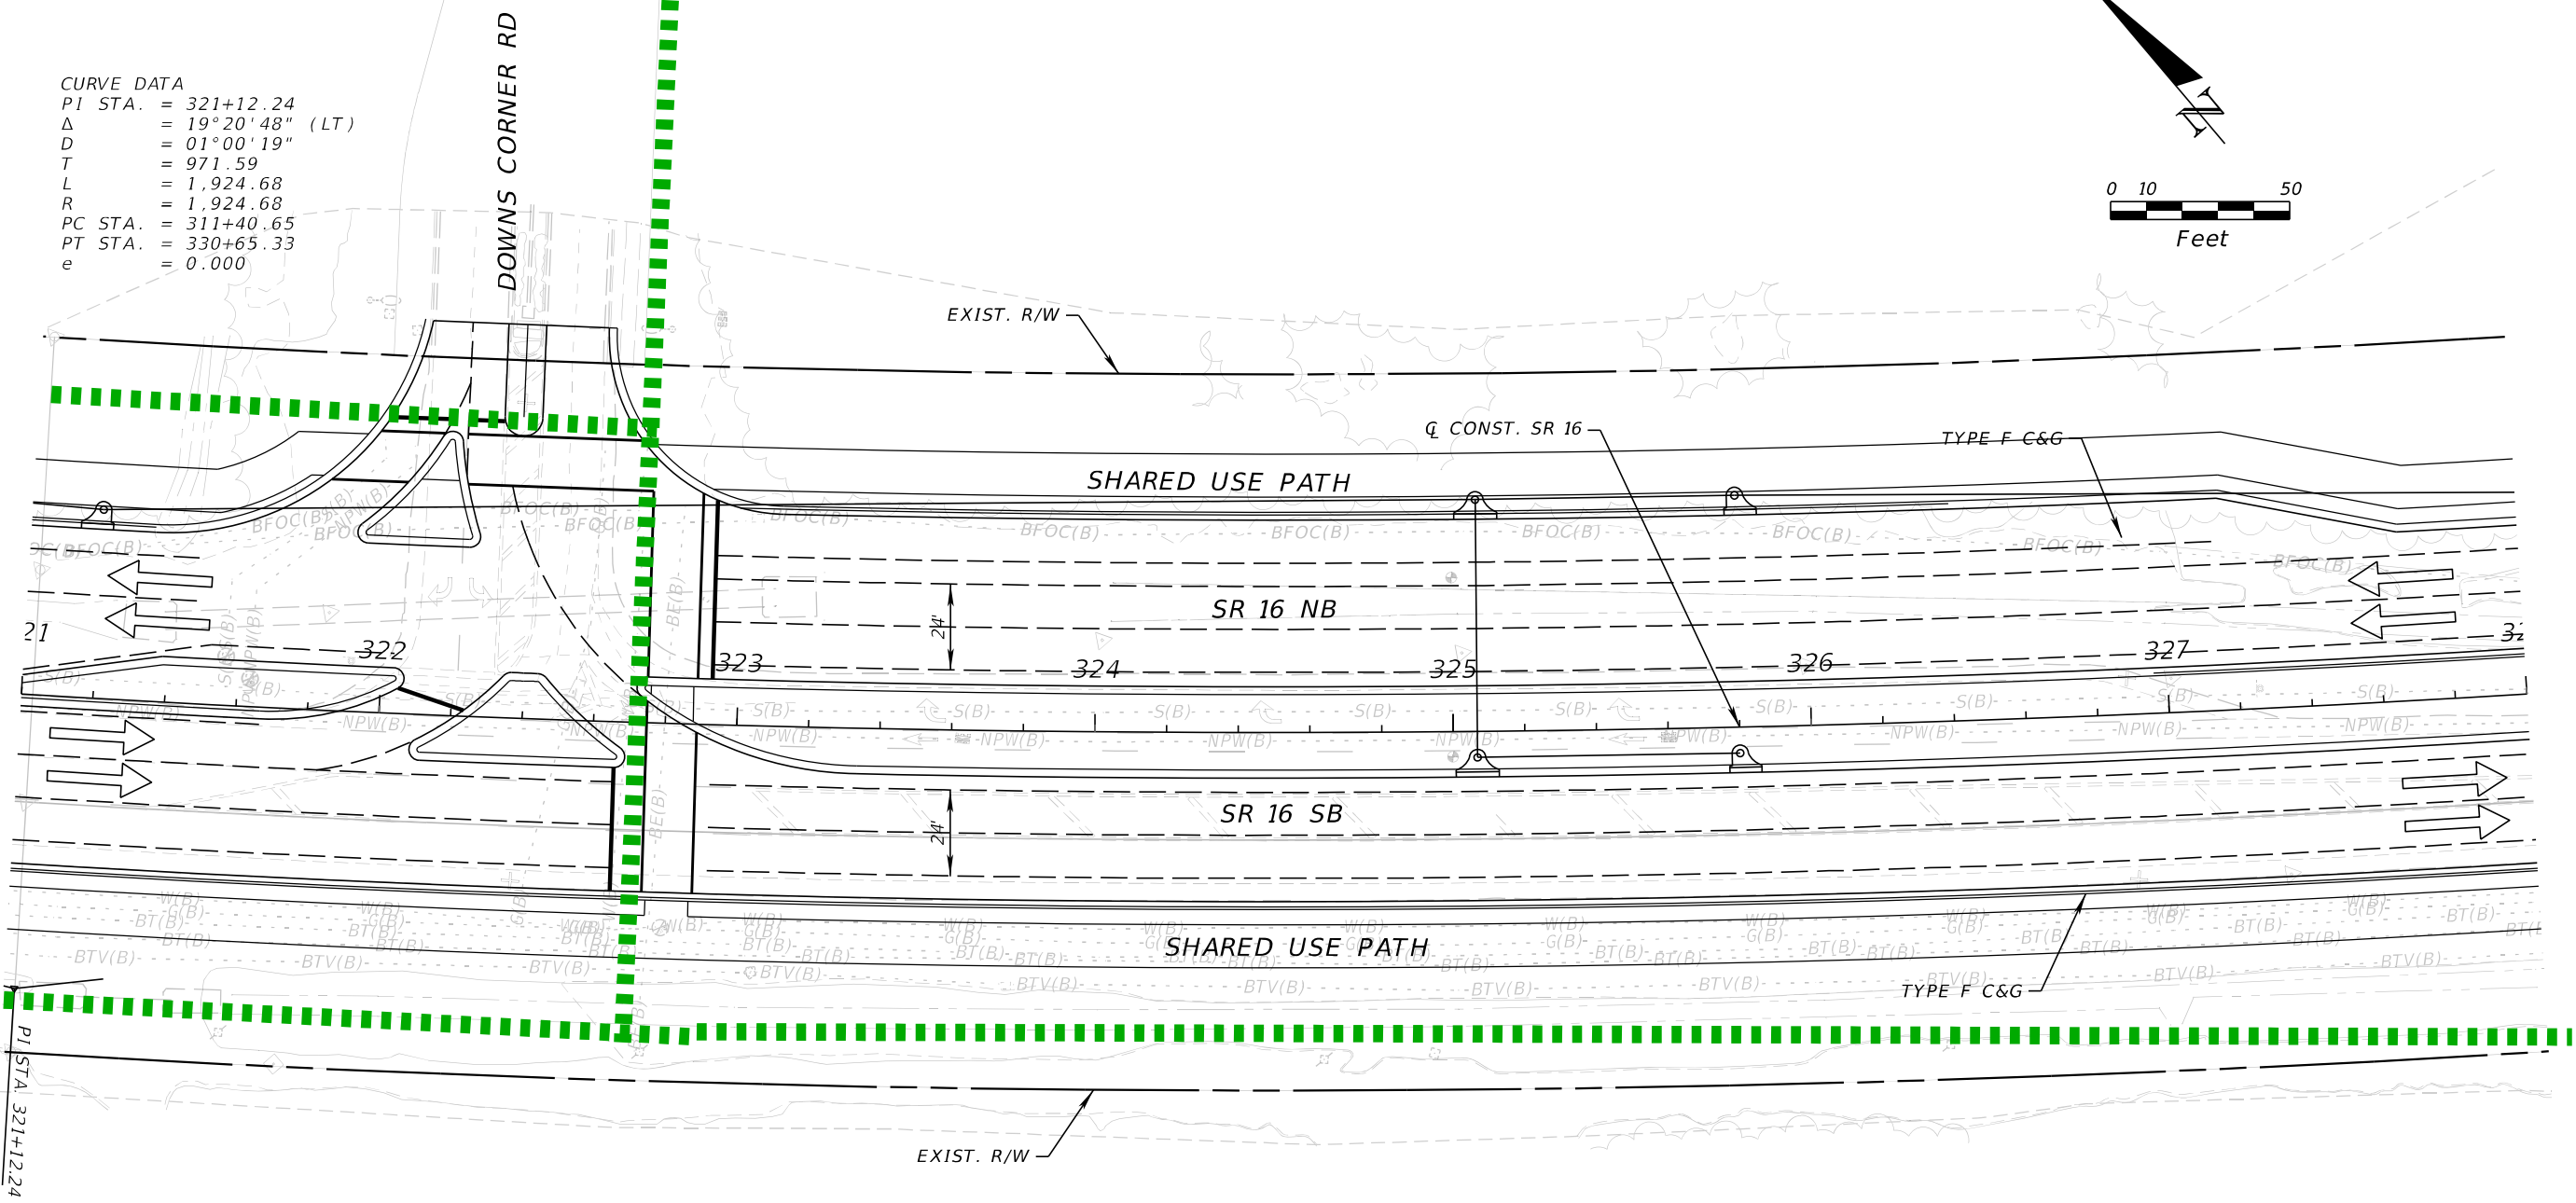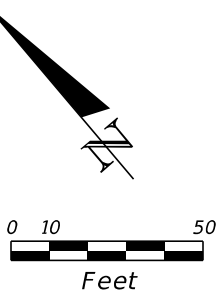

8/5/2024 4:28:58 PM BeattyM  
c:\pw\_work\sh\_pw\pw\_user\0439575\PLAINRD01.dgn


| REVISIONS |             |      |             | ENGINEER OF RECORD                                                                                                        |  | STATE OF FLORIDA<br>DEPARTMENT OF TRANSPORTATION |           |                      | SHEET<br>NO. |
|-----------|-------------|------|-------------|---------------------------------------------------------------------------------------------------------------------------|--|--------------------------------------------------|-----------|----------------------|--------------|
| DATE      | DESCRIPTION | DATE | DESCRIPTION | STEPHEN J. PARK, P.E.<br>LICENSE NUMBER: 77656<br>RS&H, INC.<br>10748 DEERWOOD PARK BLVD. SOUTH<br>JACKSONVILLE, FL 32256 |  | ROAD NO.                                         | COUNTY    | FINANCIAL PROJECT ID |              |
|           |             |      |             |                                                                                                                           |  | SR 16                                            | ST. JOHNS | 210447-5-52-01       |              |

THE OFFICIAL RECORD OF THIS SHEET IS THE ELECTRONIC FILE DIGITALLY SIGNED AND SEALED UNDER RULE 61G15-23.004, F.A.C.





8/5/2024 4:28:59 PM BeattyM  
c:\pw\_work\ysh\_pw\pw\_user\00439575\PLANRD01.dgn

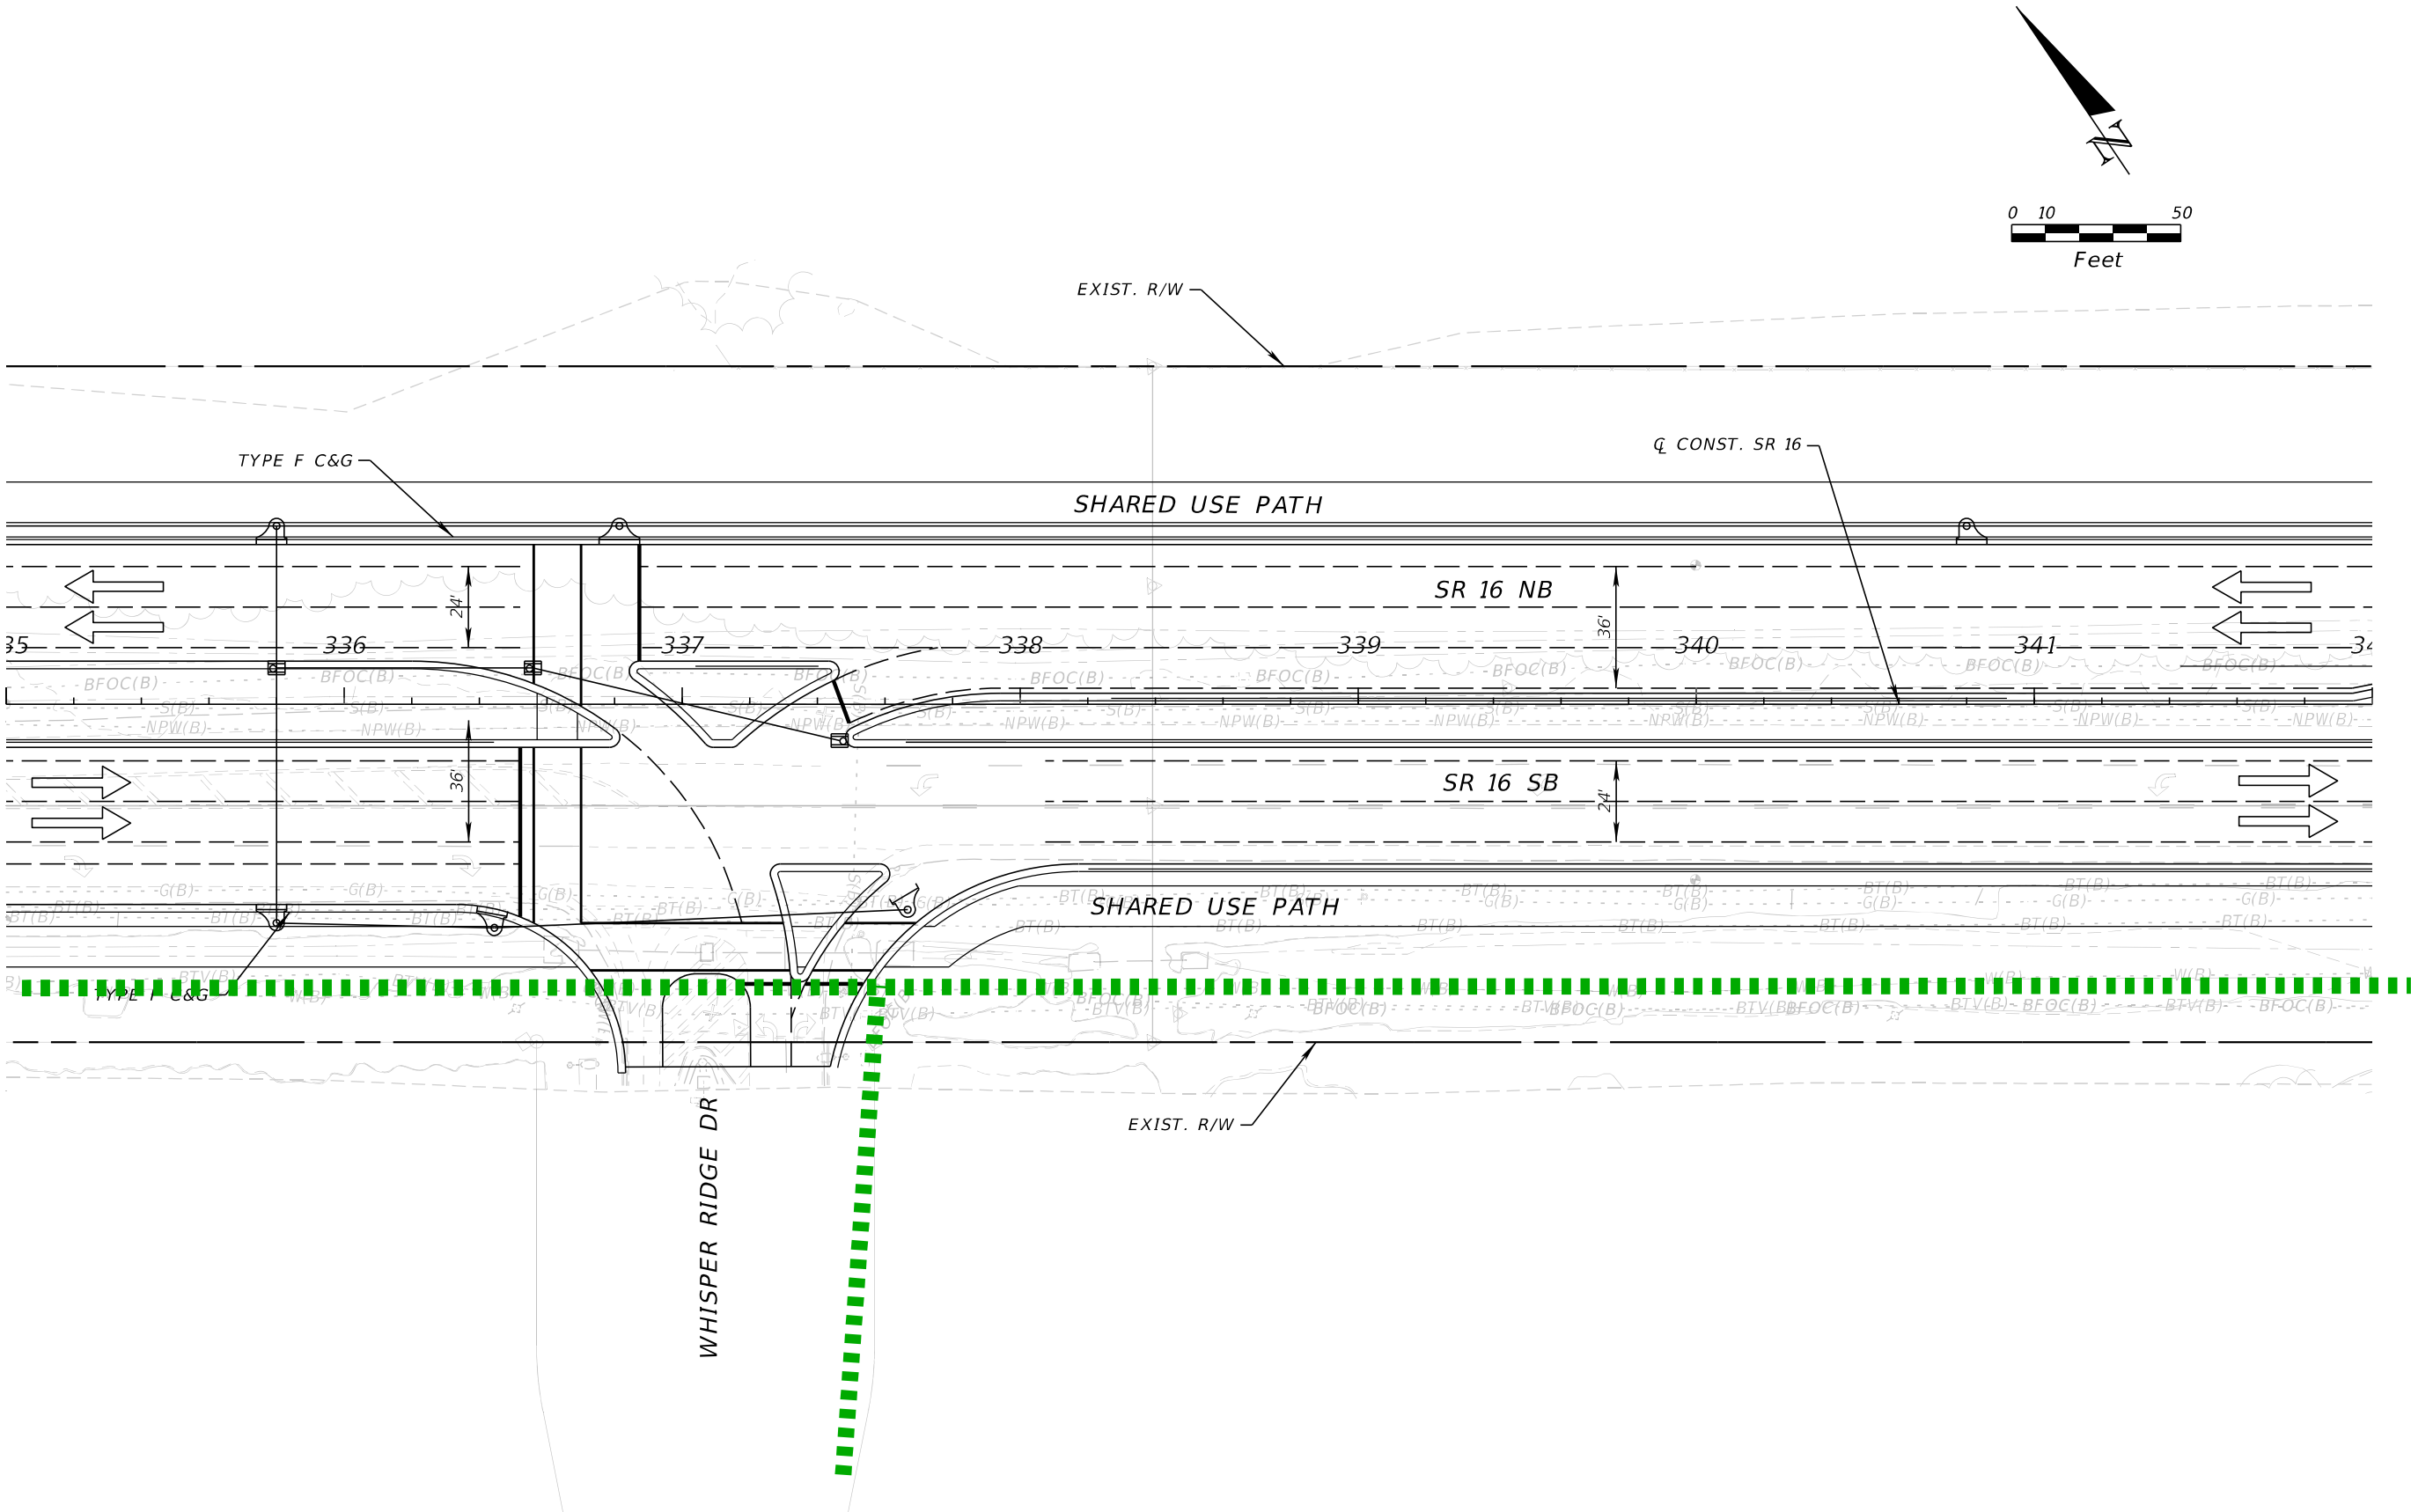

| REVISIONS |             |      |             | ENGINEER OF RECORD | STATE OF FLORIDA<br>DEPARTMENT OF TRANSPORTATION |           |                      | SHEET<br>NO. |
|-----------|-------------|------|-------------|--------------------|--------------------------------------------------|-----------|----------------------|--------------|
| DATE      | DESCRIPTION | DATE | DESCRIPTION |                    | ROAD NO.                                         | COUNTY    | FINANCIAL PROJECT ID |              |
|           |             |      |             |                    | SR 16                                            | ST. JOHNS | 210447-5-52-01       |              |


STEPHEN J. PARK, P.E.  
LICENSE NUMBER: 77656  
RS&H, INC.  
10748 DEERWOOD PARK BLVD. SOUTH  
JACKSONVILLE, FL 32256

11x17  
Plan  
Only

THE OFFICIAL RECORD OF THIS SHEET IS THE ELECTRONIC FILE DIGITALLY SIGNED AND SEALED UNDER RULE 61G15-23.004, F.A.C.





8/5/2024 4:29:00 PM BeattyM  
c:\pw\_work\ysh\_pw\pw\_user\00439575\PLANRD01.dgn

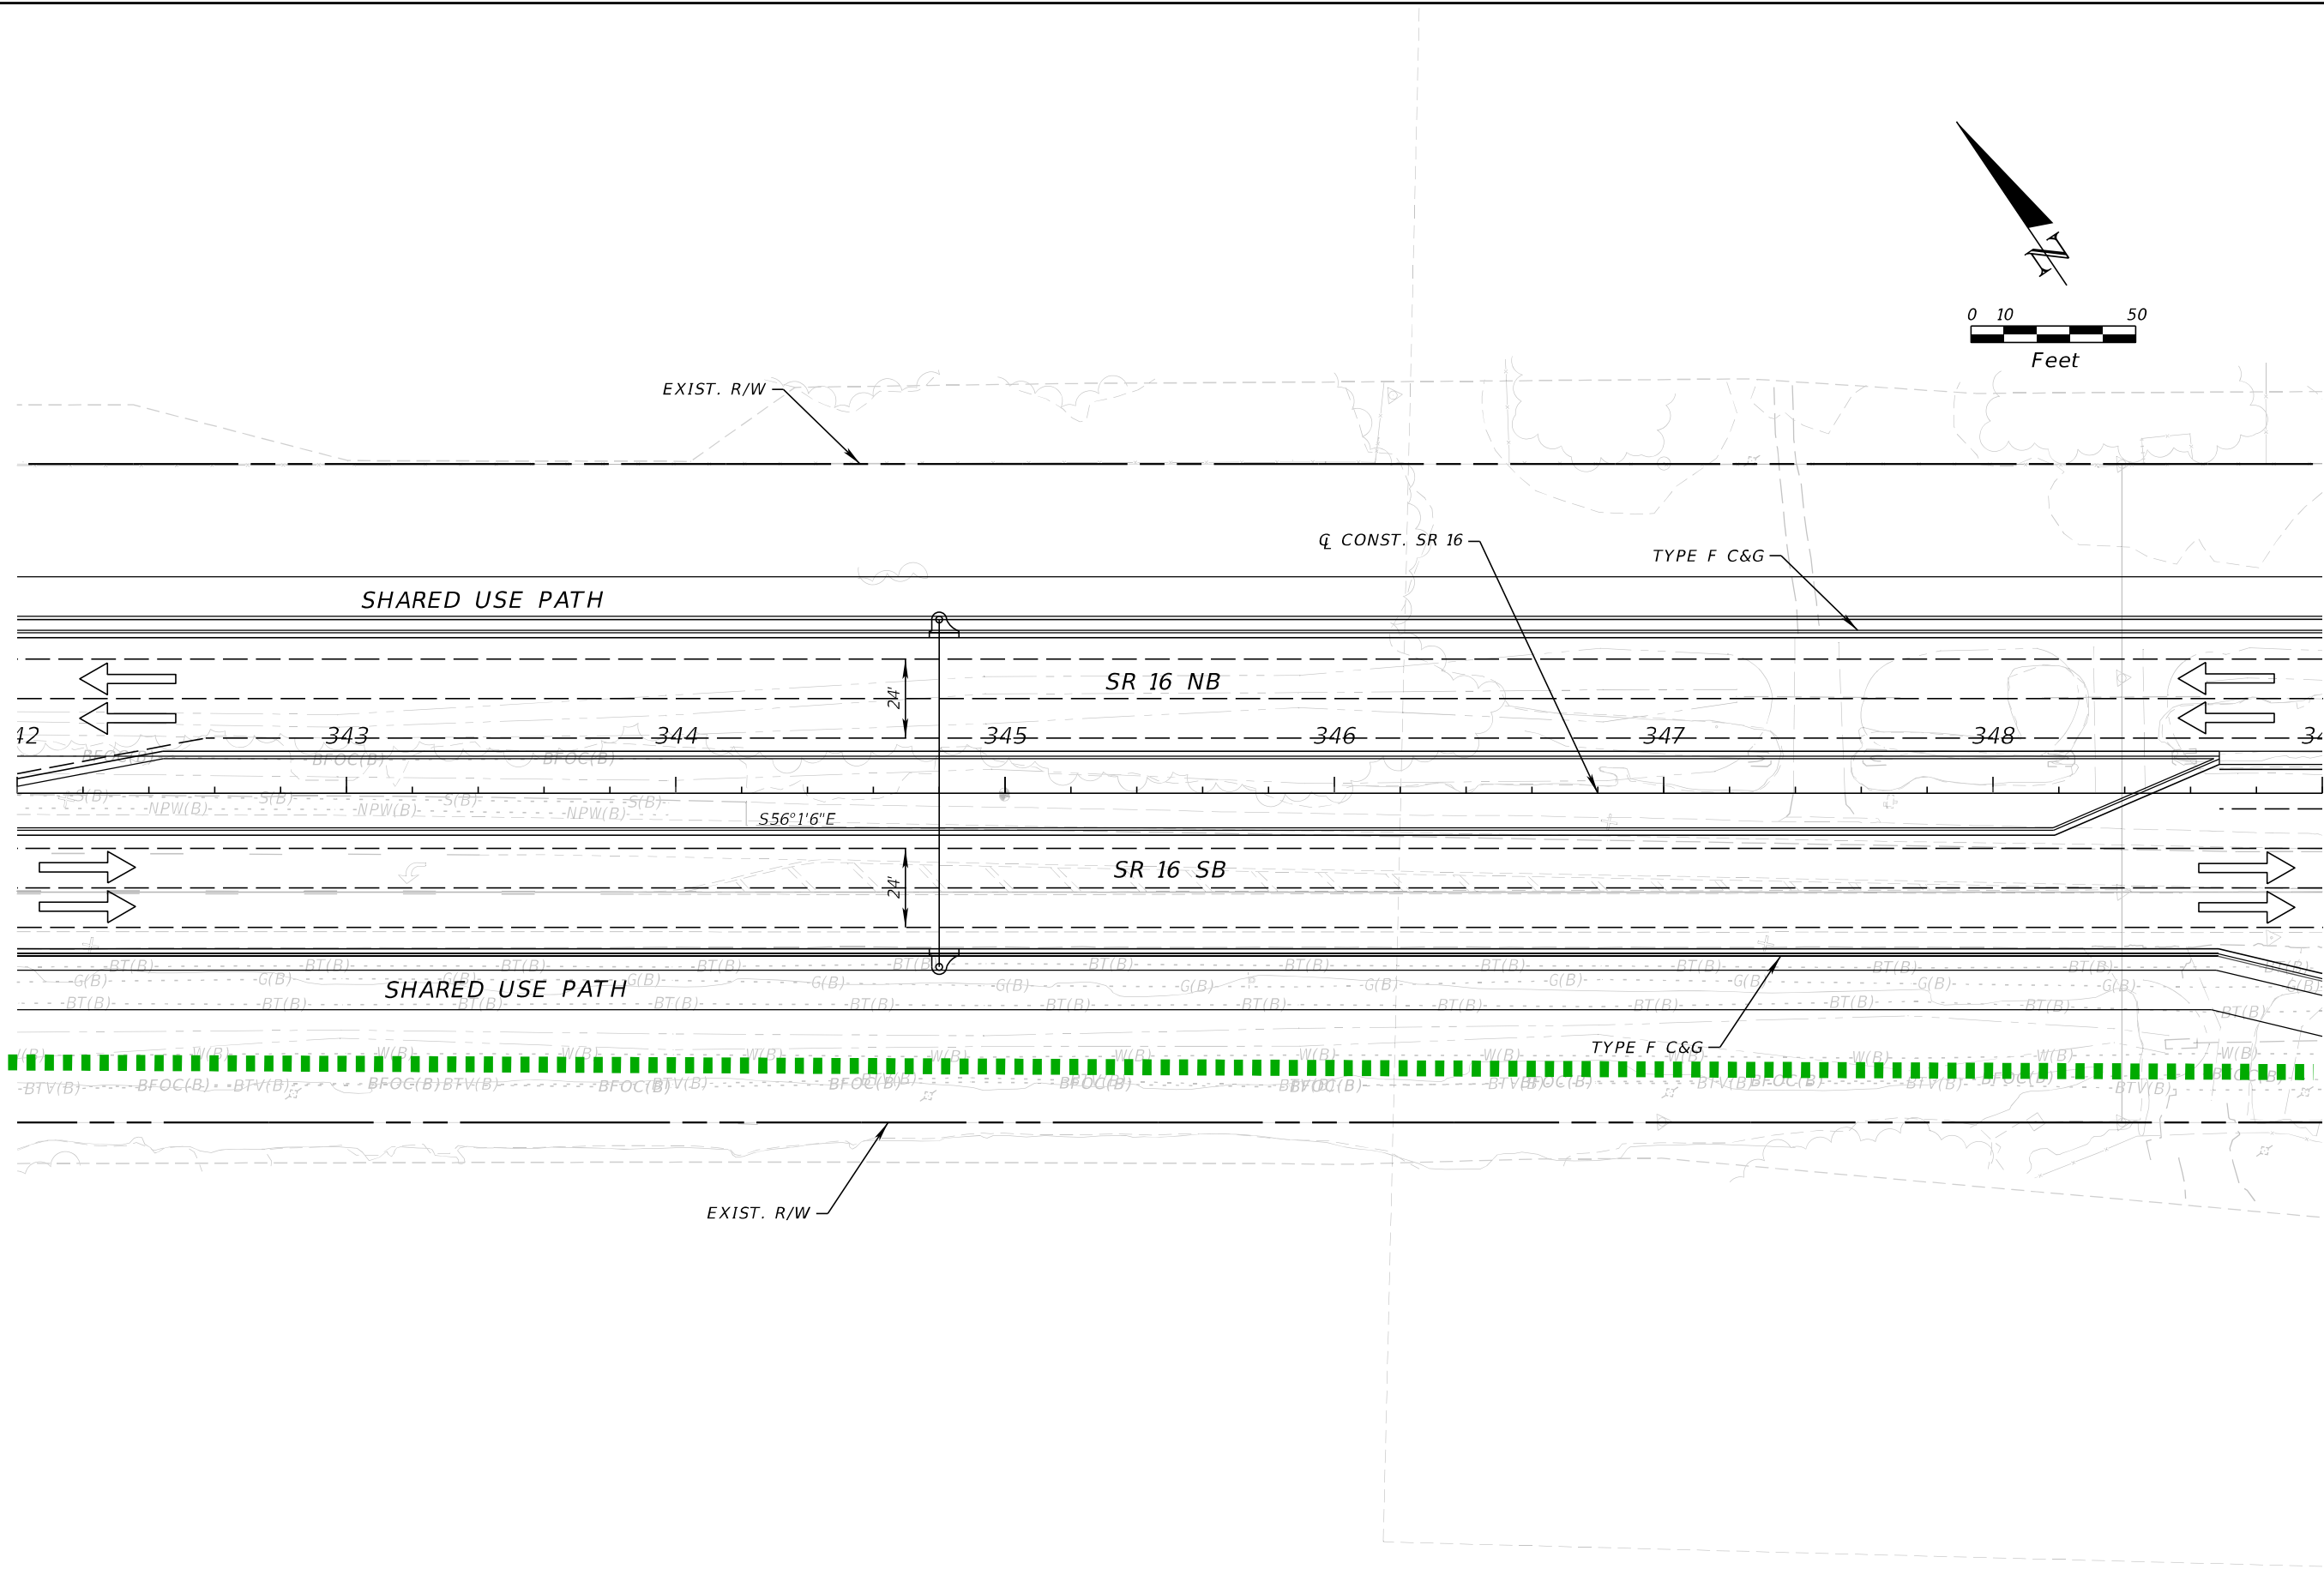

| REVISIONS |             |      |             | ENGINEER OF RECORD                                                                                                        |  | STATE OF FLORIDA<br>DEPARTMENT OF TRANSPORTATION |           |                      | SHEET<br>NO. |
|-----------|-------------|------|-------------|---------------------------------------------------------------------------------------------------------------------------|--|--------------------------------------------------|-----------|----------------------|--------------|
| DATE      | DESCRIPTION | DATE | DESCRIPTION | STEPHEN J. PARK, P.E.<br>LICENSE NUMBER: 77656<br>RS&H, INC.<br>10748 DEERWOOD PARK BLVD. SOUTH<br>JACKSONVILLE, FL 32256 |  | ROAD NO.                                         | COUNTY    | FINANCIAL PROJECT ID |              |
|           |             |      |             |                                                                                                                           |  | SR 16                                            | ST. JOHNS | 210447-5-52-01       |              |

THE OFFICIAL RECORD OF THIS SHEET IS THE ELECTRONIC FILE DIGITALLY SIGNED AND SEALED UNDER RULE 61G15-23.004, F.A.C.

TADPOLE PREP

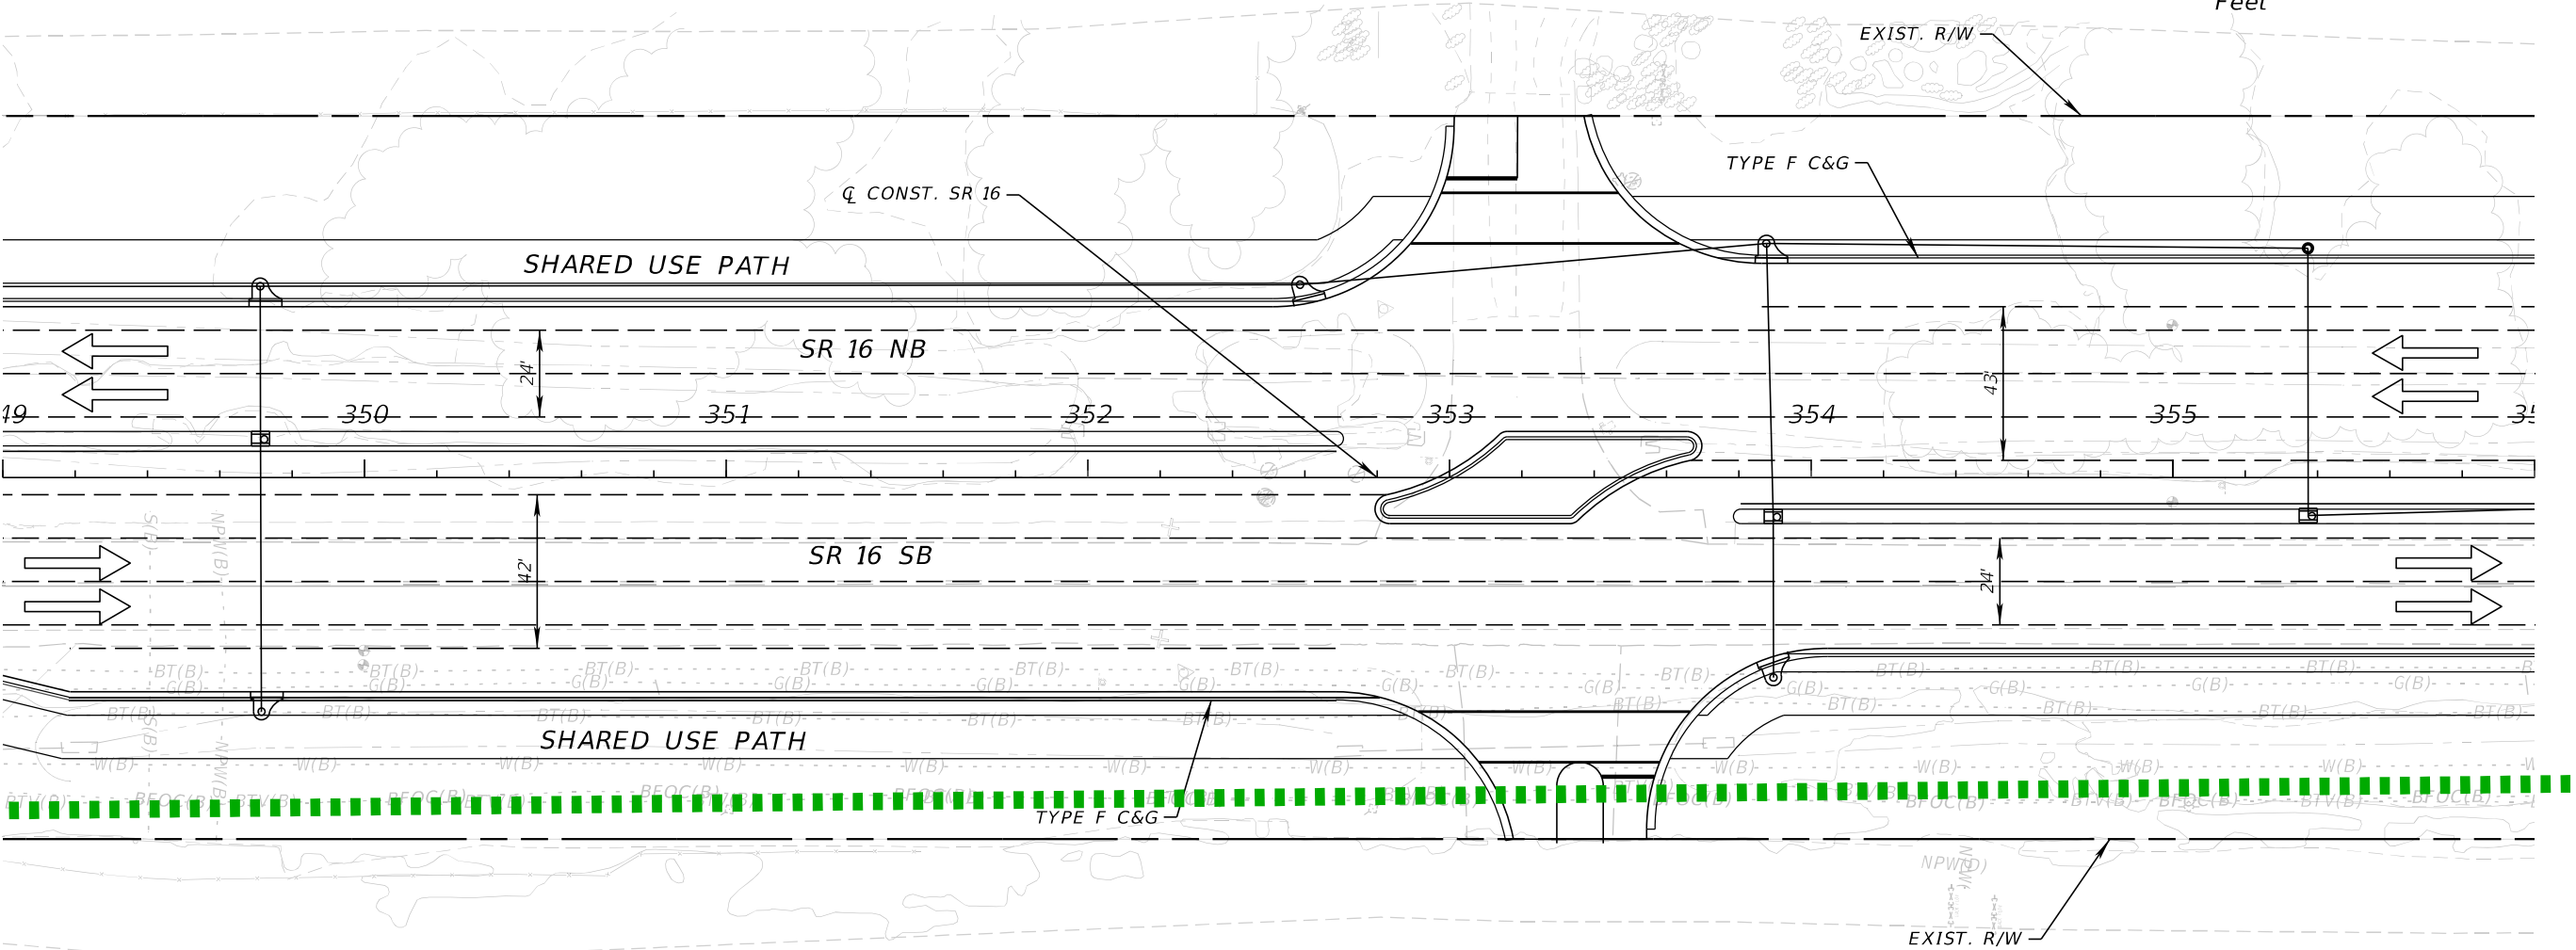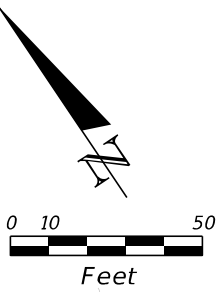



SOLUNA (UNDER CONSTRUCTION)

8/5/2024 4:29:01 PM BeattyM  
c:\pw\_work\sh\_pw\pw\_user\0439575\PLANRD01.dgn

| REVISIONS |             |      |             | ENGINEER OF RECORD                                                                                                        | STATE OF FLORIDA<br>DEPARTMENT OF TRANSPORTATION |           |                      | SHEET<br>NO.          |
|-----------|-------------|------|-------------|---------------------------------------------------------------------------------------------------------------------------|--------------------------------------------------|-----------|----------------------|-----------------------|
| DATE      | DESCRIPTION | DATE | DESCRIPTION | STEPHEN J. PARK, P.E.<br>LICENSE NUMBER: 77656<br>RS&H, INC.<br>10748 DEERWOOD PARK BLVD. SOUTH<br>JACKSONVILLE, FL 32256 | ROAD NO.                                         | COUNTY    | FINANCIAL PROJECT ID |                       |
|           |             |      |             |                                                                                                                           | SR 16                                            | ST. JOHNS | 210447-5-52-01       |                       |
|           |             |      |             |                                                                                                                           |                                                  |           |                      | 11x17<br>Plan<br>Only |

THE OFFICIAL RECORD OF THIS SHEET IS THE ELECTRONIC FILE DIGITALLY SIGNED AND SEALED UNDER RULE 61G15-23.004, F.A.C.

KINGDOM HALL OF  
JEHOVA'S WITNESSES

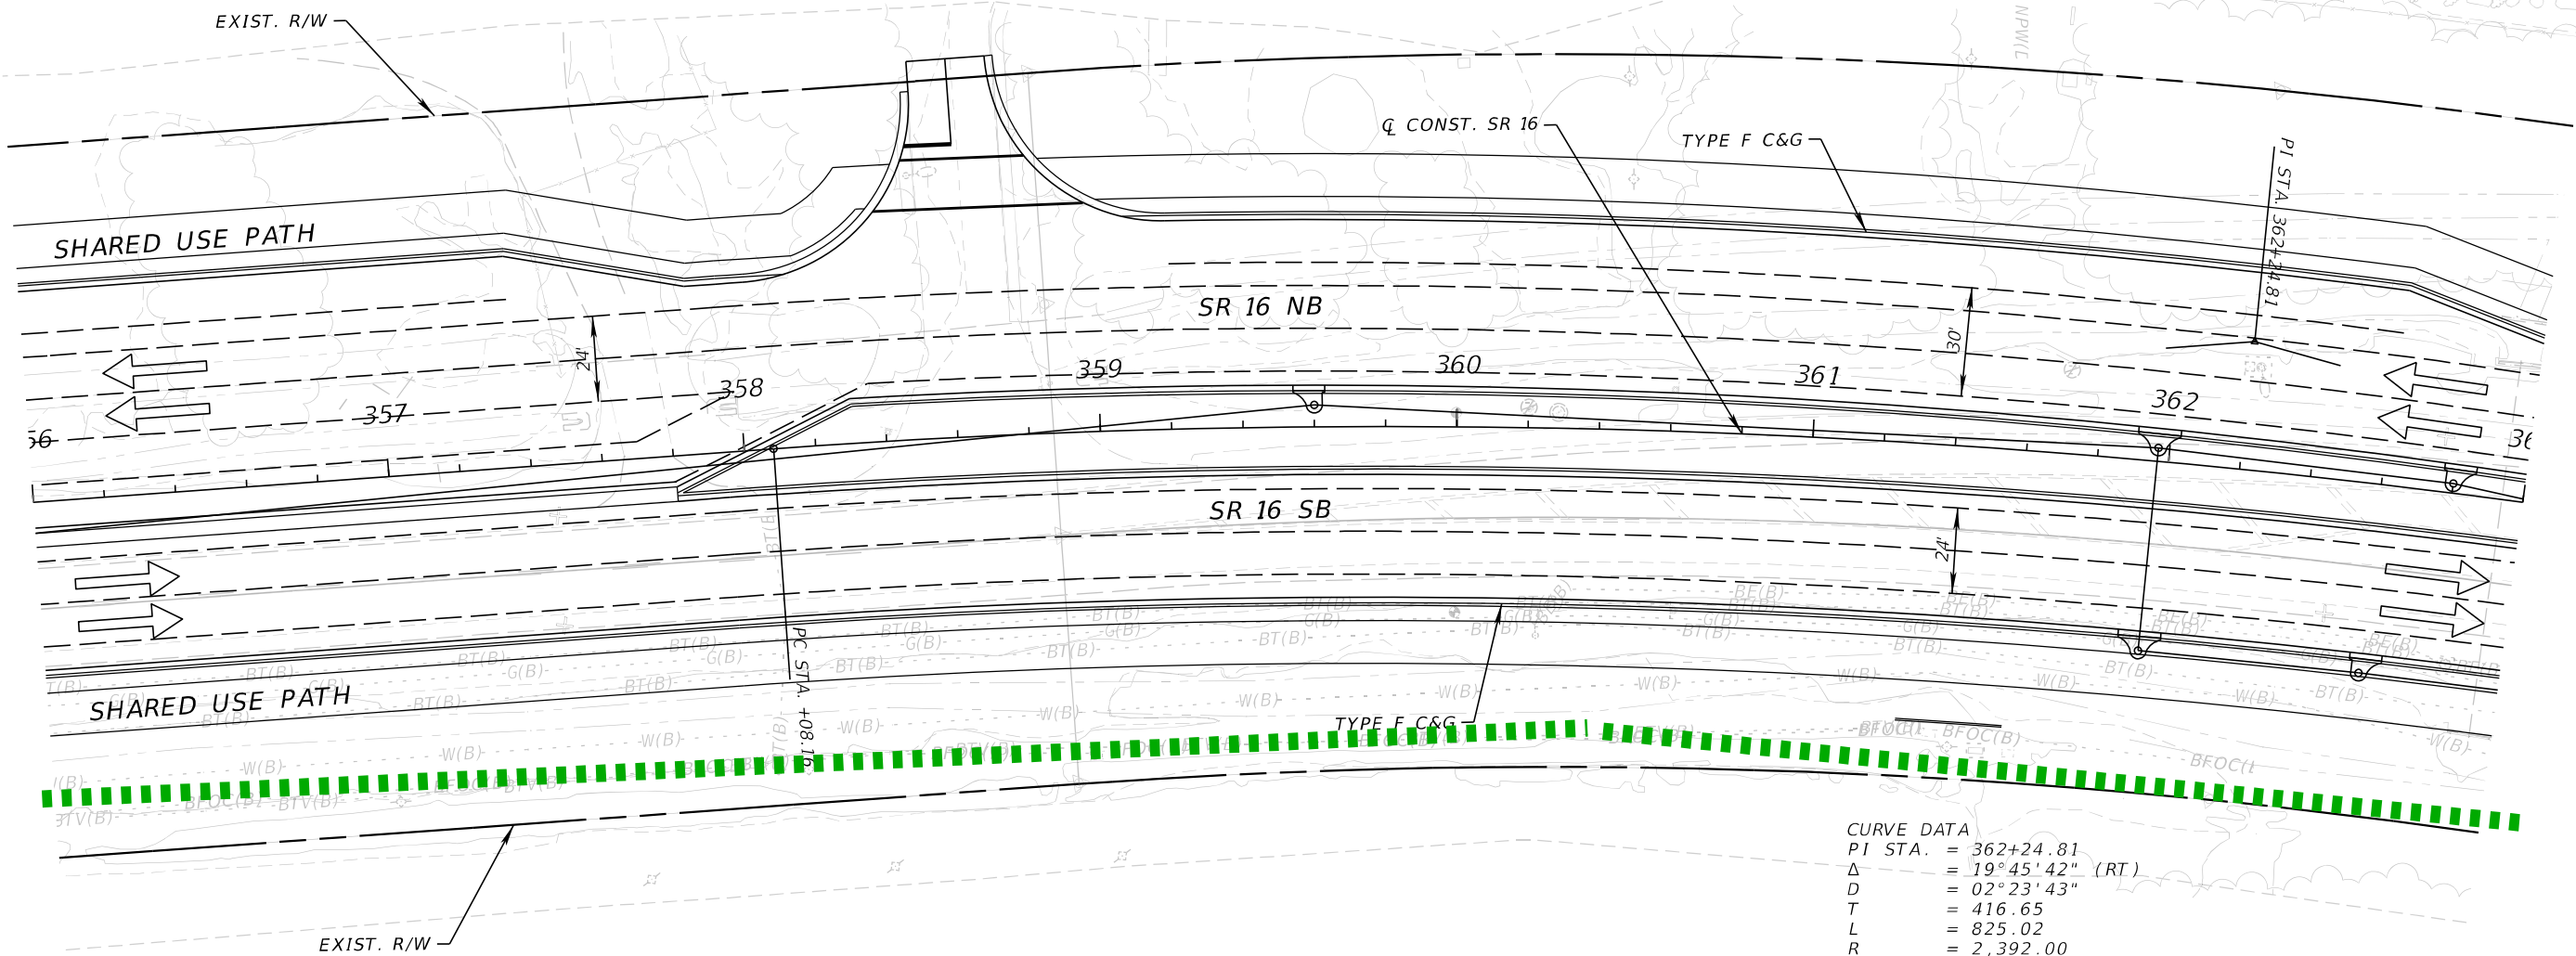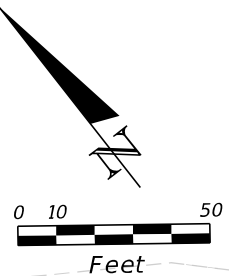



CURVE DATA  
PI STA. = 362+24.81  
 $\Delta$  = 19°45'42" (RT)  
D = 02°23'43"  
T = 416.65  
L = 825.02  
R = 2,392.00  
PC STA. = 358+08.16  
PT STA. = 366+33.18  
e = 0.000

8/5/2024 4:29:01 PM BeattyM  
c:\pw\_work\ysh\_pw\pw\_user\00439575\PLAINRD01.dgn

| REVISIONS |             |      |             | ENGINEER OF RECORD                                                                                                        |  | STATE OF FLORIDA<br>DEPARTMENT OF TRANSPORTATION |           |                      | SHEET<br>NO. |
|-----------|-------------|------|-------------|---------------------------------------------------------------------------------------------------------------------------|--|--------------------------------------------------|-----------|----------------------|--------------|
| DATE      | DESCRIPTION | DATE | DESCRIPTION | STEPHEN J. PARK, P.E.<br>LICENSE NUMBER: 77656<br>RS&H, INC.<br>10748 DEERWOOD PARK BLVD. SOUTH<br>JACKSONVILLE, FL 32256 |  | ROAD NO.                                         | COUNTY    | FINANCIAL PROJECT ID |              |
|           |             |      |             |                                                                                                                           |  | SR 16                                            | ST. JOHNS | 210447-5-52-01       |              |

THE OFFICIAL RECORD OF THIS SHEET IS THE ELECTRONIC FILE DIGITALLY SIGNED AND SEALED UNDER RULE 61G15-23.004, F.A.C.

ATLANTIC SELF STORAGE

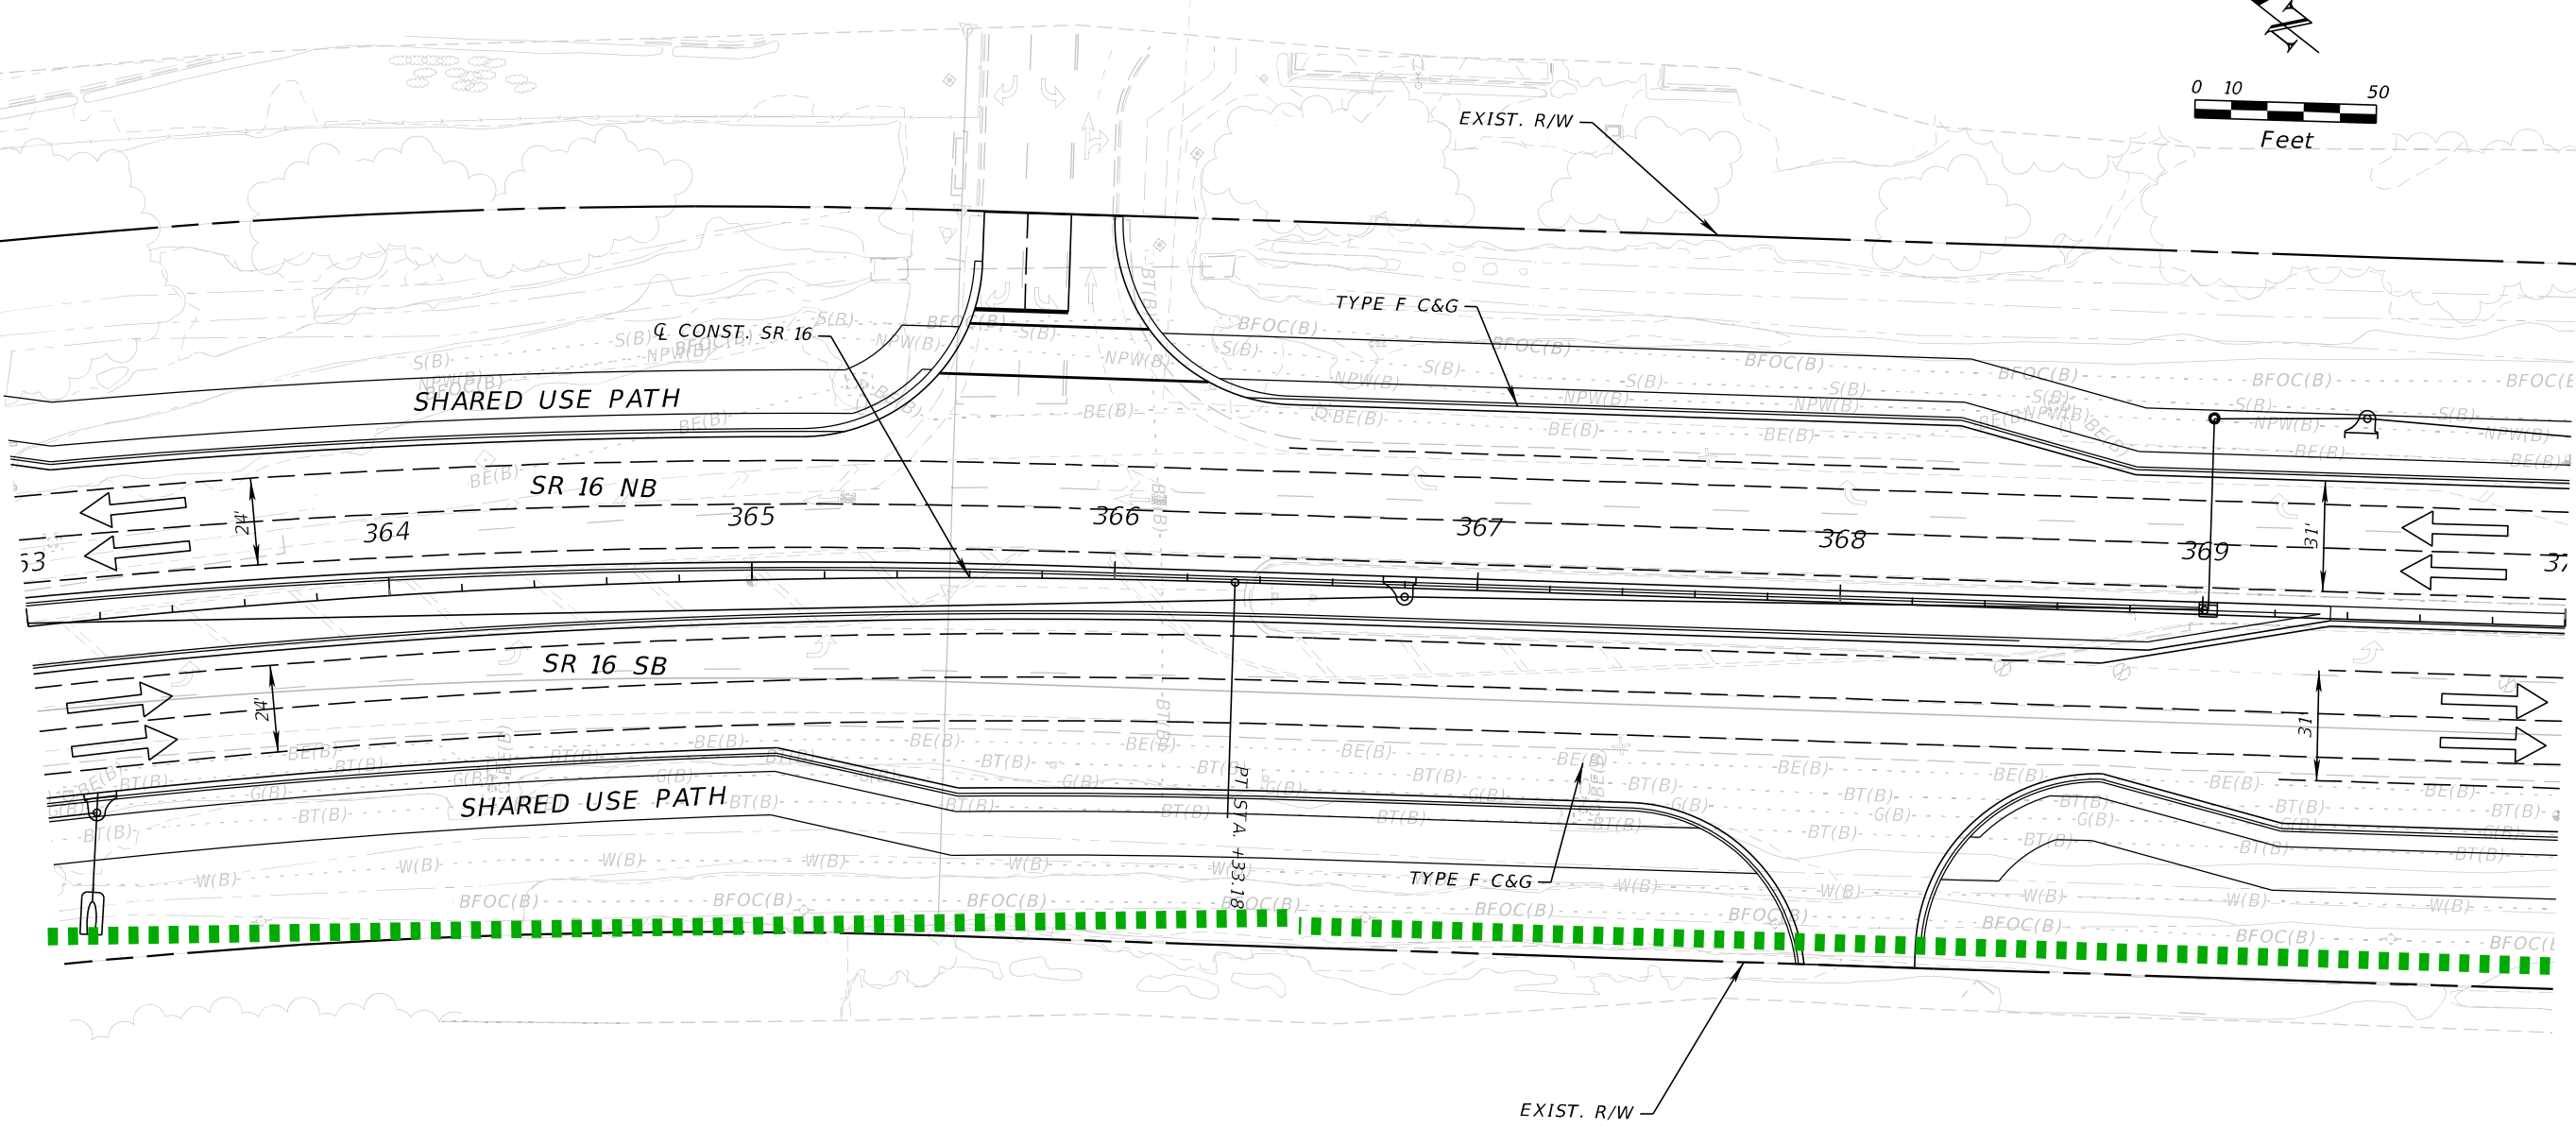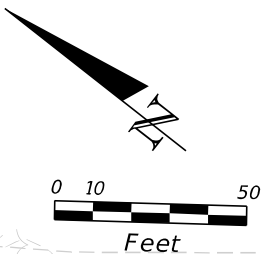


8/5/2024 4:29:02 PM BeattyM  
c:\pw\_work\ysh\_pw\pw\_user\0439575\PLANRD01.dgn

| REVISIONS |             |      |             | ENGINEER OF RECORD                                                                                                        | STATE OF FLORIDA<br>DEPARTMENT OF TRANSPORTATION |           |                      | SHEET<br>NO.          |
|-----------|-------------|------|-------------|---------------------------------------------------------------------------------------------------------------------------|--------------------------------------------------|-----------|----------------------|-----------------------|
| DATE      | DESCRIPTION | DATE | DESCRIPTION | STEPHEN J. PARK, P.E.<br>LICENSE NUMBER: 77656<br>RS&H, INC.<br>10748 DEERWOOD PARK BLVD. SOUTH<br>JACKSONVILLE, FL 32256 | ROAD NO.                                         | COUNTY    | FINANCIAL PROJECT ID |                       |
|           |             |      |             |                                                                                                                           | SR 16                                            | ST. JOHNS | 210447-5-52-01       |                       |
|           |             |      |             |                                                                                                                           |                                                  |           |                      | 11x17<br>Plan<br>Only |

THE OFFICIAL RECORD OF THIS SHEET IS THE ELECTRONIC FILE DIGITALLY SIGNED AND SEALED UNDER RULE 61G15-23.004, F.A.C.

8/5/2024 4:29:03 PM BeattyM  
c:\pw\_work\ysh\_pw\pw\_user\40439575\PLAINRD01.dgn

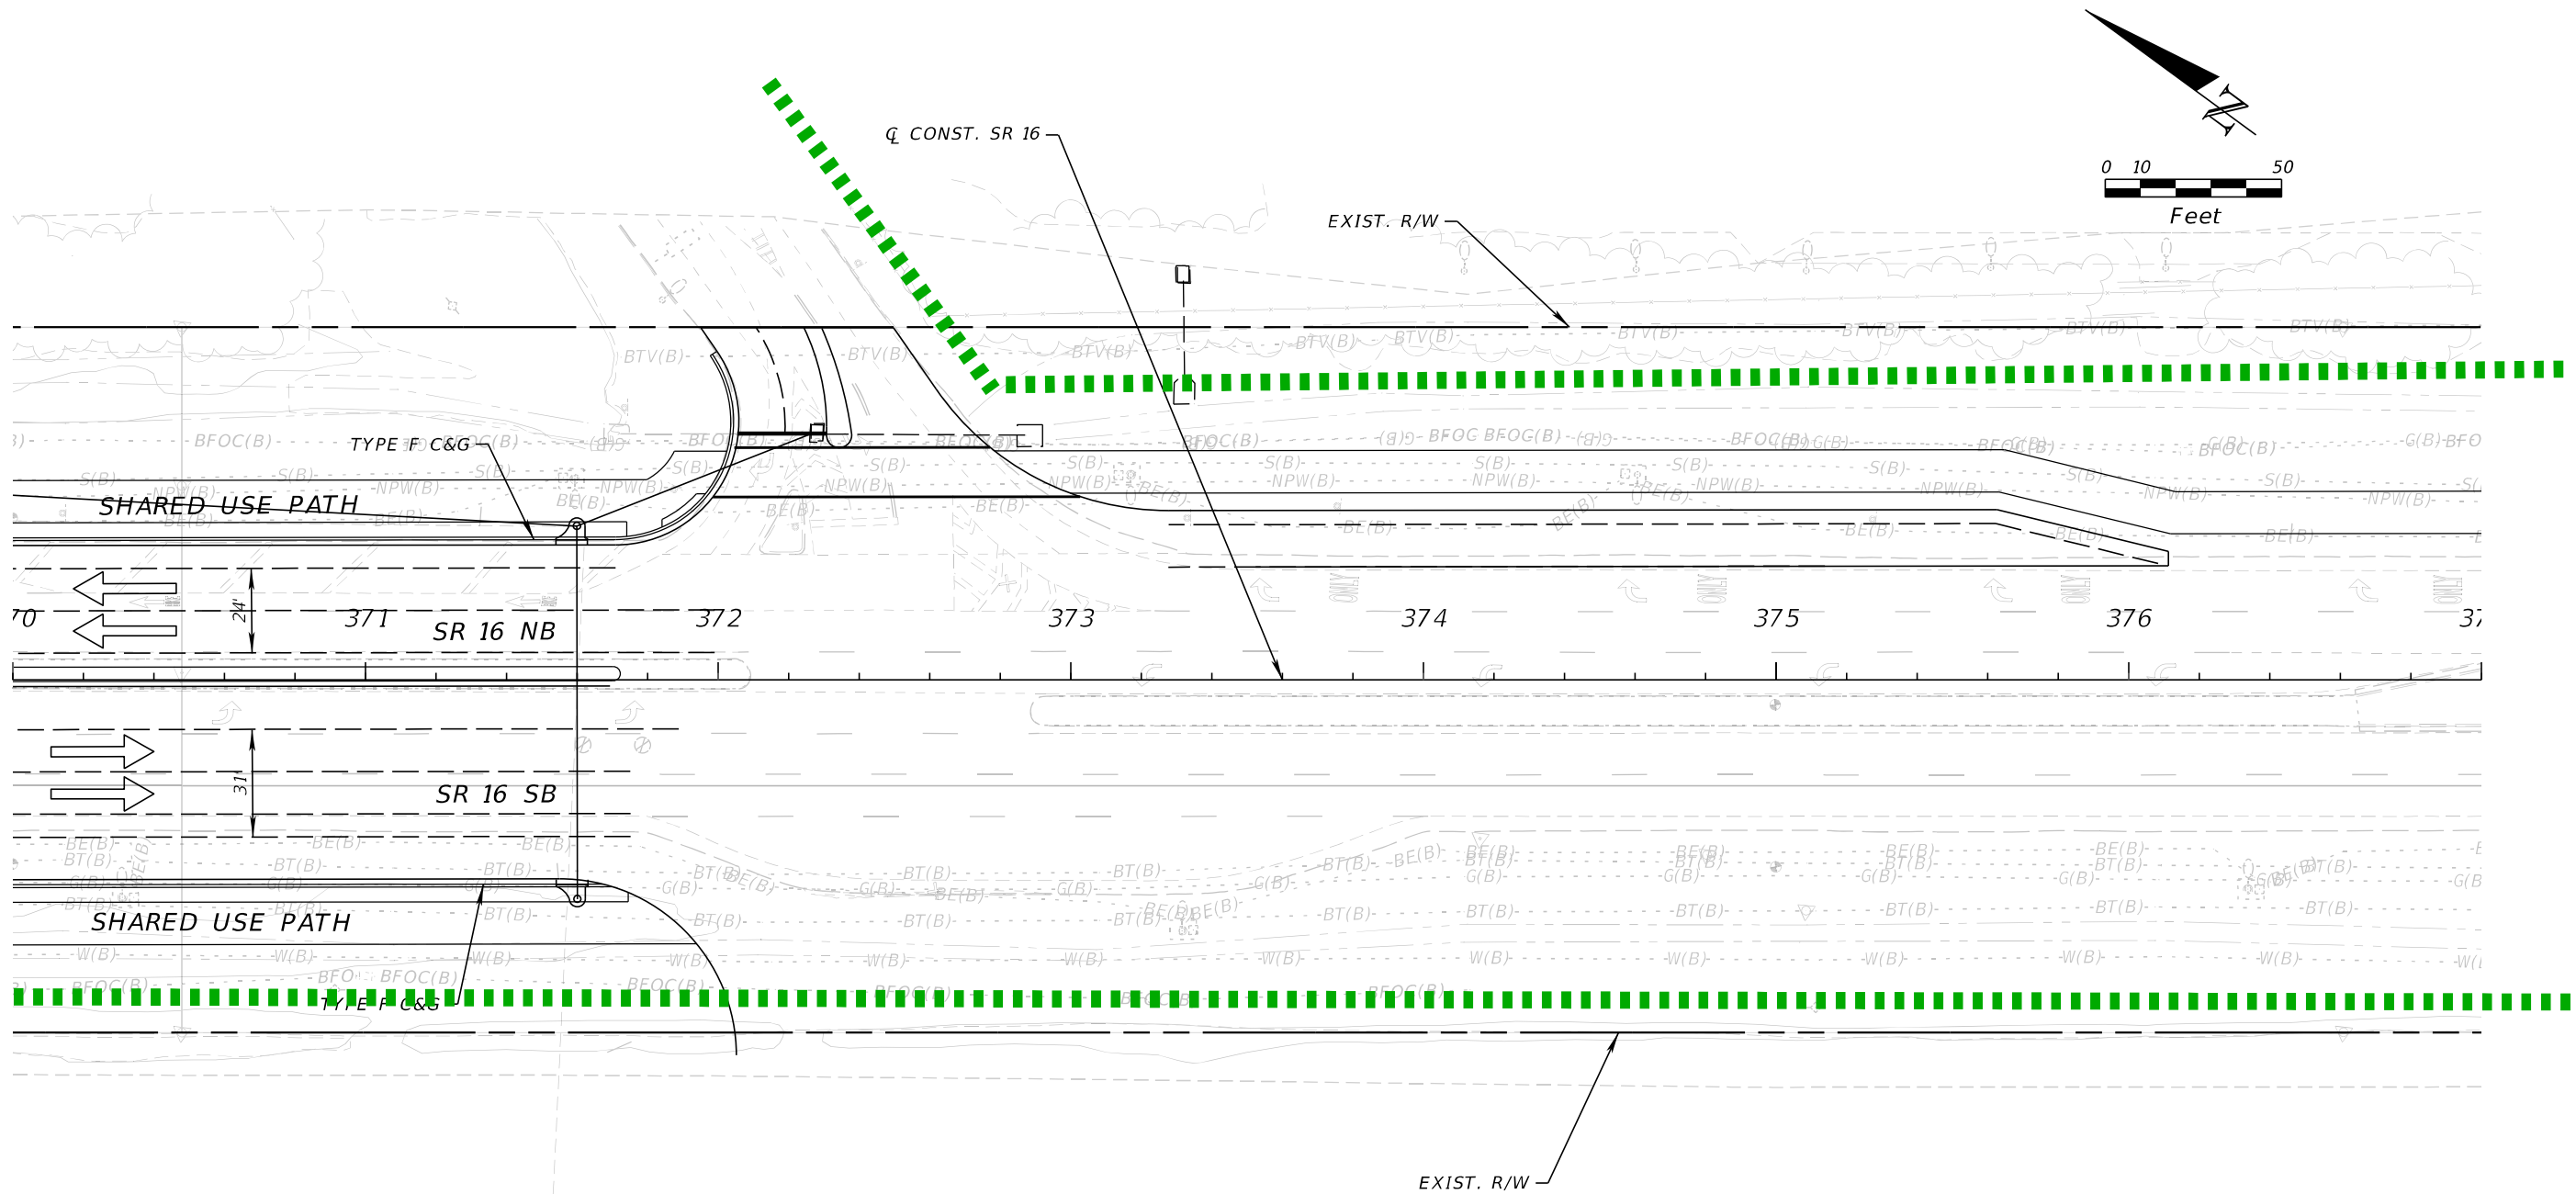


| REVISIONS |             |      |             | ENGINEER OF RECORD                                                                                                        |  | STATE OF FLORIDA<br>DEPARTMENT OF TRANSPORTATION |           |                      | SHEET<br>NO. |
|-----------|-------------|------|-------------|---------------------------------------------------------------------------------------------------------------------------|--|--------------------------------------------------|-----------|----------------------|--------------|
| DATE      | DESCRIPTION | DATE | DESCRIPTION | STEPHEN J. PARK, P.E.<br>LICENSE NUMBER: 77656<br>RS&H, INC.<br>10748 DEERWOOD PARK BLVD. SOUTH<br>JACKSONVILLE, FL 32256 |  | ROAD NO.                                         | COUNTY    | FINANCIAL PROJECT ID |              |
|           |             |      |             |                                                                                                                           |  | SR 16                                            | ST. JOHNS | 210447-5-52-01       |              |

THE OFFICIAL RECORD OF THIS SHEET IS THE ELECTRONIC FILE DIGITALLY SIGNED AND SEALED UNDER RULE 61G15-23.004, F.A.C.



8/5/2024 4:29:03 PM BeattyM  
c:\pw\_work\sh\_pw\pw\_user\0439575\PLANRD01.dgn



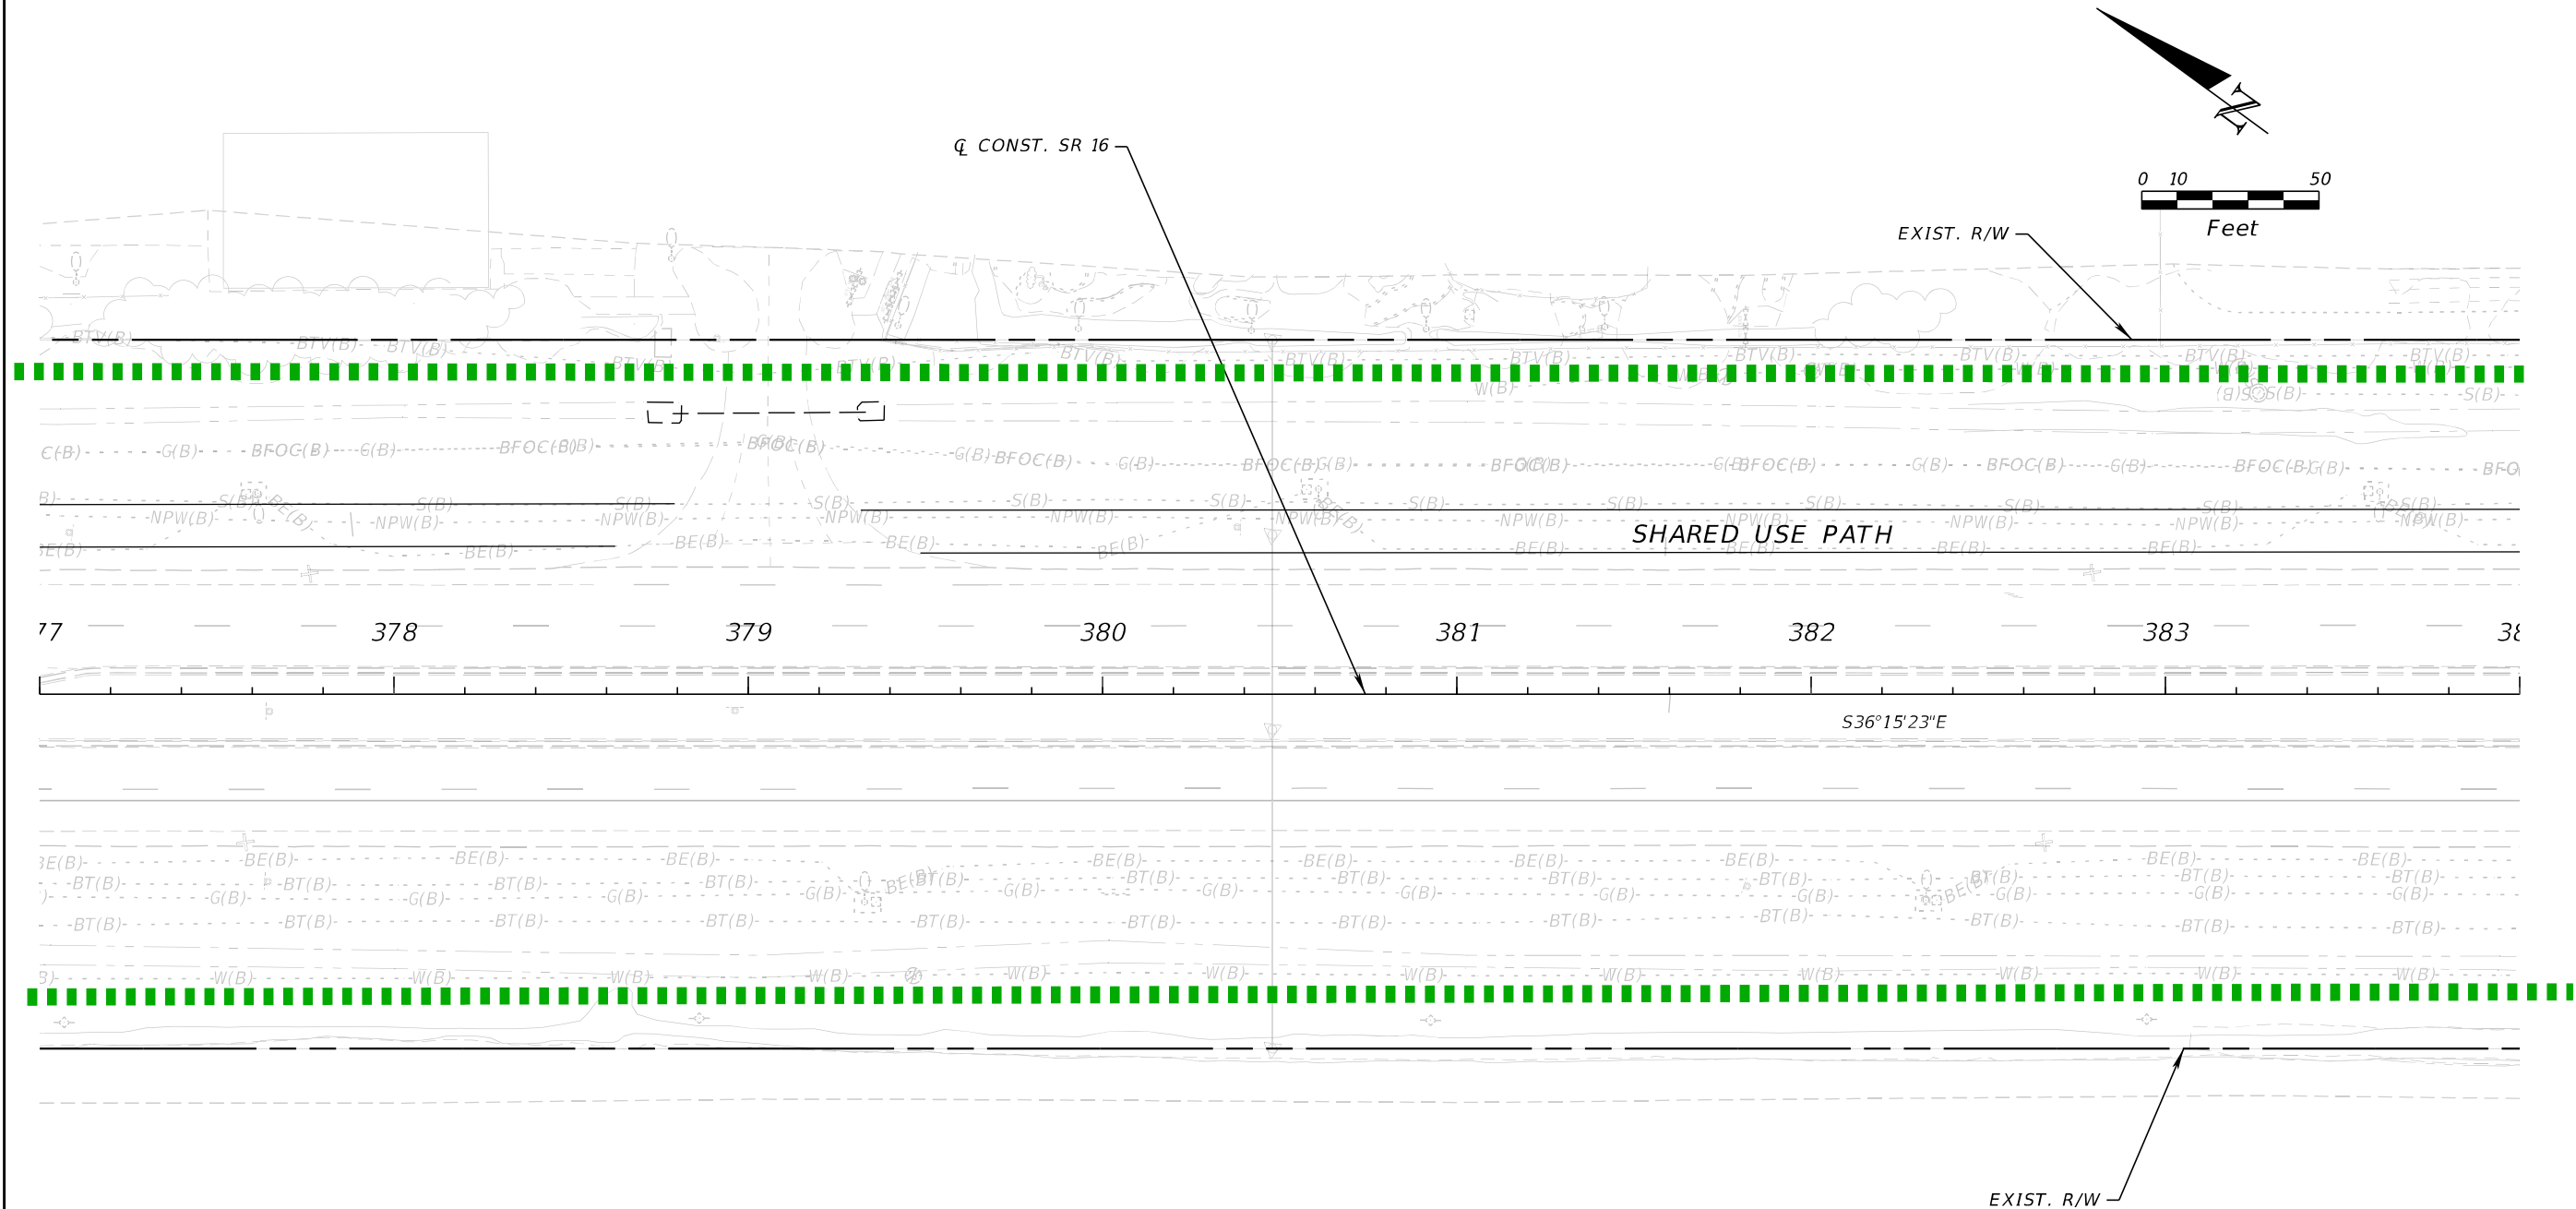


| REVISIONS |             |      |             | ENGINEER OF RECORD                                                                                                        |  | STATE OF FLORIDA<br>DEPARTMENT OF TRANSPORTATION |           |                      | SHEET<br>NO. |
|-----------|-------------|------|-------------|---------------------------------------------------------------------------------------------------------------------------|--|--------------------------------------------------|-----------|----------------------|--------------|
| DATE      | DESCRIPTION | DATE | DESCRIPTION | STEPHEN J. PARK, P.E.<br>LICENSE NUMBER: 77656<br>RS&H, INC.<br>10748 DEERWOOD PARK BLVD. SOUTH<br>JACKSONVILLE, FL 32256 |  | ROAD NO.                                         | COUNTY    | FINANCIAL PROJECT ID |              |
|           |             |      |             |                                                                                                                           |  | SR 16                                            | ST. JOHNS | 210447-5-52-01       |              |

THE OFFICIAL RECORD OF THIS SHEET IS THE ELECTRONIC FILE DIGITALLY SIGNED AND SEALED UNDER RULE 61G15-23.004, F.A.C.



SHOPPES AT MILL CREEK

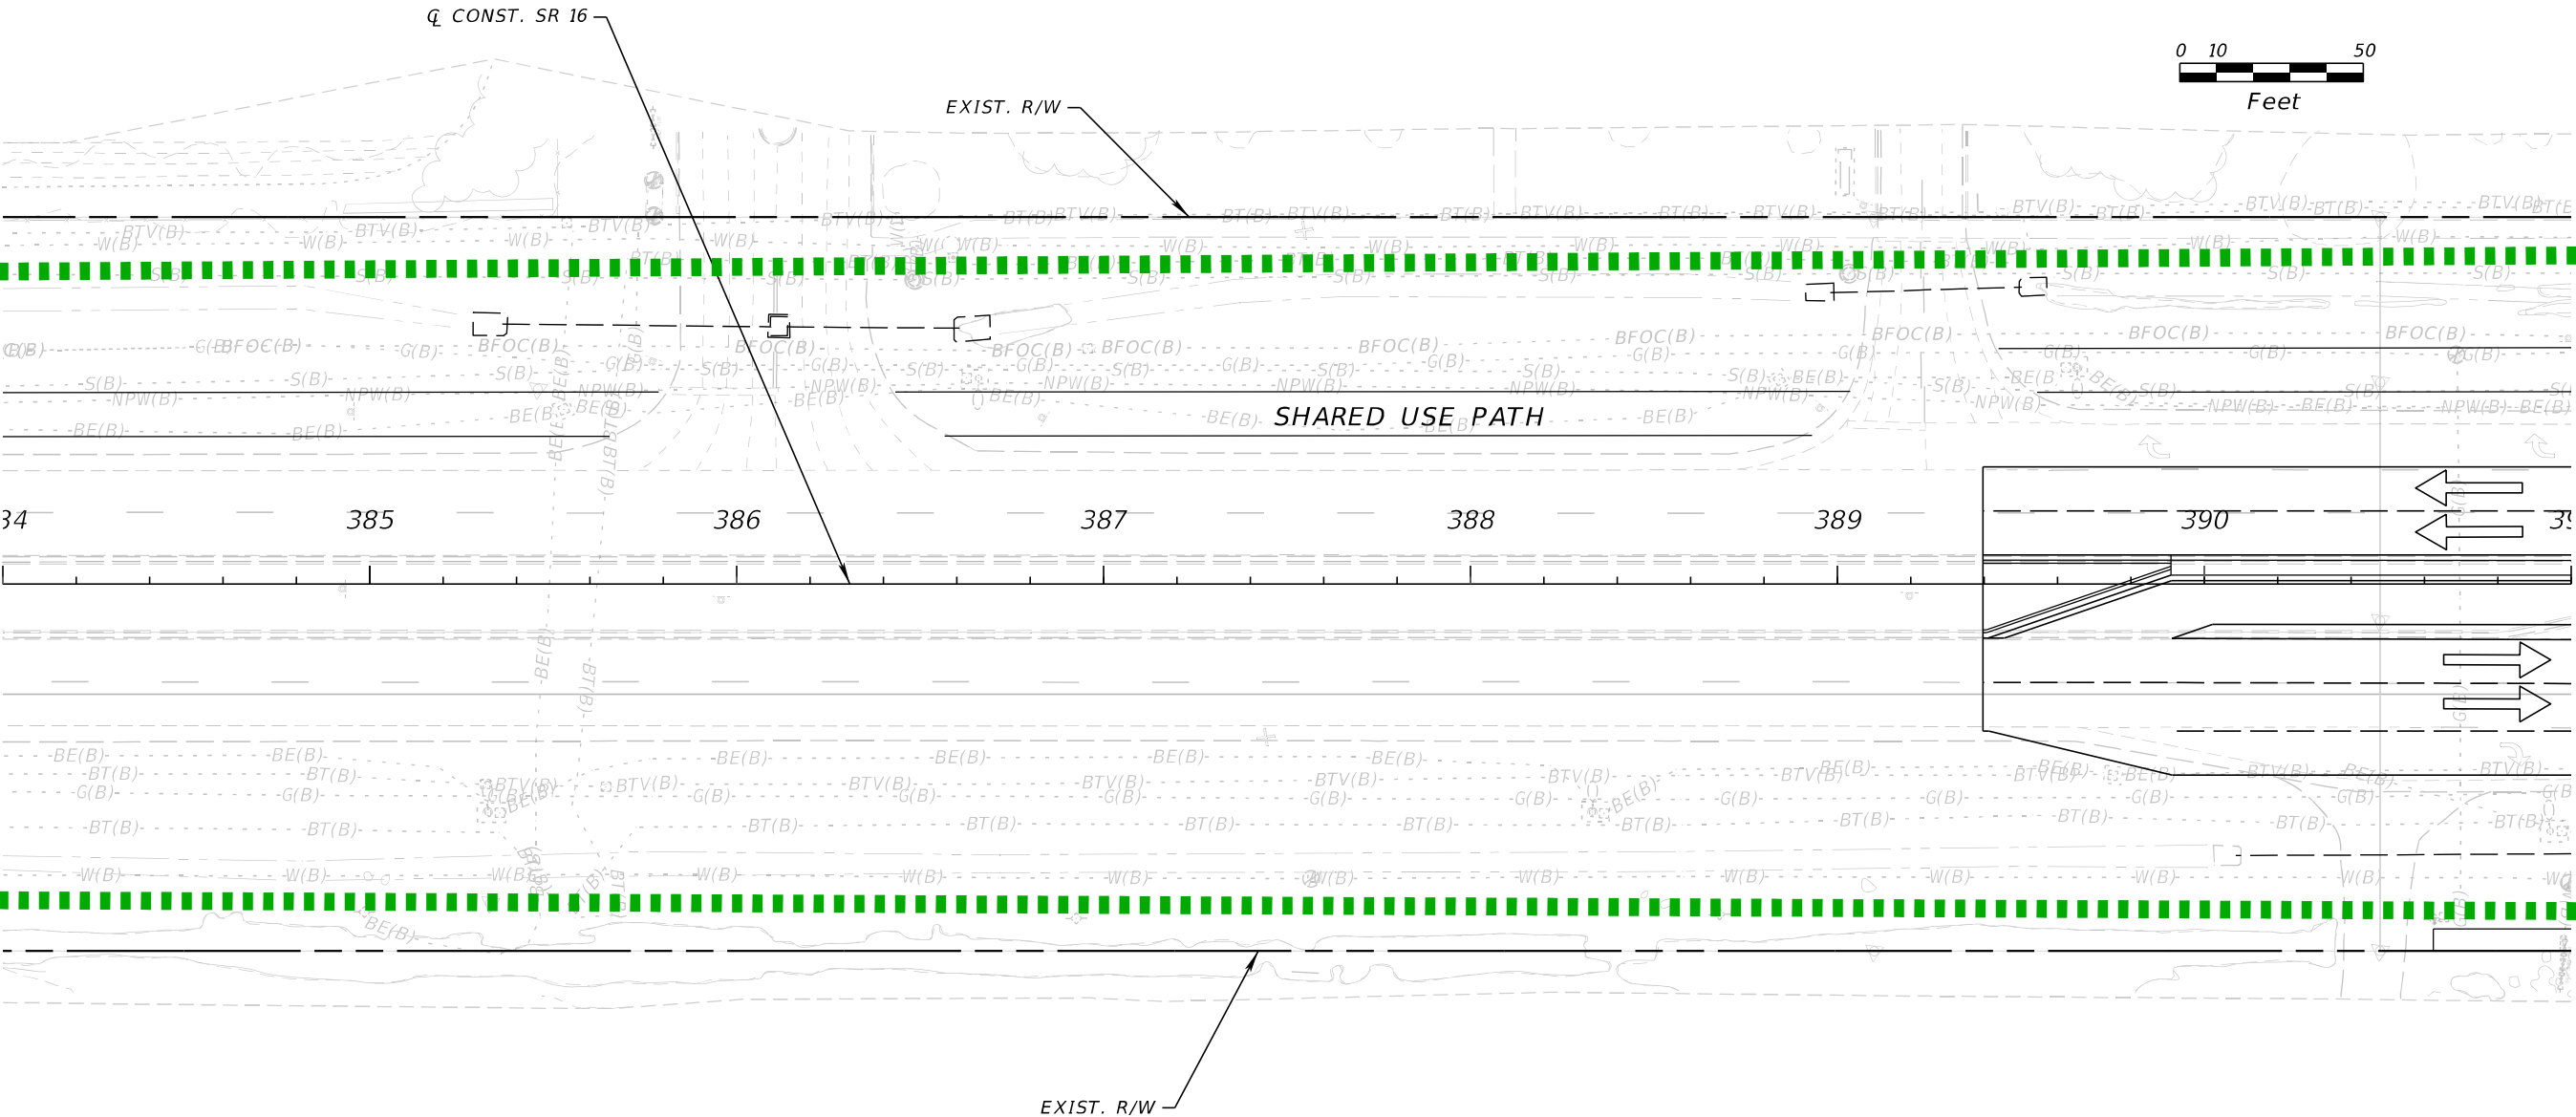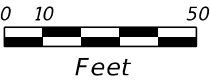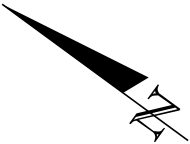

8/5/2024 4:29:04 PM BeattyM  
c:\pw\_work\ysh\_pw\pw\_user\00439575\PLANRD01.dgn



| REVISIONS |             |      |             | ENGINEER OF RECORD                                                                                                        |  | STATE OF FLORIDA<br>DEPARTMENT OF TRANSPORTATION |           |                      | SHEET<br>NO. |
|-----------|-------------|------|-------------|---------------------------------------------------------------------------------------------------------------------------|--|--------------------------------------------------|-----------|----------------------|--------------|
| DATE      | DESCRIPTION | DATE | DESCRIPTION | STEPHEN J. PARK, P.E.<br>LICENSE NUMBER: 77656<br>RS&H, INC.<br>10748 DEERWOOD PARK BLVD. SOUTH<br>JACKSONVILLE, FL 32256 |  | ROAD NO.                                         | COUNTY    | FINANCIAL PROJECT ID |              |
|           |             |      |             |                                                                                                                           |  | SR 16                                            | ST. JOHNS | 210447-5-52-01       |              |

THE OFFICIAL RECORD OF THIS SHEET IS THE ELECTRONIC FILE DIGITALLY SIGNED AND SEALED UNDER RULE 61G15-23.004, F.A.C.

SONNY'S BBQ

WENDY'S

SCOTTISH INNS

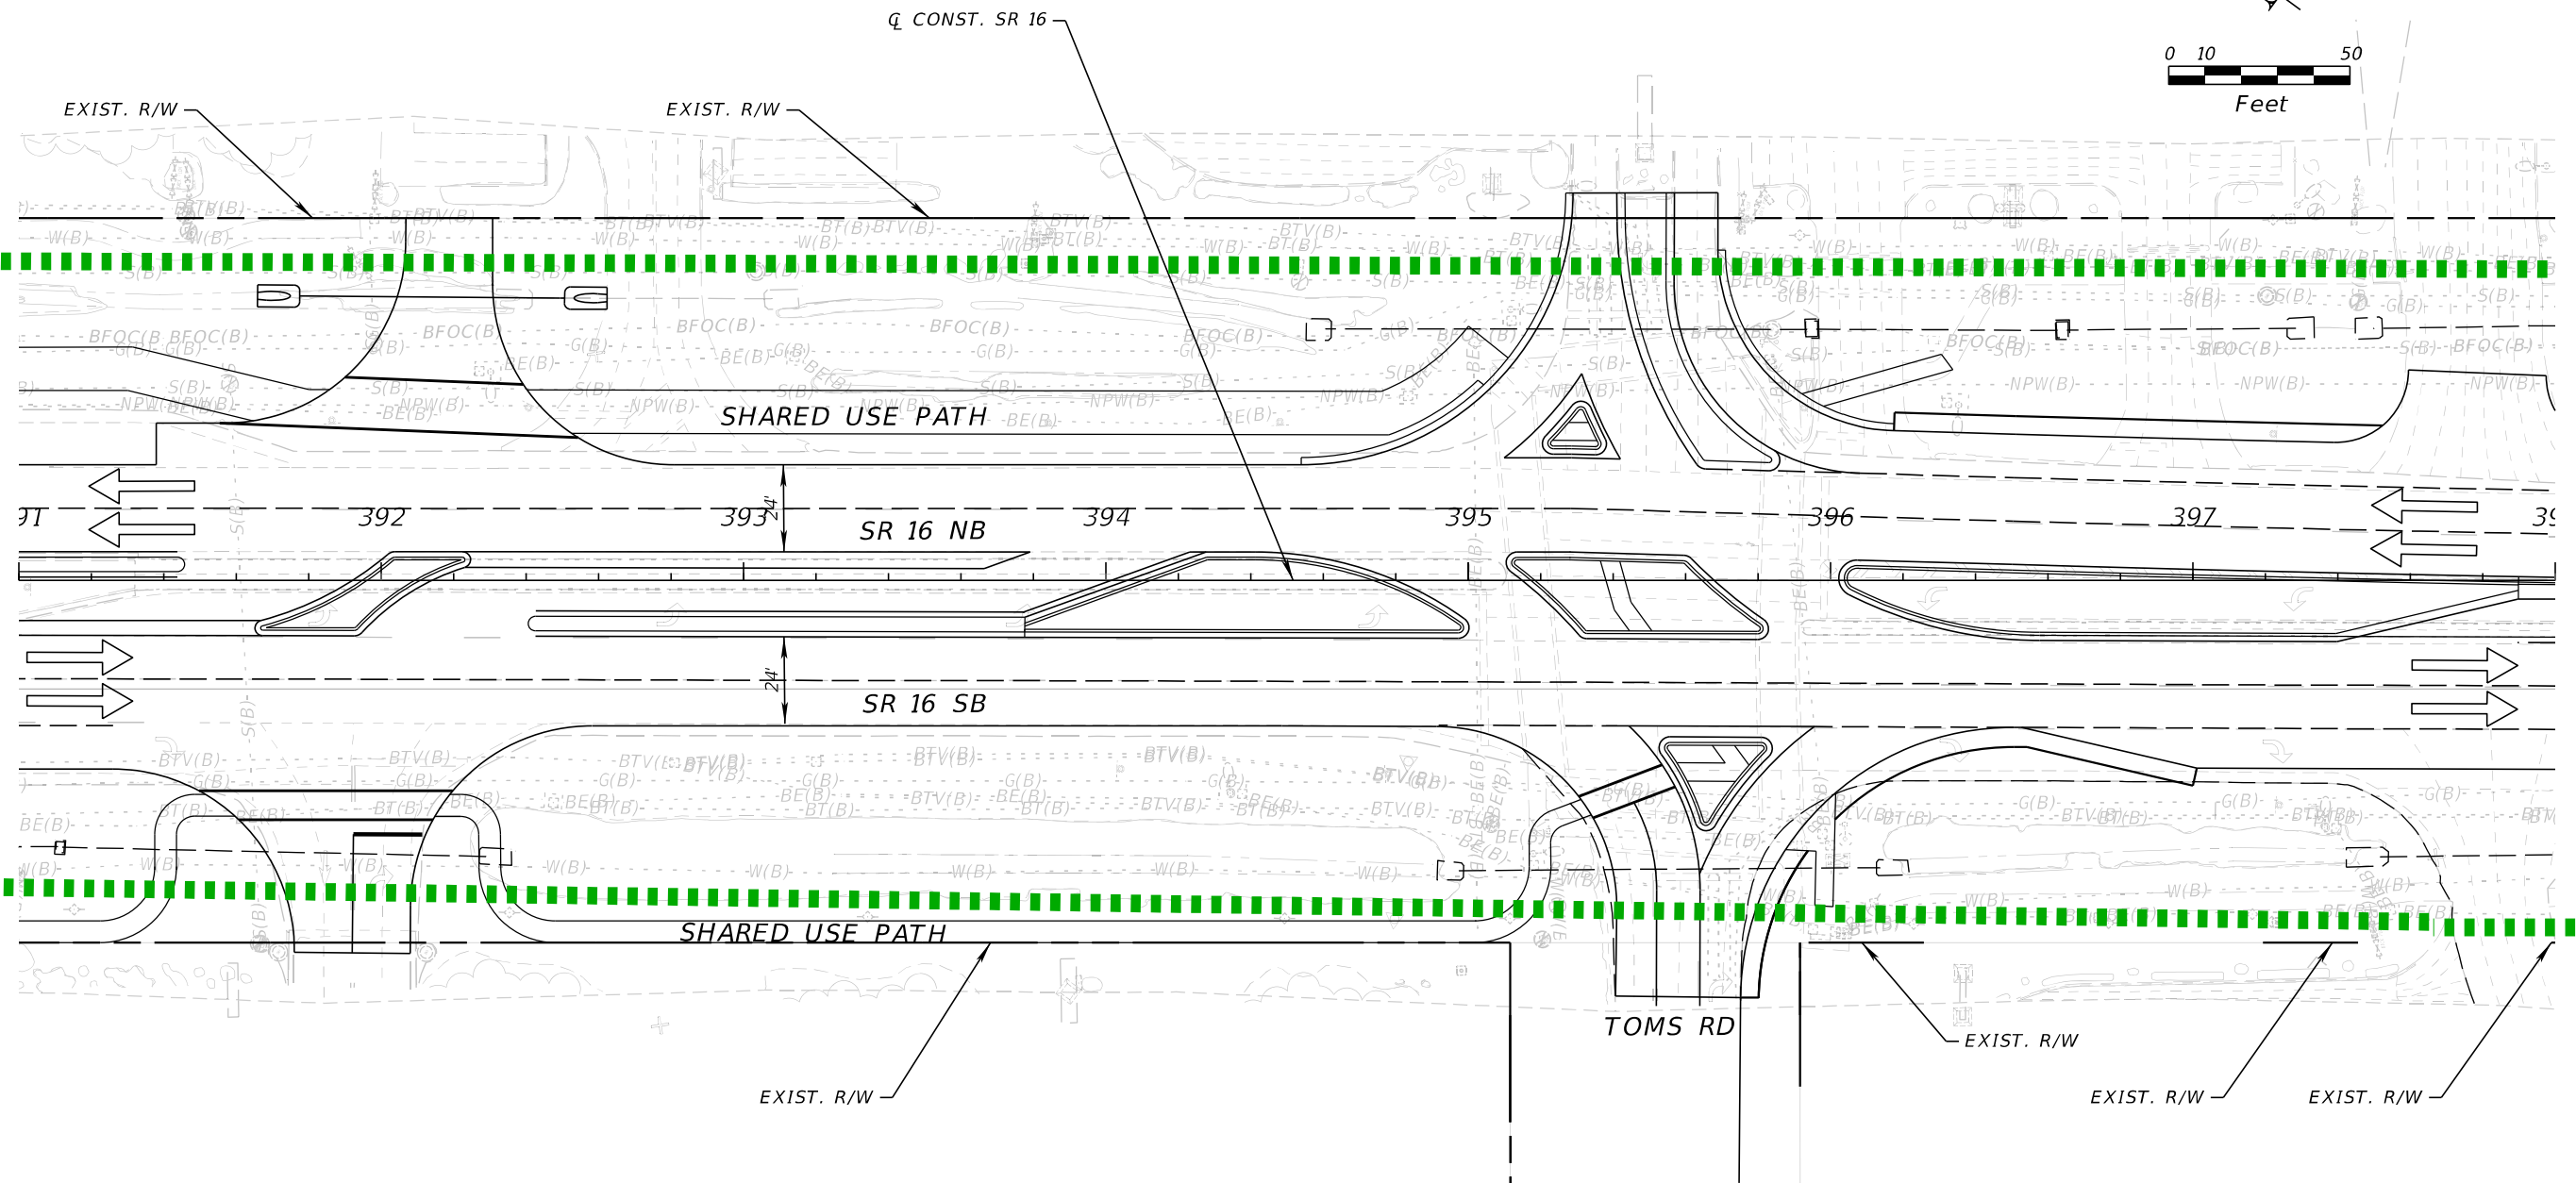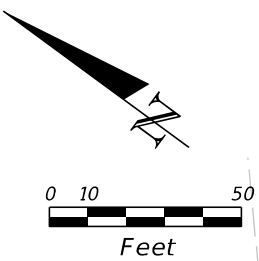



8/5/2024 4:29:04 PM BeattyM  
c:\pw\_work\ysh\_pw\pw\_user\0439575\PLANRD01.dgn

| REVISIONS |             |      |             | ENGINEER OF RECORD                                                                                                        |  | STATE OF FLORIDA<br>DEPARTMENT OF TRANSPORTATION |           |                      | SHEET<br>NO. |
|-----------|-------------|------|-------------|---------------------------------------------------------------------------------------------------------------------------|--|--------------------------------------------------|-----------|----------------------|--------------|
| DATE      | DESCRIPTION | DATE | DESCRIPTION | STEPHEN J. PARK, P.E.<br>LICENSE NUMBER: 77656<br>RS&H, INC.<br>10748 DEERWOOD PARK BLVD. SOUTH<br>JACKSONVILLE, FL 32256 |  | ROAD NO.                                         | COUNTY    | FINANCIAL PROJECT ID |              |
|           |             |      |             |                                                                                                                           |  | SR 16                                            | ST. JOHNS | 210447-5-52-01       |              |

THE OFFICIAL RECORD OF THIS SHEET IS THE ELECTRONIC FILE DIGITALLY SIGNED AND SEALED UNDER RULE 61G15-23.004, F.A.C.

DAYS INN

IHOP

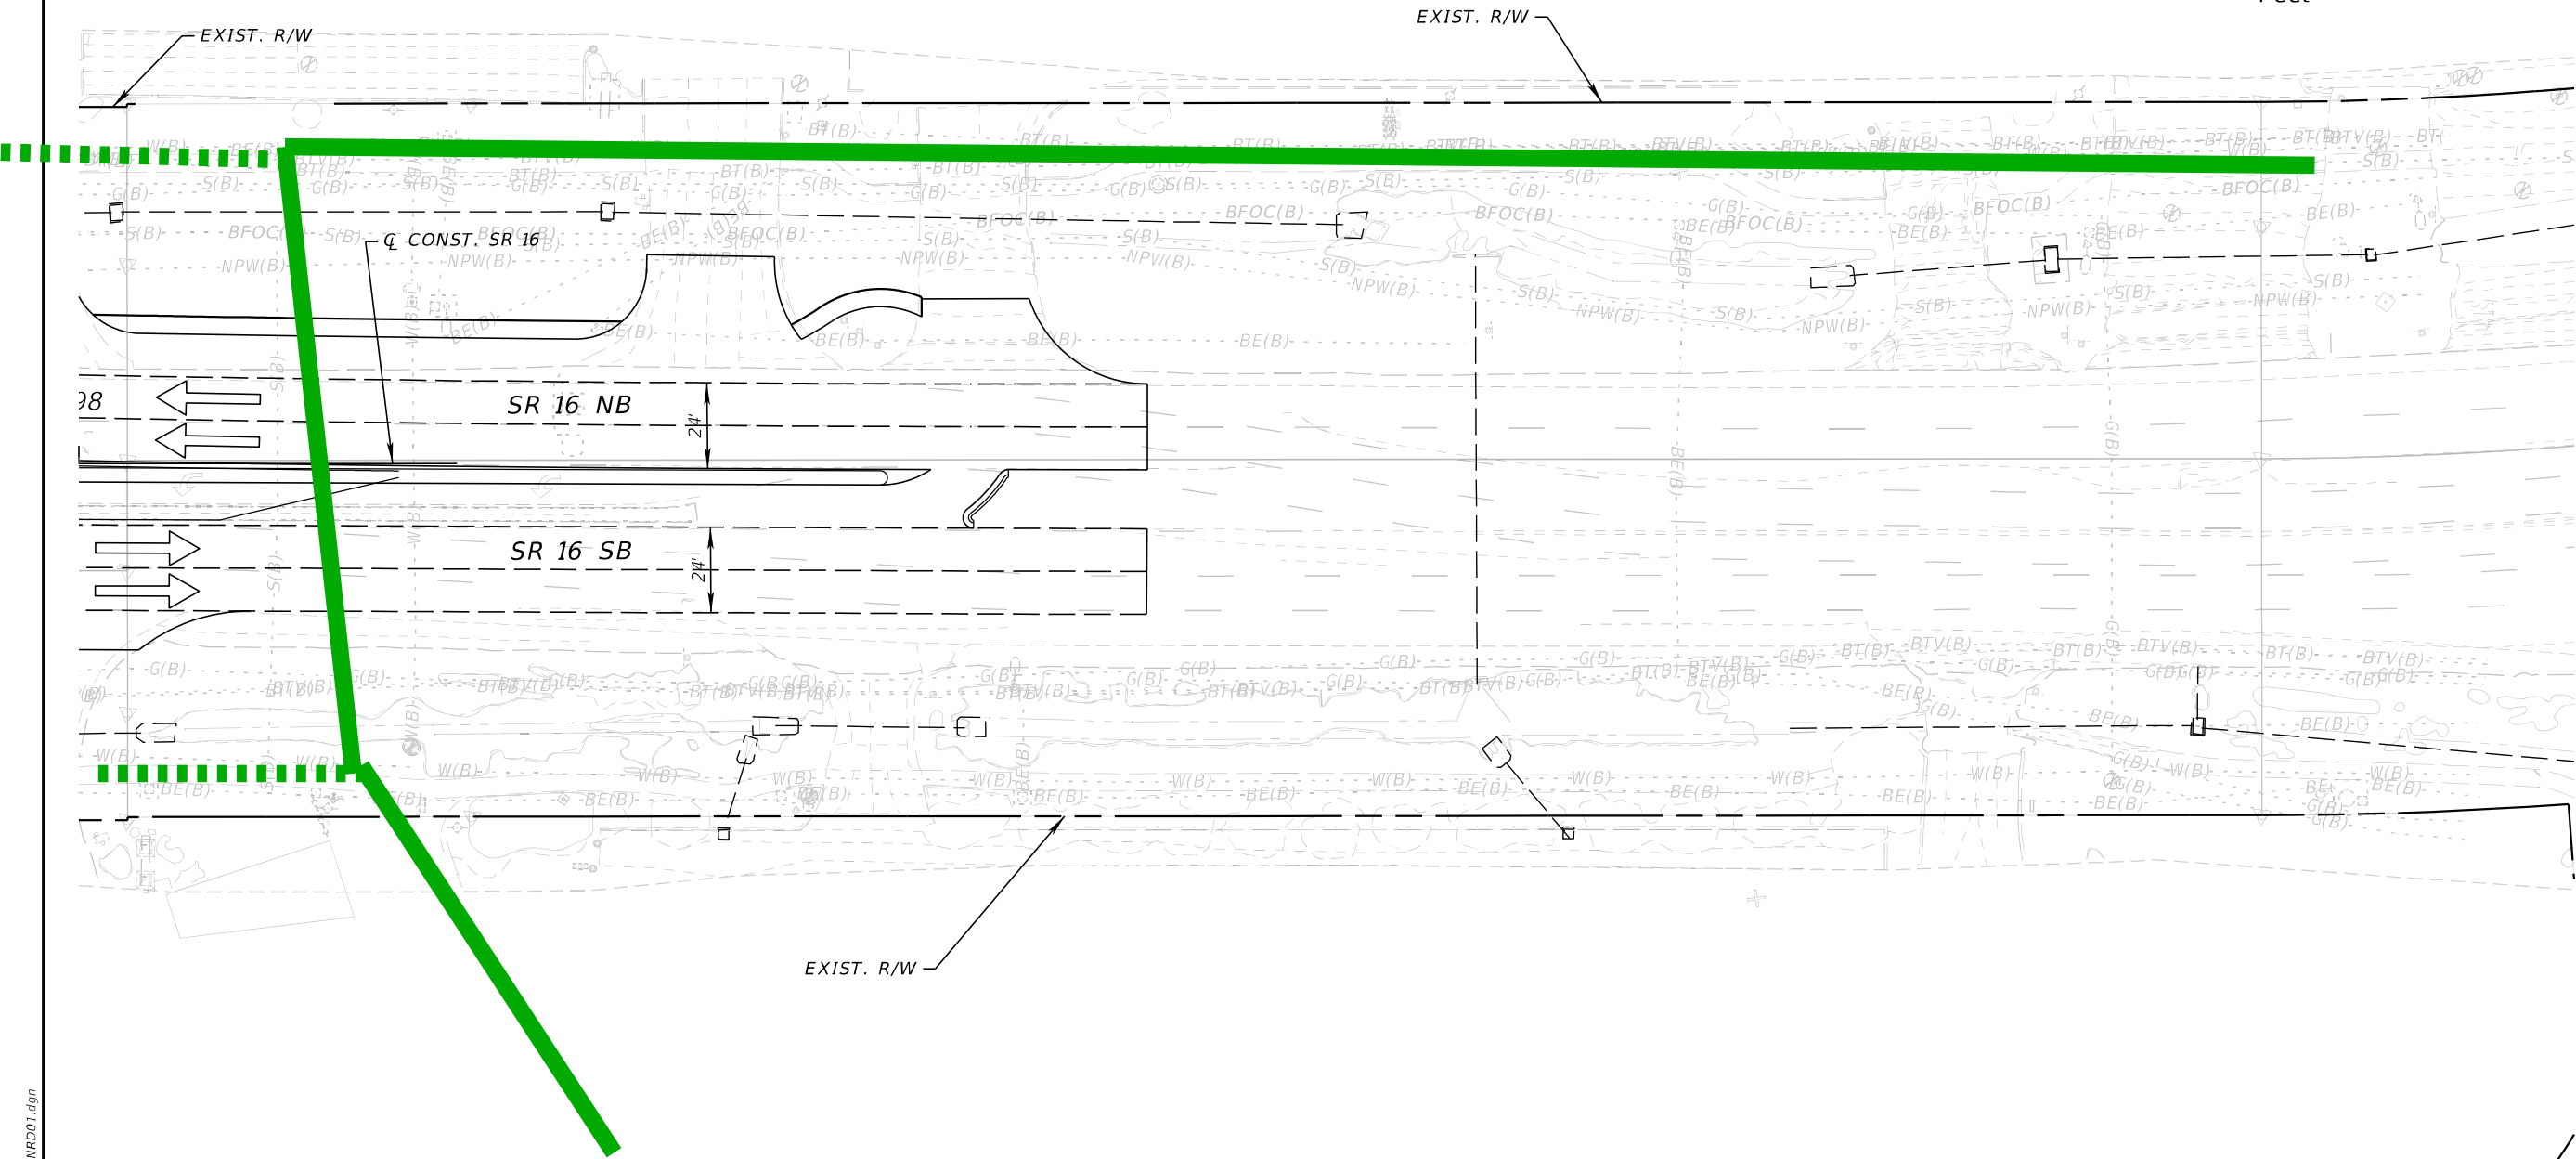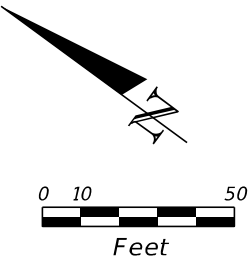

8/5/2024 4:29:05 PM BeattyM  
c:\pw\_work\ysh\_pw\pw\_user\0439575\PLANRD01.dgn

| REVISIONS |             |      |             | ENGINEER OF RECORD                                                                                                        |  |  | STATE OF FLORIDA<br>DEPARTMENT OF TRANSPORTATION |           |                      | SHEET<br>NO. |
|-----------|-------------|------|-------------|---------------------------------------------------------------------------------------------------------------------------|--|--|--------------------------------------------------|-----------|----------------------|--------------|
| DATE      | DESCRIPTION | DATE | DESCRIPTION | STEPHEN J. PARK, P.E.<br>LICENSE NUMBER: 77656<br>RS&H, INC.<br>10748 DEERWOOD PARK BLVD. SOUTH<br>JACKSONVILLE, FL 32256 |  |  | ROAD NO.                                         | COUNTY    | FINANCIAL PROJECT ID |              |
|           |             |      |             |                                                                                                                           |  |  | SR 16                                            | ST. JOHNS | 210447-5-52-01       |              |

THE OFFICIAL RECORD OF THIS SHEET IS THE ELECTRONIC FILE DIGITALLY SIGNED AND SEALED UNDER RULE 61G15-23.004, F.A.C.