

Florida Power & Light Distribution Forms and Figures





District 2 Utility Contact Form

Please Fill Out Completely

| | |
|--|--|
| Date: | 09/04/2024 |
| Company Name: | FLORIDA POWER & LIGHT |
| Phone Number: | 904-824-7659 |
| Email Address: | IVAN.GARCIA@FPL.COM |
| FPI: | 210447-5-52-01 SR16 St. Johns Co. Roadway Plan Sheets Dtd 8/5/24 Add Lanes/Reconstruct |
| Emergency number to be inserted on plans | 1-800-226-3545 |

Existing facilities are located:

- ☒ Within existing FDOT Right-of-Way (between Station: _____ to Station: _____)
- ☐ Within existing County/City Right-of-Way (between Station: _____ to Station: _____)
- ☐ Within railroad Right-of-Way (between Station: _____ to Station: _____)
- ☐ Within an easement or fee title property (Has compensable interest and may claim reimbursement for required relocation) *
- ☐ Not within project limits (Has no facilities within limits)
- ☐ No Utility Work Schedule (Has facilities within limits but is not affected)
- ☐ There will not be a claim for reimbursement
- ☐ There will be a claim for reimbursement *

* Please provide any document(s) [i.e. fee title property deed or easement document(s)] within the project limits that formulates the basis for your entitlement to be reimbursed for your utility work. NOTE: A preliminary cost estimate for any utility work within this entitled area is required.

Enclosed please find:

| | |
|--|--|
| <input checked="" type="checkbox"/> Marked Roadway Plans | <input type="checkbox"/> Company Utility Plans |
| <input type="checkbox"/> Legal Documents | <input type="checkbox"/> Preliminary Cost Estimate |

POLE OWNERS: List Joint Pole Users

COMMENTS:

Signed:



Title:

Ivan Garcia

FPL DISTRIBUTION FDOT COORDINATOR

(Signature is not required if uploading directly in PSEE)

210447-5 FDOT Plan Sheets (Roadway - Dtd 8/5/24) 081224

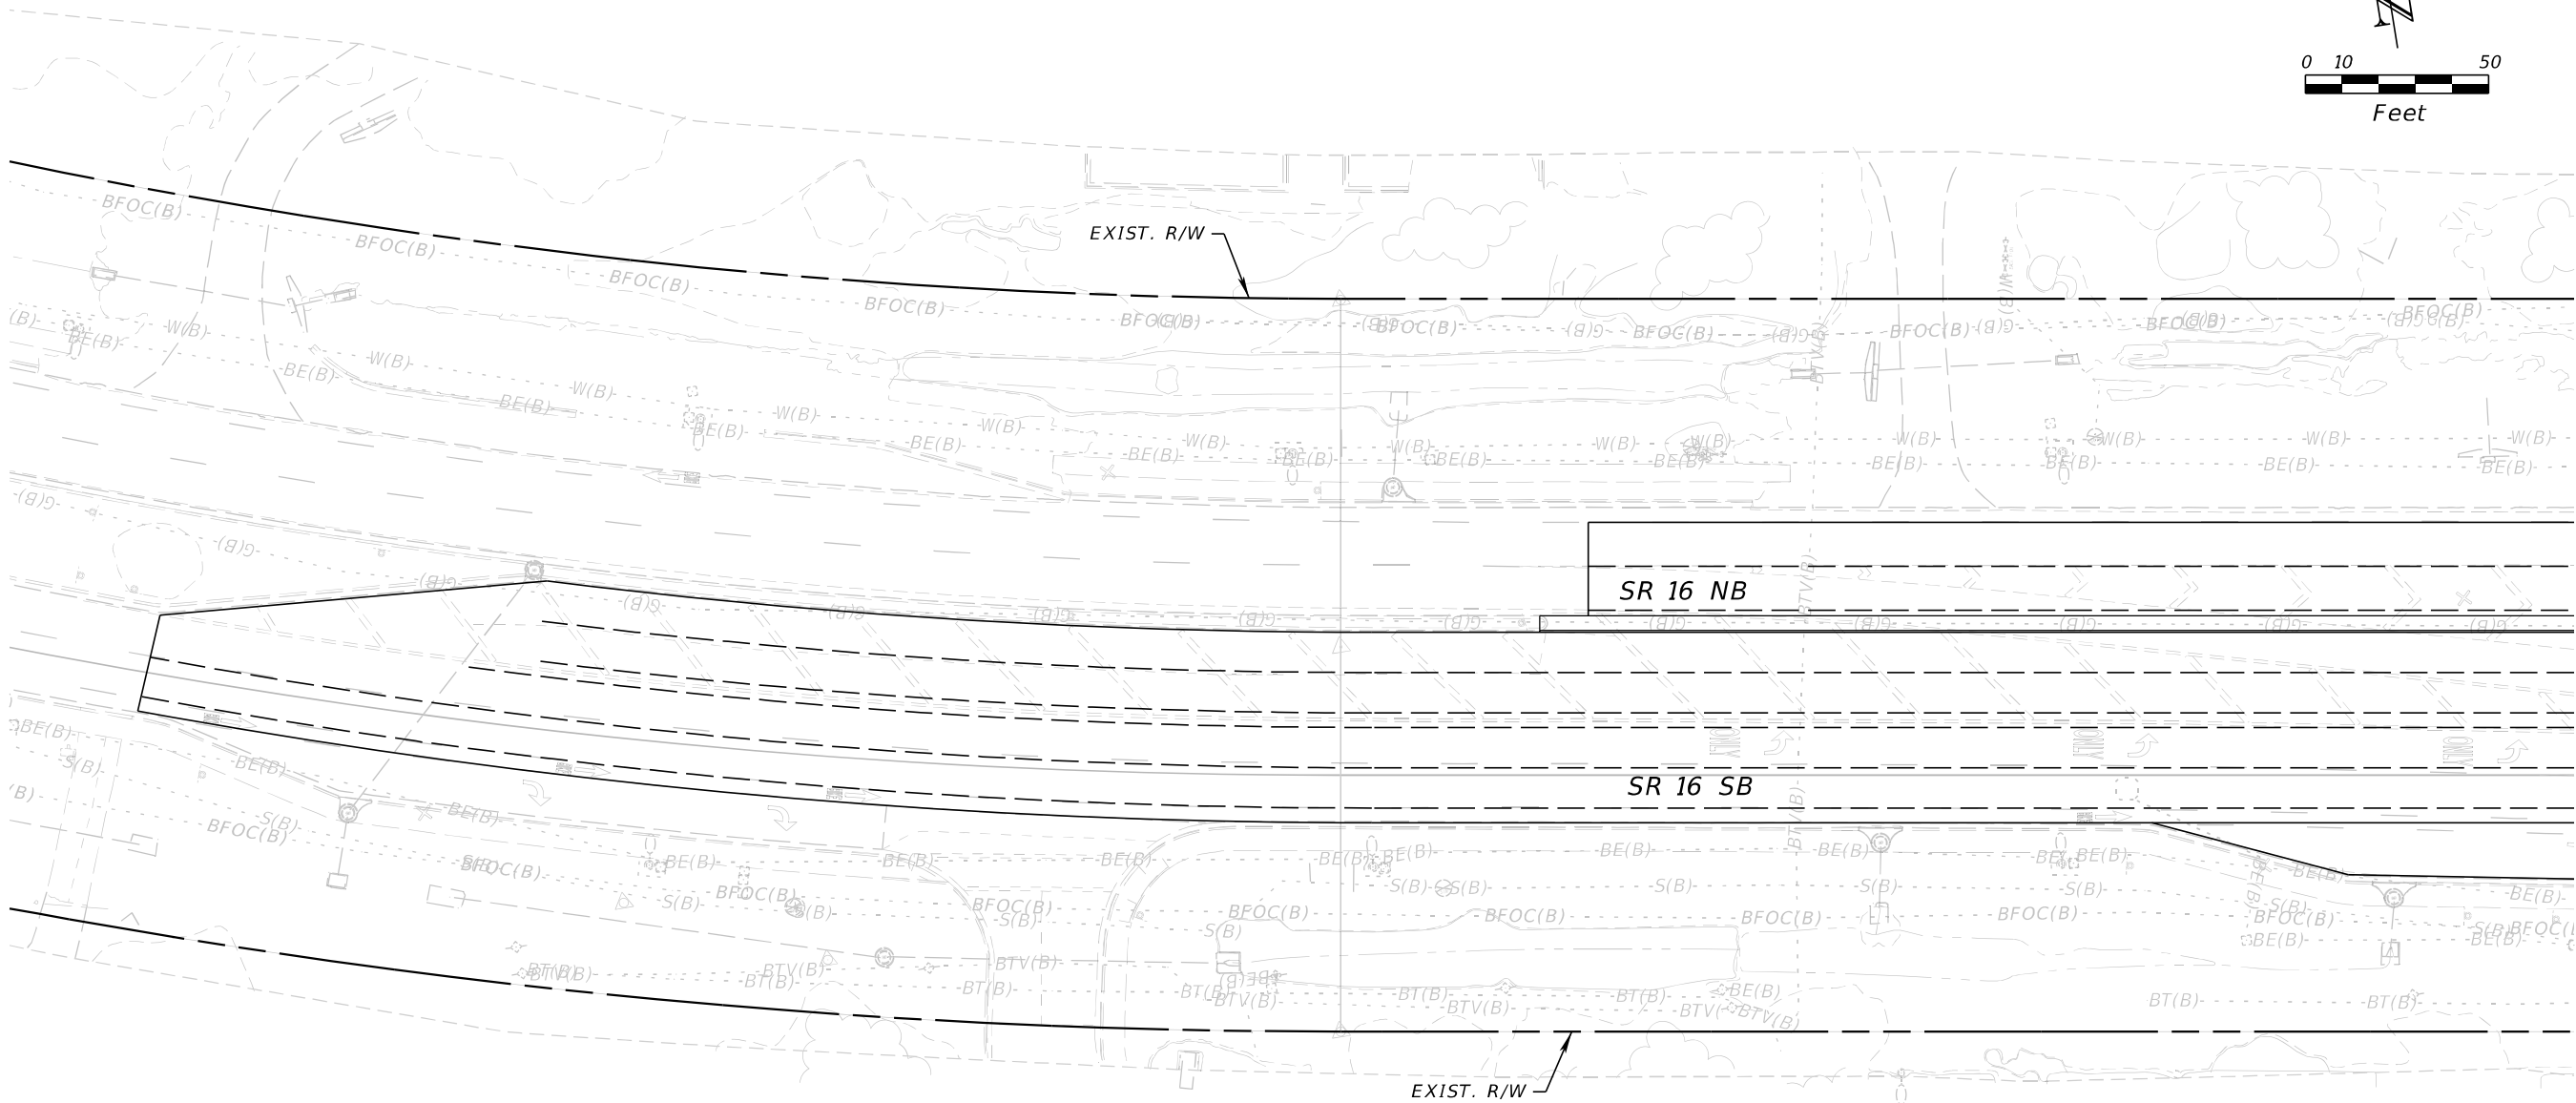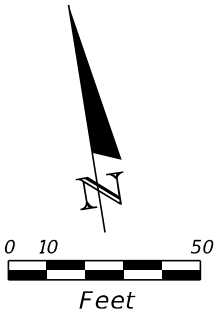

IVAN GARCIA
FPL DISTRIBUTION FDOT
COORDINATOR
904-824-7659
09/04/2024


OE UTILITIES NOT MARKED ON PLANS.
FPL MARKUPS ARE ESTIMATED BASED ON
PLAN SHEETS AND FPL GIS. IF ANY
CONFLICTS, PROVIDE CONFLICT MATRIX
OR SHOW OE ON 30% PLANS.

| REVISIONS | | | | ENGINEER OF RECORD | | STATE OF FLORIDA DEPARTMENT OF TRANSPORTATION | | | ROADWAY PLAN | SHEET NO. SR 16 - PLAN |
|-----------|-------------|------|-------------|---|--|--|-----------|----------------------|--------------|----------------------------------|
| DATE | DESCRIPTION | DATE | DESCRIPTION | STEPHEN J. PARK, P.E. LICENSE NUMBER: 77656 RS&H, INC. 10748 DEERWOOD PARK BLVD. SOUTH JACKSONVILLE, FL 32256 | | ROAD NO. | COUNTY | FINANCIAL PROJECT ID | | |
| | | | | | | SR 16 | ST. JOHNS | 210447-5-52-01 | | |

8/5/2024 4:28:36 PM BeattyM
c:\pw_work\ysh_pw\pw_user\0439575\PLANRD01.dgn

THE OFFICIAL RECORD OF THIS SHEET IS THE ELECTRONIC FILE DIGITALLY SIGNED AND SEALED UNDER RULE 61G15-23.004, F.A.C.


8/5/2024 4:28:37 PM BeattyM
c:\pw_work\ysh_pw\pw_user\00439575\PLANRD01.dgn

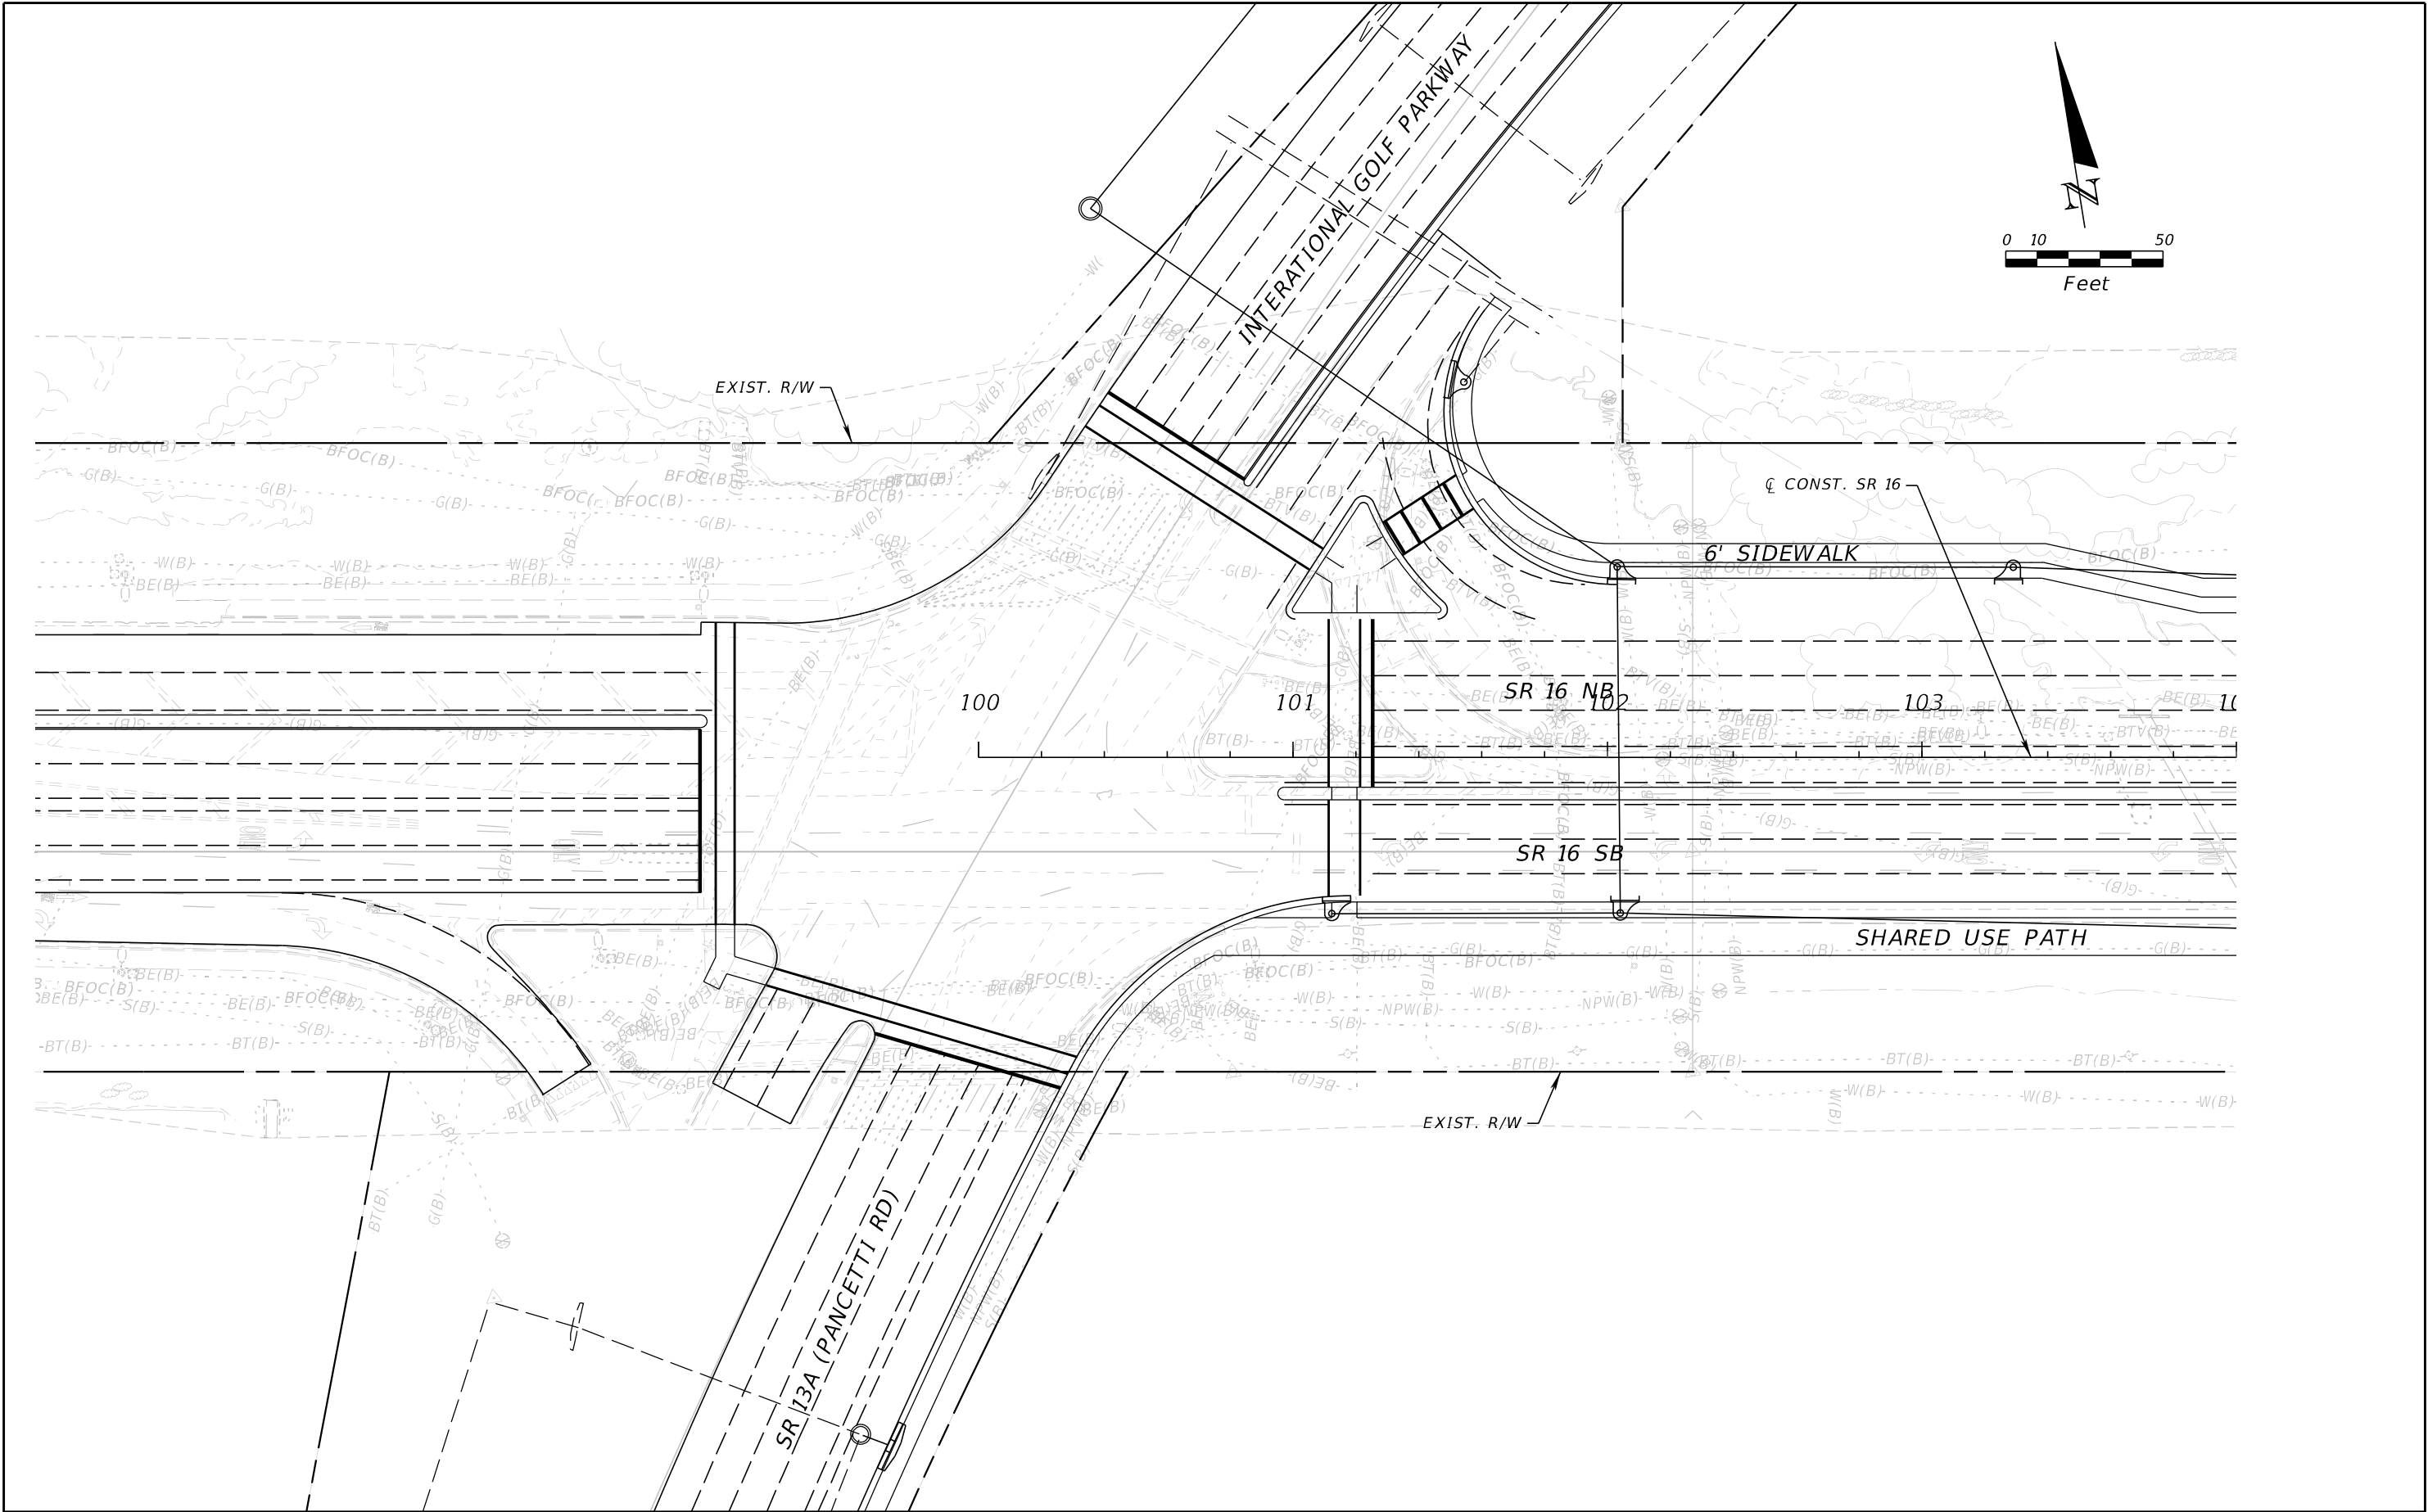

| REVISIONS | | | | ENGINEER OF RECORD | | STATE OF FLORIDA DEPARTMENT OF TRANSPORTATION | | | ROADWAY PLAN | SHEET NO. SR 16 - PLAN - 1 |
|-----------|-------------|------|-------------|---|--|--|-----------|----------------------|--------------|---|
| DATE | DESCRIPTION | DATE | DESCRIPTION | STEPHEN J. PARK, P.E. LICENSE NUMBER: 77656 RS&H, INC. 10748 DEERWOOD PARK BLVD. SOUTH JACKSONVILLE, FL 32256 | | ROAD NO. | COUNTY | FINANCIAL PROJECT ID | | |
| | | | | | | SR 16 | ST. JOHNS | 210447-5-52-01 | | |

THE OFFICIAL RECORD OF THIS SHEET IS THE ELECTRONIC FILE DIGITALLY SIGNED AND SEALED UNDER RULE 61G15-23.004, F.A.C.



8/5/2024 4:28:38 PM BeattyM
c:\pw_work\ysh_pw\pw_user\00439575\PLAINRD01.dgn

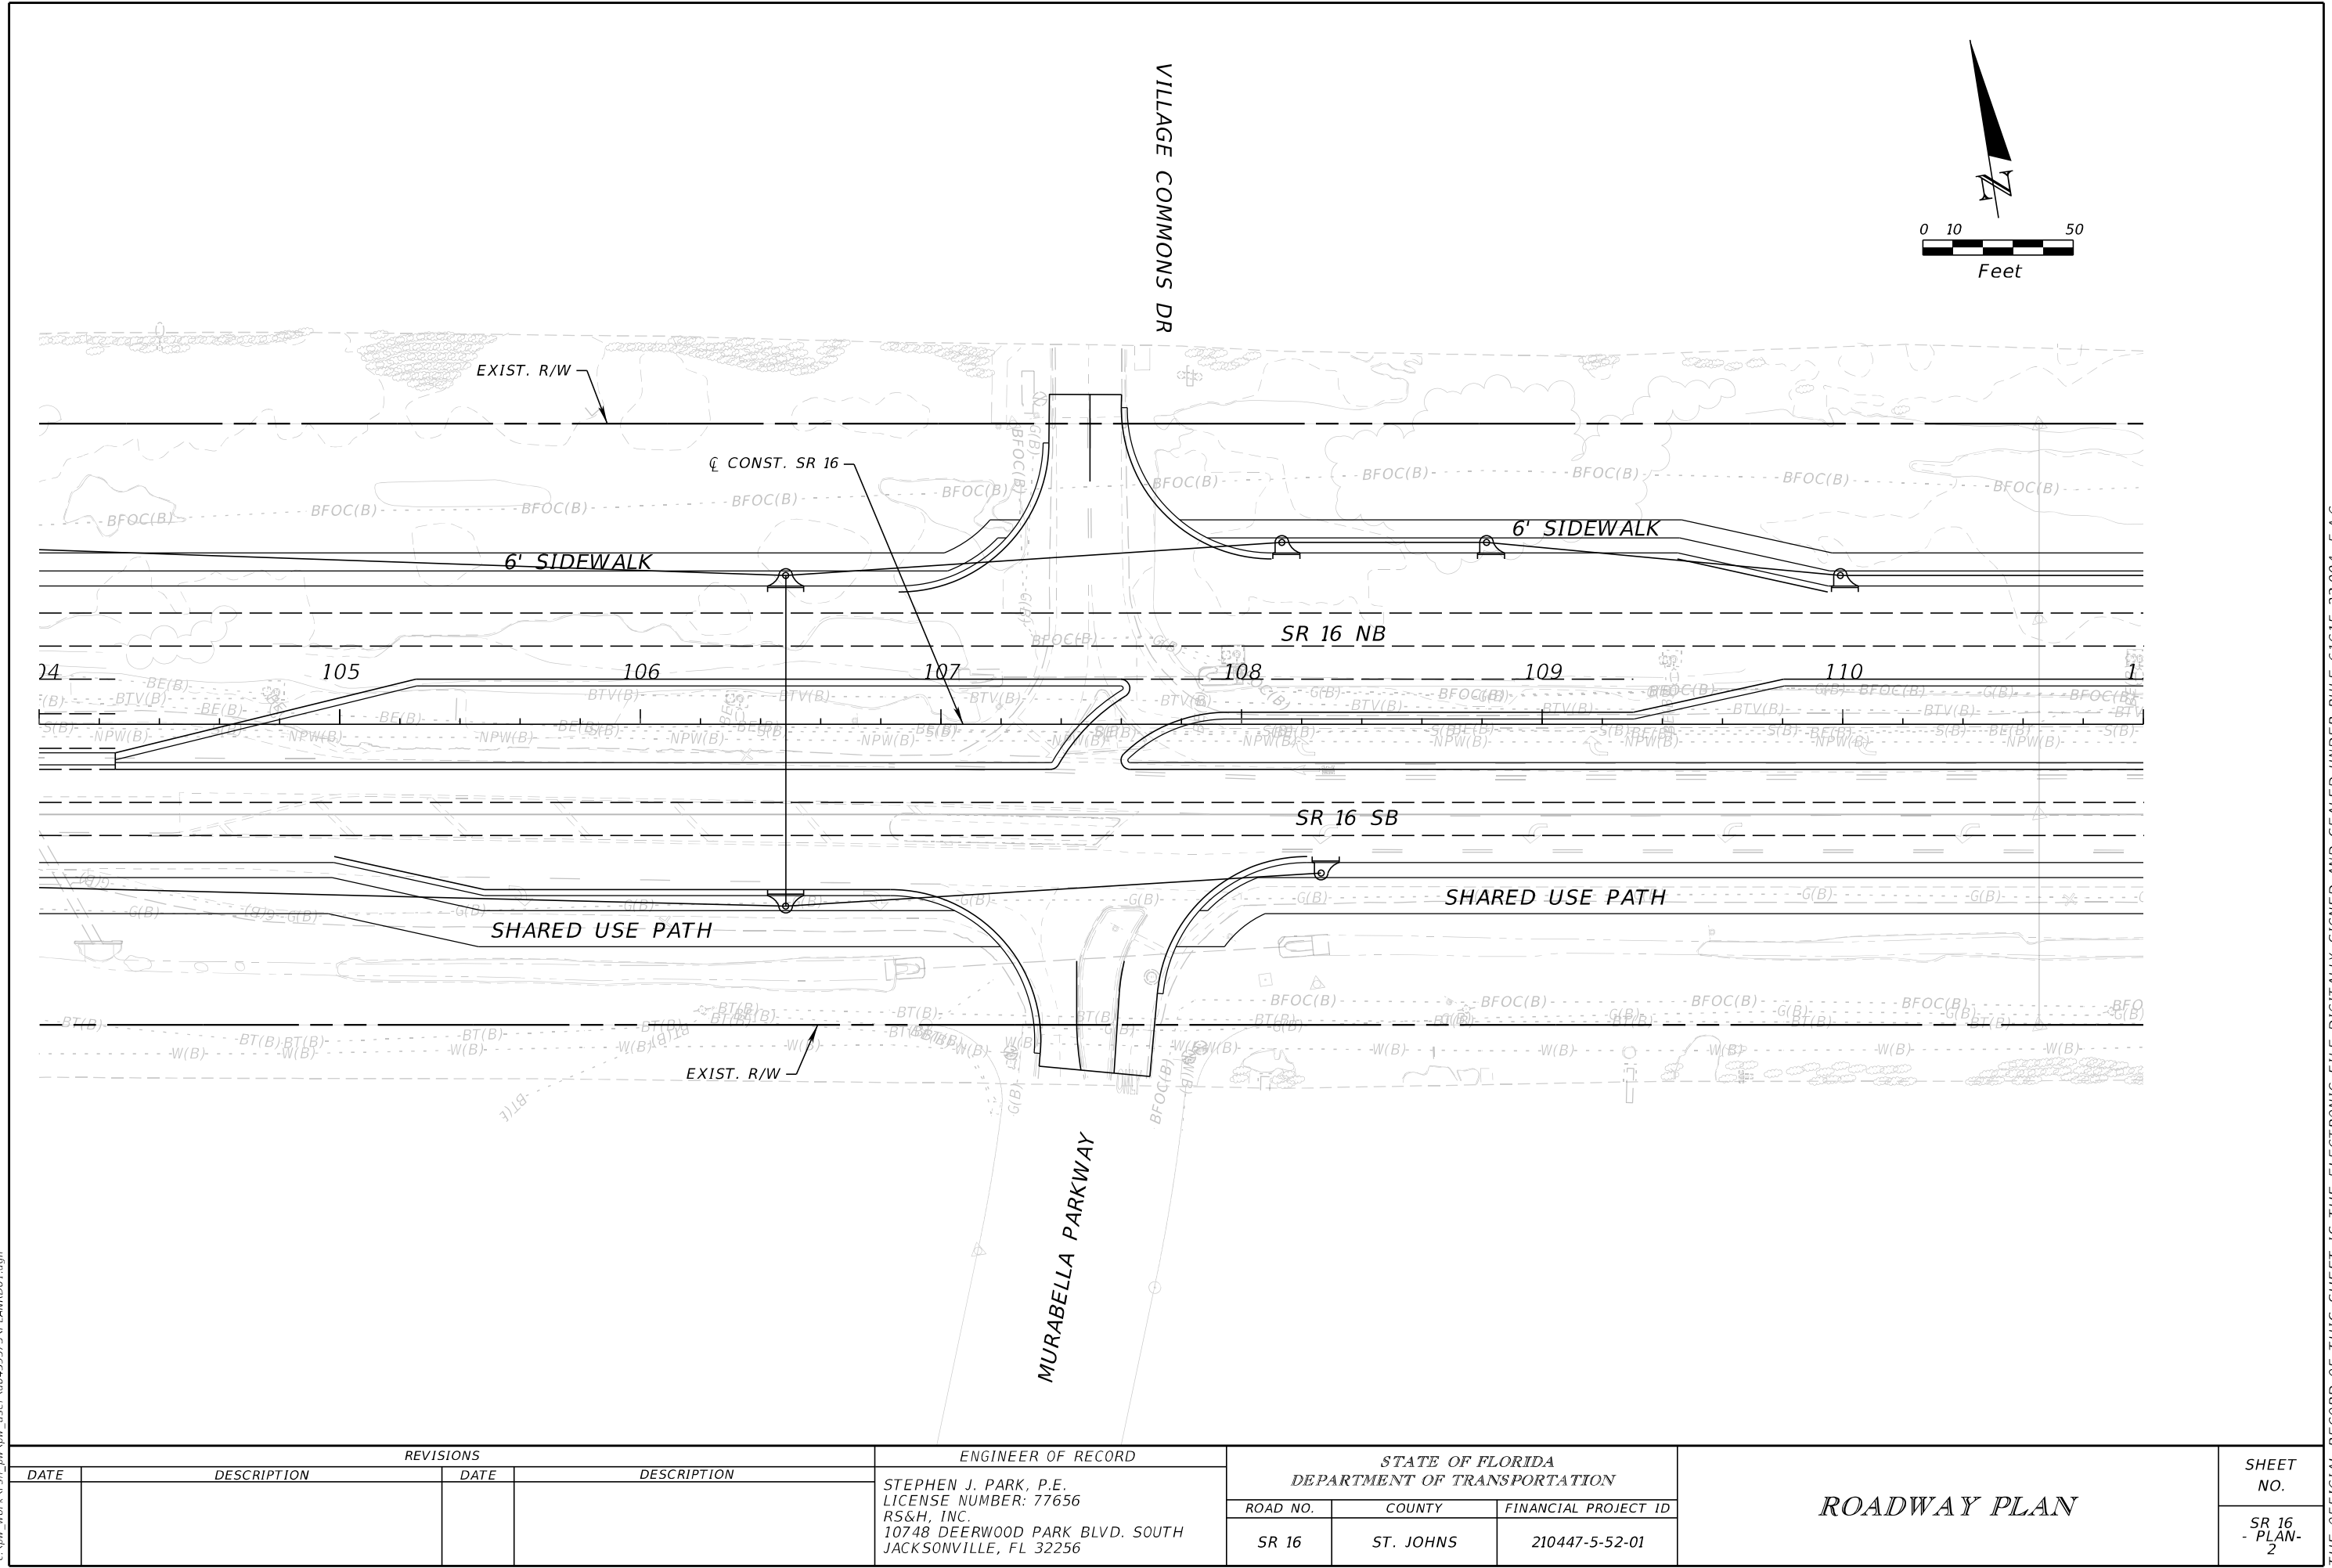

| REVISIONS | | | | ENGINEER OF RECORD | STATE OF FLORIDA DEPARTMENT OF TRANSPORTATION | | | ROADWAY PLAN | SHEET NO. |
|-----------|-------------|------|-------------|---|--|-----------|----------------------|--------------|------------------------|
| DATE | DESCRIPTION | DATE | DESCRIPTION | STEPHEN J. PARK, P.E. LICENSE NUMBER: 77656 RS&H, INC. 10748 DEERWOOD PARK BLVD. SOUTH JACKSONVILLE, FL 32256 | ROAD NO. | COUNTY | FINANCIAL PROJECT ID | | SR 16 - PLAN - 2 |
| | | | | | SR 16 | ST. JOHNS | 210447-5-52-01 | | |

THE OFFICIAL RECORD OF THIS SHEET IS THE ELECTRONIC FILE DIGITALLY SIGNED AND SEALED UNDER RULE 61G15-23.004, F.A.C.


8/5/2024 4:28:39 PM BeattyM
c:\pw_work\ysh_pw\pw_user\00439575\PLANRD01.dgn

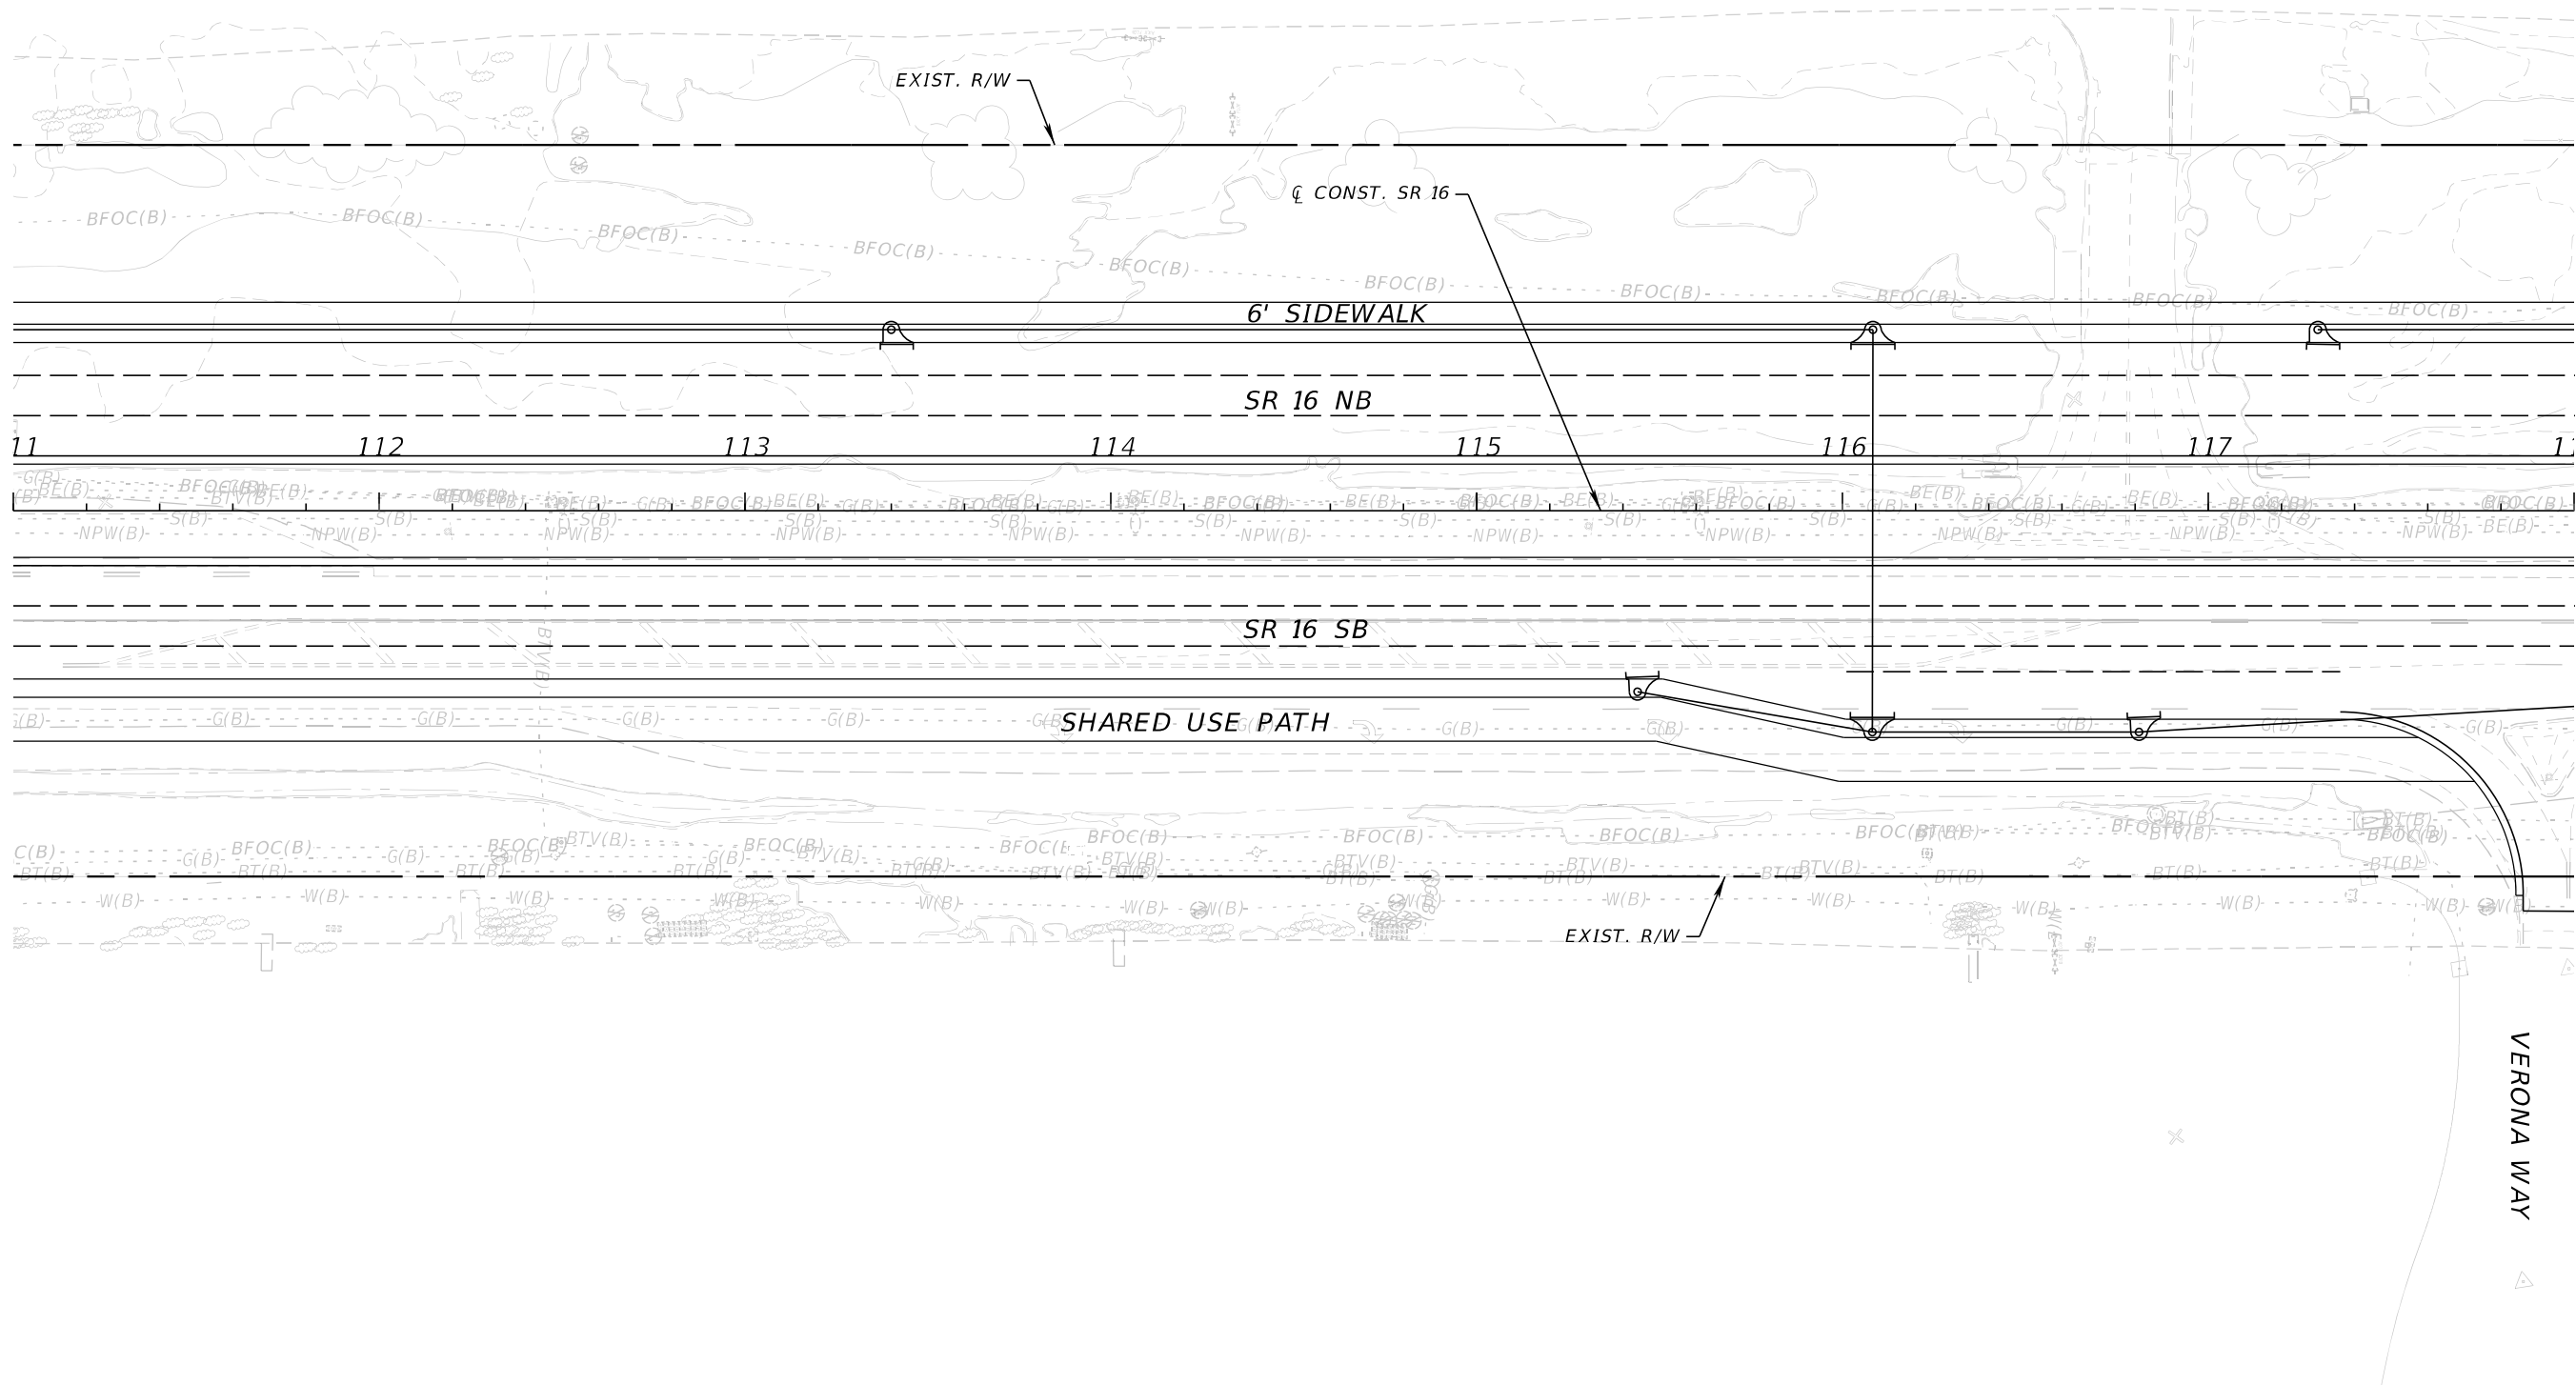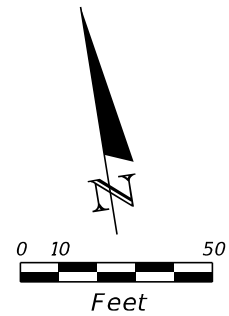

| REVISIONS | | | | ENGINEER OF RECORD | | STATE OF FLORIDA DEPARTMENT OF TRANSPORTATION | | | SHEET NO. |
|-----------|-------------|------|-------------|---|--|--|-----------|----------------------|--------------|
| DATE | DESCRIPTION | DATE | DESCRIPTION | STEPHEN J. PARK, P.E. LICENSE NUMBER: 77656 RS&H, INC. 10748 DEERWOOD PARK BLVD. SOUTH JACKSONVILLE, FL 32256 | | ROAD NO. | COUNTY | FINANCIAL PROJECT ID | |
| | | | | | | SR 16 | ST. JOHNS | 210447-5-52-01 | |

THE OFFICIAL RECORD OF THIS SHEET IS THE ELECTRONIC FILE DIGITALLY SIGNED AND SEALED UNDER RULE 61G15-23.004, F.A.C.



8/5/2024 4:28:40 PM BeattyM
c:\pw_work\ysh_pw\pw_user\00439575\PLANRD01.dgn

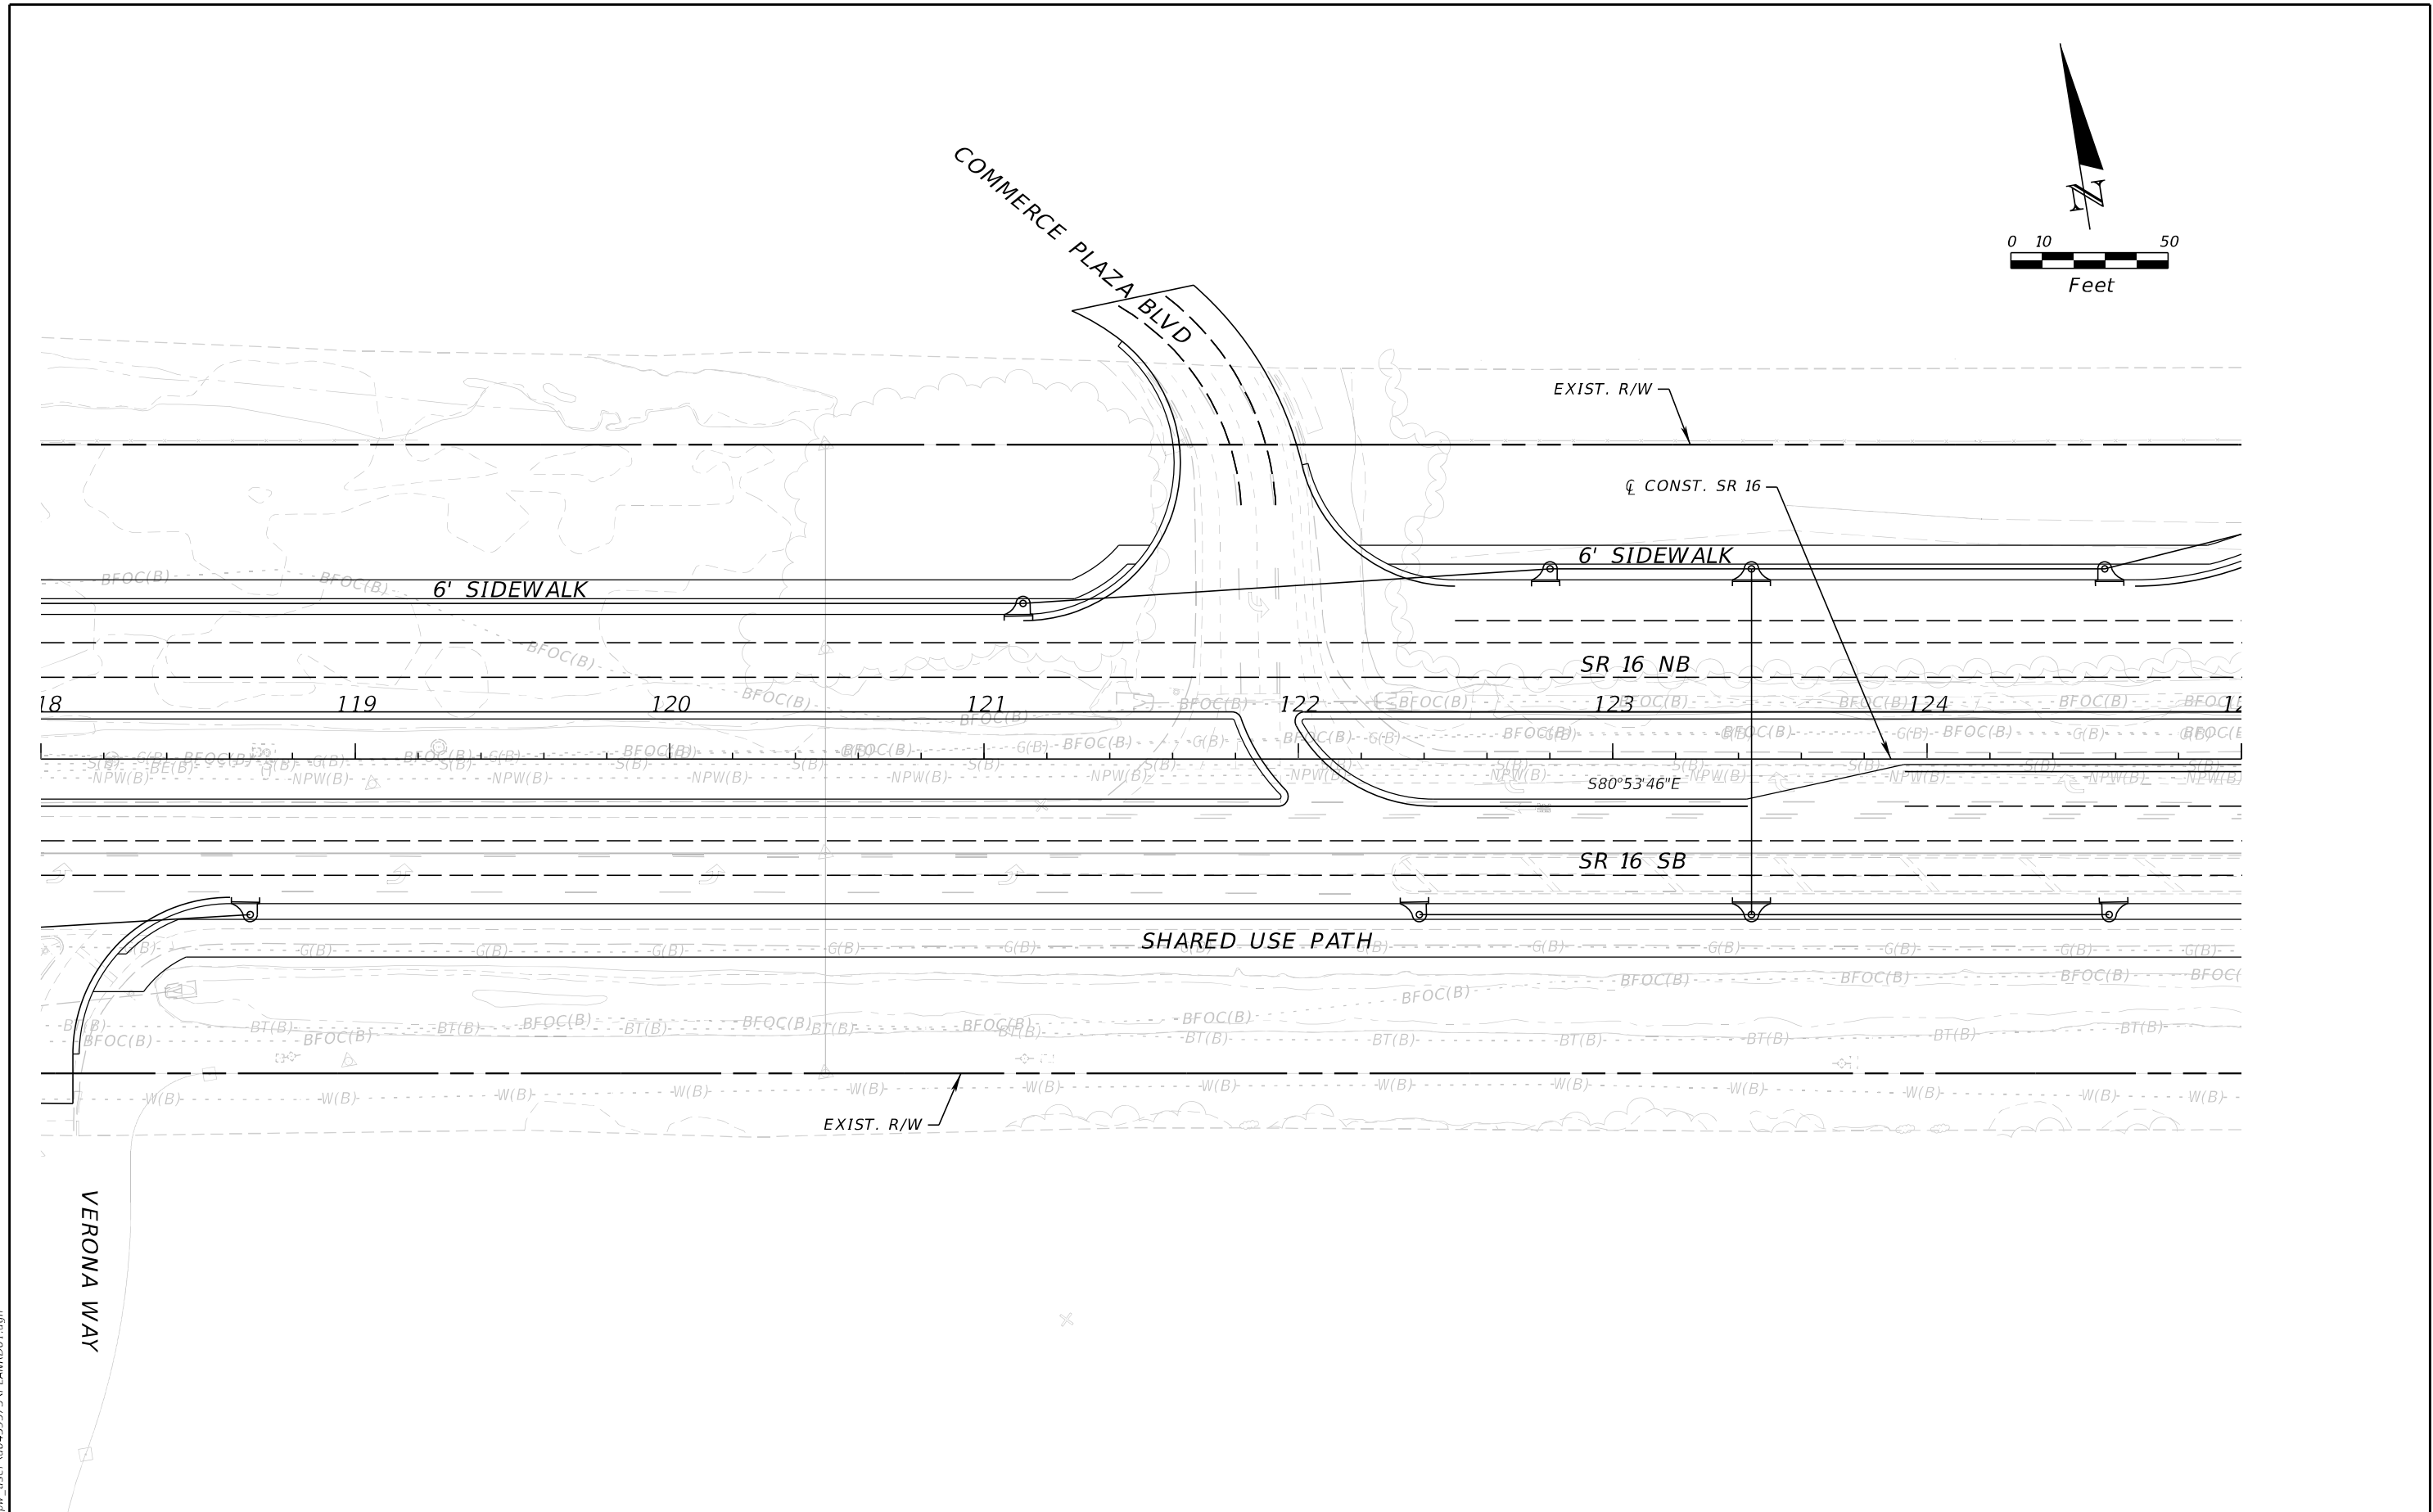

| REVISIONS | | | | ENGINEER OF RECORD | STATE OF FLORIDA DEPARTMENT OF TRANSPORTATION | | | ROADWAY PLAN | SHEET NO. |
|-----------|-------------|------|-------------|--------------------|--|-----------|----------------------|--------------|-----------------------|
| DATE | DESCRIPTION | DATE | DESCRIPTION | | ROAD NO. | COUNTY | FINANCIAL PROJECT ID | | |
| | | | | | SR 16 | ST. JOHNS | 210447-5-52-01 | | SR 16 - PLAN- 4 |

THE OFFICIAL RECORD OF THIS SHEET IS THE ELECTRONIC FILE DIGITALLY SIGNED AND SEALED UNDER RULE 61G15-23.004, F.A.C.


8/5/2024 4:28:40 PM BeattyM
c:\pw_work\sh_pw\pw_user\0439575\PLANRD01.dgn

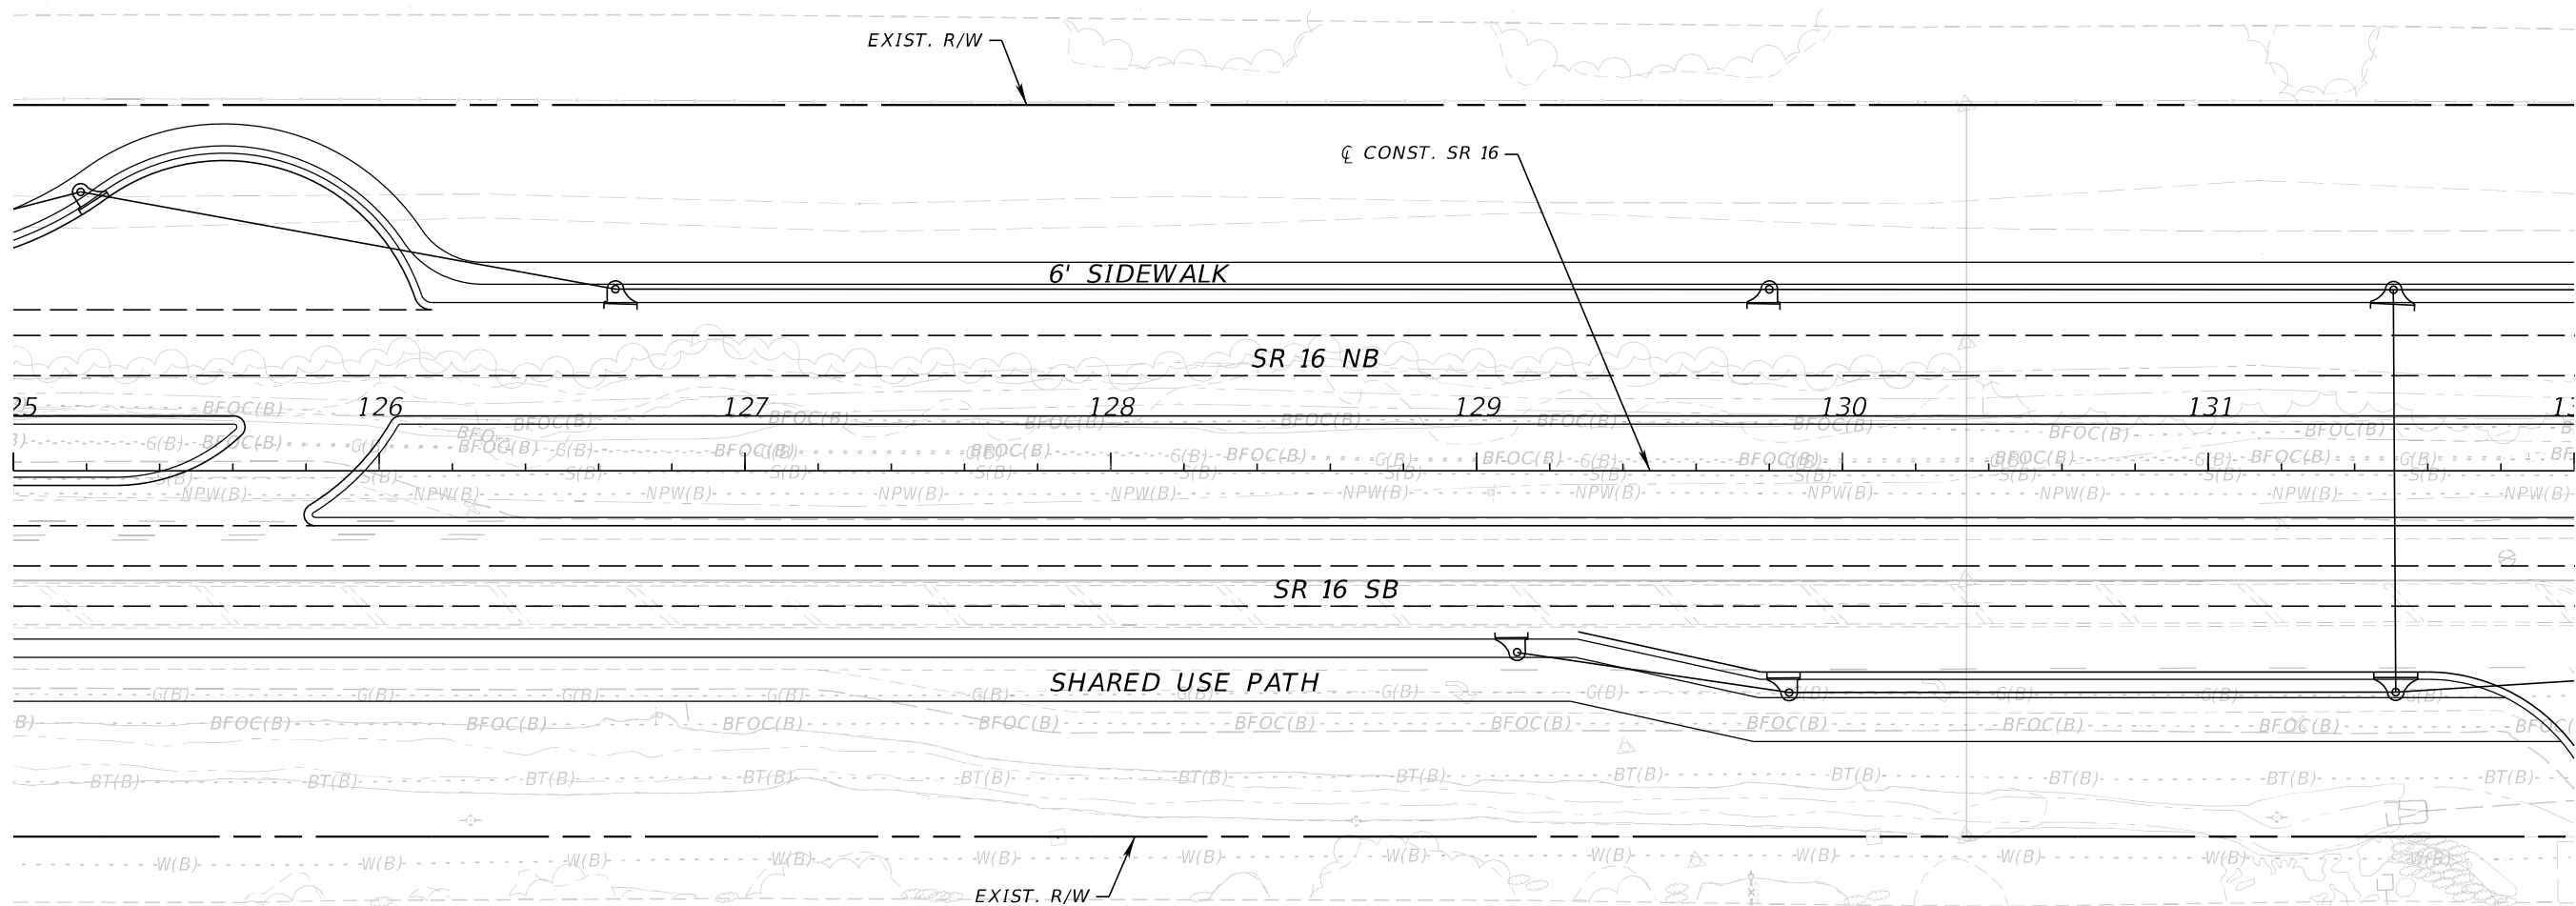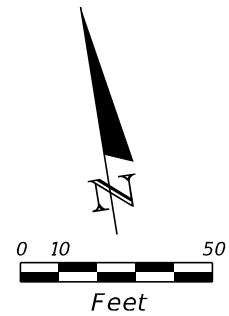

| REVISIONS | | | | ENGINEER OF RECORD | | STATE OF FLORIDA DEPARTMENT OF TRANSPORTATION | | | ROADWAY PLAN | SHEET NO. SR 16 - PLAN - 5 |
|-----------|-------------|------|-------------|---|--|--|-----------|----------------------|--------------|--|
| DATE | DESCRIPTION | DATE | DESCRIPTION | STEPHEN J. PARK, P.E. LICENSE NUMBER: 77656 RS&H, INC. 10748 DEERWOOD PARK BLVD. SOUTH JACKSONVILLE, FL 32256 | | ROAD NO. | COUNTY | FINANCIAL PROJECT ID | | |
| | | | | | | SR 16 | ST. JOHNS | 210447-5-52-01 | | |

THE OFFICIAL RECORD OF THIS SHEET IS THE ELECTRONIC FILE DIGITALLY SIGNED AND SEALED UNDER RULE 61G15-23.004, F.A.C.


8/5/2024 4:28:41 PM BeattyM
c:\pw_work\ysh_pw\pw_user\00439575\PLANRD01.dgn

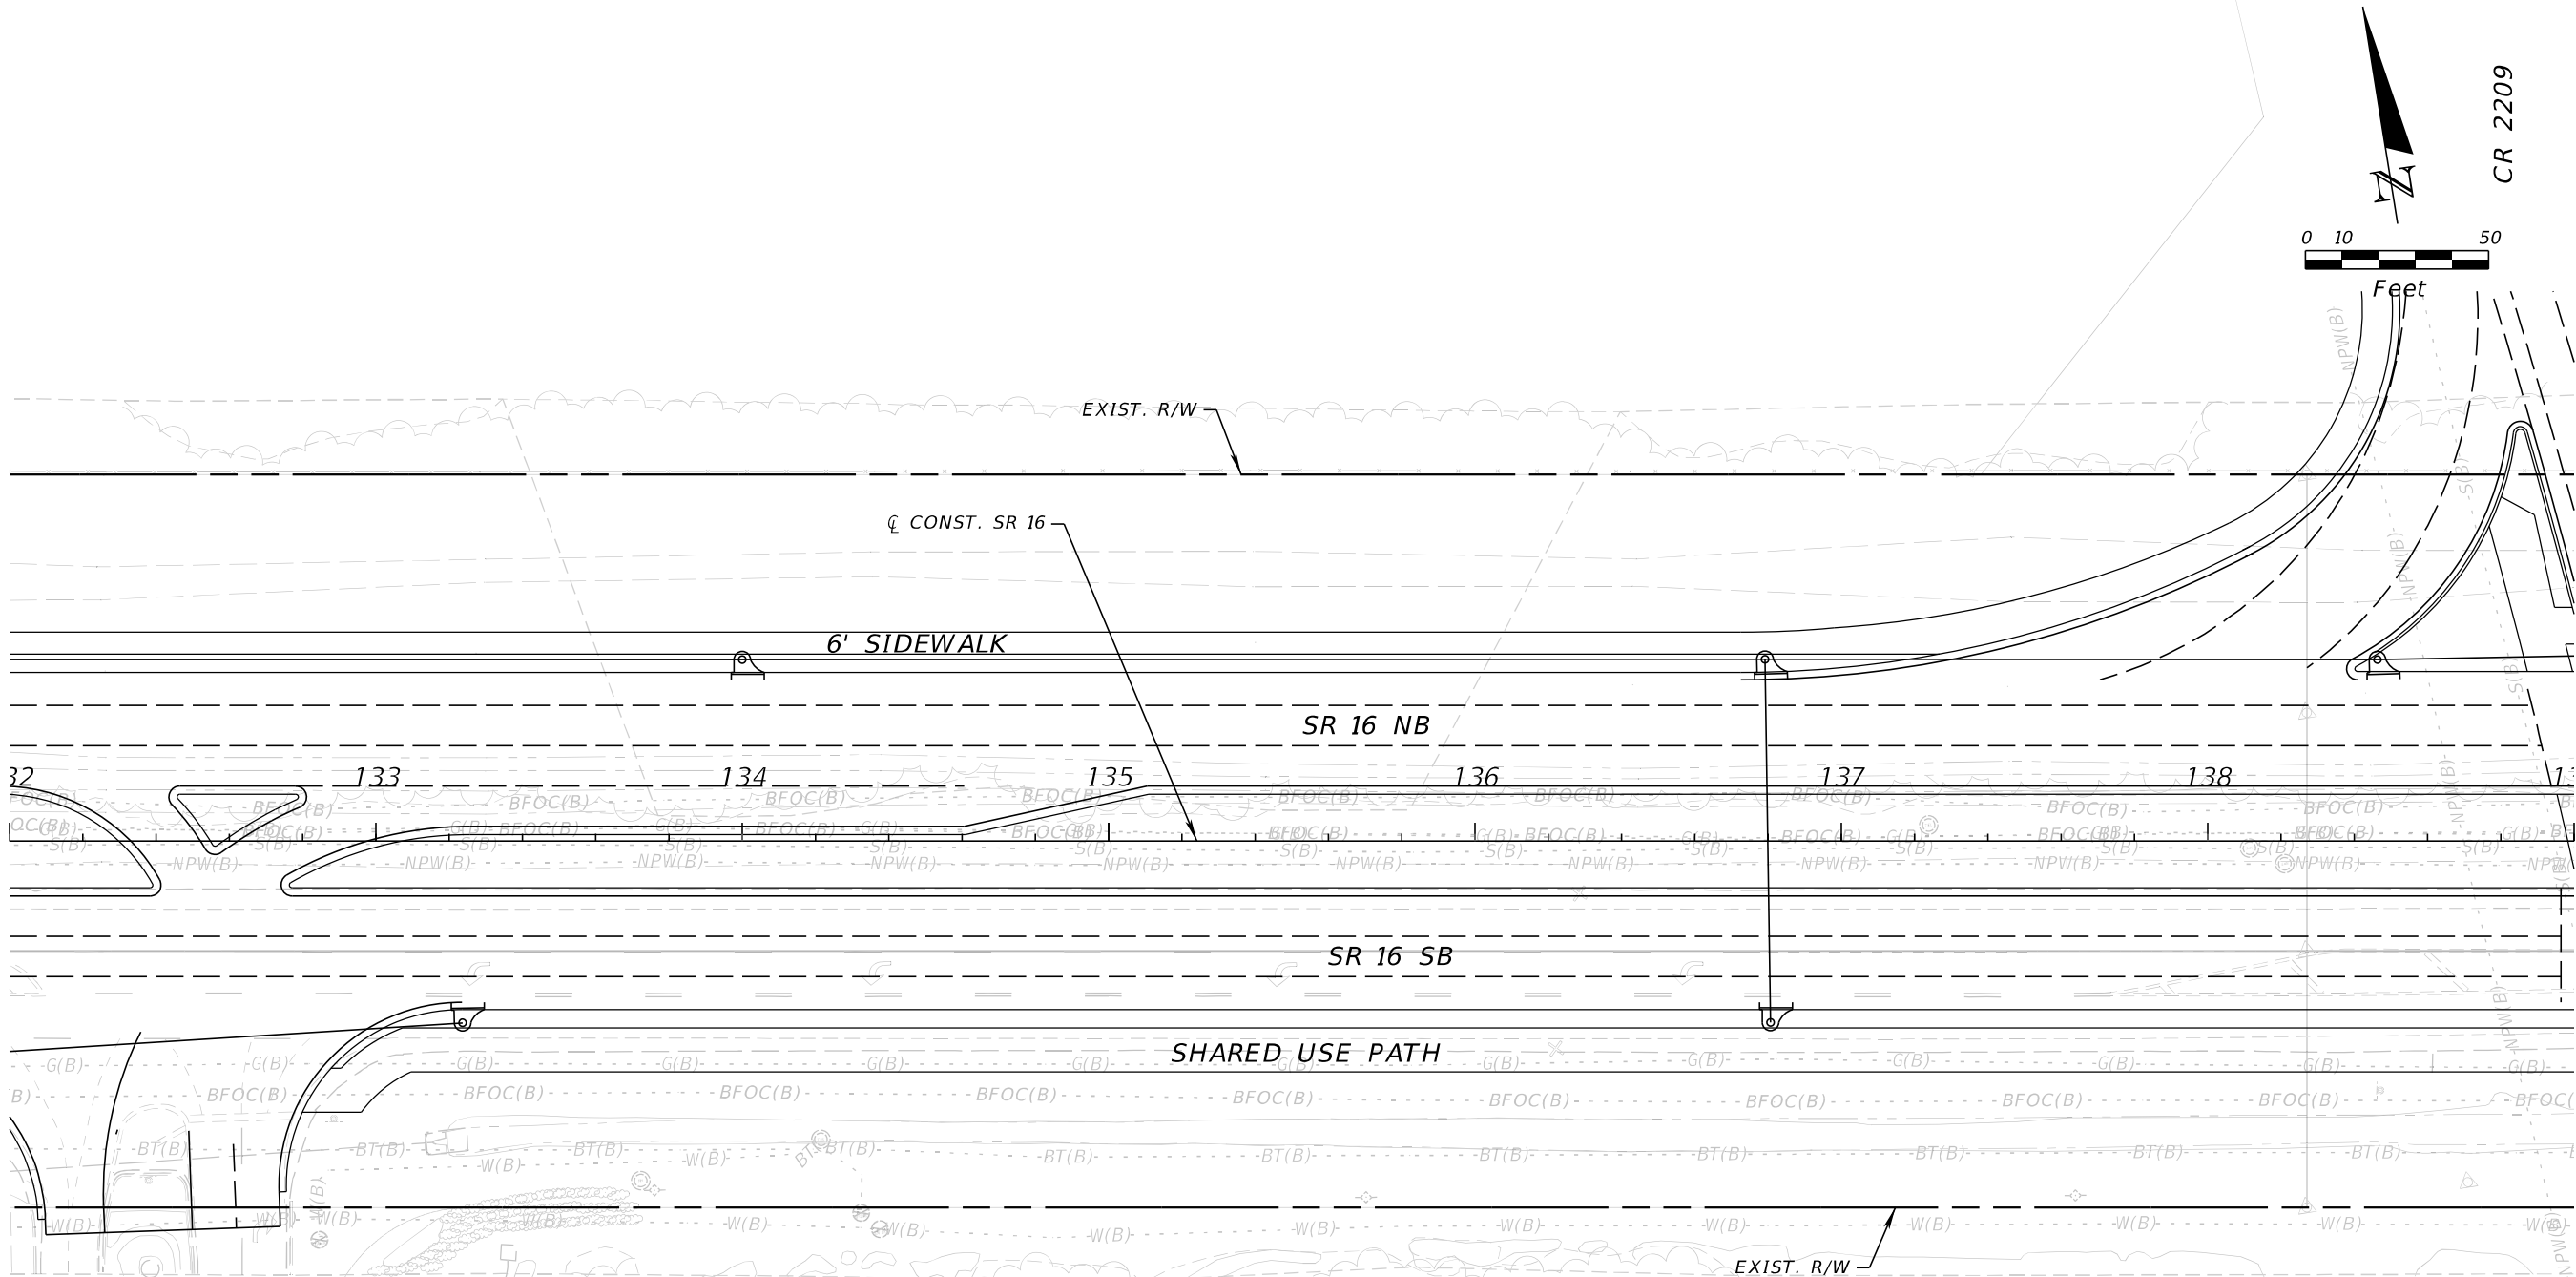

| REVISIONS | | | | ENGINEER OF RECORD | | STATE OF FLORIDA DEPARTMENT OF TRANSPORTATION | | | ROADWAY PLAN | SHEET NO. SR 16 - PLAN - 6 |
|-----------|-------------|------|-------------|---|--|--|-----------|----------------------|--------------|--|
| DATE | DESCRIPTION | DATE | DESCRIPTION | STEPHEN J. PARK, P.E. LICENSE NUMBER: 77656 RS&H, INC. 10748 DEERWOOD PARK BLVD. SOUTH JACKSONVILLE, FL 32256 | | ROAD NO. | COUNTY | FINANCIAL PROJECT ID | | |
| | | | | | | SR 16 | ST. JOHNS | 210447-5-52-01 | | |

THE OFFICIAL RECORD OF THIS SHEET IS THE ELECTRONIC FILE DIGITALLY SIGNED AND SEALED UNDER RULE 61G15-23.004, F.A.C.


8/5/2024 4:28:42 PM BeattyM
c:\pw_work\sh_pw\pw_user\00439575\PLAINRD01.dgn

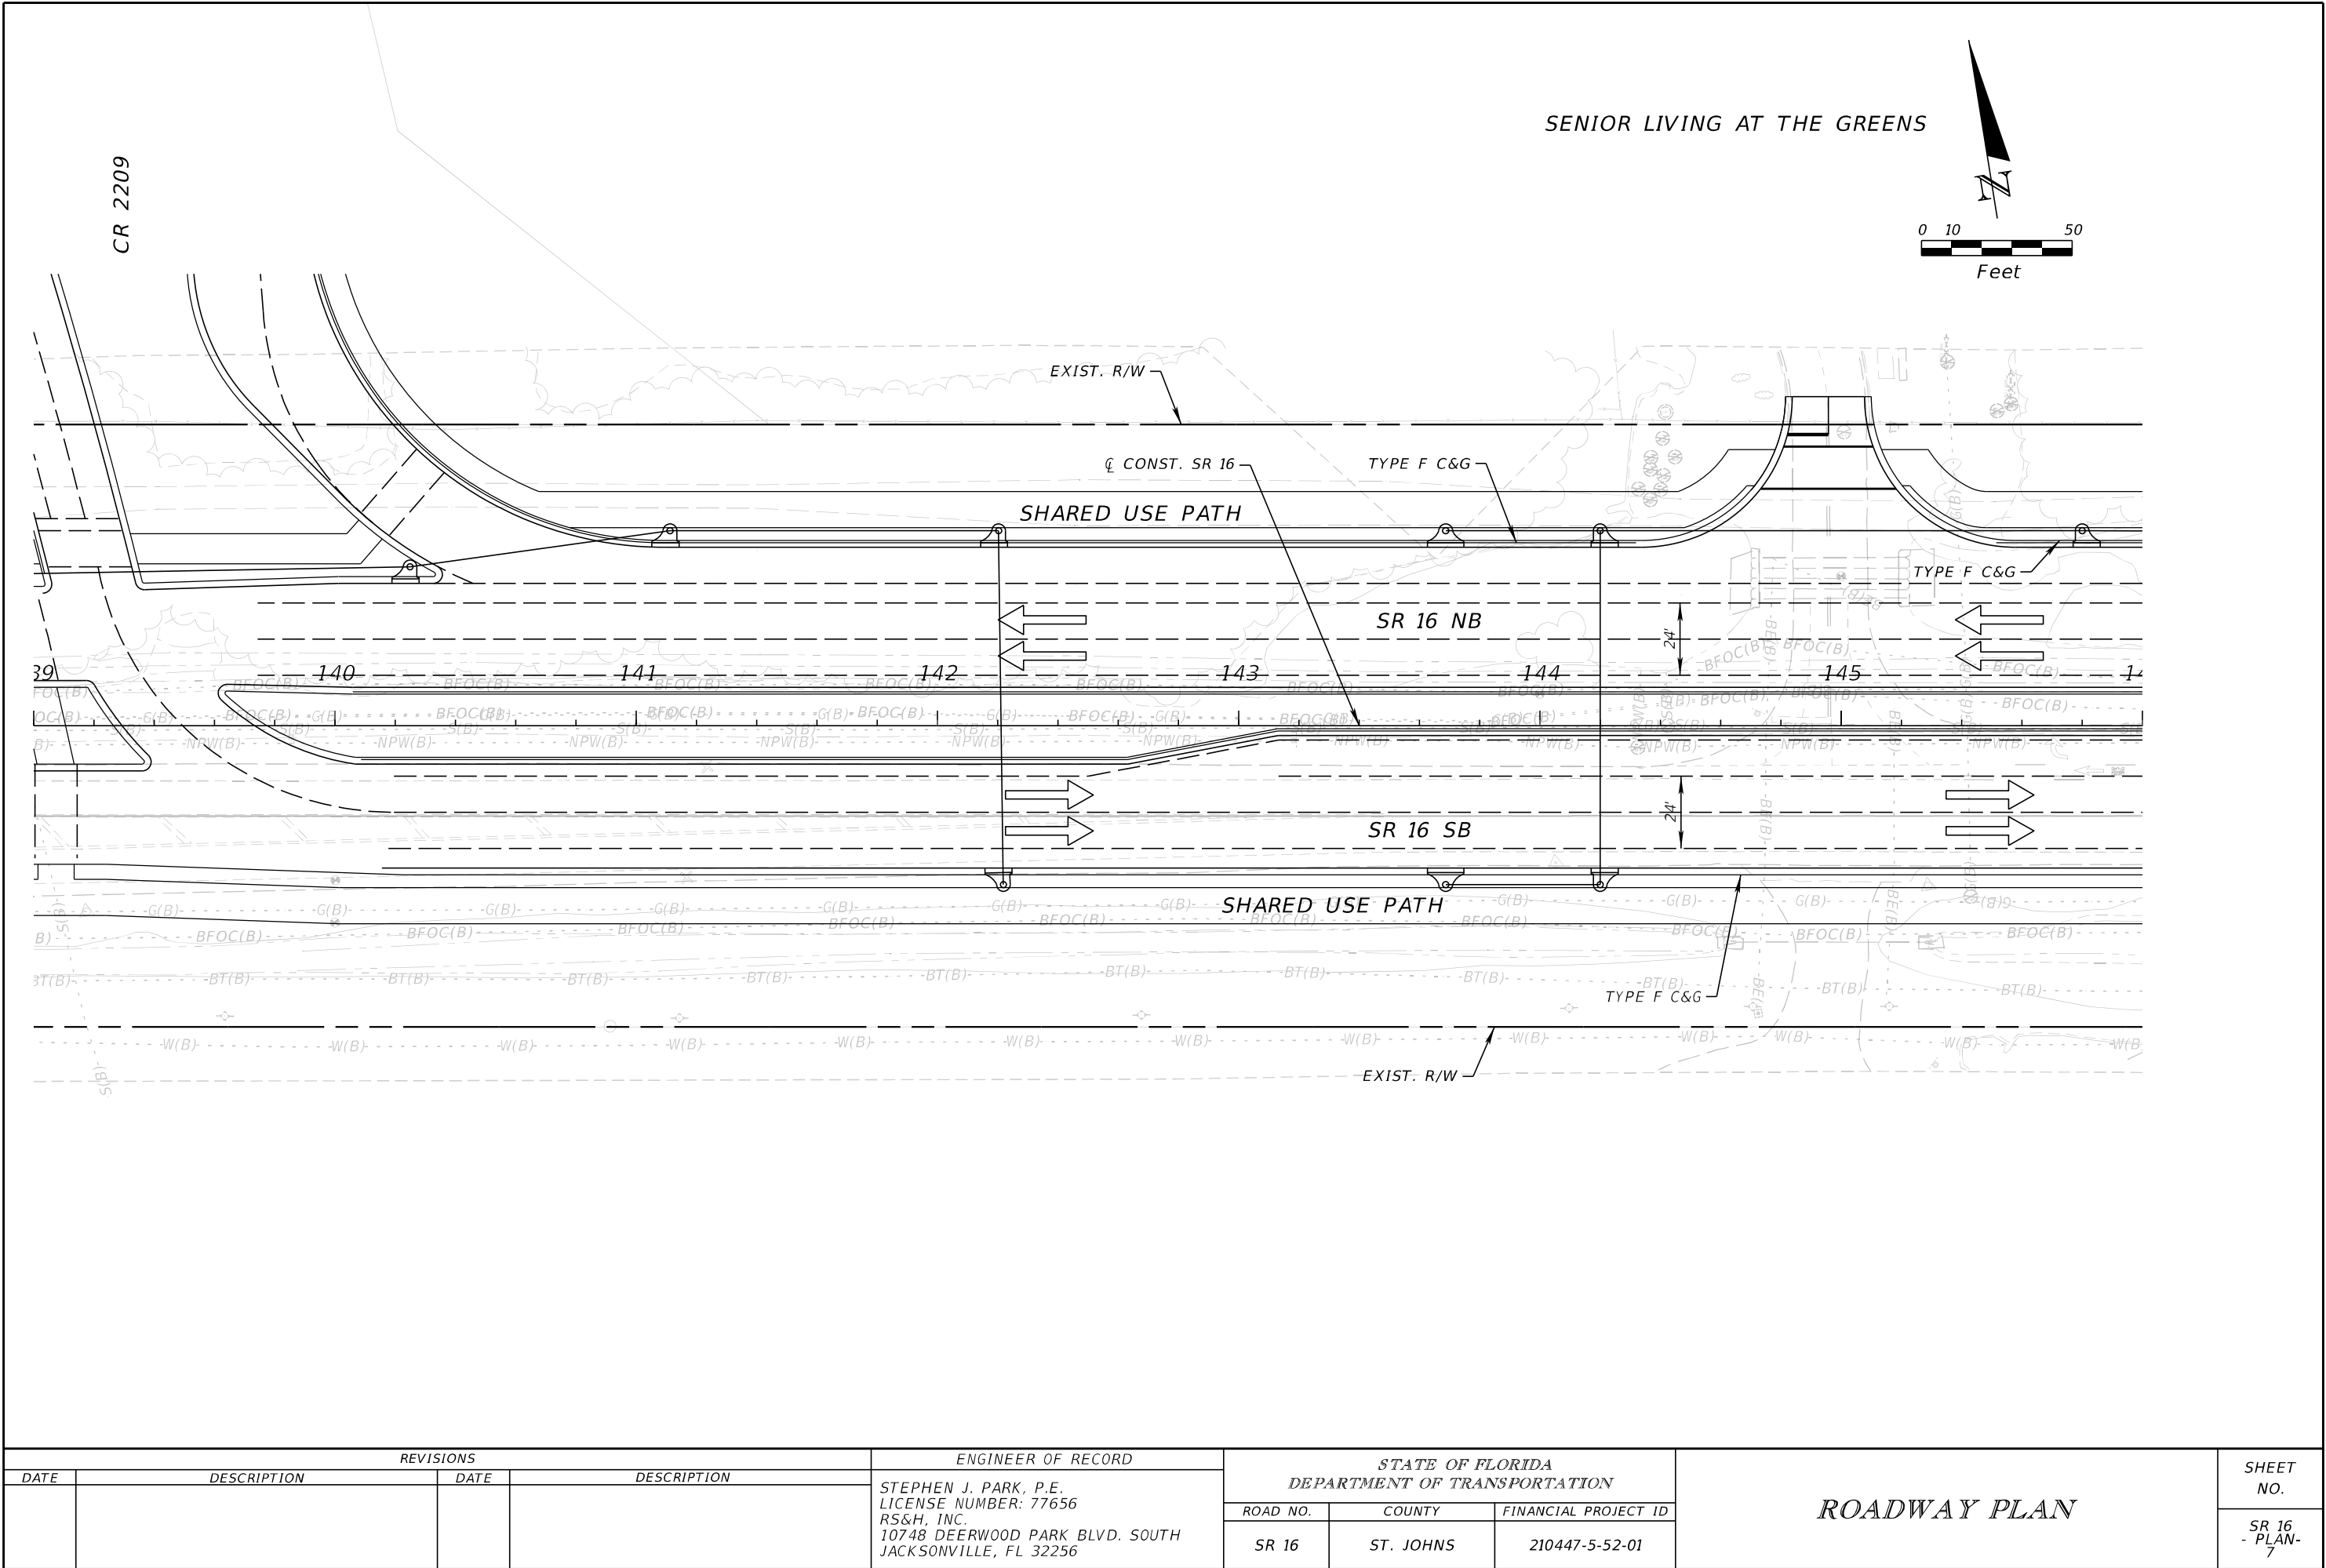

| REVISIONS | | | | ENGINEER OF RECORD | | STATE OF FLORIDA DEPARTMENT OF TRANSPORTATION | | | ROADWAY PLAN | SHEET NO. SR 16 - PLAN - 7 |
|-----------|-------------|------|-------------|---|--|--|-----------|----------------------|--------------|---|
| DATE | DESCRIPTION | DATE | DESCRIPTION | STEPHEN J. PARK, P.E. LICENSE NUMBER: 77656 RS&H, INC. 10748 DEERWOOD PARK BLVD. SOUTH JACKSONVILLE, FL 32256 | | ROAD NO. | COUNTY | FINANCIAL PROJECT ID | | |
| | | | | | | SR 16 | ST. JOHNS | 210447-5-52-01 | | |

THE OFFICIAL RECORD OF THIS SHEET IS THE ELECTRONIC FILE DIGITALLY SIGNED AND SEALED UNDER RULE 61G15-23.004, F.A.C.


8/5/2024 4:28:42 PM BeattyM
c:\pw_work\sh_pw\pw_user\0439575\PLANRD01.dgn

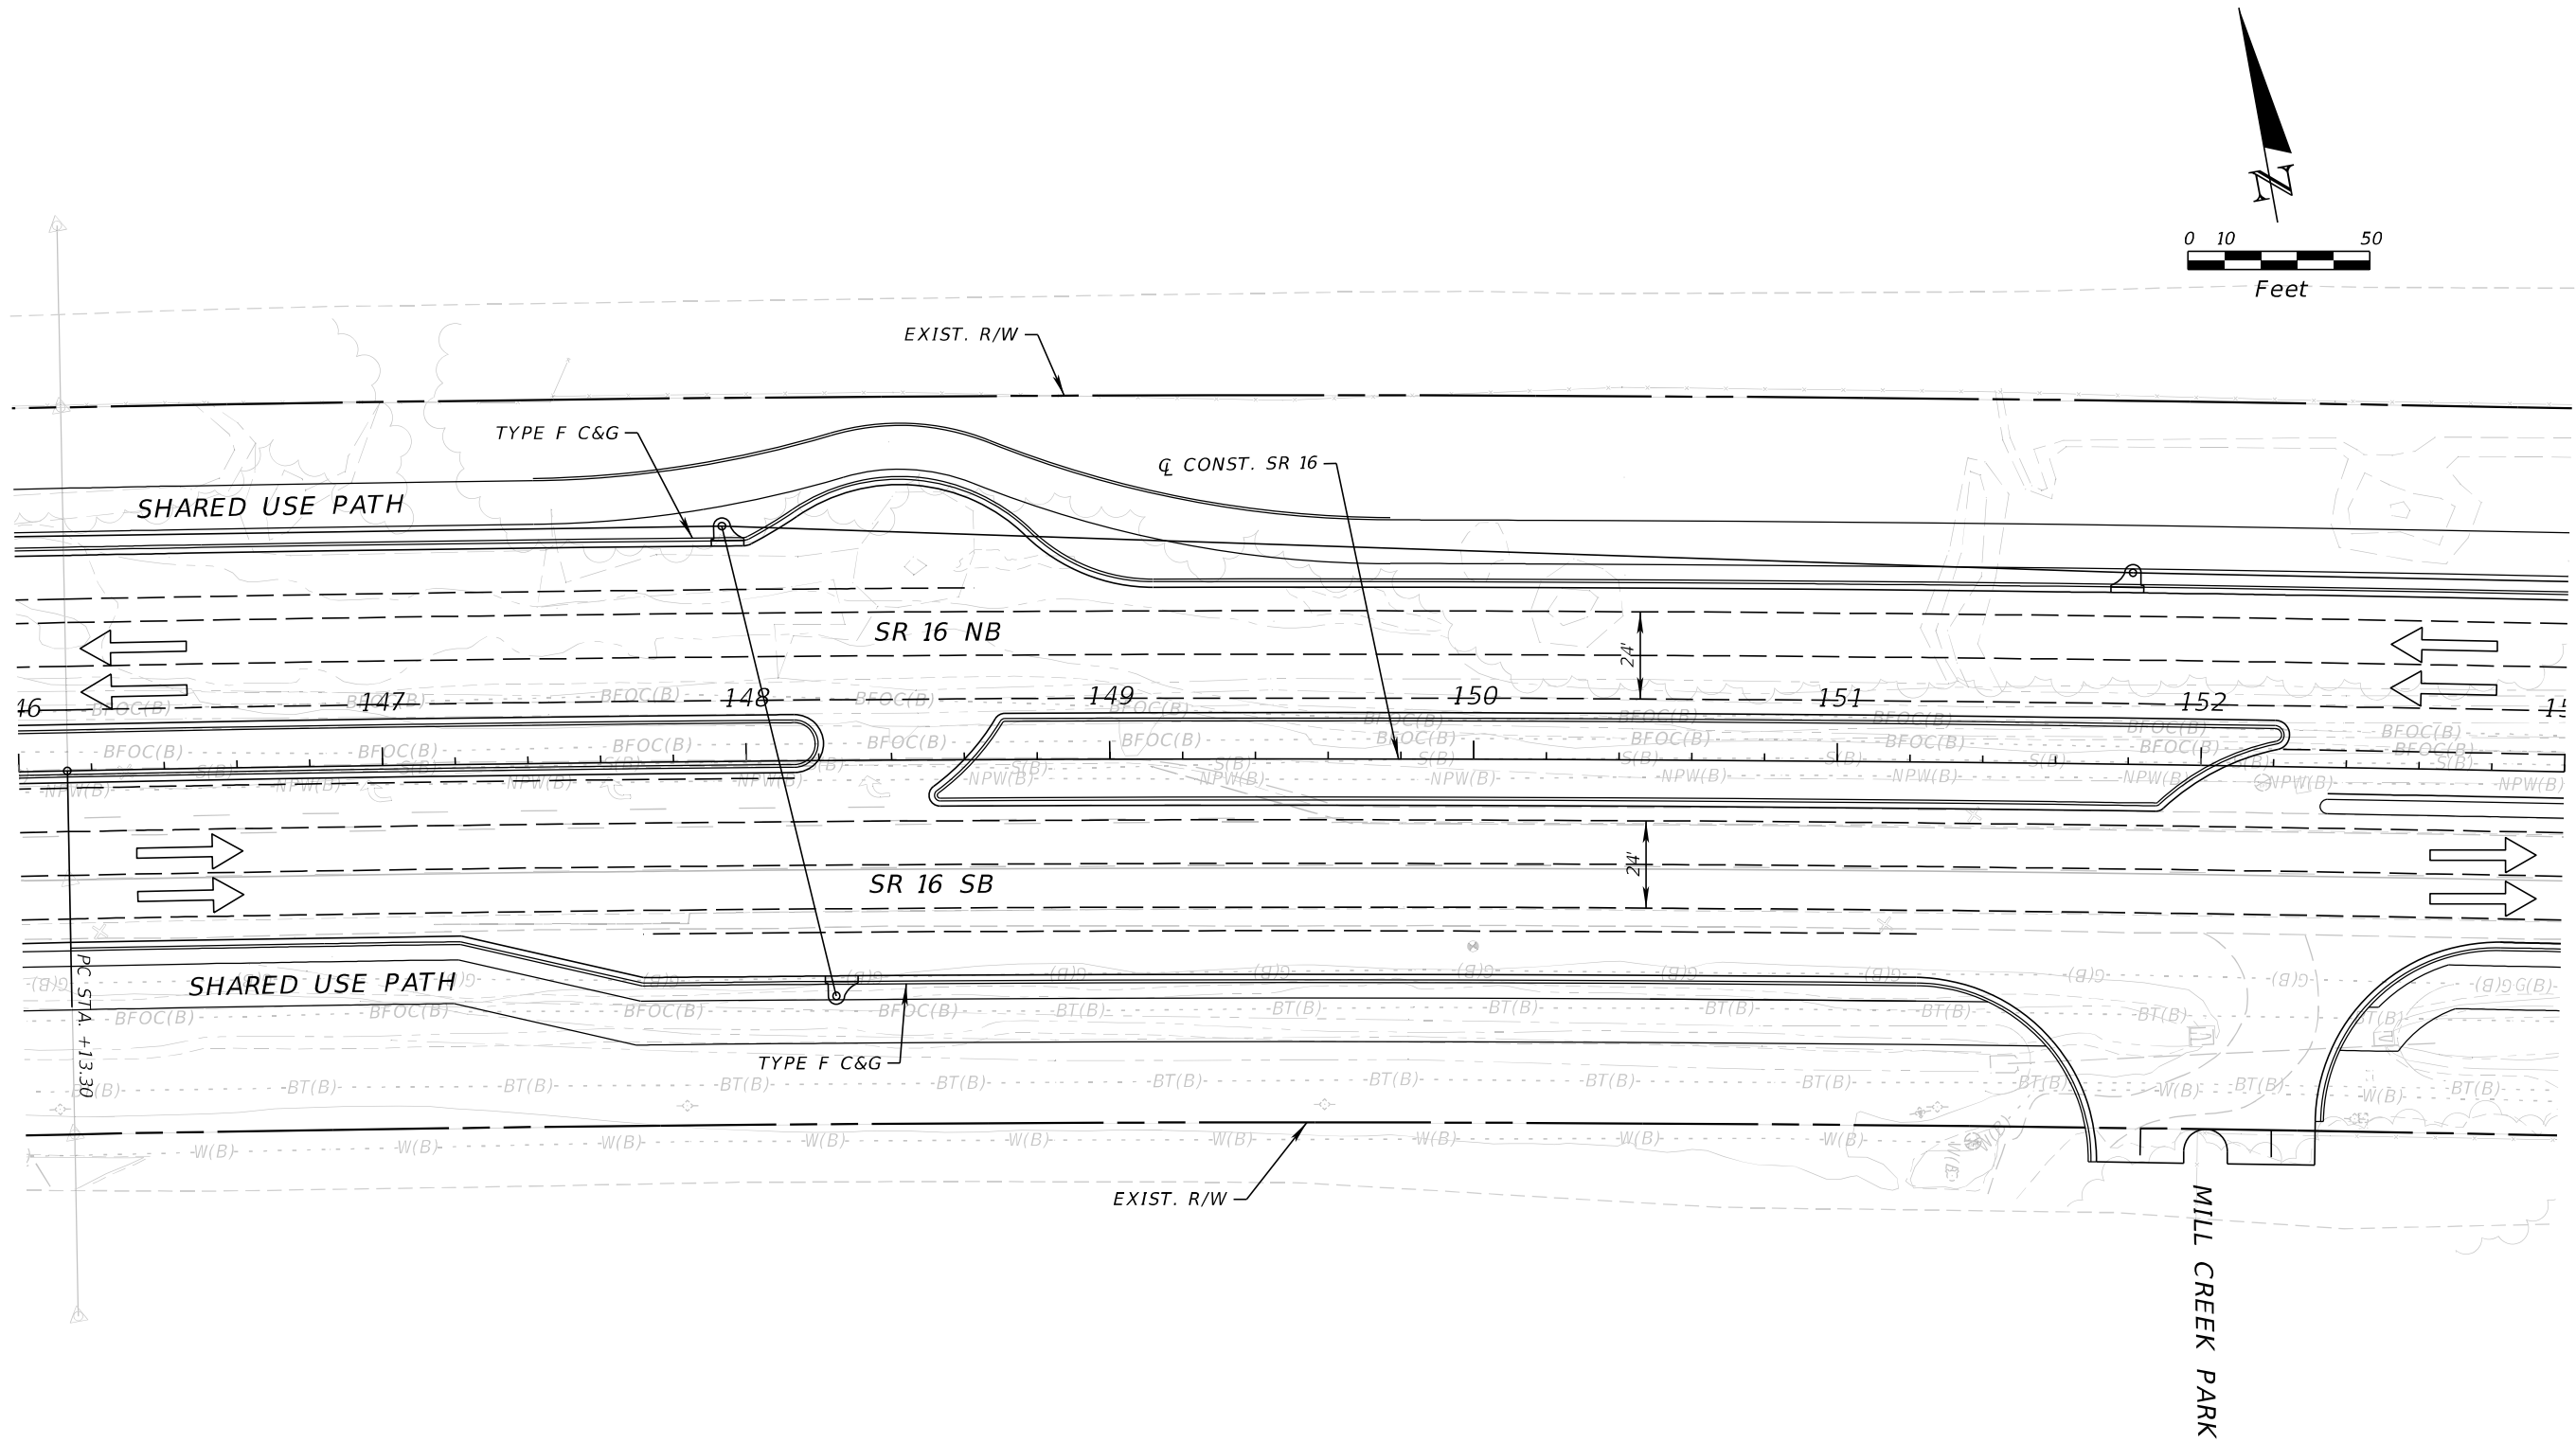

| REVISIONS | | | | ENGINEER OF RECORD | | STATE OF FLORIDA DEPARTMENT OF TRANSPORTATION | | | ROADWAY PLAN | SHEET NO. SR 16 - PLAN - 8 |
|-----------|-------------|------|-------------|---|--|--|-----------|----------------------|--------------|---|
| DATE | DESCRIPTION | DATE | DESCRIPTION | STEPHEN J. PARK, P.E. LICENSE NUMBER: 77656 RS&H, INC. 10748 DEERWOOD PARK BLVD. SOUTH JACKSONVILLE, FL 32256 | | ROAD NO. | COUNTY | FINANCIAL PROJECT ID | | |
| | | | | | | SR 16 | ST. JOHNS | 210447-5-52-01 | | |

THE OFFICIAL RECORD OF THIS SHEET IS THE ELECTRONIC FILE DIGITALLY SIGNED AND SEALED UNDER RULE 61G15-23.004, F.A.C.


8/5/2024 4:28:43 PM BeattyM
c:\pw_work\ysh_pw\pw_user\0439575\PLANRD01.dgn

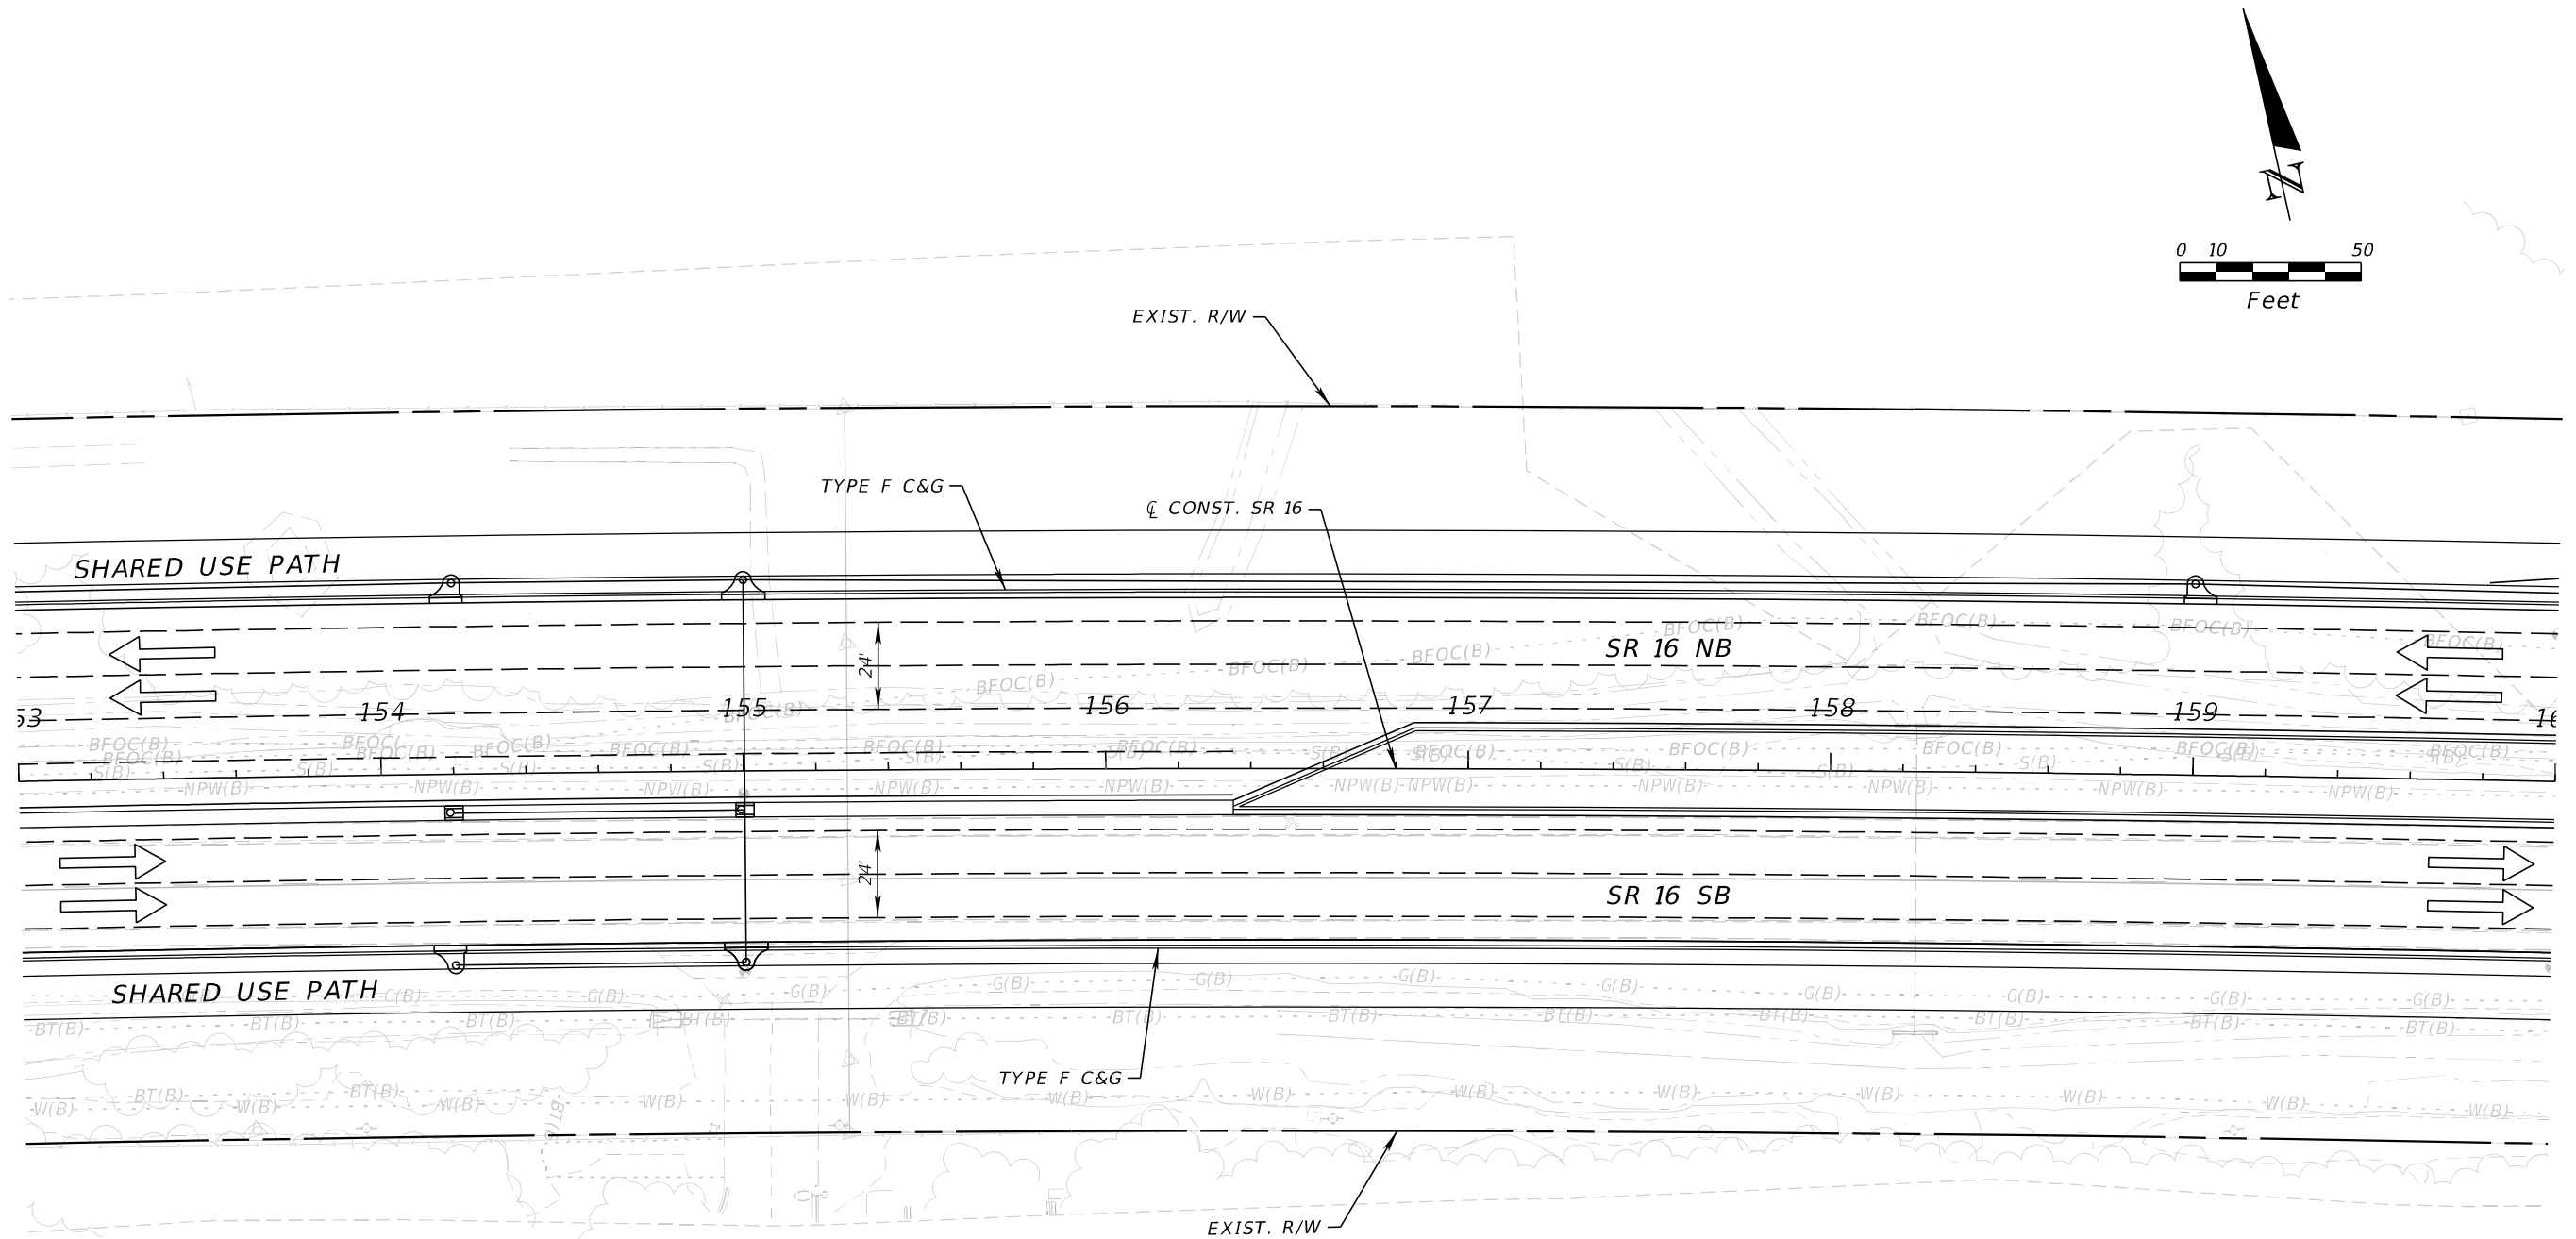

| REVISIONS | | | | ENGINEER OF RECORD | | STATE OF FLORIDA DEPARTMENT OF TRANSPORTATION | | | ROADWAY PLAN | SHEET NO. SR 16 - PLAN - 9 |
|-----------|-------------|------|-------------|---|--|--|-----------|----------------------|--------------|---|
| DATE | DESCRIPTION | DATE | DESCRIPTION | STEPHEN J. PARK, P.E. LICENSE NUMBER: 77656 RS&H, INC. 10748 DEERWOOD PARK BLVD. SOUTH JACKSONVILLE, FL 32256 | | ROAD NO. | COUNTY | FINANCIAL PROJECT ID | | |
| | | | | | | SR 16 | ST. JOHNS | 210447-5-52-01 | | |

THE OFFICIAL RECORD OF THIS SHEET IS THE ELECTRONIC FILE DIGITALLY SIGNED AND SEALED UNDER RULE 61G15-23.004, F.A.C.


8/5/2024 4:28:43 PM BeattyM
c:\pw_work\ysh_pw\pw_user\0439575\PLANRD01.dgn

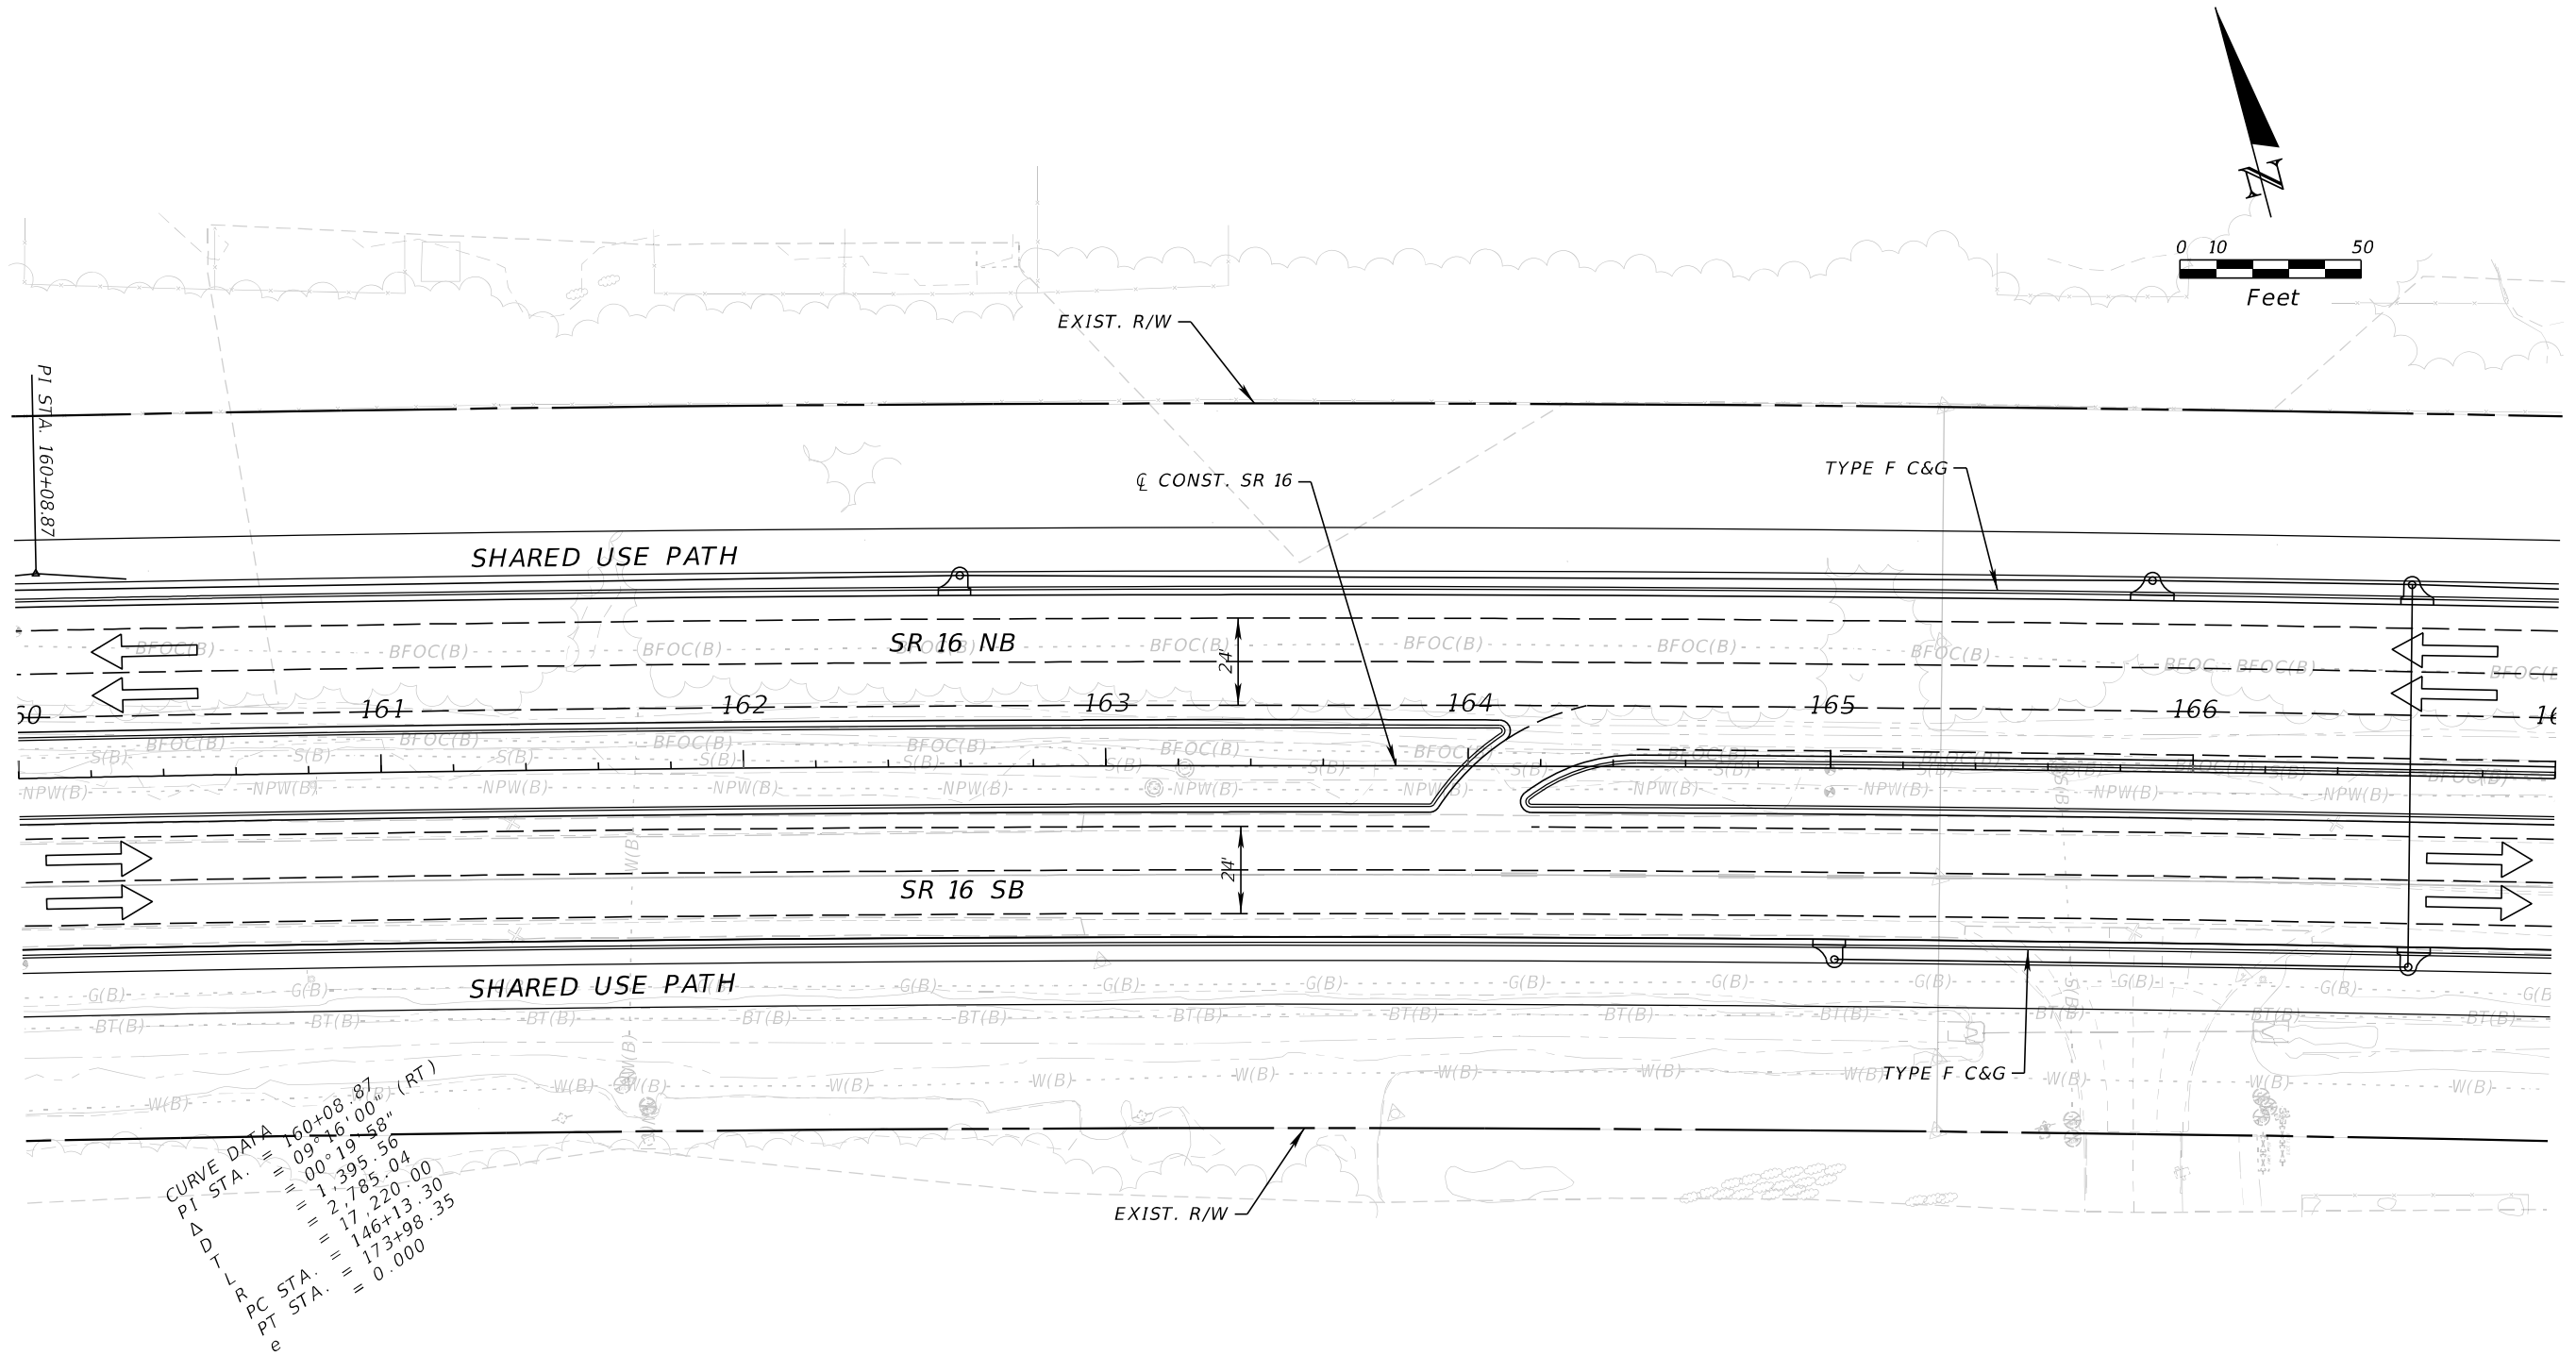

| REVISIONS | | | | ENGINEER OF RECORD | | STATE OF FLORIDA DEPARTMENT OF TRANSPORTATION | | | ROADWAY PLAN | SHEET NO. SR 16 - PLAN - 10 |
|-----------|-------------|------|-------------|---|--|--|-----------|----------------------|--------------|--|
| DATE | DESCRIPTION | DATE | DESCRIPTION | STEPHEN J. PARK, P.E. LICENSE NUMBER: 77656 RS&H, INC. 10748 DEERWOOD PARK BLVD. SOUTH JACKSONVILLE, FL 32256 | | ROAD NO. | COUNTY | FINANCIAL PROJECT ID | | |
| | | | | | | SR 16 | ST. JOHNS | 210447-5-52-01 | | |

THE OFFICIAL RECORD OF THIS SHEET IS THE ELECTRONIC FILE DIGITALLY SIGNED AND SEALED UNDER RULE 61G15-23.004, F.A.C.


8/5/2024 4:28:44 PM BeattyM
c:\pw_work\sh_pw\pw_user\00439575\PLANRD01.dgn

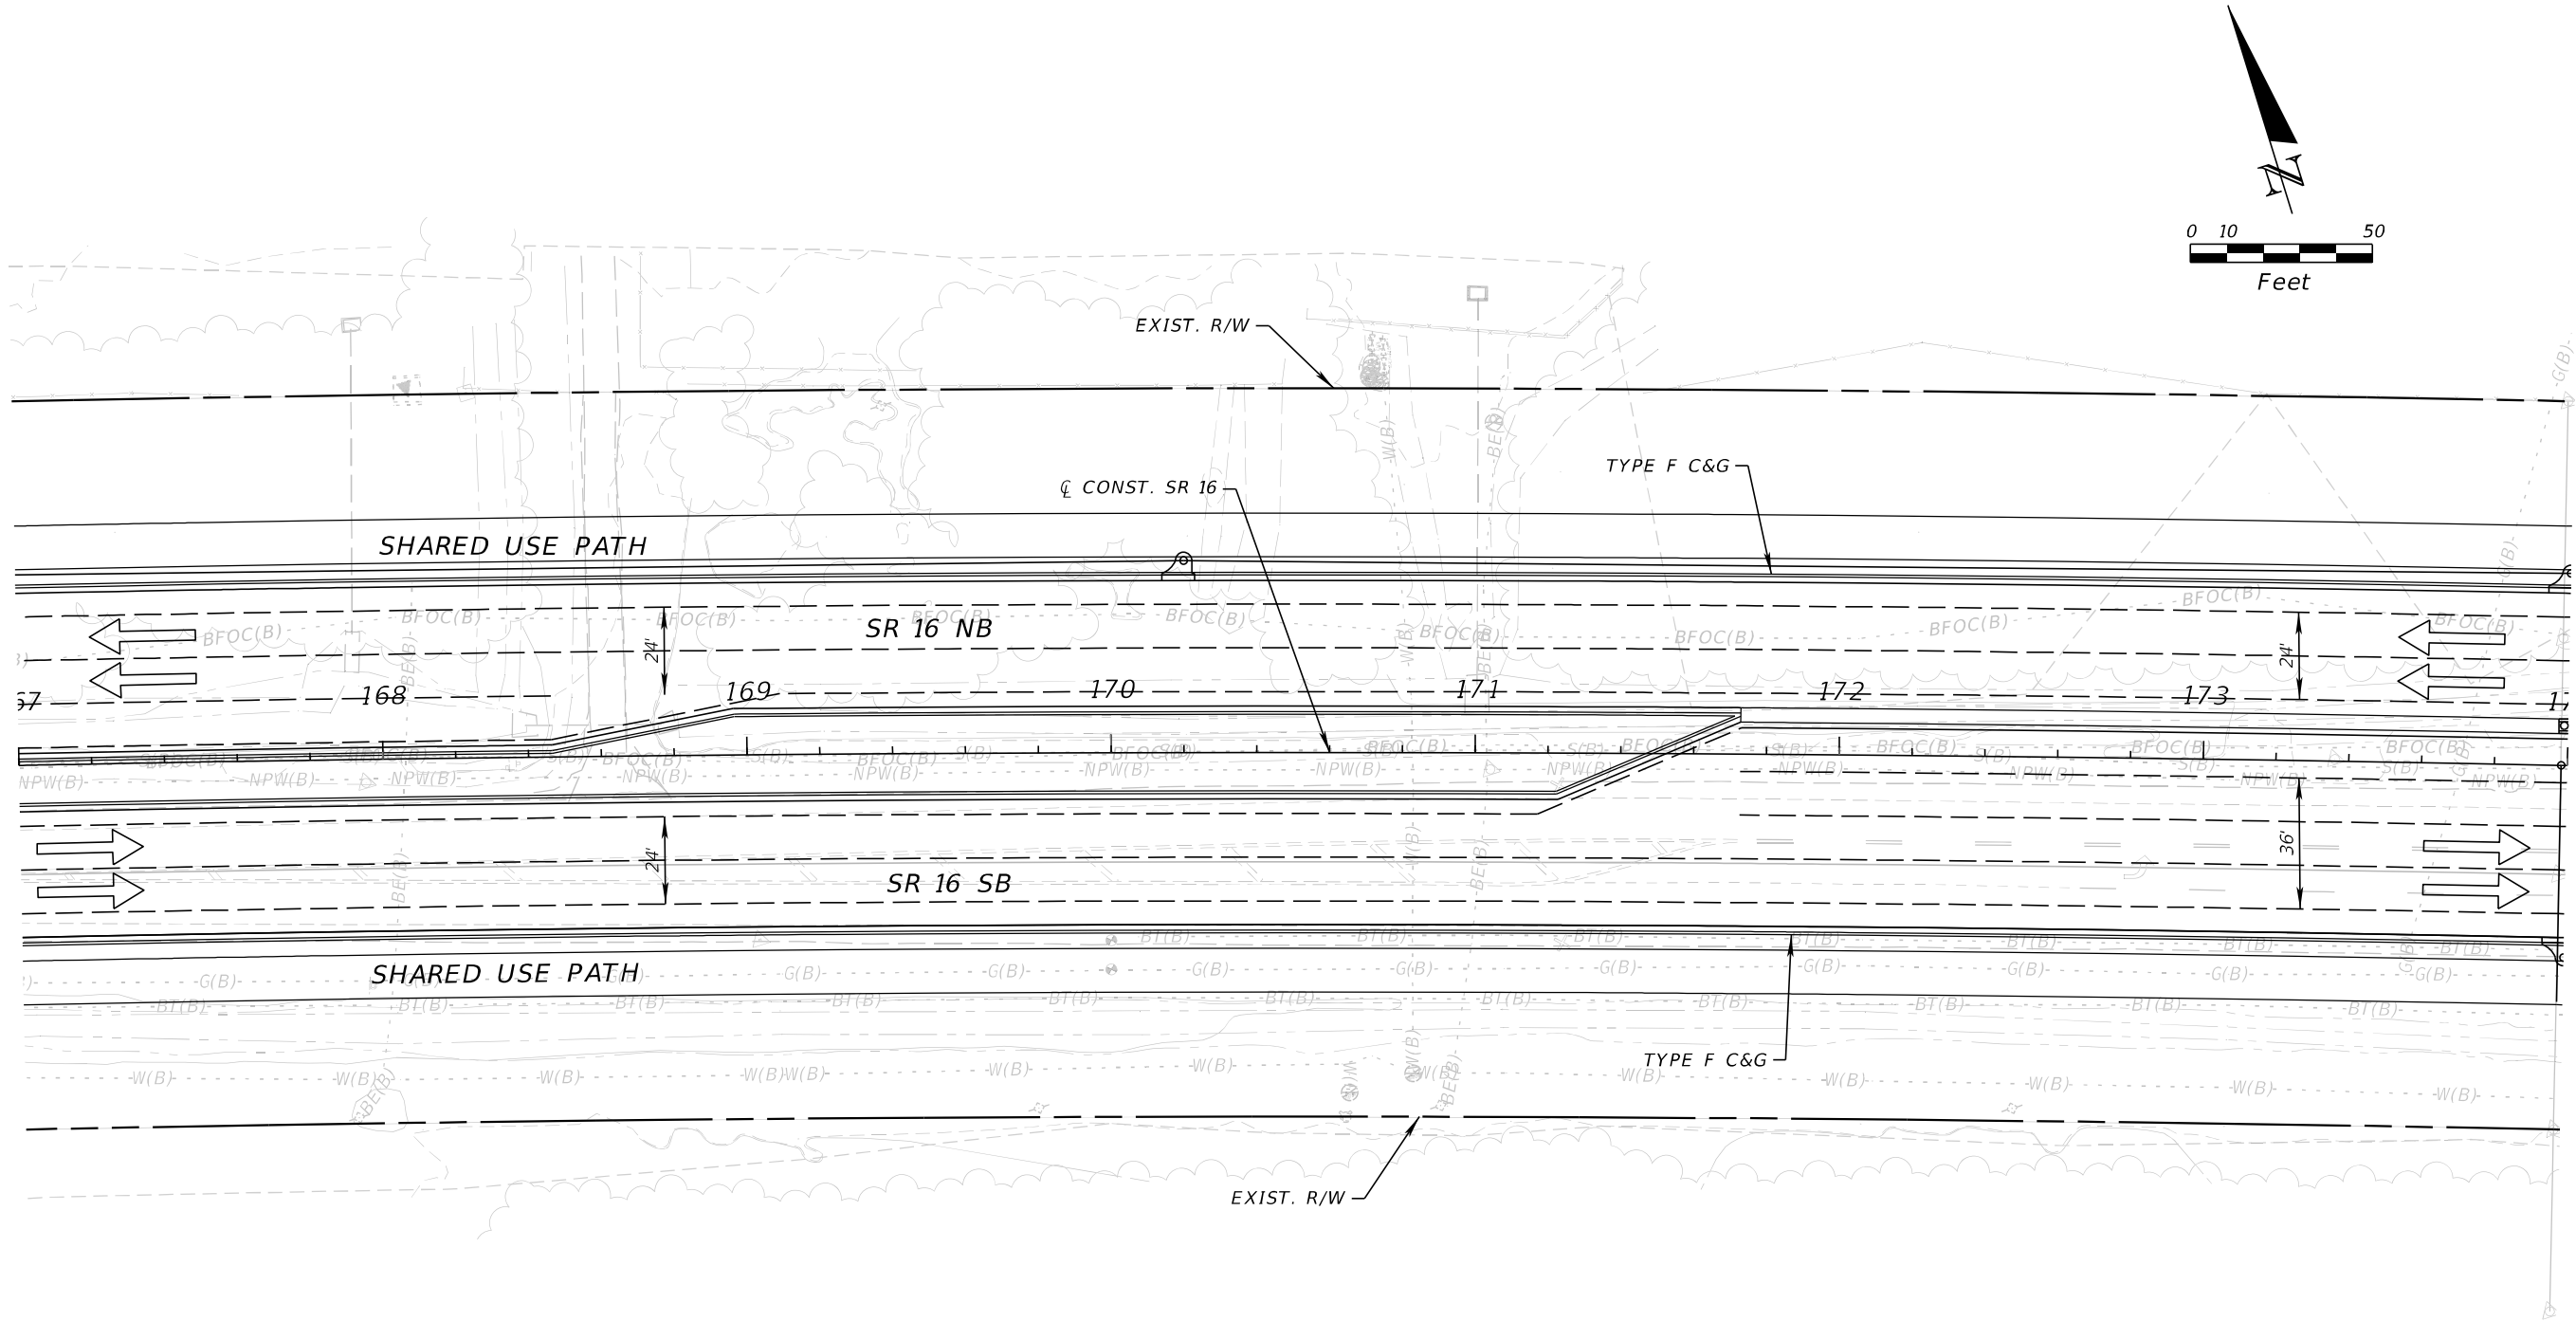

| REVISIONS | | | | ENGINEER OF RECORD | STATE OF FLORIDA DEPARTMENT OF TRANSPORTATION | | | ROADWAY PLAN | SHEET NO. SR 16 - PLAN - 11 |
|-----------|-------------|------|-------------|---|--|-----------|----------------------|--------------|--|
| DATE | DESCRIPTION | DATE | DESCRIPTION | | ROAD NO. | COUNTY | FINANCIAL PROJECT ID | | |
| | | | | STEPHEN J. PARK, P.E. LICENSE NUMBER: 77656 RS&H, INC. 10748 DEERWOOD PARK BLVD. SOUTH JACKSONVILLE, FL 32256 | SR 16 | ST. JOHNS | 210447-5-52-01 | | |

THE OFFICIAL RECORD OF THIS SHEET IS THE ELECTRONIC FILE DIGITALLY SIGNED AND SEALED UNDER RULE 61G15-23.004, F.A.C.

8/5/2024 4:28:45 PM BeattyM
c:\pw_work\ysh_pw\pw_user\0439575\PLANRD01.dgn

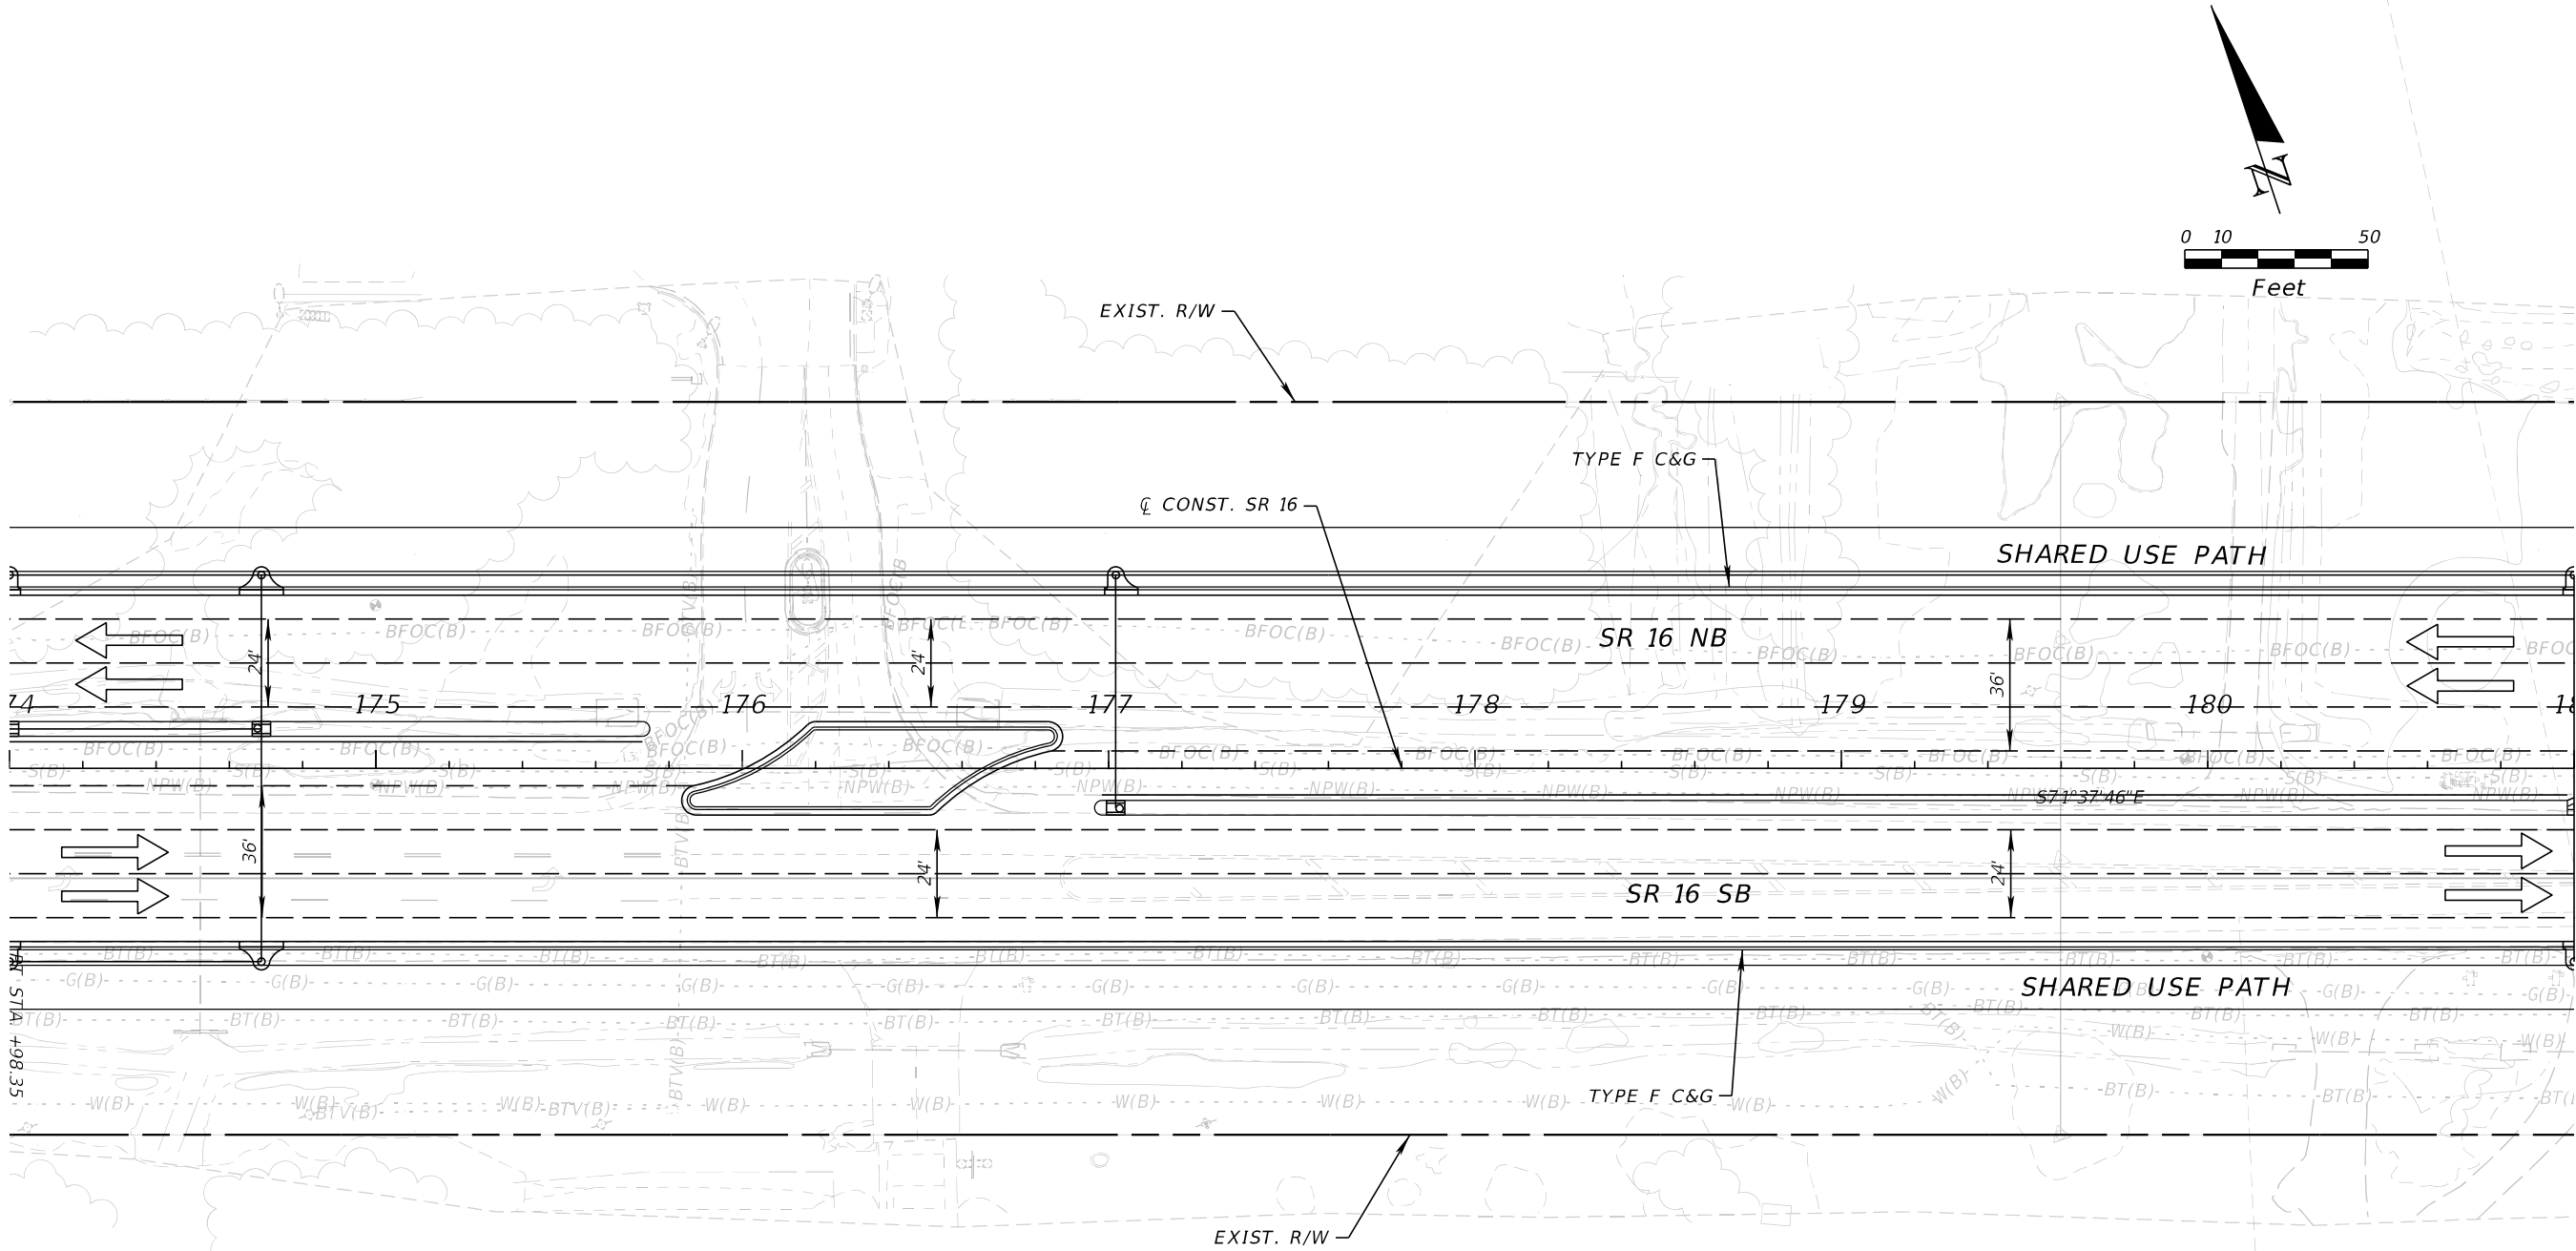

| REVISIONS | | | |
|-----------|-------------|------|-------------|
| DATE | DESCRIPTION | DATE | DESCRIPTION |
| | | | |

| ENGINEER OF RECORD | |
|---|--|
| STEPHEN J. PARK, P.E. LICENSE NUMBER: 77656 RS&H, INC. 10748 DEERWOOD PARK BLVD. SOUTH JACKSONVILLE, FL 32256 | |


| STATE OF FLORIDA DEPARTMENT OF TRANSPORTATION | | |
|--|-----------|----------------------|
| ROAD NO. | COUNTY | FINANCIAL PROJECT ID |
| SR 16 | ST. JOHNS | 210447-5-52-01 |

| ROADWAY PLAN | |
|--------------|--|
| | |

| SHEET NO. |
|-------------------------|
| SR 16 - PLAN - 12 |

THE OFFICIAL RECORD OF THIS SHEET IS THE ELECTRONIC FILE DIGITALLY SIGNED AND SEALED UNDER RULE 61G15-23.004, F.A.C.

8/5/2024 4:28:45 PM BeattyM
c:\pw_work\ysh_pw\pw_user\0439575\PLANRD01.dgn


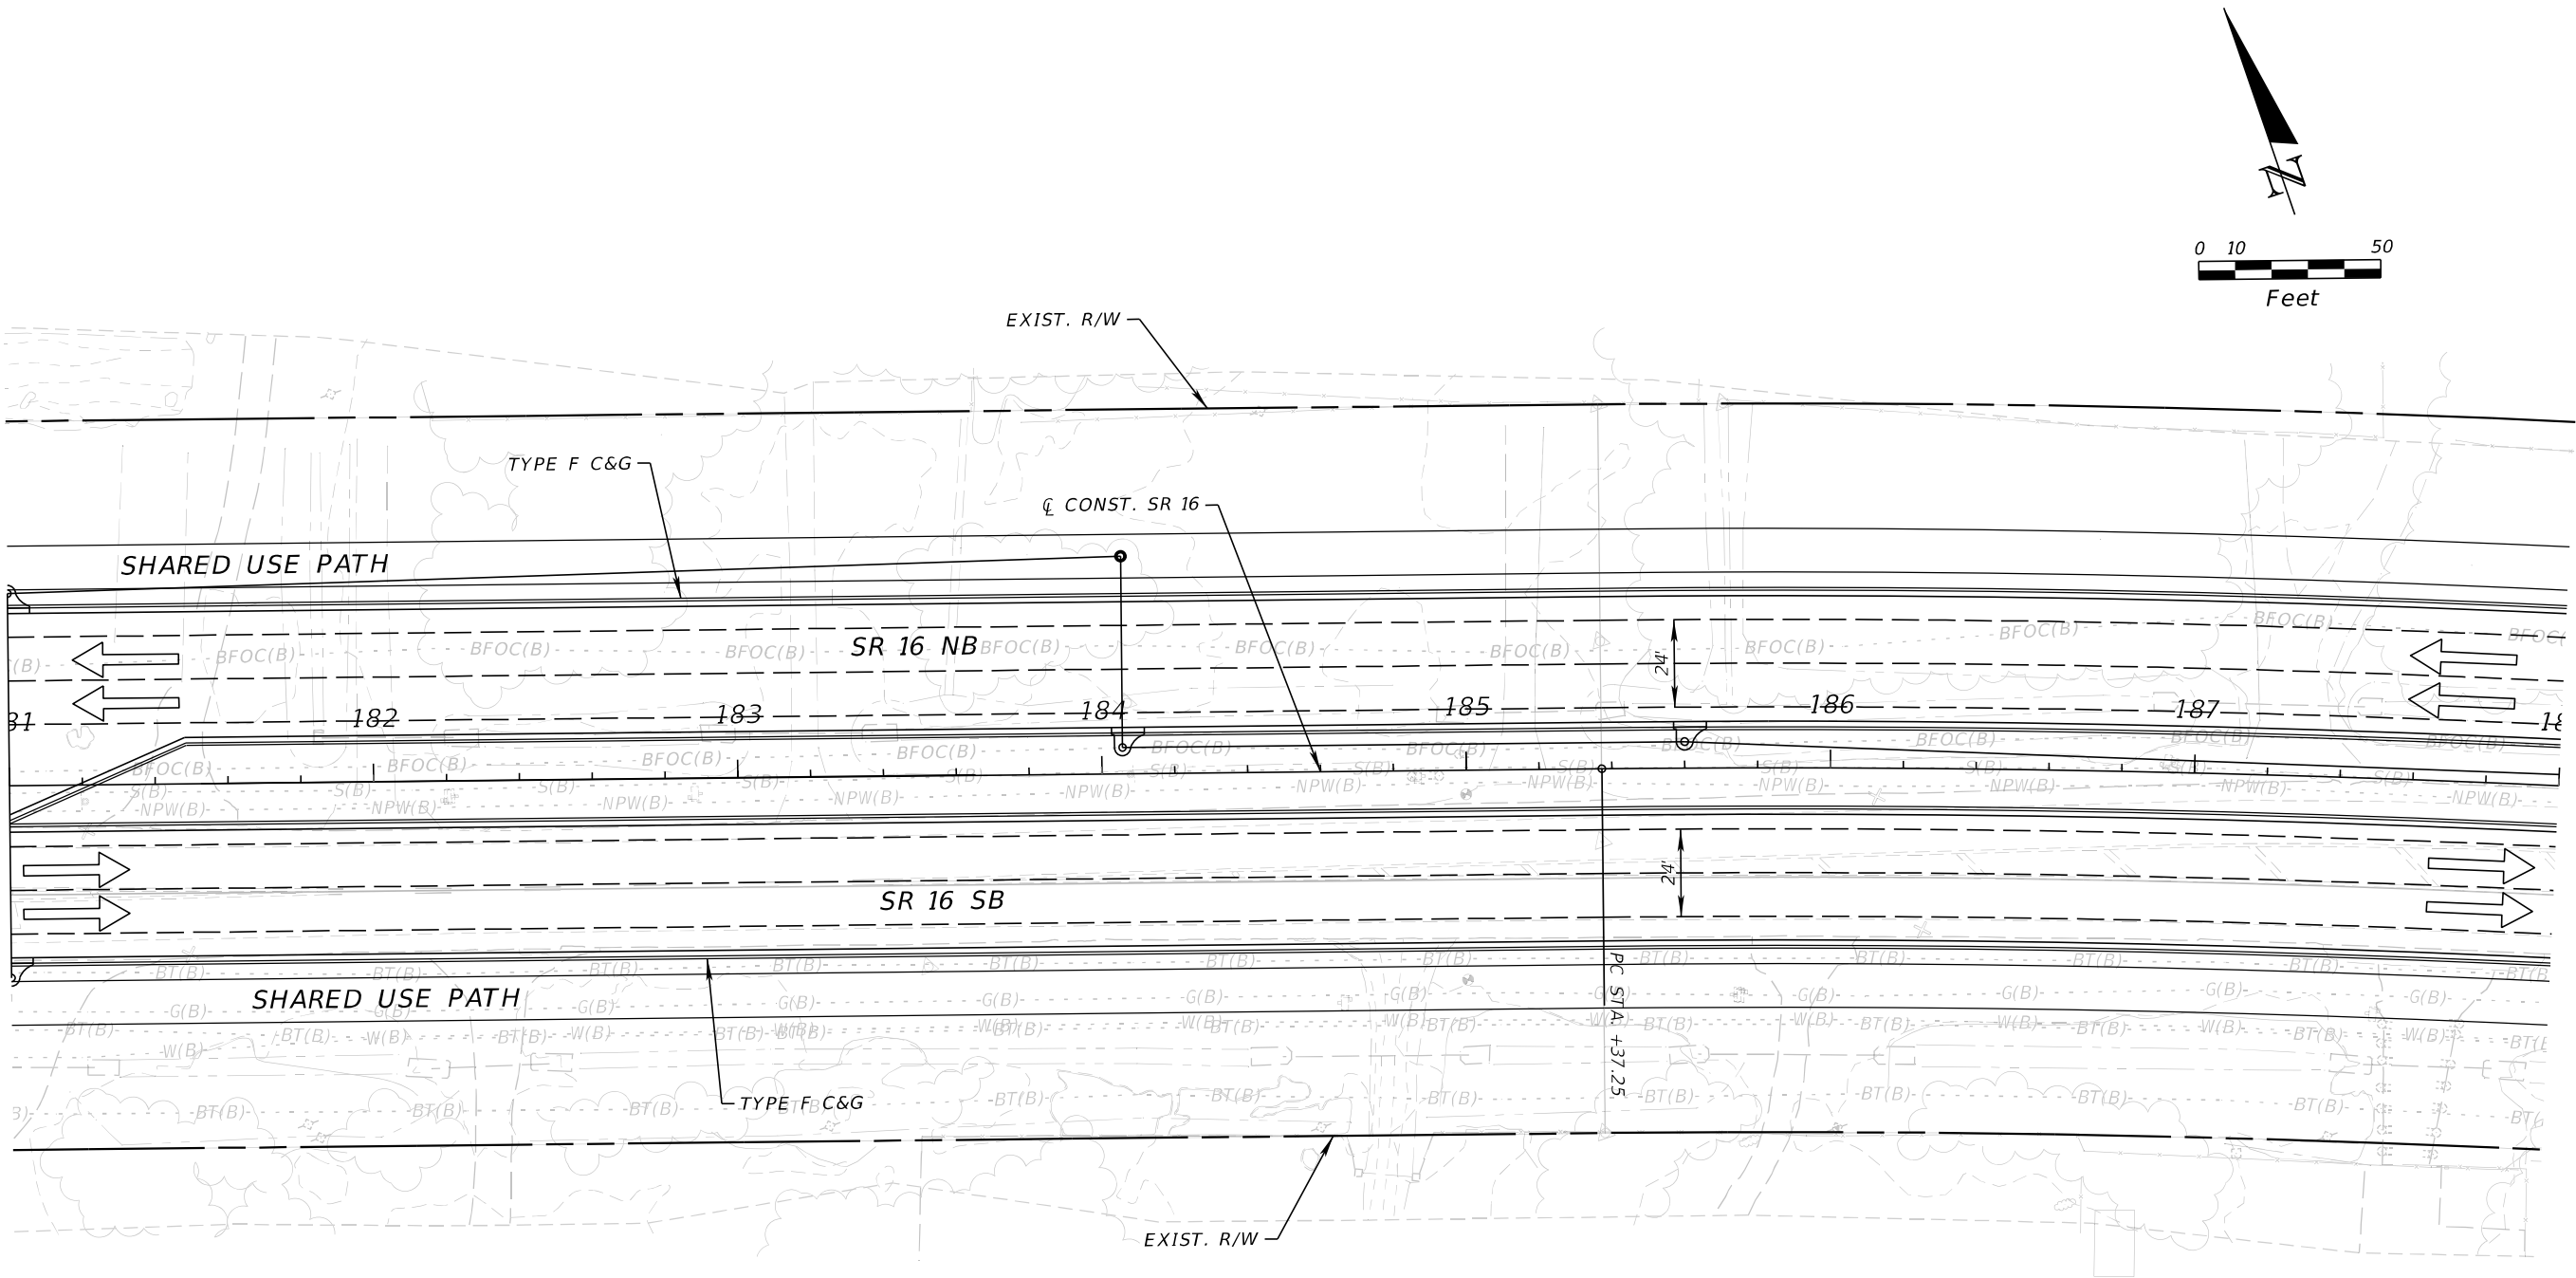


| REVISIONS | | | | ENGINEER OF RECORD | STATE OF FLORIDA DEPARTMENT OF TRANSPORTATION | | | SHEET NO. |
|-----------|-------------|------|-------------|---|--|-----------|----------------------|-----------------------|
| DATE | DESCRIPTION | DATE | DESCRIPTION | | ROAD NO. | COUNTY | FINANCIAL PROJECT ID | |
| | | | | STEPHEN J. PARK, P.E. LICENSE NUMBER: 77656 RS&H, INC. 10748 DEERWOOD PARK BLVD. SOUTH JACKSONVILLE, FL 32256 | SR 16 | ST. JOHNS | 210447-5-52-01 | 11x17 Plan Only |

THE OFFICIAL RECORD OF THIS SHEET IS THE ELECTRONIC FILE DIGITALLY SIGNED AND SEALED UNDER RULE 61G15-23.004, F.A.C.

SJC PROJECT SIDE

FDOT PROJECT SIDE

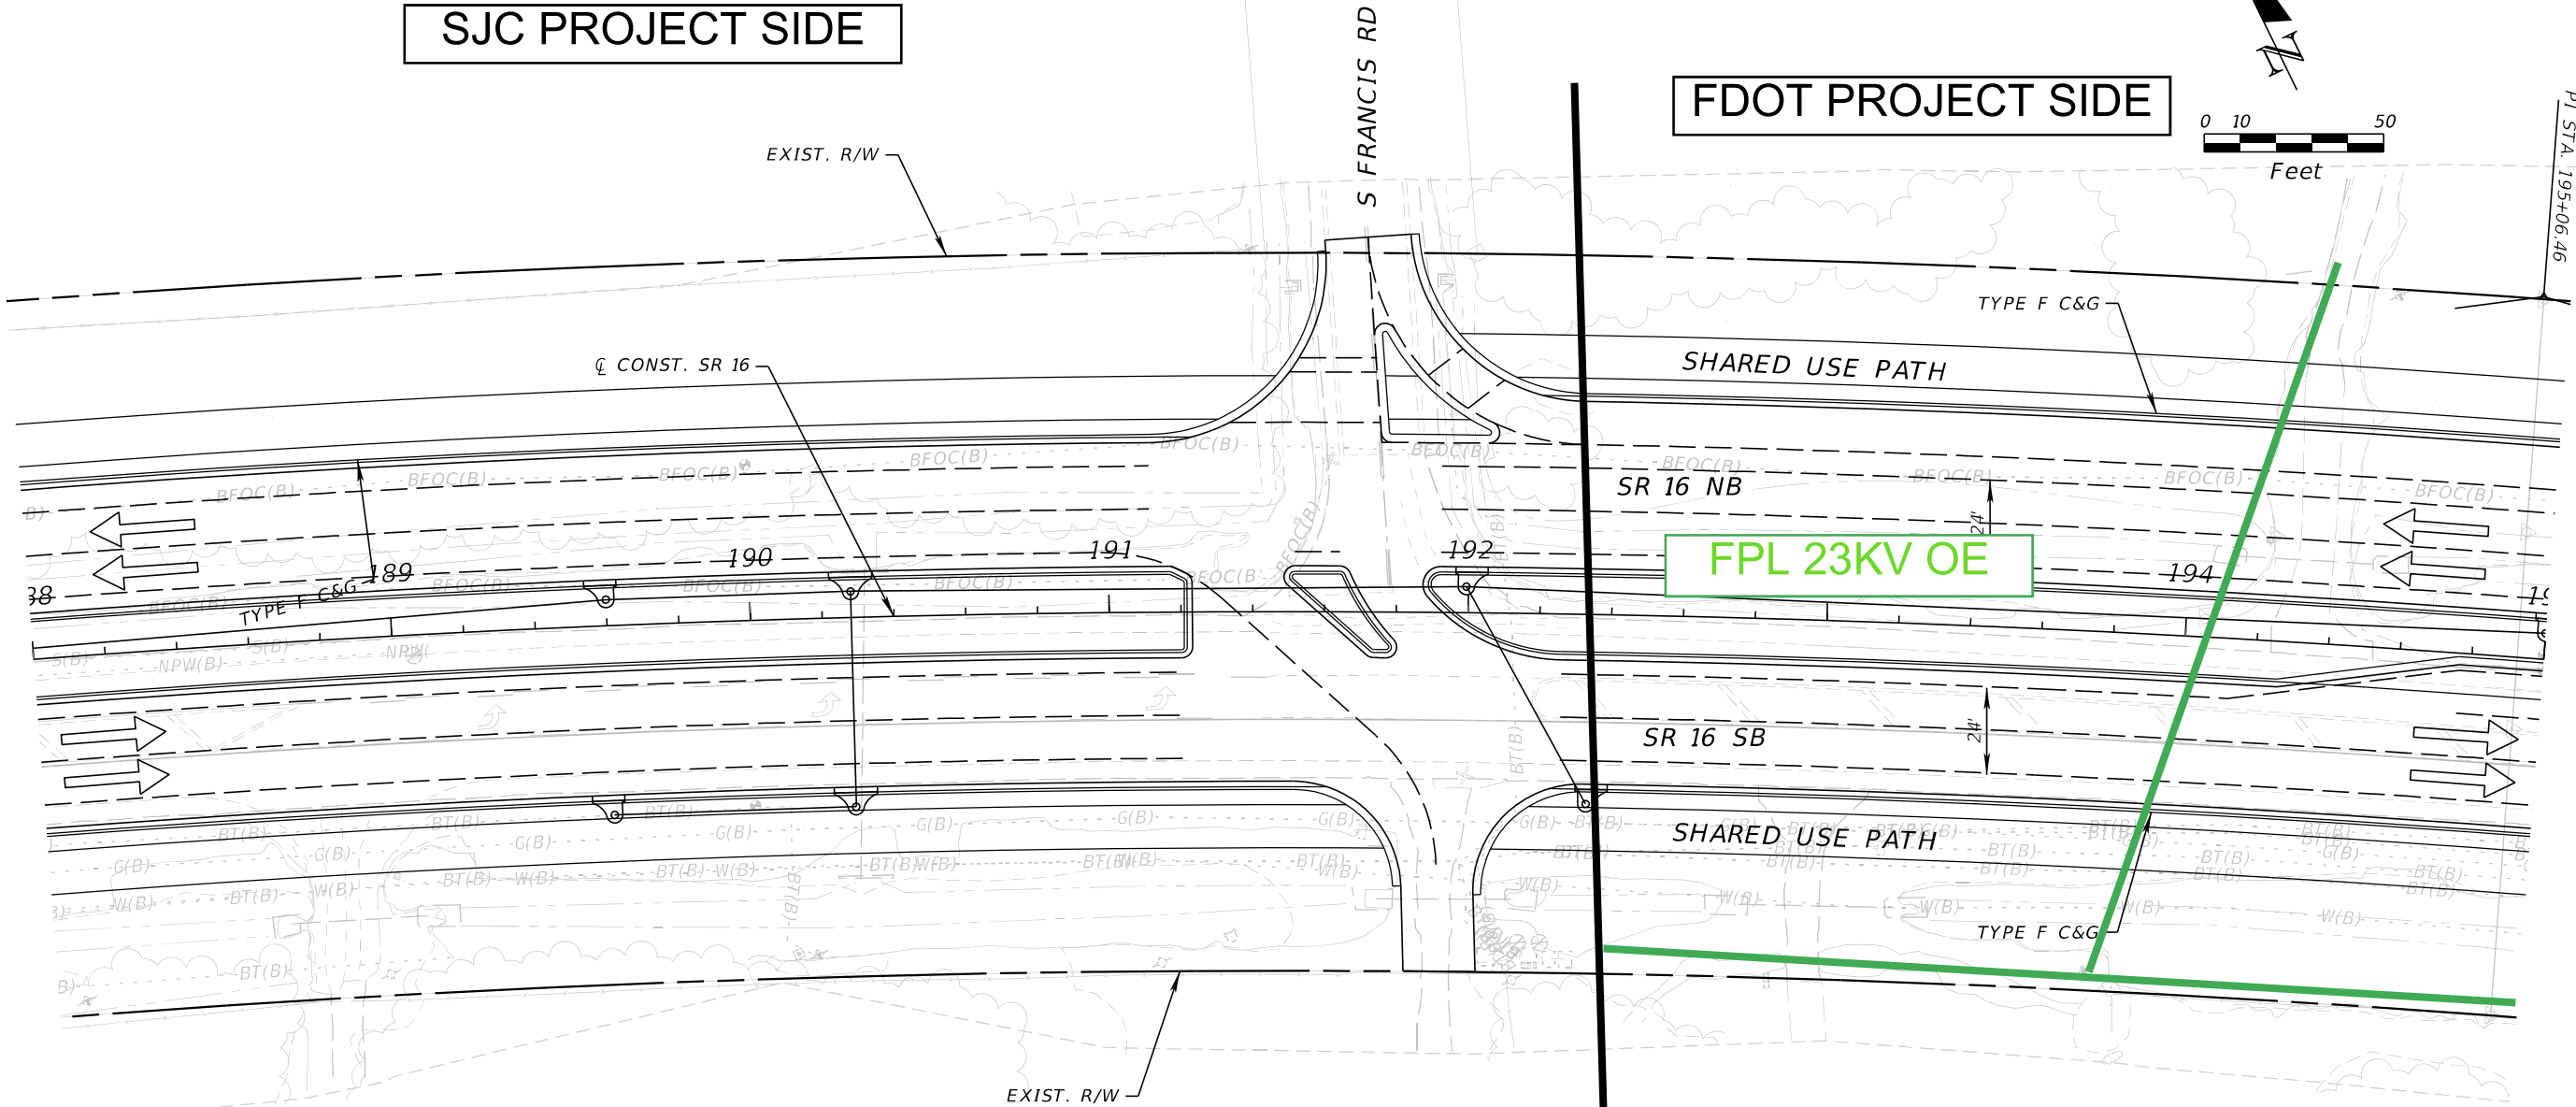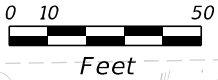


8/5/2024 4:28:46 PM BeattyM
c:\pw_work\ysh_pw\pw_user\0439575\PLANRD01.dgn

| REVISIONS | | | | ENGINEER OF RECORD | | STATE OF FLORIDA DEPARTMENT OF TRANSPORTATION | | | SHEET NO. |
|-----------|-------------|------|-------------|---|--|--|-----------|----------------------|--------------|
| DATE | DESCRIPTION | DATE | DESCRIPTION | STEPHEN J. PARK, P.E. LICENSE NUMBER: 77656 RS&H, INC. 10748 DEERWOOD PARK BLVD. SOUTH JACKSONVILLE, FL 32256 | | ROAD NO. | COUNTY | FINANCIAL PROJECT ID | |
| | | | | | | SR 16 | ST. JOHNS | 210447-5-52-01 | |

THE OFFICIAL RECORD OF THIS SHEET IS THE ELECTRONIC FILE DIGITALLY SIGNED AND SEALED UNDER RULE 61G15-23.004, F.A.C.

8/5/2024 4:28:47 PM BeattyM
c:\pw_work\ysh_pw\pw_user\00439575\PLANRD01.dgn

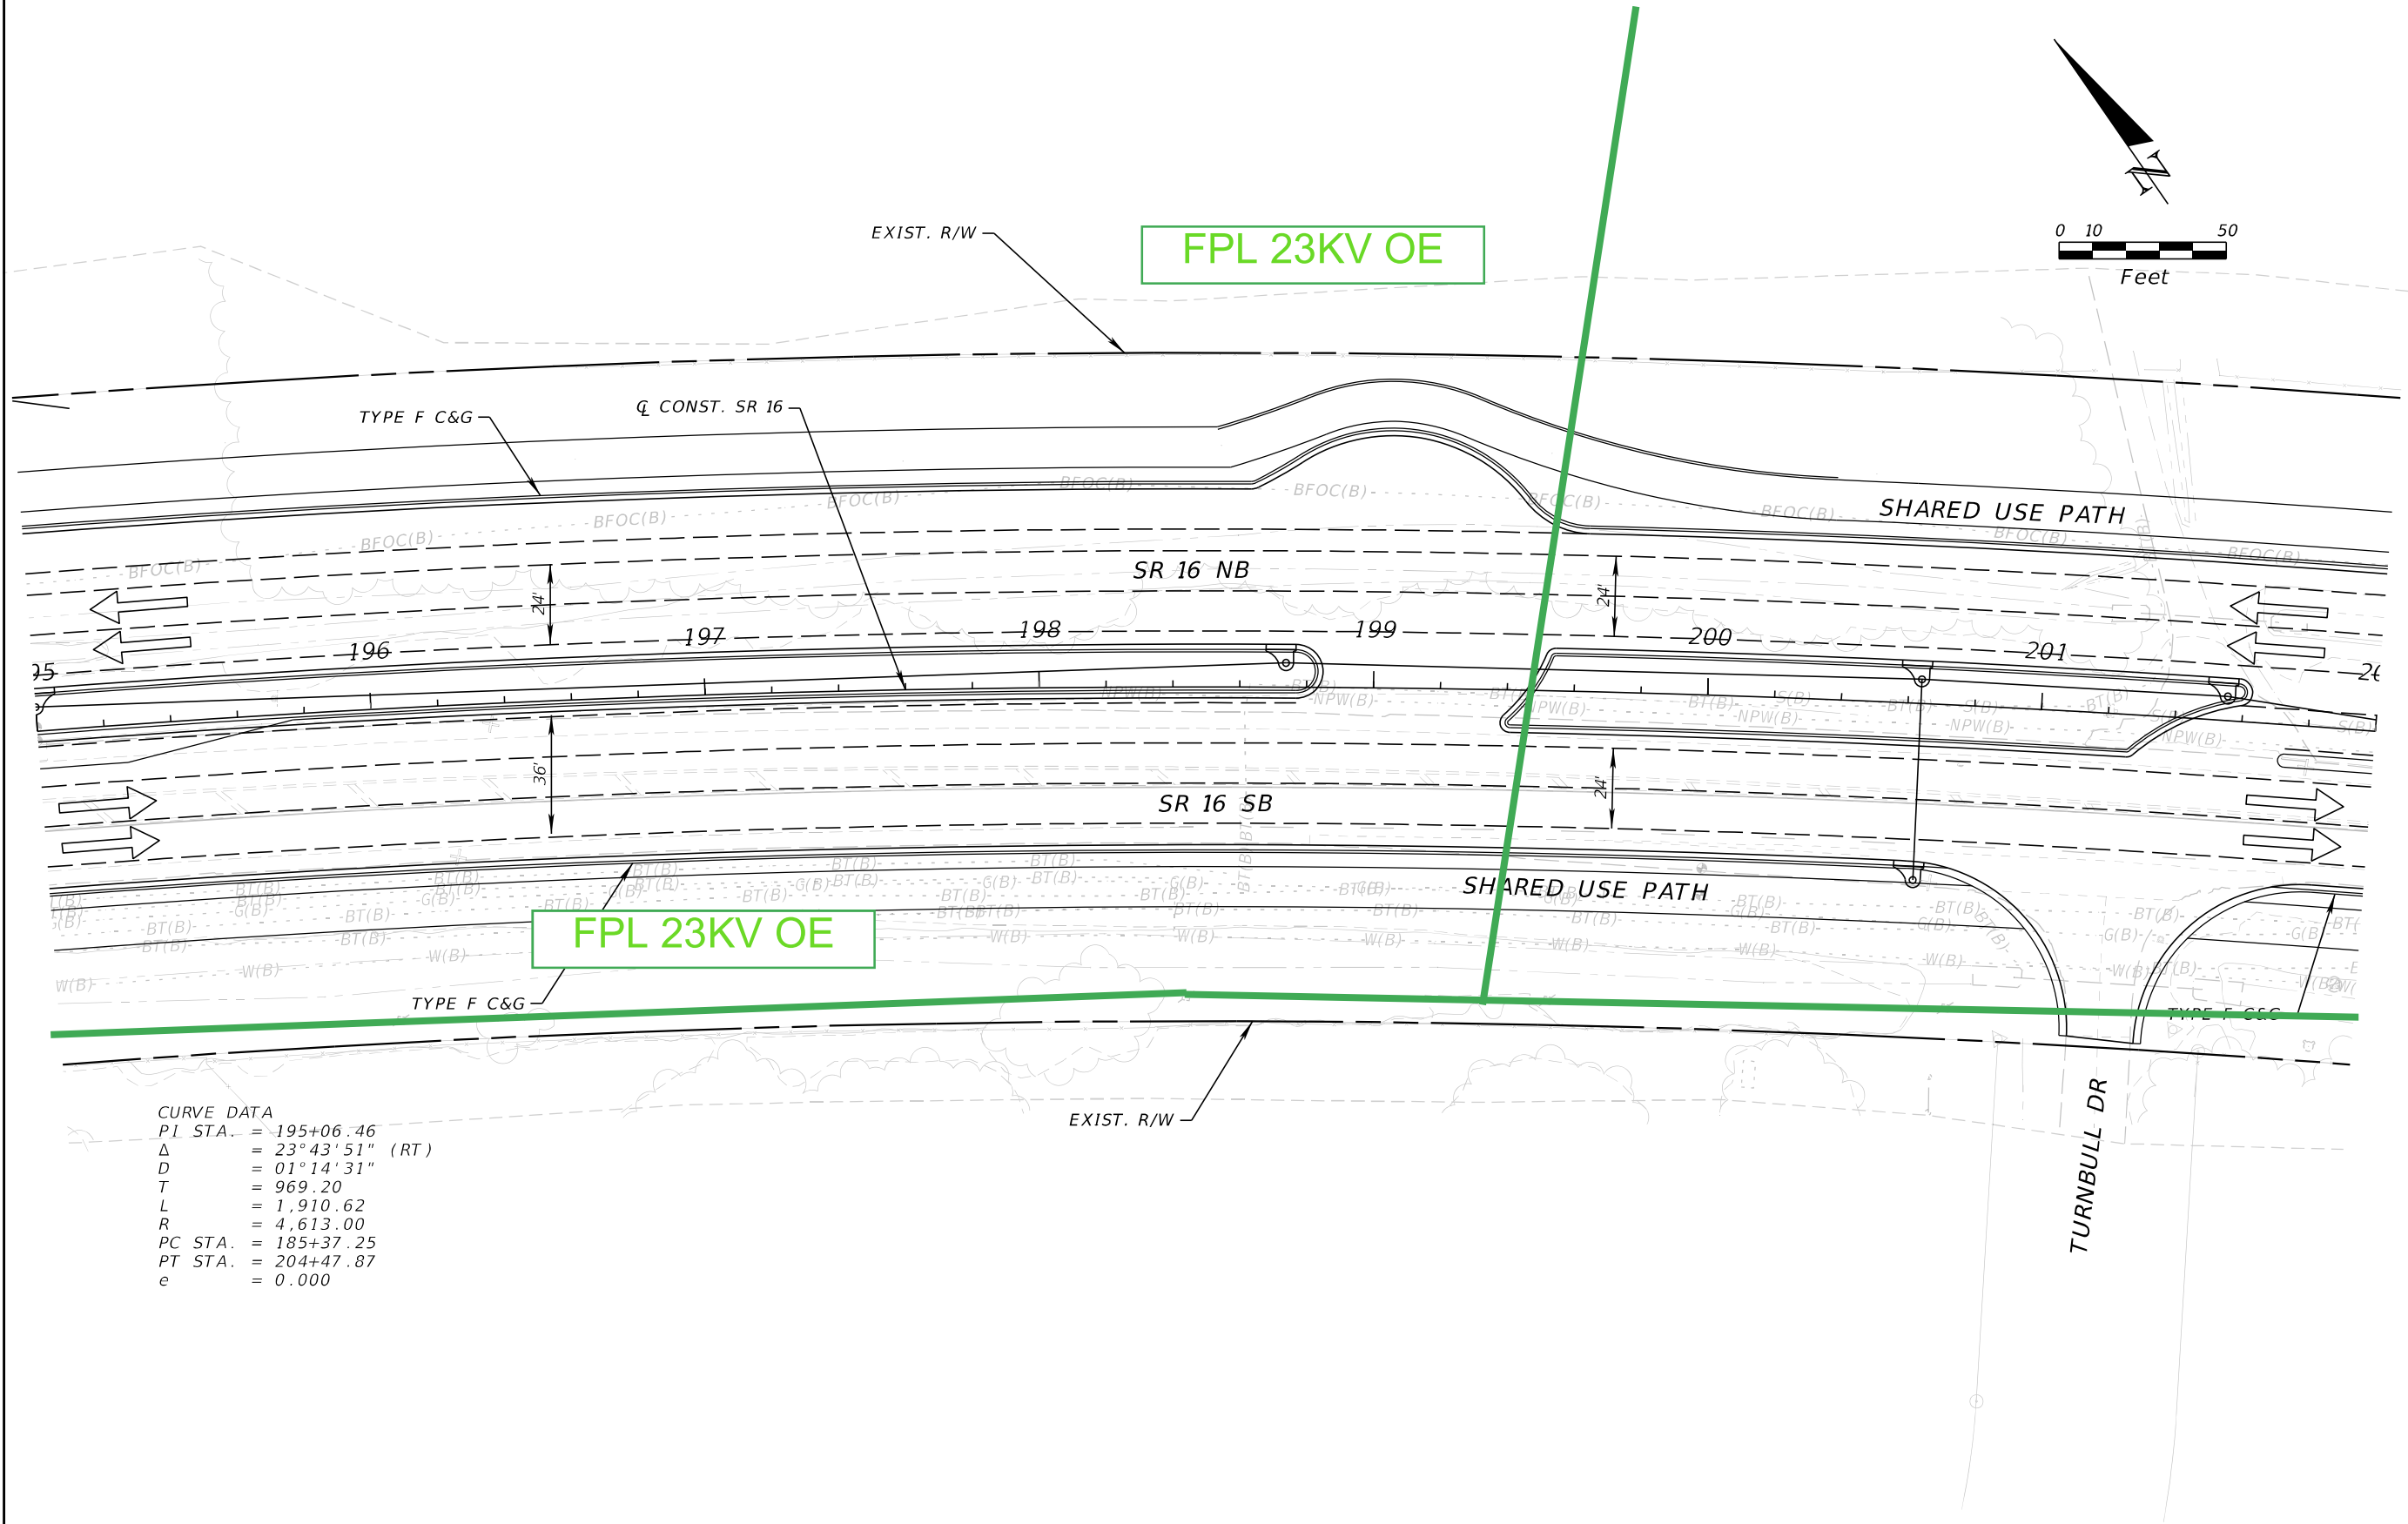


CURVE DATA
PI STA. = 195+06.46
Δ = 23°43'51" (RT)
D = 01°14'31"
T = 969.20
L = 1,910.62
R = 4,613.00
PC STA. = 185+37.25
PT STA. = 204+47.87
e = 0.000

| REVISIONS | | | | ENGINEER OF RECORD | | STATE OF FLORIDA DEPARTMENT OF TRANSPORTATION | | | SHEET NO. |
|-----------|-------------|------|-------------|---|--|--|-----------|----------------------|--------------|
| DATE | DESCRIPTION | DATE | DESCRIPTION | STEPHEN J. PARK, P.E. LICENSE NUMBER: 77656 RS&H, INC. 10748 DEERWOOD PARK BLVD. SOUTH JACKSONVILLE, FL 32256 | | ROAD NO. | COUNTY | FINANCIAL PROJECT ID | |
| | | | | | | SR 16 | ST. JOHNS | 210447-5-52-01 | |

THE OFFICIAL RECORD OF THIS SHEET IS THE ELECTRONIC FILE DIGITALLY SIGNED AND SEALED UNDER RULE 61G15-23.004, F.A.C.


8/5/2024 4:28:48 PM BeattyM
c:\pw_work\ysh_pw\pw_user\0439575\PLANRD01.dgn

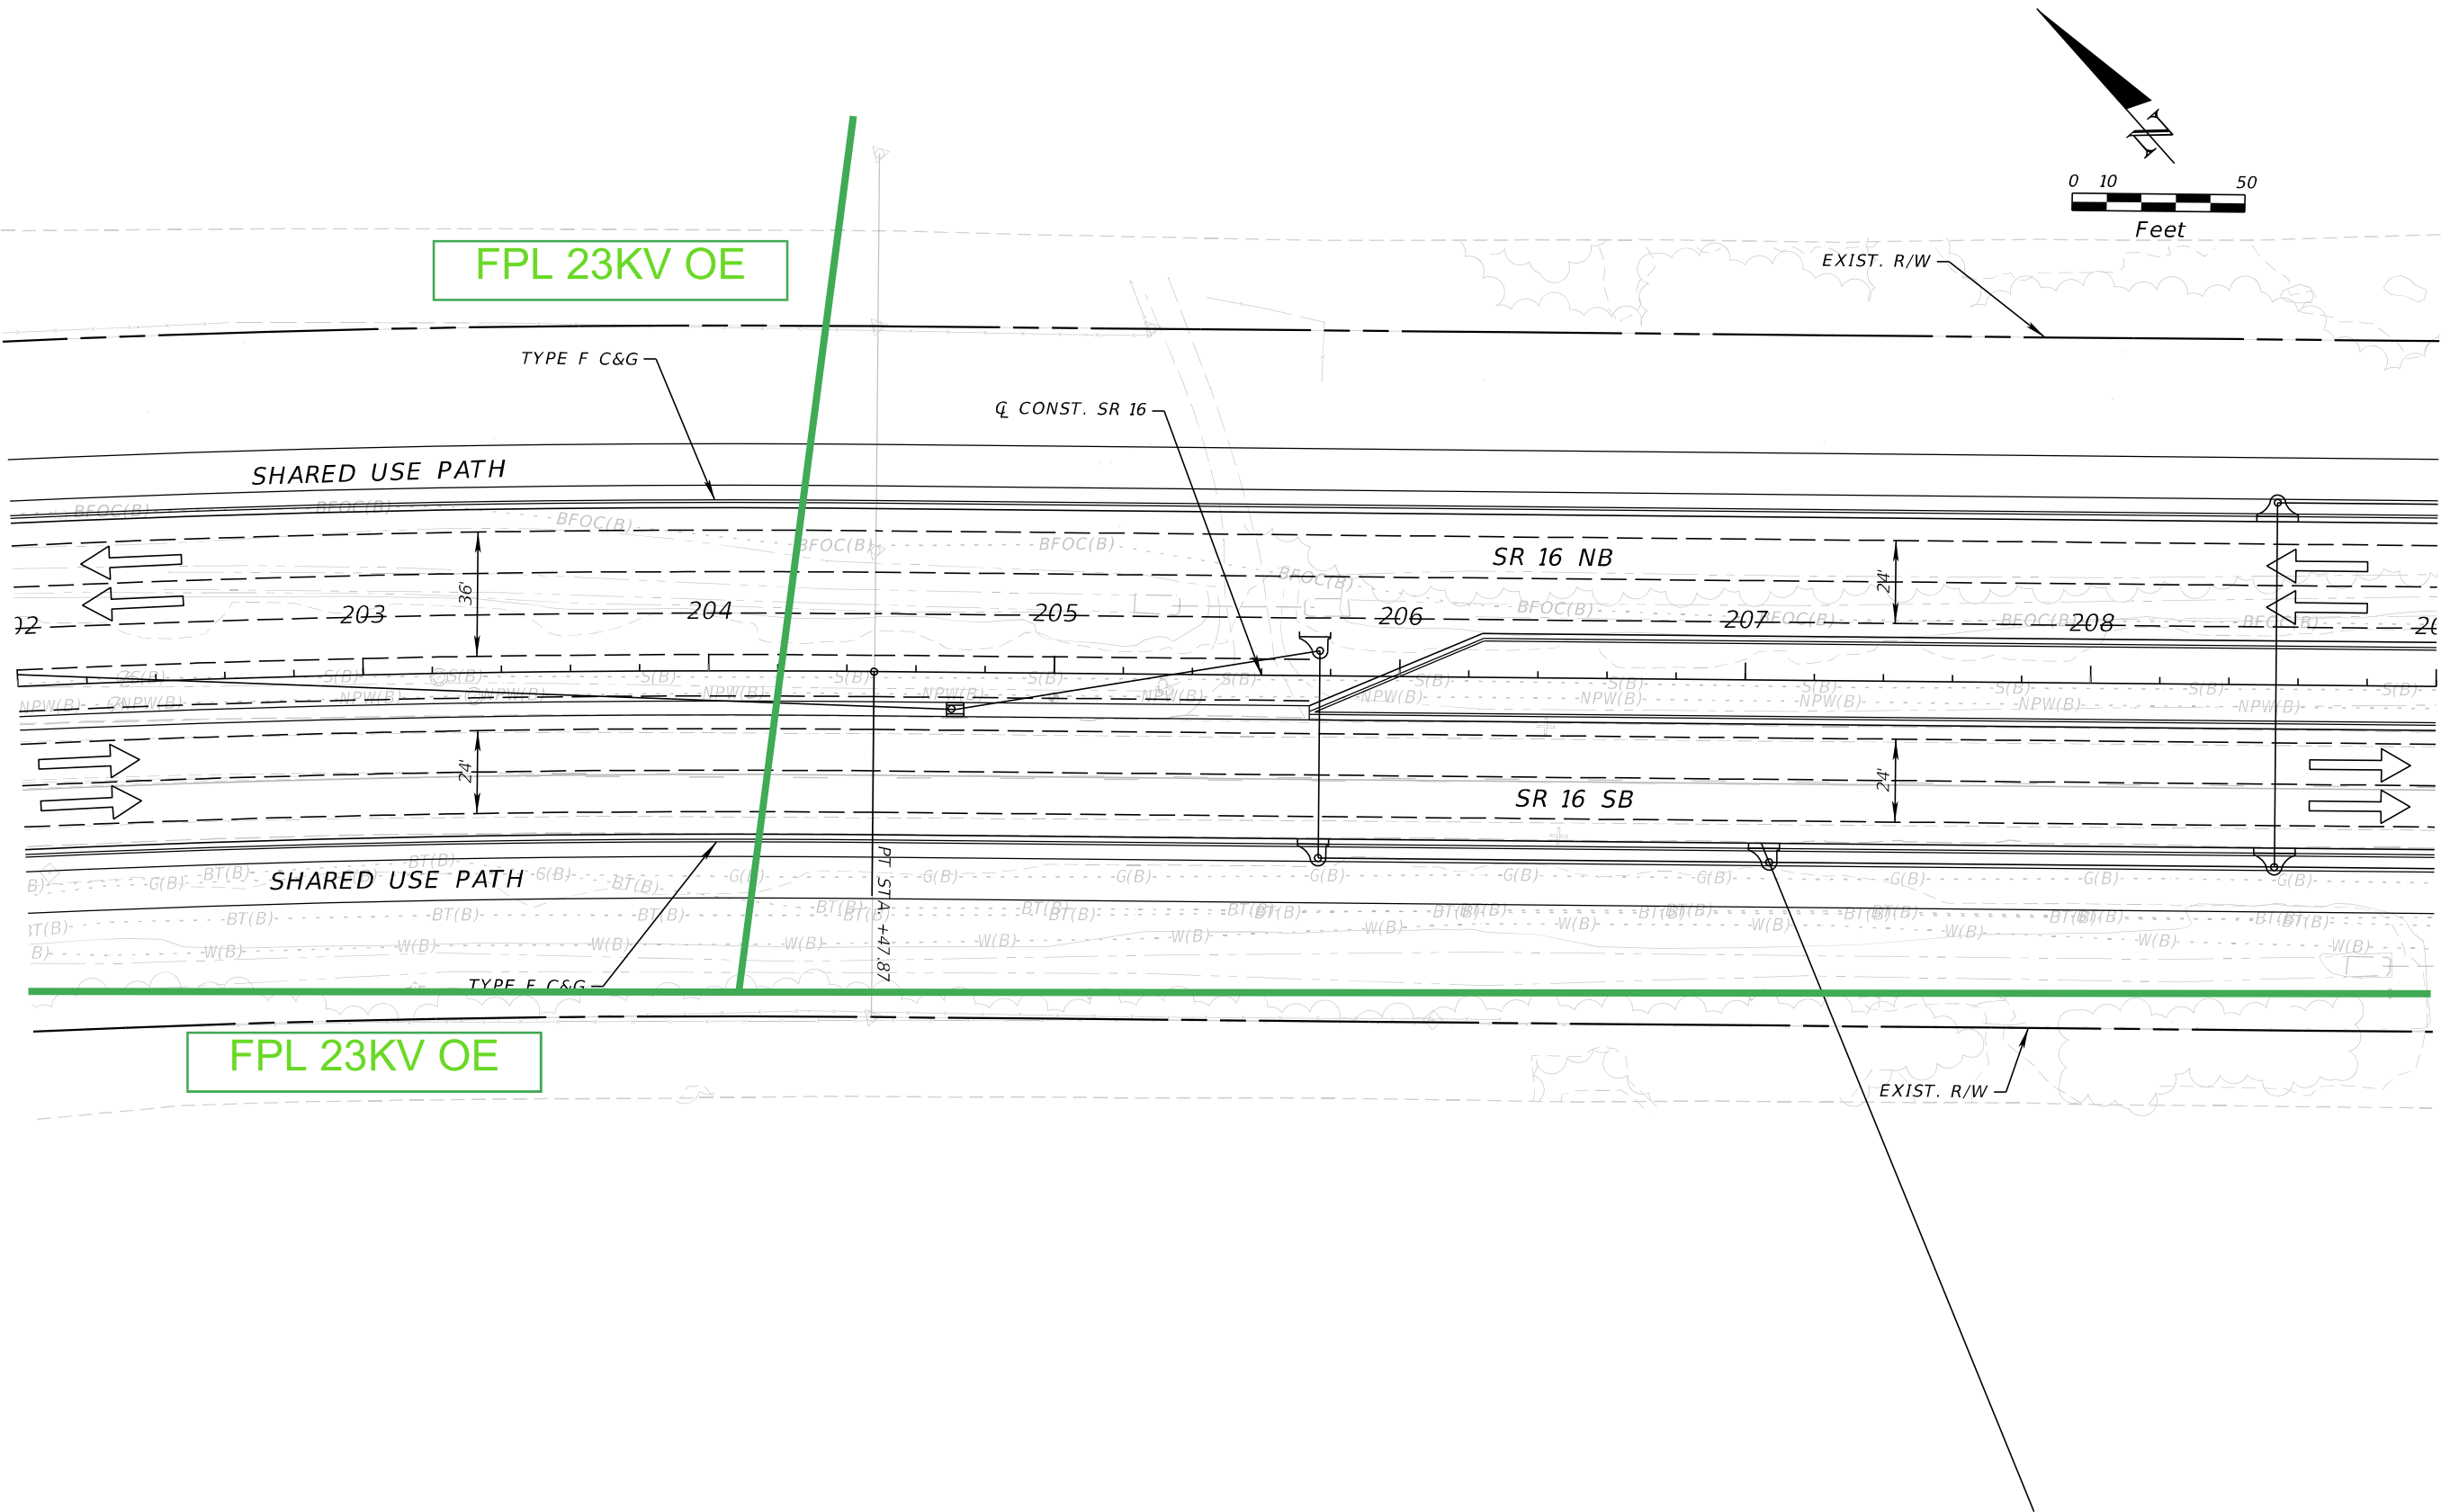

| REVISIONS | | | | ENGINEER OF RECORD | STATE OF FLORIDA DEPARTMENT OF TRANSPORTATION | | | SHEET NO. | | |
|-----------|-------------|--|------|--------------------|--|---|--------|--------------|----------------------|-----------------------|
| DATE | DESCRIPTION | | DATE | DESCRIPTION | | ROAD NO. | COUNTY | | FINANCIAL PROJECT ID | |
| | | | | | | STEPHEN J. PARK, P.E. LICENSE NUMBER: 77656 RS&H, INC. 10748 DEERWOOD PARK BLVD. SOUTH JACKSONVILLE, FL 32256 | SR 16 | ST. JOHNS | 210447-5-52-01 | 11x17 Plan Only |
| | | | | | | | | | | |

THE OFFICIAL RECORD OF THIS SHEET IS THE ELECTRONIC FILE DIGITALLY SIGNED AND SEALED UNDER RULE 61G15-23.004, F.A.C.


8/5/2024 4:28:48 PM BeattyM
c:\pw_work\ysh_pw\pw_user\0439575\PLANRD01.dgn

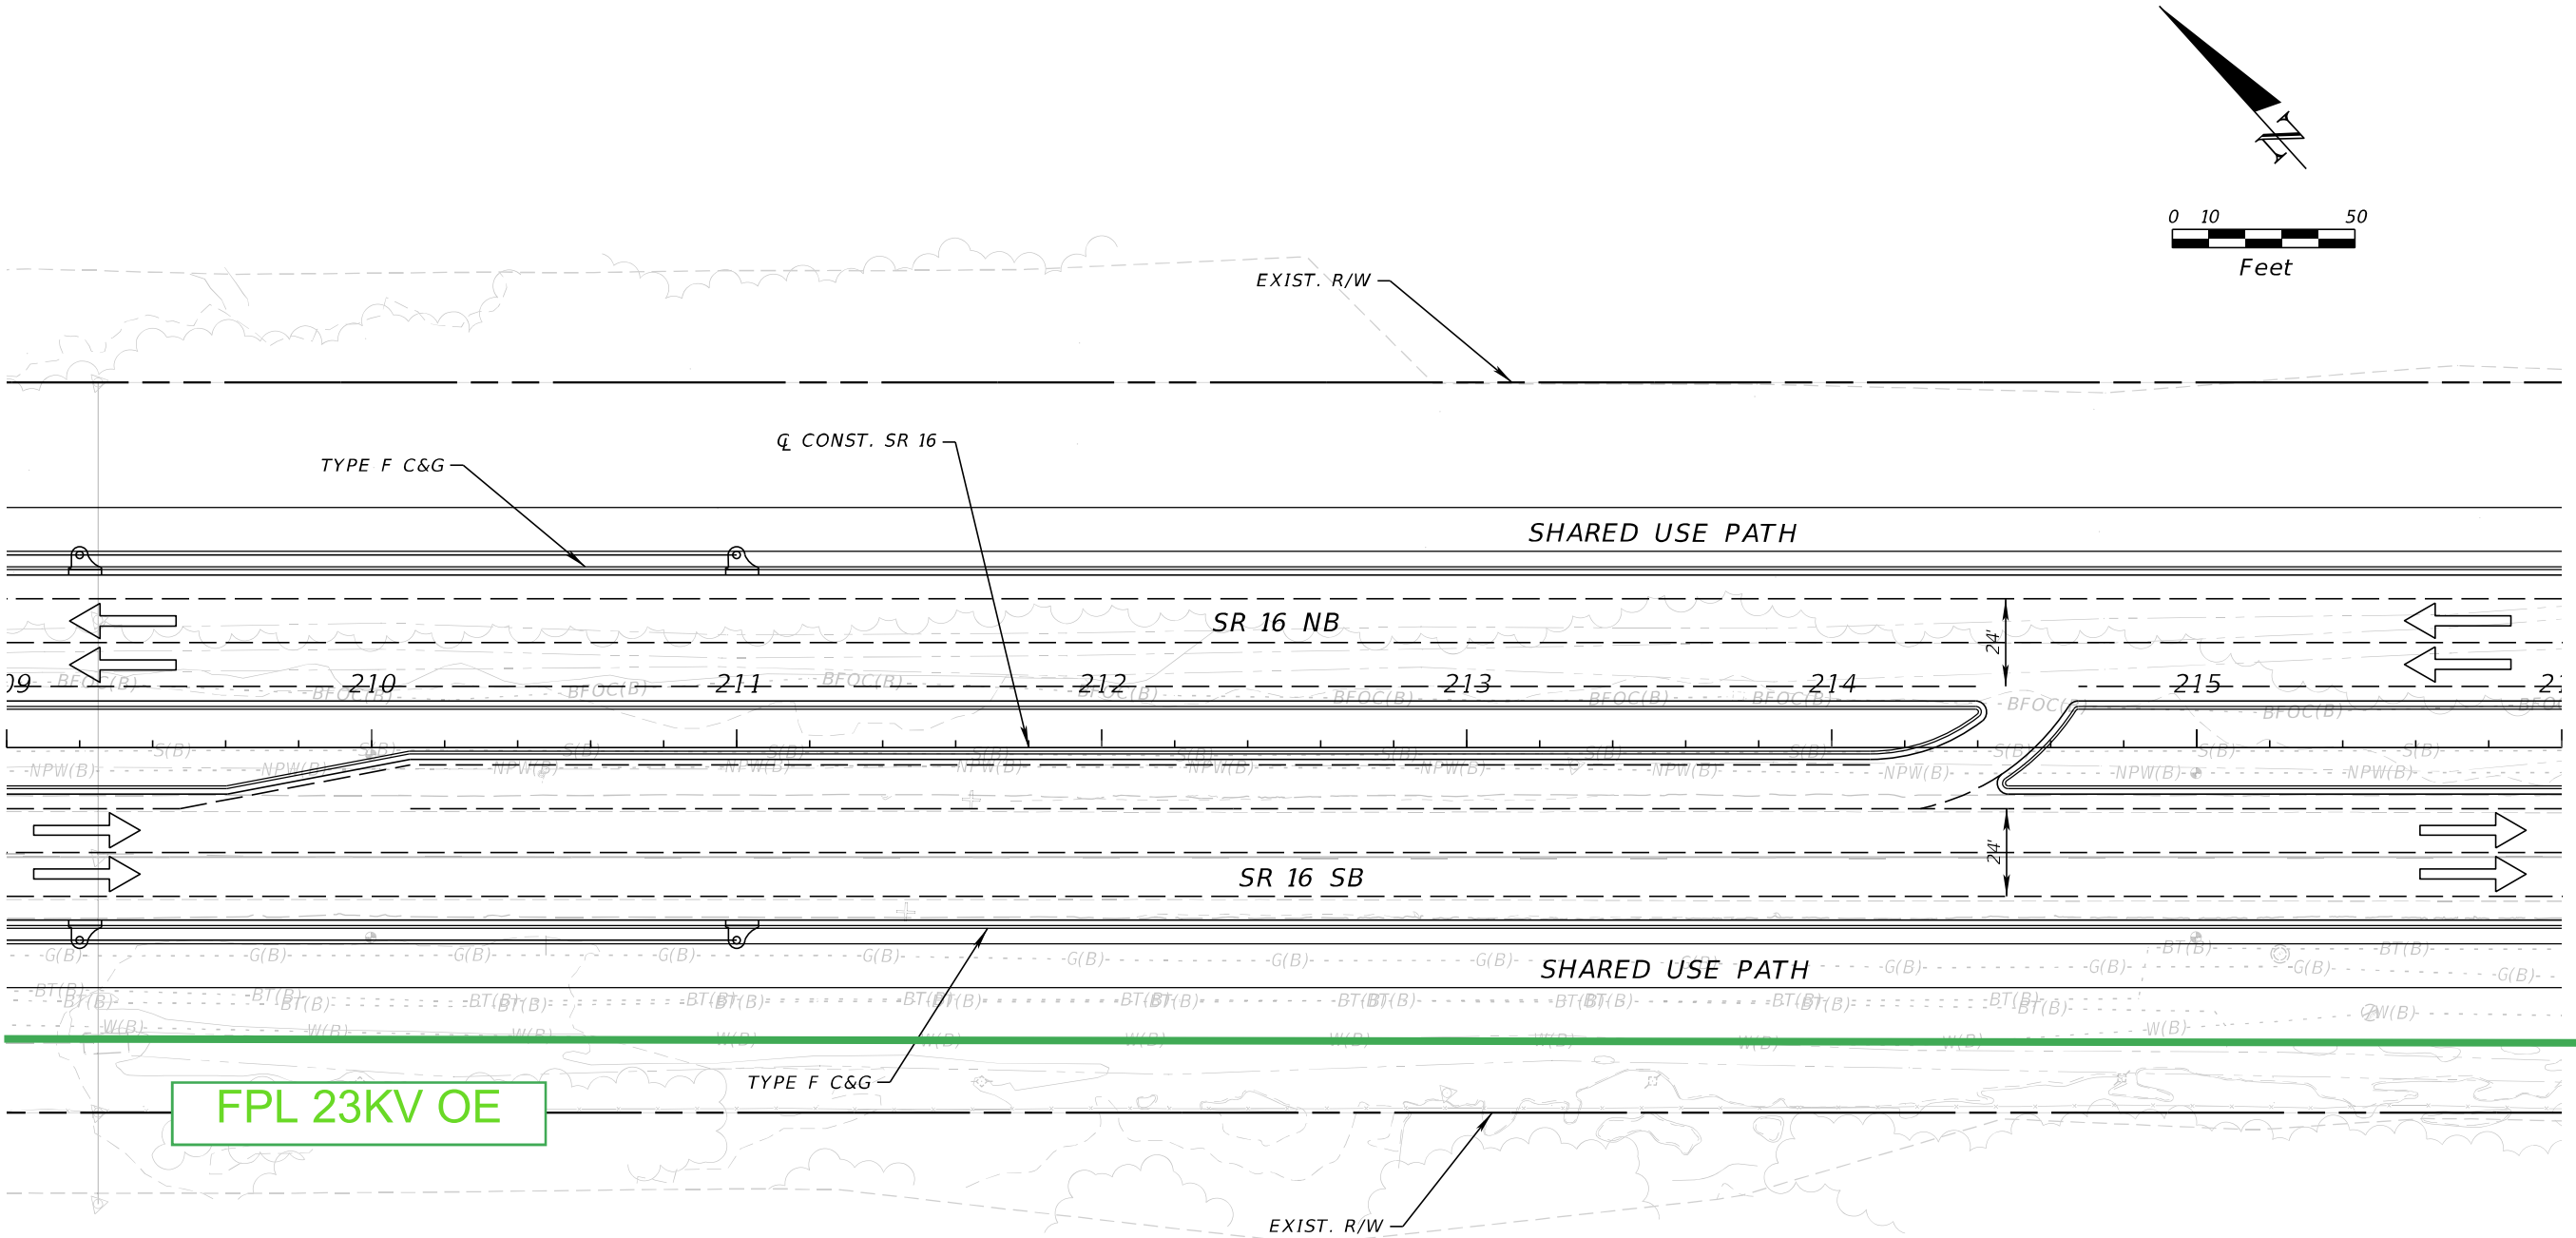

| REVISIONS | | | | ENGINEER OF RECORD | STATE OF FLORIDA DEPARTMENT OF TRANSPORTATION | | | SHEET NO. |
|-----------|-------------|------|-------------|---|--|-----------|----------------------|--------------|
| DATE | DESCRIPTION | DATE | DESCRIPTION | STEPHEN J. PARK, P.E. LICENSE NUMBER: 77656 RS&H, INC. 10748 DEERWOOD PARK BLVD. SOUTH JACKSONVILLE, FL 32256 | ROAD NO. | COUNTY | FINANCIAL PROJECT ID | |
| | | | | | SR 16 | ST. JOHNS | 210447-5-52-01 | |

THE OFFICIAL RECORD OF THIS SHEET IS THE ELECTRONIC FILE DIGITALLY SIGNED AND SEALED UNDER RULE 61G15-23.004, F.A.C.


8/5/2024 4:28:49 PM BeattyM
c:\pw_work\sh_pw\pw_user\0439575\PLANRD01.dgn

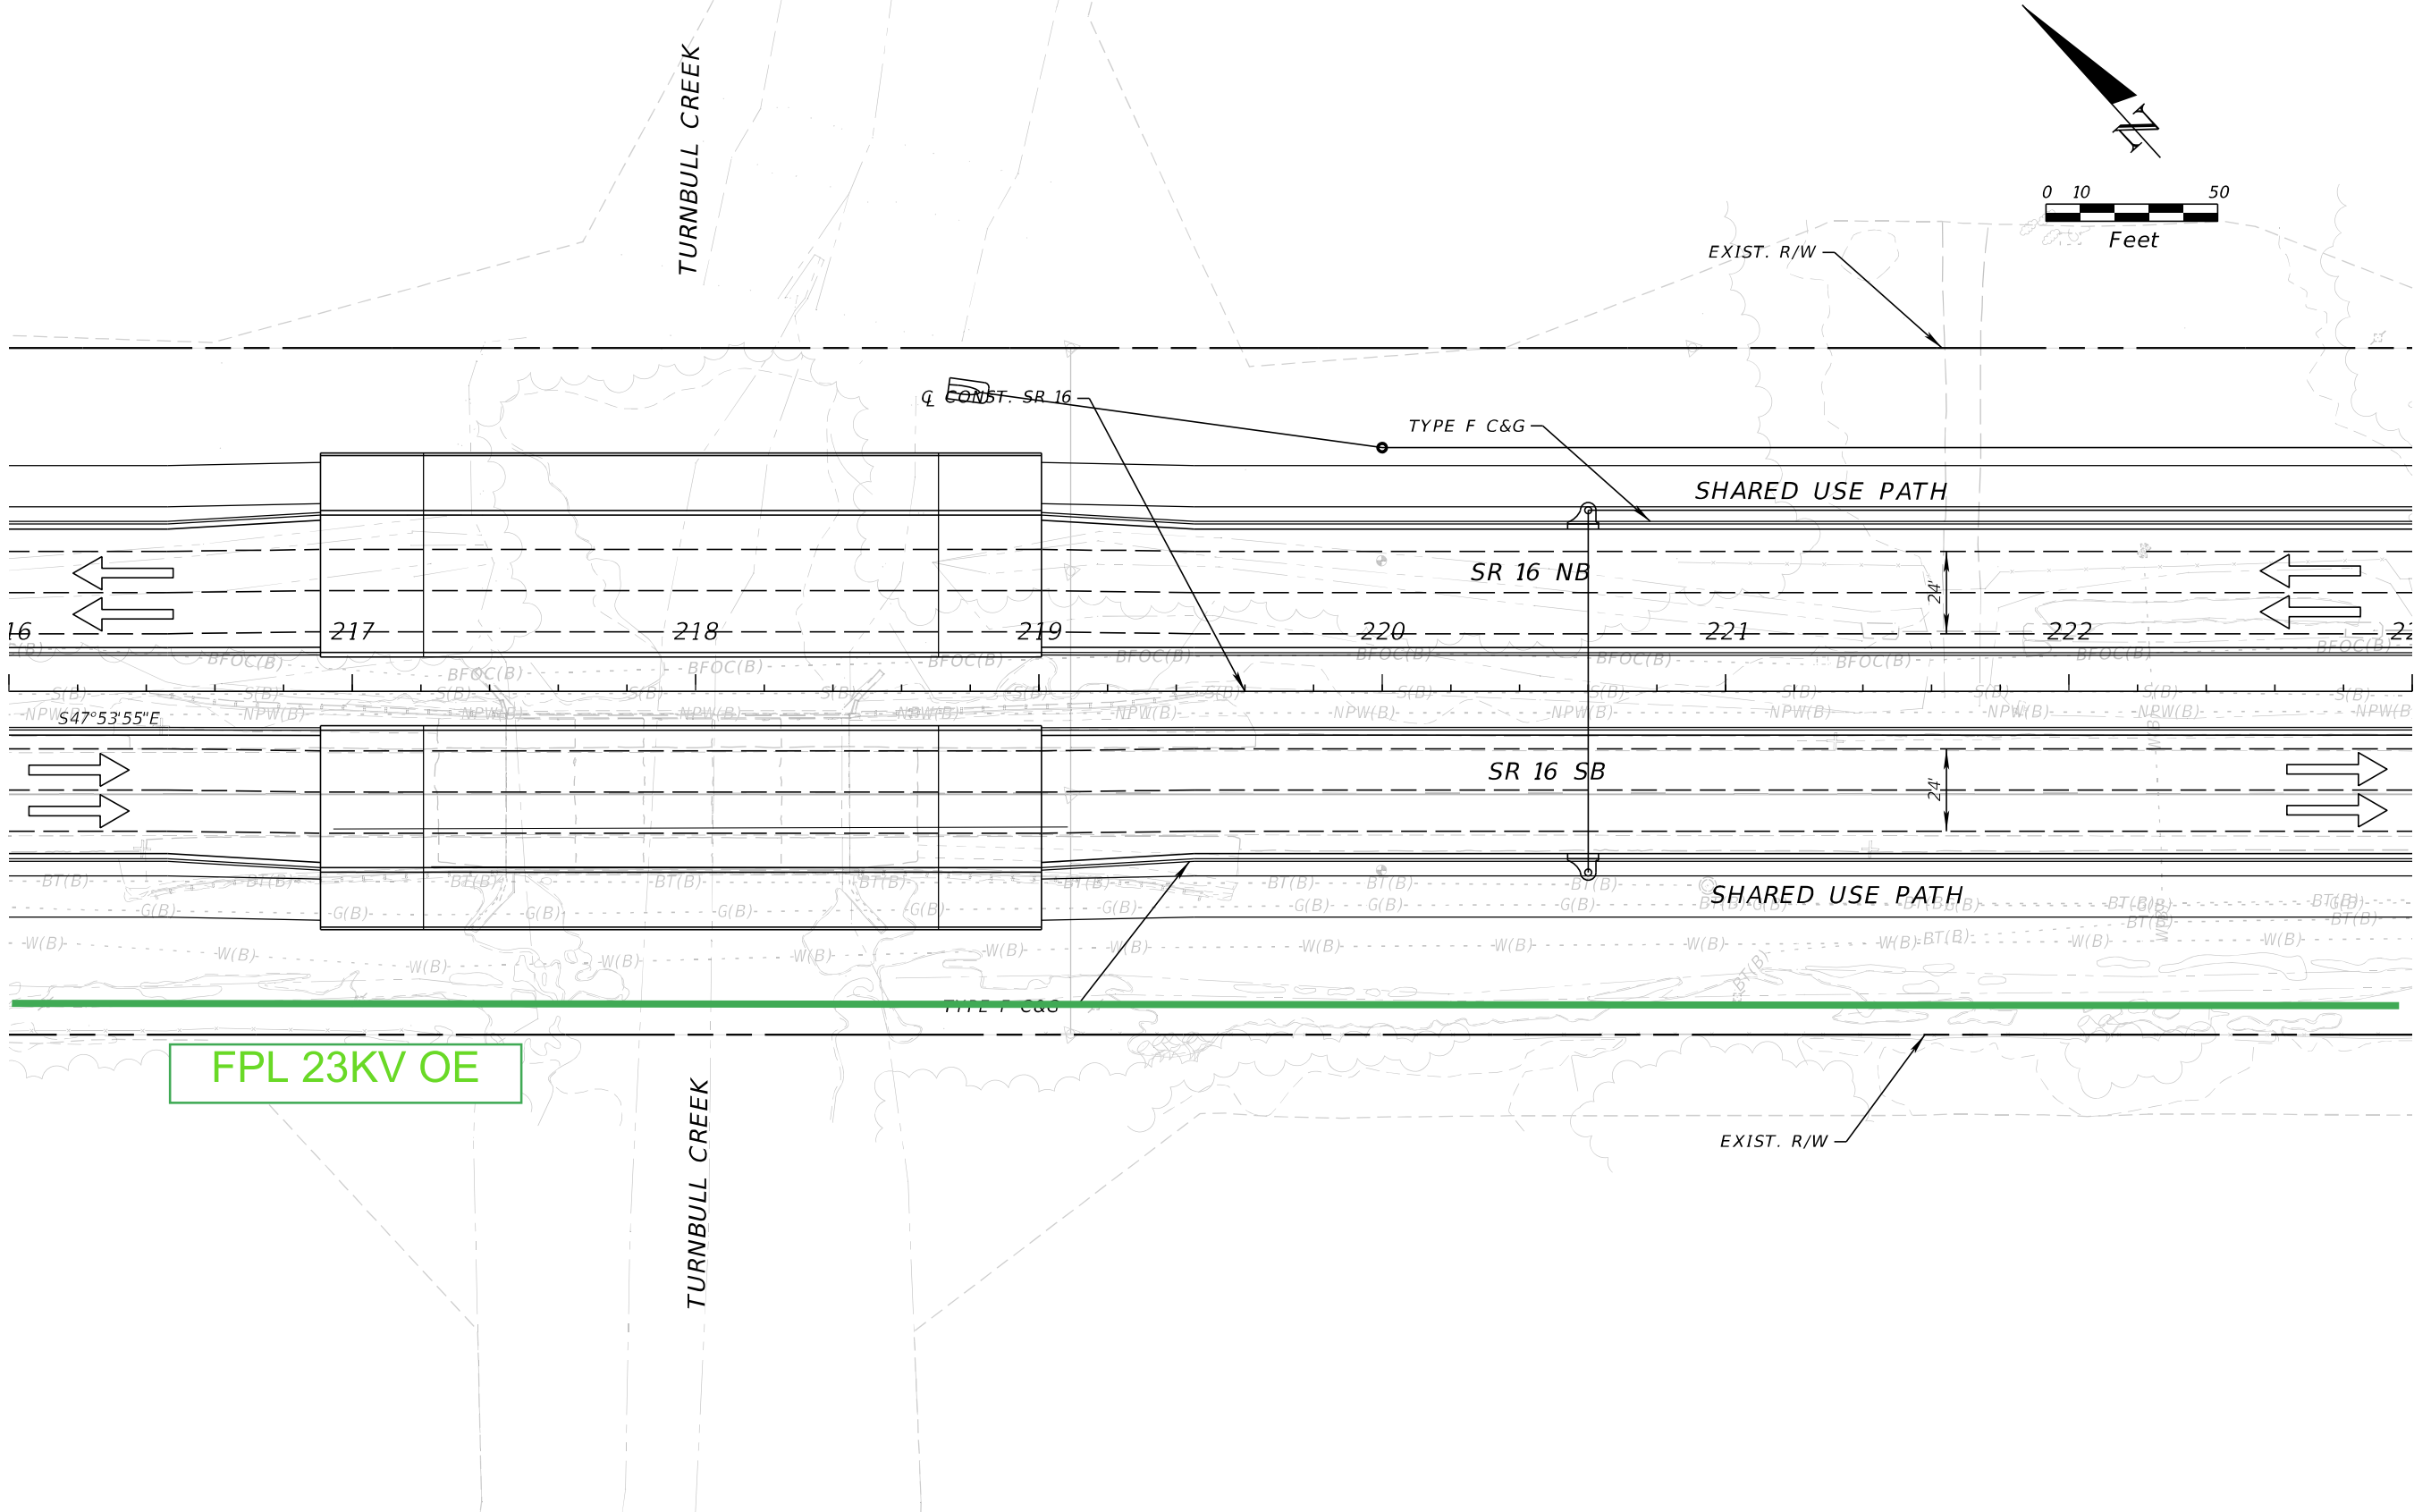

| REVISIONS | | | | ENGINEER OF RECORD | STATE OF FLORIDA DEPARTMENT OF TRANSPORTATION | | | SHEET NO. | | |
|-----------|-------------|--|------|--------------------|--|---|--------|--------------|----------------------|-----------------------|
| DATE | DESCRIPTION | | DATE | DESCRIPTION | | ROAD NO. | COUNTY | | FINANCIAL PROJECT ID | |
| | | | | | | STEPHEN J. PARK, P.E. LICENSE NUMBER: 77656 RS&H, INC. 10748 DEERWOOD PARK BLVD. SOUTH JACKSONVILLE, FL 32256 | SR 16 | ST. JOHNS | 210447-5-52-01 | 11x17 Plan Only |
| | | | | | | | | | | |

THE OFFICIAL RECORD OF THIS SHEET IS THE ELECTRONIC FILE DIGITALLY SIGNED AND SEALED UNDER RULE 61G15-23.004, F.A.C.


8/5/2024 4:28:49 PM BeattyM
c:\pw_work\sh_pw\pw_user\0439575\PLAINRD01.dgn

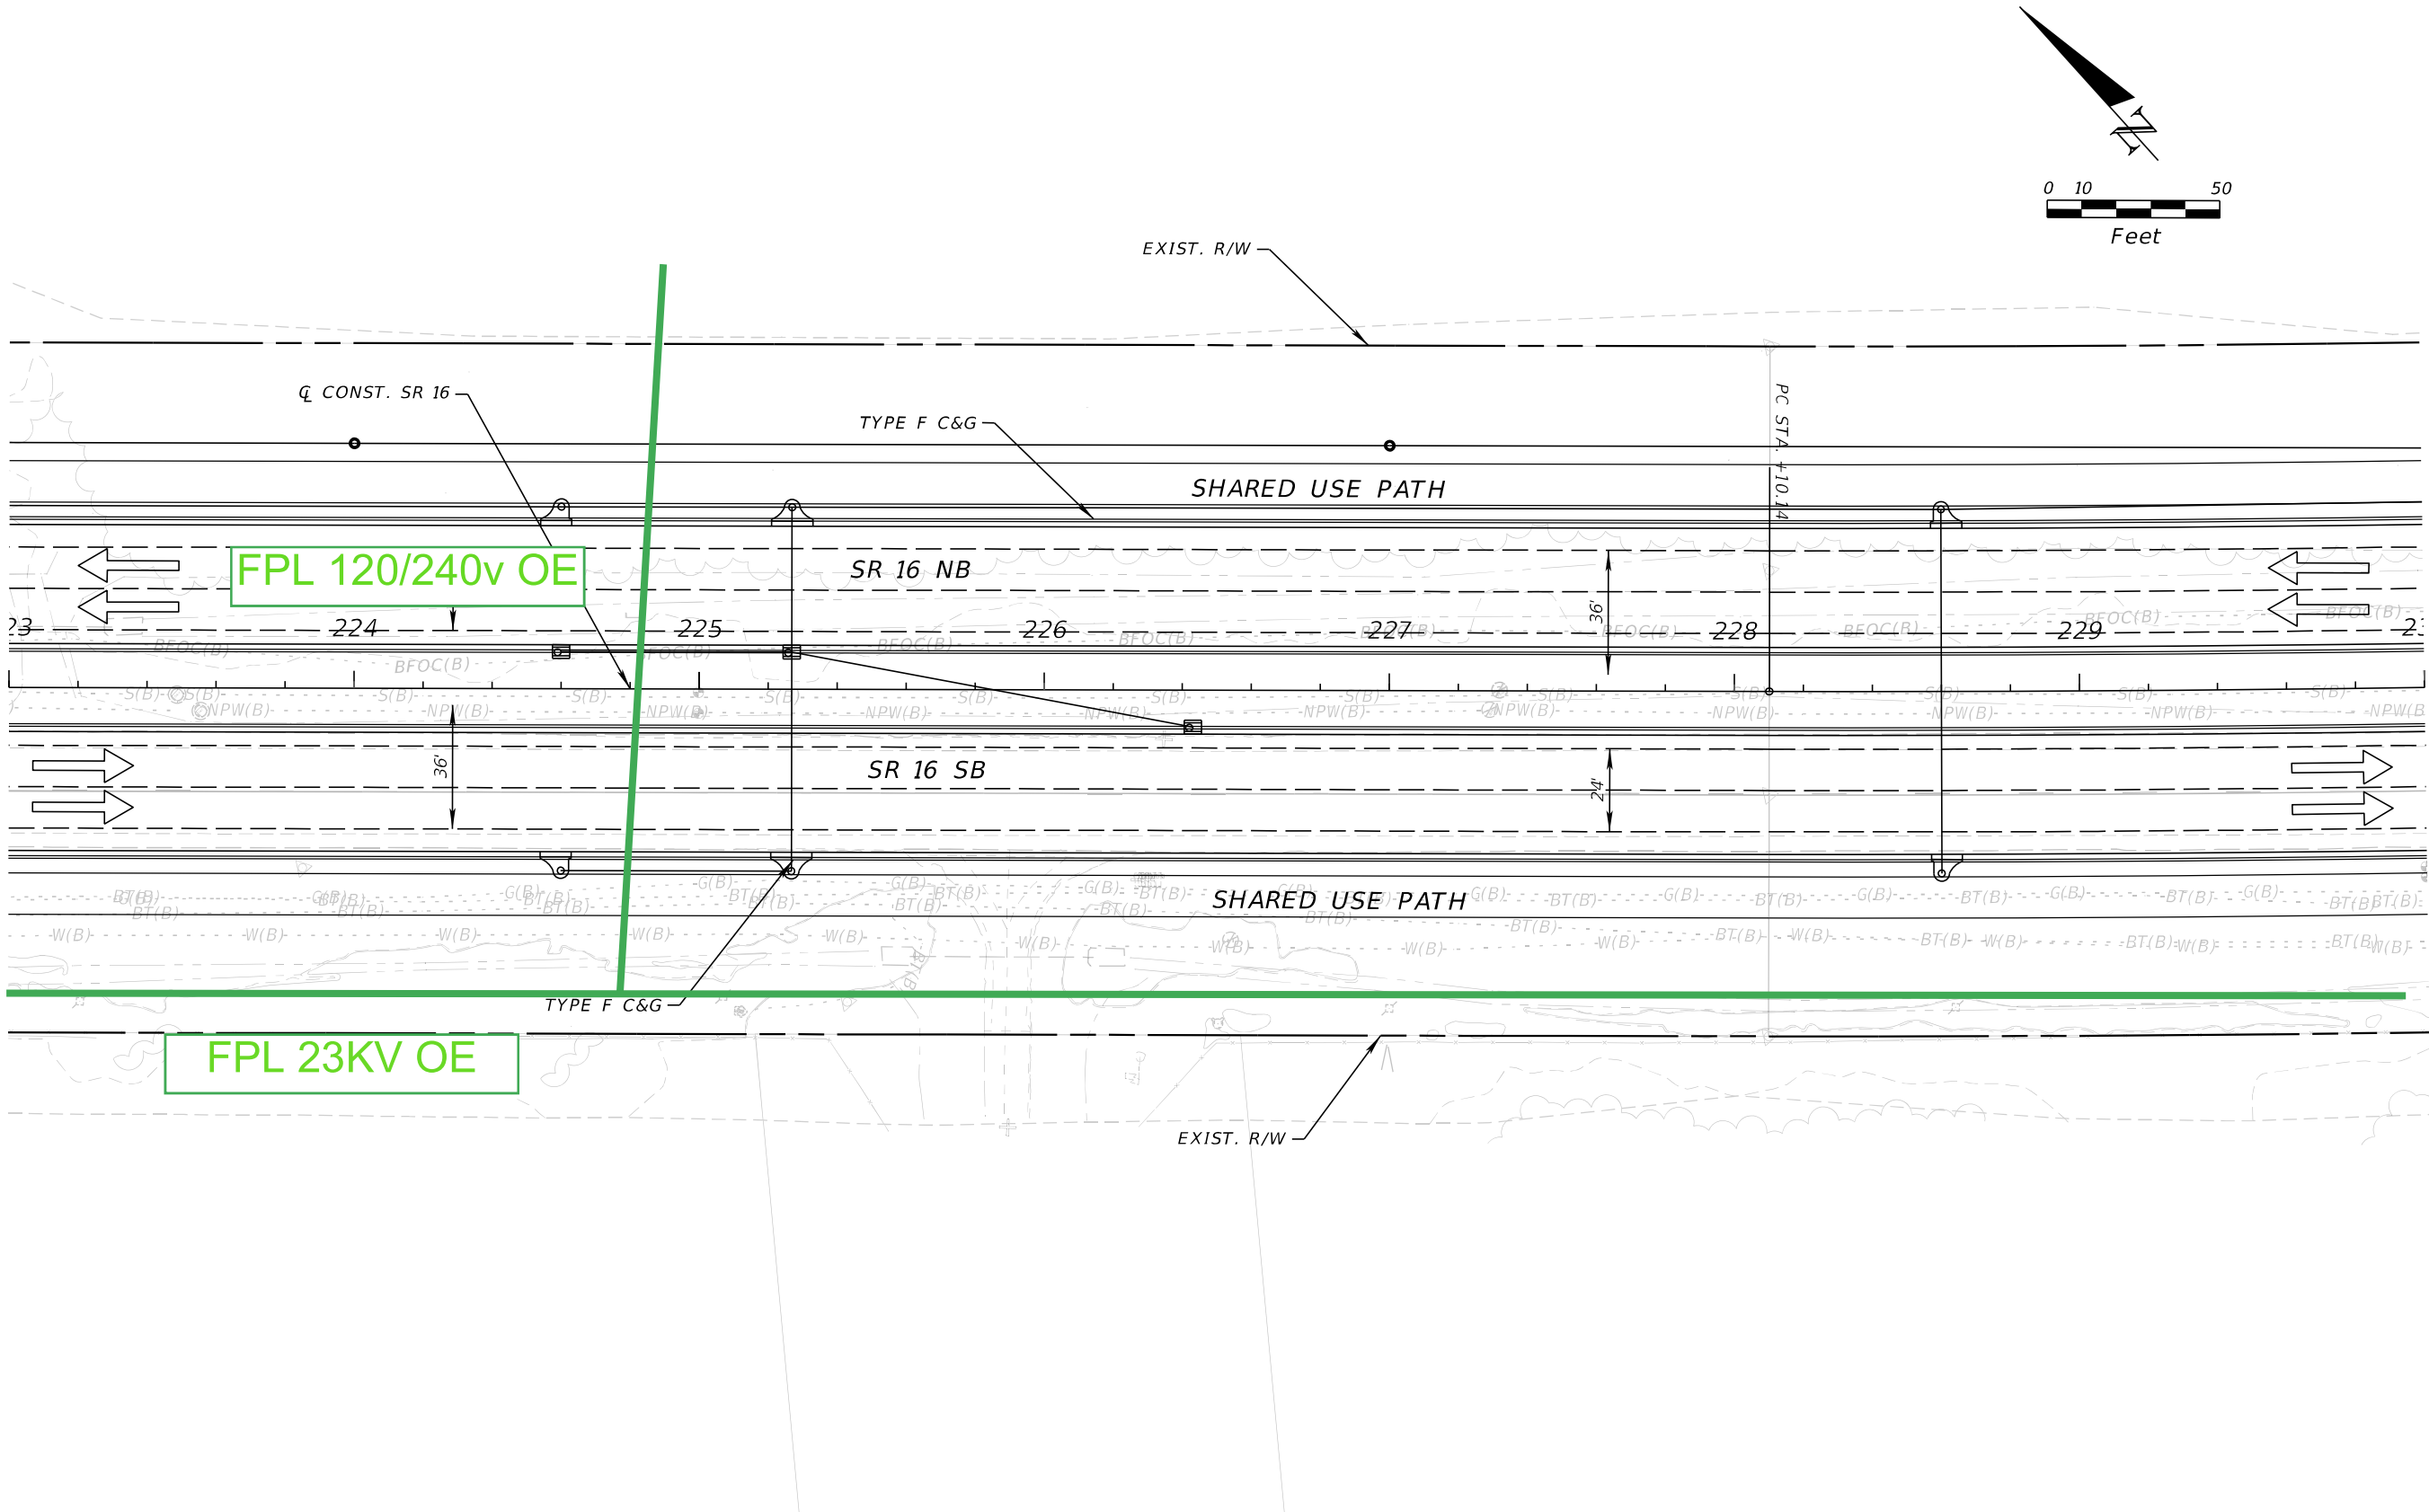

| REVISIONS | | | | ENGINEER OF RECORD | | STATE OF FLORIDA DEPARTMENT OF TRANSPORTATION | | | ROADWAY PLAN | SHEET NO. SR 16 - PLAN - 19 |
|-----------|-------------|------|-------------|---|--|--|-----------|----------------------|--------------|--|
| DATE | DESCRIPTION | DATE | DESCRIPTION | STEPHEN J. PARK, P.E. LICENSE NUMBER: 77656 RS&H, INC. 10748 DEERWOOD PARK BLVD. SOUTH JACKSONVILLE, FL 32256 | | ROAD NO. | COUNTY | FINANCIAL PROJECT ID | | |
| | | | | | | SR 16 | ST. JOHNS | 210447-5-52-01 | | |

THE OFFICIAL RECORD OF THIS SHEET IS THE ELECTRONIC FILE DIGITALLY SIGNED AND SEALED UNDER RULE 61G15-23.004, F.A.C.

8/5/2024 4:28:50 PM BeattyM
c:\pw_work\sh_pw\pw_user\0439575\PLANRD01.dgn


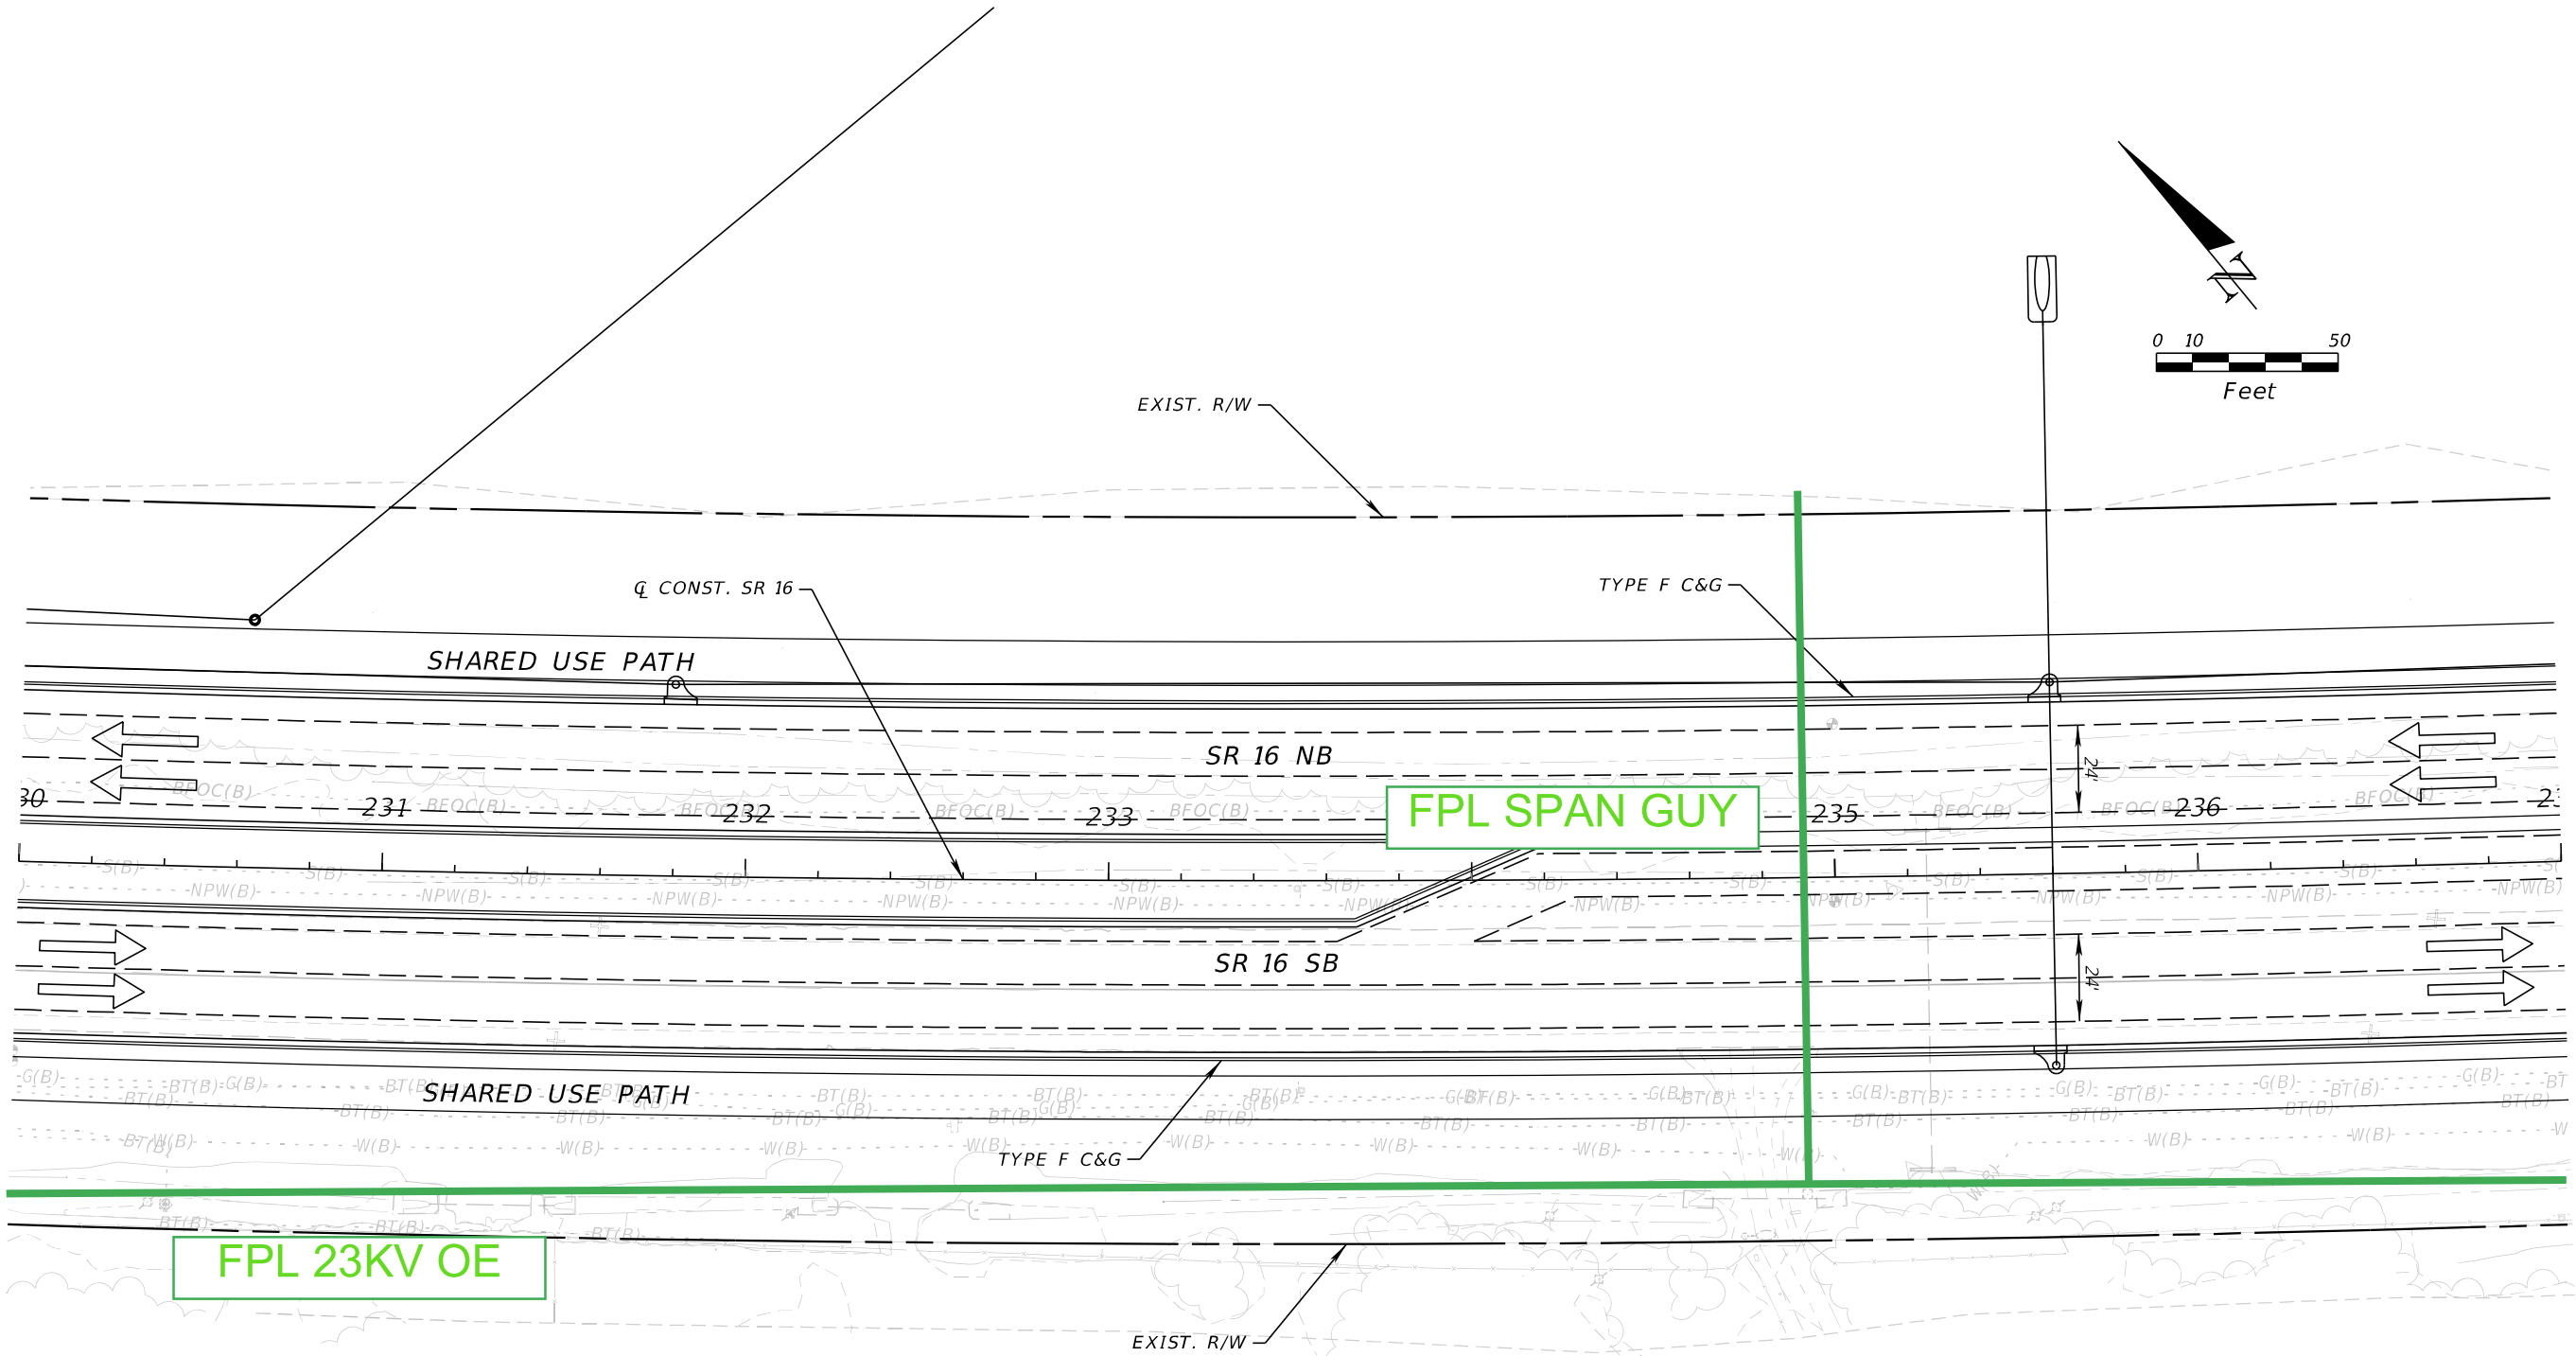


| REVISIONS | | | | ENGINEER OF RECORD | STATE OF FLORIDA DEPARTMENT OF TRANSPORTATION | | | SHEET NO. |
|-----------|-------------|------|-------------|---|--|-----------|----------------------|-----------------------|
| DATE | DESCRIPTION | DATE | DESCRIPTION | STEPHEN J. PARK, P.E. LICENSE NUMBER: 77656 RS&H, INC. 10748 DEERWOOD PARK BLVD. SOUTH JACKSONVILLE, FL 32256 | ROAD NO. | COUNTY | FINANCIAL PROJECT ID | |
| | | | | | SR 16 | ST. JOHNS | 210447-5-52-01 | |
| | | | | | | | | 11x17 Plan Only |

THE OFFICIAL RECORD OF THIS SHEET IS THE ELECTRONIC FILE DIGITALLY SIGNED AND SEALED UNDER RULE 61G15-23.004, F.A.C.

8/5/2024 4:28:51 PM BeattyM
c:\pw_work\sh_pw\pw_user\0439575\PLANRD01.dgn


CURVE DATA
PI STA. = 239+02.25
Δ = 10°55'00" (LT)
D = 00°30'05"
T = 1,092.10
L = 2,177.60
R = 2,177.60
PC STA. = 228+10.14
PT STA. = 249+87.74
e = 0.000

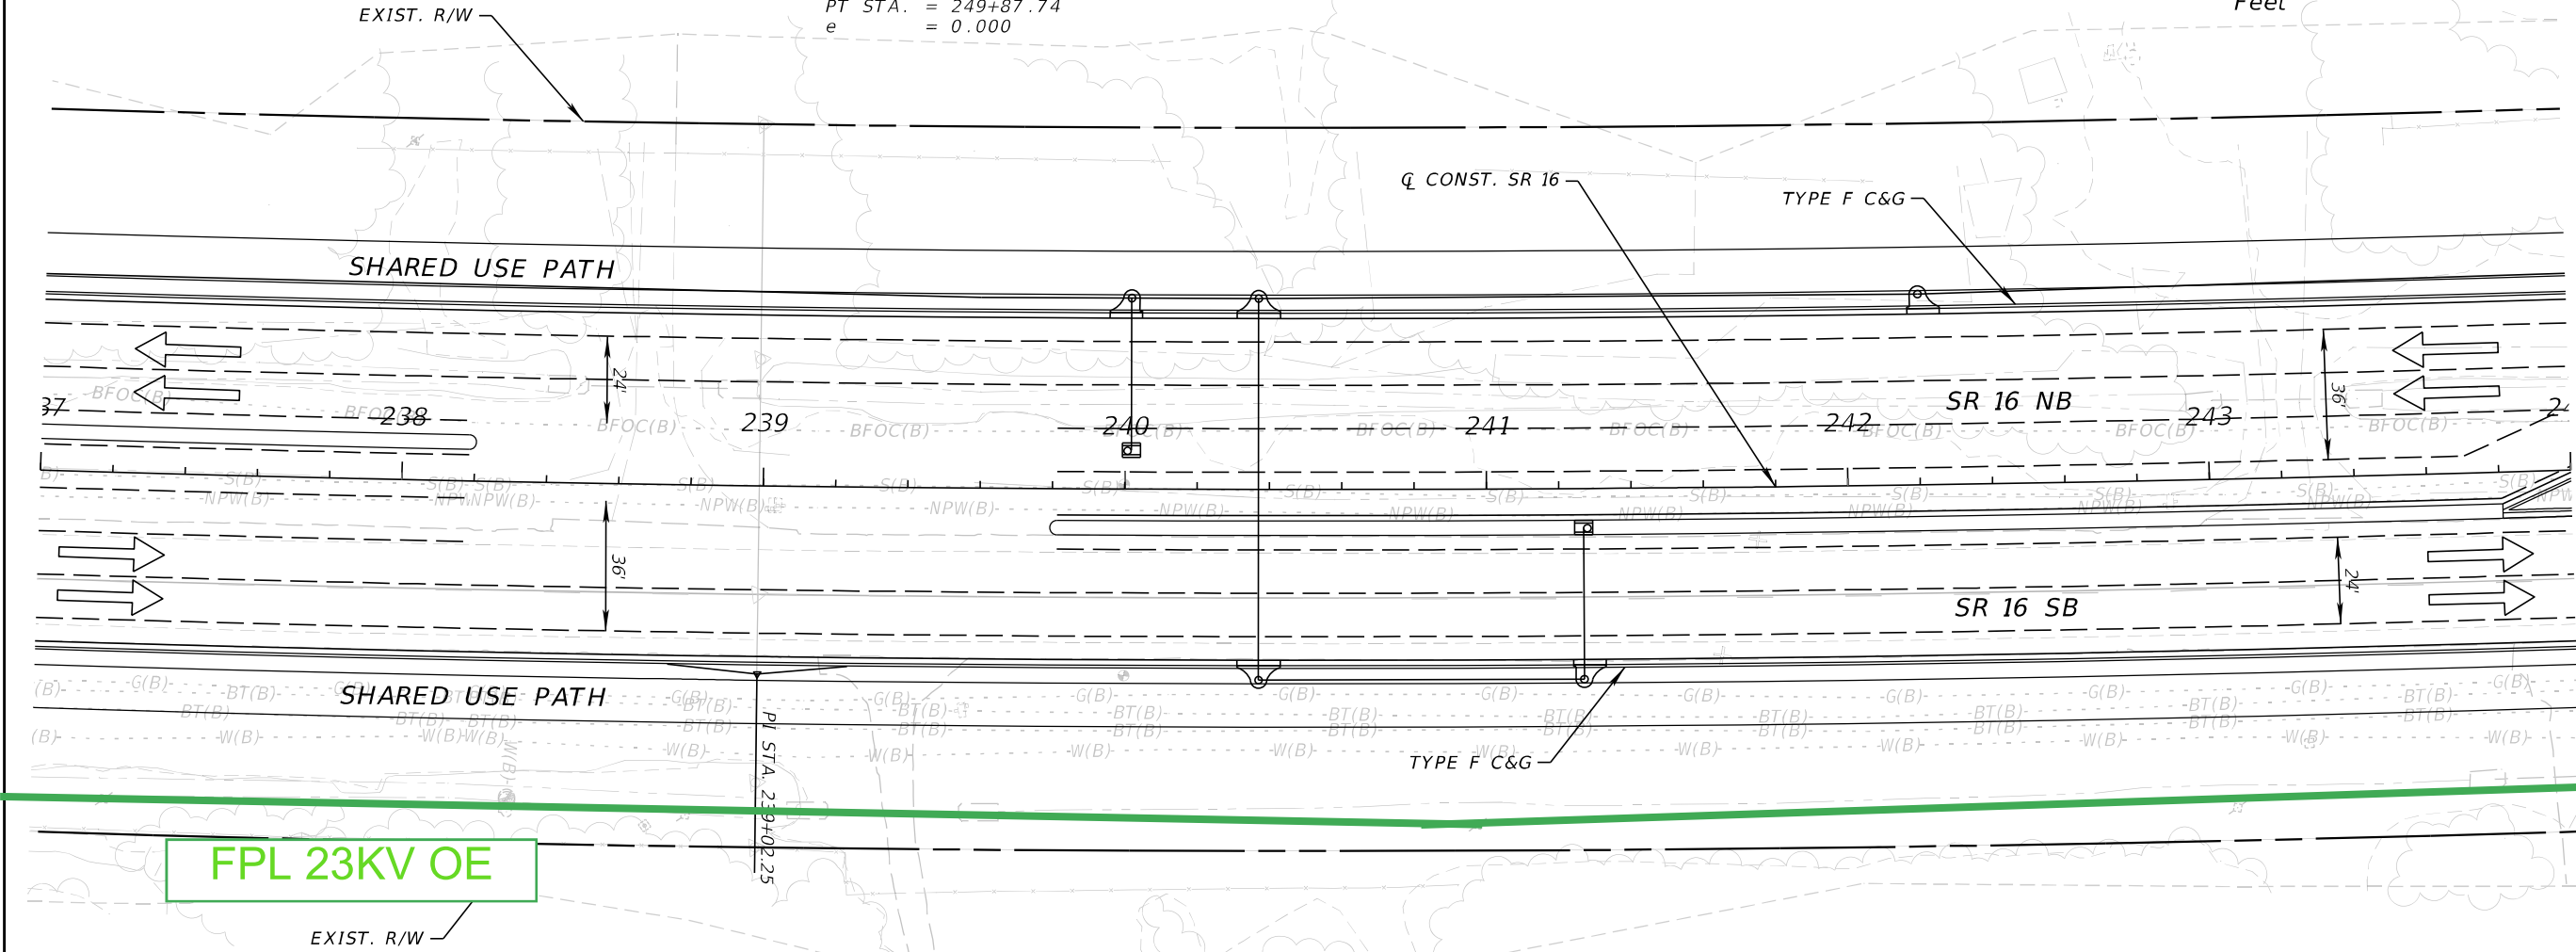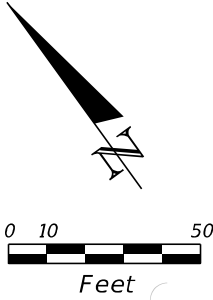

| REVISIONS | | | | ENGINEER OF RECORD | STATE OF FLORIDA DEPARTMENT OF TRANSPORTATION | | | SHEET NO. |
|-----------|-------------|------|-------------|---|--|-----------|----------------------|-----------------------|
| DATE | DESCRIPTION | DATE | DESCRIPTION | STEPHEN J. PARK, P.E. LICENSE NUMBER: 77656 RS&H, INC. 10748 DEERWOOD PARK BLVD. SOUTH JACKSONVILLE, FL 32256 | ROAD NO. | COUNTY | FINANCIAL PROJECT ID | |
| | | | | | SR 16 | ST. JOHNS | 210447-5-52-01 | |
| | | | | | | | | 11x17 Plan Only |

THE OFFICIAL RECORD OF THIS SHEET IS THE ELECTRONIC FILE DIGITALLY SIGNED AND SEALED UNDER RULE 61G15-23.004, F.A.C.


8/5/2024 4:28:51 PM BeattyM
c:\pw_work\sh_pw\pw_user\0439575\PLAINRD01.dgn

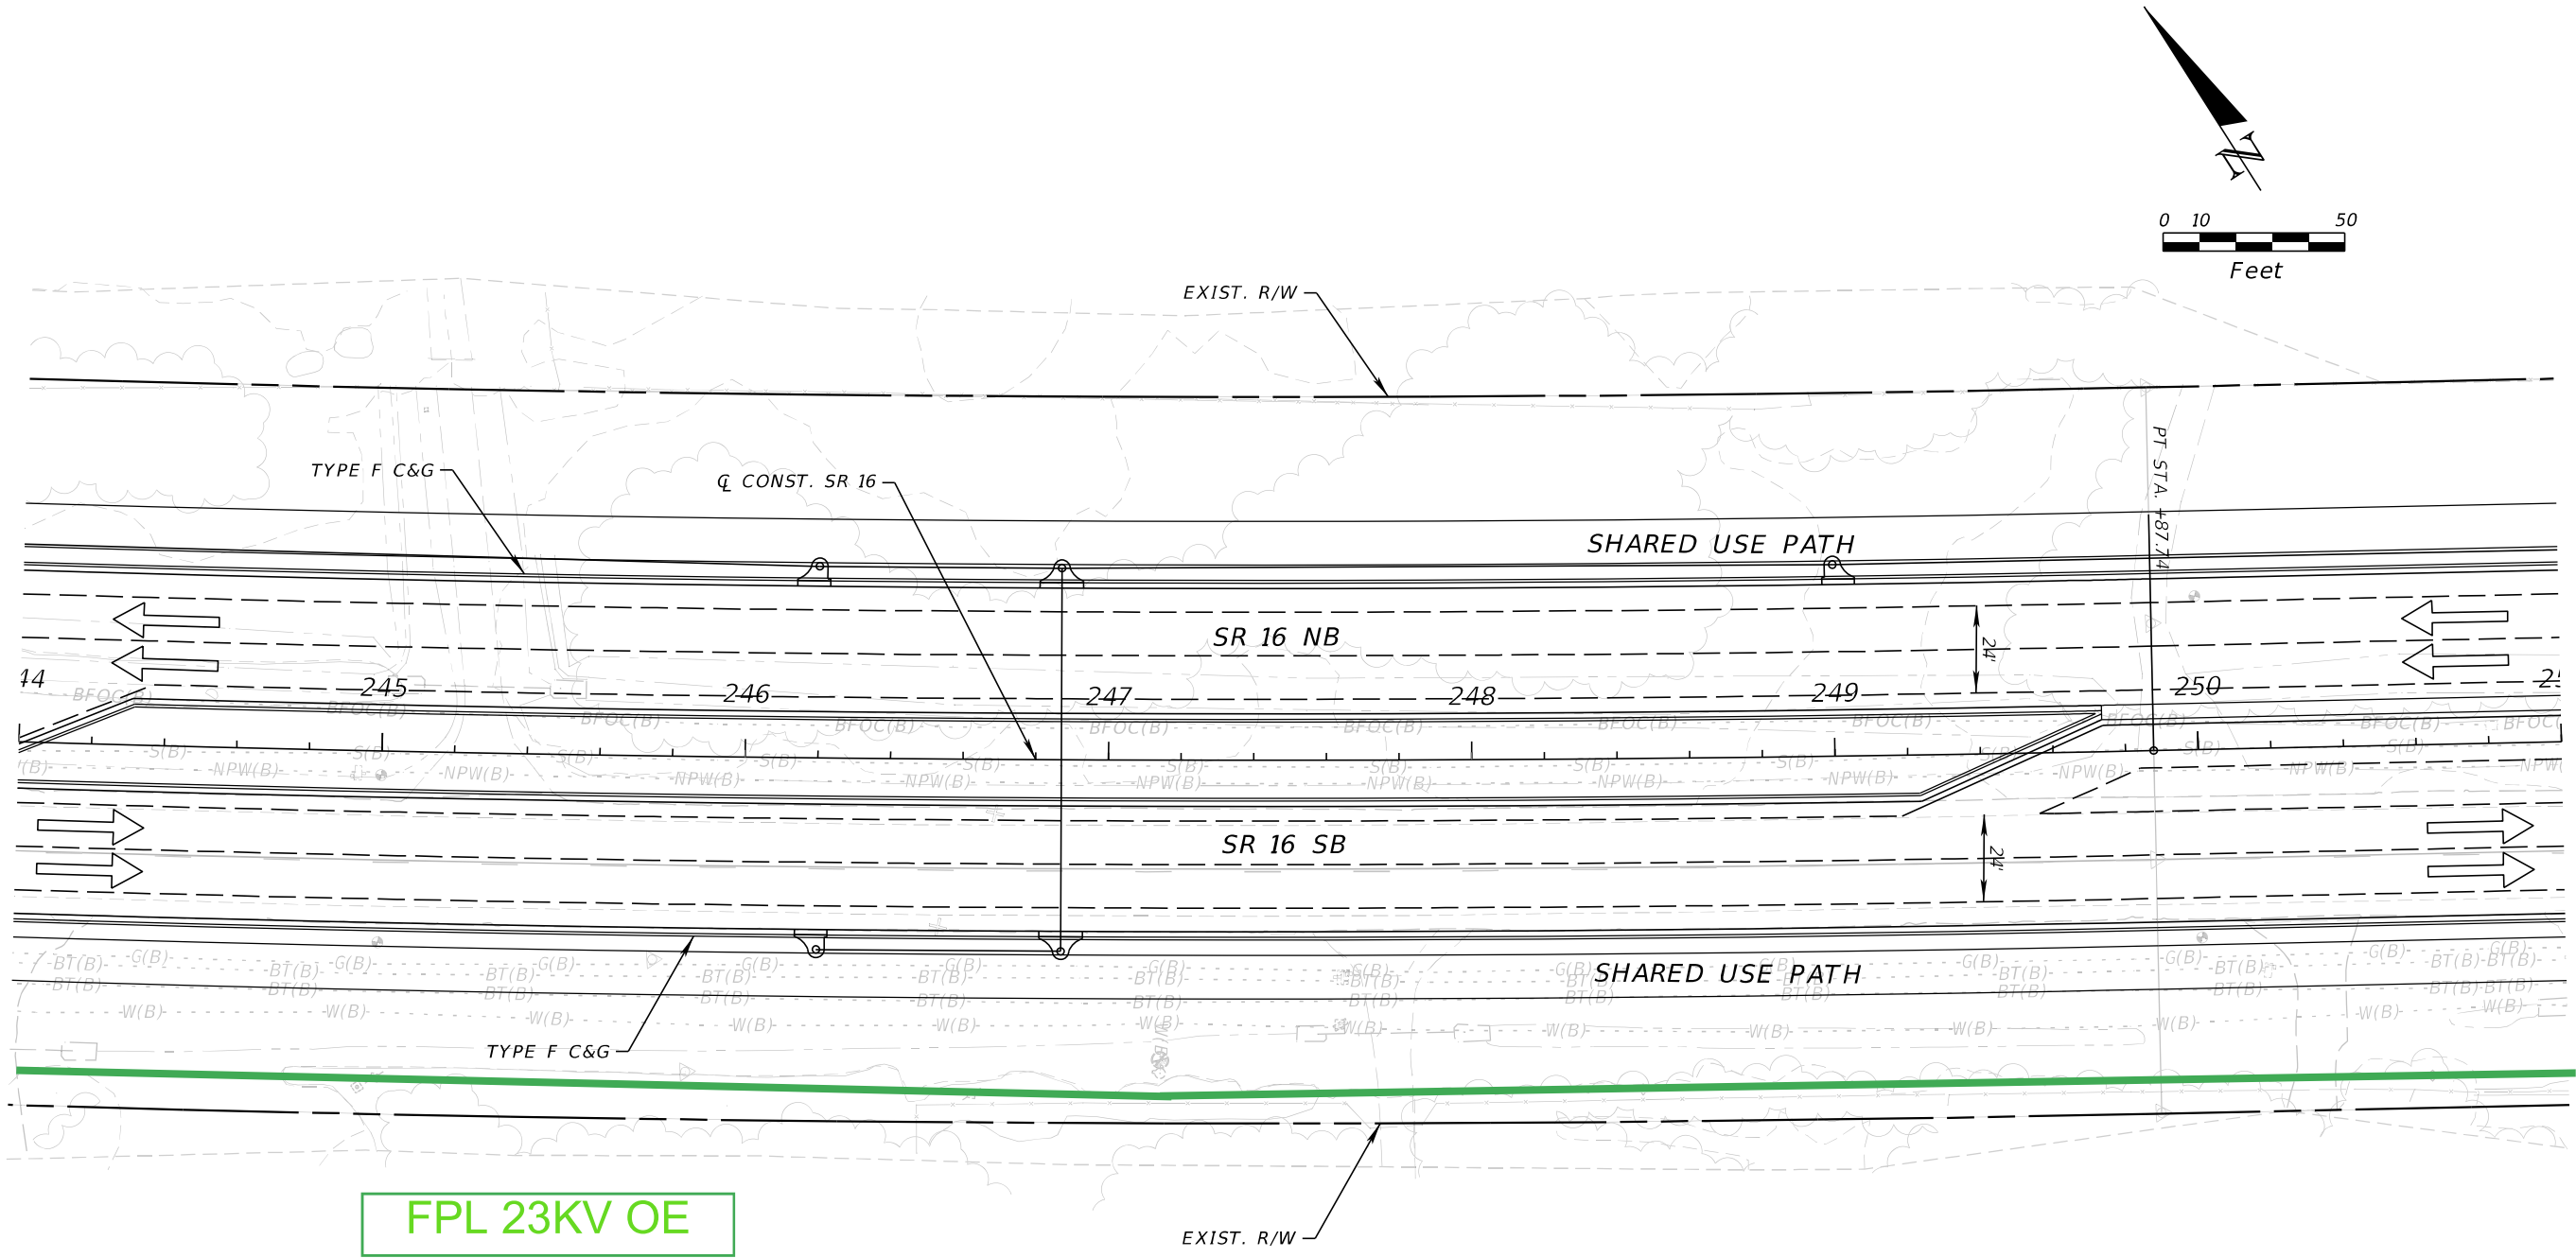

| REVISIONS | | | | ENGINEER OF RECORD | STATE OF FLORIDA DEPARTMENT OF TRANSPORTATION | | | SHEET NO. |
|-----------|-------------|------|-------------|---|--|-----------|----------------------|-----------------------|
| DATE | DESCRIPTION | DATE | DESCRIPTION | STEPHEN J. PARK, P.E. LICENSE NUMBER: 77656 RS&H, INC. 10748 DEERWOOD PARK BLVD. SOUTH JACKSONVILLE, FL 32256 | ROAD NO. | COUNTY | FINANCIAL PROJECT ID | |
| | | | | | SR 16 | ST. JOHNS | 210447-5-52-01 | |
| | | | | | | | | 11x17 Plan Only |

THE OFFICIAL RECORD OF THIS SHEET IS THE ELECTRONIC FILE DIGITALLY SIGNED AND SEALED UNDER RULE 61G15-23.004, F.A.C.


8/5/2024 4:28:52 PM BeattyM
c:\pw_work\ysh_pw\pw_user\00439575\PLANRD01.dgn

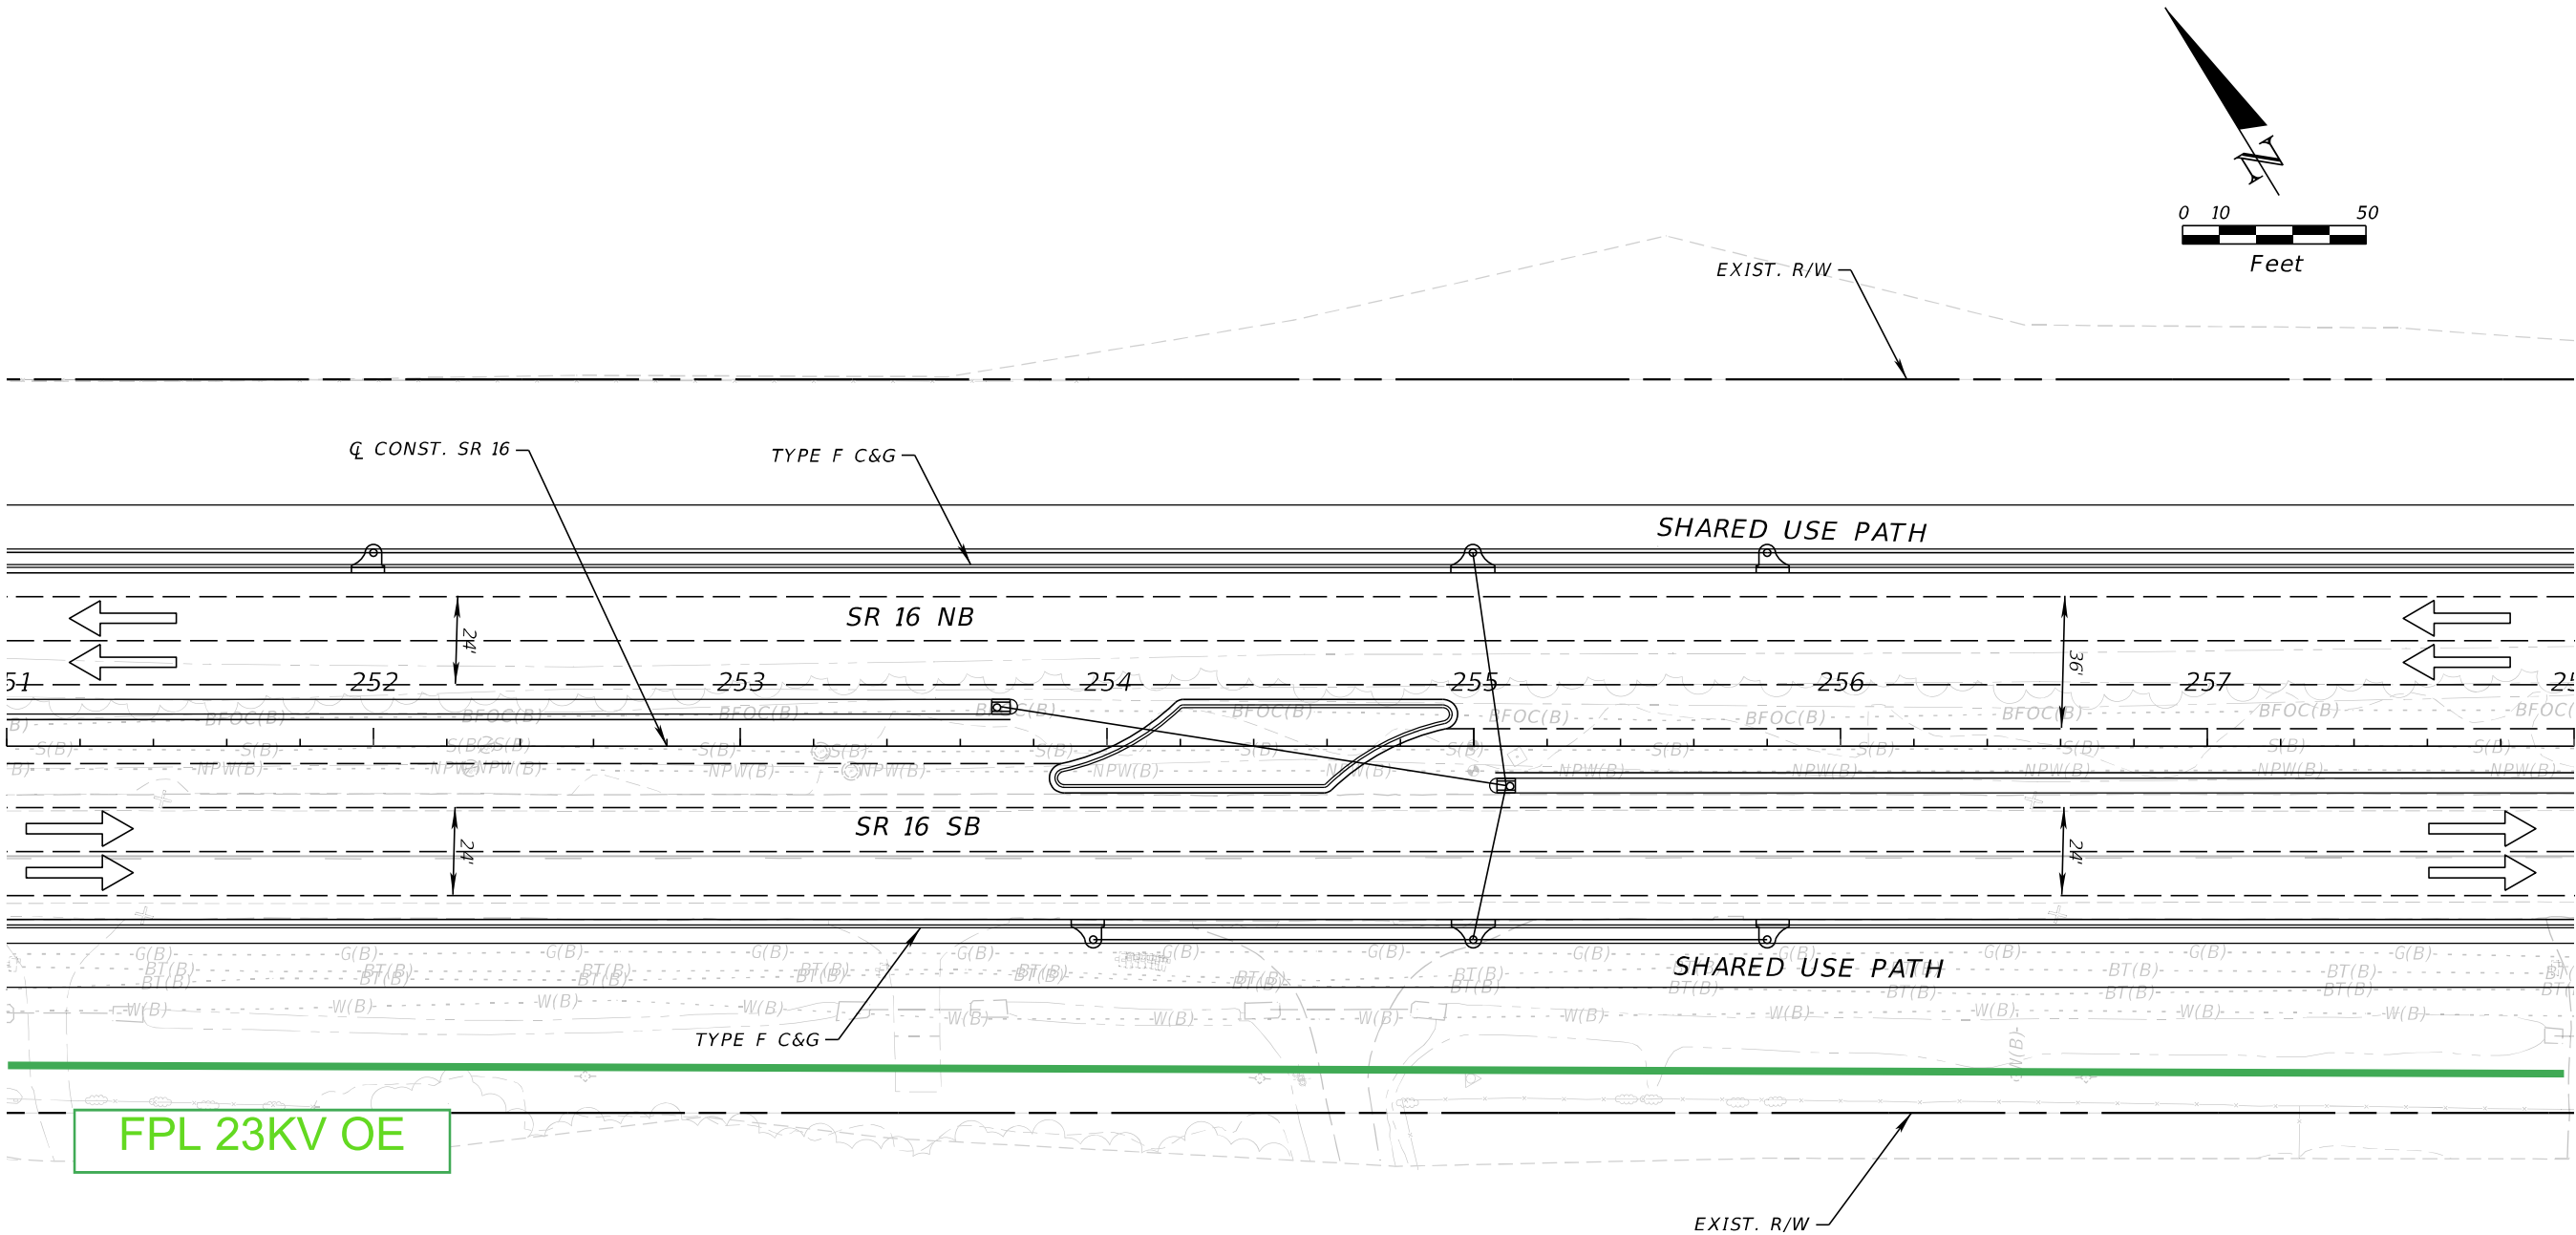

| REVISIONS | | | | ENGINEER OF RECORD | STATE OF FLORIDA DEPARTMENT OF TRANSPORTATION | | | SHEET NO. |
|-----------|-------------|------|-------------|---|--|-----------|----------------------|-----------------------|
| DATE | DESCRIPTION | DATE | DESCRIPTION | STEPHEN J. PARK, P.E. LICENSE NUMBER: 77656 RS&H, INC. 10748 DEERWOOD PARK BLVD. SOUTH JACKSONVILLE, FL 32256 | ROAD NO. | COUNTY | FINANCIAL PROJECT ID | |
| | | | | | SR 16 | ST. JOHNS | 210447-5-52-01 | |
| | | | | | | | | 11x17 Plan Only |

THE OFFICIAL RECORD OF THIS SHEET IS THE ELECTRONIC FILE DIGITALLY SIGNED AND SEALED UNDER RULE 61G15-23.004, F.A.C.


8/5/2024 4:28:52 PM BeattyM
c:\pw_work\ysh_pw\pw_user\00439575\PLANRD01.dgn

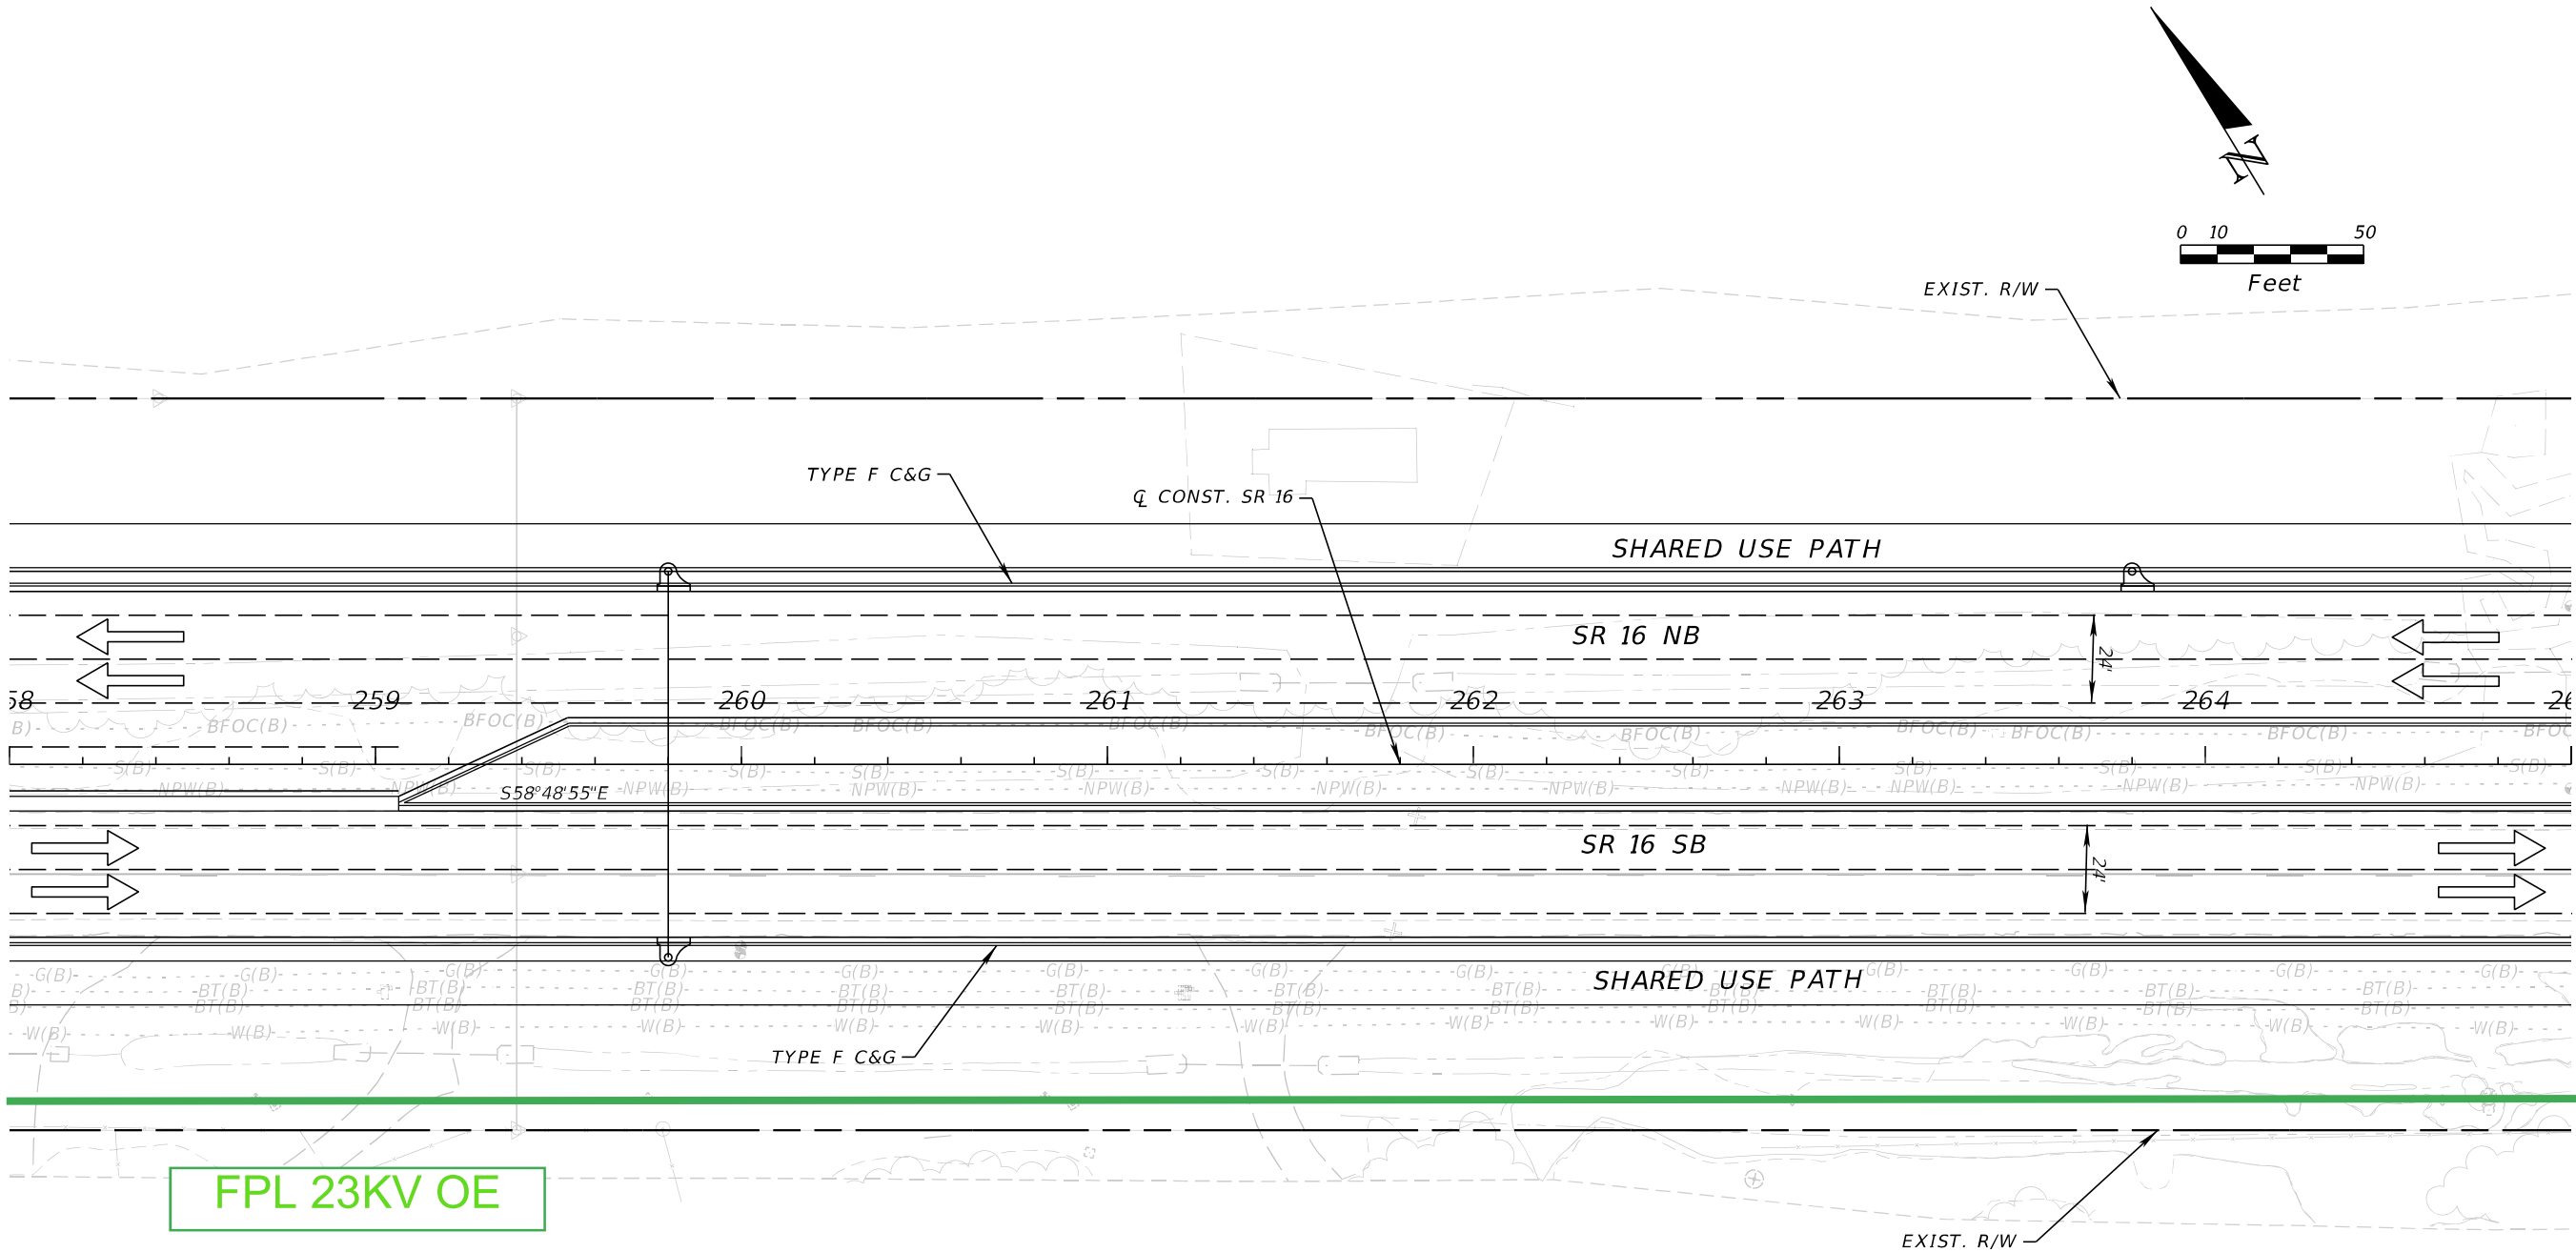

| REVISIONS | | | | ENGINEER OF RECORD | | STATE OF FLORIDA DEPARTMENT OF TRANSPORTATION | | | SHEET NO. |
|-----------|-------------|------|-------------|---|--|--|-----------|----------------------|--------------|
| DATE | DESCRIPTION | DATE | DESCRIPTION | STEPHEN J. PARK, P.E. LICENSE NUMBER: 77656 RS&H, INC. 10748 DEERWOOD PARK BLVD. SOUTH JACKSONVILLE, FL 32256 | | ROAD NO. | COUNTY | FINANCIAL PROJECT ID | |
| | | | | | | SR 16 | ST. JOHNS | 210447-5-52-01 | |

THE OFFICIAL RECORD OF THIS SHEET IS THE ELECTRONIC FILE DIGITALLY SIGNED AND SEALED UNDER RULE 61G15-23.004, F.A.C.


8/5/2024 4:28:53 PM BeattyM
c:\pw_work\sh_pw\pw_user\0439575\PLANRD01.dgn

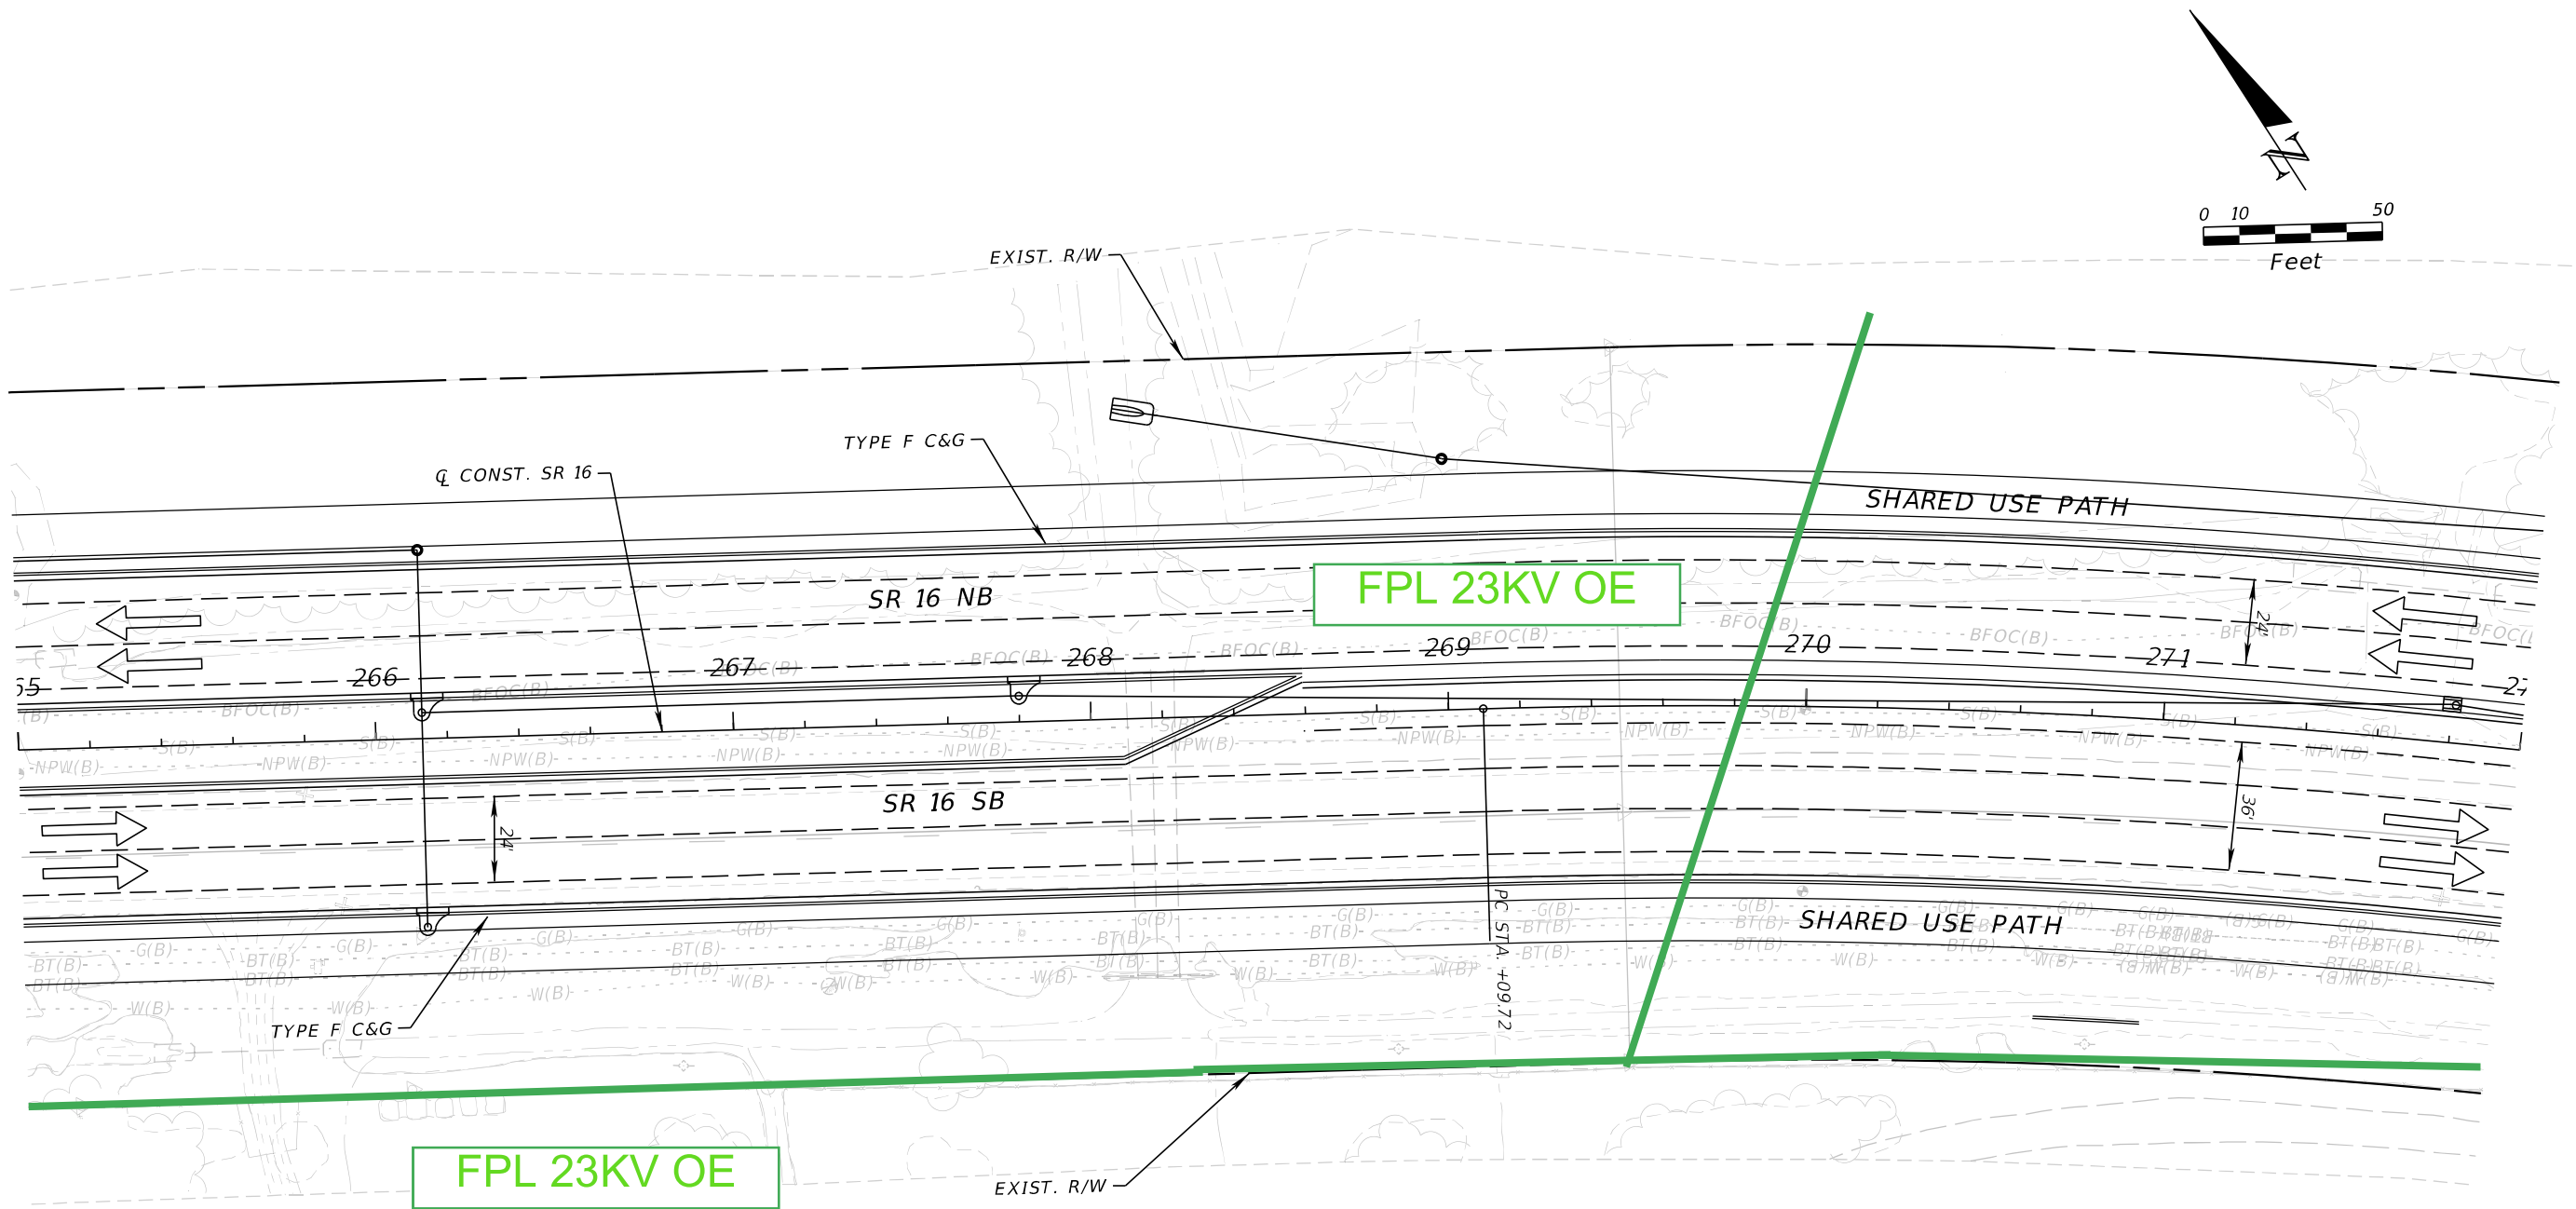

| REVISIONS | | | | ENGINEER OF RECORD | STATE OF FLORIDA DEPARTMENT OF TRANSPORTATION | | | SHEET NO. |
|-----------|-------------|------|-------------|---|--|-----------|----------------------|-----------------------|
| DATE | DESCRIPTION | DATE | DESCRIPTION | STEPHEN J. PARK, P.E. LICENSE NUMBER: 77656 RS&H, INC. 10748 DEERWOOD PARK BLVD. SOUTH JACKSONVILLE, FL 32256 | ROAD NO. | COUNTY | FINANCIAL PROJECT ID | |
| | | | | | SR 16 | ST. JOHNS | 210447-5-52-01 | |
| | | | | | | | | 11x17 Plan Only |

THE OFFICIAL RECORD OF THIS SHEET IS THE ELECTRONIC FILE DIGITALLY SIGNED AND SEALED UNDER RULE 61G15-23.004, F.A.C.


8/5/2024 4:28:54 PM BeattyM
c:\pw_work\ysh_pw\pw_user\00439575\PLAINRD01.dgn

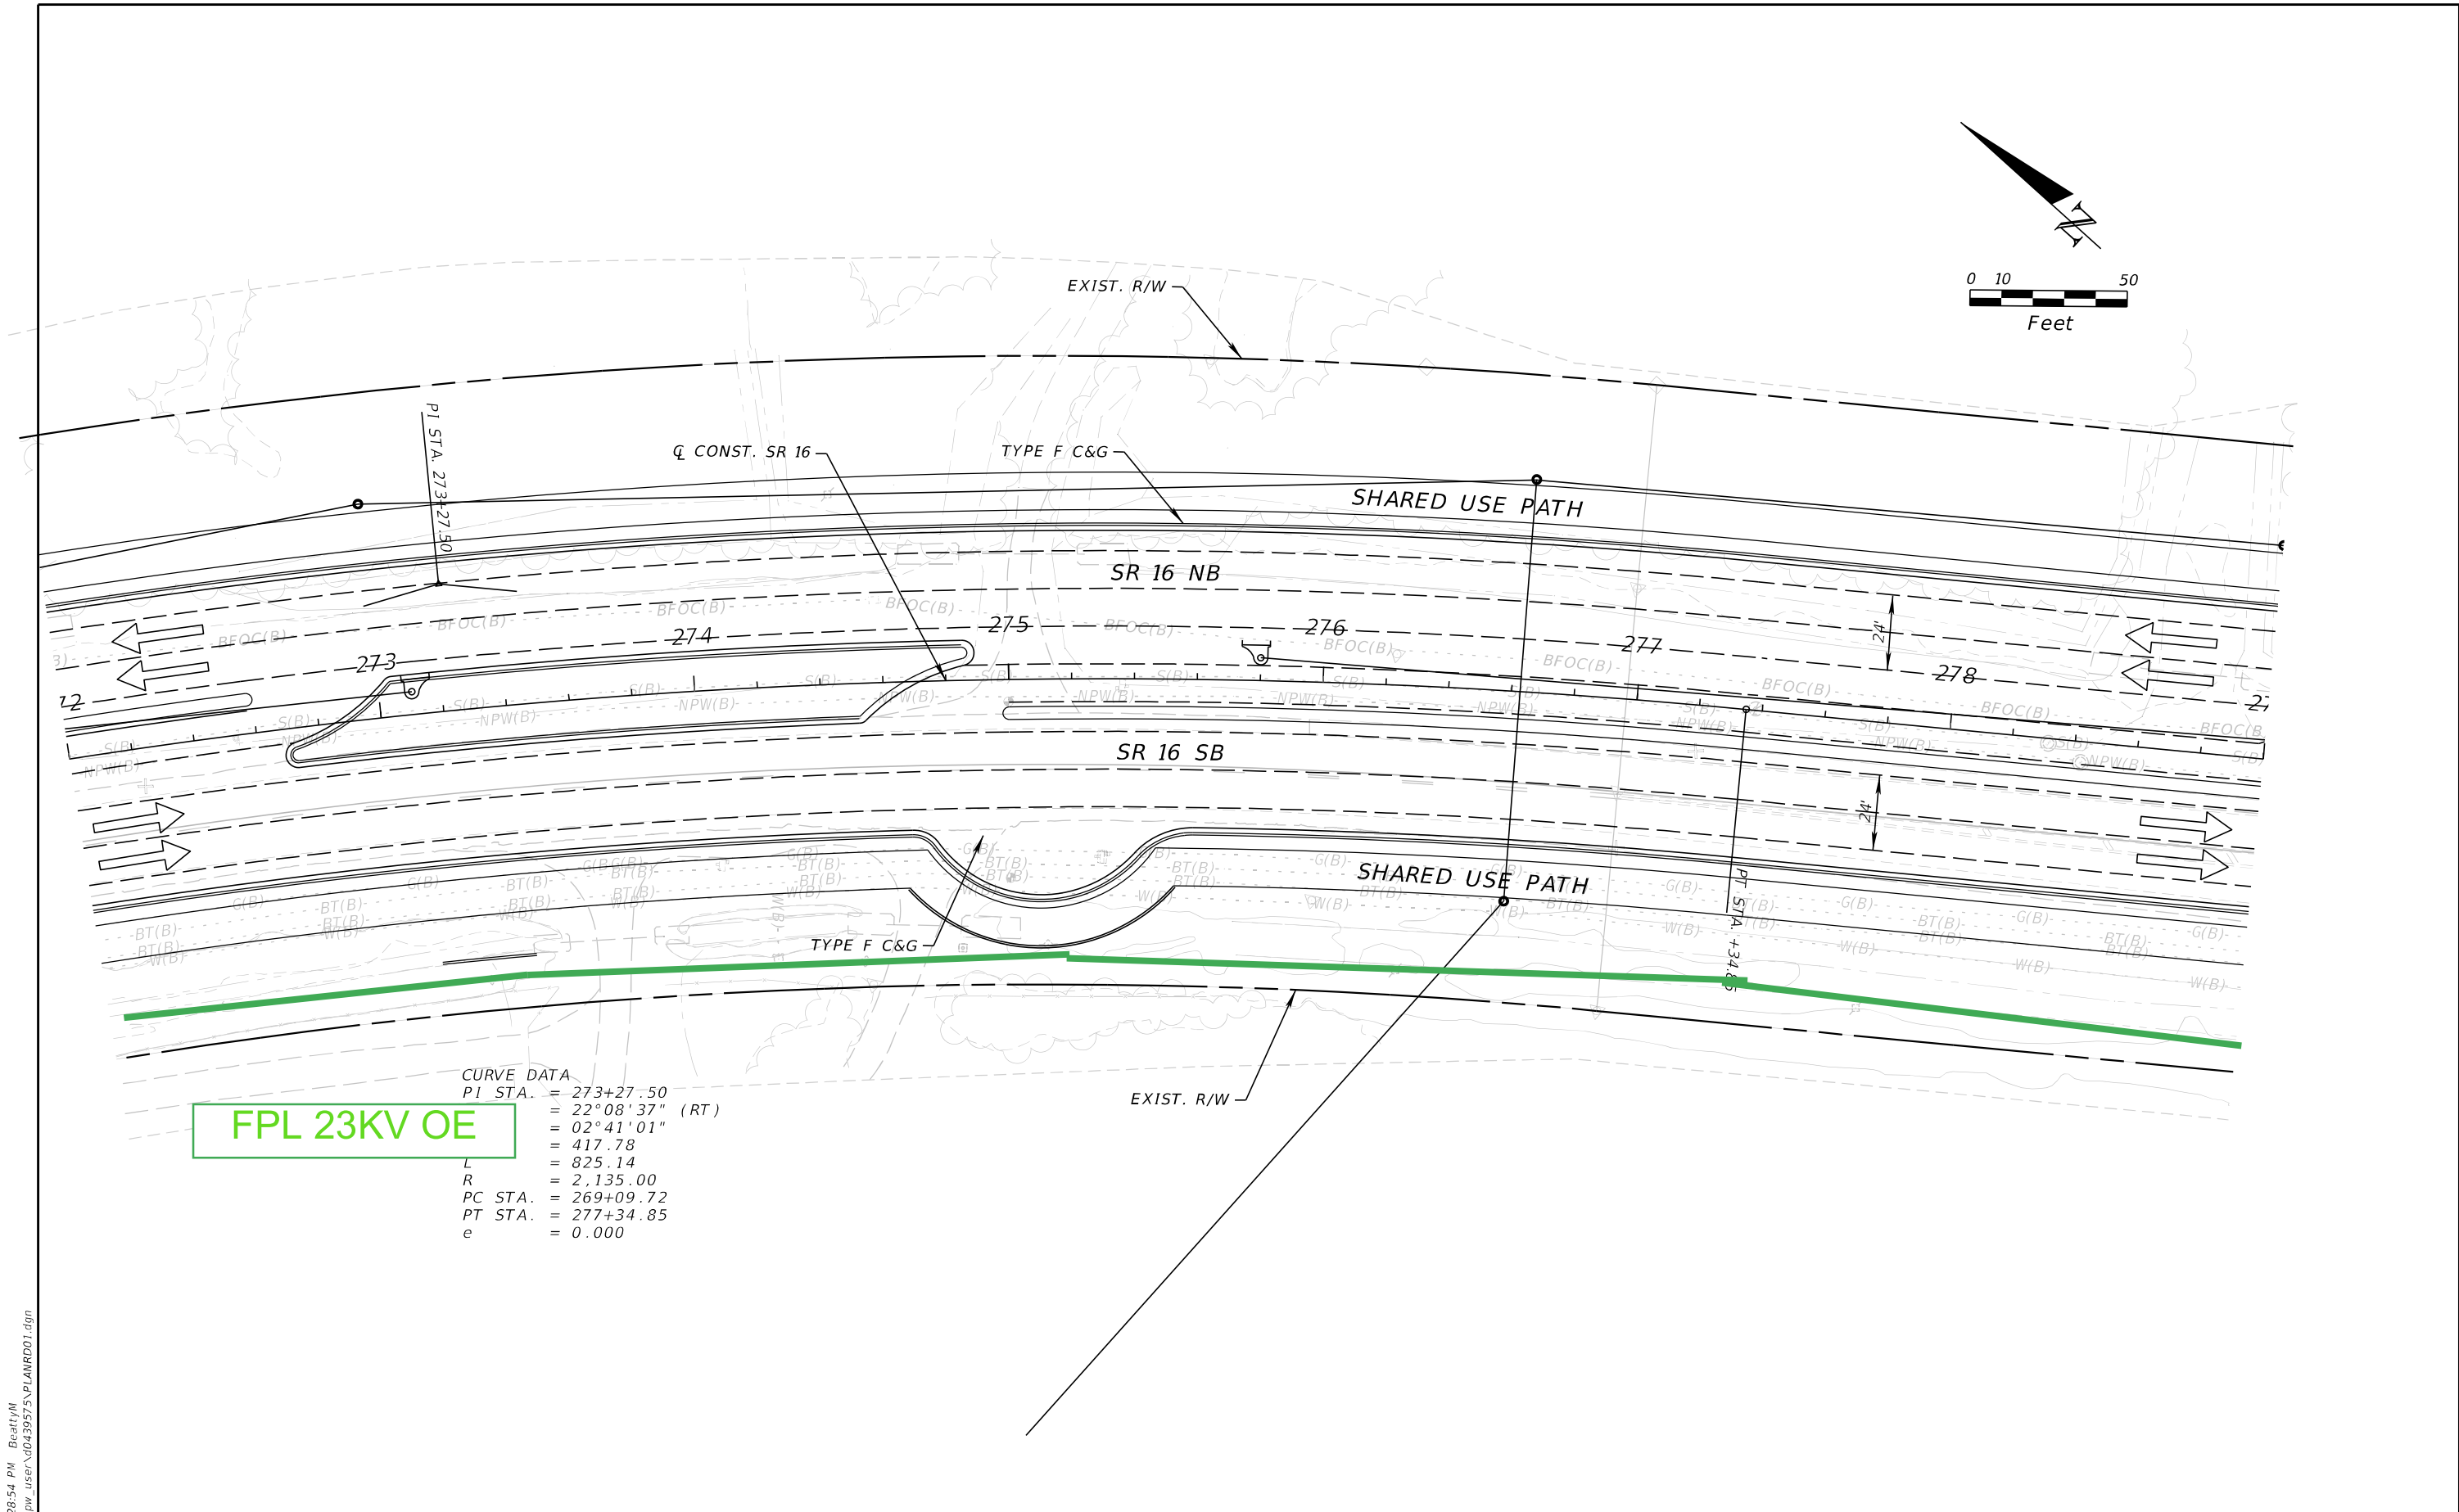

| REVISIONS | | | | ENGINEER OF RECORD | | STATE OF FLORIDA DEPARTMENT OF TRANSPORTATION | | | SHEET NO. |
|-----------|-------------|------|-------------|---|--|--|-----------|----------------------|--------------|
| DATE | DESCRIPTION | DATE | DESCRIPTION | STEPHEN J. PARK, P.E. LICENSE NUMBER: 77656 RS&H, INC. 10748 DEERWOOD PARK BLVD. SOUTH JACKSONVILLE, FL 32256 | | ROAD NO. | COUNTY | FINANCIAL PROJECT ID | |
| | | | | | | SR 16 | ST. JOHNS | 210447-5-52-01 | |

THE OFFICIAL RECORD OF THIS SHEET IS THE ELECTRONIC FILE DIGITALLY SIGNED AND SEALED UNDER RULE 61G15-23.004, F.A.C.


8/5/2024 4:28:54 PM BeattyM
c:\pw_work\sh_pw\pw_user\0439575\PLANRD01.dgn

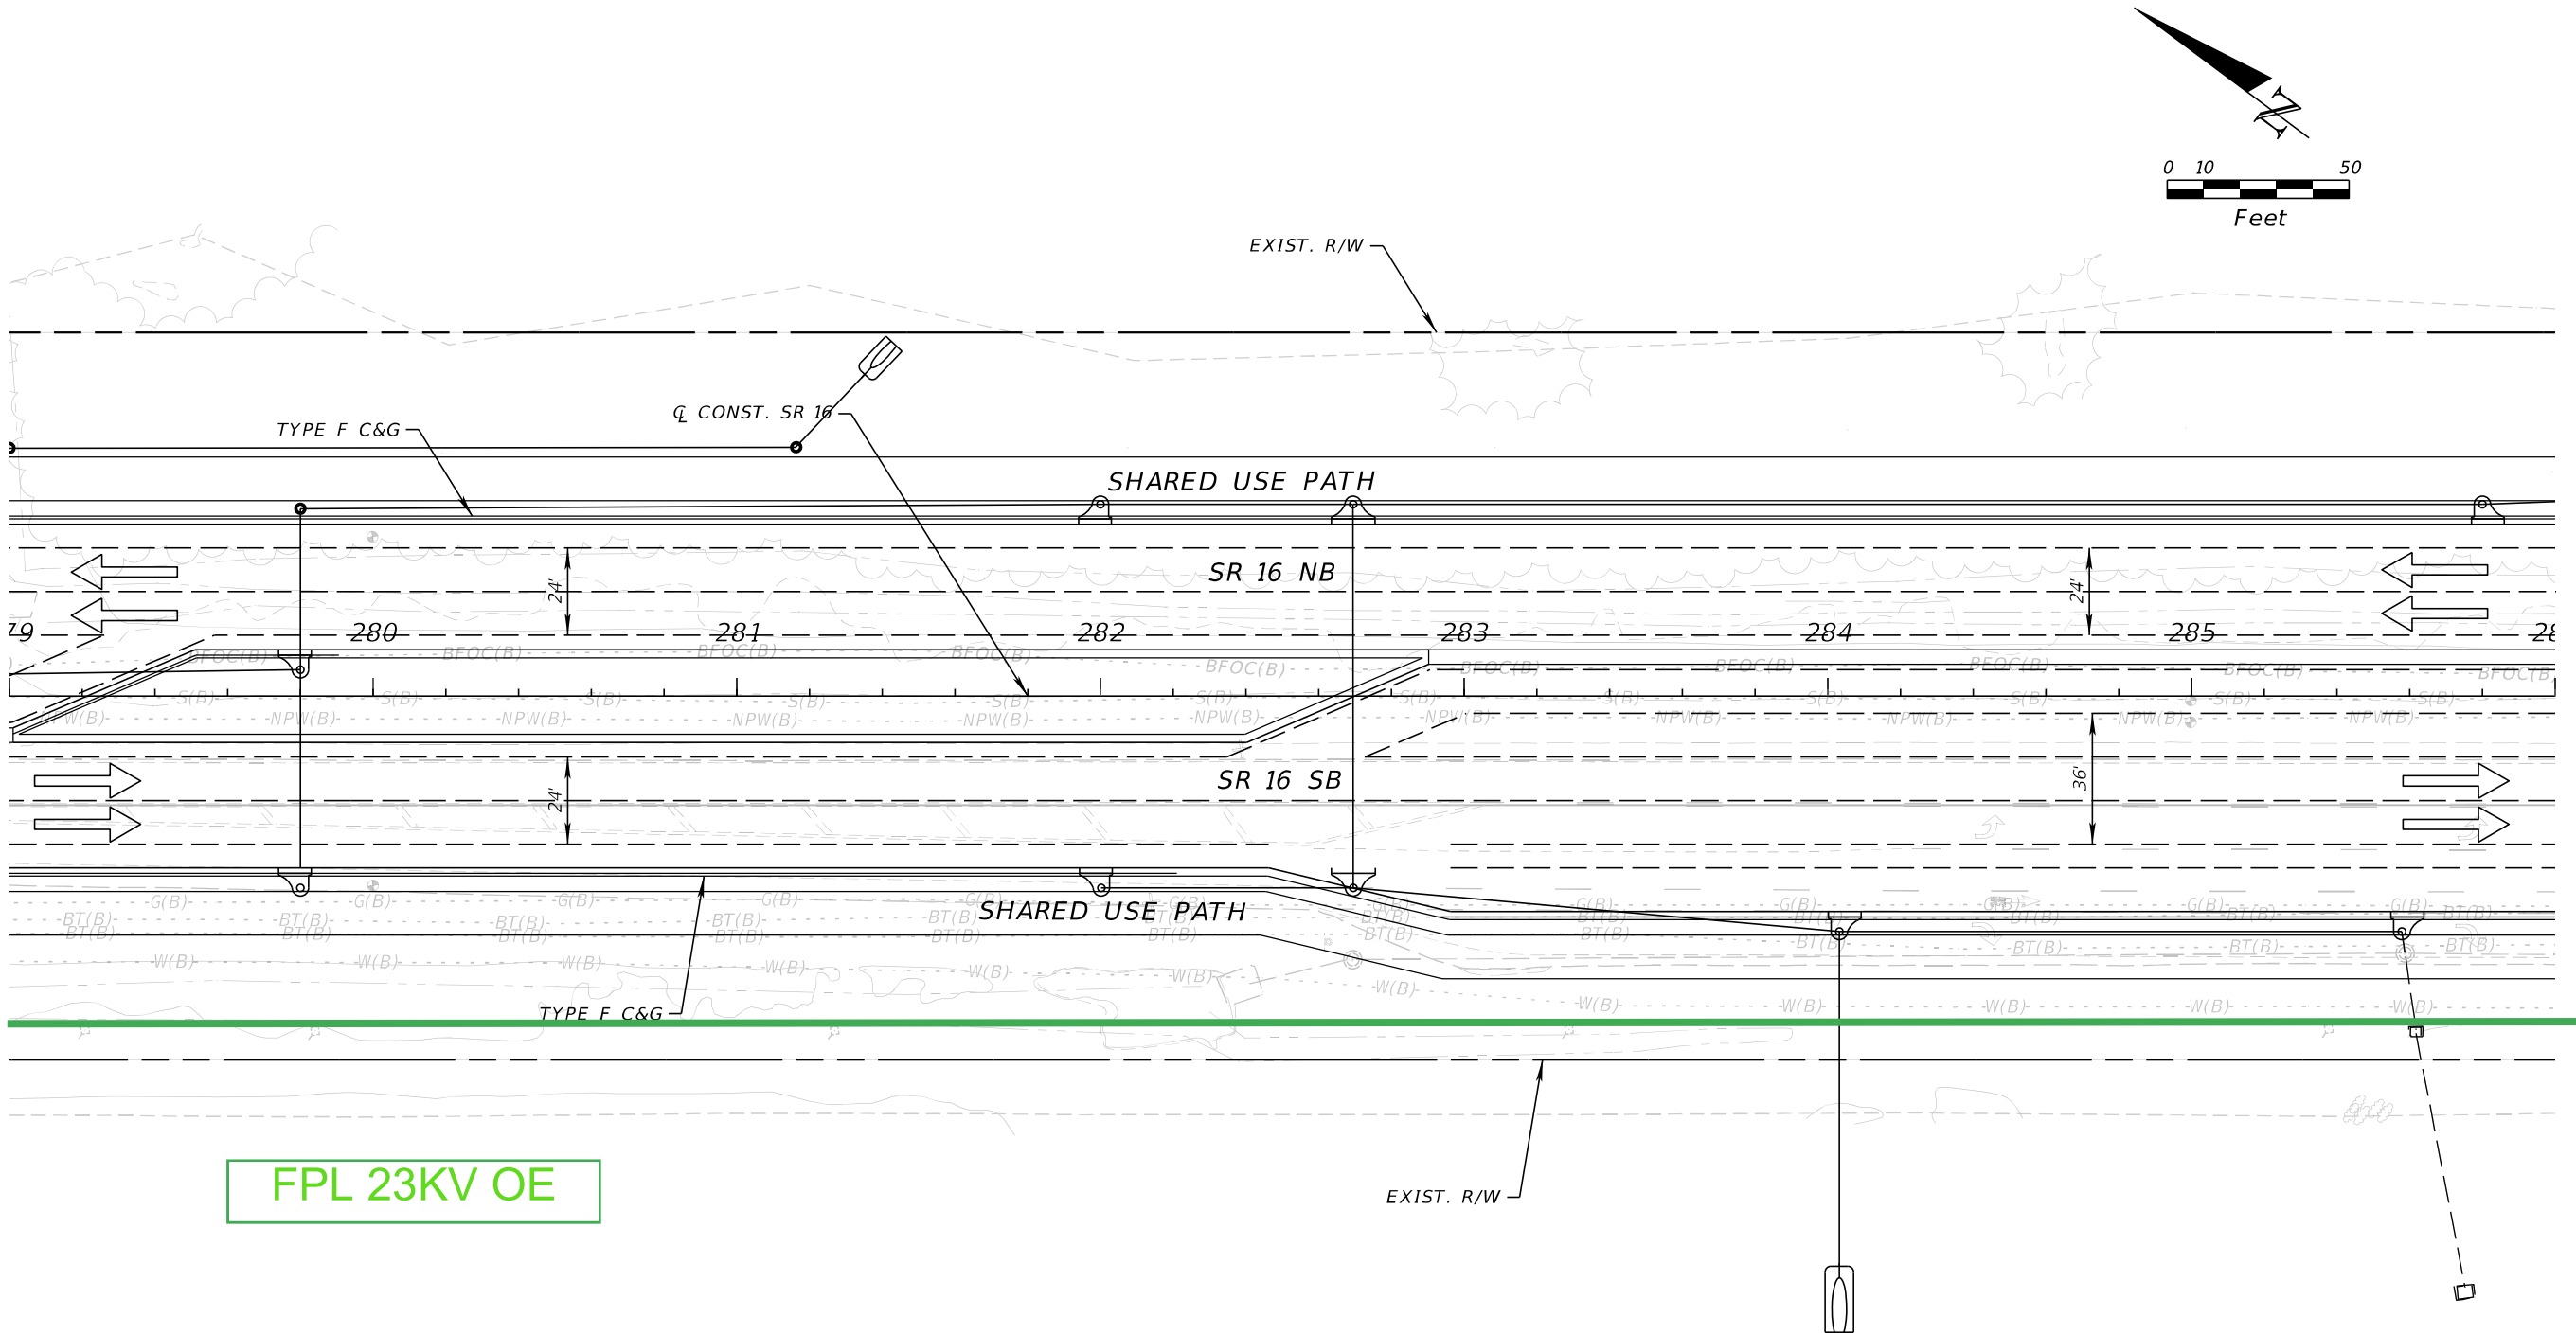

| REVISIONS | | | | ENGINEER OF RECORD | STATE OF FLORIDA DEPARTMENT OF TRANSPORTATION | | | SHEET NO. |
|-----------|-------------|------|-------------|---|--|-----------|----------------------|-----------------------|
| DATE | DESCRIPTION | DATE | DESCRIPTION | STEPHEN J. PARK, P.E. LICENSE NUMBER: 77656 RS&H, INC. 10748 DEERWOOD PARK BLVD. SOUTH JACKSONVILLE, FL 32256 | ROAD NO. | COUNTY | FINANCIAL PROJECT ID | |
| | | | | | SR 16 | ST. JOHNS | 210447-5-52-01 | |
| | | | | | | | | 11x17 Plan Only |

THE OFFICIAL RECORD OF THIS SHEET IS THE ELECTRONIC FILE DIGITALLY SIGNED AND SEALED UNDER RULE 61G15-23.004, F.A.C.


8/5/2024 4:28:55 PM BeattyM
c:\pw_work\sh_pw\pw_user\0439575\PLAINRD01.dgn

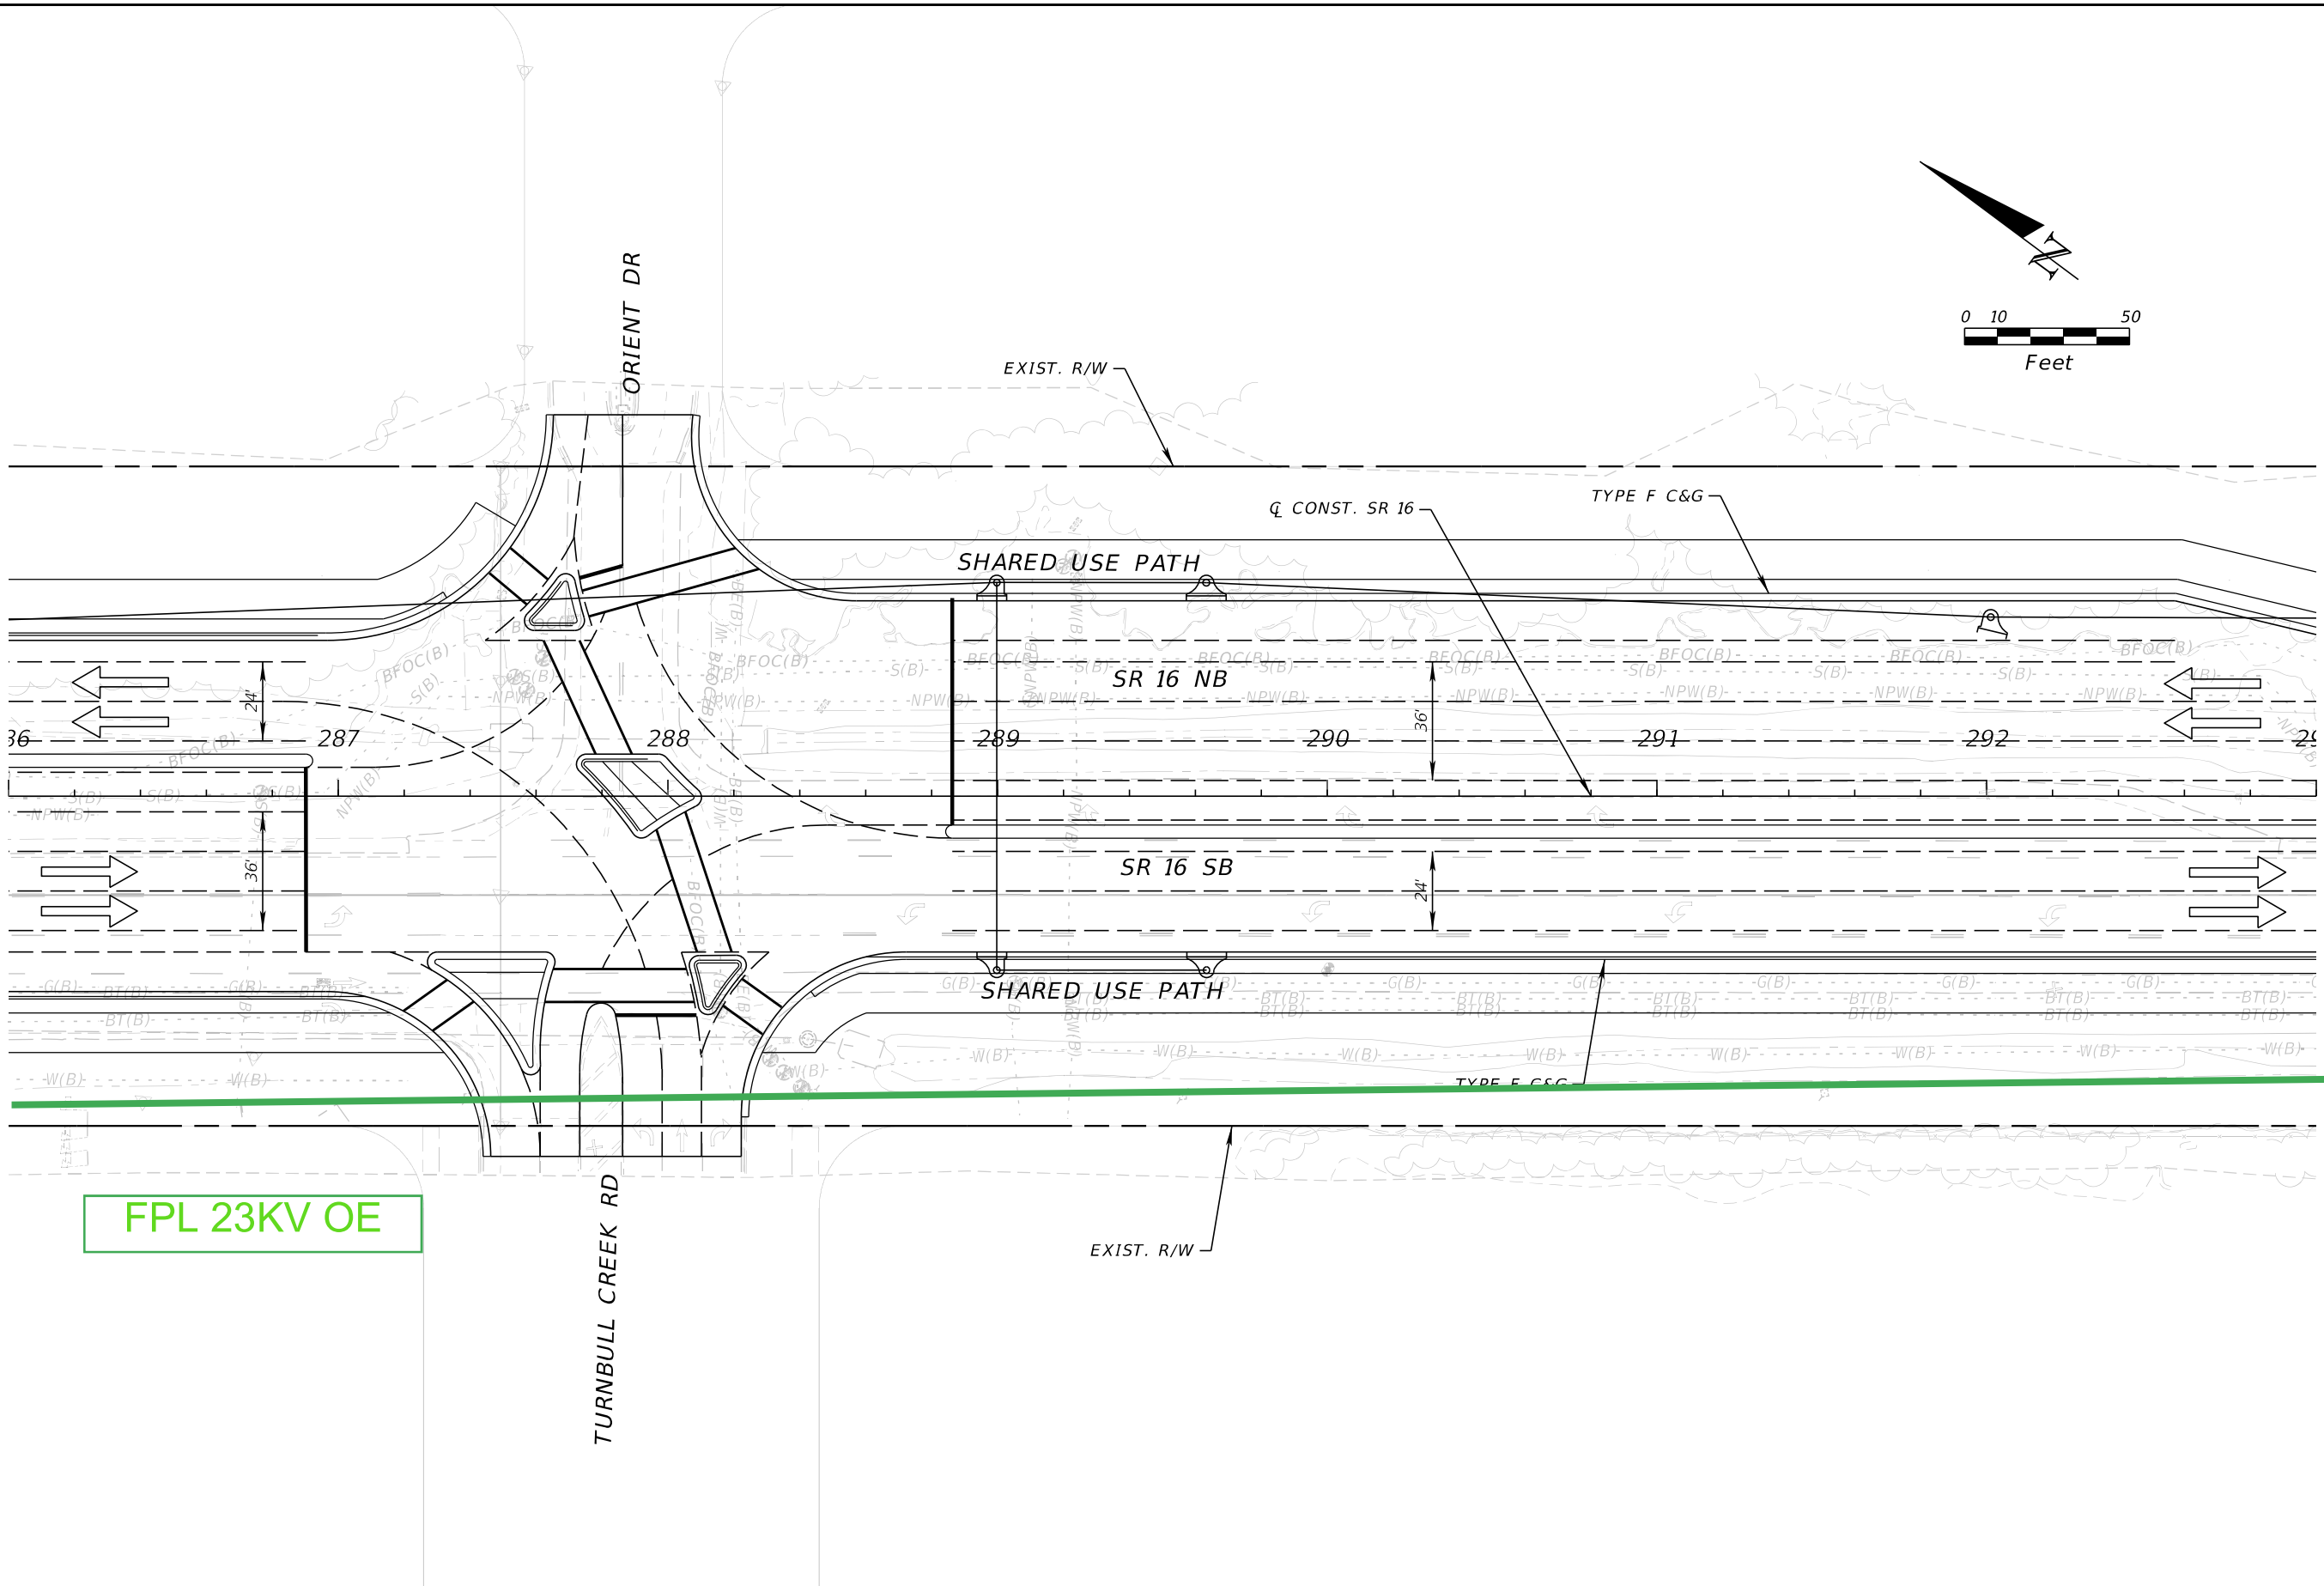

| REVISIONS | | | | ENGINEER OF RECORD | STATE OF FLORIDA DEPARTMENT OF TRANSPORTATION | | | SHEET NO. |
|-----------|-------------|------|-------------|---|--|-----------|----------------------|-----------------------|
| DATE | DESCRIPTION | DATE | DESCRIPTION | | ROAD NO. | COUNTY | FINANCIAL PROJECT ID | |
| | | | | | SR 16 | ST. JOHNS | 210447-5-52-01 | |
| | | | | STEPHEN J. PARK, P.E. LICENSE NUMBER: 77656 RS&H, INC. 10748 DEERWOOD PARK BLVD. SOUTH JACKSONVILLE, FL 32256 | | | | 11x17 Plan Only |

THE OFFICIAL RECORD OF THIS SHEET IS THE ELECTRONIC FILE DIGITALLY SIGNED AND SEALED UNDER RULE 61G15-23.004, F.A.C.


8/5/2024 4:28:55 PM BeattyM
c:\pw_work\sh_pw\pw_user\00439575\PLANRD01.dgn

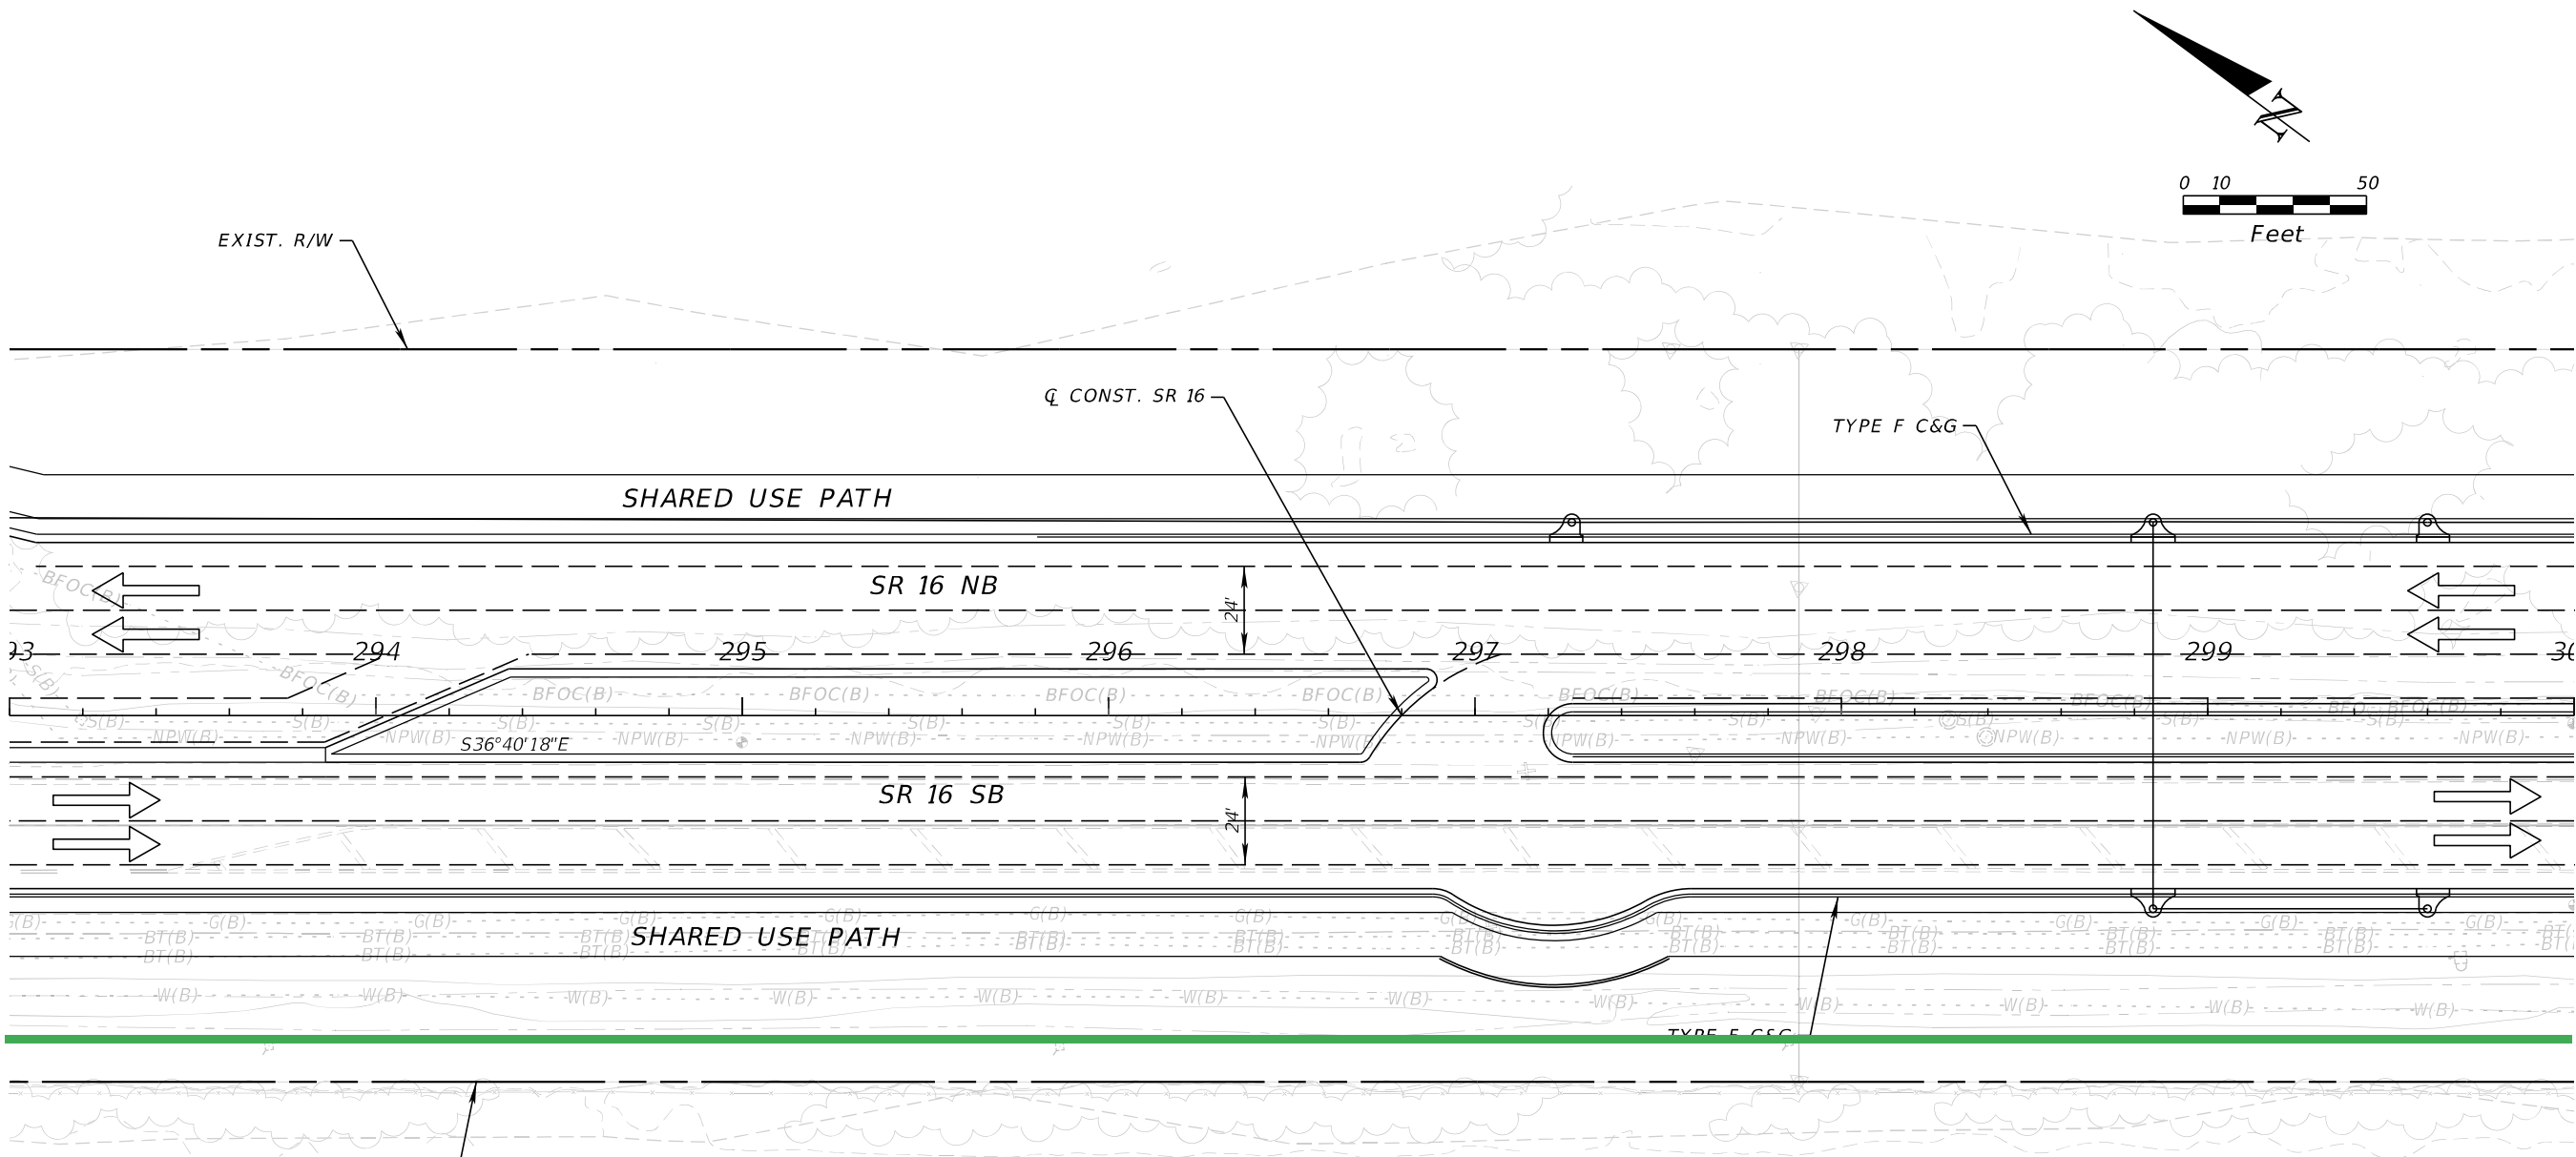

| REVISIONS | | | | ENGINEER OF RECORD | STATE OF FLORIDA DEPARTMENT OF TRANSPORTATION | | | SHEET NO. |
|-----------|-------------|------|-------------|---|--|-----------|----------------------|-----------------------|
| DATE | DESCRIPTION | DATE | DESCRIPTION | | ROAD NO. | COUNTY | FINANCIAL PROJECT ID | |
| | | | | | SR 16 | ST. JOHNS | 210447-5-52-01 | |
| | | | | STEPHEN J. PARK, P.E. LICENSE NUMBER: 77656 RS&H, INC. 10748 DEERWOOD PARK BLVD. SOUTH JACKSONVILLE, FL 32256 | | | | 11x17 Plan Only |

THE OFFICIAL RECORD OF THIS SHEET IS THE ELECTRONIC FILE DIGITALLY SIGNED AND SEALED UNDER RULE 61G15-23.004, F.A.C.


8/5/2024 4:28:56 PM BeattyM
c:\pw_work\sh_pw\pw_user\0439575\PLANRD01.dgn

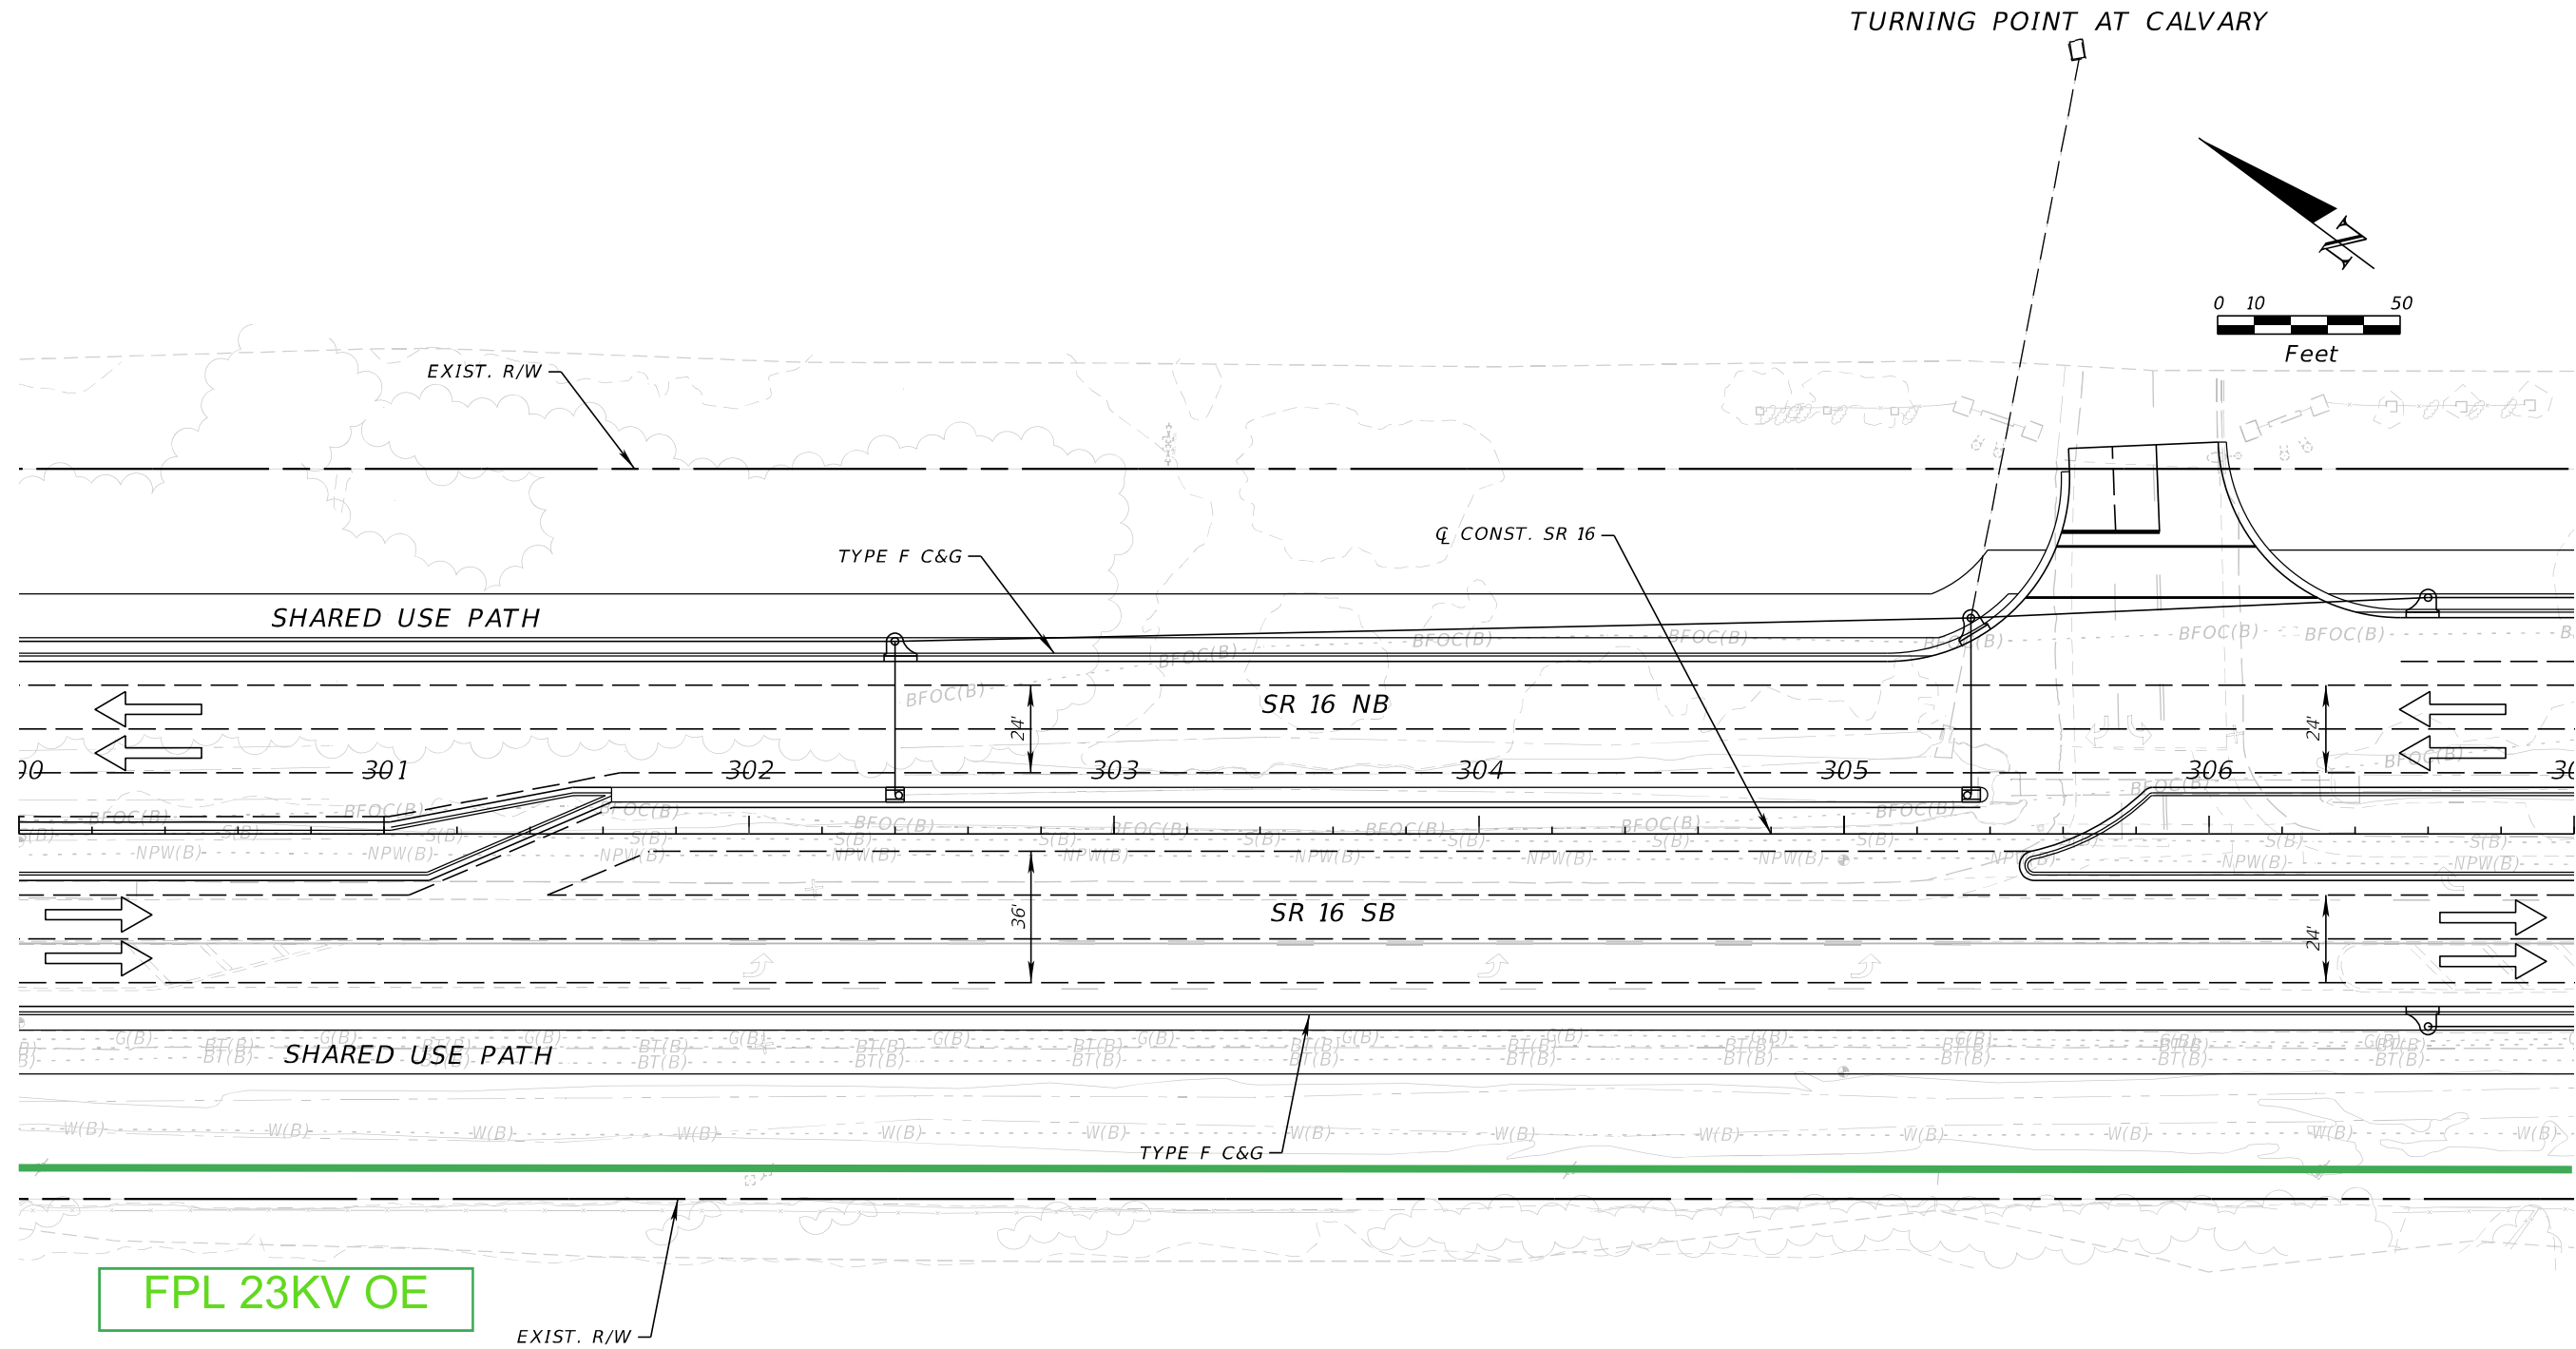

| | | | | | | | | | |
|-----------|-------------|--|------|---|--|--|--|--|-----------------------|
| REVISIONS | | | | ENGINEER OF RECORD | | STATE OF FLORIDA DEPARTMENT OF TRANSPORTATION | | | SHEET NO. |
| DATE | DESCRIPTION | | DATE | DESCRIPTION | | ROAD NO. COUNTY FINANCIAL PROJECT ID | | | |
| | | | | | | | | | |
| | | | | STEPHEN J. PARK, P.E. LICENSE NUMBER: 77656 RS&H, INC. 10748 DEERWOOD PARK BLVD. SOUTH JACKSONVILLE, FL 32256 | | SR 16 ST. JOHNS 210447-5-52-01 | | | 11x17 Plan Only |

THE OFFICIAL RECORD OF THIS SHEET IS THE ELECTRONIC FILE DIGITALLY SIGNED AND SEALED UNDER RULE 61G15-23.004, F.A.C.


8/5/2024 4:28:57 PM BeattyM
c:\pw_work\sh_pw\pw_user\0439575\PLANRD01.dgn

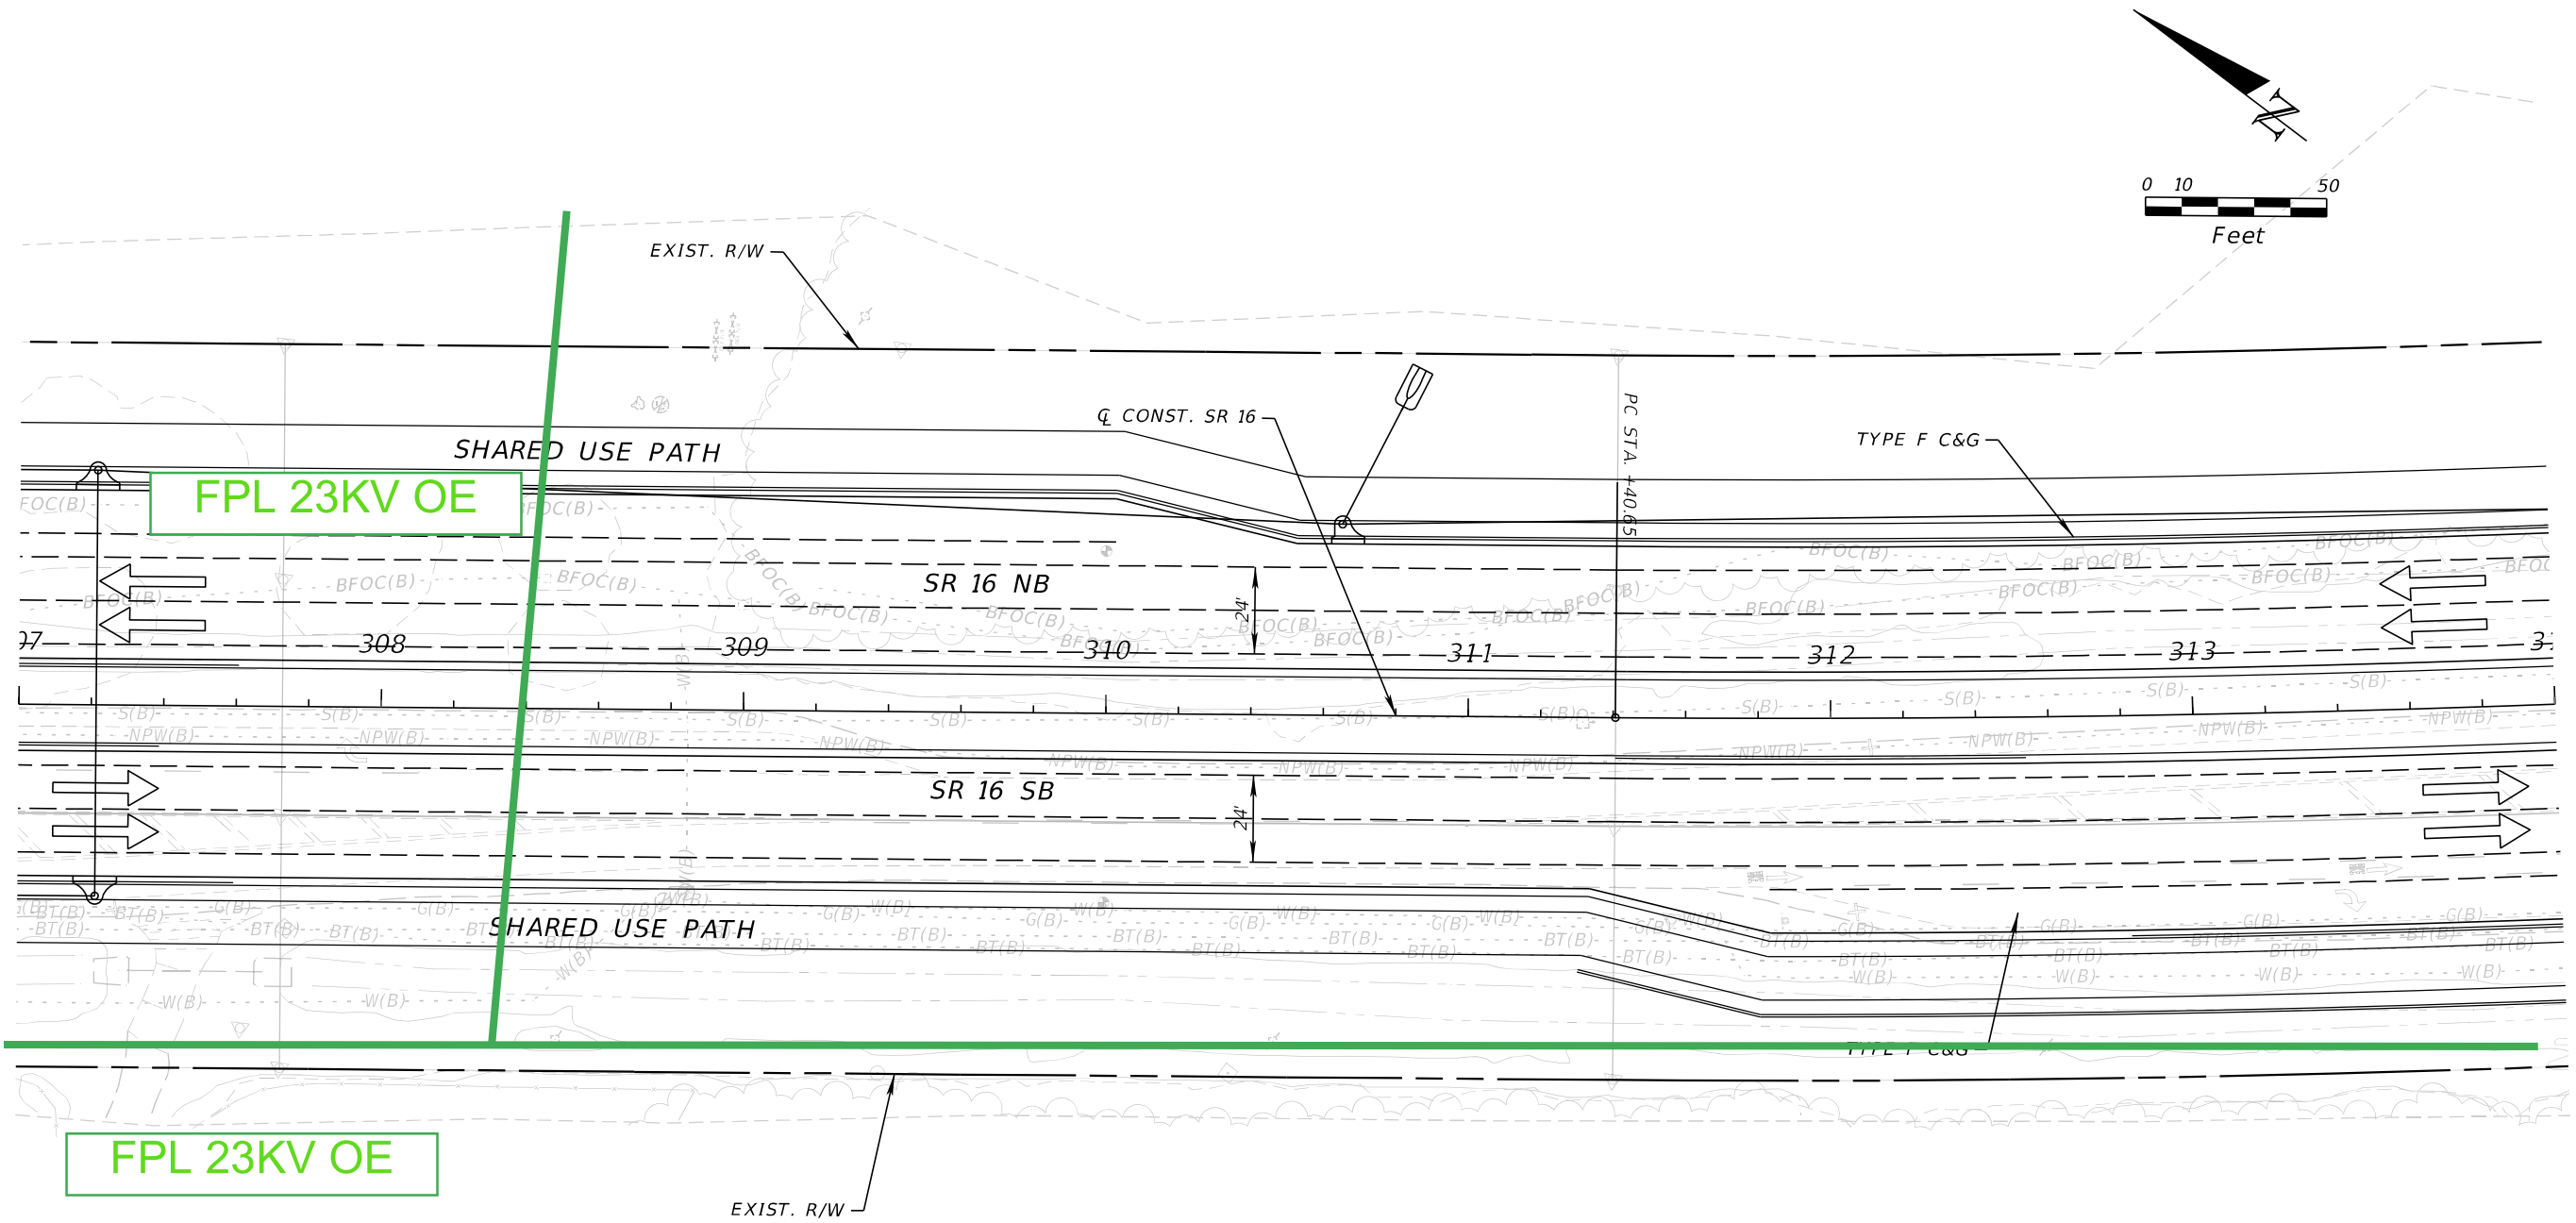

| REVISIONS | | | | ENGINEER OF RECORD | STATE OF FLORIDA DEPARTMENT OF TRANSPORTATION | | | SHEET NO. |
|-----------|-------------|------|-------------|---|--|-----------|----------------------|-----------------------|
| DATE | DESCRIPTION | DATE | DESCRIPTION | STEPHEN J. PARK, P.E. LICENSE NUMBER: 77656 RS&H, INC. 10748 DEERWOOD PARK BLVD. SOUTH JACKSONVILLE, FL 32256 | ROAD NO. | COUNTY | FINANCIAL PROJECT ID | |
| | | | | | SR 16 | ST. JOHNS | 210447-5-52-01 | 11x17 Plan Only |

THE OFFICIAL RECORD OF THIS SHEET IS THE ELECTRONIC FILE DIGITALLY SIGNED AND SEALED UNDER RULE 61G15-23.004, F.A.C.

8/5/2024 4:28:57 PM BeattyM
c:\pw_work\ysh_pw\pw_user\0439575\PLAINRD01.dgn

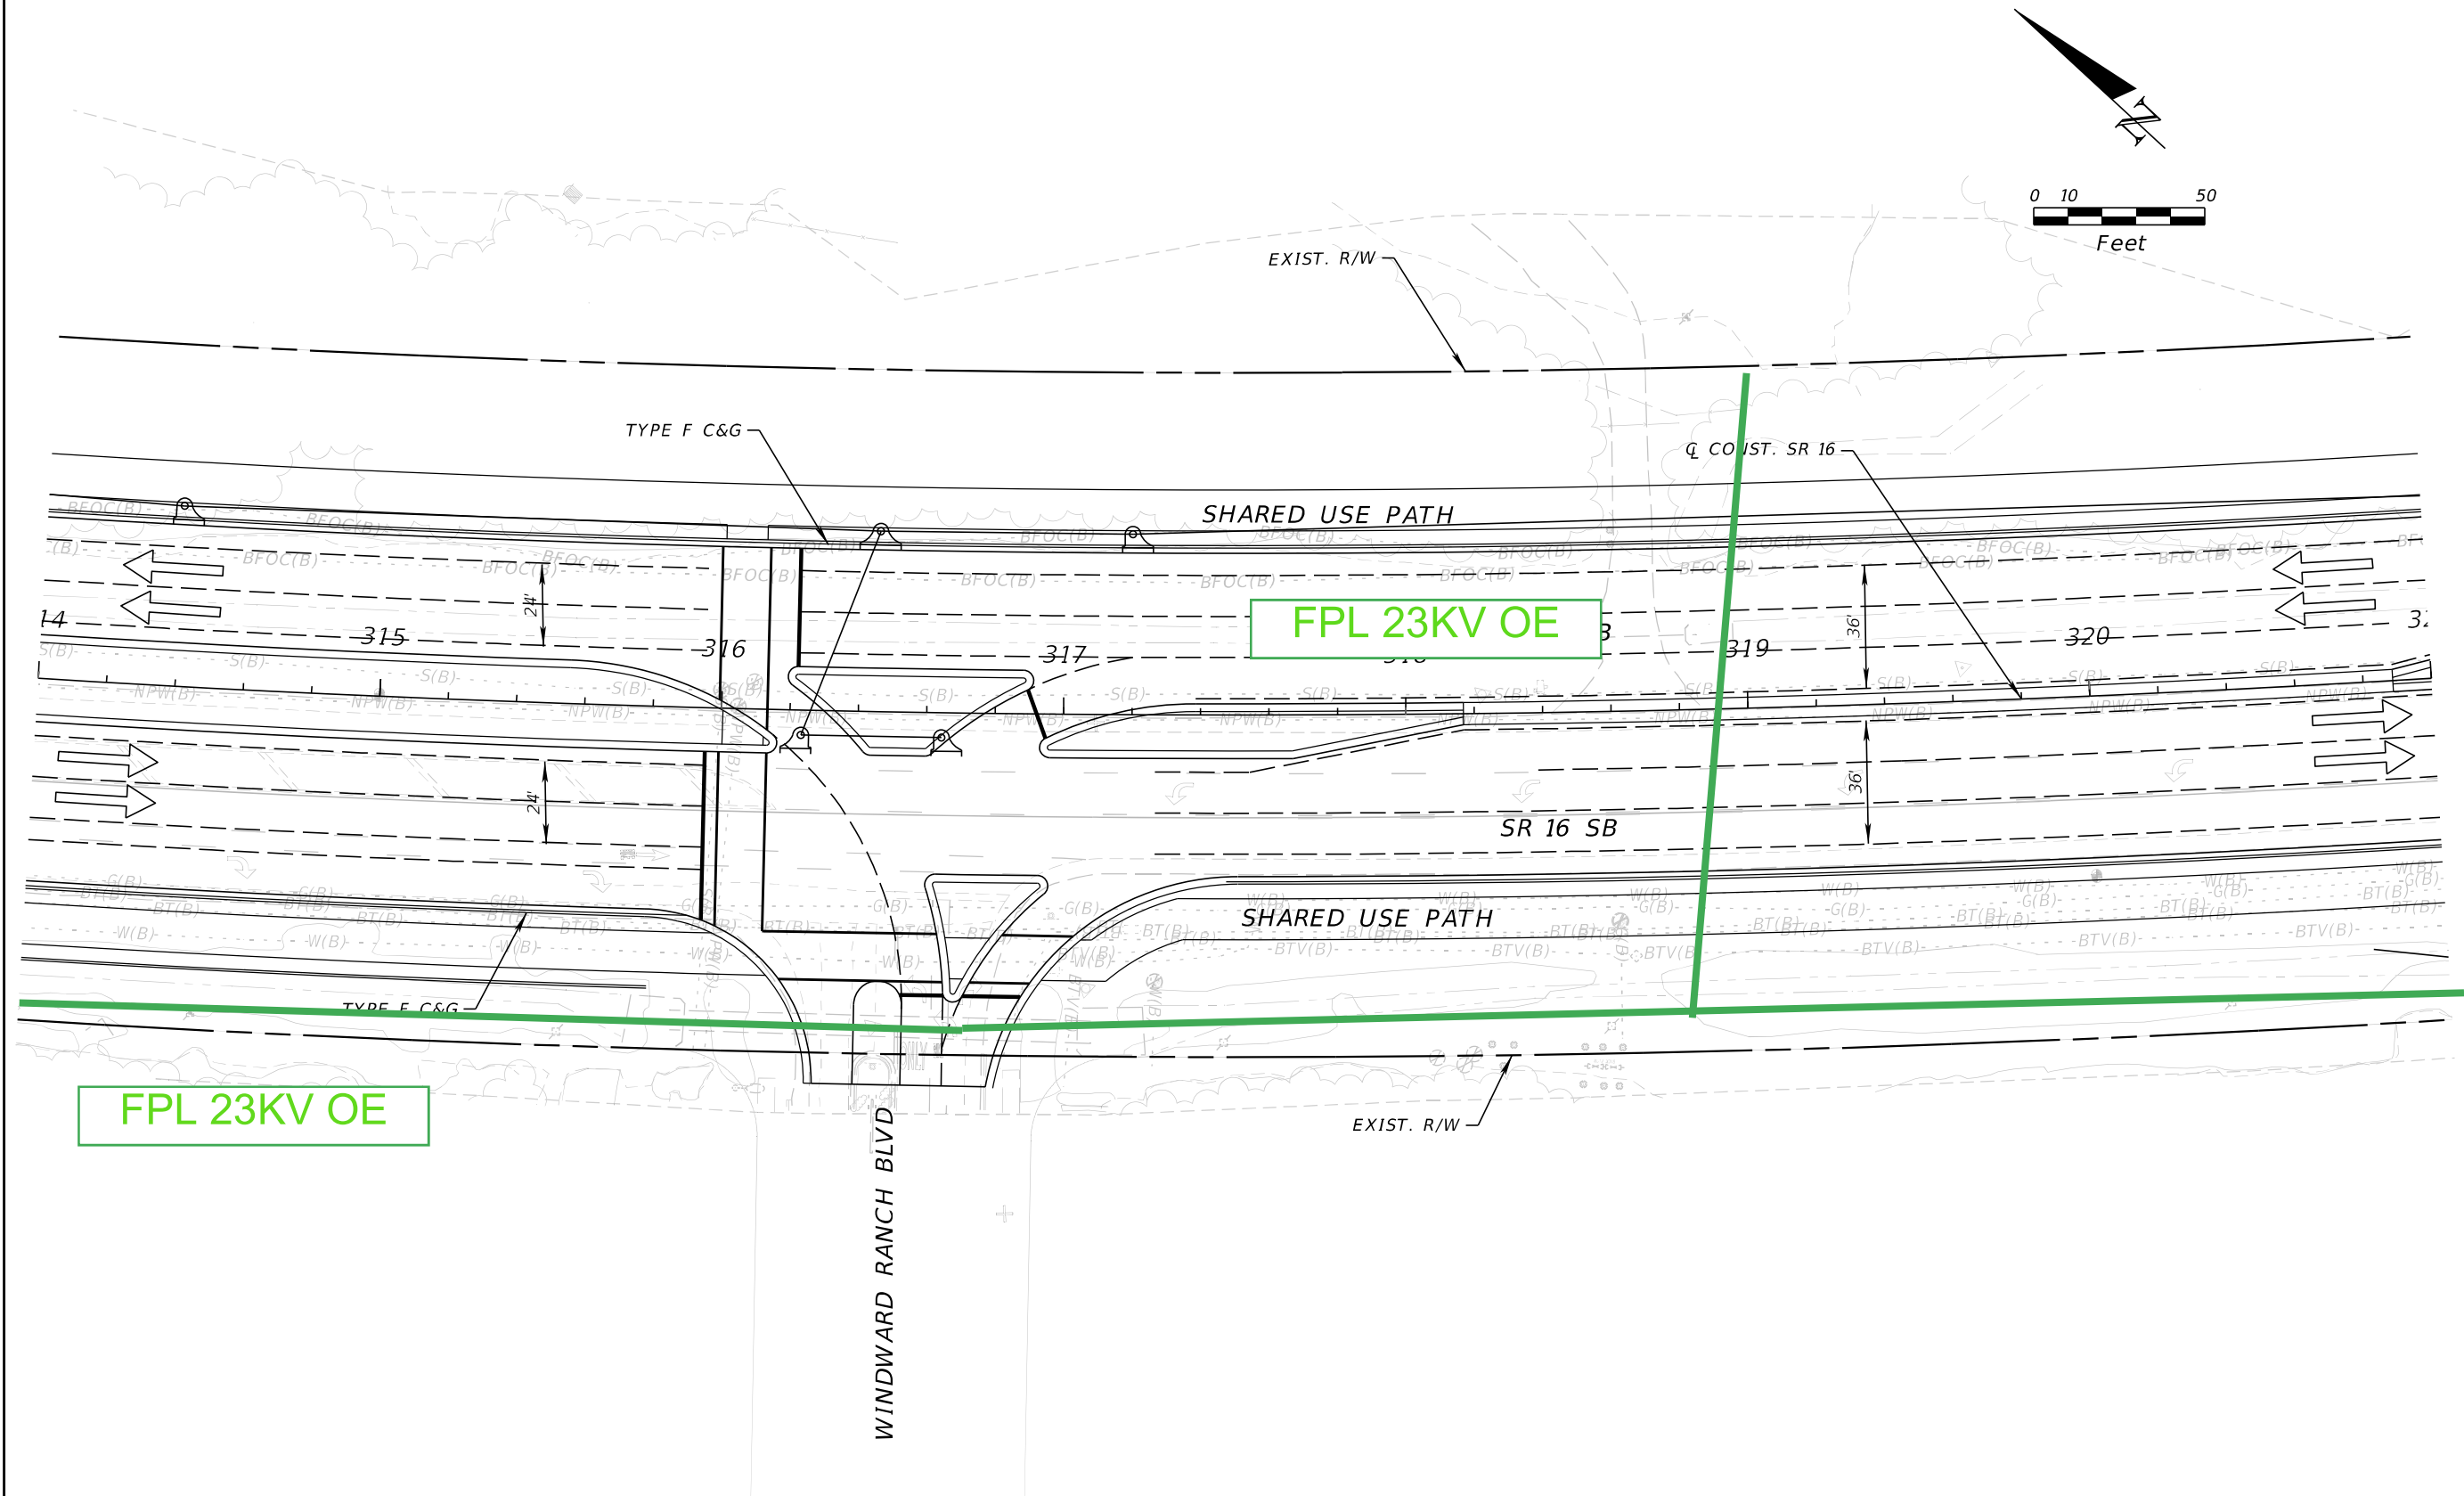



| REVISIONS | | | | ENGINEER OF RECORD | STATE OF FLORIDA DEPARTMENT OF TRANSPORTATION | | | SHEET NO. |
|-----------|-------------|------|-------------|---|--|-----------|----------------------|-----------------------|
| DATE | DESCRIPTION | DATE | DESCRIPTION | | ROAD NO. | COUNTY | FINANCIAL PROJECT ID | |
| | | | | | SR 16 | ST. JOHNS | 210447-5-52-01 | |
| | | | | STEPHEN J. PARK, P.E. LICENSE NUMBER: 77656 RS&H, INC. 10748 DEERWOOD PARK BLVD. SOUTH JACKSONVILLE, FL 32256 | | | | 11x17 Plan Only |

THE OFFICIAL RECORD OF THIS SHEET IS THE ELECTRONIC FILE DIGITALLY SIGNED AND SEALED UNDER RULE 61G15-23.004, F.A.C.

8/5/2024 4:28:58 PM BeattyM
c:\pw_work\ysh_pw\pw_user\0439575\PLAINRD01.dgn

CURVE DATA
PI STA. = 321+12.24
 Δ = 19°20'48" (LT)
D = 01°00'19"
T = 971.59
L = 1,924.68
R = 1,924.68
PC STA. = 311+40.65
PT STA. = 330+65.33
e = 0.000


DOWN'S CORNER RD

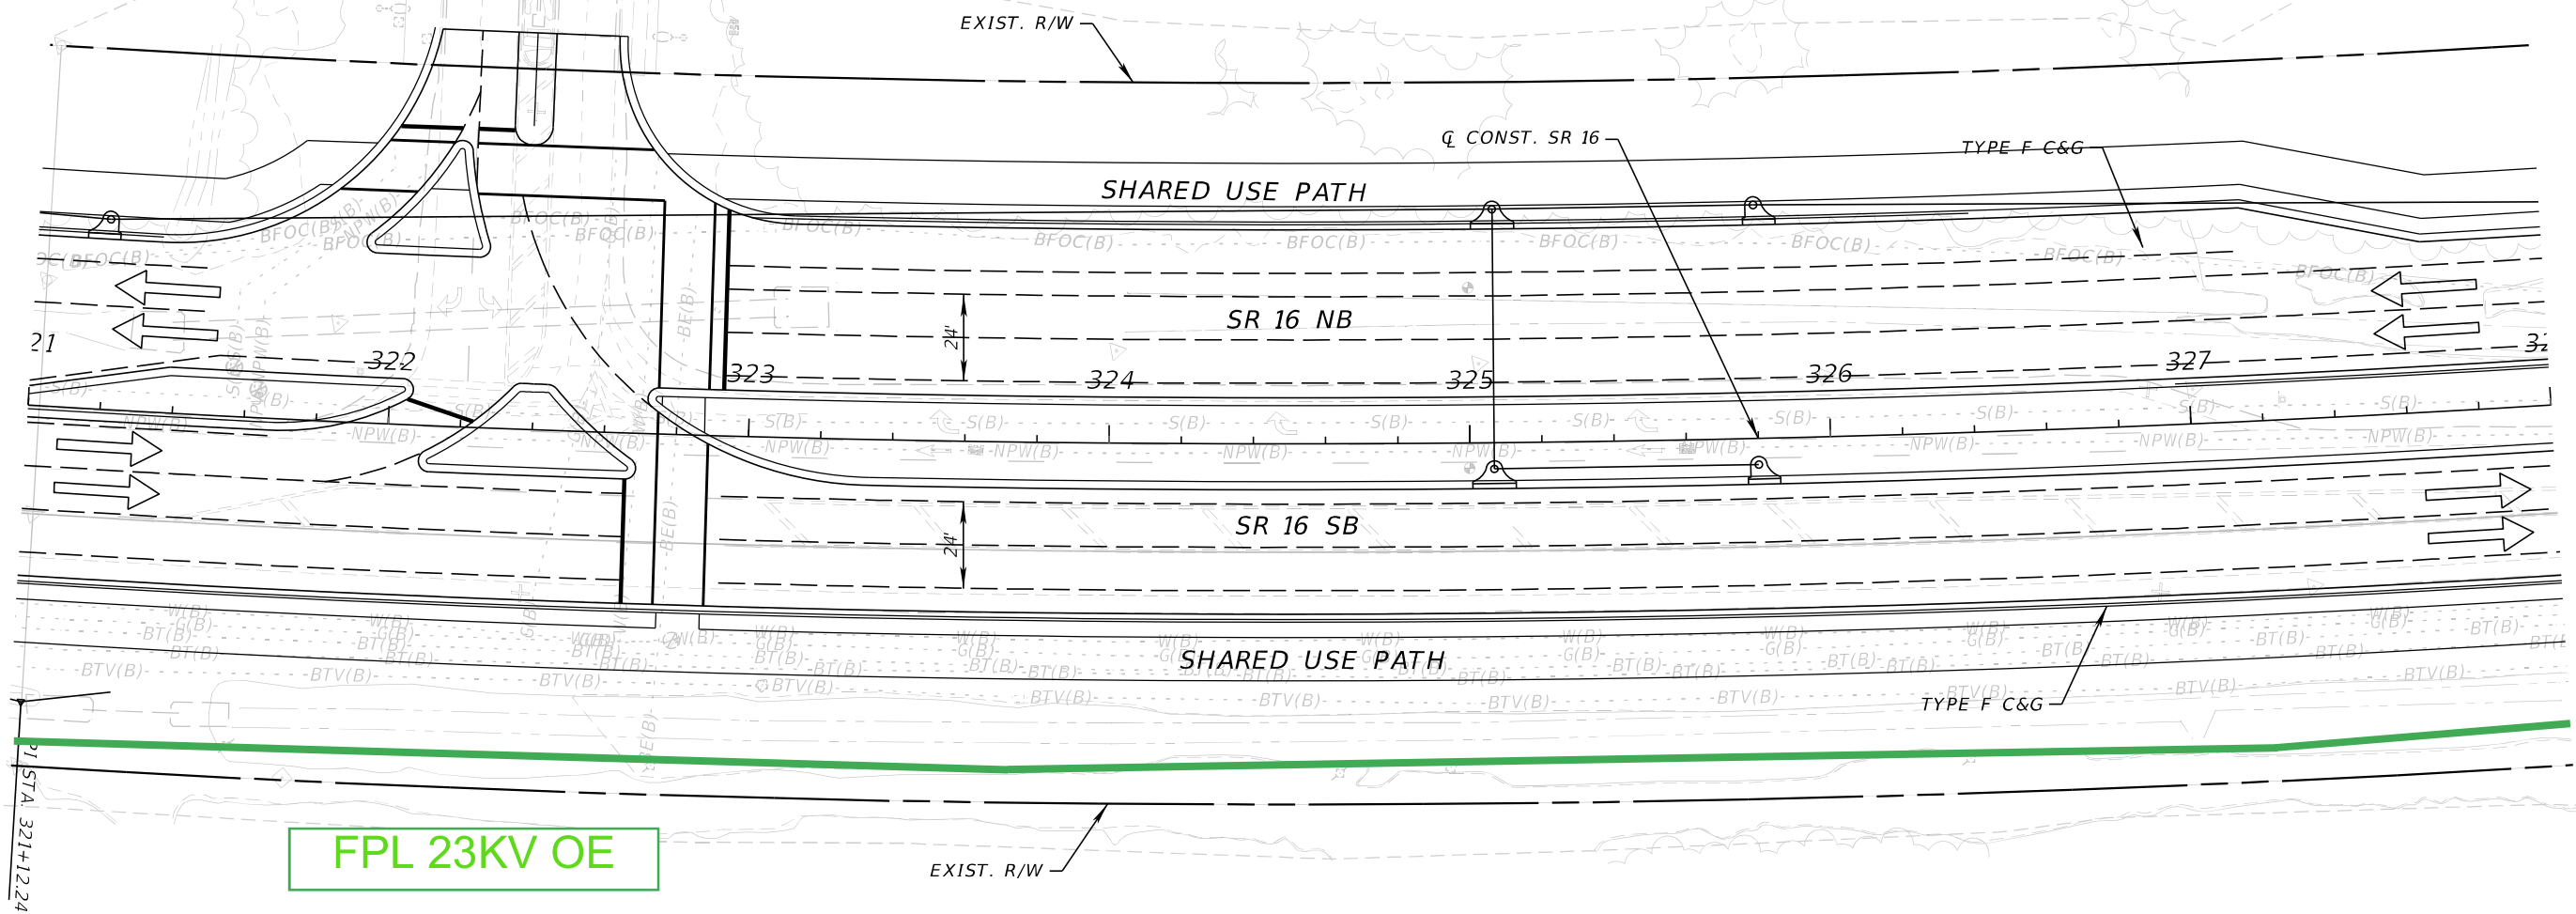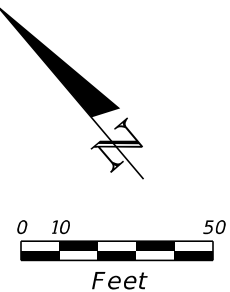

| REVISIONS | | | | ENGINEER OF RECORD | STATE OF FLORIDA DEPARTMENT OF TRANSPORTATION | | | SHEET NO. |
|-----------|-------------|------|-------------|---|--|-----------|----------------------|-----------------------|
| DATE | DESCRIPTION | DATE | DESCRIPTION | STEPHEN J. PARK, P.E. LICENSE NUMBER: 77656 RS&H, INC. 10748 DEERWOOD PARK BLVD. SOUTH JACKSONVILLE, FL 32256 | ROAD NO. | COUNTY | FINANCIAL PROJECT ID | |
| | | | | | SR 16 | ST. JOHNS | 210447-5-52-01 | |
| | | | | | | | | 11x17 Plan Only |

THE OFFICIAL RECORD OF THIS SHEET IS THE ELECTRONIC FILE DIGITALLY SIGNED AND SEALED UNDER RULE 61G15-23.004, F.A.C.


8/5/2024 4:28:59 PM BeattyM
c:\pw_work\ysh_pw\pw_user\00439575\PLANRD01.dgn

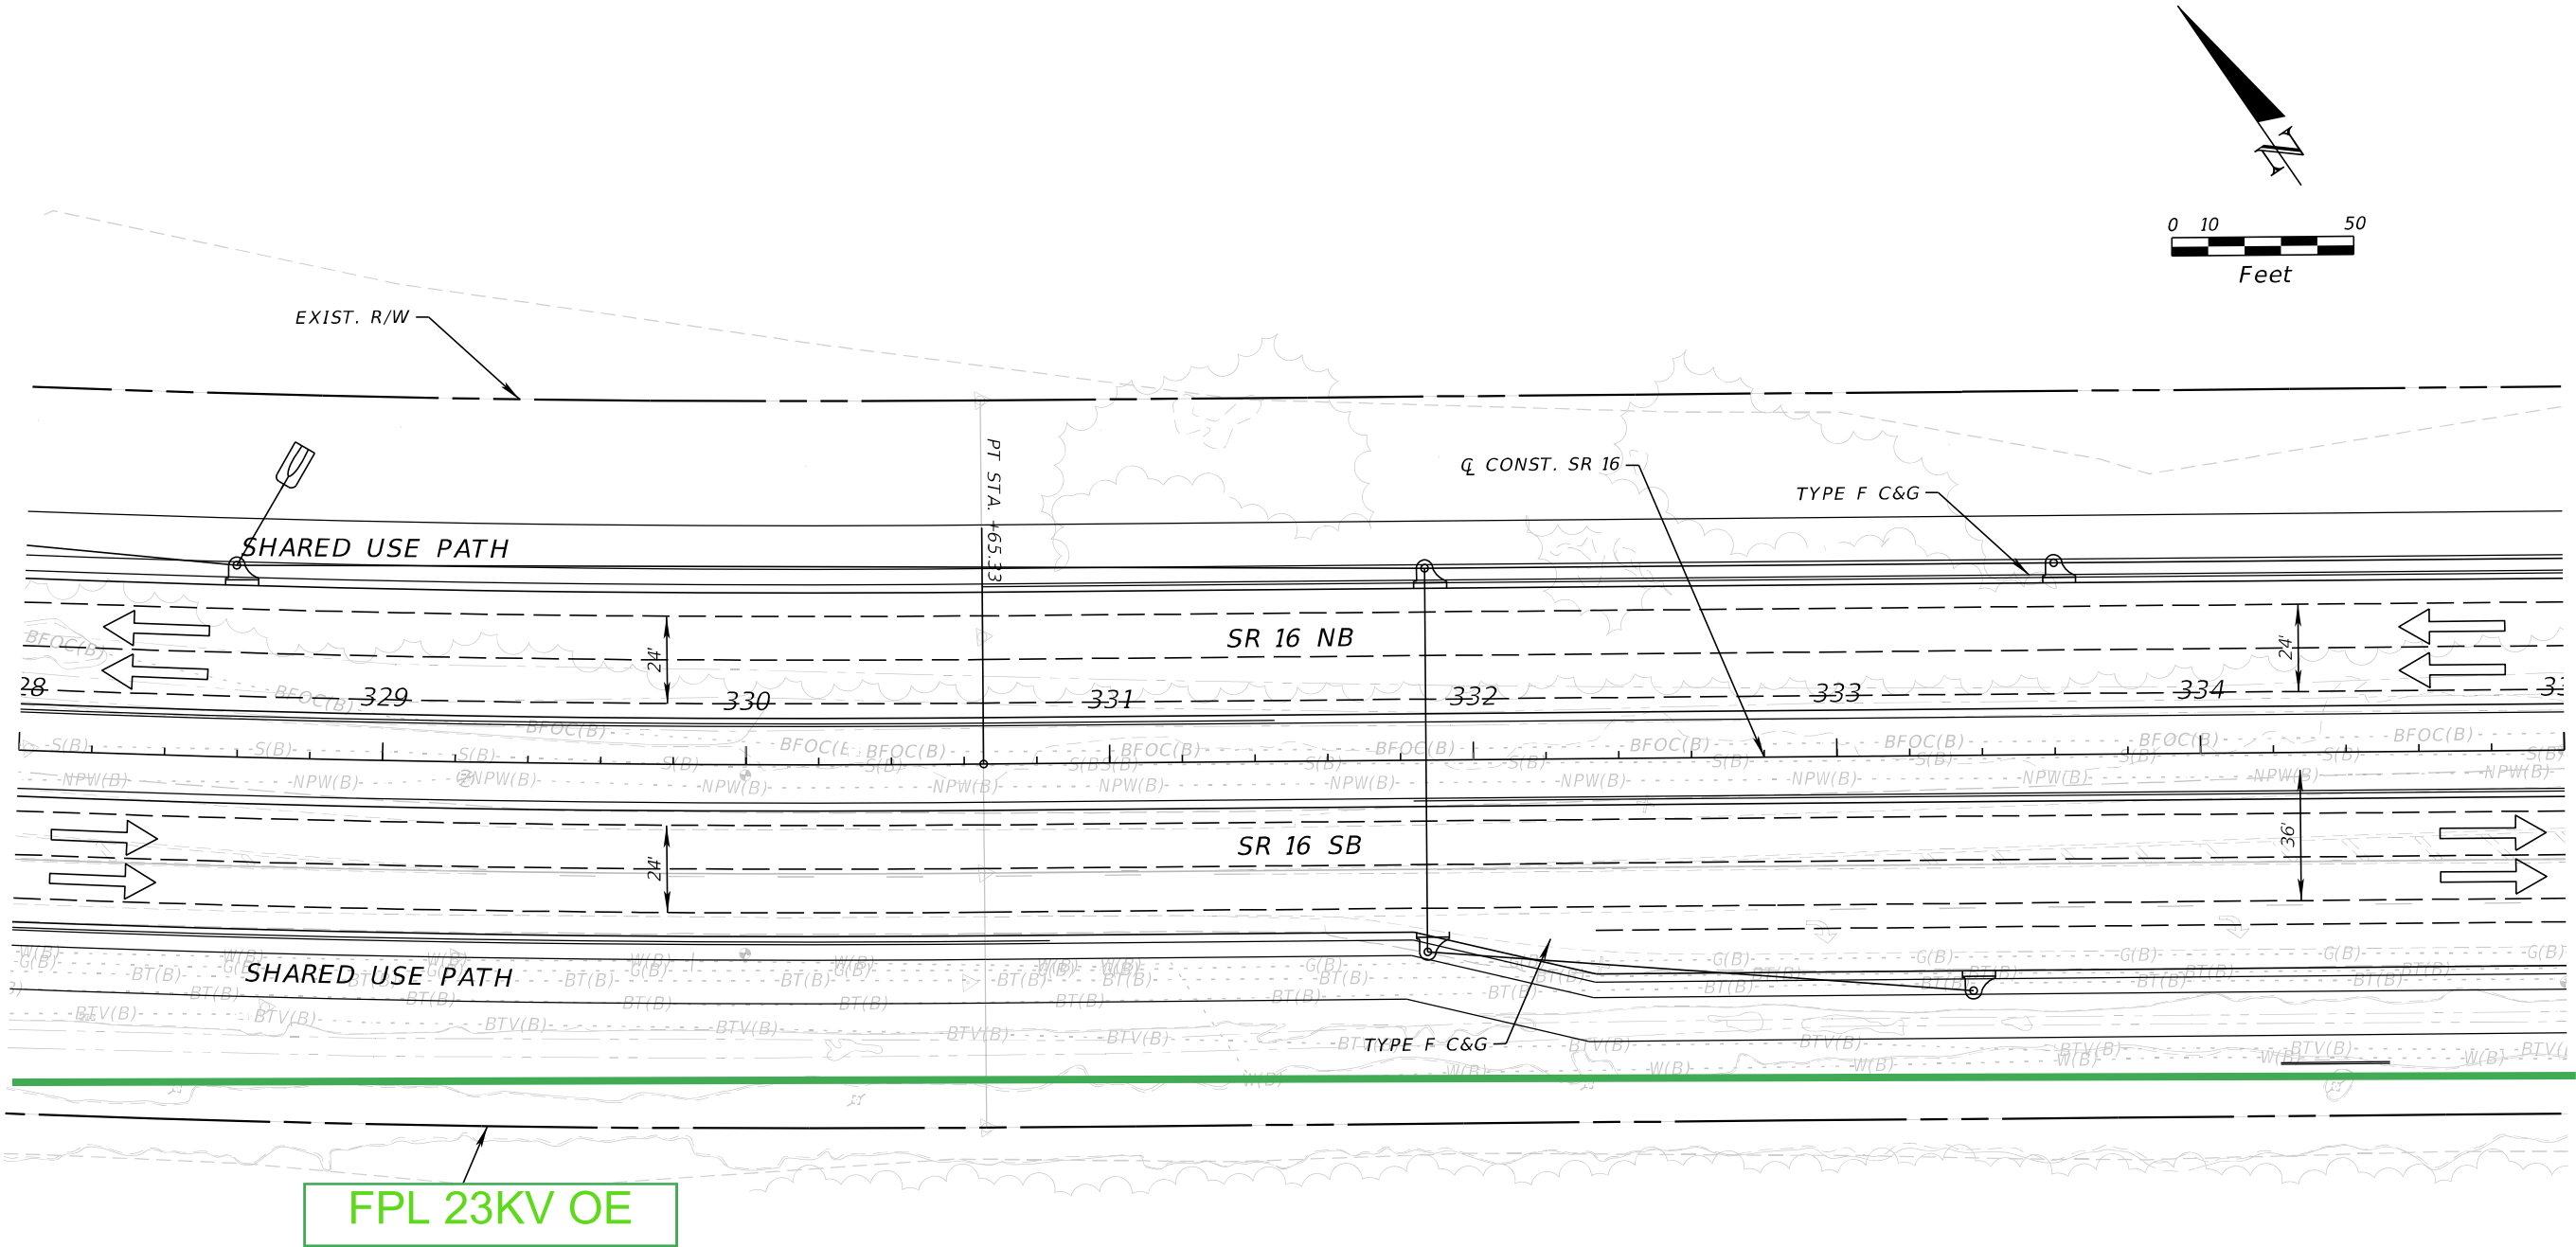

| REVISIONS | | | | ENGINEER OF RECORD | STATE OF FLORIDA DEPARTMENT OF TRANSPORTATION | | | SHEET NO. |
|-----------|-------------|------|-------------|---|--|-----------|----------------------|-----------------------|
| DATE | DESCRIPTION | DATE | DESCRIPTION | STEPHEN J. PARK, P.E. LICENSE NUMBER: 77656 RS&H, INC. 10748 DEERWOOD PARK BLVD. SOUTH JACKSONVILLE, FL 32256 | ROAD NO. | COUNTY | FINANCIAL PROJECT ID | |
| | | | | | SR 16 | ST. JOHNS | 210447-5-52-01 | |
| | | | | | | | | 11x17 Plan Only |

THE OFFICIAL RECORD OF THIS SHEET IS THE ELECTRONIC FILE DIGITALLY SIGNED AND SEALED UNDER RULE 61G15-23.004, F.A.C.


8/5/2024 4:28:59 PM BeattyM
c:\pw_work\ysh_pw\pw_user\00439575\PLANRD01.dgn

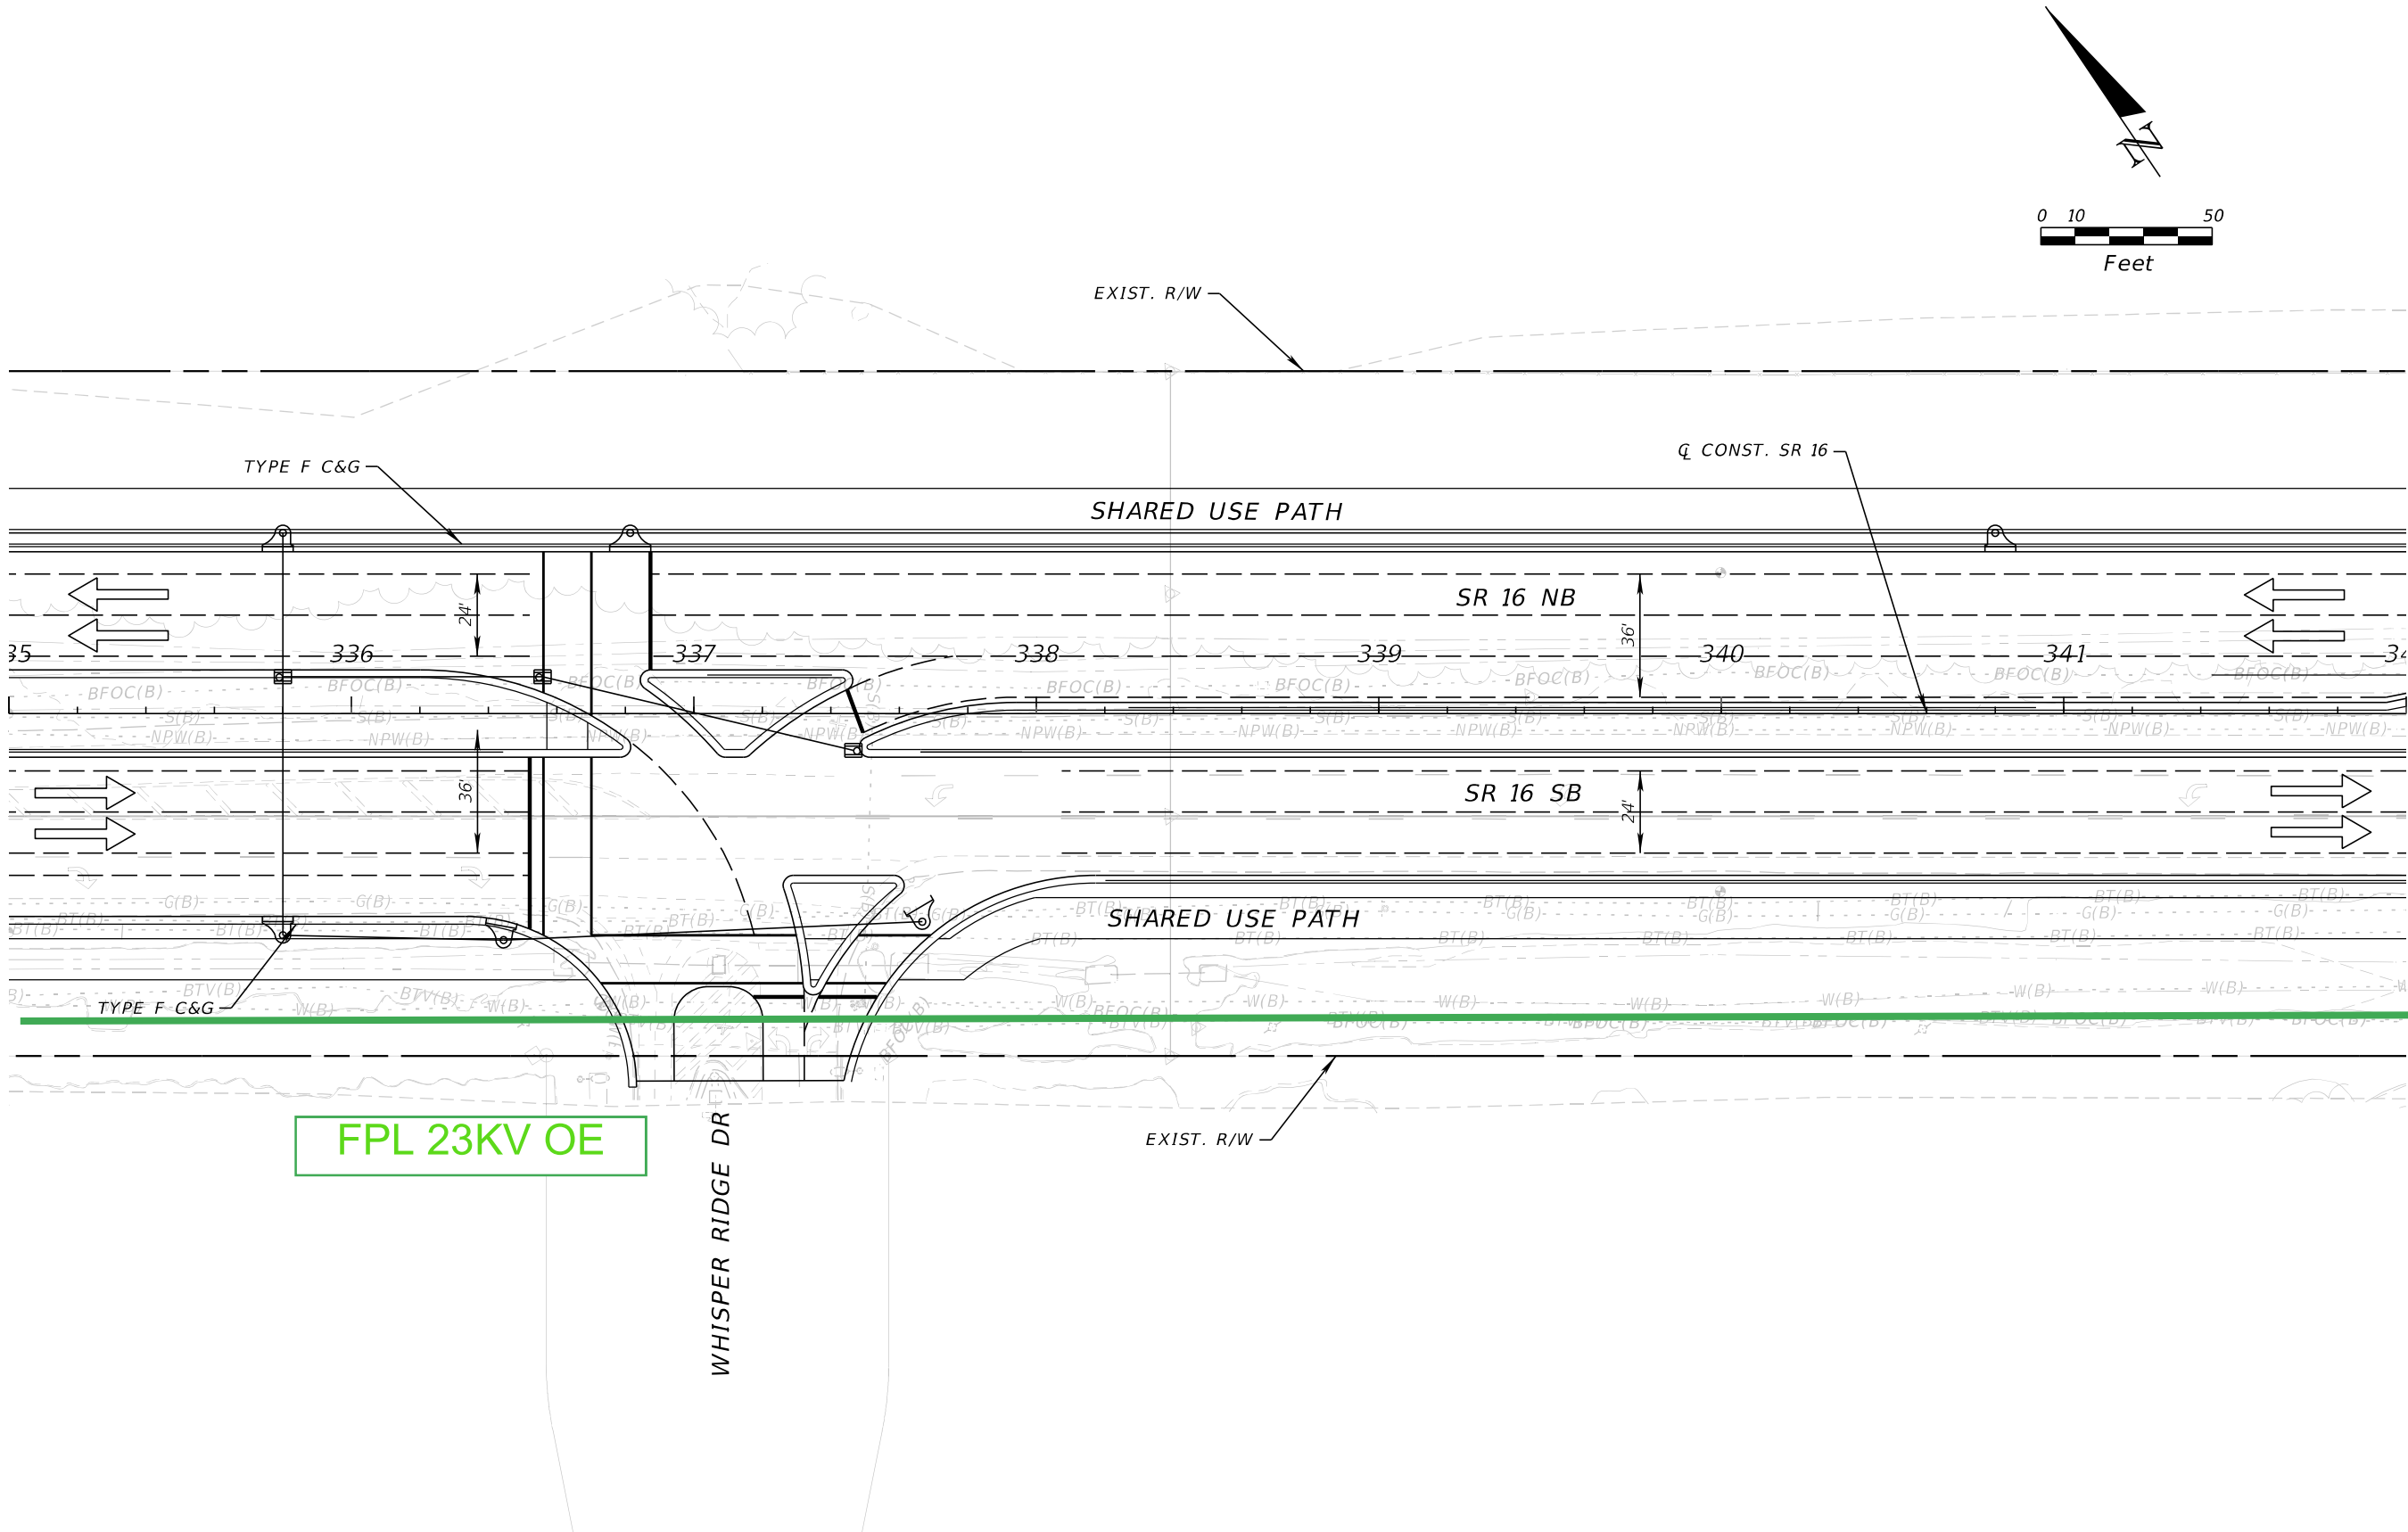

| REVISIONS | | | | ENGINEER OF RECORD | STATE OF FLORIDA DEPARTMENT OF TRANSPORTATION | | | SHEET NO. |
|-----------|-------------|------|-------------|---|--|-----------|----------------------|-----------------------|
| DATE | DESCRIPTION | DATE | DESCRIPTION | | ROAD NO. | COUNTY | FINANCIAL PROJECT ID | |
| | | | | STEPHEN J. PARK, P.E. LICENSE NUMBER: 77656 RS&H, INC. 10748 DEERWOOD PARK BLVD. SOUTH JACKSONVILLE, FL 32256 | SR 16 | ST. JOHNS | 210447-5-52-01 | 11x17 Plan Only |

THE OFFICIAL RECORD OF THIS SHEET IS THE ELECTRONIC FILE DIGITALLY SIGNED AND SEALED UNDER RULE 61G15-23.004, F.A.C.



8/5/2024 4:29:00 PM BeattyM
c:\pw_work\sh_pw\pw_user\0439575\PLANRD01.dgn

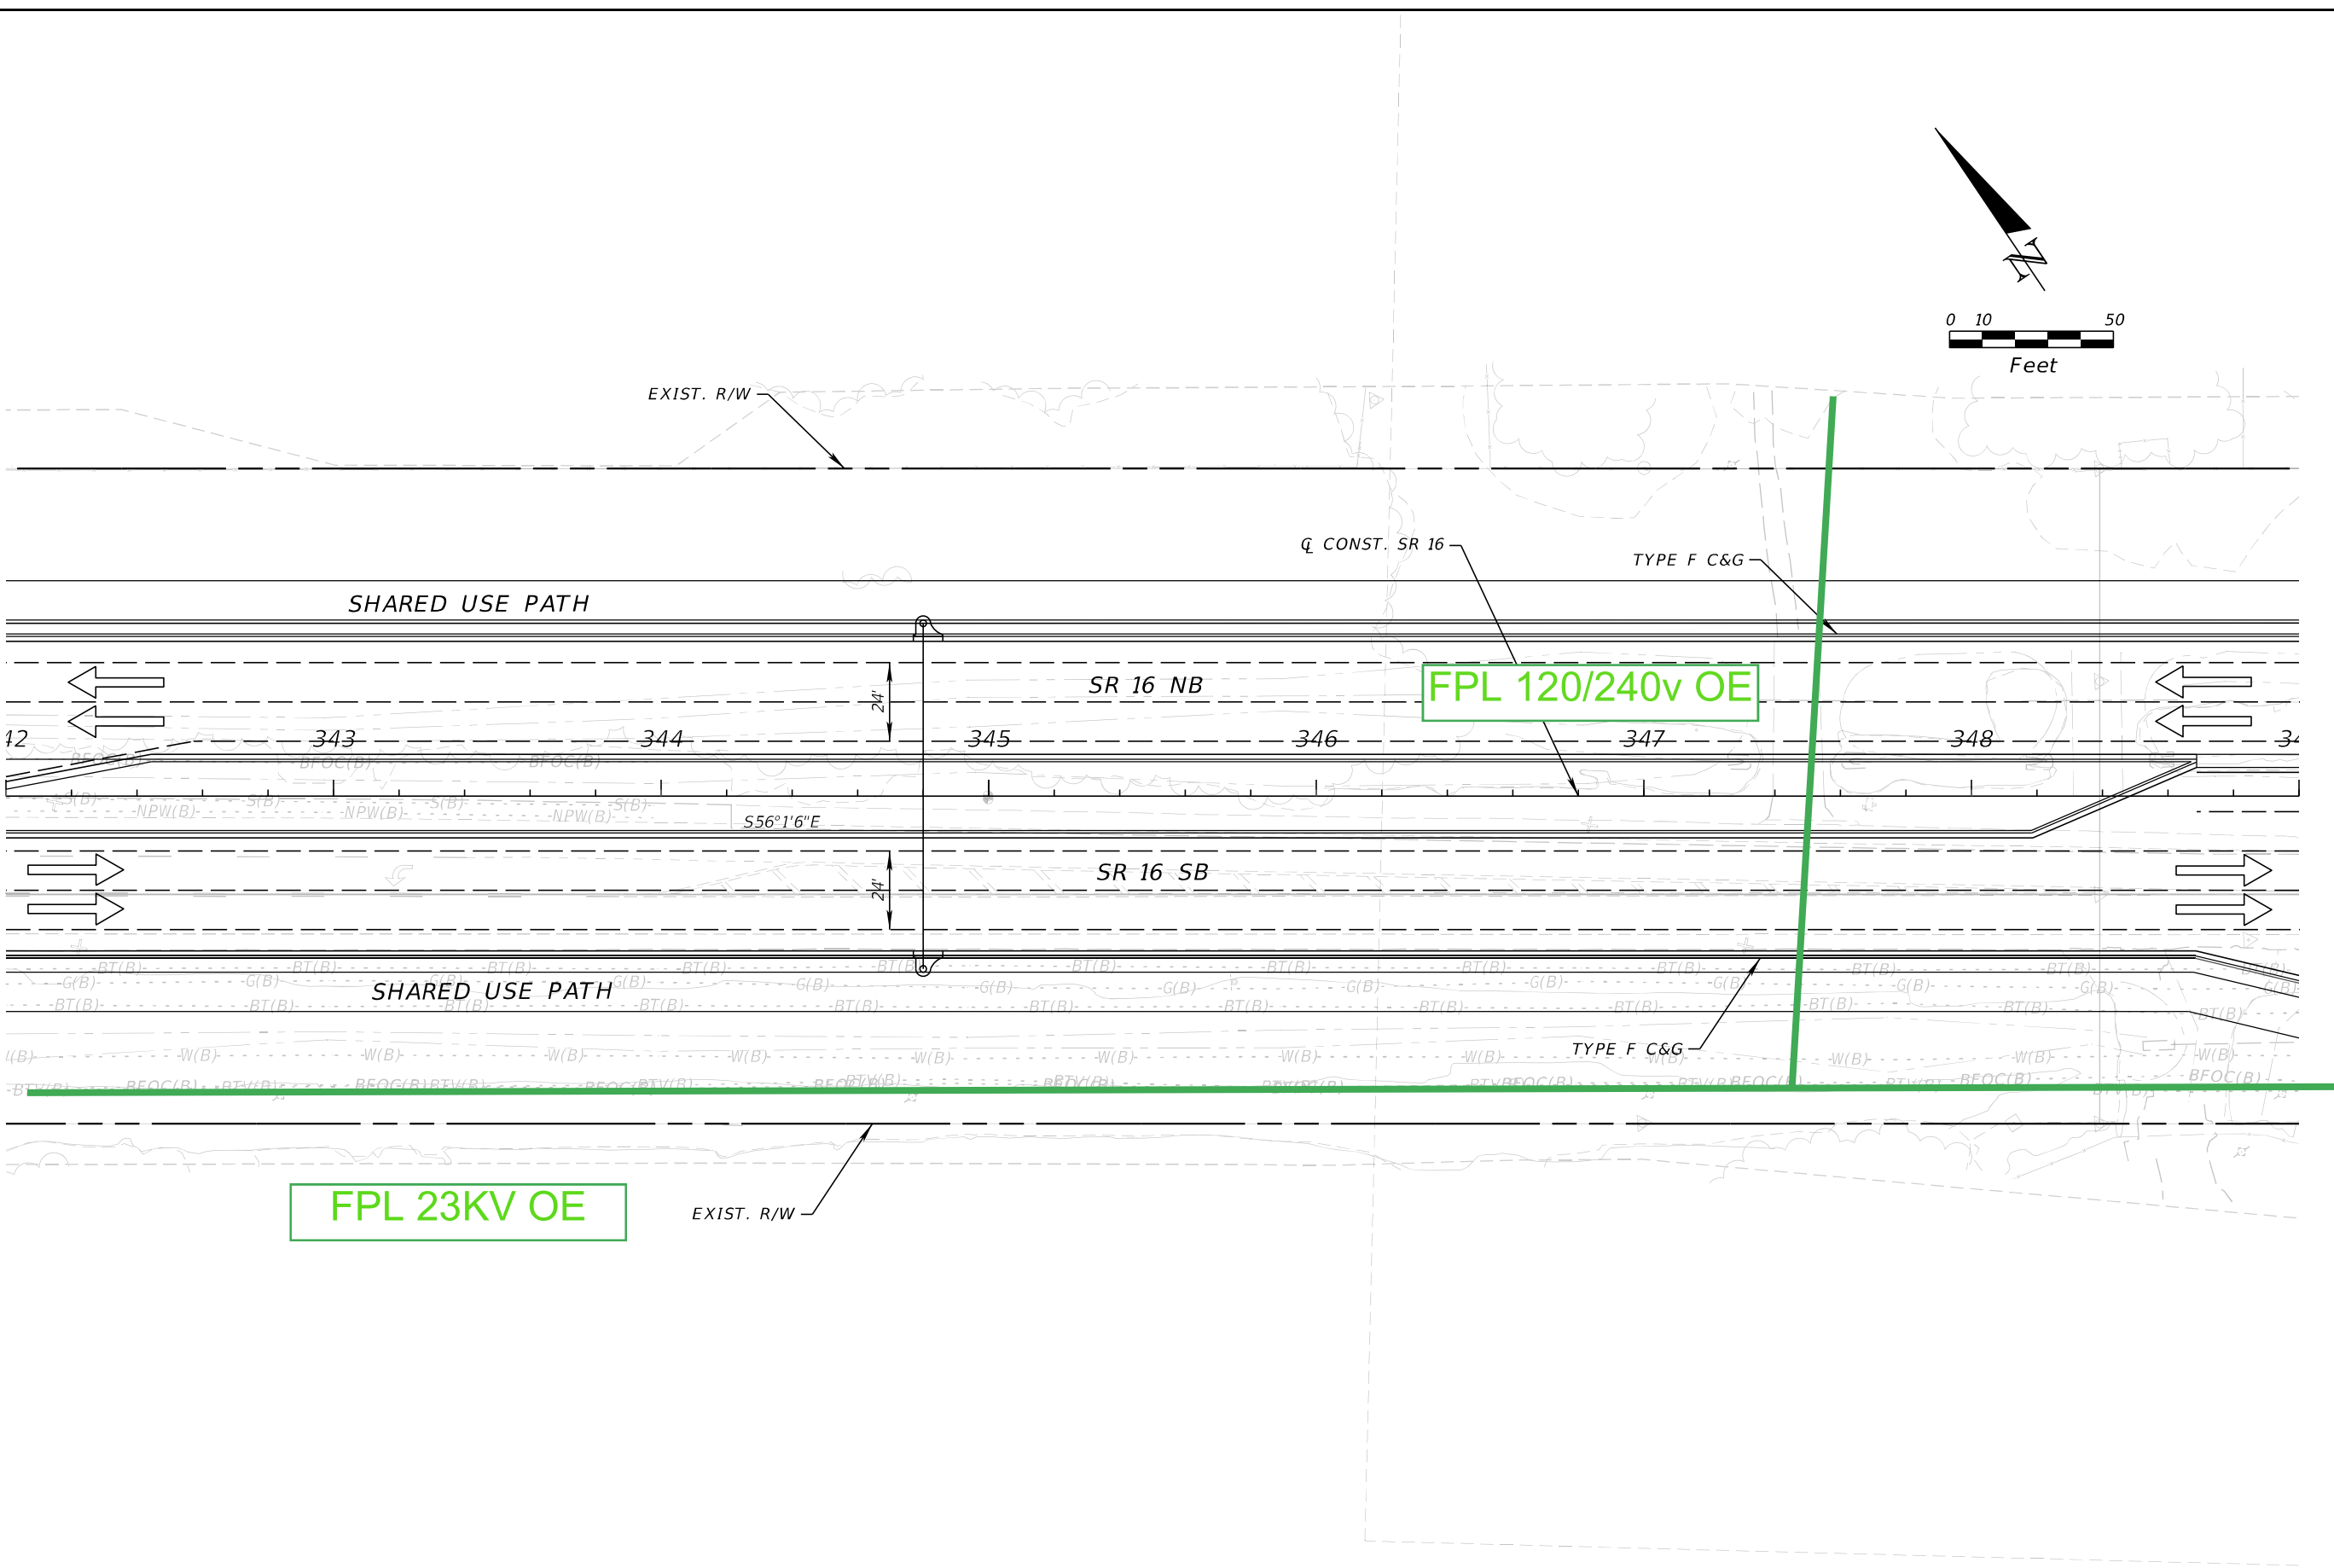

| REVISIONS | | | | ENGINEER OF RECORD | STATE OF FLORIDA DEPARTMENT OF TRANSPORTATION | | | SHEET NO. | | |
|-----------|-------------|--|------|--------------------|--|---|--------|--------------|----------------------|-----------------------|
| DATE | DESCRIPTION | | DATE | DESCRIPTION | | ROAD NO. | COUNTY | | FINANCIAL PROJECT ID | |
| | | | | | | STEPHEN J. PARK, P.E. LICENSE NUMBER: 77656 RS&H, INC. 10748 DEERWOOD PARK BLVD. SOUTH JACKSONVILLE, FL 32256 | SR 16 | ST. JOHNS | 210447-5-52-01 | 11x17 Plan Only |

THE OFFICIAL RECORD OF THIS SHEET IS THE ELECTRONIC FILE DIGITALLY SIGNED AND SEALED UNDER RULE 61G15-23.004, F.A.C.

TADPOLE PREP

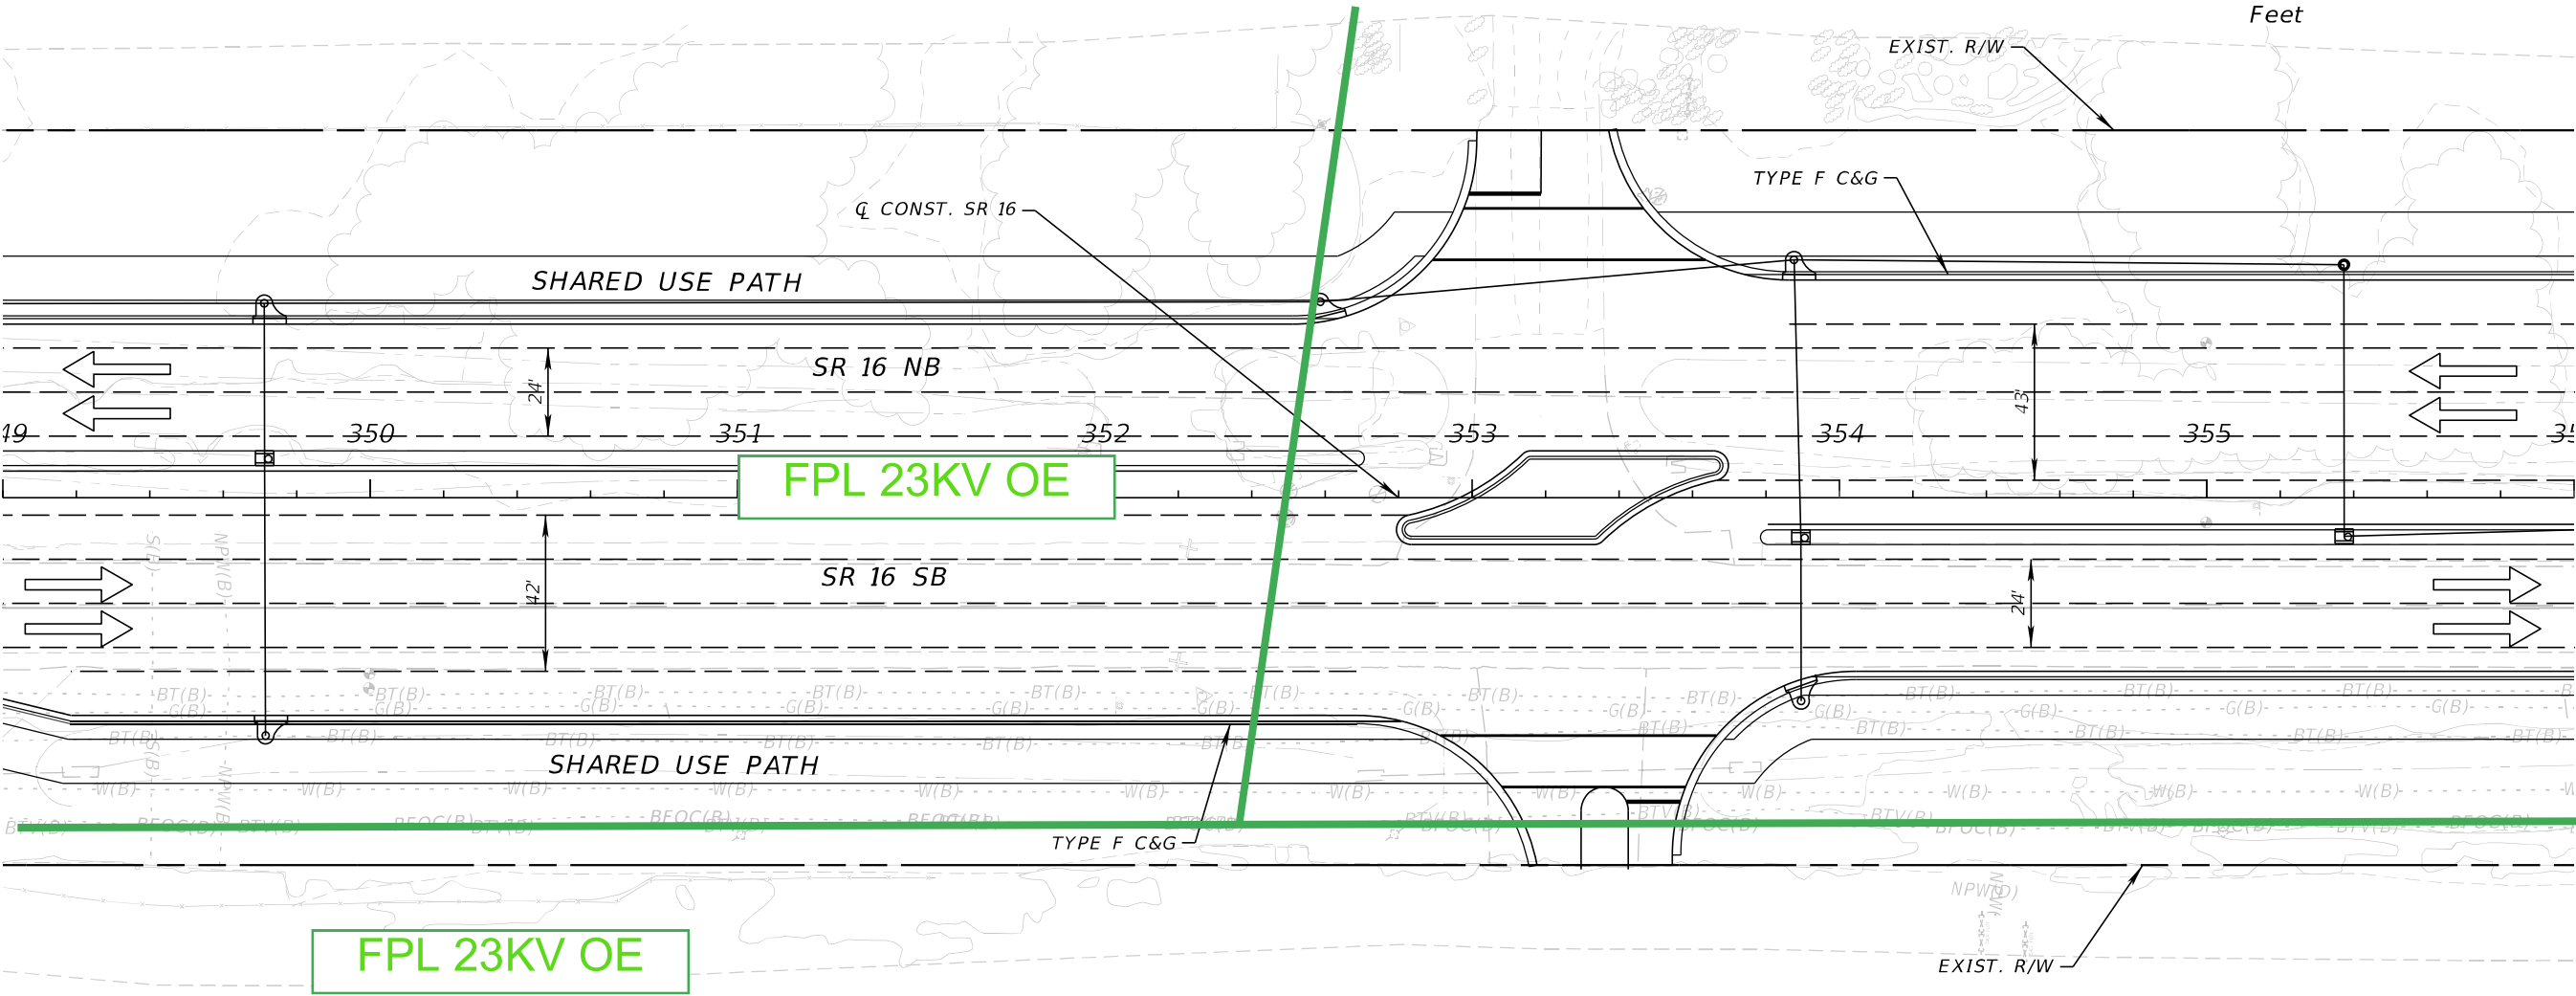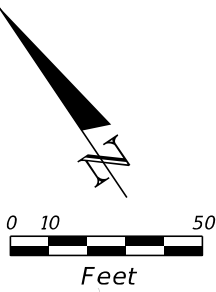



SOLUNA (UNDER CONSTRUCTION)

8/5/2024 4:29:01 PM BeattyM
c:\pw_work\sh_pw\pw_user\0439575\PLANRD01.dgn

| REVISIONS | | | | ENGINEER OF RECORD | STATE OF FLORIDA DEPARTMENT OF TRANSPORTATION | | | SHEET NO. |
|-----------|-------------|------|-------------|---|--|-----------|----------------------|-----------------------|
| DATE | DESCRIPTION | DATE | DESCRIPTION | STEPHEN J. PARK, P.E. LICENSE NUMBER: 77656 RS&H, INC. 10748 DEERWOOD PARK BLVD. SOUTH JACKSONVILLE, FL 32256 | ROAD NO. | COUNTY | FINANCIAL PROJECT ID | |
| | | | | | SR 16 | ST. JOHNS | 210447-5-52-01 | |
| | | | | | | | | 11x17 Plan Only |

THE OFFICIAL RECORD OF THIS SHEET IS THE ELECTRONIC FILE DIGITALLY SIGNED AND SEALED UNDER RULE 61G15-23.004, F.A.C.

KINGDOM HALL OF
JEHOVA'S WITNESSES

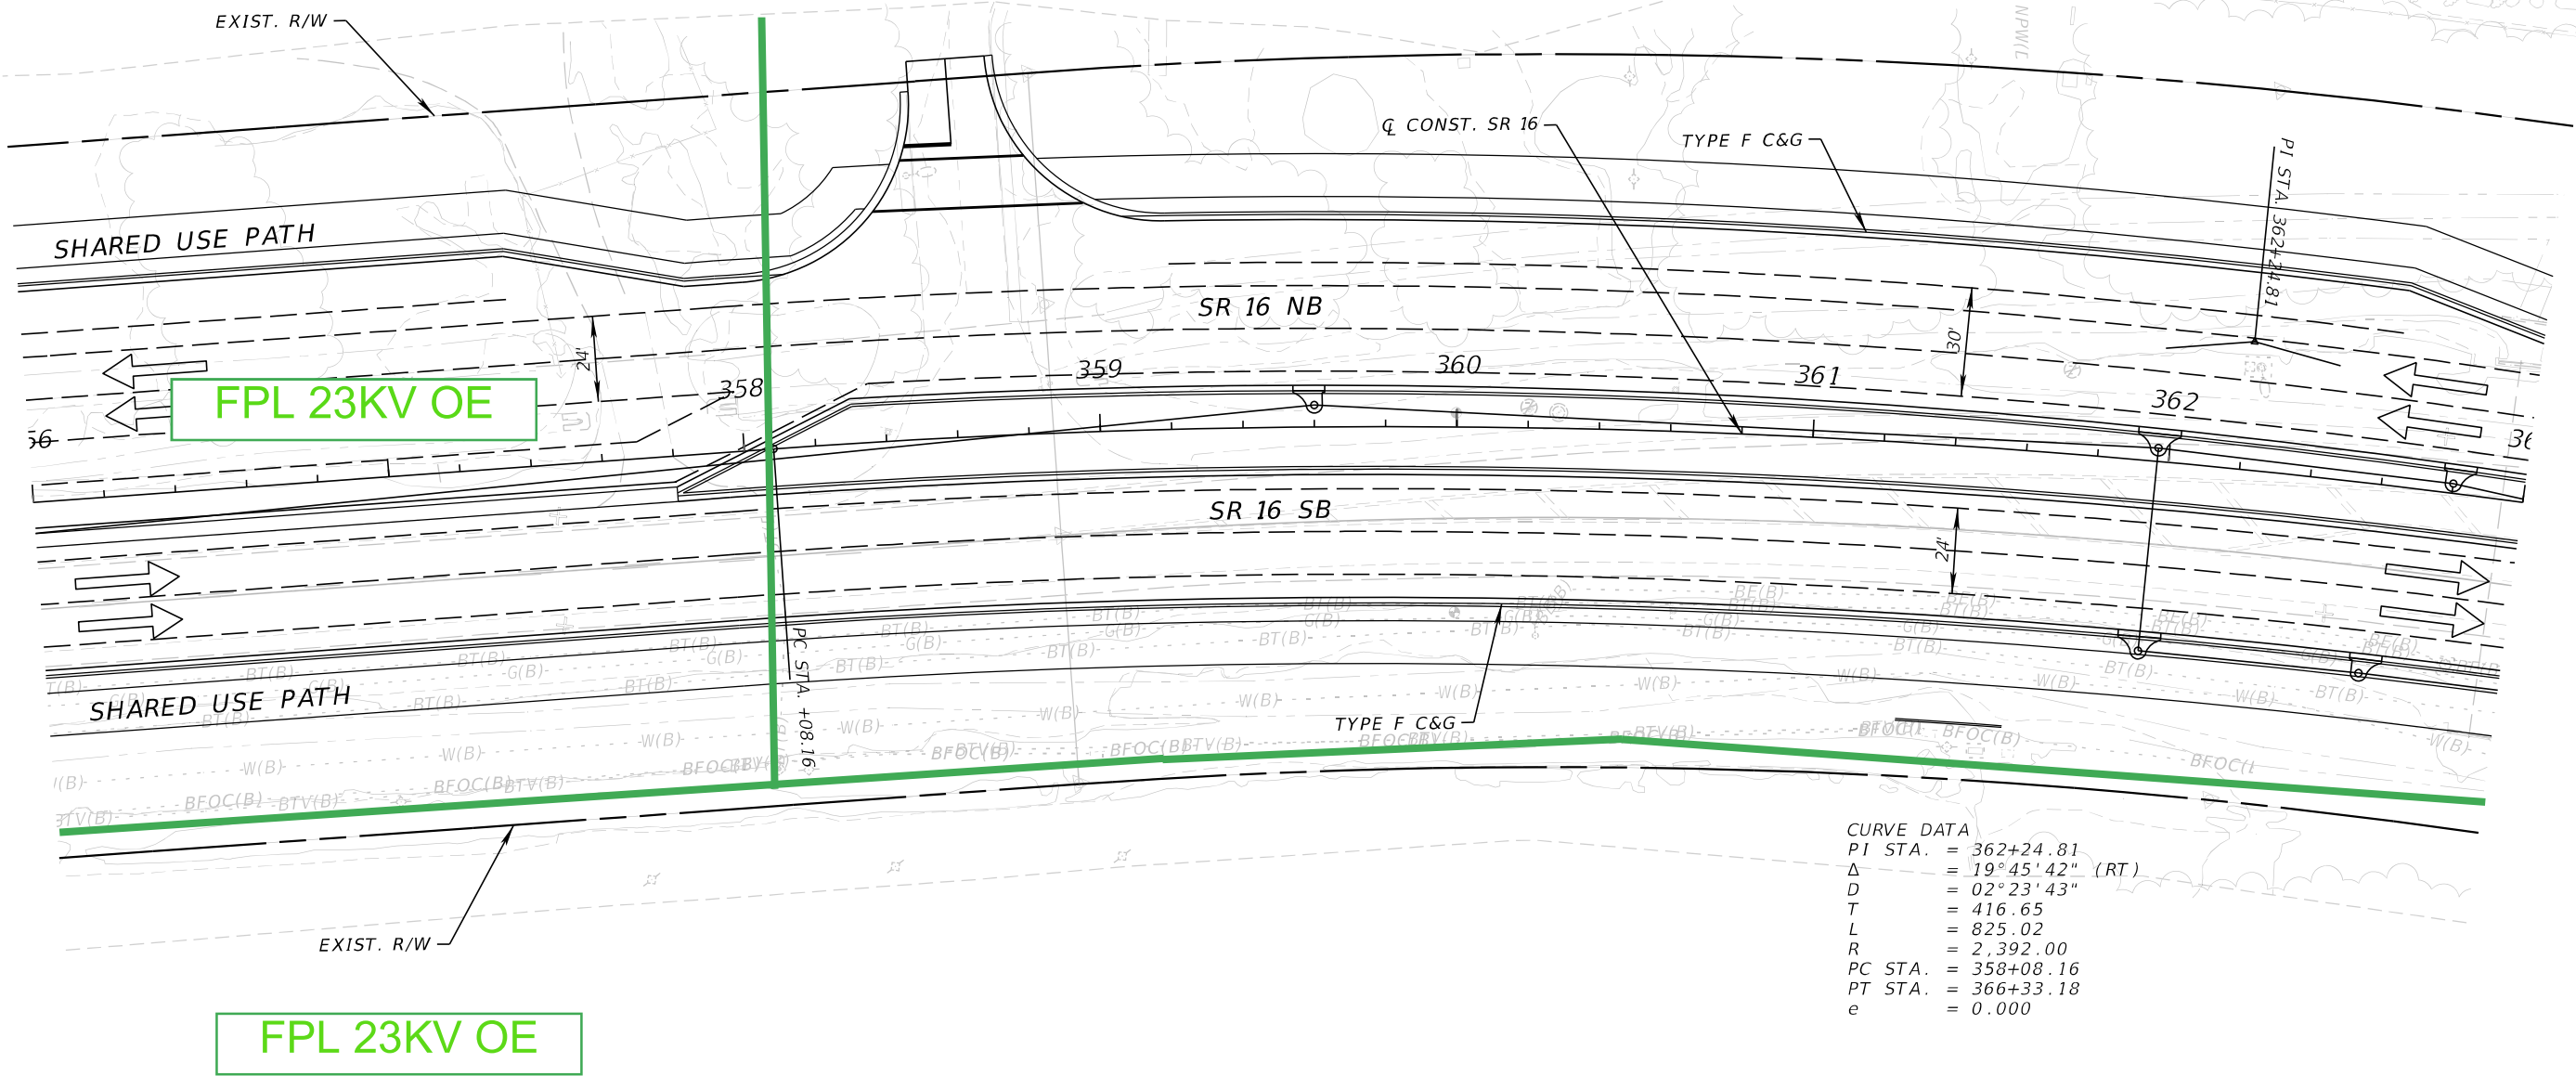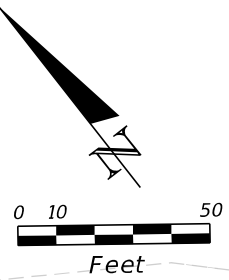



| CURVE DATA | |
|------------|------------------|
| PI STA. | = 362+24.81 |
| Δ | = 19°45'42" (RT) |
| D | = 02°23'43" |
| T | = 416.65 |
| L | = 825.02 |
| R | = 2,392.00 |
| PC STA. | = 358+08.16 |
| PT STA. | = 366+33.18 |
| e | = 0.000 |

8/5/2024 4:29:01 PM BeattyM
c:\pw_work\sh_pw\pw_user\0439575\PLANRD01.dgn

| REVISIONS | | | | ENGINEER OF RECORD | STATE OF FLORIDA DEPARTMENT OF TRANSPORTATION | | | SHEET NO. |
|-----------|-------------|------|-------------|---|--|-----------|----------------------|-----------------------|
| DATE | DESCRIPTION | DATE | DESCRIPTION | STEPHEN J. PARK, P.E. LICENSE NUMBER: 77656 RS&H, INC. 10748 DEERWOOD PARK BLVD. SOUTH JACKSONVILLE, FL 32256 | ROAD NO. | COUNTY | FINANCIAL PROJECT ID | |
| | | | | | SR 16 | ST. JOHNS | 210447-5-52-01 | |
| | | | | | | | | 11x17 Plan Only |

THE OFFICIAL RECORD OF THIS SHEET IS THE ELECTRONIC FILE DIGITALLY SIGNED AND SEALED UNDER RULE 61G15-23.004, F.A.C.

ATLANTIC SELF STORAGE

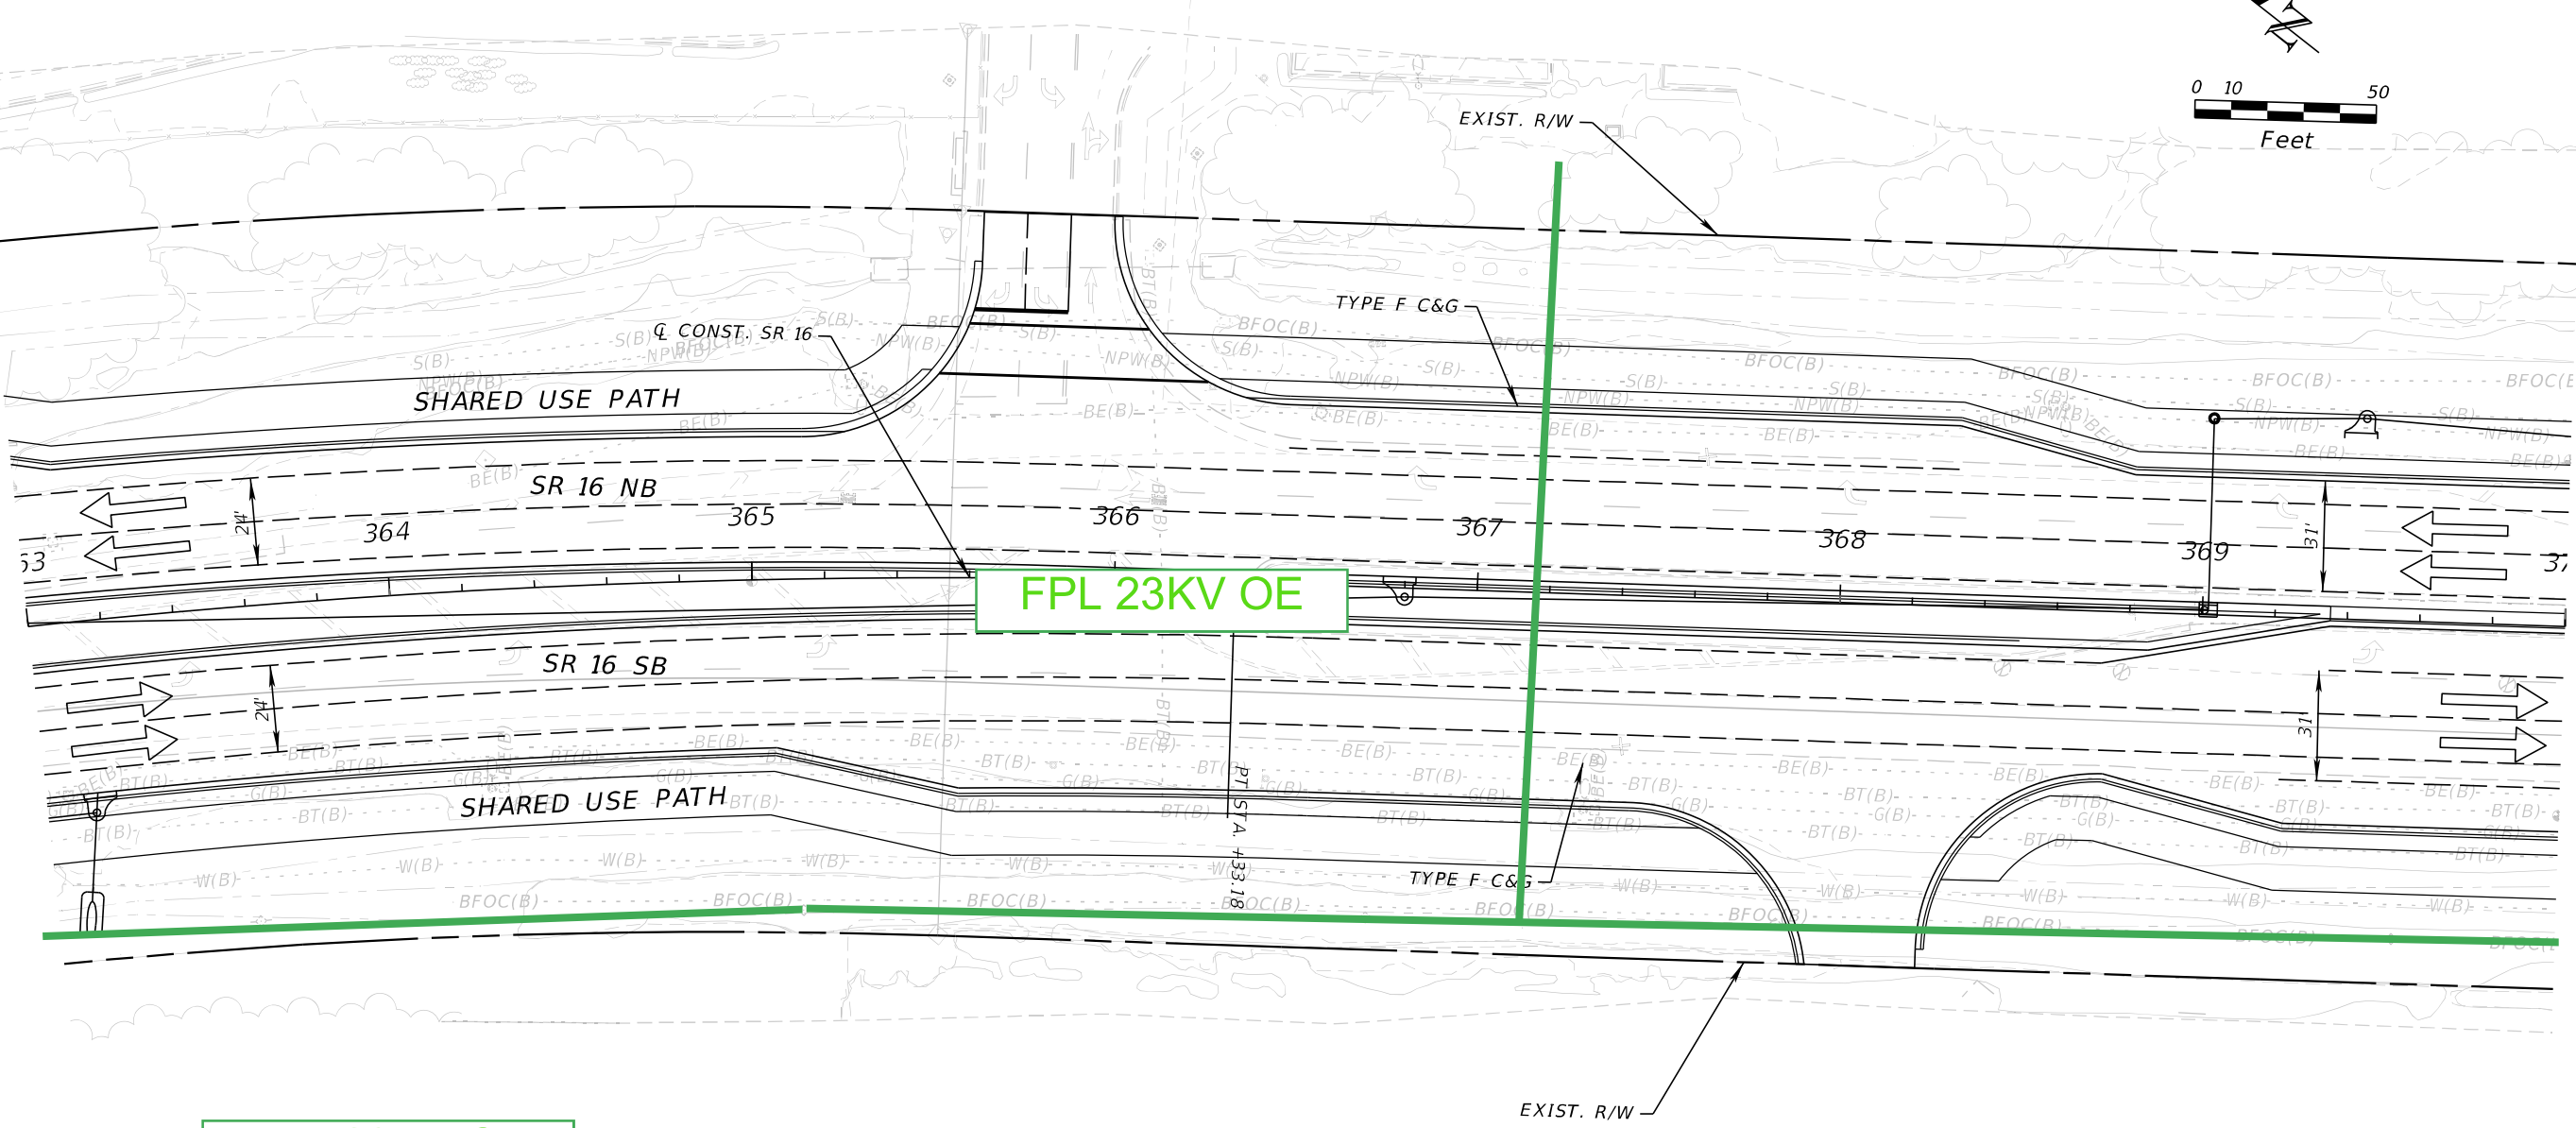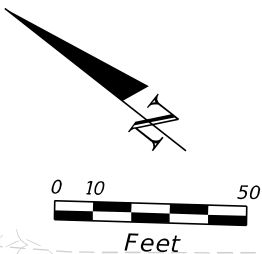


FPL 23KV OE

8/5/2024 4:29:02 PM BeattyM c:\pw_work\ysh_pw\pw_user\00439575\PLANRD01.dgn

| REVISIONS | | | | ENGINEER OF RECORD | | STATE OF FLORIDA DEPARTMENT OF TRANSPORTATION | | | SHEET NO. |
|-----------|-------------|------|-------------|---|--|--|-----------|----------------------|--------------|
| DATE | DESCRIPTION | DATE | DESCRIPTION | STEPHEN J. PARK, P.E. LICENSE NUMBER: 77656 RS&H, INC. 10748 DEERWOOD PARK BLVD. SOUTH JACKSONVILLE, FL 32256 | | ROAD NO. | COUNTY | FINANCIAL PROJECT ID | |
| | | | | | | SR 16 | ST. JOHNS | 210447-5-52-01 | |

THE OFFICIAL RECORD OF THIS SHEET IS THE ELECTRONIC FILE DIGITALLY SIGNED AND SEALED UNDER RULE 61G15-23.004, F.A.C.


8/5/2024 4:29:03 PM BeattyM
c:\pw_work\ysh_pw\pw_user\00439575\PLANRD01.dgn

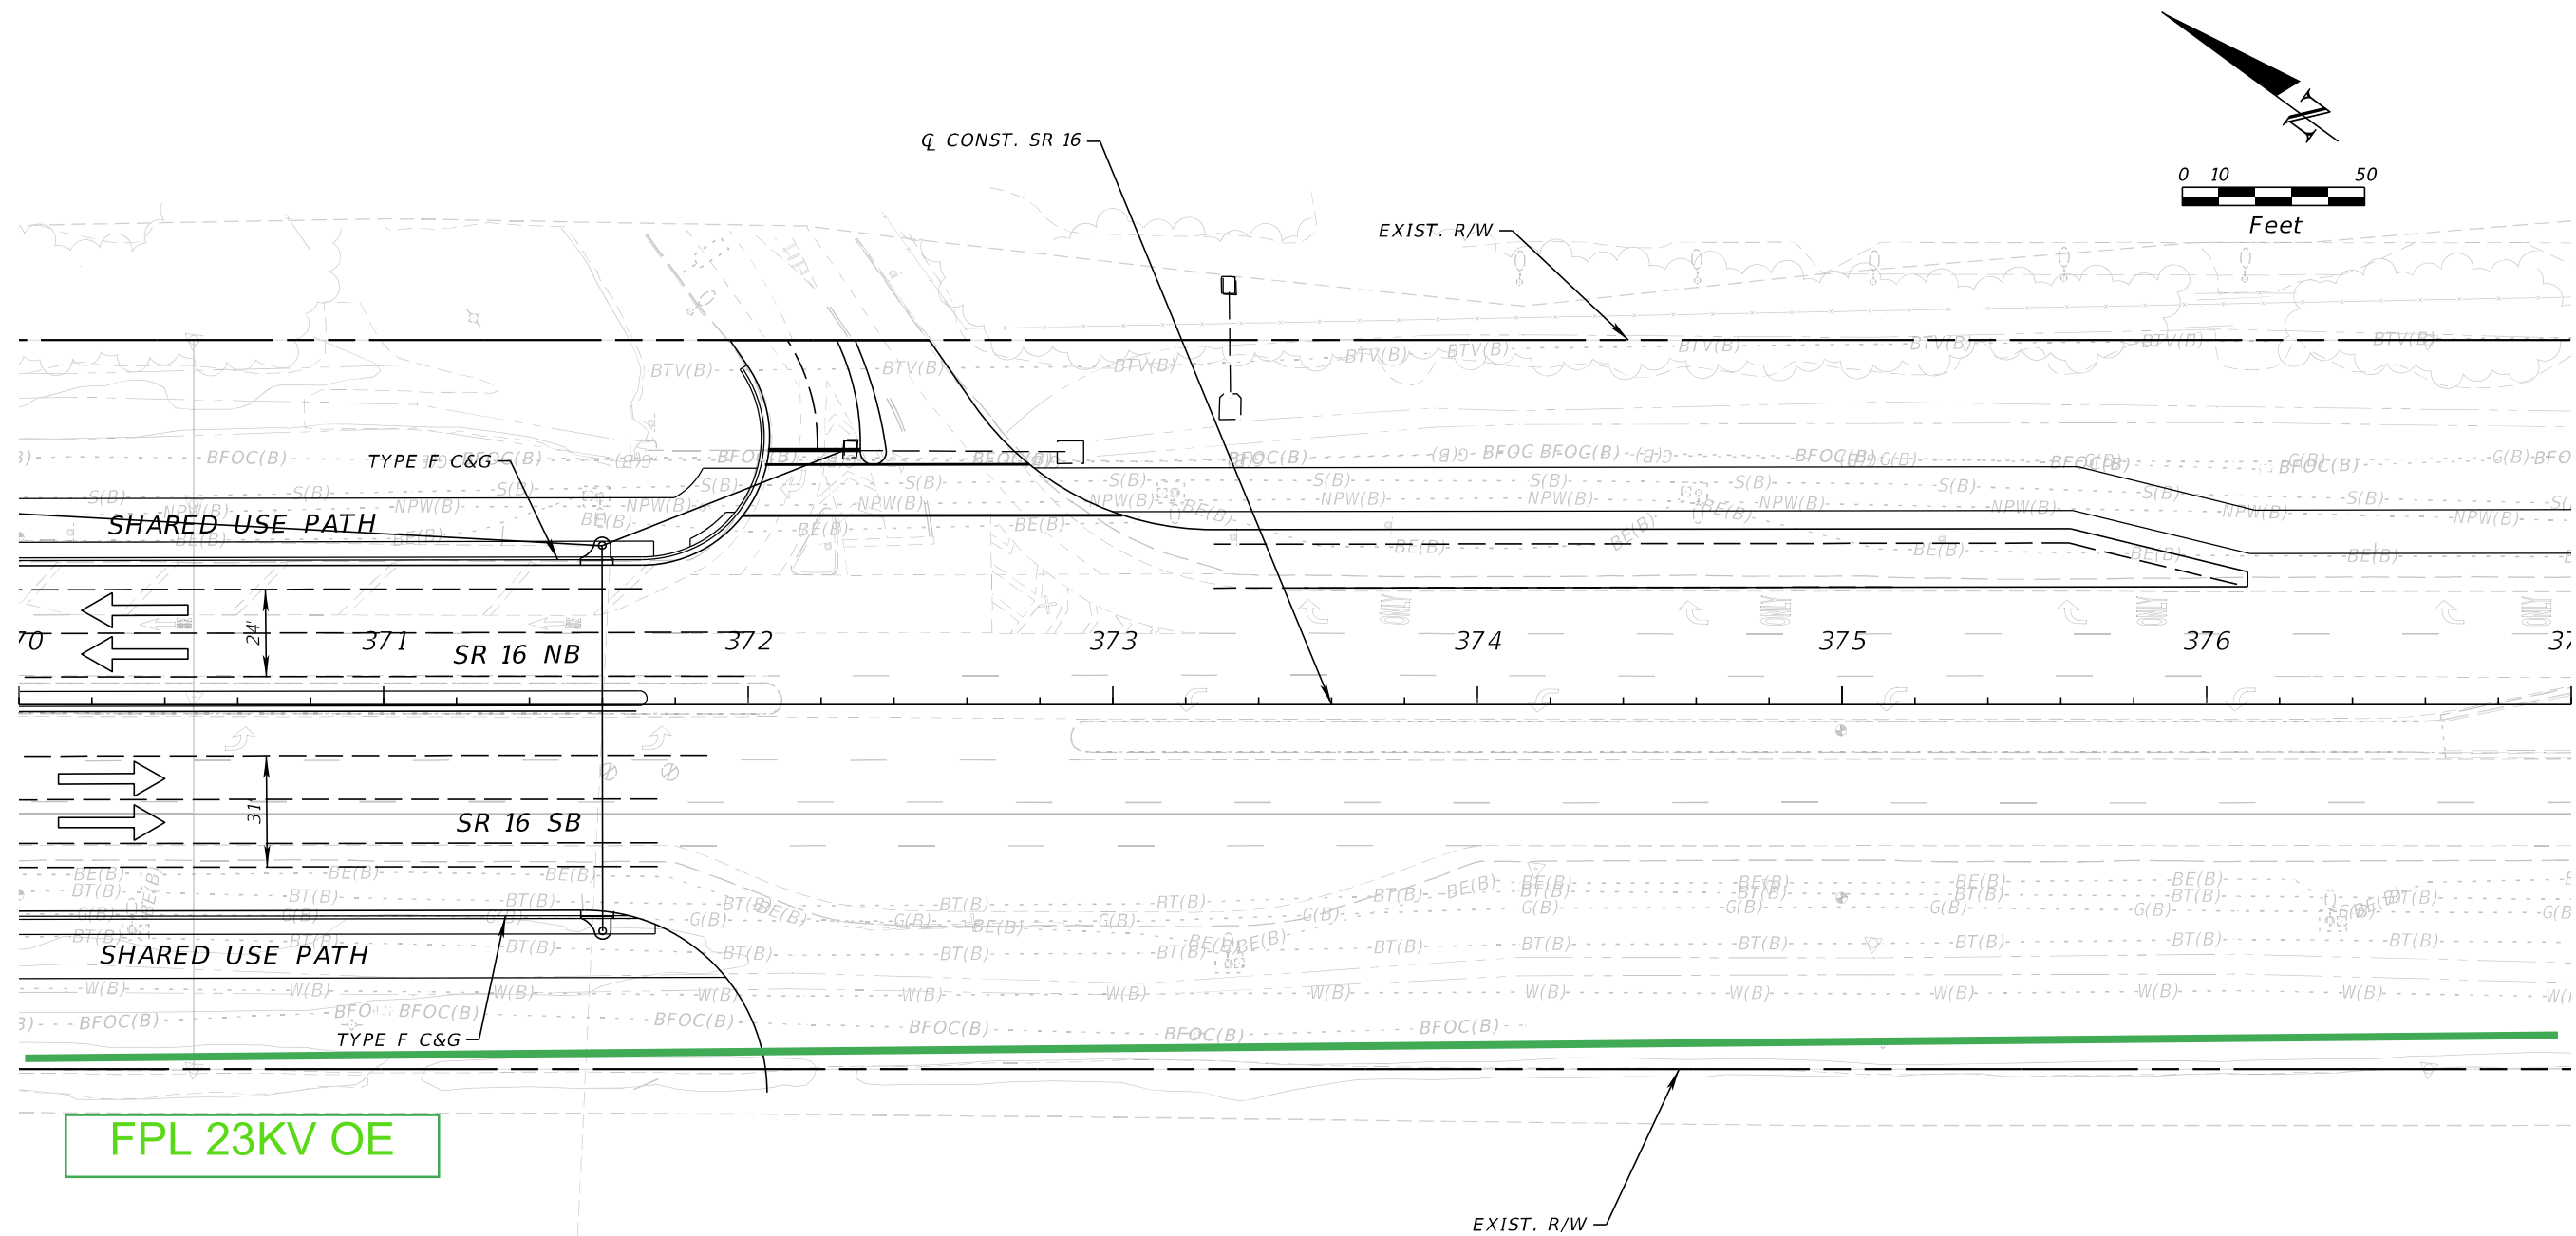

| | | | | | | | | | |
|-----------|-------------|--|------|---|--|--|--|--|-----------------------|
| REVISIONS | | | | ENGINEER OF RECORD | | STATE OF FLORIDA DEPARTMENT OF TRANSPORTATION | | | SHEET NO. |
| DATE | DESCRIPTION | | DATE | DESCRIPTION | | ROAD NO. COUNTY FINANCIAL PROJECT ID | | | |
| | | | | | | | | | |
| | | | | STEPHEN J. PARK, P.E. LICENSE NUMBER: 77656 RS&H, INC. 10748 DEERWOOD PARK BLVD. SOUTH JACKSONVILLE, FL 32256 | | SR 16 ST. JOHNS 210447-5-52-01 | | | 11x17 Plan Only |

THE OFFICIAL RECORD OF THIS SHEET IS THE ELECTRONIC FILE DIGITALLY SIGNED AND SEALED UNDER RULE 61G15-23.004, F.A.C.




8/5/2024 4:29:03 PM BeattyM
c:\pw_work\sh_pw\pw_user\0439575\PLANRD01.dgn

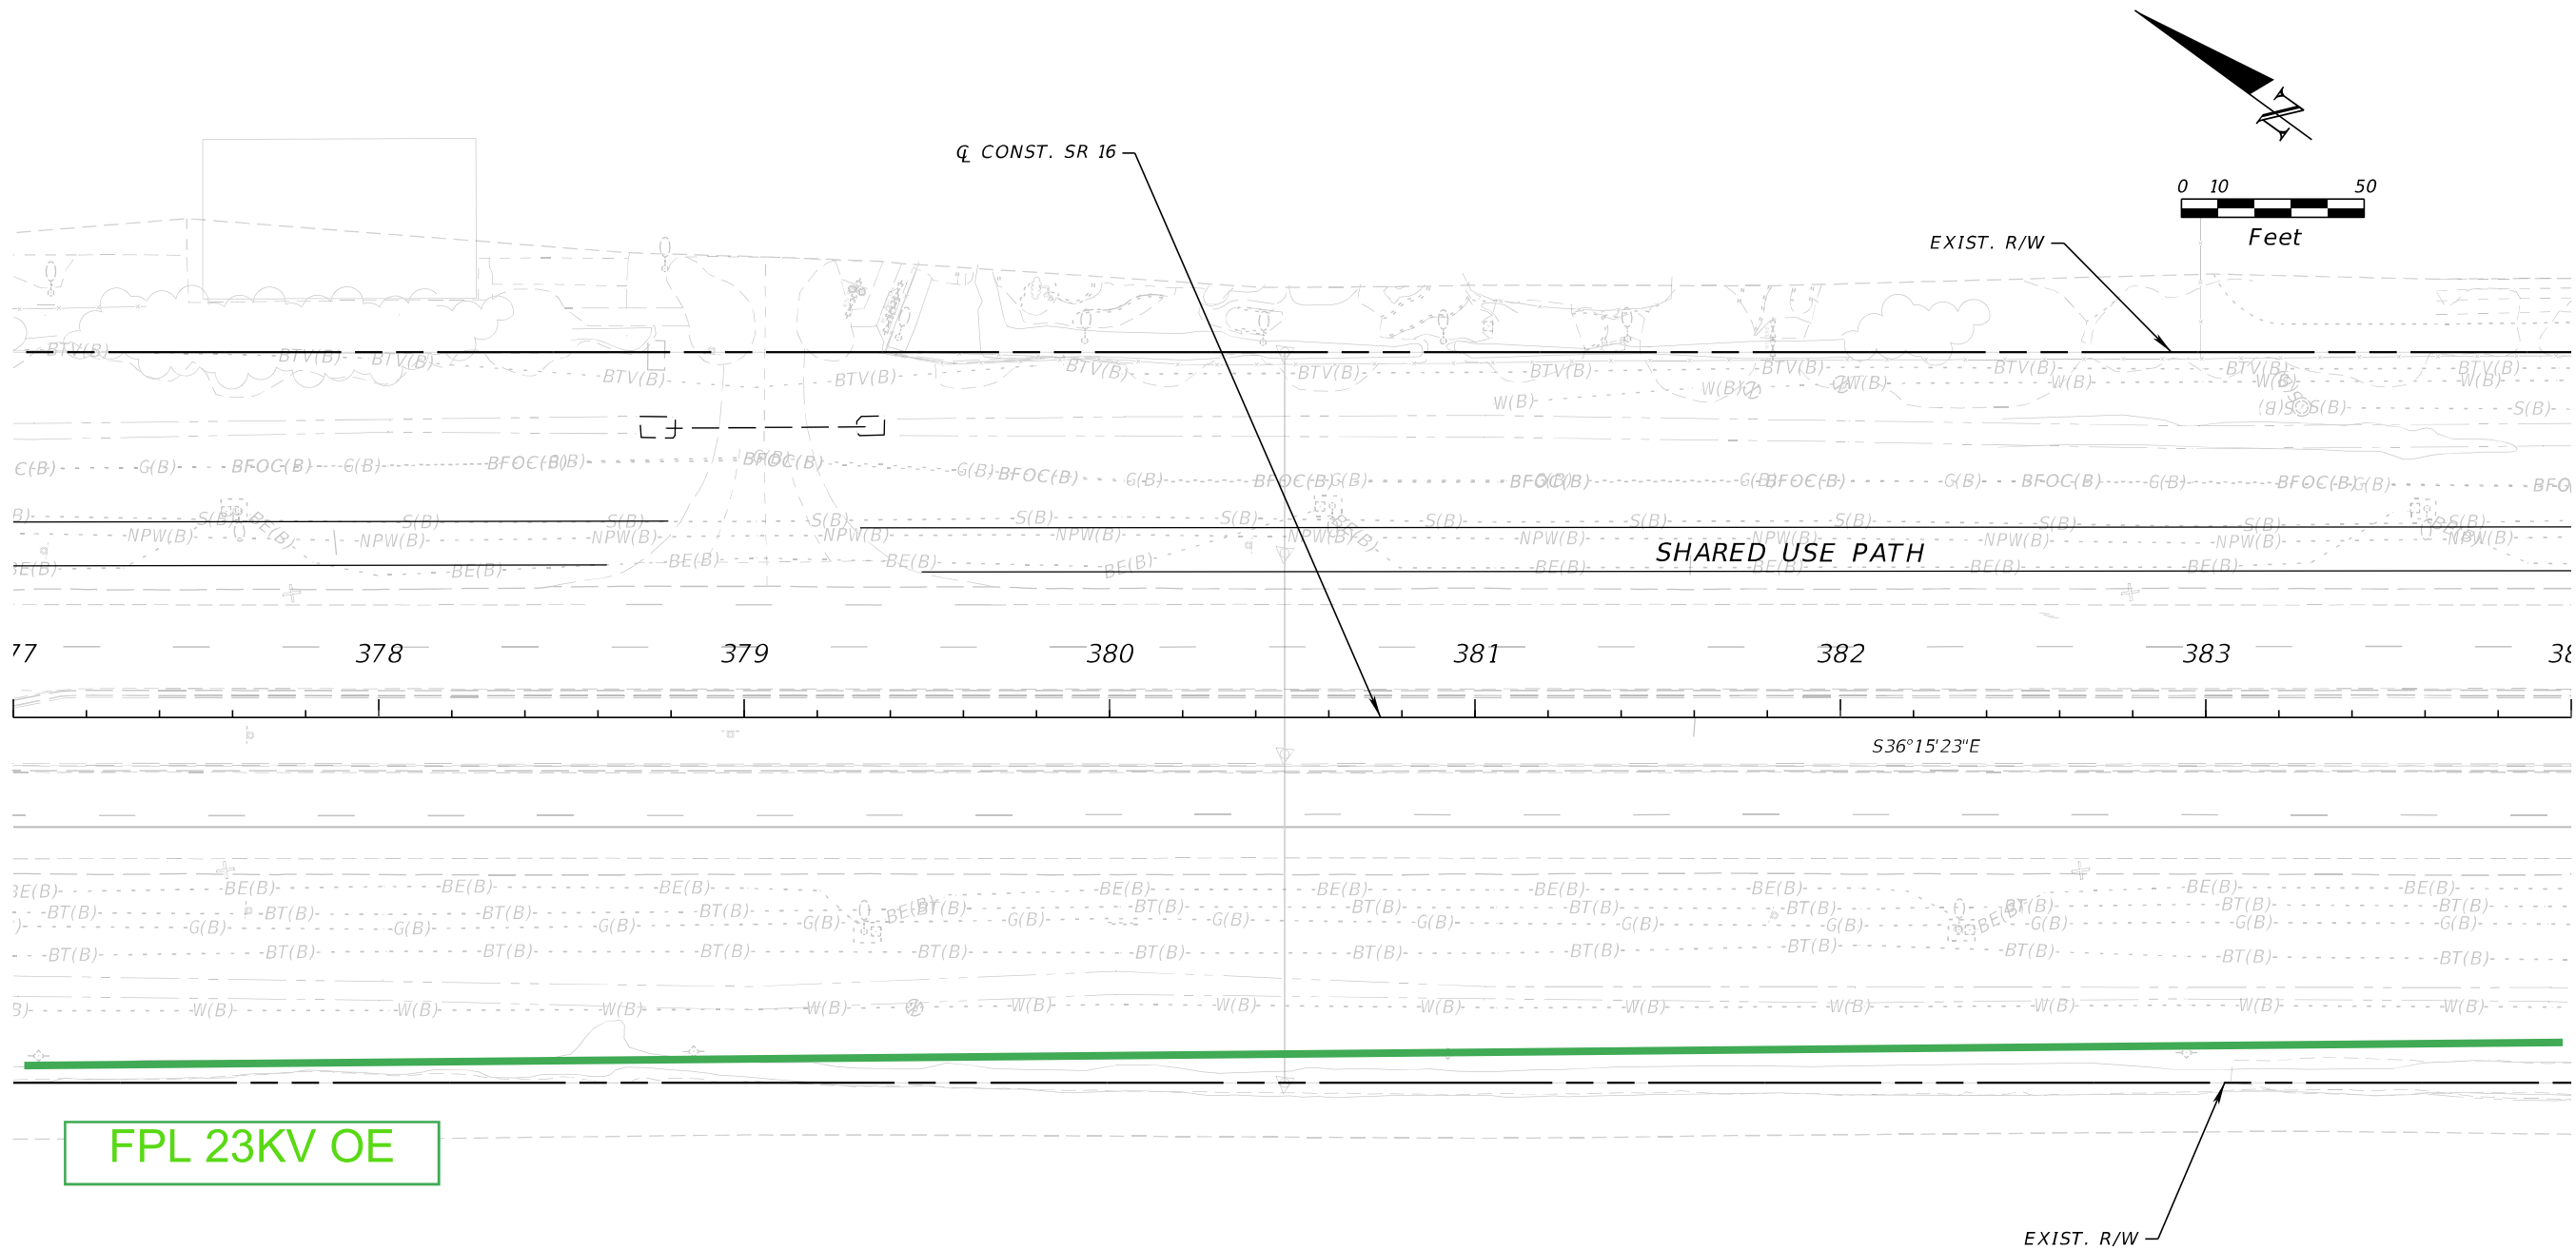

| REVISIONS | | | | ENGINEER OF RECORD | | STATE OF FLORIDA DEPARTMENT OF TRANSPORTATION | | | SHEET NO. |
|-----------|-------------|------|-------------|---|--|--|-----------|----------------------|--------------|
| DATE | DESCRIPTION | DATE | DESCRIPTION | STEPHEN J. PARK, P.E. LICENSE NUMBER: 77656 RS&H, INC. 10748 DEERWOOD PARK BLVD. SOUTH JACKSONVILLE, FL 32256 | | ROAD NO. | COUNTY | FINANCIAL PROJECT ID | |
| | | | | | | SR 16 | ST. JOHNS | 210447-5-52-01 | |

THE OFFICIAL RECORD OF THIS SHEET IS THE ELECTRONIC FILE DIGITALLY SIGNED AND SEALED UNDER RULE 61G15-23.004, F.A.C.

SHOPPES AT MILL CREEK

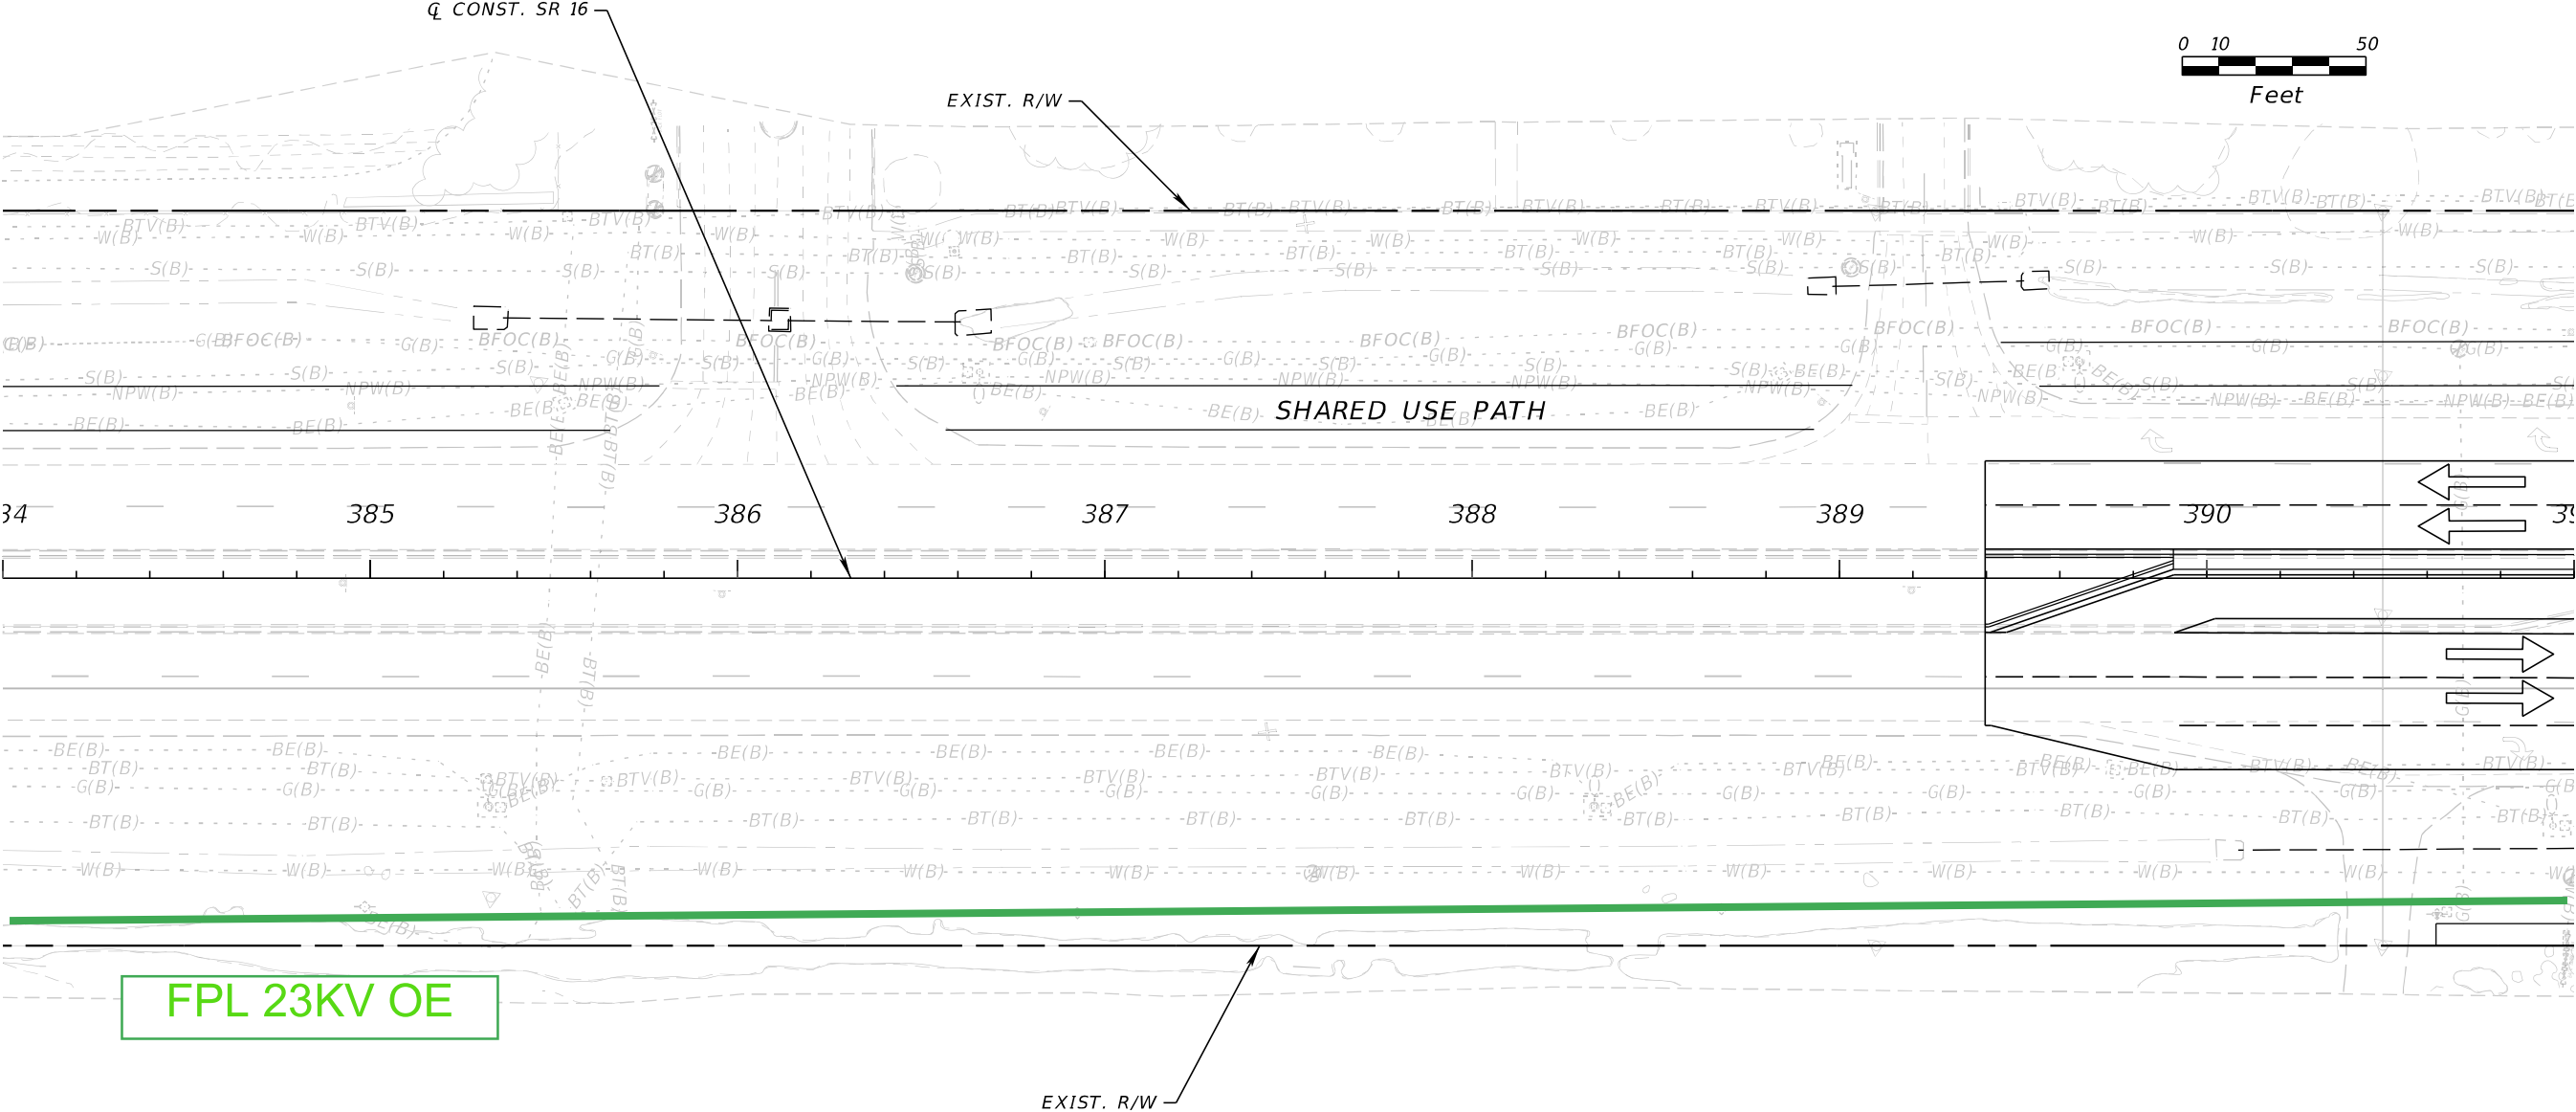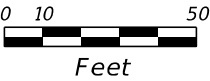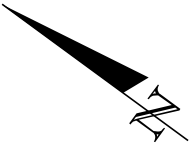

8/5/2024 4:29:04 PM BeattyM
c:\pw_work\ysh_pw\pw_user\00439575\PLANRD01.dgn



| REVISIONS | | | | ENGINEER OF RECORD | | STATE OF FLORIDA DEPARTMENT OF TRANSPORTATION | | | SHEET NO. |
|-----------|-------------|------|-------------|---|--|--|-----------|----------------------|--------------|
| DATE | DESCRIPTION | DATE | DESCRIPTION | STEPHEN J. PARK, P.E. LICENSE NUMBER: 77656 RS&H, INC. 10748 DEERWOOD PARK BLVD. SOUTH JACKSONVILLE, FL 32256 | | ROAD NO. | COUNTY | FINANCIAL PROJECT ID | |
| | | | | | | SR 16 | ST. JOHNS | 210447-5-52-01 | |

THE OFFICIAL RECORD OF THIS SHEET IS THE ELECTRONIC FILE DIGITALLY SIGNED AND SEALED UNDER RULE 61G15-23.004, F.A.C.

SONNY'S BBQ

WENDY'S

SCOTTISH INNS

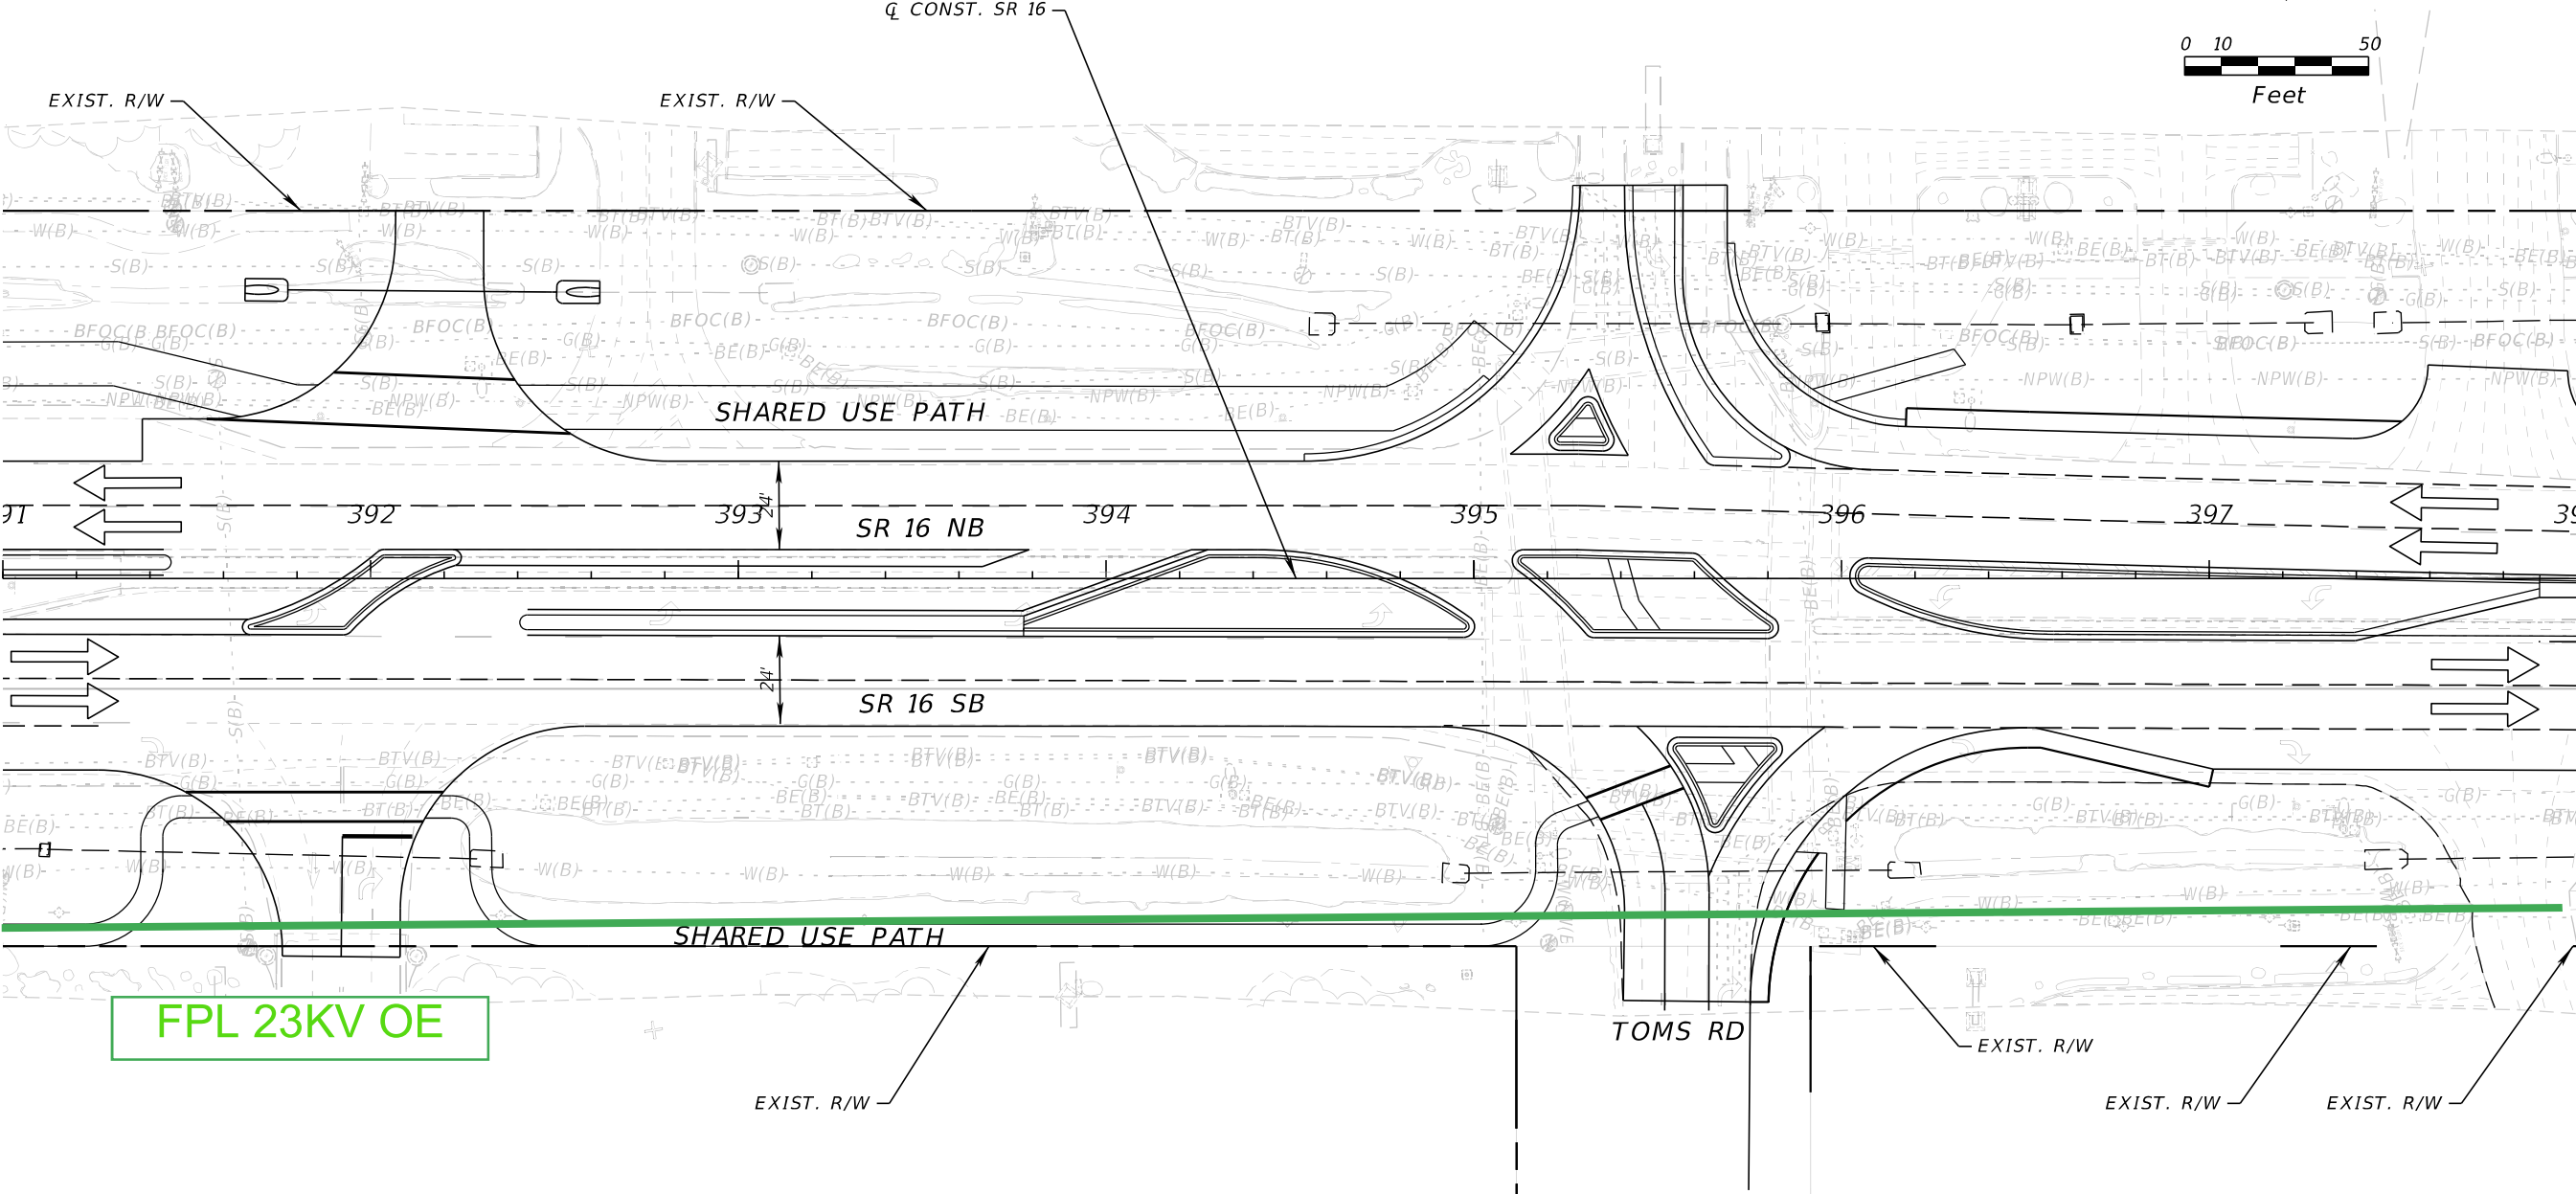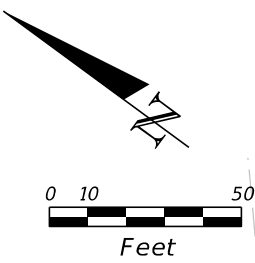



8/5/2024 4:29:04 PM BeattyM
c:\pw_work\ysh_pw\pw_user\00439575\PLANRD01.dgn

| REVISIONS | | | | ENGINEER OF RECORD | | STATE OF FLORIDA DEPARTMENT OF TRANSPORTATION | | | SHEET NO. |
|-----------|-------------|------|-------------|---|--|--|-----------|----------------------|--------------|
| DATE | DESCRIPTION | DATE | DESCRIPTION | STEPHEN J. PARK, P.E. LICENSE NUMBER: 77656 RS&H, INC. 10748 DEERWOOD PARK BLVD. SOUTH JACKSONVILLE, FL 32256 | | ROAD NO. | COUNTY | FINANCIAL PROJECT ID | |
| | | | | | | SR 16 | ST. JOHNS | 210447-5-52-01 | |

THE OFFICIAL RECORD OF THIS SHEET IS THE ELECTRONIC FILE DIGITALLY SIGNED AND SEALED UNDER RULE 61G15-23.004, F.A.C.

DAYS INN

IHOP

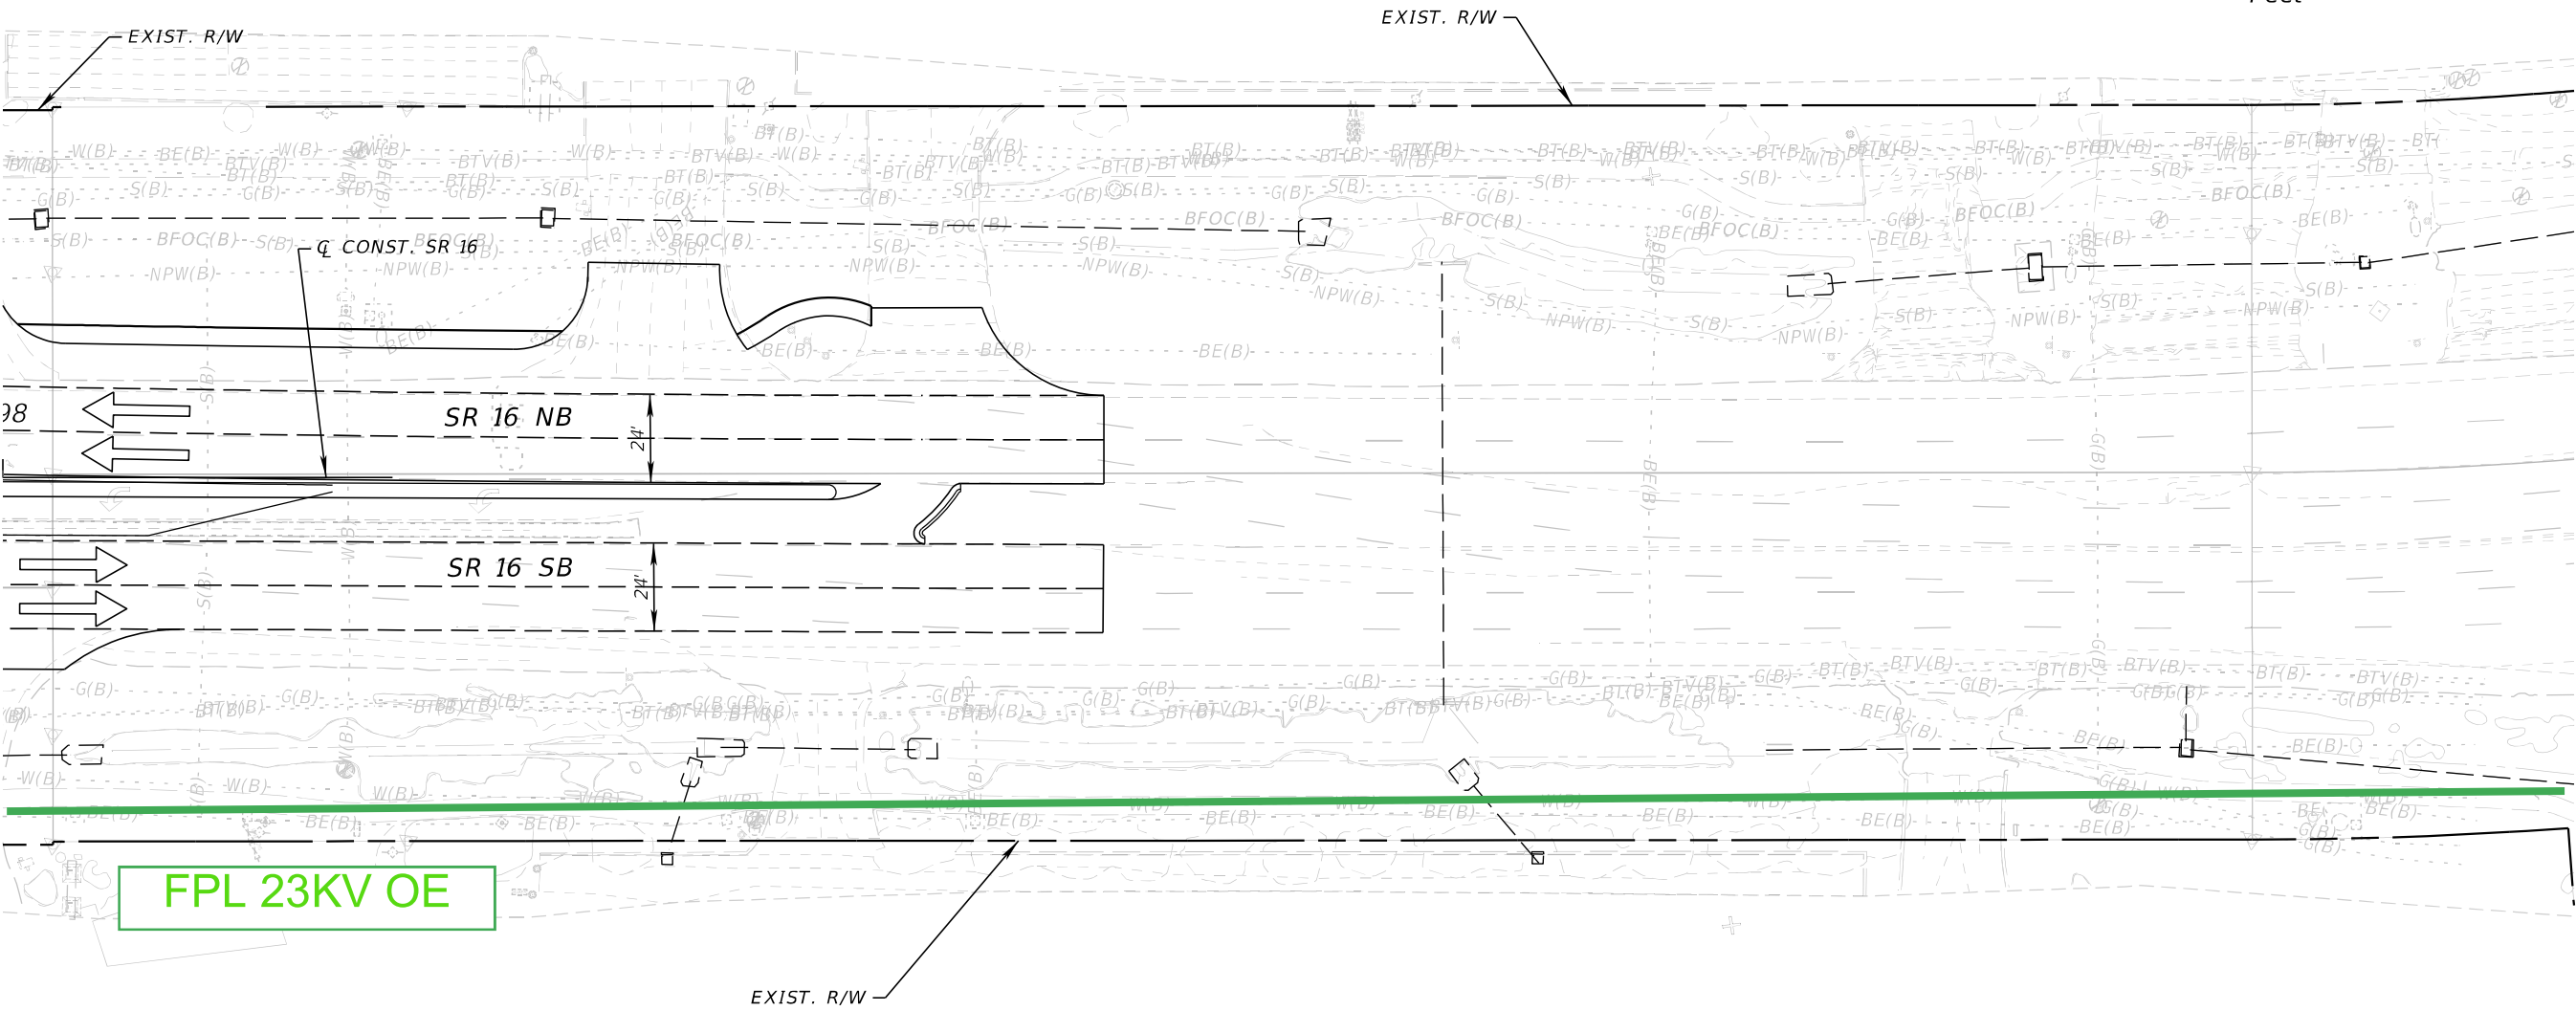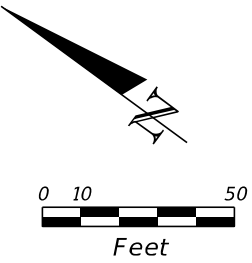

8/5/2024 4:29:05 PM BeattyM
c:\pw_work\ysh_pw\pw_user\0439575\PLANRD01.dgn


| REVISIONS | | | | ENGINEER OF RECORD | STATE OF FLORIDA DEPARTMENT OF TRANSPORTATION | | | SHEET NO. |
|-----------|-------------|------|-------------|---|--|-----------|----------------------|--------------|
| DATE | DESCRIPTION | DATE | DESCRIPTION | STEPHEN J. PARK, P.E. LICENSE NUMBER: 77656 RS&H, INC. 10748 DEERWOOD PARK BLVD. SOUTH JACKSONVILLE, FL 32256 | ROAD NO. | COUNTY | FINANCIAL PROJECT ID | |
| | | | | | SR 16 | ST. JOHNS | 210447-5-52-01 | |
| | | | | | SR 16 - PLAN - 44 | | | |

THE OFFICIAL RECORD OF THIS SHEET IS THE ELECTRONIC FILE DIGITALLY SIGNED AND SEALED UNDER RULE 61G15-23.004, F.A.C.

Florida Power & Light Transmission Forms and Figures




8/5/2024 4:28:46 PM BeattyM
c:\pw_work\ysh_pw\pw_user\0439575\PLANRD01.dgn

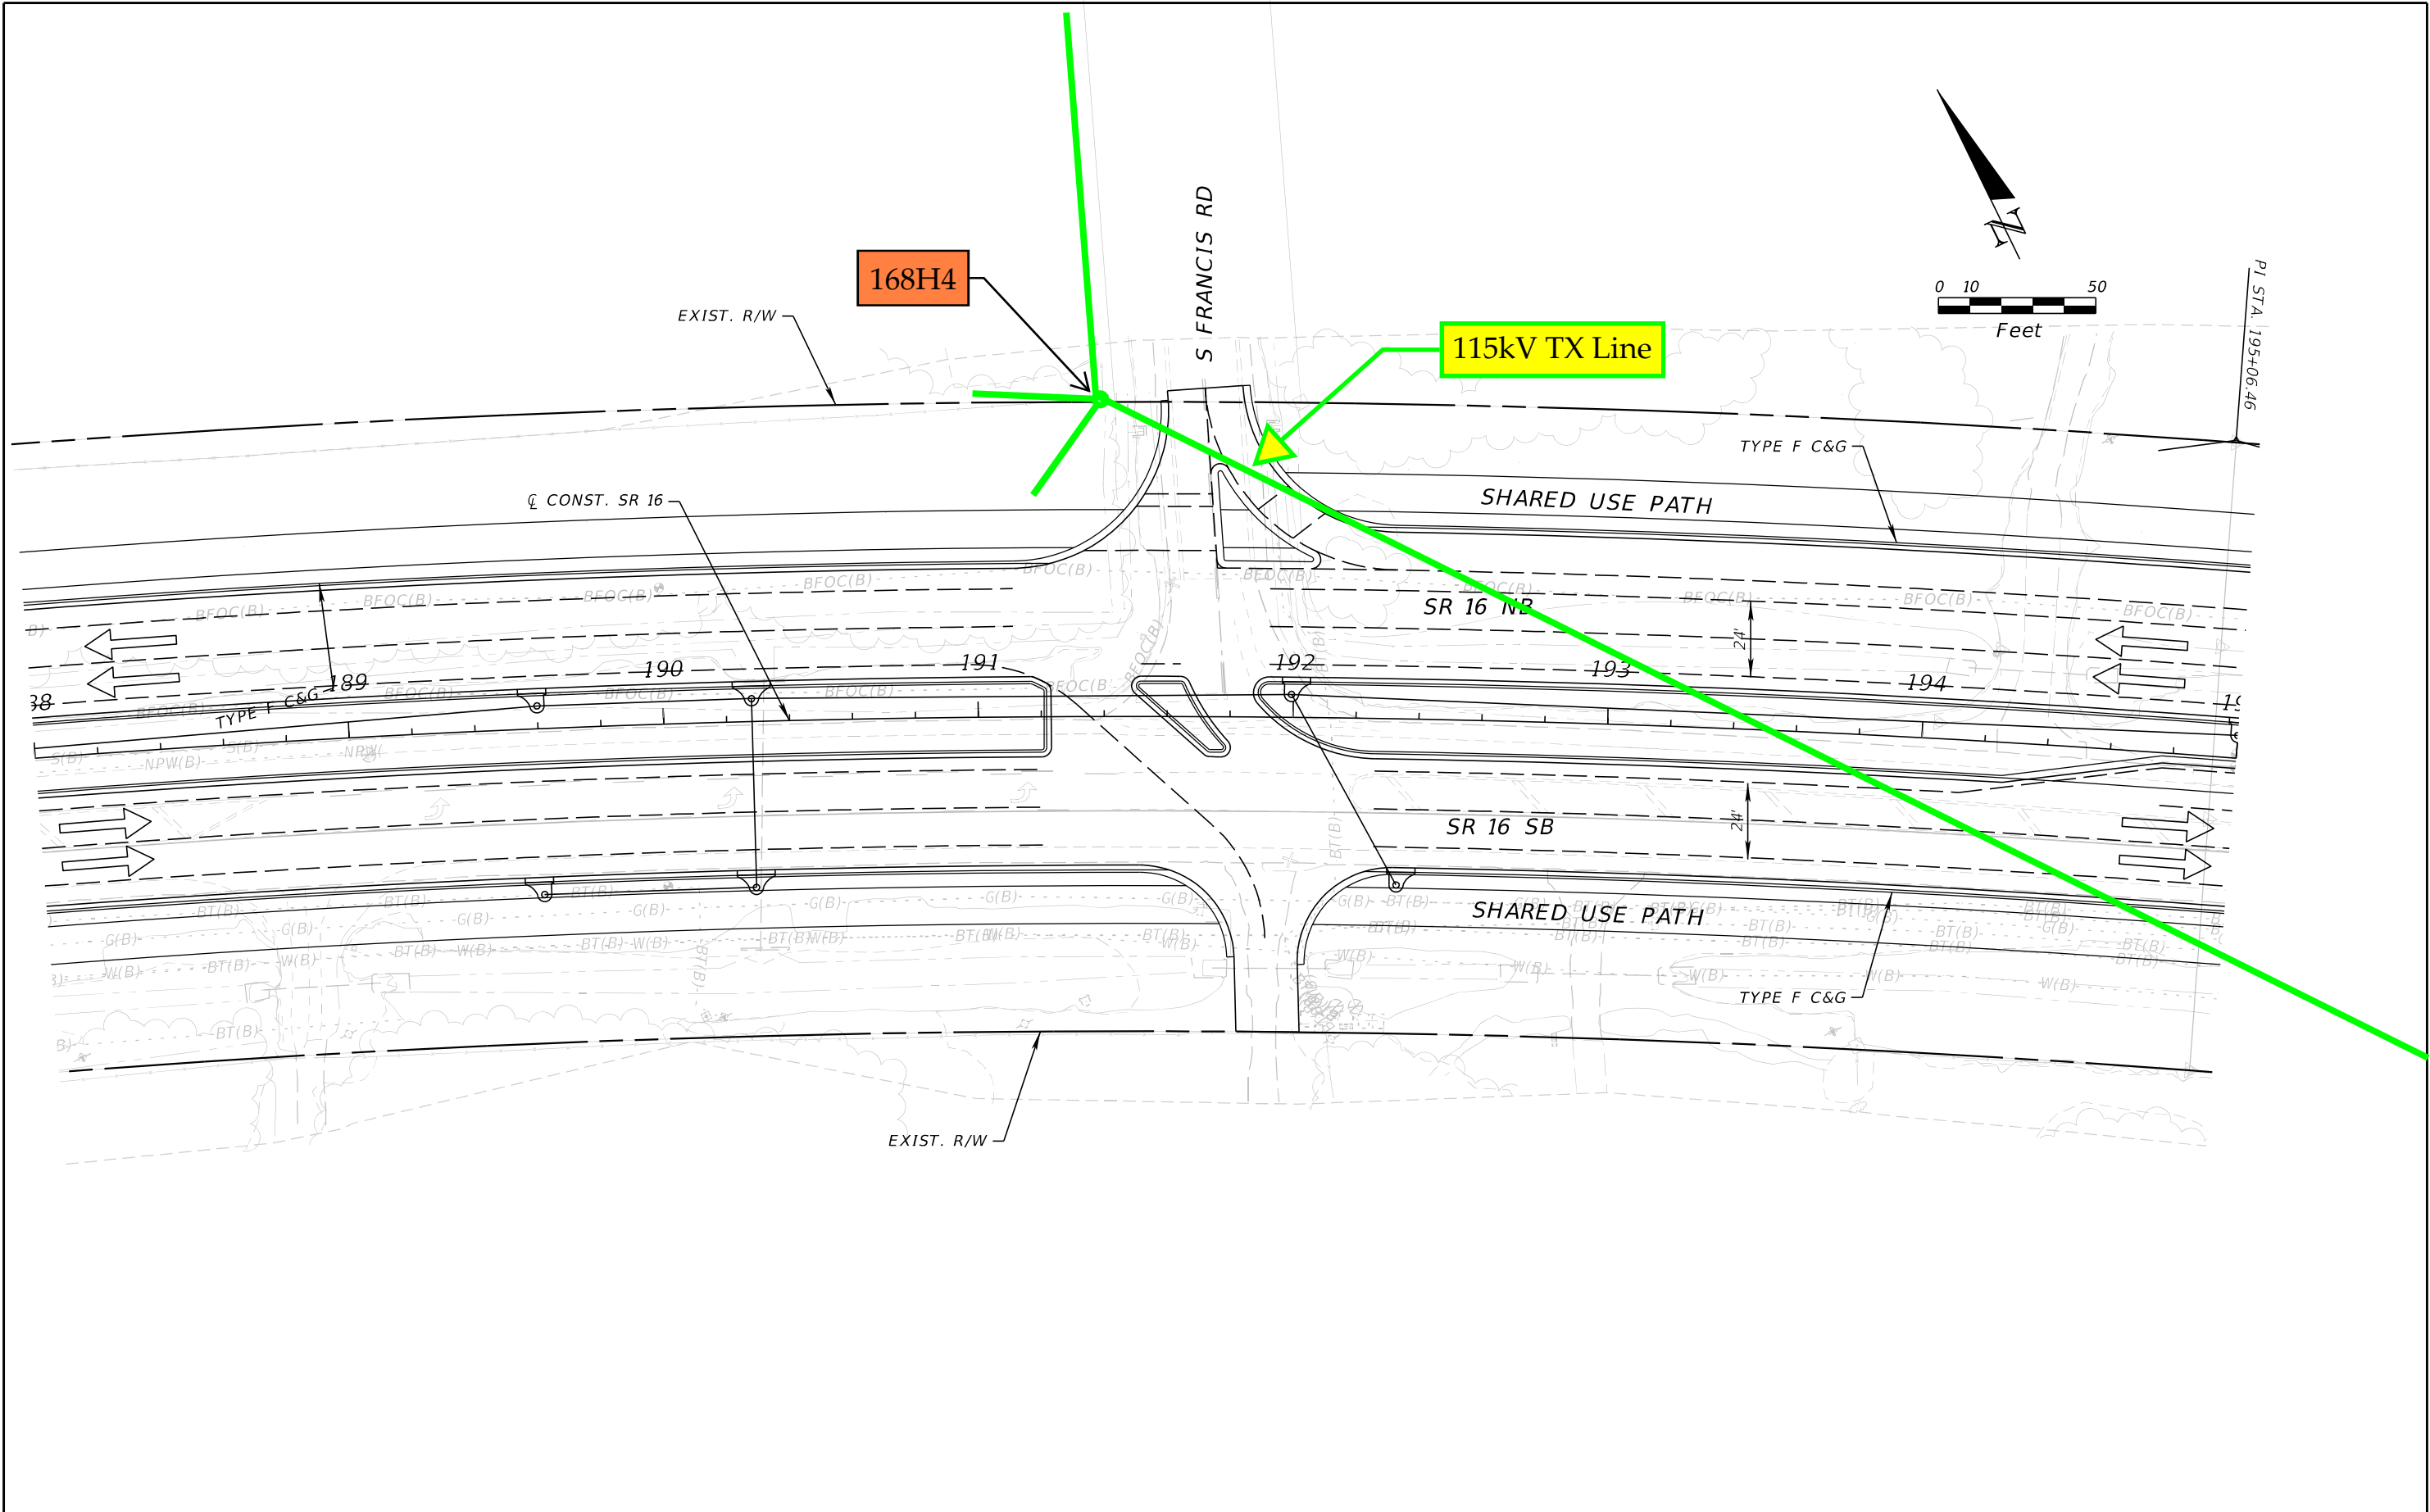

| REVISIONS | | | | ENGINEER OF RECORD | STATE OF FLORIDA DEPARTMENT OF TRANSPORTATION | | | SHEET NO. |
|-----------|-------------|------|-------------|---|--|-----------|----------------------|-----------------------|
| DATE | DESCRIPTION | DATE | DESCRIPTION | STEPHEN J. PARK, P.E. LICENSE NUMBER: 77656 RS&H, INC. 10748 DEERWOOD PARK BLVD. SOUTH JACKSONVILLE, FL 32256 | ROAD NO. | COUNTY | FINANCIAL PROJECT ID | |
| | | | | | SR 16 | ST. JOHNS | 210447-5-52-01 | |
| | | | | | | | | 11x17 Plan Only |

THE OFFICIAL RECORD OF THIS SHEET IS THE ELECTRONIC FILE DIGITALLY SIGNED AND SEALED UNDER RULE 61G15-23.004, F.A.C.

8/5/2024 4:28:47 PM BeattyM
c:\pw_work\ysh_pw\pw_user\00439575\PLANRD01.dgn

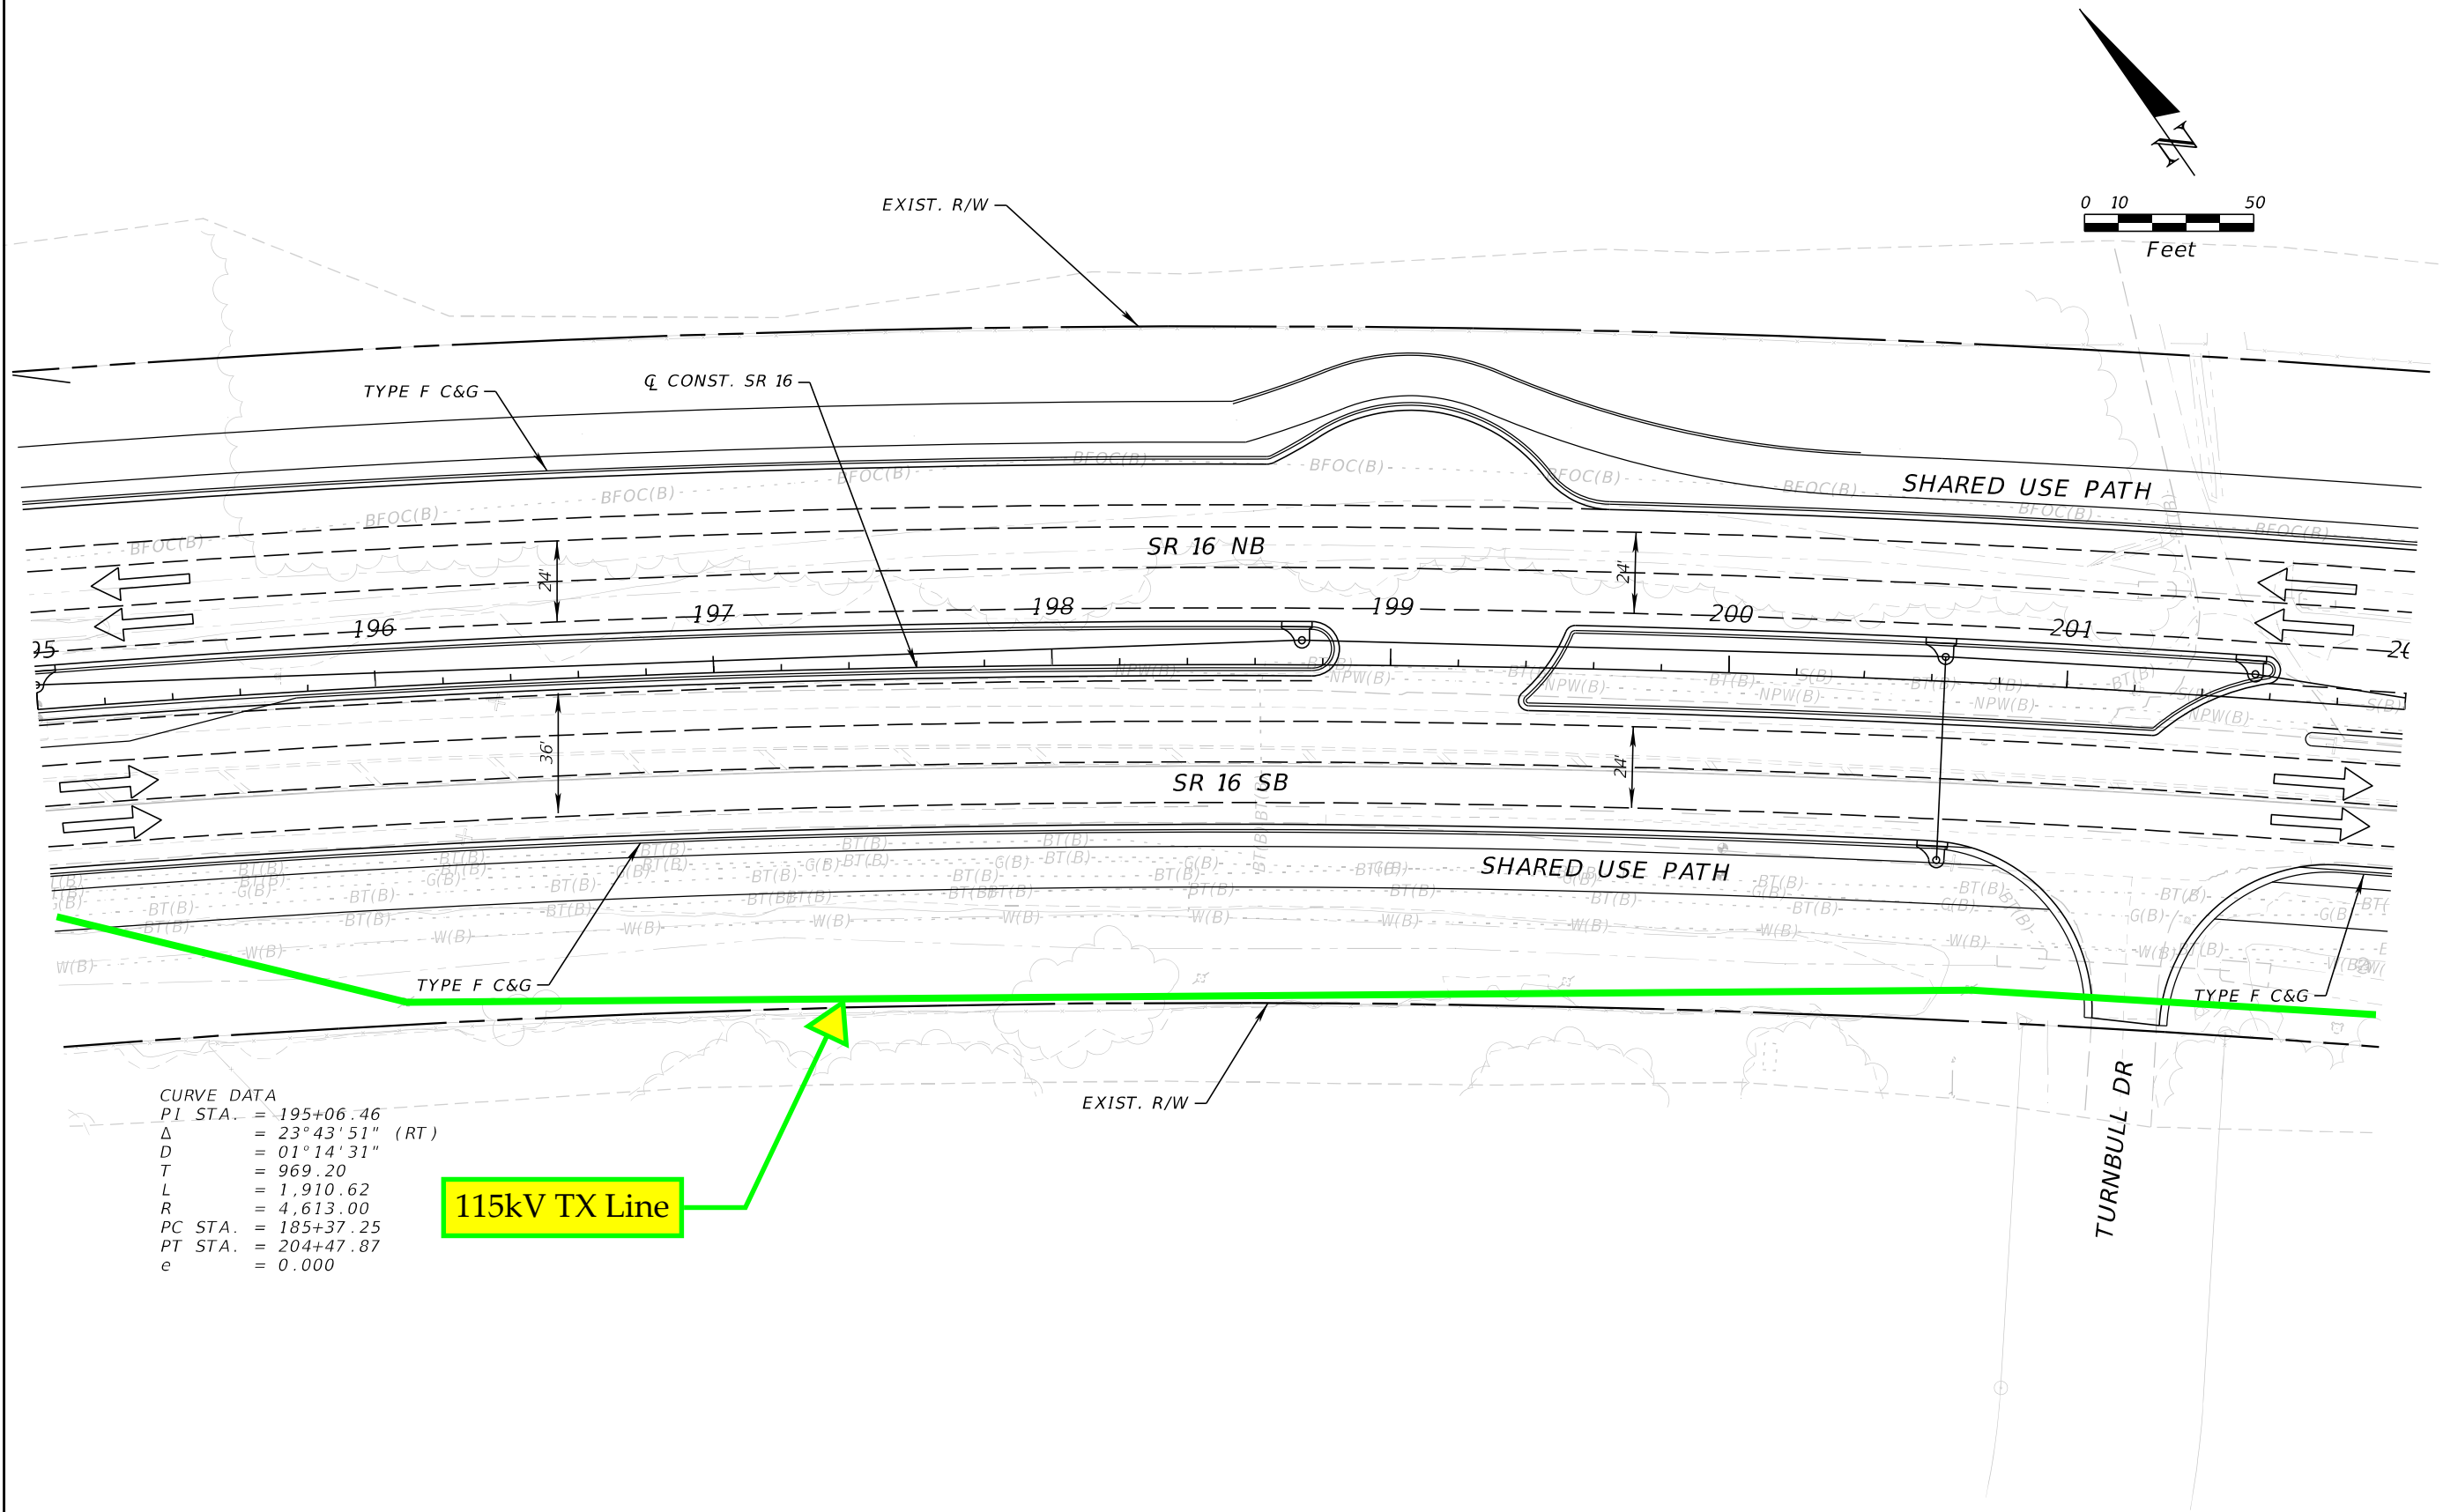


CURVE DATA
PI STA. = 195+06.46
Δ = 23°43'51" (RT)
D = 01°14'31"
T = 969.20
L = 1,910.62
R = 4,613.00
PC STA. = 185+37.25
PT STA. = 204+47.87
e = 0.000

115kV TX Line

| REVISIONS | | | | ENGINEER OF RECORD | | STATE OF FLORIDA DEPARTMENT OF TRANSPORTATION | | | SHEET NO. |
|-----------|-------------|------|-------------|---|--|--|-----------|----------------------|--------------|
| DATE | DESCRIPTION | DATE | DESCRIPTION | STEPHEN J. PARK, P.E. LICENSE NUMBER: 77656 RS&H, INC. 10748 DEERWOOD PARK BLVD. SOUTH JACKSONVILLE, FL 32256 | | ROAD NO. | COUNTY | FINANCIAL PROJECT ID | |
| | | | | | | SR 16 | ST. JOHNS | 210447-5-52-01 | |

THE OFFICIAL RECORD OF THIS SHEET IS THE ELECTRONIC FILE DIGITALLY SIGNED AND SEALED UNDER RULE 61G15-23.004, F.A.C.


8/5/2024 4:28:48 PM BeattyM
c:\pw_work\ysh_pw\pw_user\0439575\PLANRD01.dgn

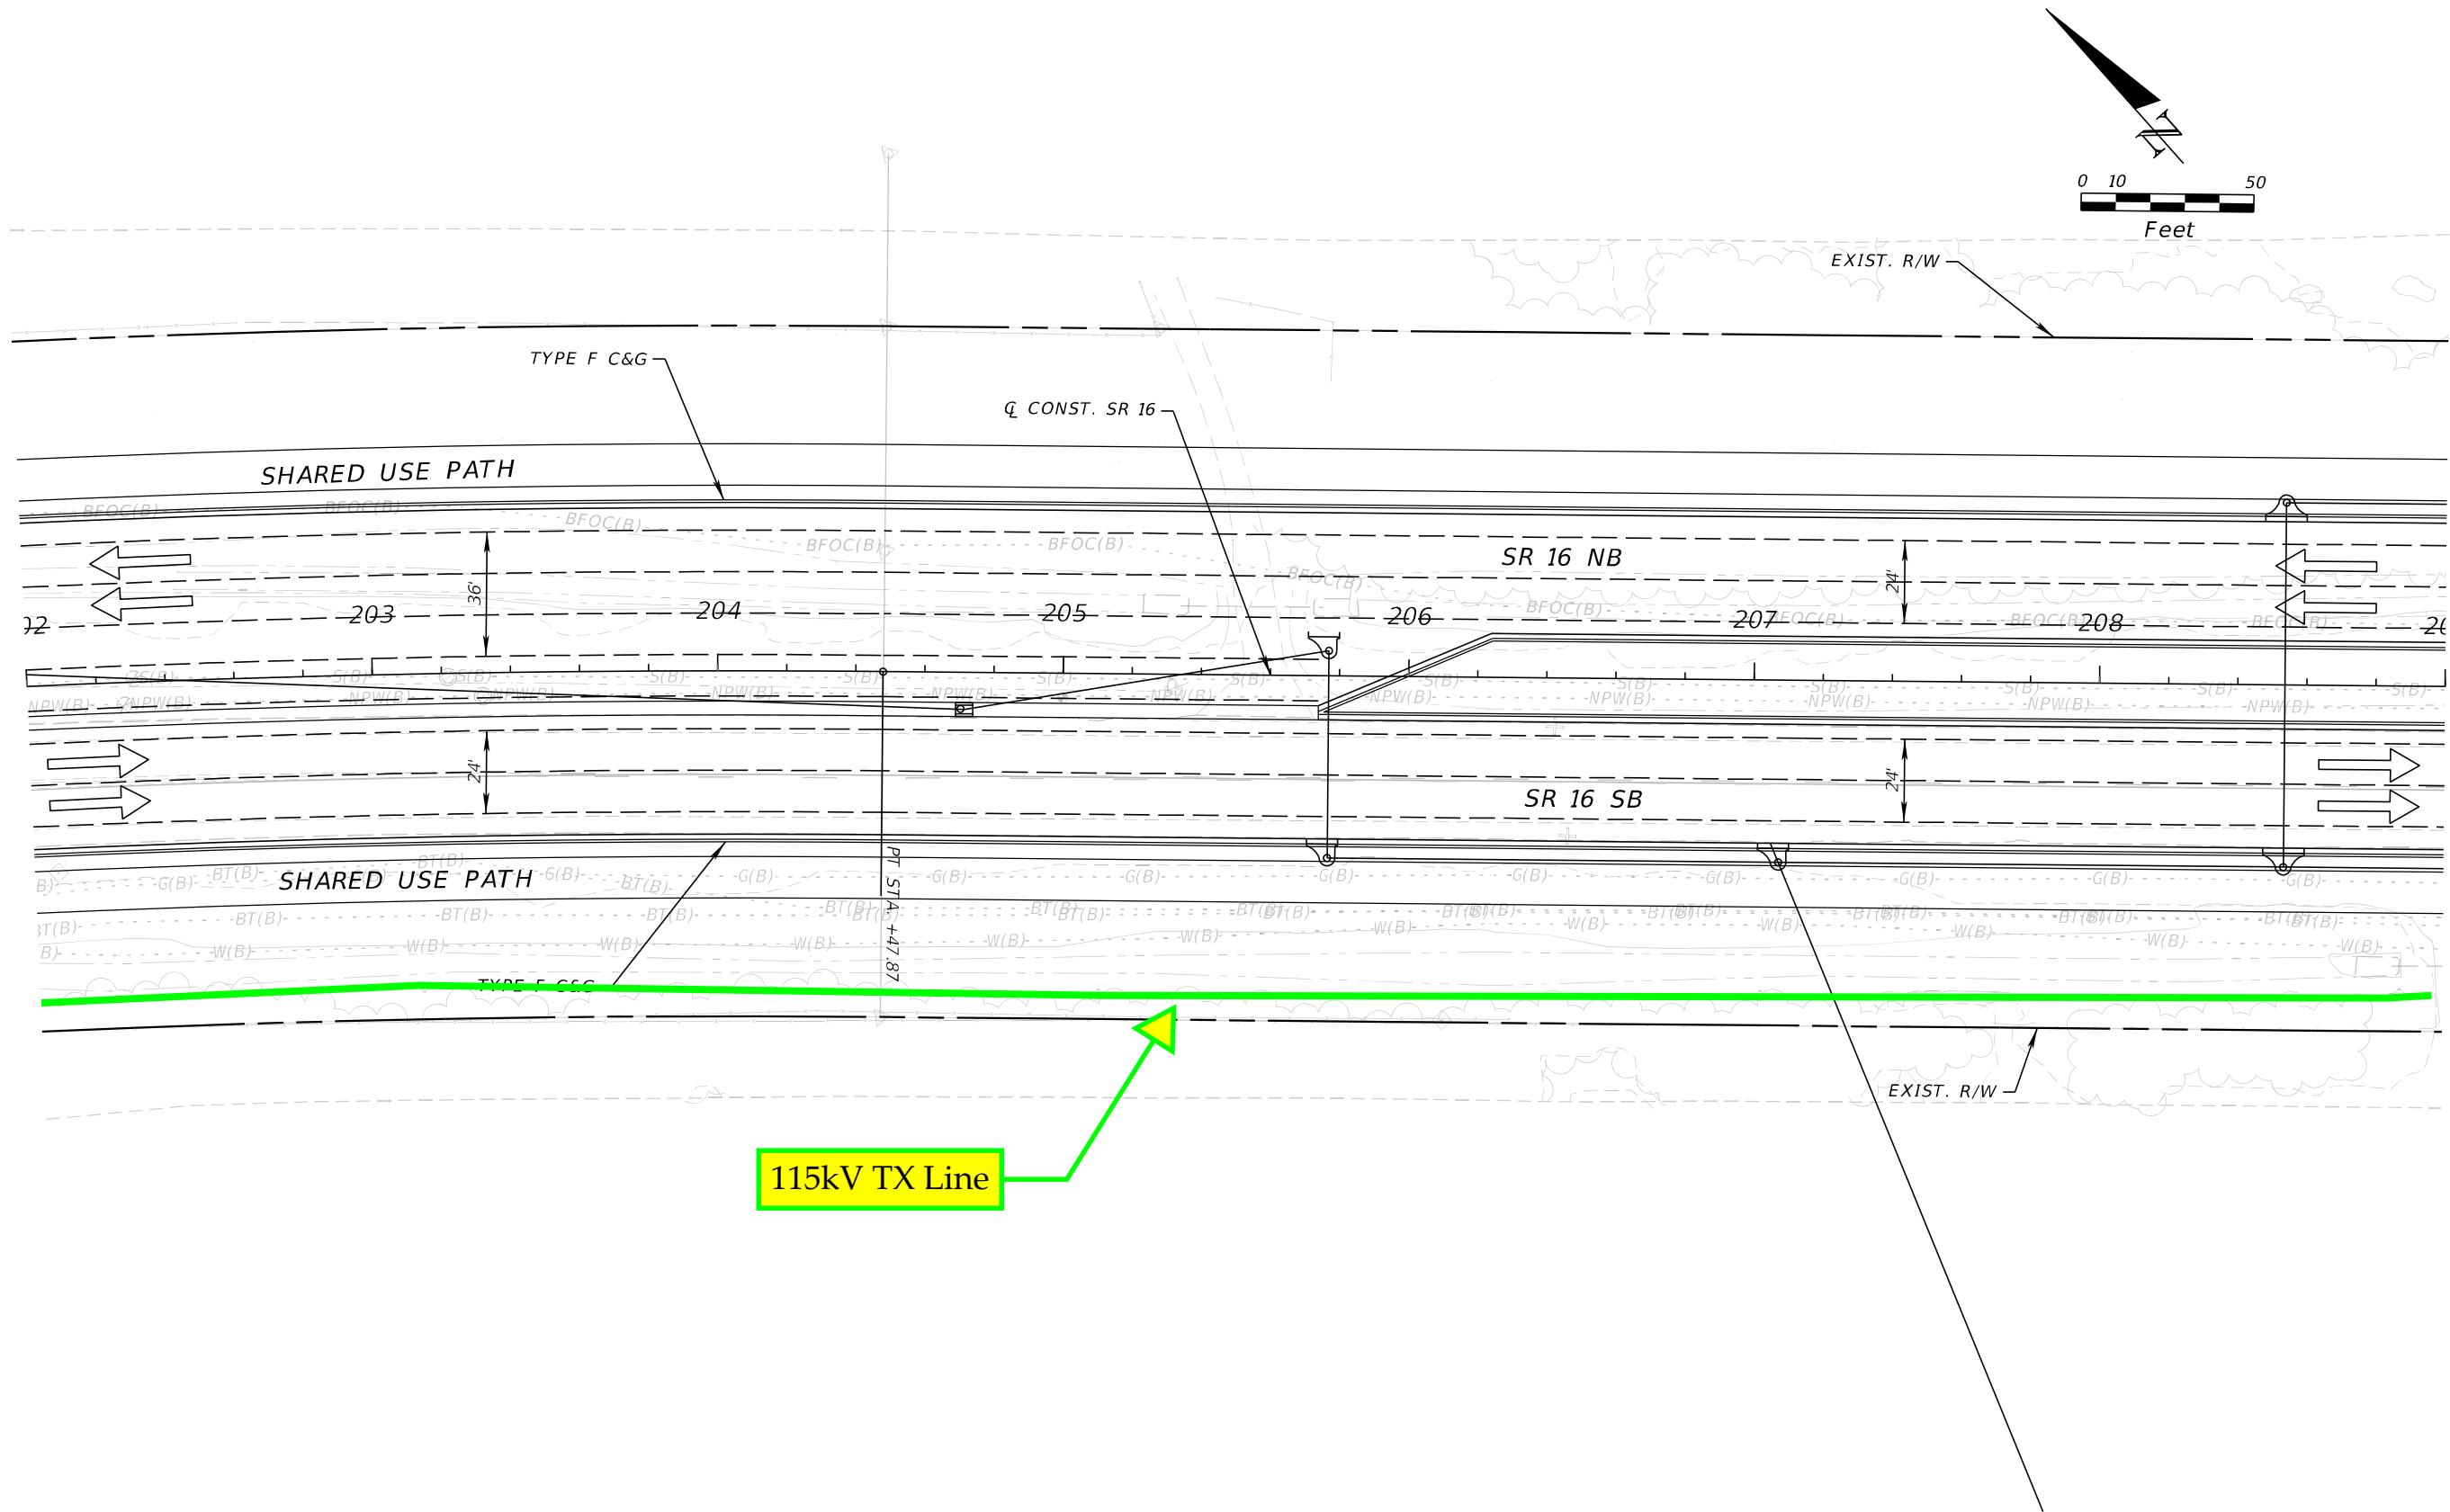

| REVISIONS | | | | ENGINEER OF RECORD | STATE OF FLORIDA DEPARTMENT OF TRANSPORTATION | | | SHEET NO. |
|-----------|-------------|------|-------------|---|--|-----------|----------------------|-----------------------|
| DATE | DESCRIPTION | DATE | DESCRIPTION | STEPHEN J. PARK, P.E. LICENSE NUMBER: 77656 RS&H, INC. 10748 DEERWOOD PARK BLVD. SOUTH JACKSONVILLE, FL 32256 | ROAD NO. | COUNTY | FINANCIAL PROJECT ID | |
| | | | | | SR 16 | ST. JOHNS | 210447-5-52-01 | |
| | | | | | | | | 11x17 Plan Only |

THE OFFICIAL RECORD OF THIS SHEET IS THE ELECTRONIC FILE DIGITALLY SIGNED AND SEALED UNDER RULE 61G15-23.004, F.A.C.


8/5/2024 4:28:48 PM BeattyM
c:\pw_work\ysh_pw\pw_user\0439575\PLANRD01.dgn

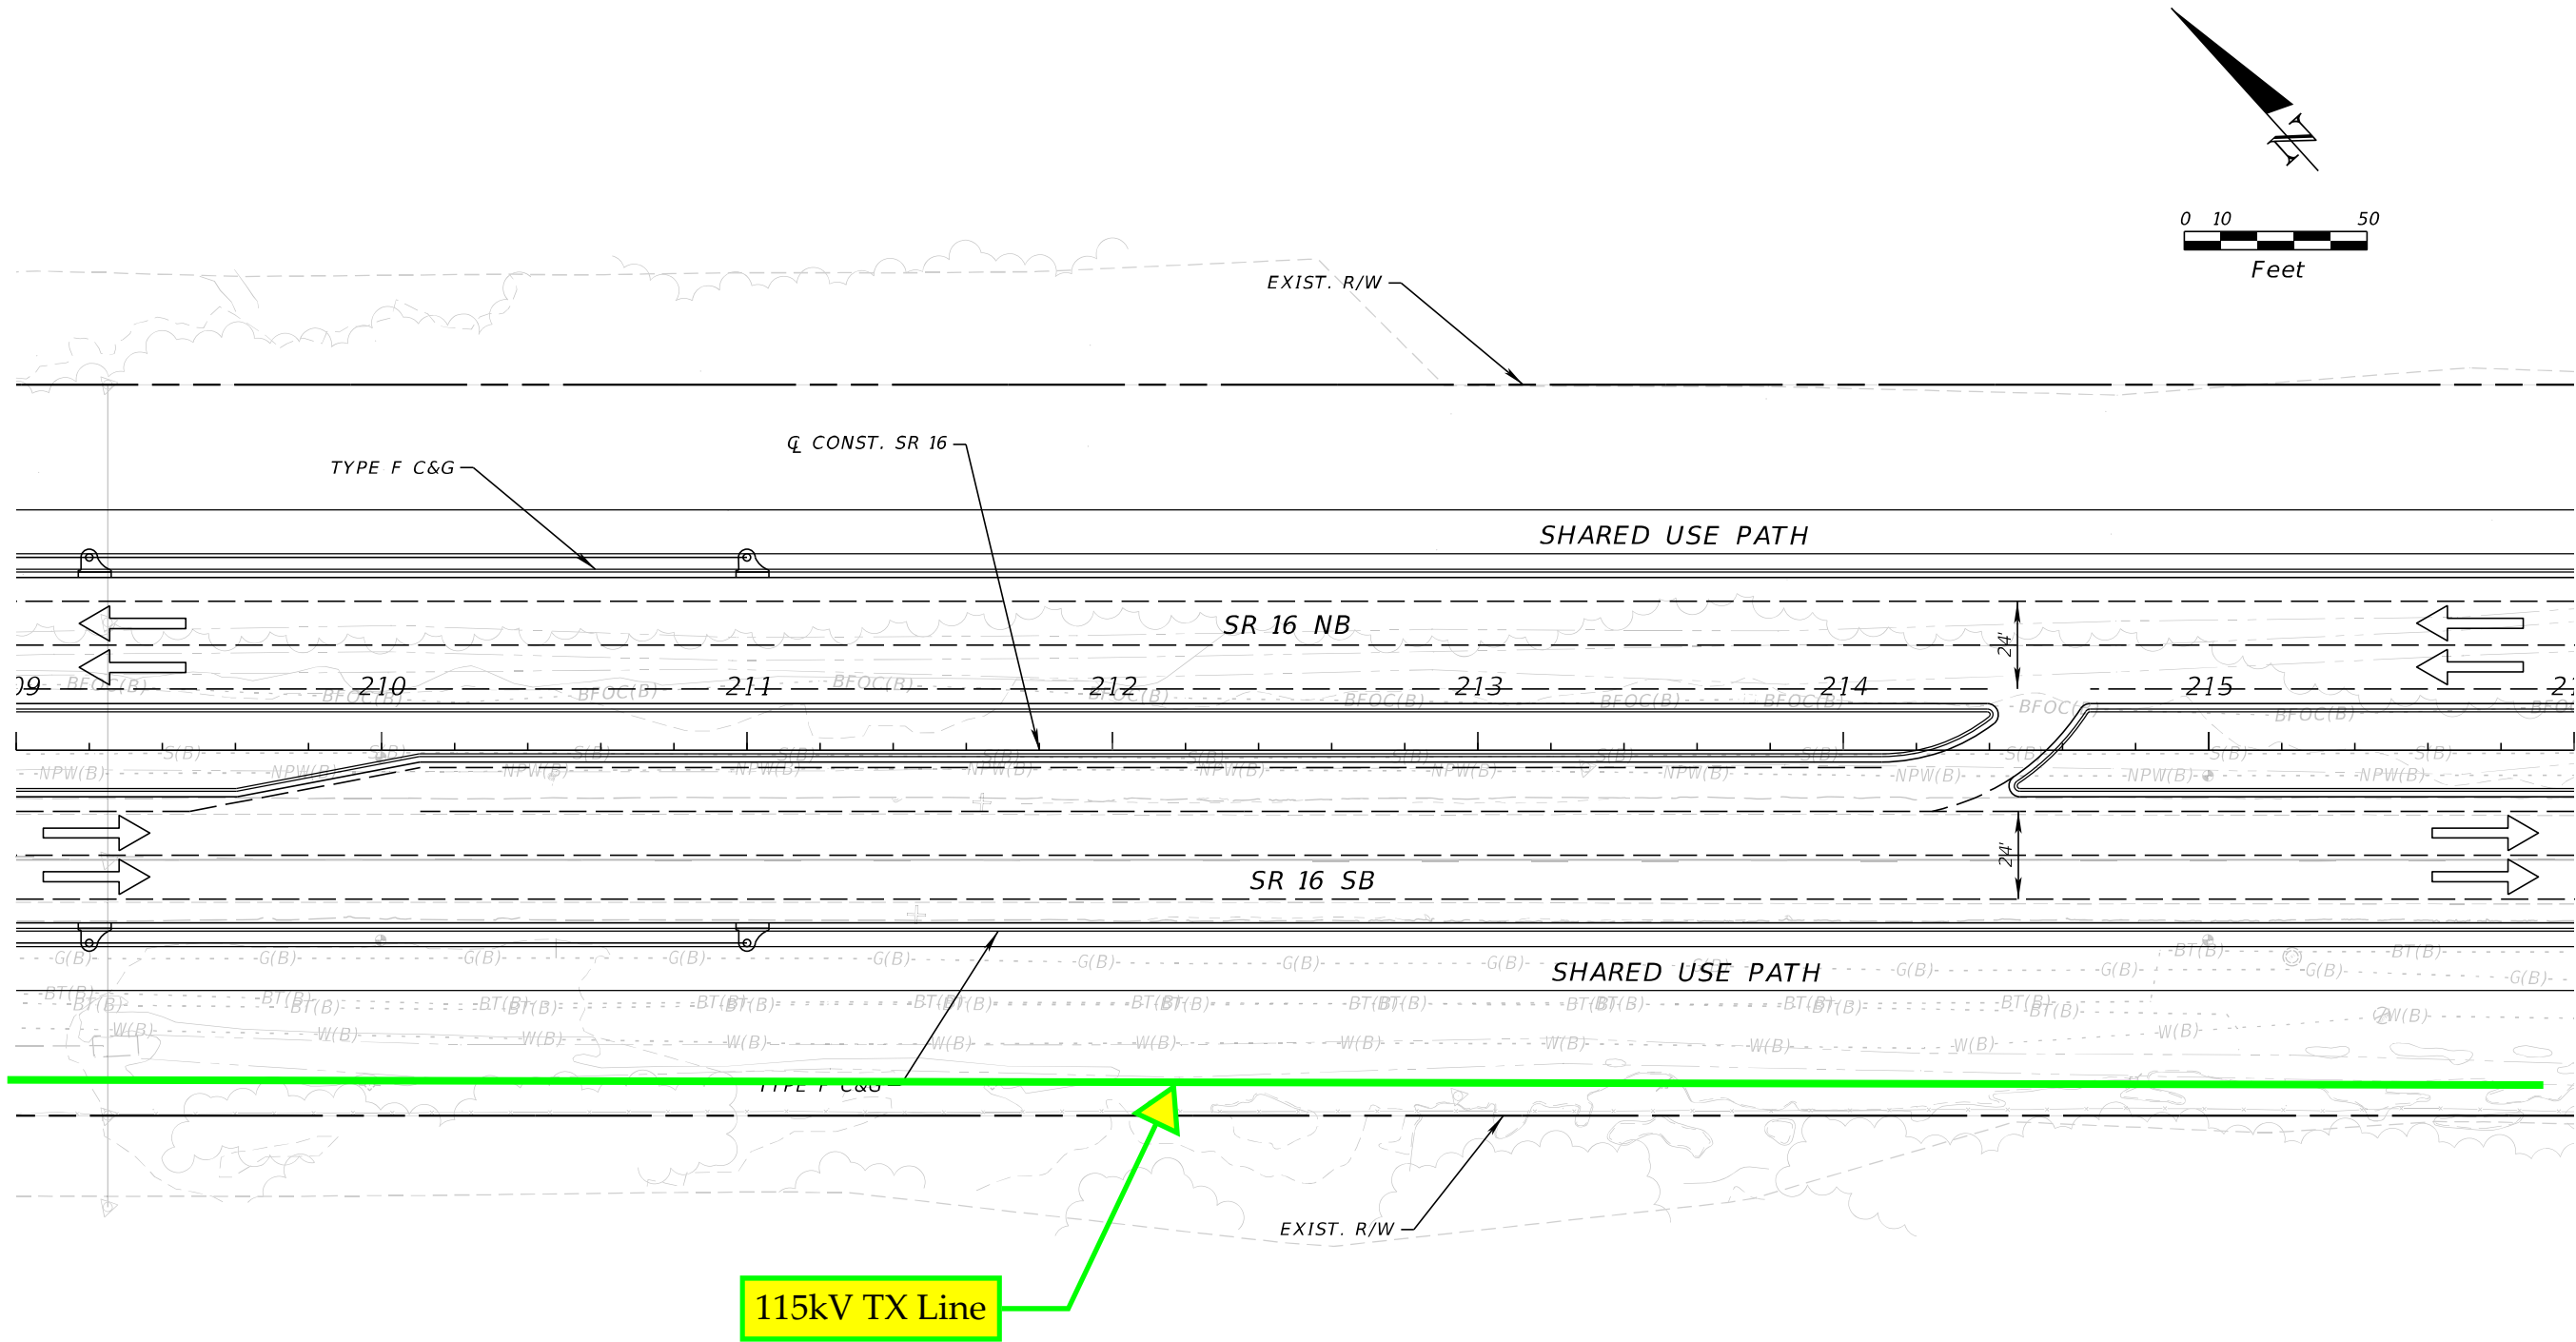

| REVISIONS | | | | ENGINEER OF RECORD | | STATE OF FLORIDA DEPARTMENT OF TRANSPORTATION | | | SHEET NO. |
|-----------|-------------|------|-------------|---|--|--|-----------|----------------------|--------------|
| DATE | DESCRIPTION | DATE | DESCRIPTION | STEPHEN J. PARK, P.E. LICENSE NUMBER: 77656 RS&H, INC. 10748 DEERWOOD PARK BLVD. SOUTH JACKSONVILLE, FL 32256 | | ROAD NO. | COUNTY | FINANCIAL PROJECT ID | |
| | | | | | | SR 16 | ST. JOHNS | 210447-5-52-01 | |

THE OFFICIAL RECORD OF THIS SHEET IS THE ELECTRONIC FILE DIGITALLY SIGNED AND SEALED UNDER RULE 61G15-23.004, F.A.C.


8/5/2024 4:28:49 PM BeattyM
c:\pw_work\sh_pw\pw_user\00439575\PLANRD01.dgn

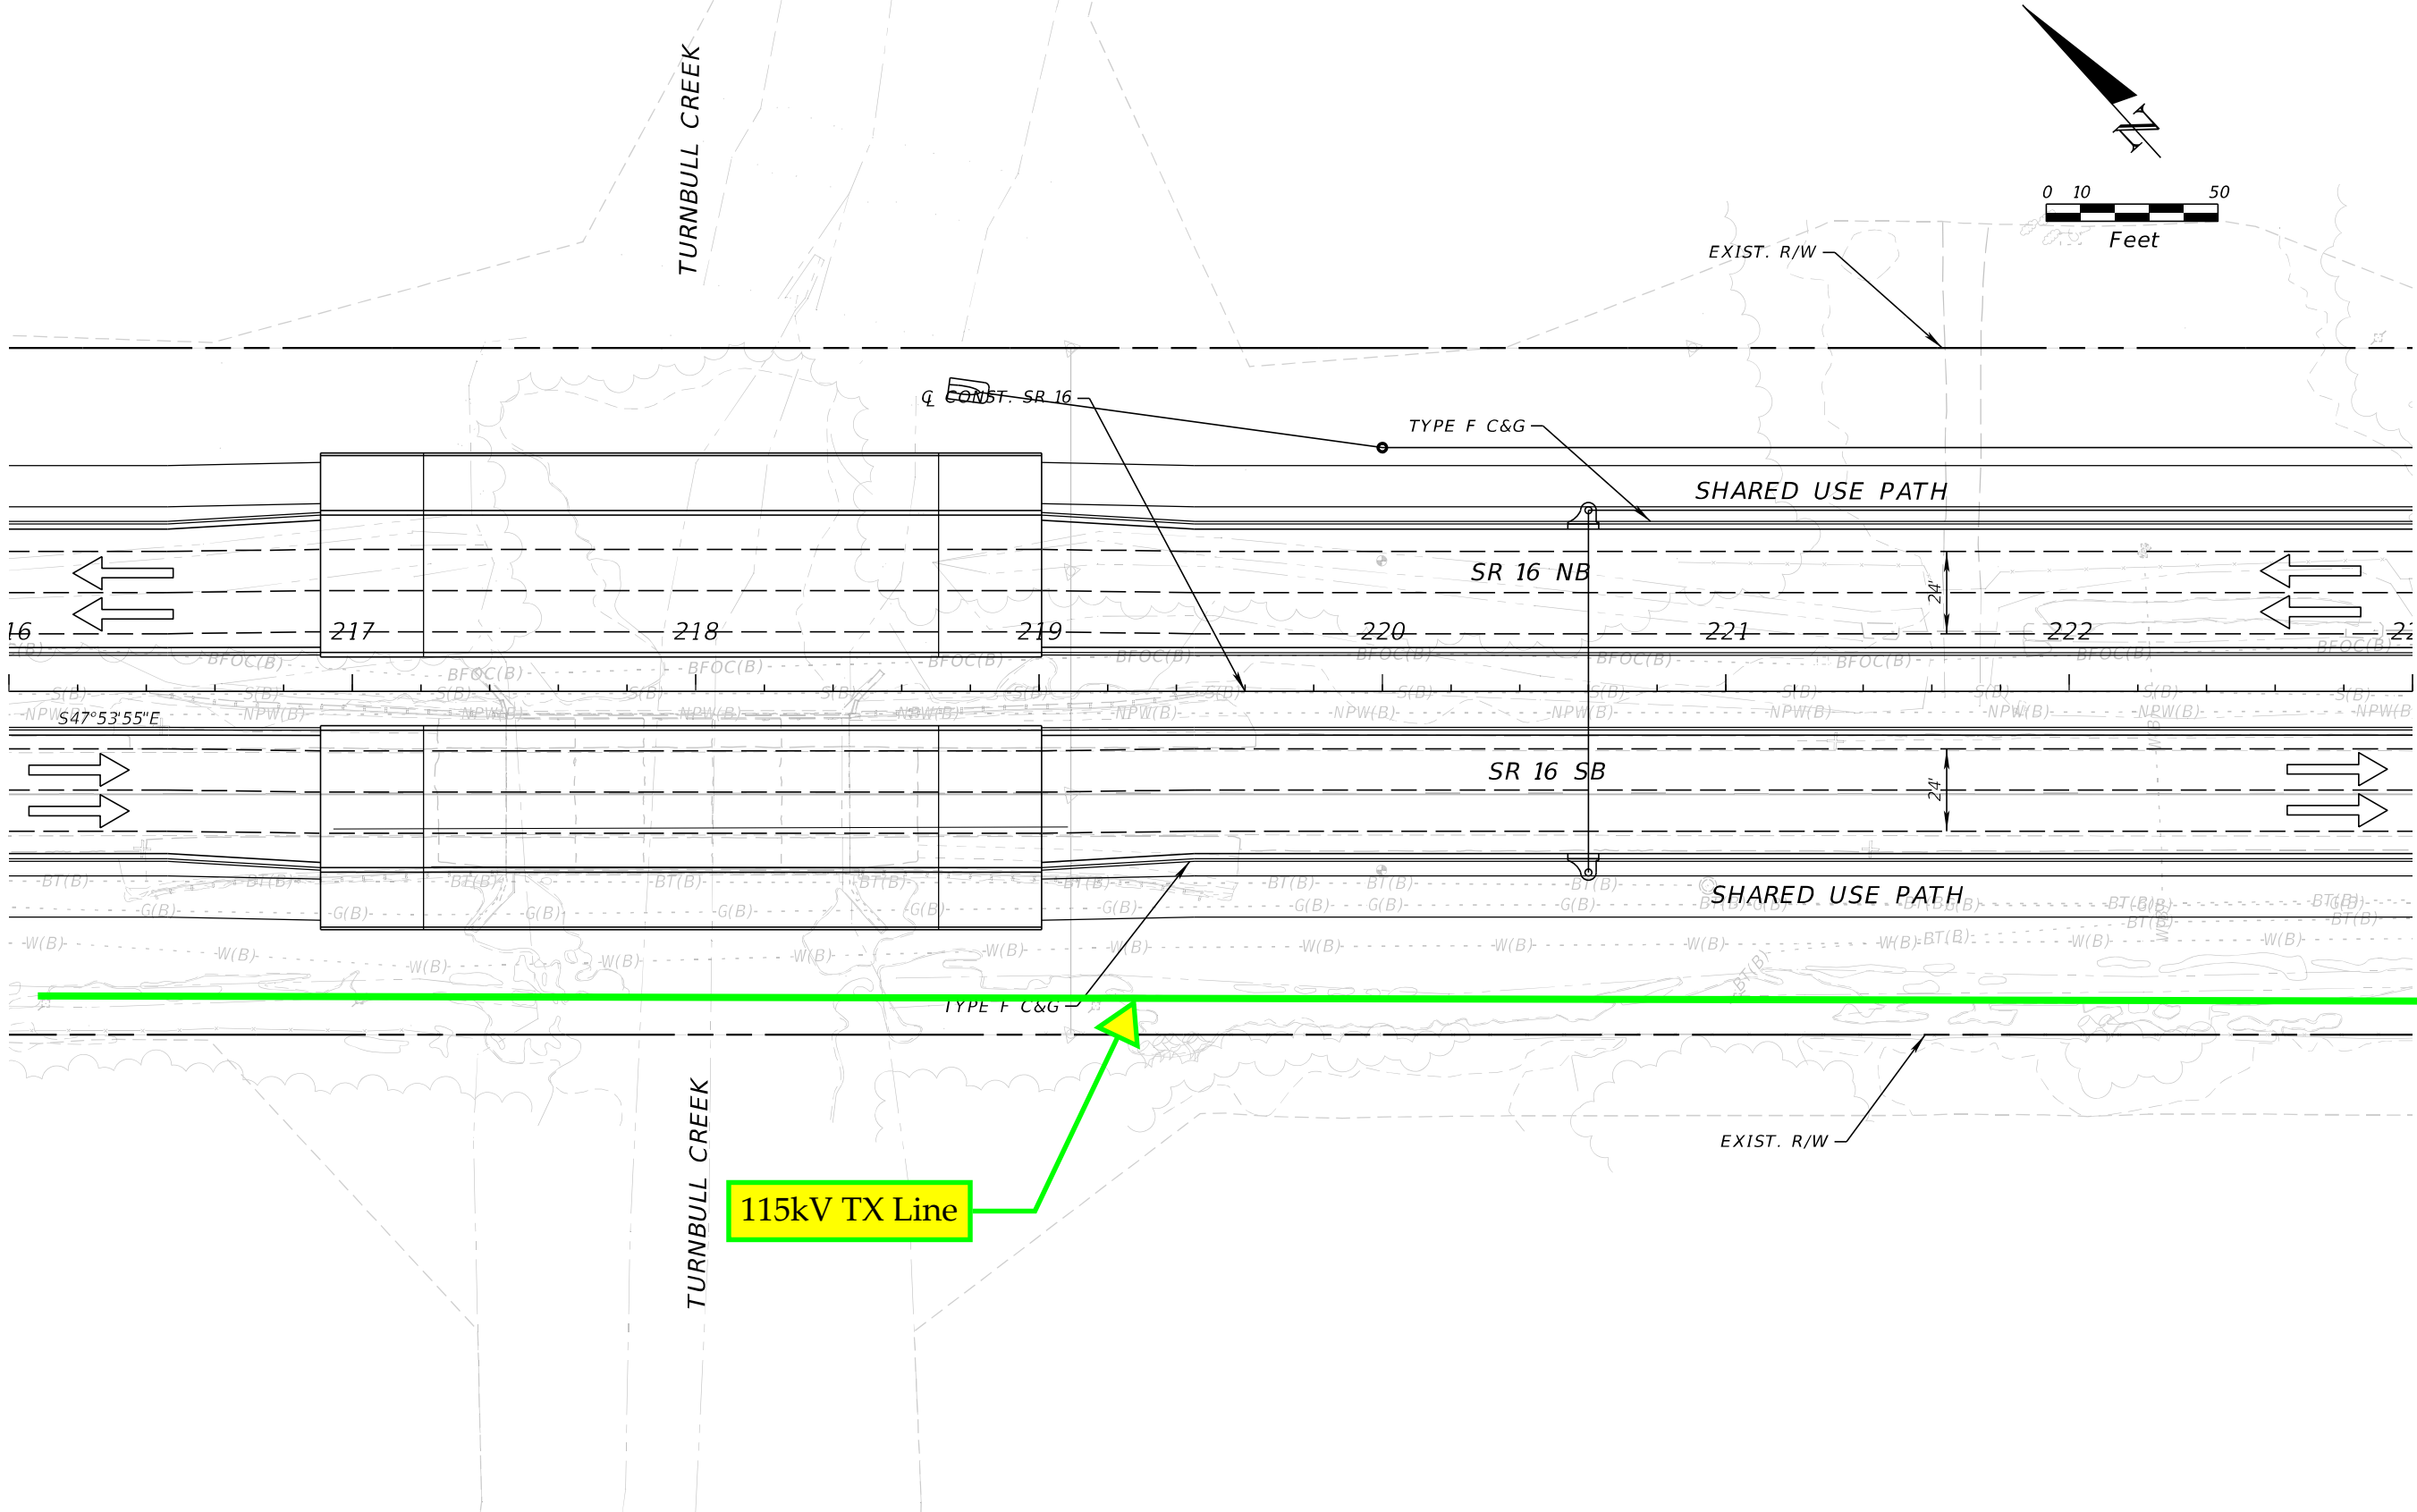

| REVISIONS | | | | ENGINEER OF RECORD | STATE OF FLORIDA DEPARTMENT OF TRANSPORTATION | | | SHEET NO. |
|-----------|-------------|------|-------------|---|--|-----------|----------------------|-----------------------|
| DATE | DESCRIPTION | DATE | DESCRIPTION | STEPHEN J. PARK, P.E. LICENSE NUMBER: 77656 RS&H, INC. 10748 DEERWOOD PARK BLVD. SOUTH JACKSONVILLE, FL 32256 | ROAD NO. | COUNTY | FINANCIAL PROJECT ID | |
| | | | | | SR 16 | ST. JOHNS | 210447-5-52-01 | 11x17 Plan Only |
| | | | | | | | | |

THE OFFICIAL RECORD OF THIS SHEET IS THE ELECTRONIC FILE DIGITALLY SIGNED AND SEALED UNDER RULE 61G15-23.004, F.A.C.


8/5/2024 4:28:49 PM BeattyM
c:\pw_work\sh_pw\pw_user\00439575\PLANRD01.dgn

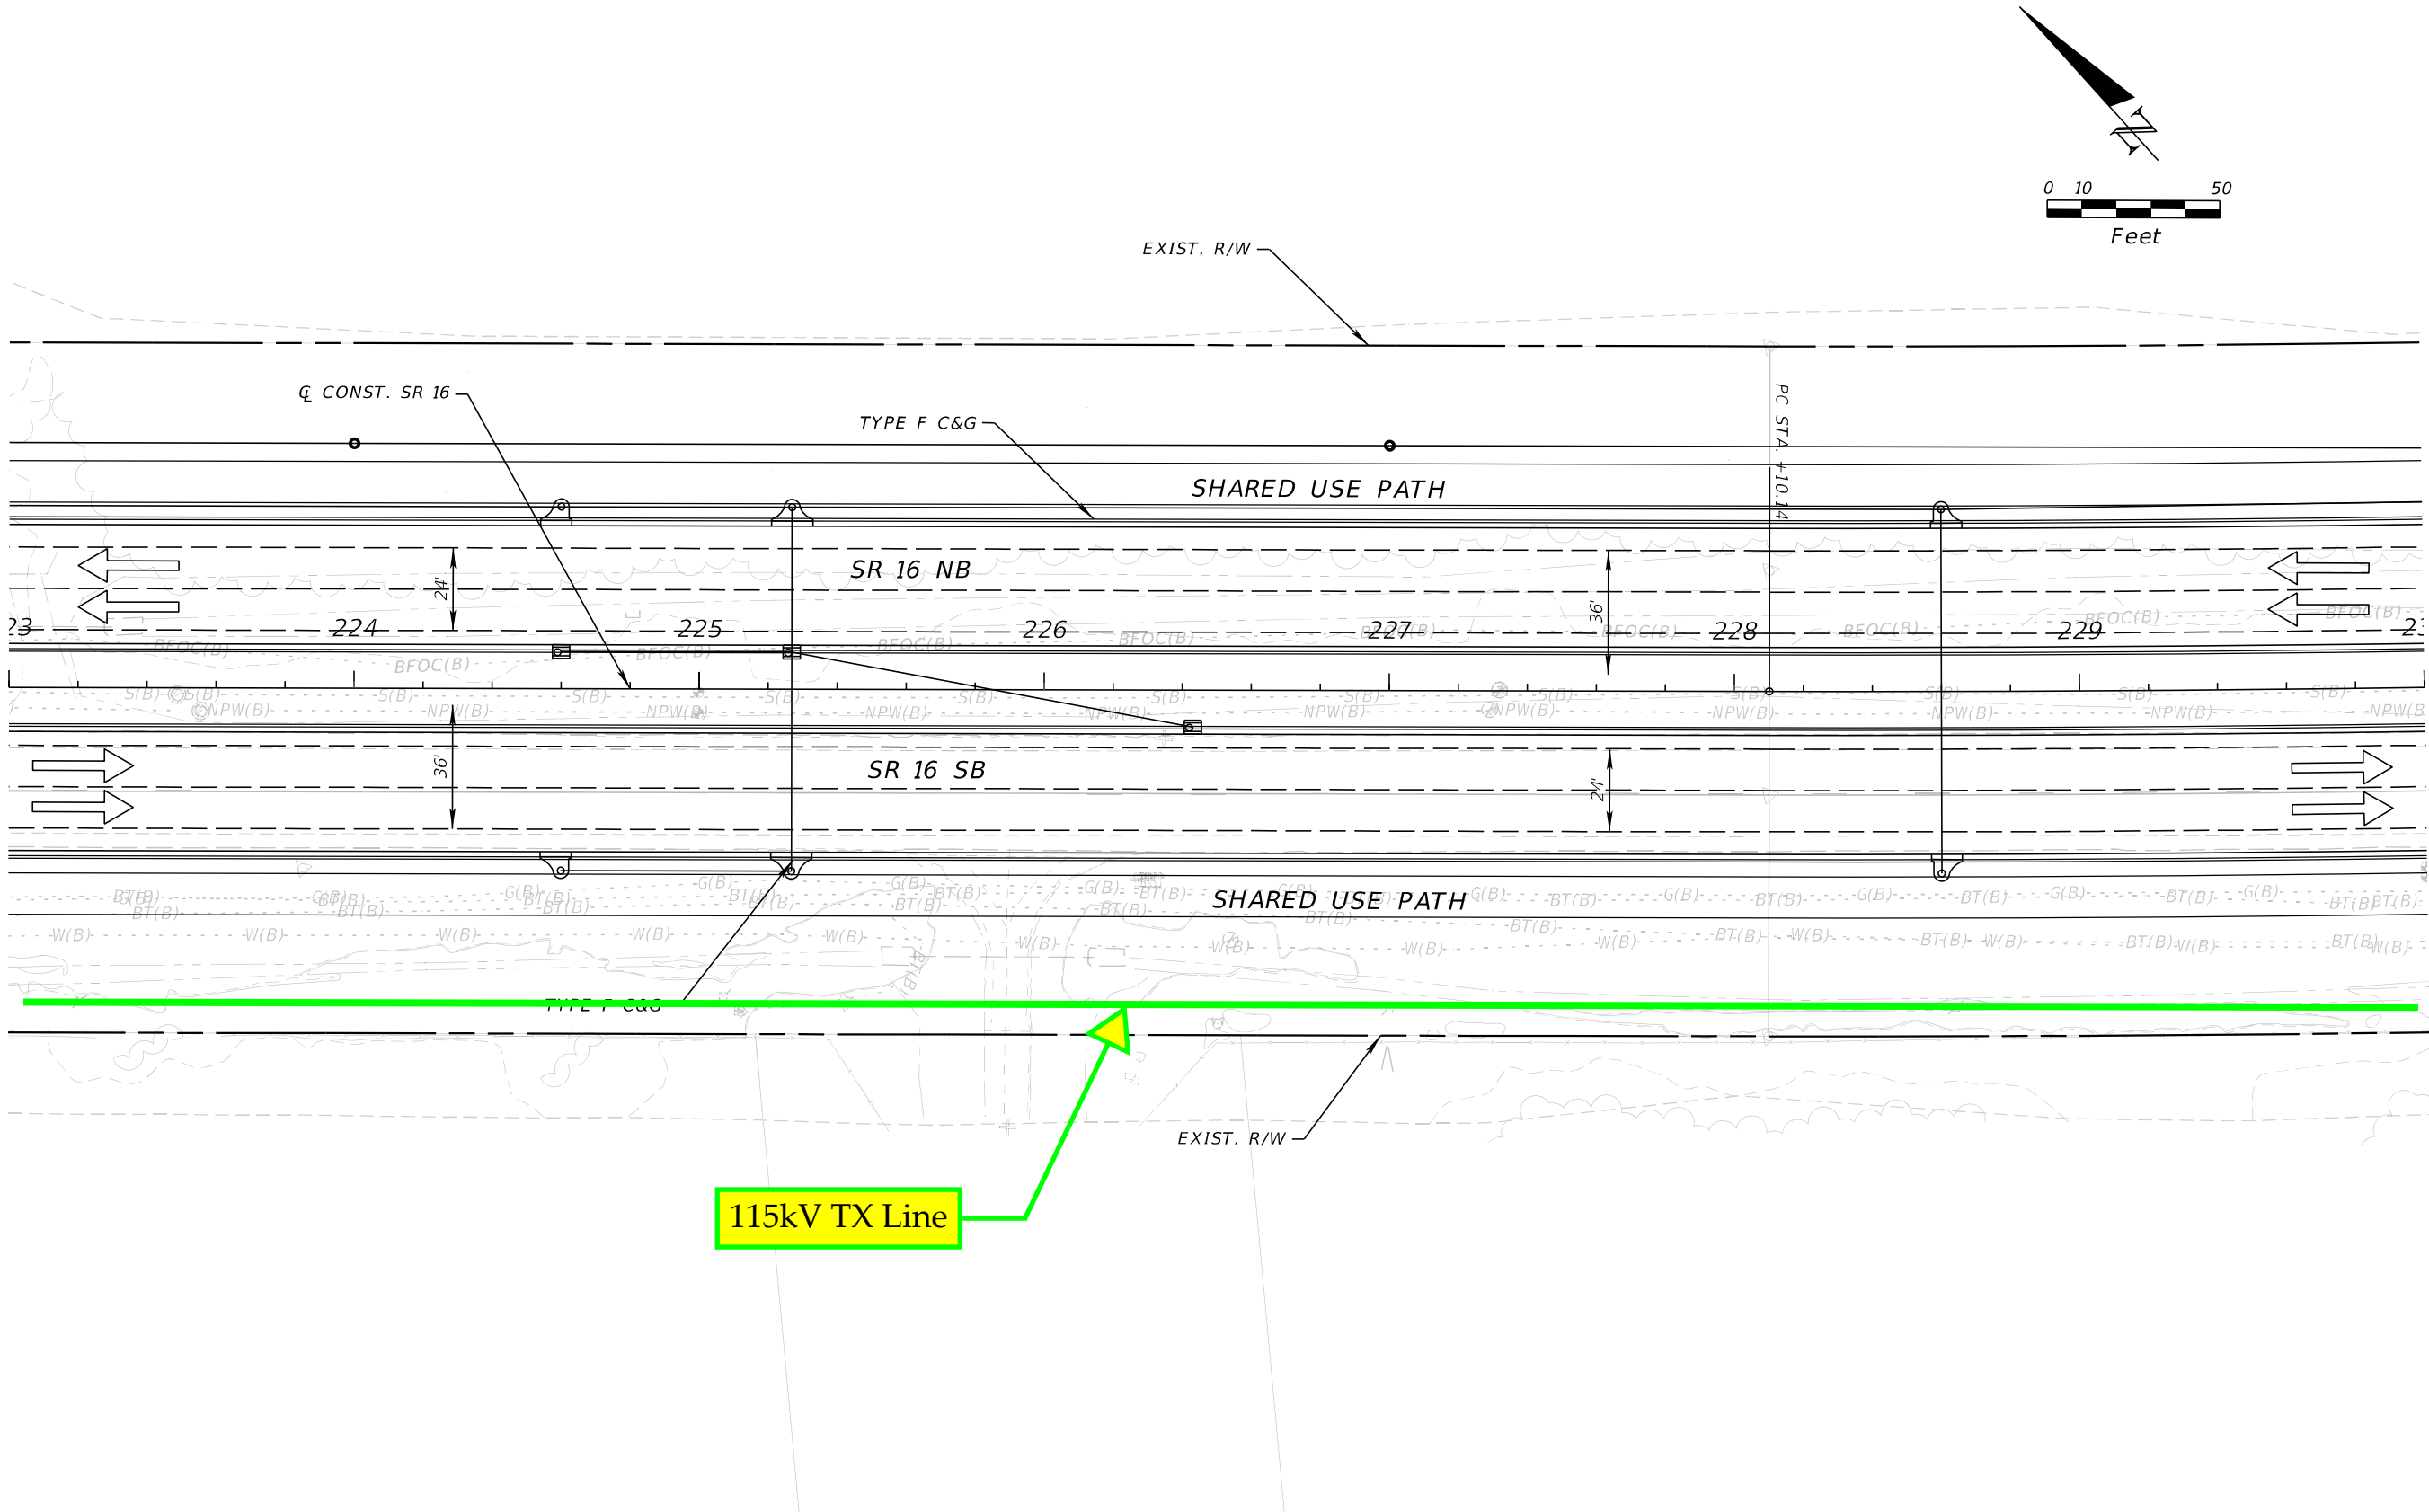

| REVISIONS | | | | ENGINEER OF RECORD | | STATE OF FLORIDA DEPARTMENT OF TRANSPORTATION | | | ROADWAY PLAN | SHEET NO. SR 16 - PLAN- 19 |
|-----------|-------------|------|-------------|---|--|--|-----------|----------------------|--------------|---|
| DATE | DESCRIPTION | DATE | DESCRIPTION | STEPHEN J. PARK, P.E. LICENSE NUMBER: 77656 RS&H, INC. 10748 DEERWOOD PARK BLVD. SOUTH JACKSONVILLE, FL 32256 | | ROAD NO. | COUNTY | FINANCIAL PROJECT ID | | |
| | | | | | | SR 16 | ST. JOHNS | 210447-5-52-01 | | |

THE OFFICIAL RECORD OF THIS SHEET IS THE ELECTRONIC FILE DIGITALLY SIGNED AND SEALED UNDER RULE 61G15-23.004, F.A.C.

8/5/2024 4:28:50 PM BeattyM
c:\pw_work\sh_pw_user\0439575\PLAINRD01.dgn


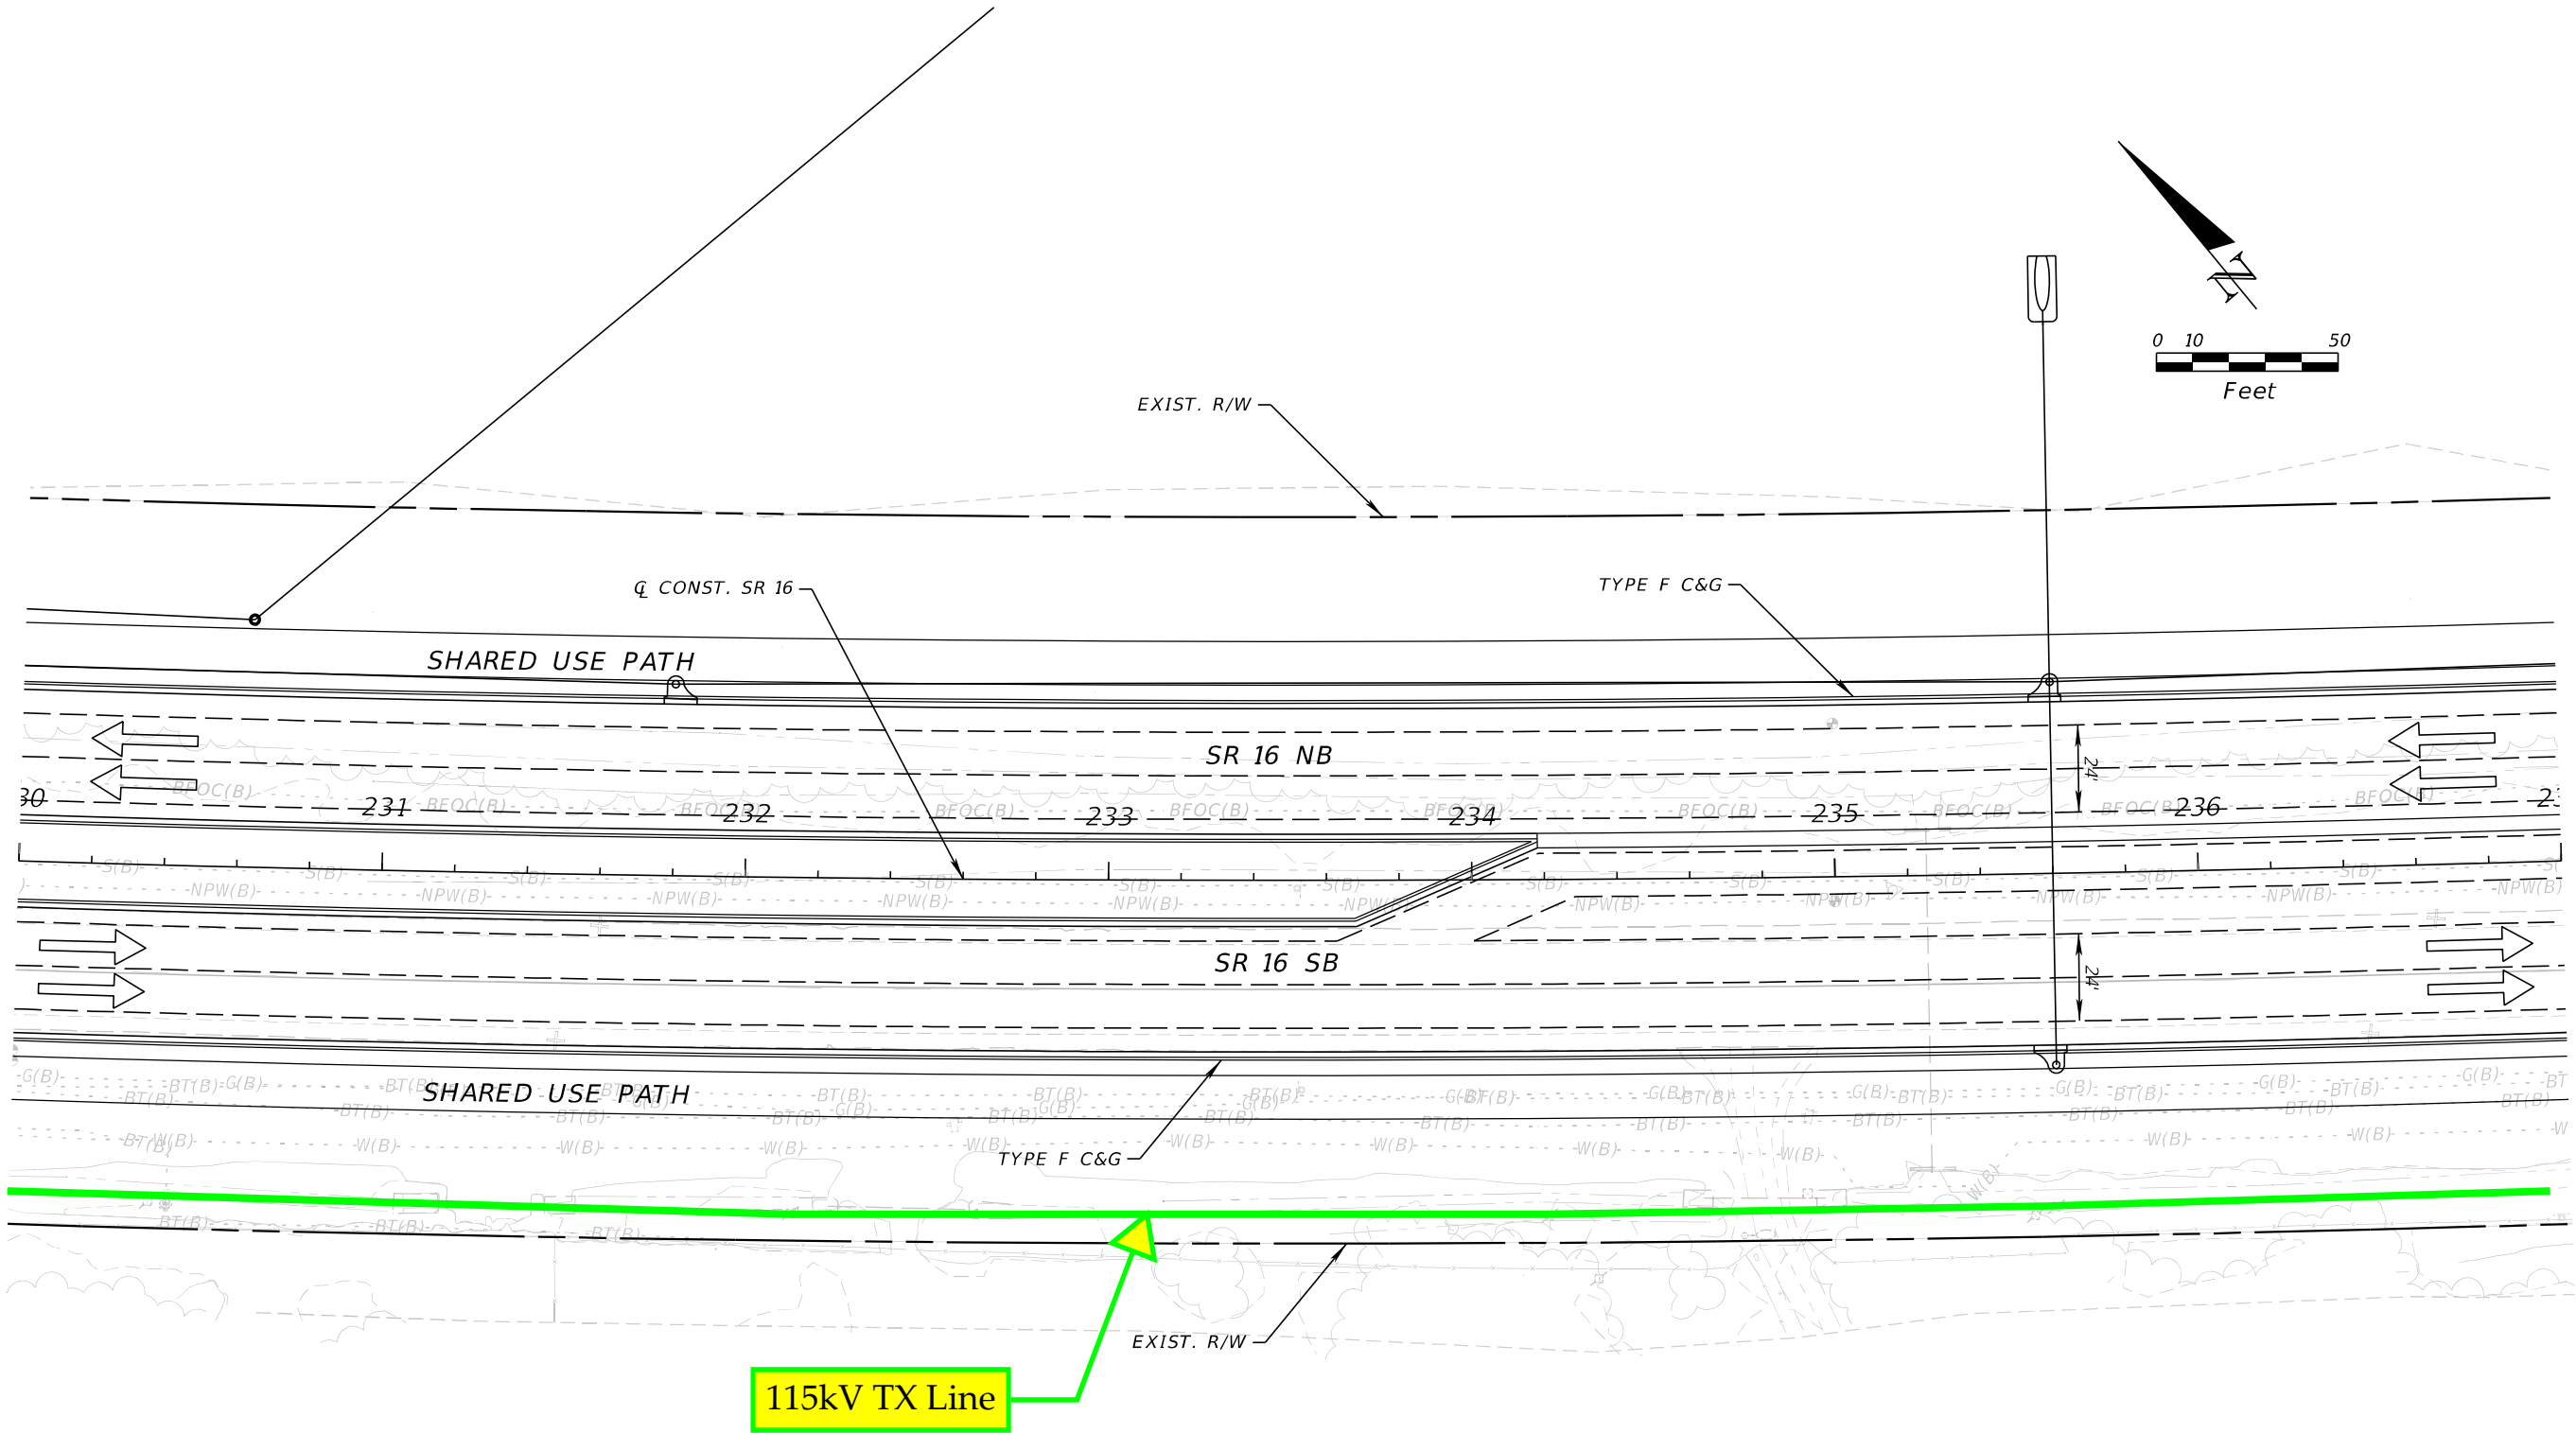


| REVISIONS | | | | ENGINEER OF RECORD | | STATE OF FLORIDA DEPARTMENT OF TRANSPORTATION | | | SHEET NO. |
|-----------|-------------|------|-------------|---|--|--|-----------|----------------------|--------------|
| DATE | DESCRIPTION | DATE | DESCRIPTION | STEPHEN J. PARK, P.E. LICENSE NUMBER: 77656 RS&H, INC. 10748 DEERWOOD PARK BLVD. SOUTH JACKSONVILLE, FL 32256 | | ROAD NO. | COUNTY | FINANCIAL PROJECT ID | |
| | | | | | | SR 16 | ST. JOHNS | 210447-5-52-01 | |

THE OFFICIAL RECORD OF THIS SHEET IS THE ELECTRONIC FILE DIGITALLY SIGNED AND SEALED UNDER RULE 61G15-23.004, F.A.C.

8/5/2024 4:28:51 PM BeattyM
c:\pw_work\sh_pw\pw_user\0439575\PLANRD01.dgn


CURVE DATA
PI STA. = 239+02.25
 Δ = 10°55'00" (LT)
D = 00°30'05"
T = 1,092.10
L = 2,177.60
R = 2,177.60
PC STA. = 228+10.14
PT STA. = 249+87.74
e = 0.000

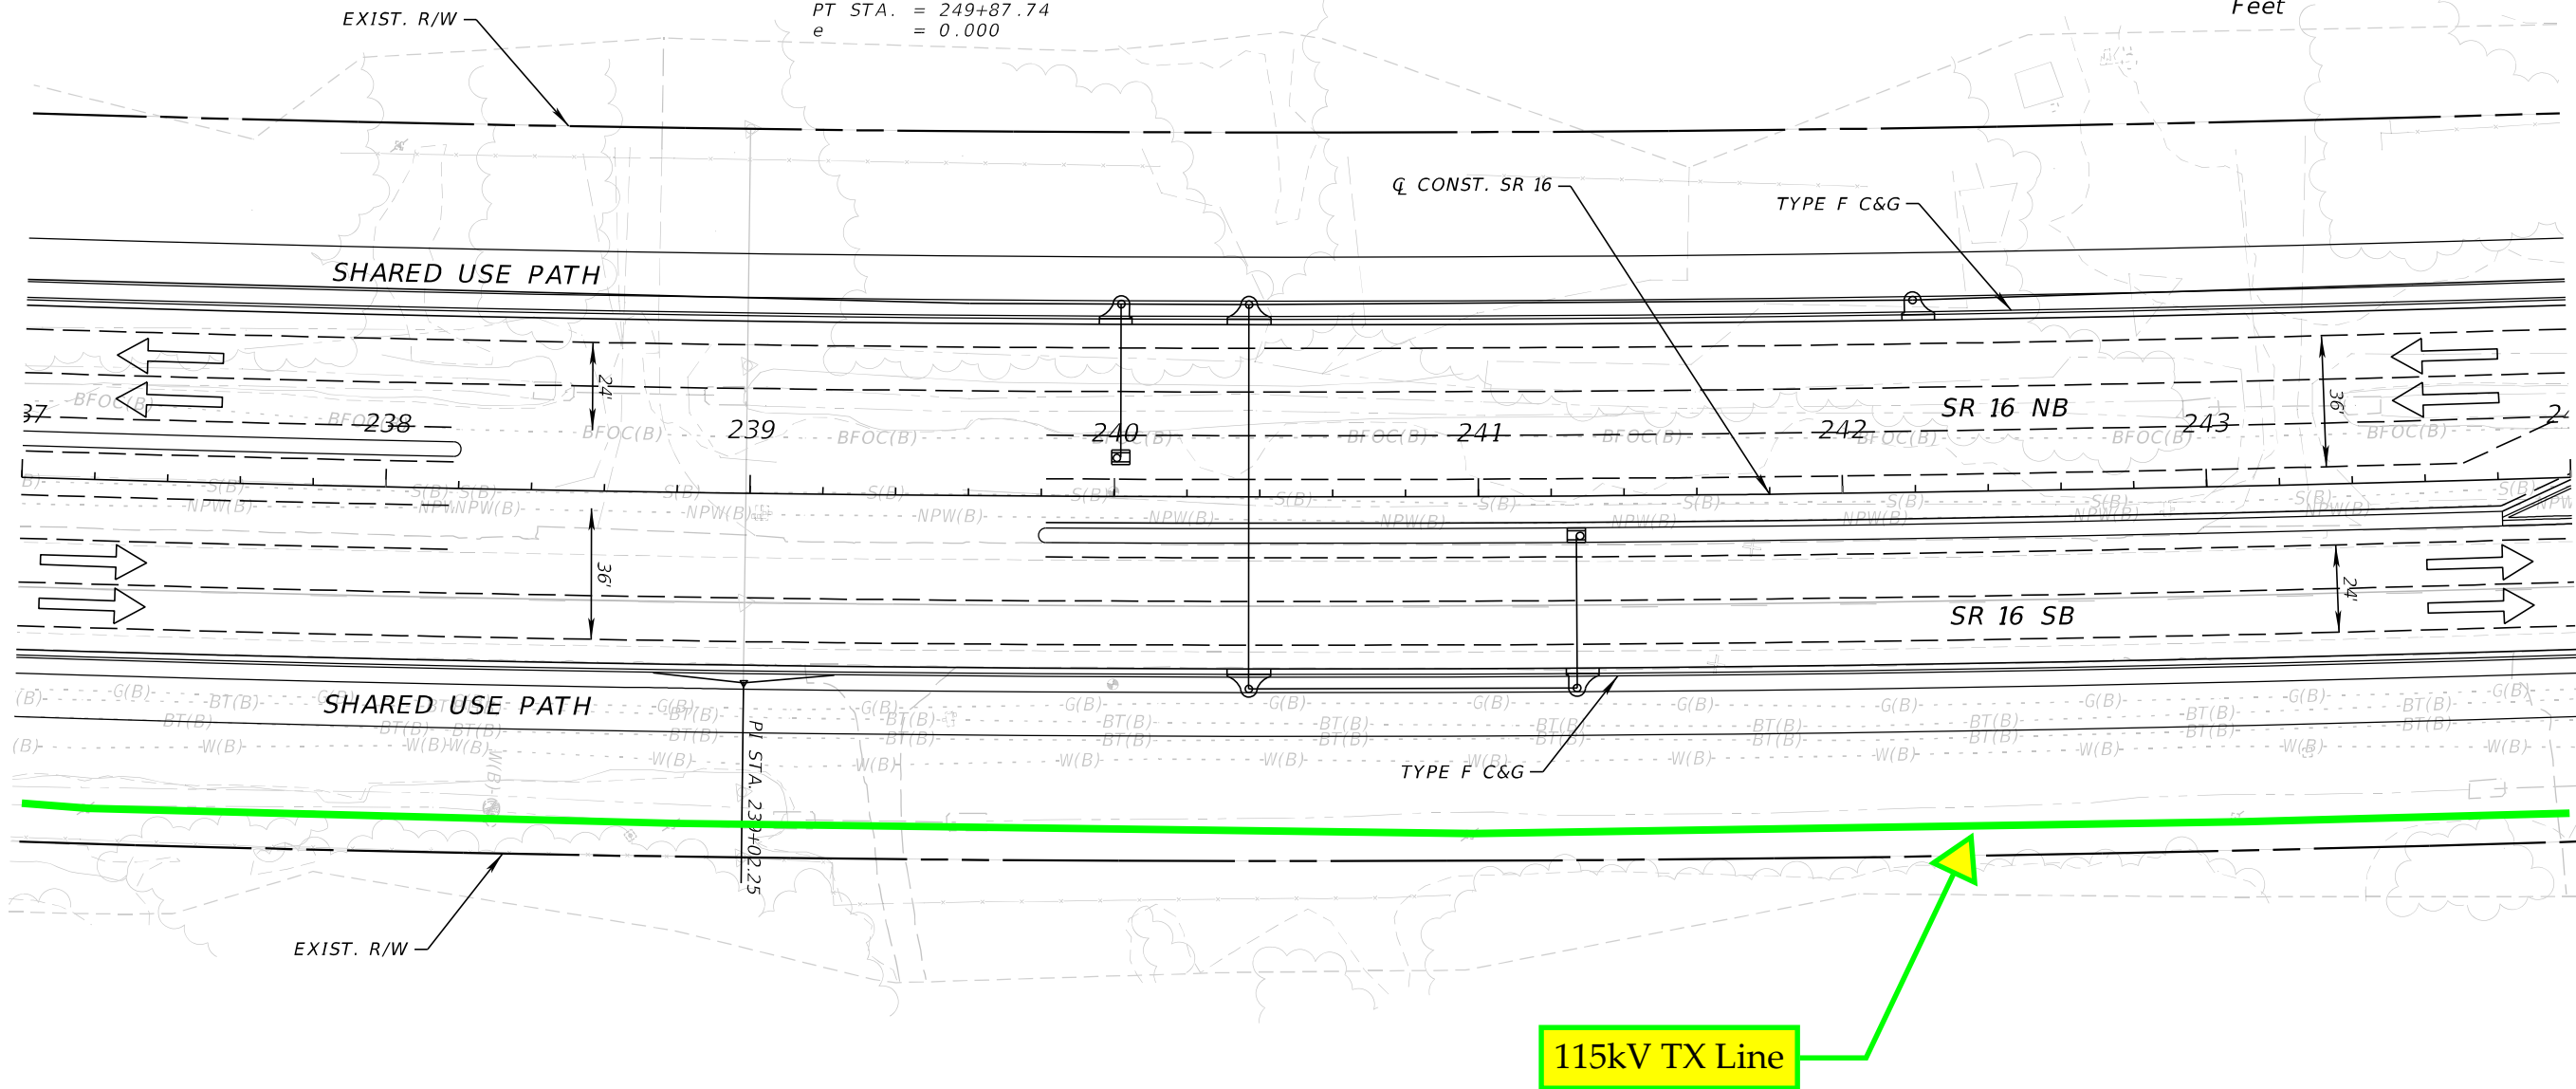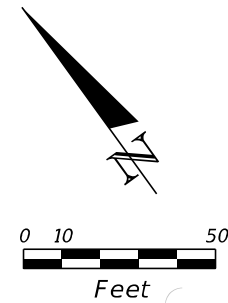

| REVISIONS | | | | ENGINEER OF RECORD | | STATE OF FLORIDA DEPARTMENT OF TRANSPORTATION | | | SHEET NO. |
|-----------|-------------|------|-------------|---|--|--|-----------|----------------------|--------------|
| DATE | DESCRIPTION | DATE | DESCRIPTION | STEPHEN J. PARK, P.E. LICENSE NUMBER: 77656 RS&H, INC. 10748 DEERWOOD PARK BLVD. SOUTH JACKSONVILLE, FL 32256 | | ROAD NO. | COUNTY | FINANCIAL PROJECT ID | |
| | | | | | | SR 16 | ST. JOHNS | 210447-5-52-01 | |

THE OFFICIAL RECORD OF THIS SHEET IS THE ELECTRONIC FILE DIGITALLY SIGNED AND SEALED UNDER RULE 61G15-23.004, F.A.C.


8/5/2024 4:28:51 PM BeattyM
c:\pw_work\sh_pw\pw_user\0439575\PLAINRD01.dgn

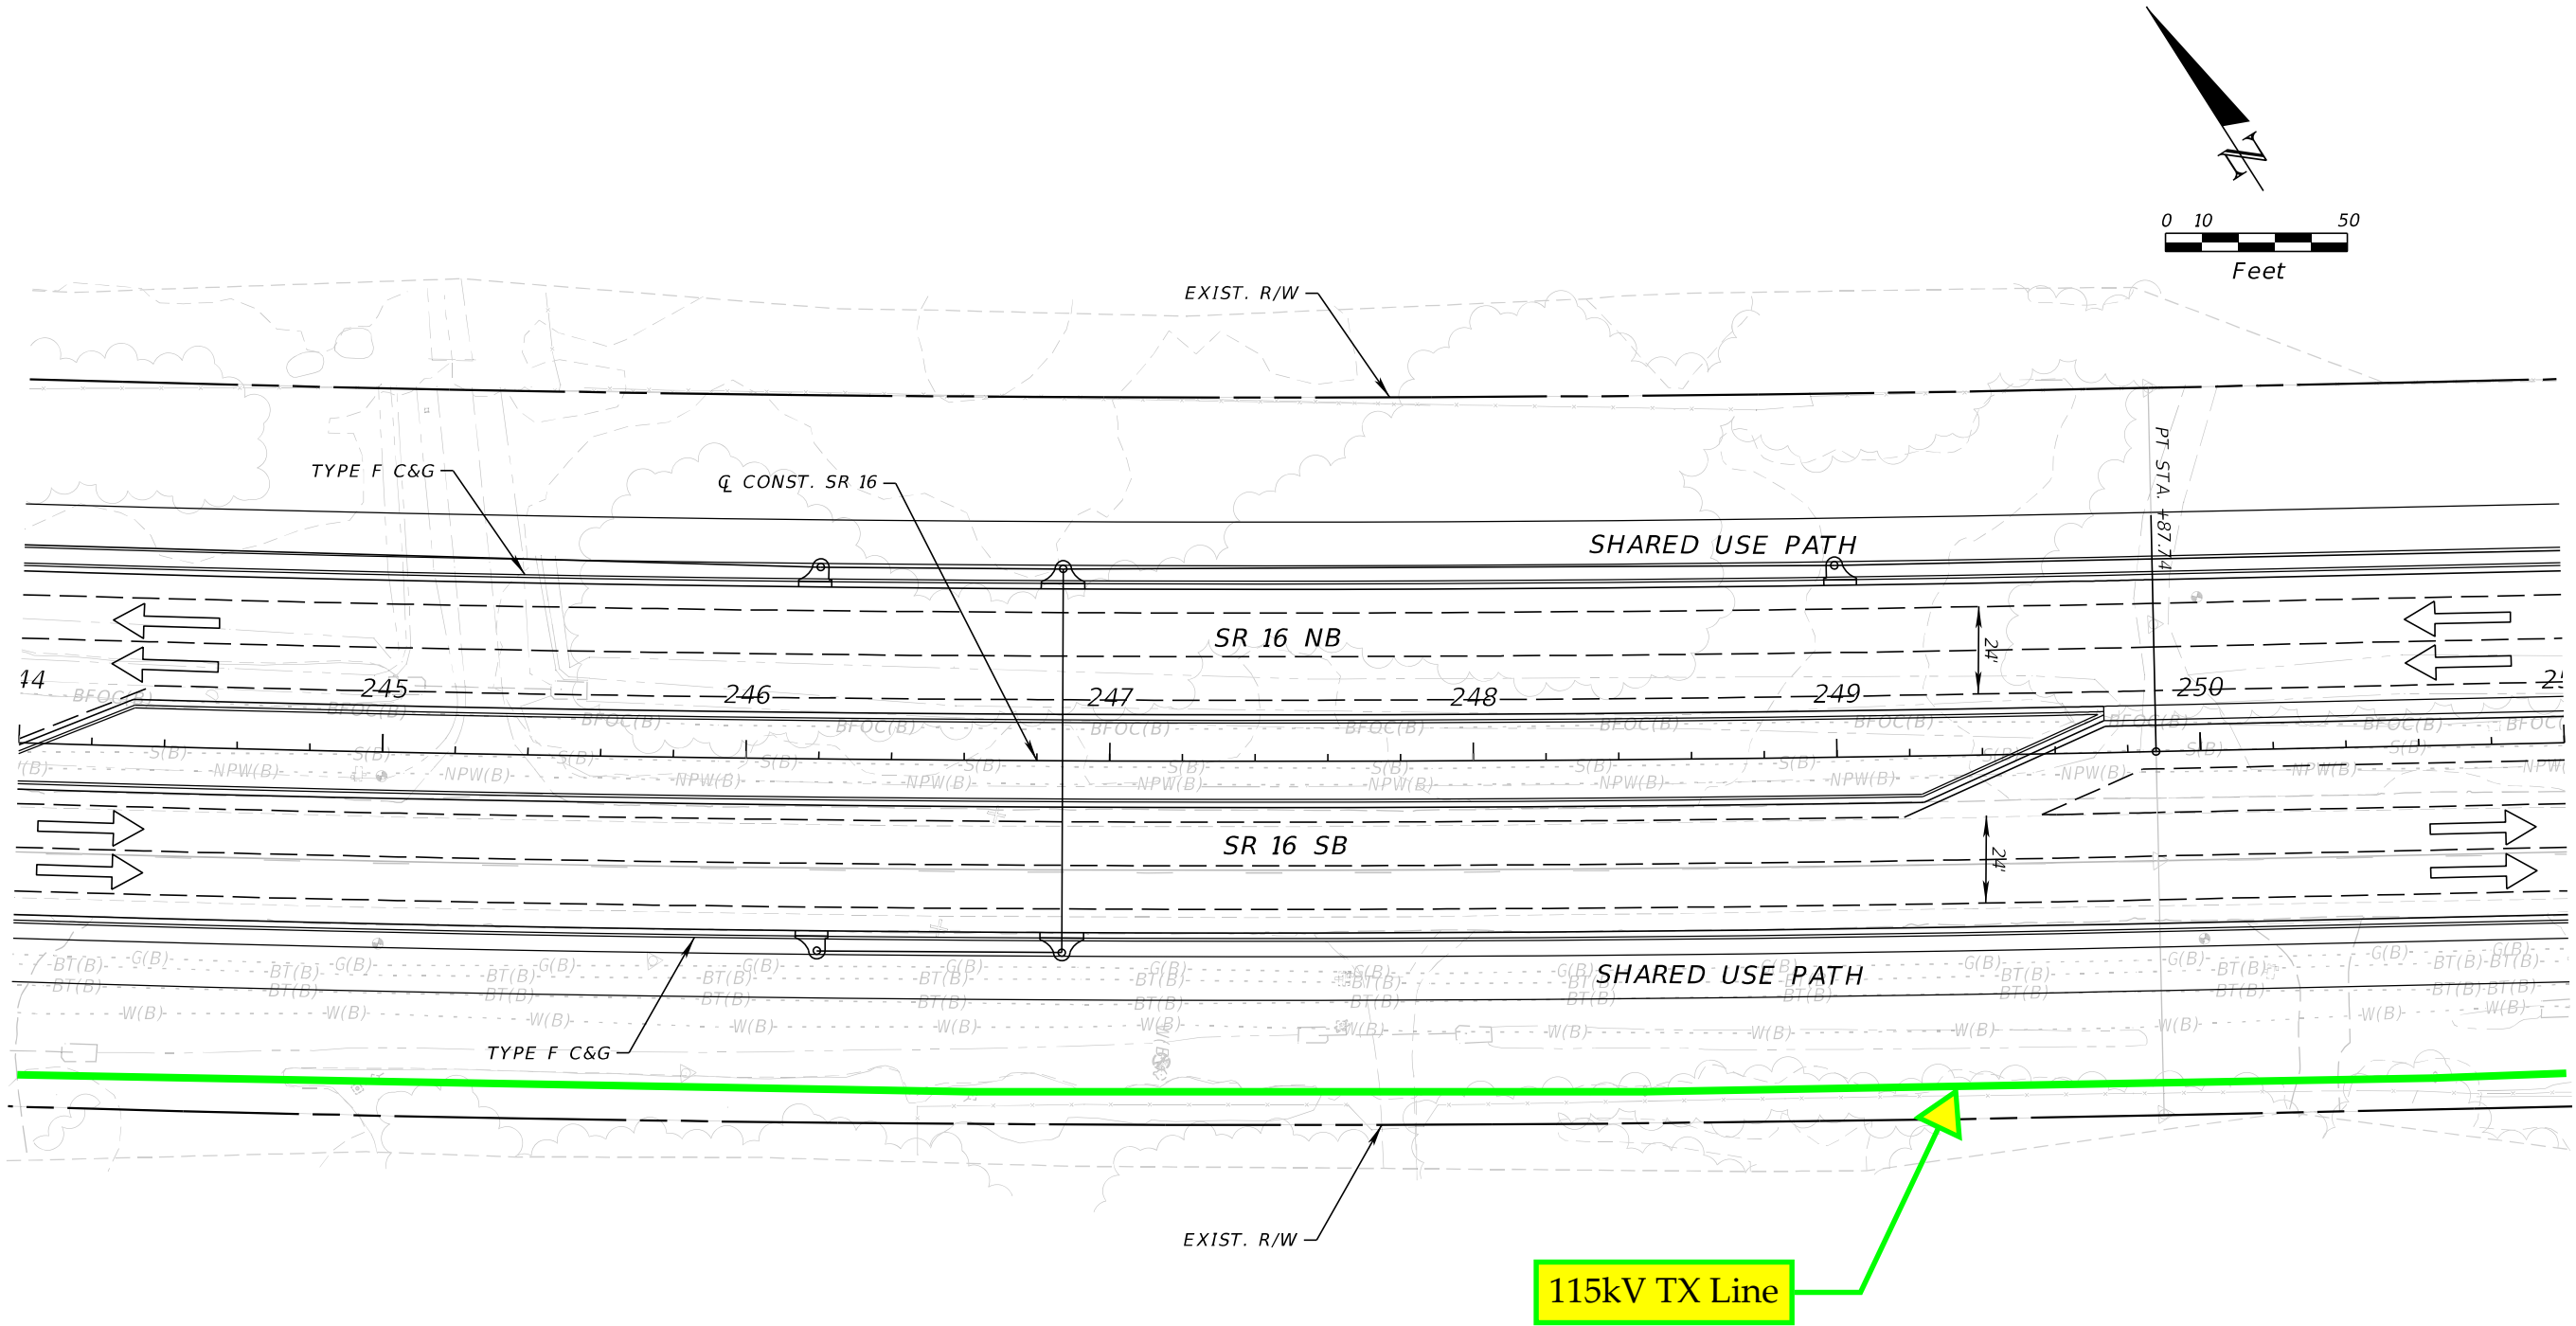

| REVISIONS | | | | ENGINEER OF RECORD | STATE OF FLORIDA DEPARTMENT OF TRANSPORTATION | | | SHEET NO. |
|-----------|-------------|------|-------------|---|--|-----------|----------------------|-----------------------|
| DATE | DESCRIPTION | DATE | DESCRIPTION | | ROAD NO. | COUNTY | FINANCIAL PROJECT ID | |
| | | | | | SR 16 | ST. JOHNS | 210447-5-52-01 | |
| | | | | STEPHEN J. PARK, P.E. LICENSE NUMBER: 77656 RS&H, INC. 10748 DEERWOOD PARK BLVD. SOUTH JACKSONVILLE, FL 32256 | | | | 11x17 Plan Only |

THE OFFICIAL RECORD OF THIS SHEET IS THE ELECTRONIC FILE DIGITALLY SIGNED AND SEALED UNDER RULE 61G15-23.004, F.A.C.


8/5/2024 4:28:52 PM BeattyM
c:\pw_work\ysh_pw\pw_user\0439575\PLANRD01.dgn

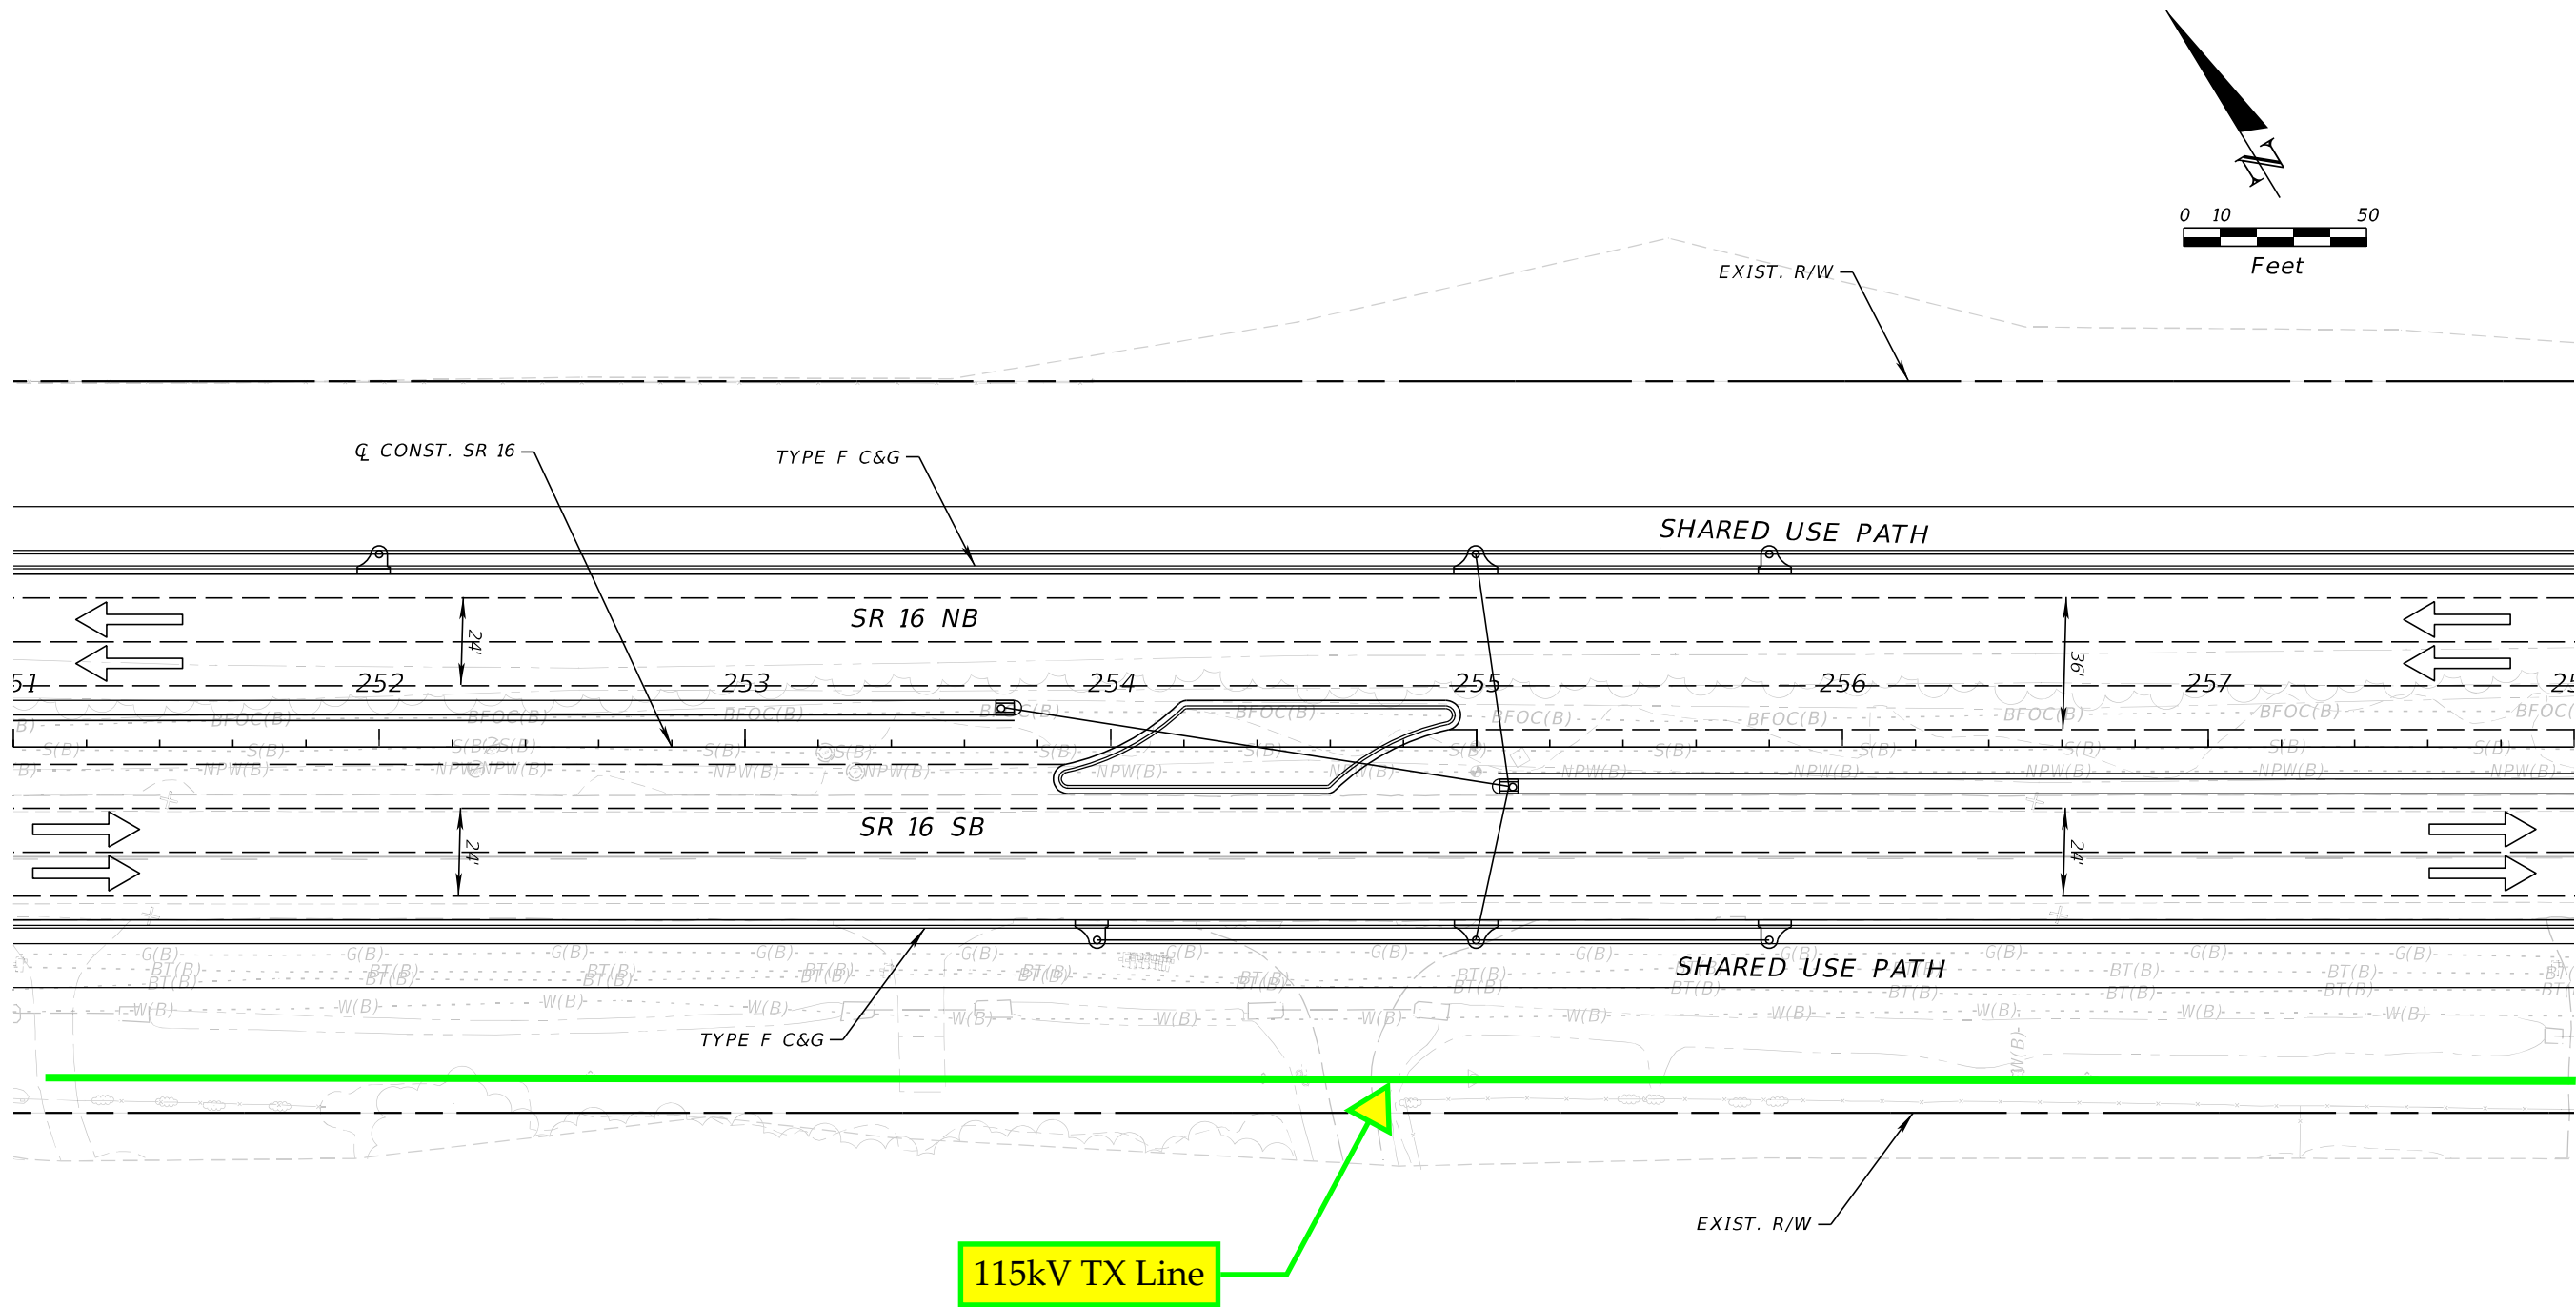

| REVISIONS | | | | ENGINEER OF RECORD | | STATE OF FLORIDA DEPARTMENT OF TRANSPORTATION | | | SHEET NO. |
|-----------|-------------|------|-------------|---|--|--|-----------|----------------------|--------------|
| DATE | DESCRIPTION | DATE | DESCRIPTION | STEPHEN J. PARK, P.E. LICENSE NUMBER: 77656 RS&H, INC. 10748 DEERWOOD PARK BLVD. SOUTH JACKSONVILLE, FL 32256 | | ROAD NO. | COUNTY | FINANCIAL PROJECT ID | |
| | | | | | | SR 16 | ST. JOHNS | 210447-5-52-01 | |

THE OFFICIAL RECORD OF THIS SHEET IS THE ELECTRONIC FILE DIGITALLY SIGNED AND SEALED UNDER RULE 61G15-23.004, F.A.C.


8/5/2024 4:28:52 PM BeattyM
c:\pw_work\sh_pw\pw_user\0439575\PLANRD01.dgn

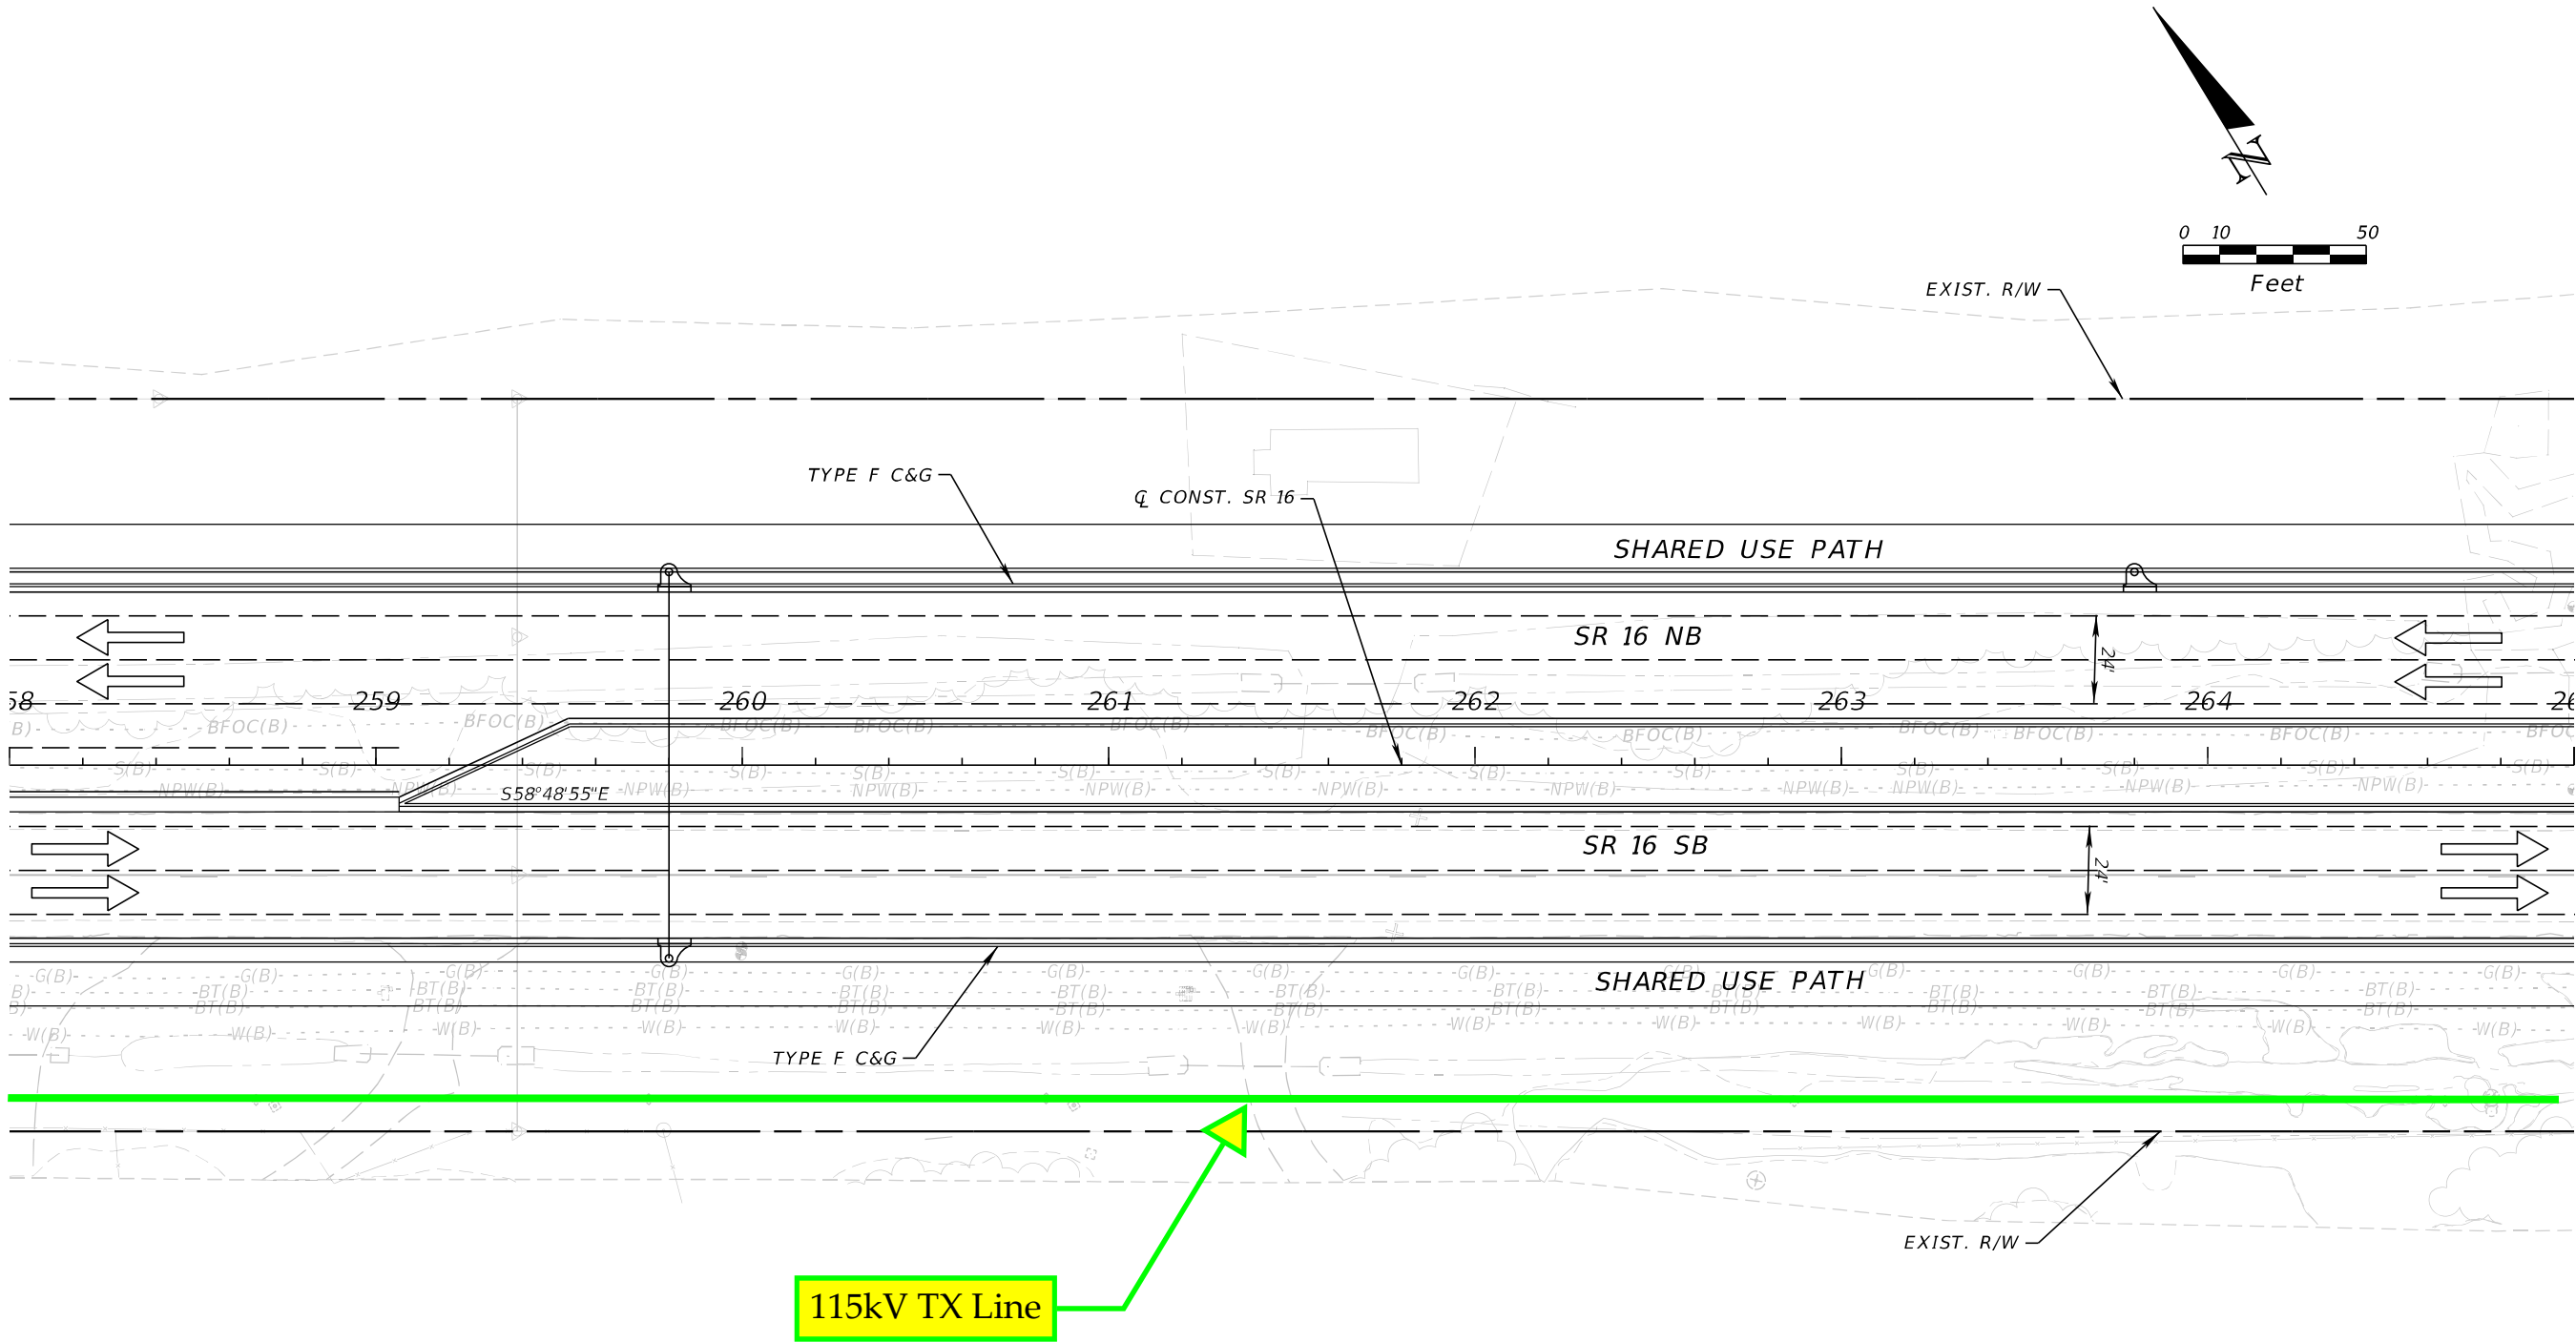

| REVISIONS | | | | ENGINEER OF RECORD | STATE OF FLORIDA DEPARTMENT OF TRANSPORTATION | | | SHEET NO. | |
|-----------|-------------|--|------|--------------------|--|---|--------|--------------|-----------------------|
| DATE | DESCRIPTION | | DATE | DESCRIPTION | | ROAD NO. | COUNTY | | FINANCIAL PROJECT ID |
| | | | | | | STEPHEN J. PARK, P.E. LICENSE NUMBER: 77656 RS&H, INC. 10748 DEERWOOD PARK BLVD. SOUTH JACKSONVILLE, FL 32256 | | | 11x17 Plan Only |
| | | | | | | SR 16 ST. JOHNS 210447-5-52-01 | | | |

THE OFFICIAL RECORD OF THIS SHEET IS THE ELECTRONIC FILE DIGITALLY SIGNED AND SEALED UNDER RULE 61G15-23.004, F.A.C.


8/5/2024 4:28:53 PM BeattyM
c:\pw_work\sh_pw\pw_user\0439575\PLANRD01.dgn

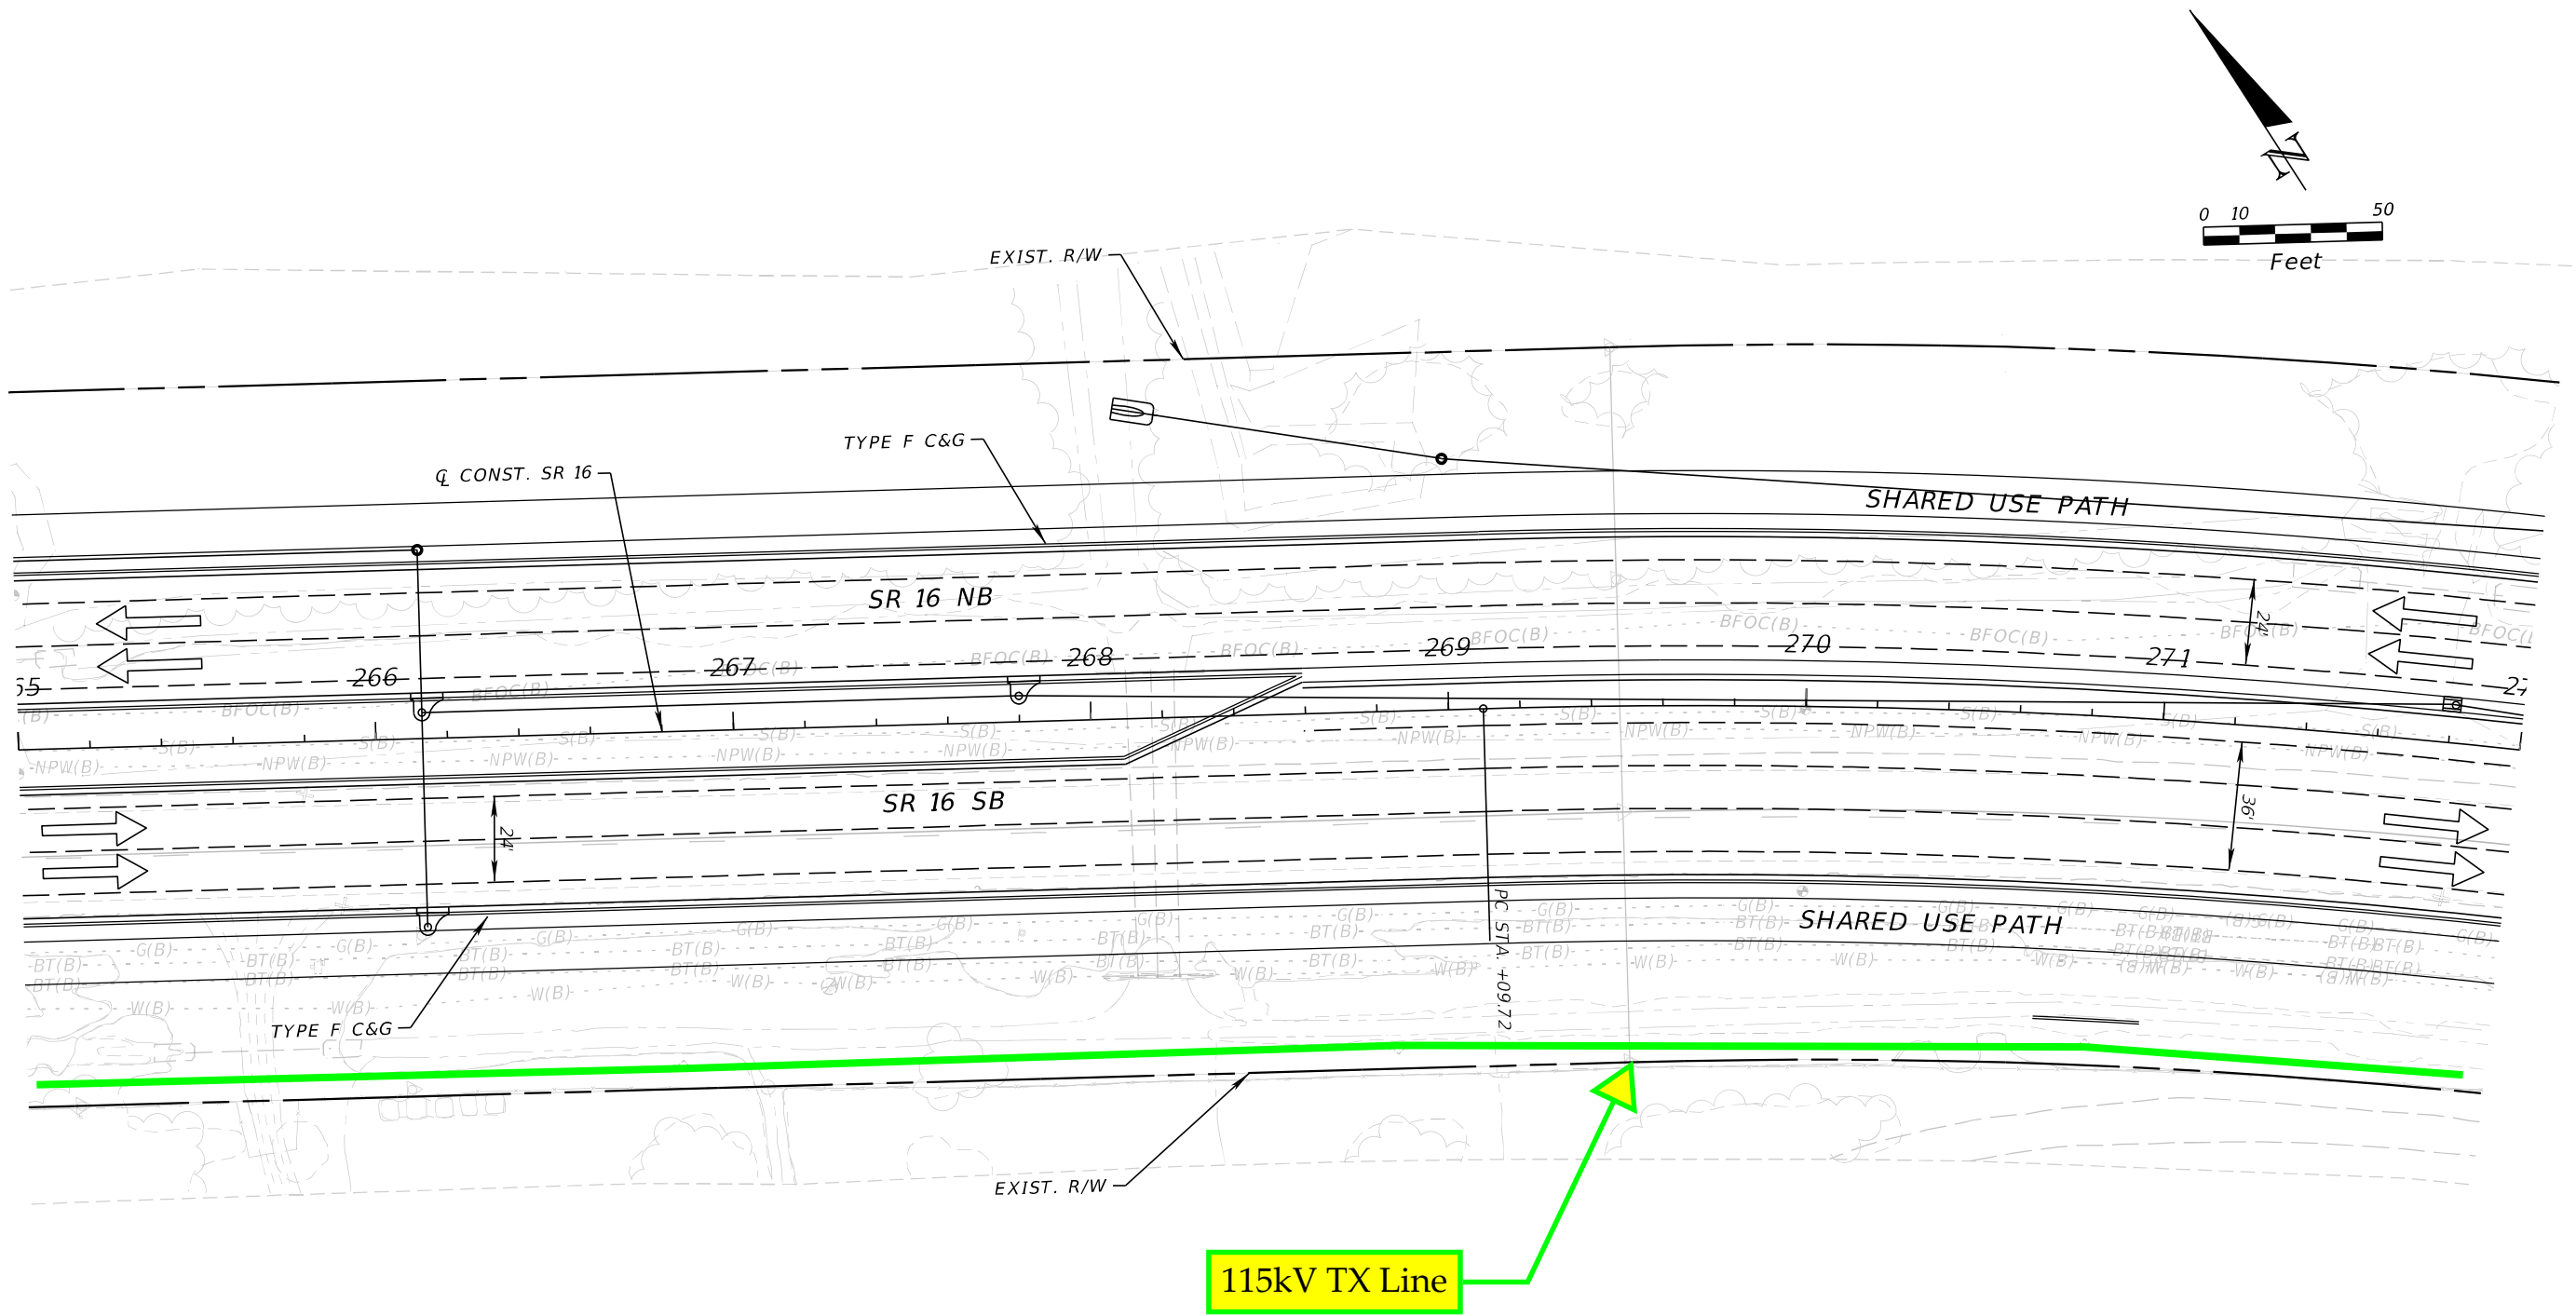

| REVISIONS | | | | ENGINEER OF RECORD | STATE OF FLORIDA DEPARTMENT OF TRANSPORTATION | | | SHEET NO. |
|-----------|-------------|------|-------------|---|--|-----------|----------------------|-----------------------|
| DATE | DESCRIPTION | DATE | DESCRIPTION | STEPHEN J. PARK, P.E. LICENSE NUMBER: 77656 RS&H, INC. 10748 DEERWOOD PARK BLVD. SOUTH JACKSONVILLE, FL 32256 | ROAD NO. | COUNTY | FINANCIAL PROJECT ID | |
| | | | | | SR 16 | ST. JOHNS | 210447-5-52-01 | |
| | | | | | | | | 11x17 Plan Only |

THE OFFICIAL RECORD OF THIS SHEET IS THE ELECTRONIC FILE DIGITALLY SIGNED AND SEALED UNDER RULE 61G15-23.004, F.A.C.


8/5/2024 4:28:54 PM BeattyM
c:\pw_work\ysh_pw\pw_user\00439575\PLANRD01.dgn

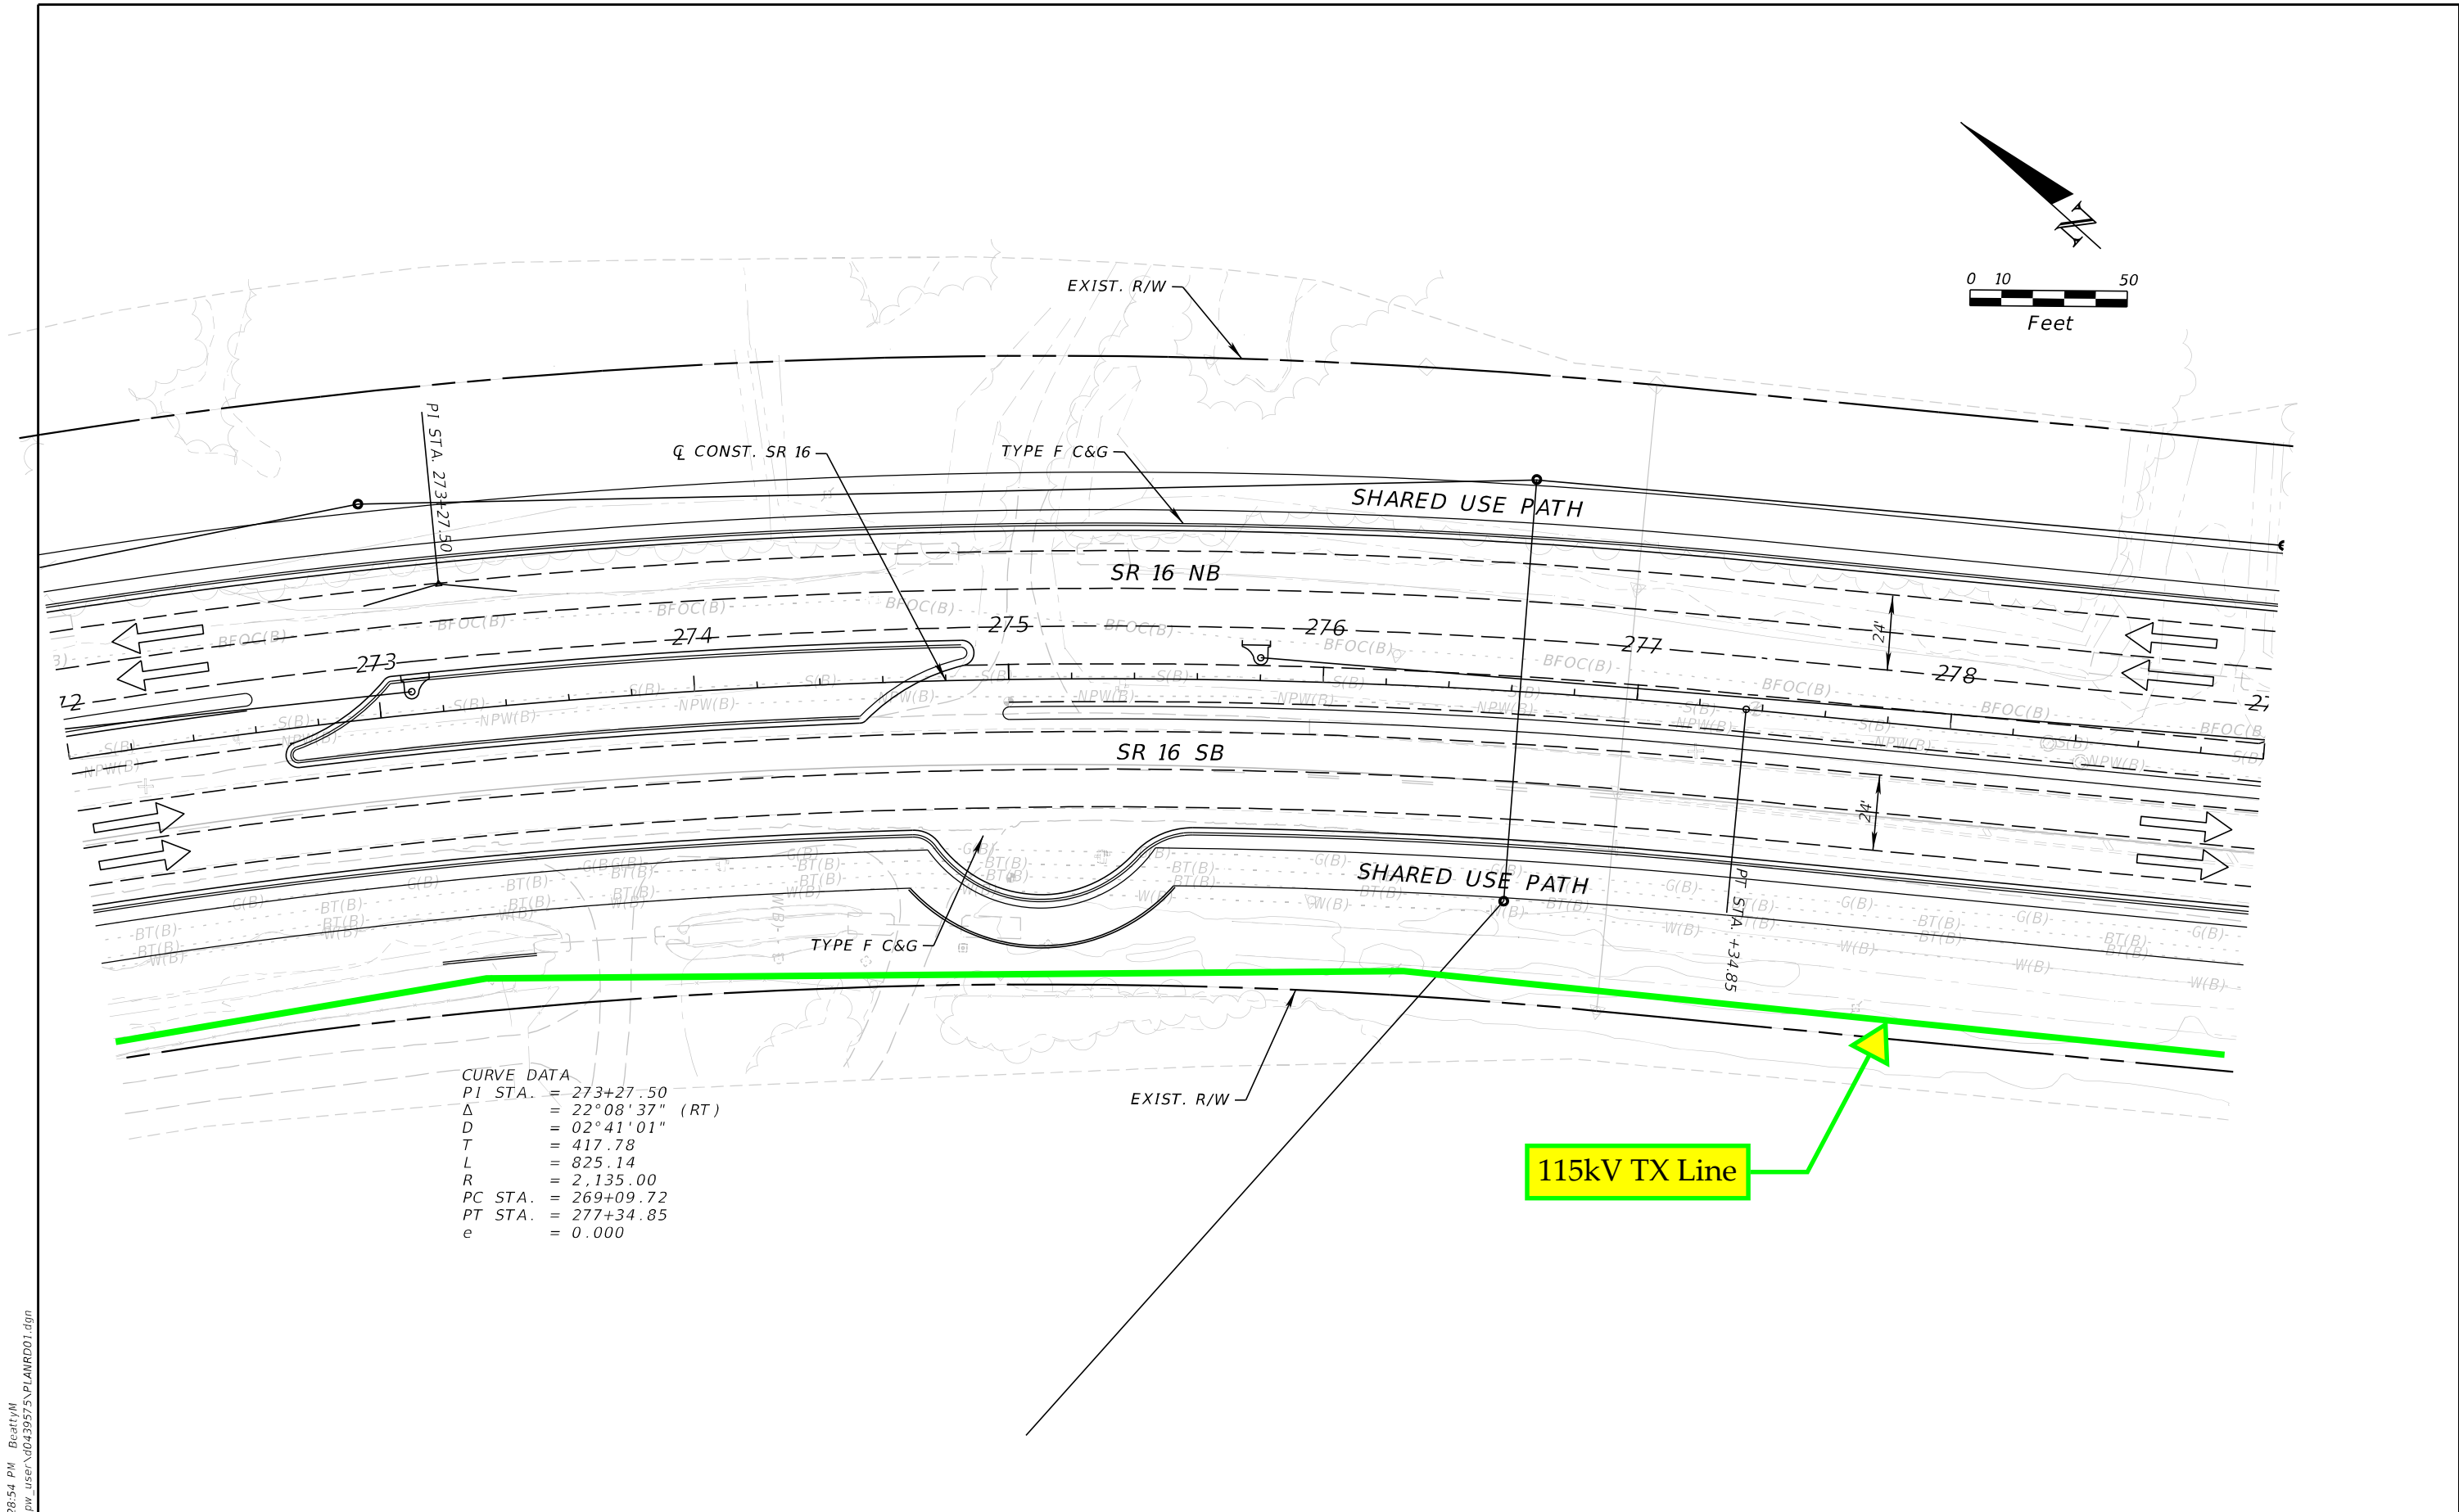

| REVISIONS | | | | ENGINEER OF RECORD | | STATE OF FLORIDA DEPARTMENT OF TRANSPORTATION | | | SHEET NO. |
|-----------|-------------|------|-------------|---|--|--|-----------|----------------------|-----------------------|
| DATE | DESCRIPTION | DATE | DESCRIPTION | STEPHEN J. PARK, P.E. LICENSE NUMBER: 77656 RS&H, INC. 10748 DEERWOOD PARK BLVD. SOUTH JACKSONVILLE, FL 32256 | | ROAD NO. | COUNTY | FINANCIAL PROJECT ID | |
| | | | | | | SR 16 | ST. JOHNS | 210447-5-52-01 | 11x17 Plan Only |

THE OFFICIAL RECORD OF THIS SHEET IS THE ELECTRONIC FILE DIGITALLY SIGNED AND SEALED UNDER RULE 61G15-23.004, F.A.C.


8/5/2024 4:28:54 PM BeattyM
c:\pw_work\sh_pw\pw_user\0439575\PLAINRD01.dgn

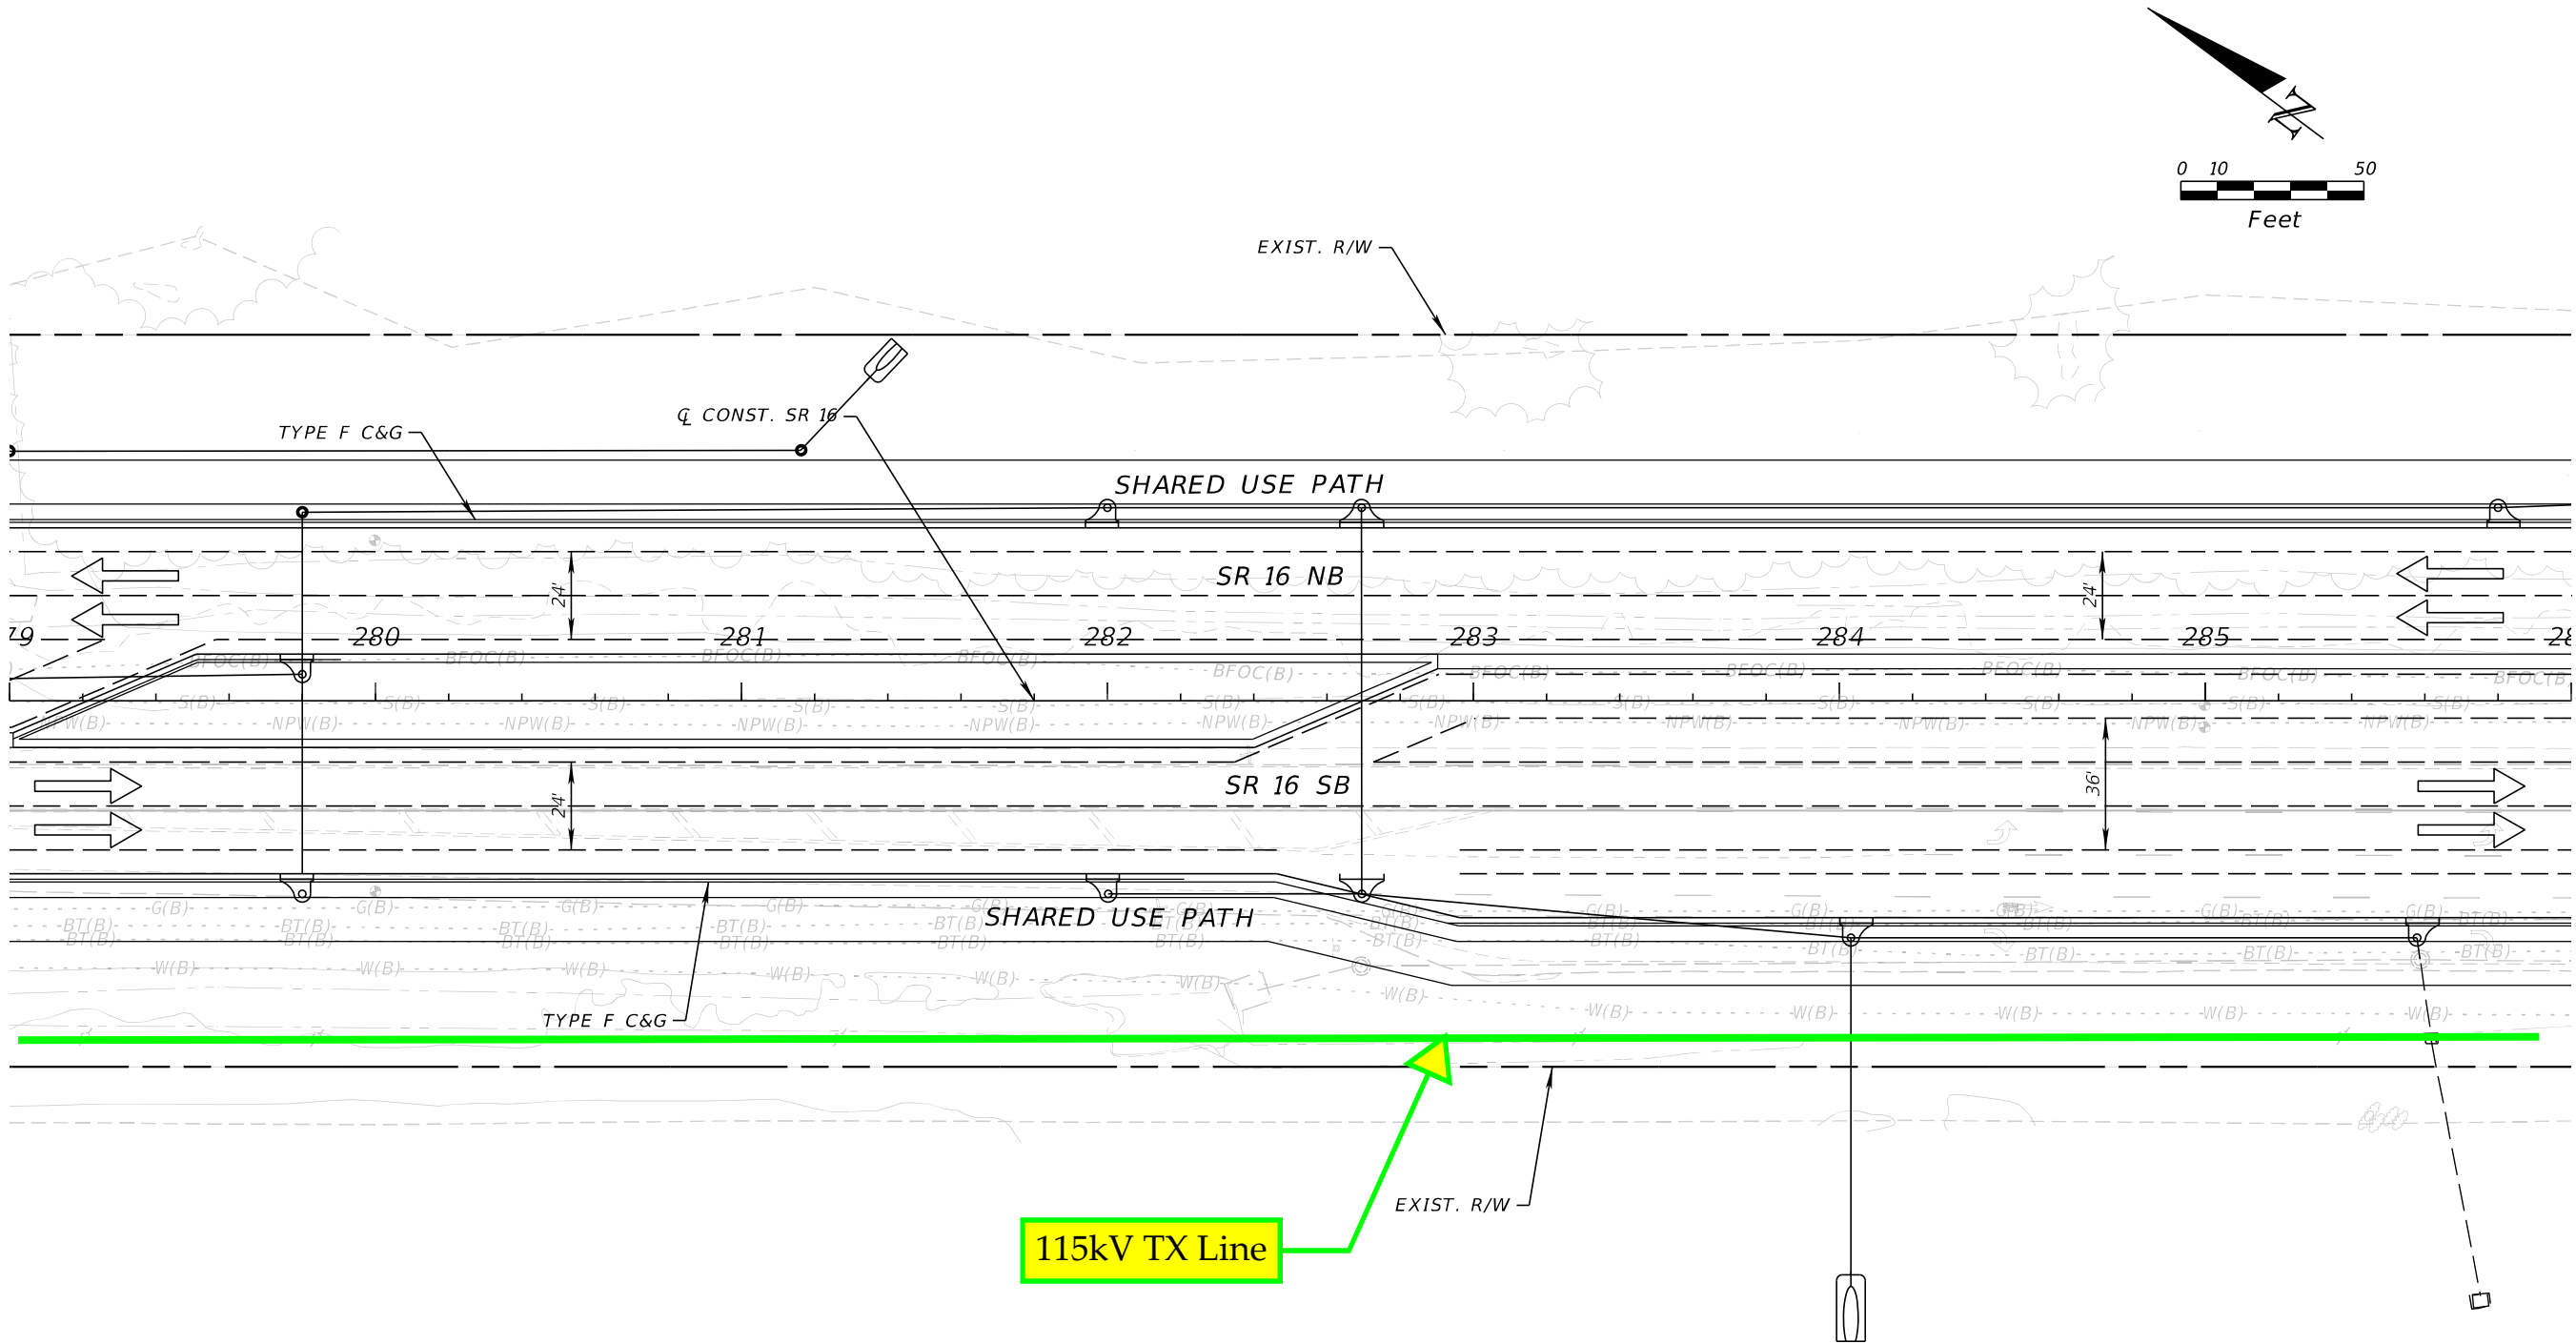

| REVISIONS | | | | ENGINEER OF RECORD | STATE OF FLORIDA DEPARTMENT OF TRANSPORTATION | | | SHEET NO. |
|-----------|-------------|------|-------------|---|--|-----------|----------------------|-----------------------|
| DATE | DESCRIPTION | DATE | DESCRIPTION | | ROAD NO. | COUNTY | FINANCIAL PROJECT ID | |
| | | | | STEPHEN J. PARK, P.E. LICENSE NUMBER: 77656 RS&H, INC. 10748 DEERWOOD PARK BLVD. SOUTH JACKSONVILLE, FL 32256 | SR 16 | ST. JOHNS | 210447-5-52-01 | 11x17 Plan Only |

THE OFFICIAL RECORD OF THIS SHEET IS THE ELECTRONIC FILE DIGITALLY SIGNED AND SEALED UNDER RULE 61G15-23.004, F.A.C.


8/5/2024 4:28:55 PM BeattyM
c:\pw_work\sh_pw\pw_user\0439575\PLAINRD01.dgn

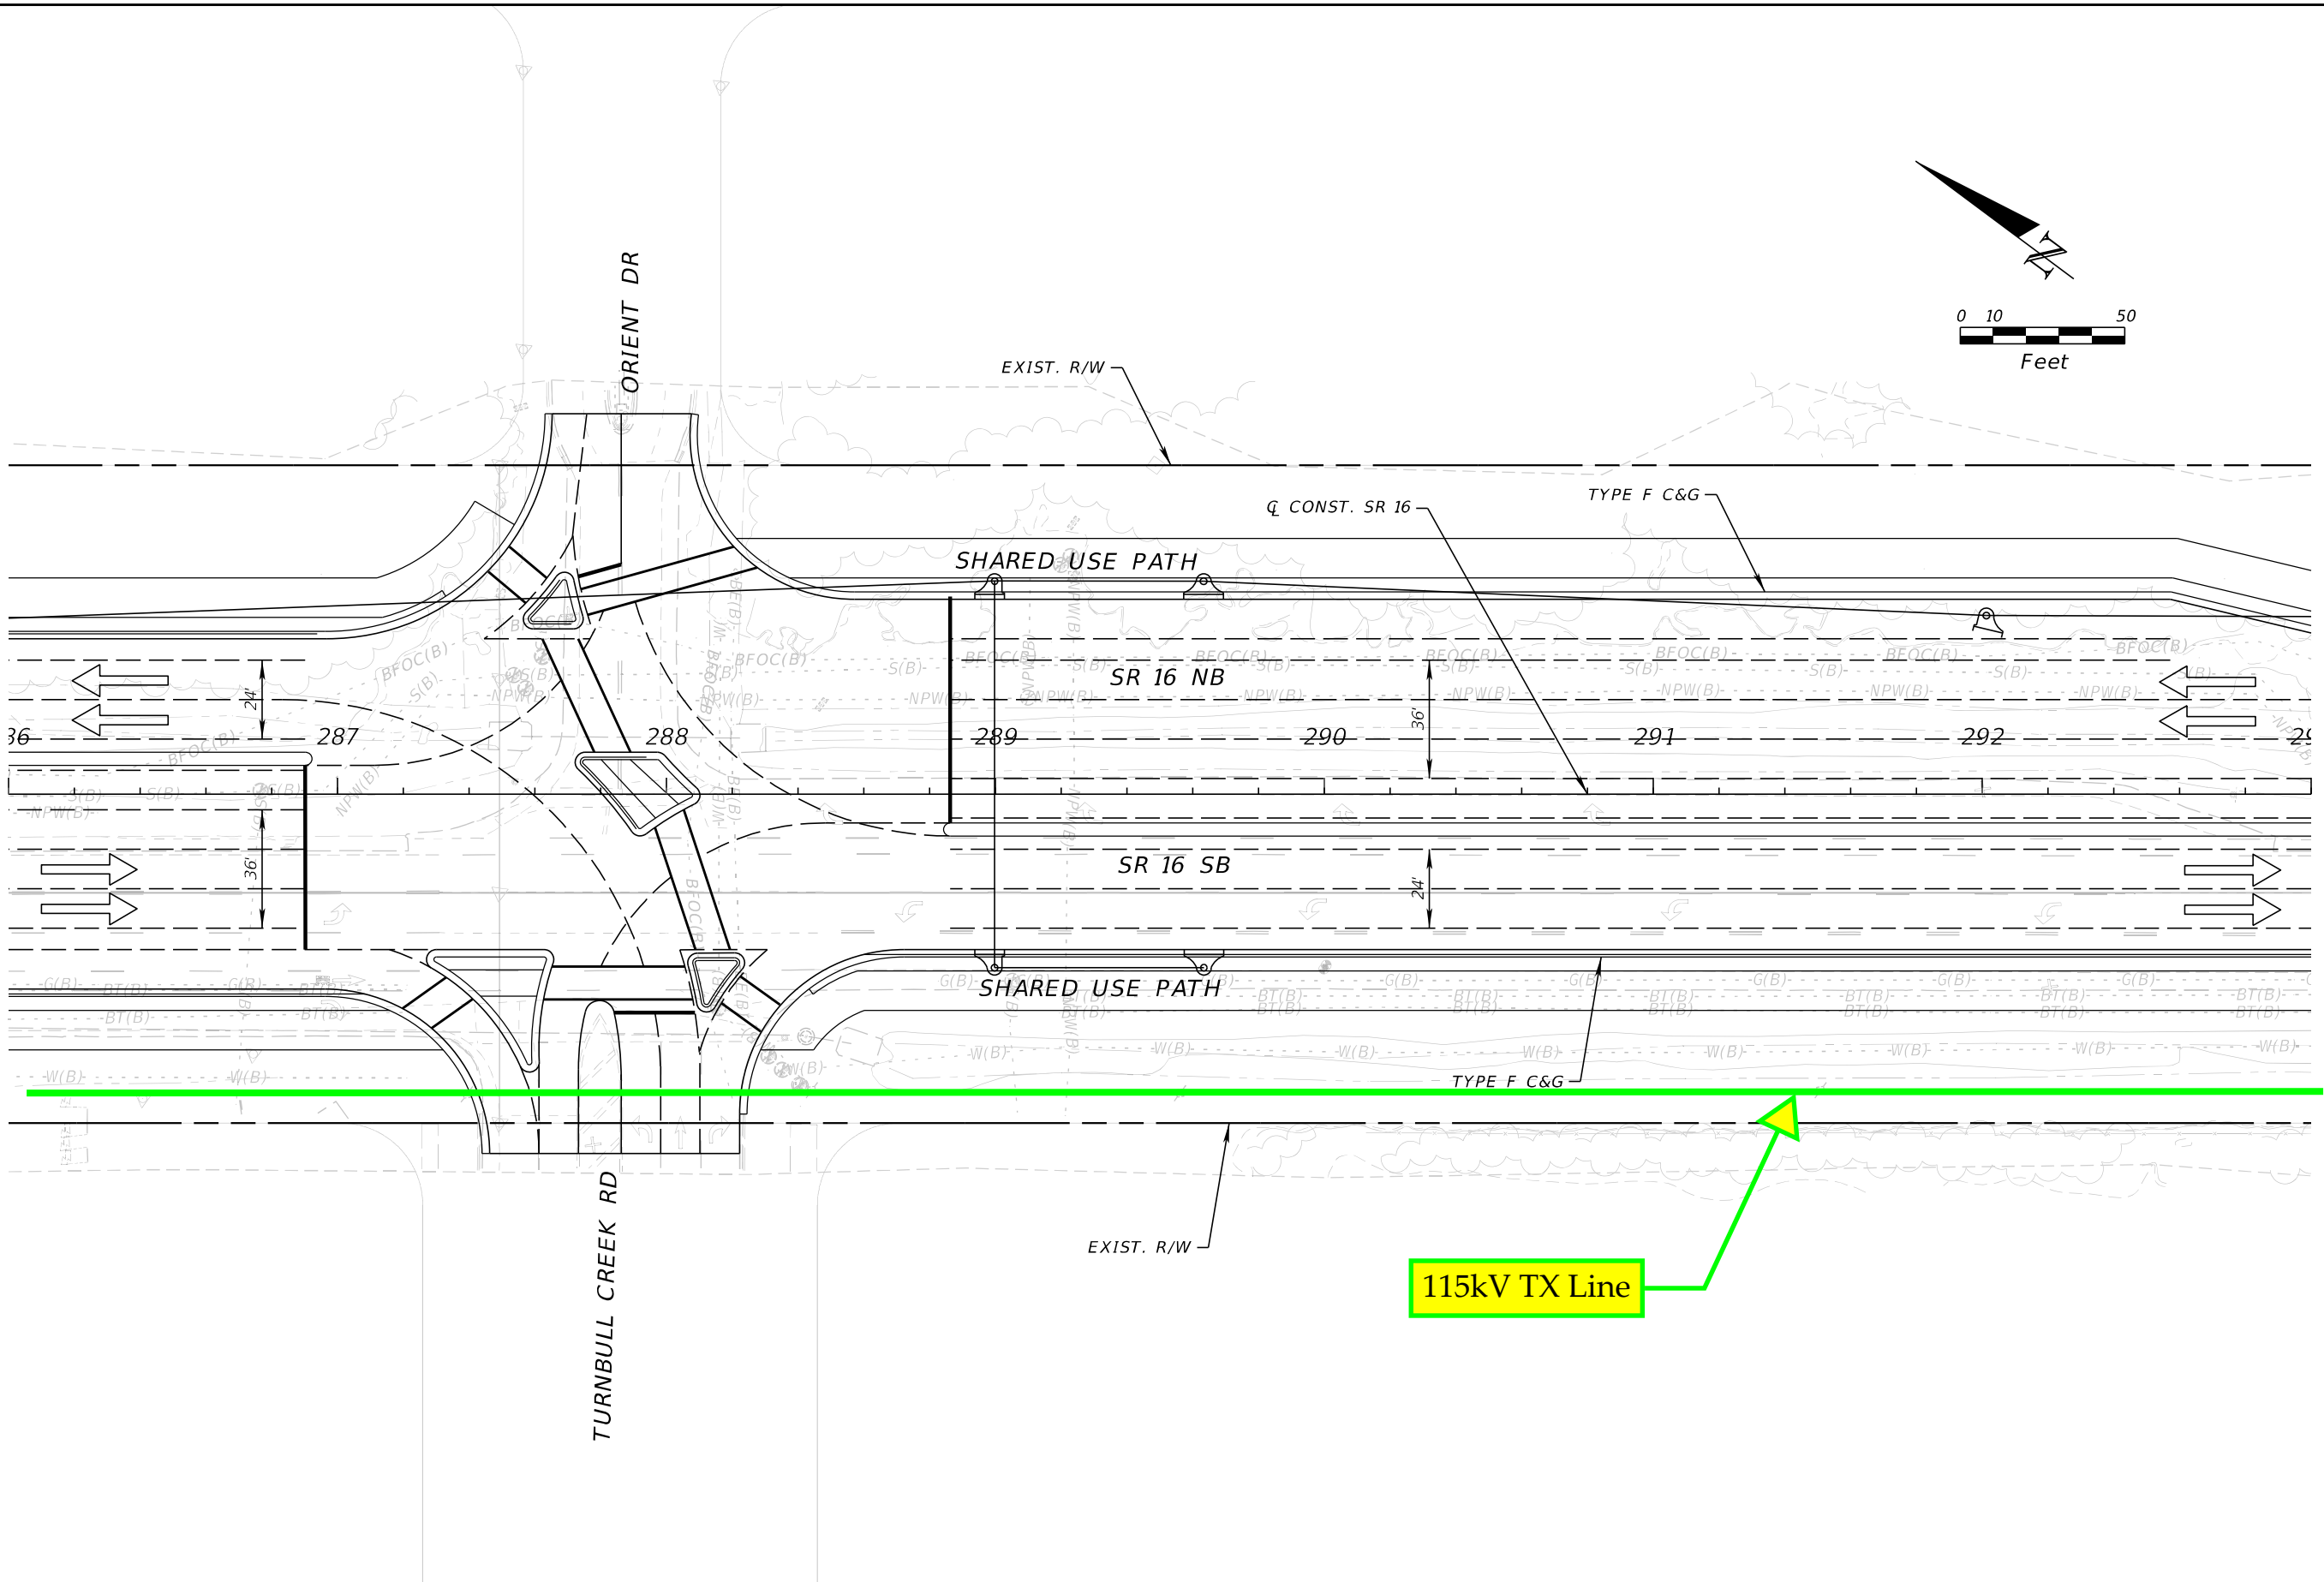

| REVISIONS | | | | ENGINEER OF RECORD | STATE OF FLORIDA DEPARTMENT OF TRANSPORTATION | | | SHEET NO. |
|-----------|-------------|------|-------------|---|--|-----------|----------------------|-----------------------|
| DATE | DESCRIPTION | DATE | DESCRIPTION | | ROAD NO. | COUNTY | FINANCIAL PROJECT ID | |
| | | | | | SR 16 | ST. JOHNS | 210447-5-52-01 | |
| | | | | STEPHEN J. PARK, P.E. LICENSE NUMBER: 77656 RS&H, INC. 10748 DEERWOOD PARK BLVD. SOUTH JACKSONVILLE, FL 32256 | | | | 11x17 Plan Only |

THE OFFICIAL RECORD OF THIS SHEET IS THE ELECTRONIC FILE DIGITALLY SIGNED AND SEALED UNDER RULE 61G15-23.004, F.A.C.


8/5/2024 4:28:55 PM BeattyM
c:\pw_work\ysh_pw\pw_user\00439575\PLANRD01.dgn

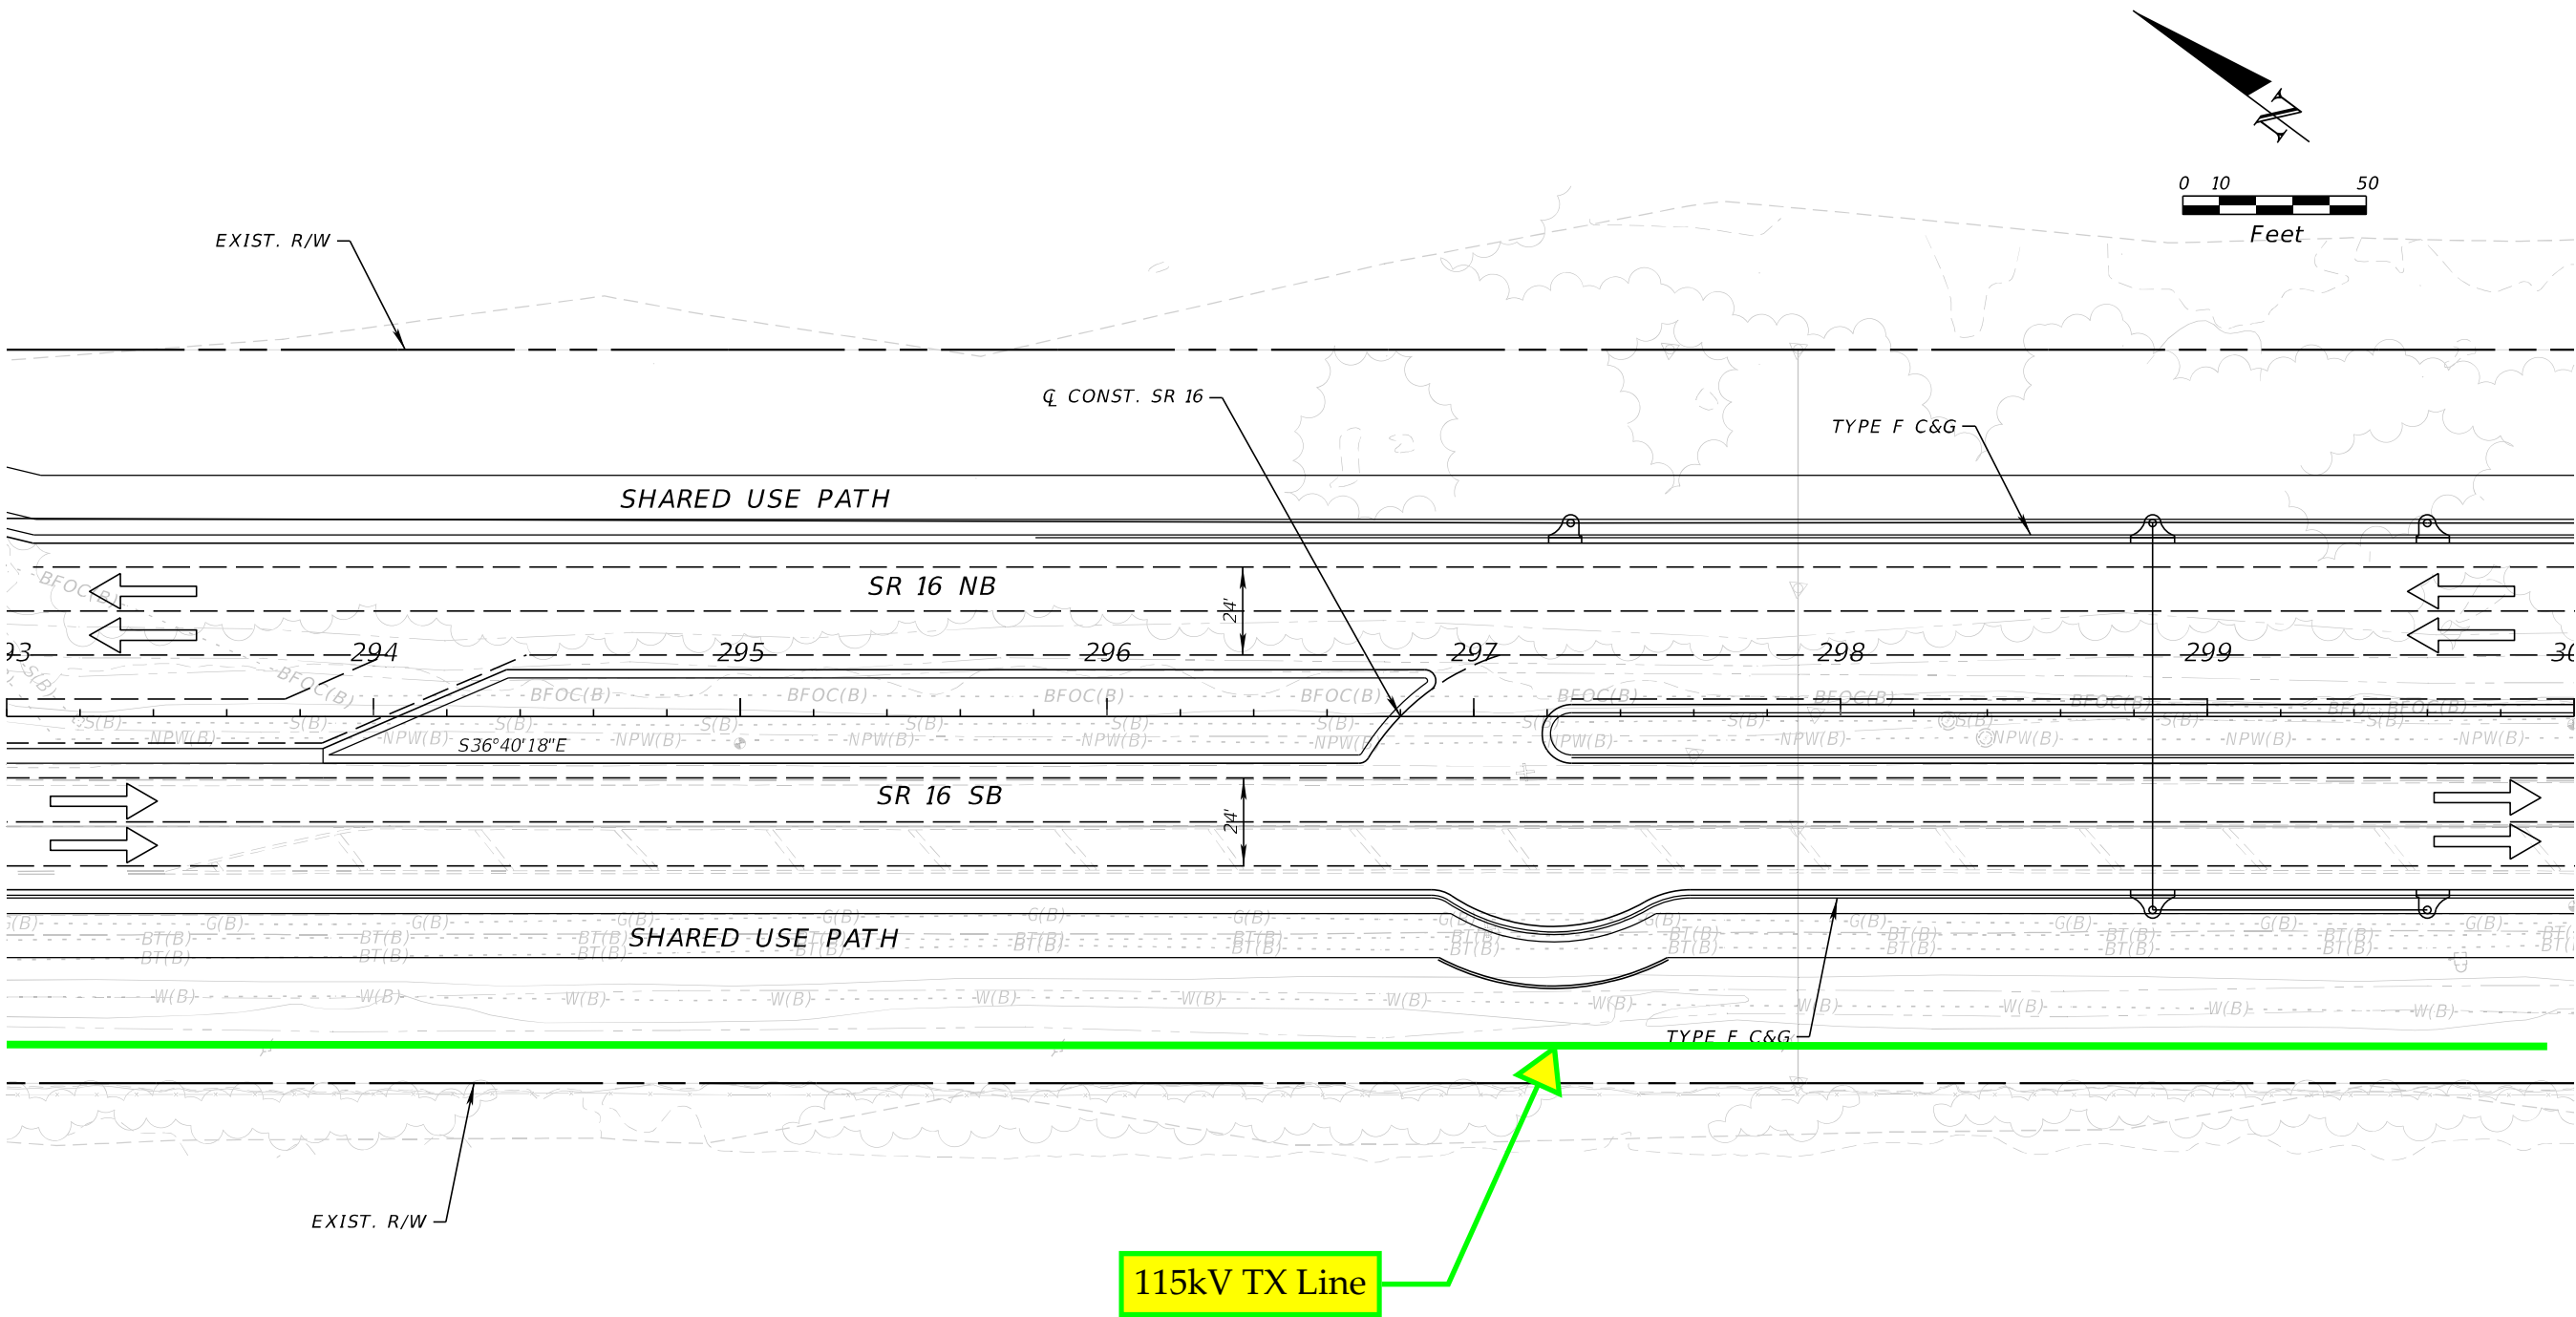

| REVISIONS | | | | ENGINEER OF RECORD | STATE OF FLORIDA DEPARTMENT OF TRANSPORTATION | | | SHEET NO. |
|-----------|-------------|------|-------------|---|--|-----------|----------------------|-----------------------|
| DATE | DESCRIPTION | DATE | DESCRIPTION | STEPHEN J. PARK, P.E. LICENSE NUMBER: 77656 RS&H, INC. 10748 DEERWOOD PARK BLVD. SOUTH JACKSONVILLE, FL 32256 | ROAD NO. | COUNTY | FINANCIAL PROJECT ID | |
| | | | | | SR 16 | ST. JOHNS | 210447-5-52-01 | |
| | | | | | | | | 11x17 Plan Only |

THE OFFICIAL RECORD OF THIS SHEET IS THE ELECTRONIC FILE DIGITALLY SIGNED AND SEALED UNDER RULE 61G15-23.004, F.A.C.


8/5/2024 4:28:56 PM BeattyM
c:\pw_work\ysh_pw\pw_user\00439575\PLANRD01.dgn

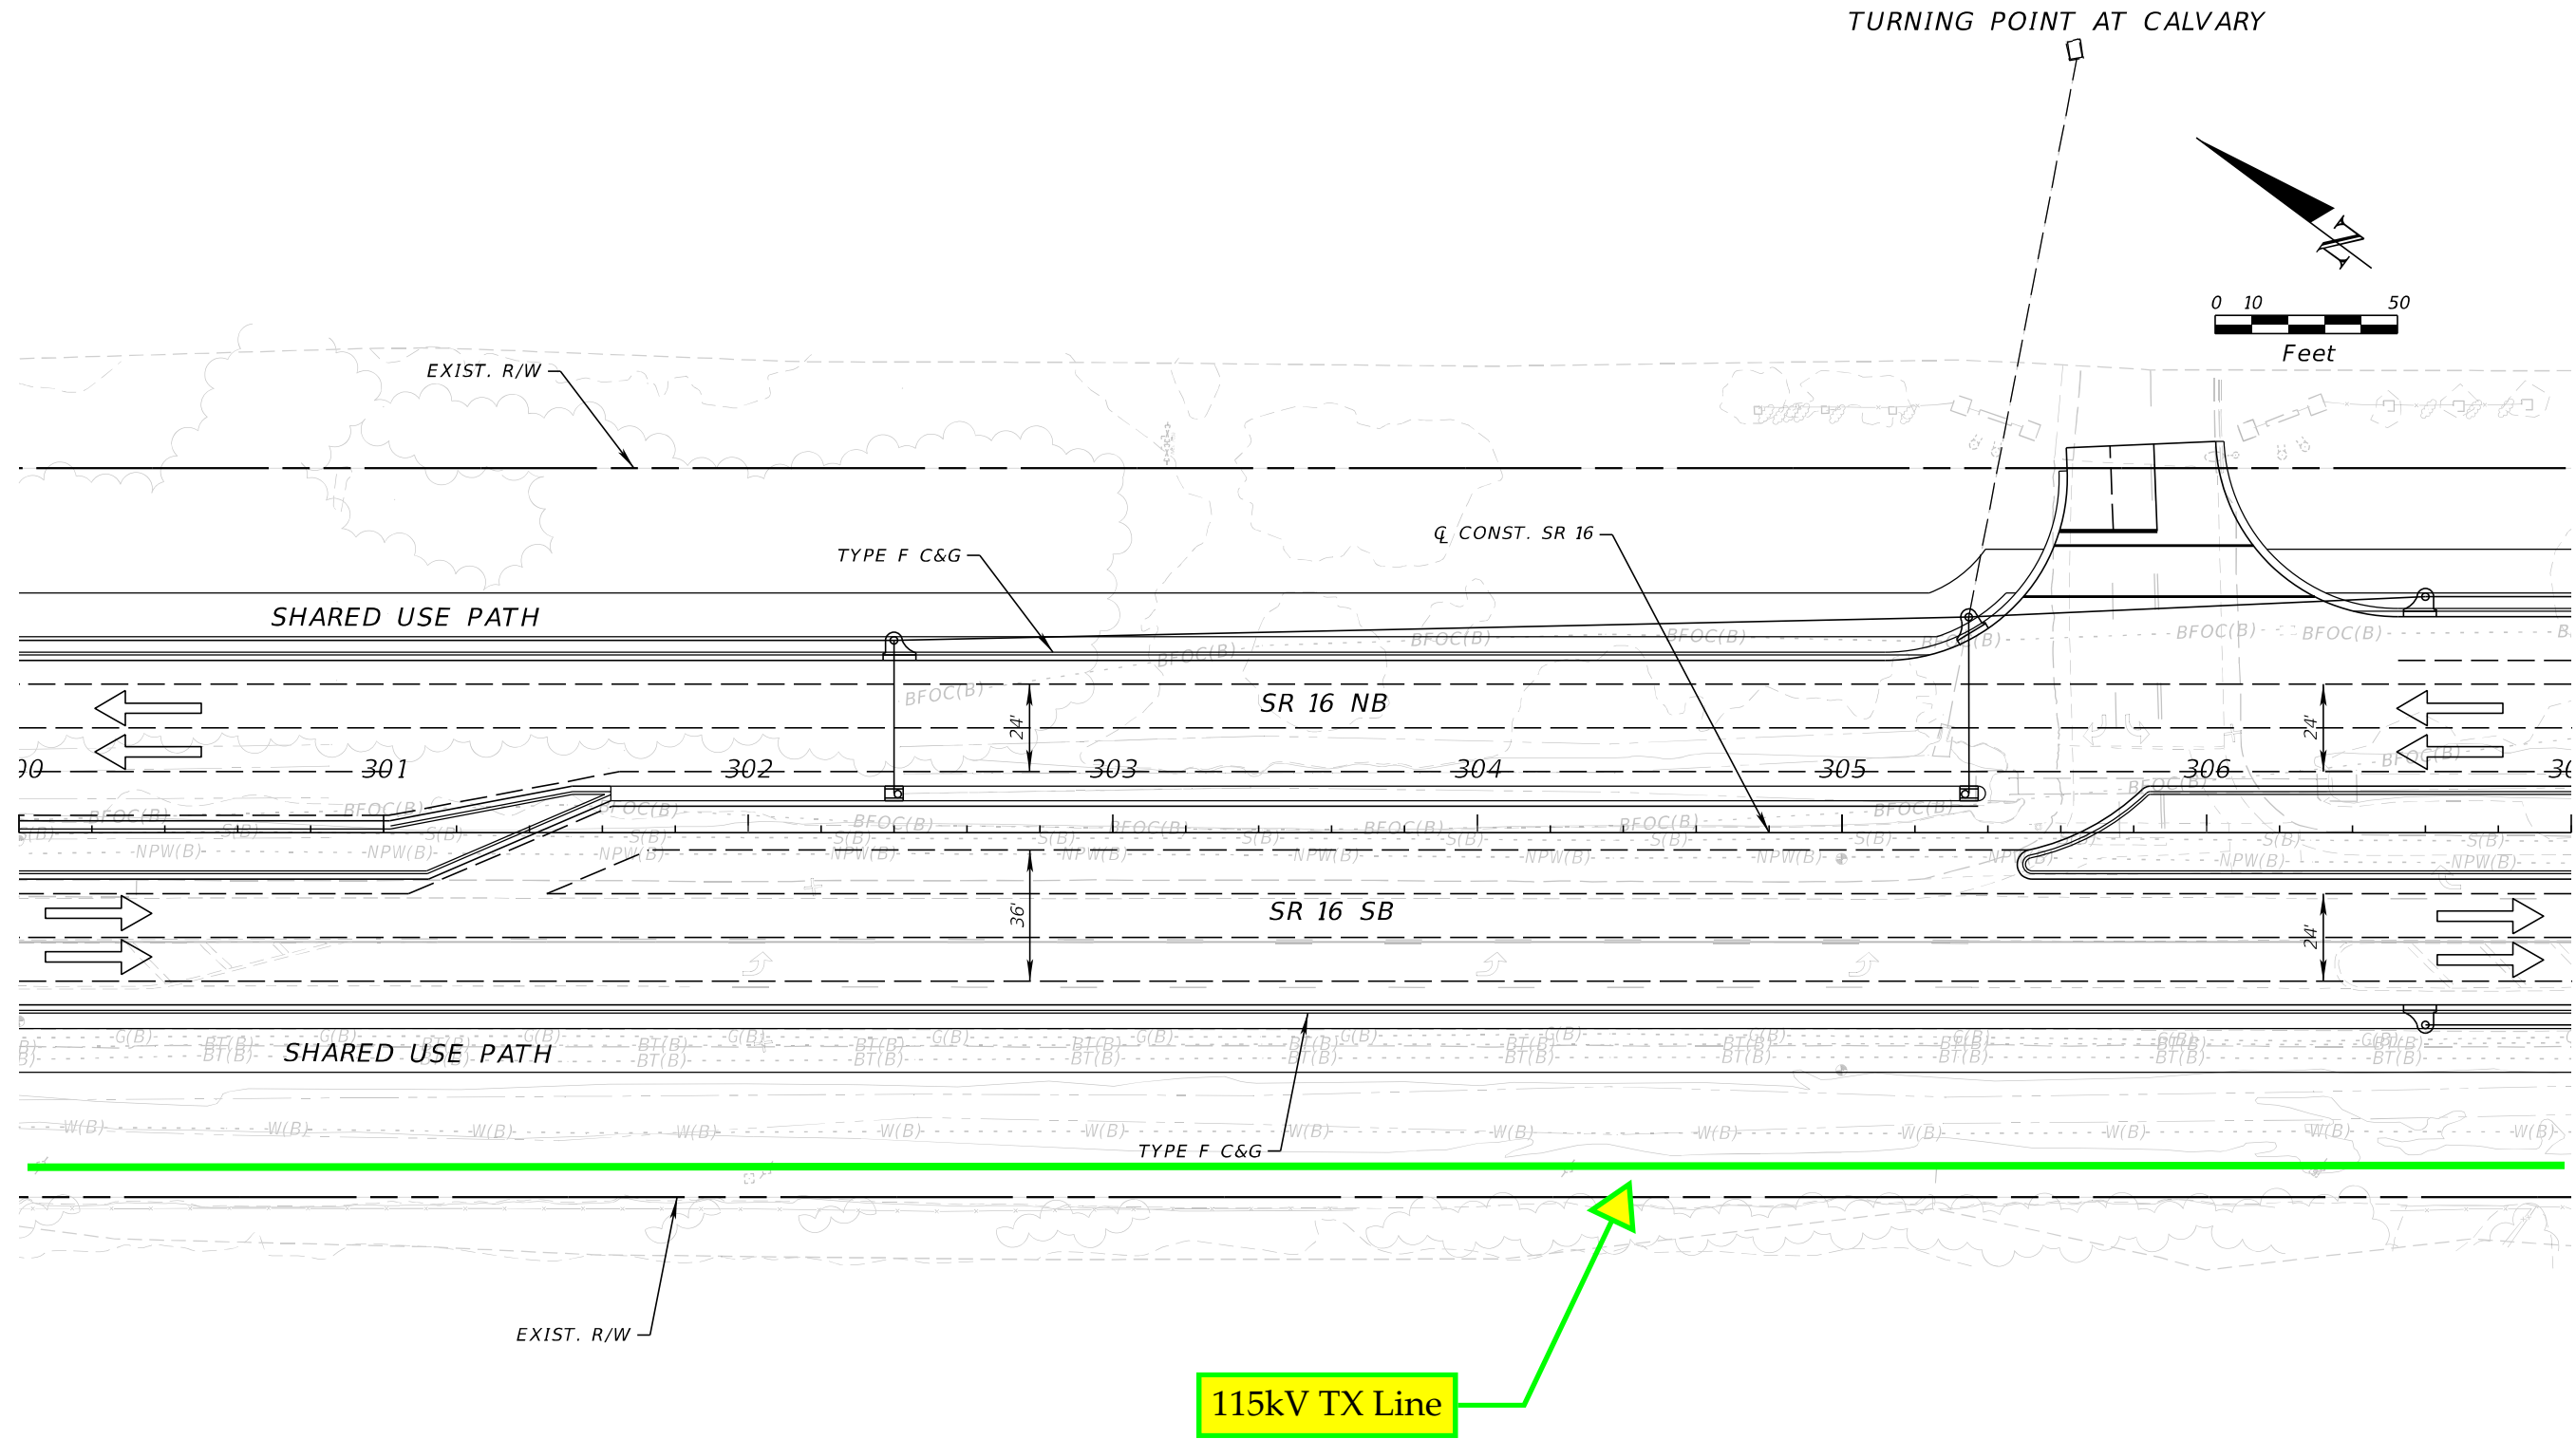

| REVISIONS | | | | ENGINEER OF RECORD | | STATE OF FLORIDA DEPARTMENT OF TRANSPORTATION | | | SHEET NO. |
|-----------|-------------|------|-------------|---|--|--|-----------|----------------------|--------------|
| DATE | DESCRIPTION | DATE | DESCRIPTION | STEPHEN J. PARK, P.E. LICENSE NUMBER: 77656 RS&H, INC. 10748 DEERWOOD PARK BLVD. SOUTH JACKSONVILLE, FL 32256 | | ROAD NO. | COUNTY | FINANCIAL PROJECT ID | |
| | | | | | | SR 16 | ST. JOHNS | 210447-5-52-01 | |

THE OFFICIAL RECORD OF THIS SHEET IS THE ELECTRONIC FILE DIGITALLY SIGNED AND SEALED UNDER RULE 61G15-23.004, F.A.C.


8/5/2024 4:28:57 PM BeattyM
c:\pw_work\ysh_pw\pw_user\00439575\PLANRD01.dgn

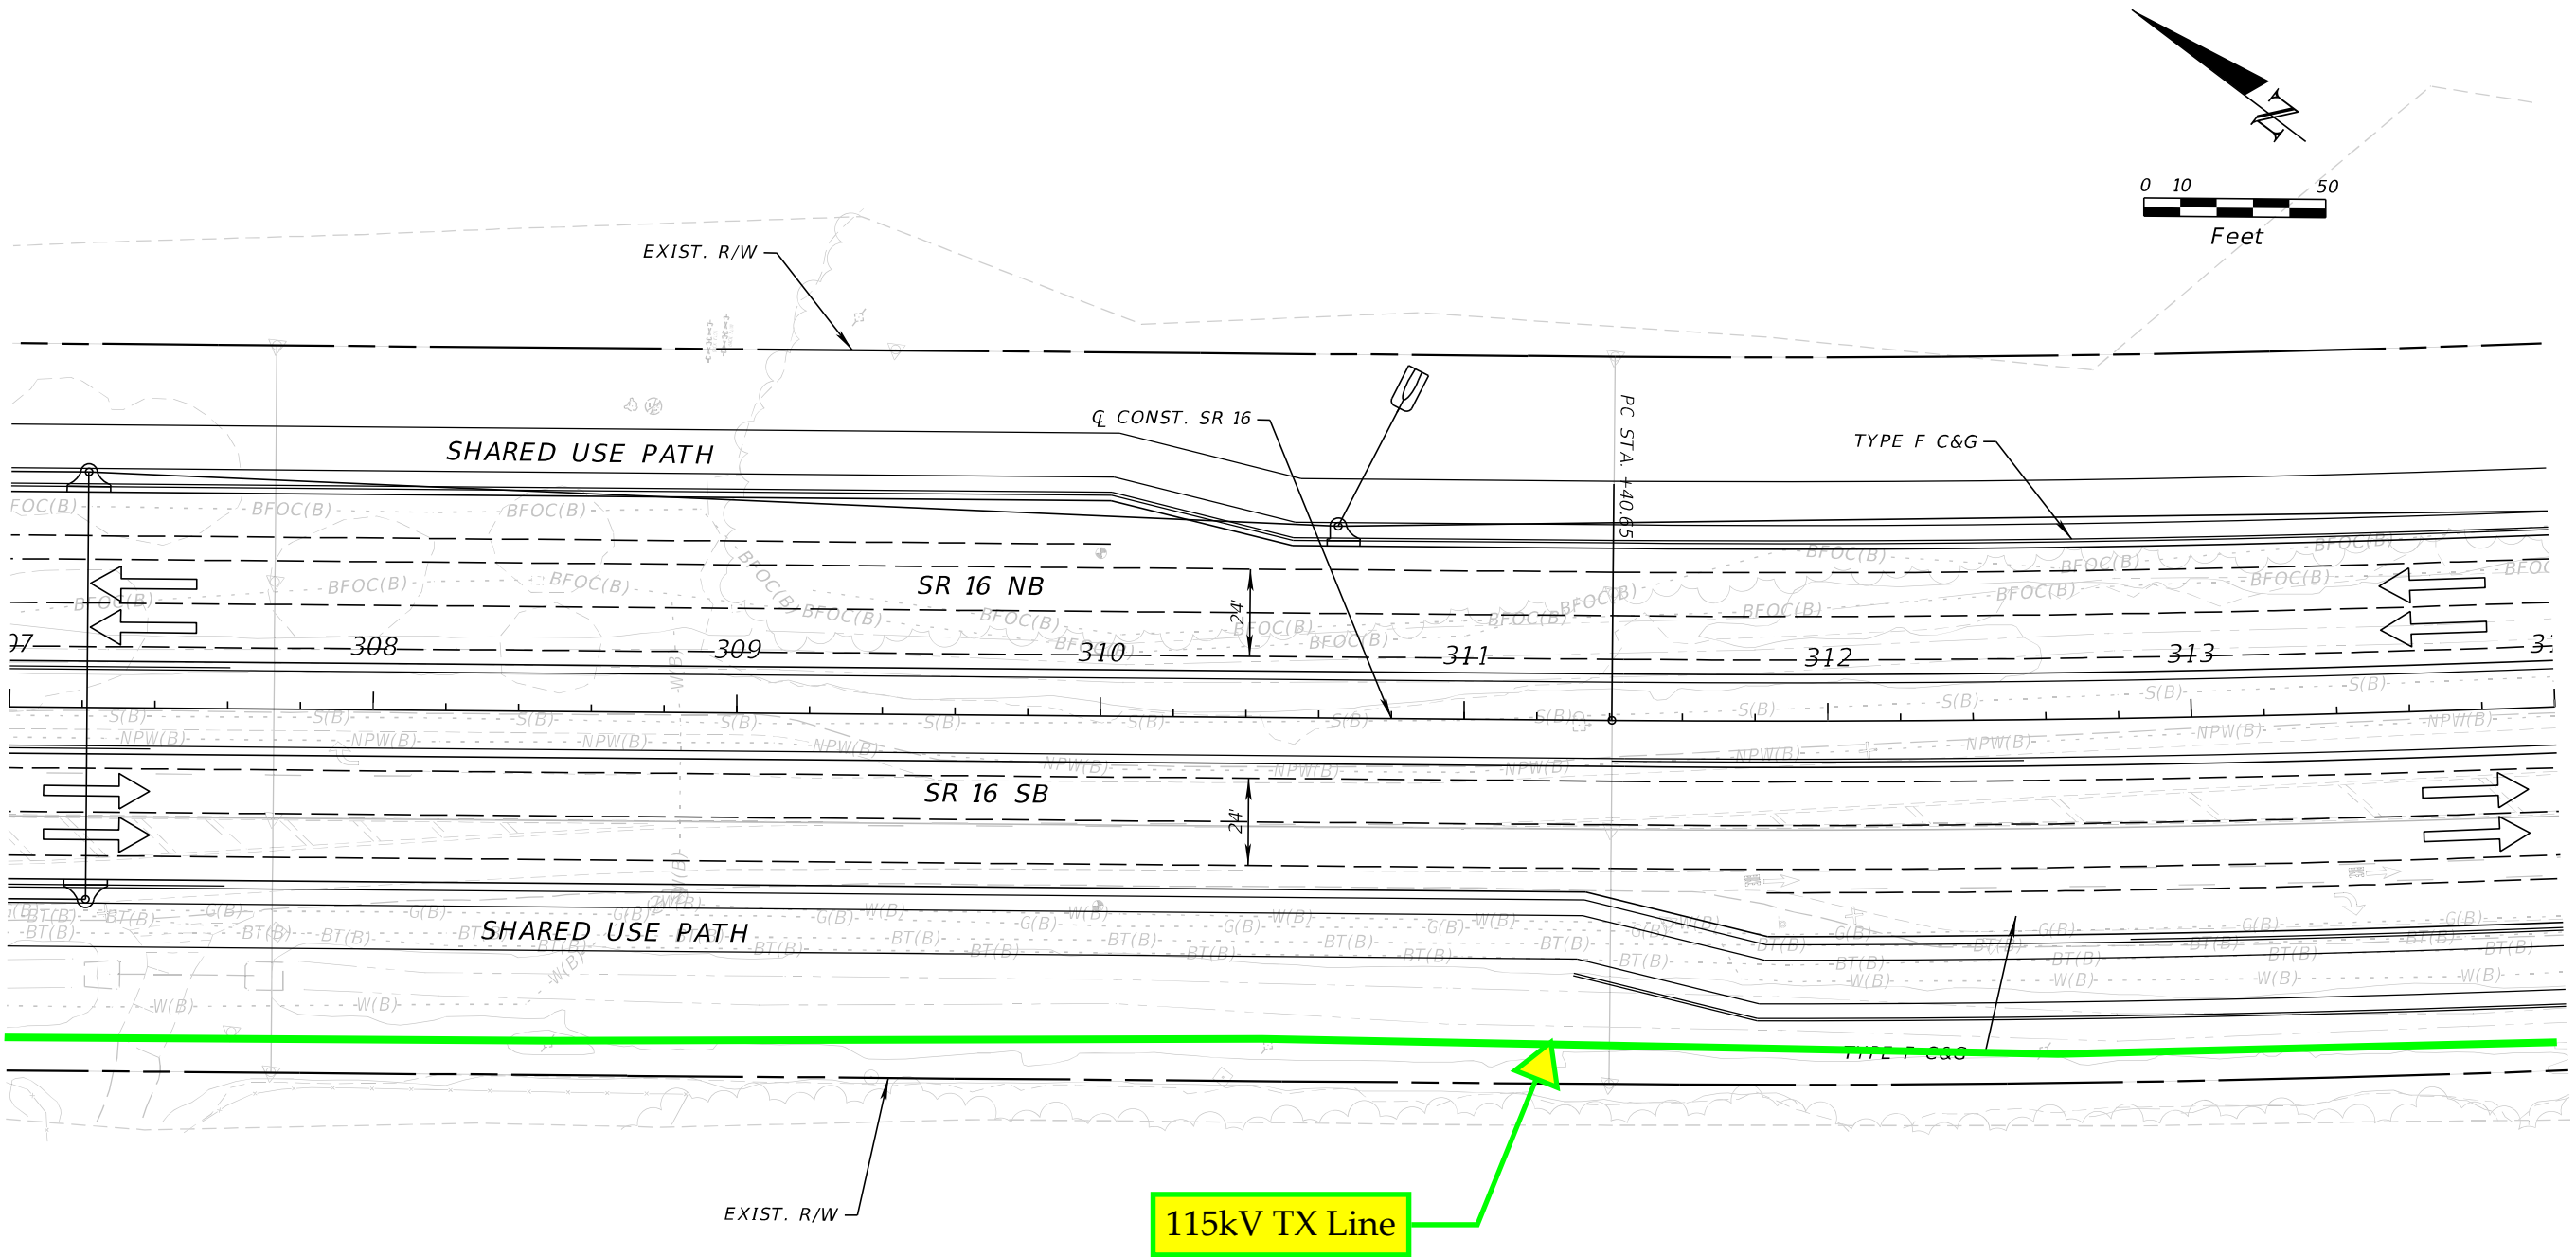

| REVISIONS | | | | ENGINEER OF RECORD | STATE OF FLORIDA DEPARTMENT OF TRANSPORTATION | | | SHEET NO. | | |
|-----------|-------------|--|------|--------------------|--|---|--------|--------------|----------------------|-----------------------|
| DATE | DESCRIPTION | | DATE | DESCRIPTION | | ROAD NO. | COUNTY | | FINANCIAL PROJECT ID | |
| | | | | | | STEPHEN J. PARK, P.E. LICENSE NUMBER: 77656 RS&H, INC. 10748 DEERWOOD PARK BLVD. SOUTH JACKSONVILLE, FL 32256 | SR 16 | ST. JOHNS | 210447-5-52-01 | 11x17 Plan Only |

THE OFFICIAL RECORD OF THIS SHEET IS THE ELECTRONIC FILE DIGITALLY SIGNED AND SEALED UNDER RULE 61G15-23.004, F.A.C.



8/5/2024 4:28:57 PM BeattyM
c:\pw_work\ysh_pw\pw_user\0439575\PLAINRD01.dgn

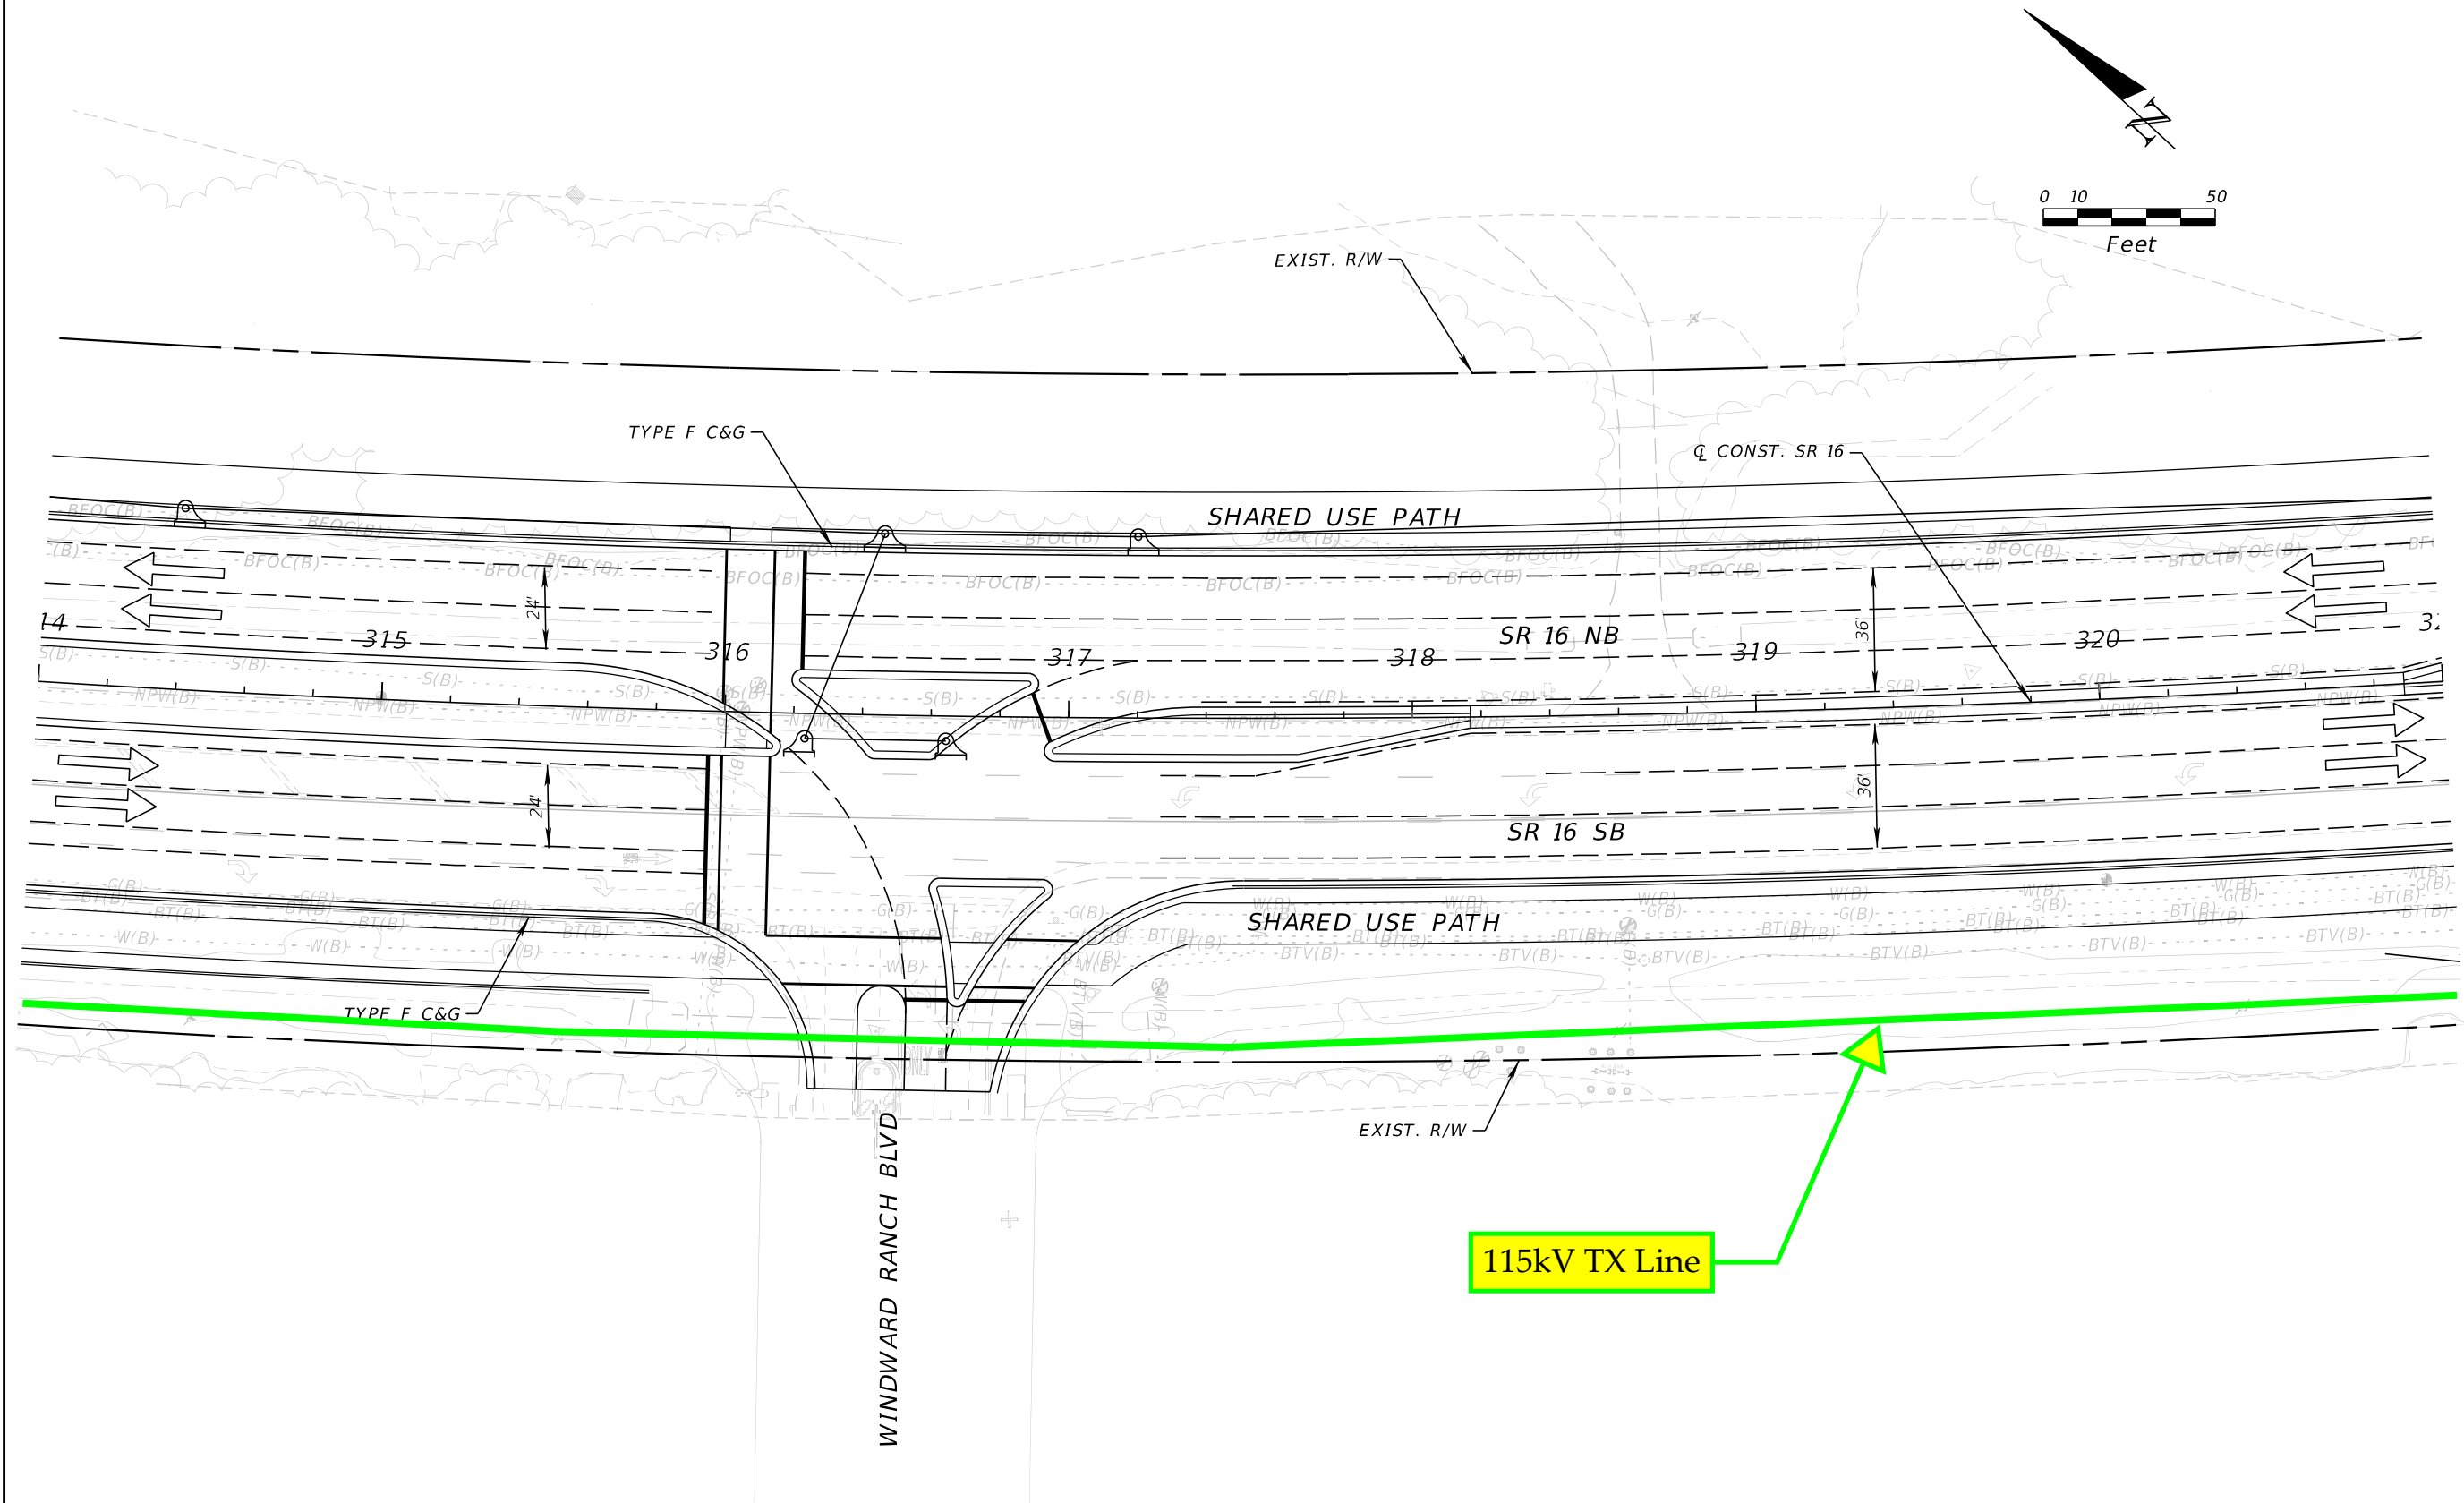

| REVISIONS | | | | ENGINEER OF RECORD | STATE OF FLORIDA DEPARTMENT OF TRANSPORTATION | | | SHEET NO. |
|-----------|-------------|------|-------------|---|--|-----------|----------------------|-----------------------|
| DATE | DESCRIPTION | DATE | DESCRIPTION | | ROAD NO. | COUNTY | FINANCIAL PROJECT ID | |
| | | | | | SR 16 | ST. JOHNS | 210447-5-52-01 | |
| | | | | STEPHEN J. PARK, P.E. LICENSE NUMBER: 77656 RS&H, INC. 10748 DEERWOOD PARK BLVD. SOUTH JACKSONVILLE, FL 32256 | | | | 11x17 Plan Only |

THE OFFICIAL RECORD OF THIS SHEET IS THE ELECTRONIC FILE DIGITALLY SIGNED AND SEALED UNDER RULE 61G15-23.004, F.A.C.

CURVE DATA
PI STA. = 321+12.24
Δ = 19°20'48" (LT)
D = 01°00'19"
T = 971.59
L = 1,924.68
R = 1,924.68
PC STA. = 311+40.65
PT STA. = 330+65.33
e = 0.000

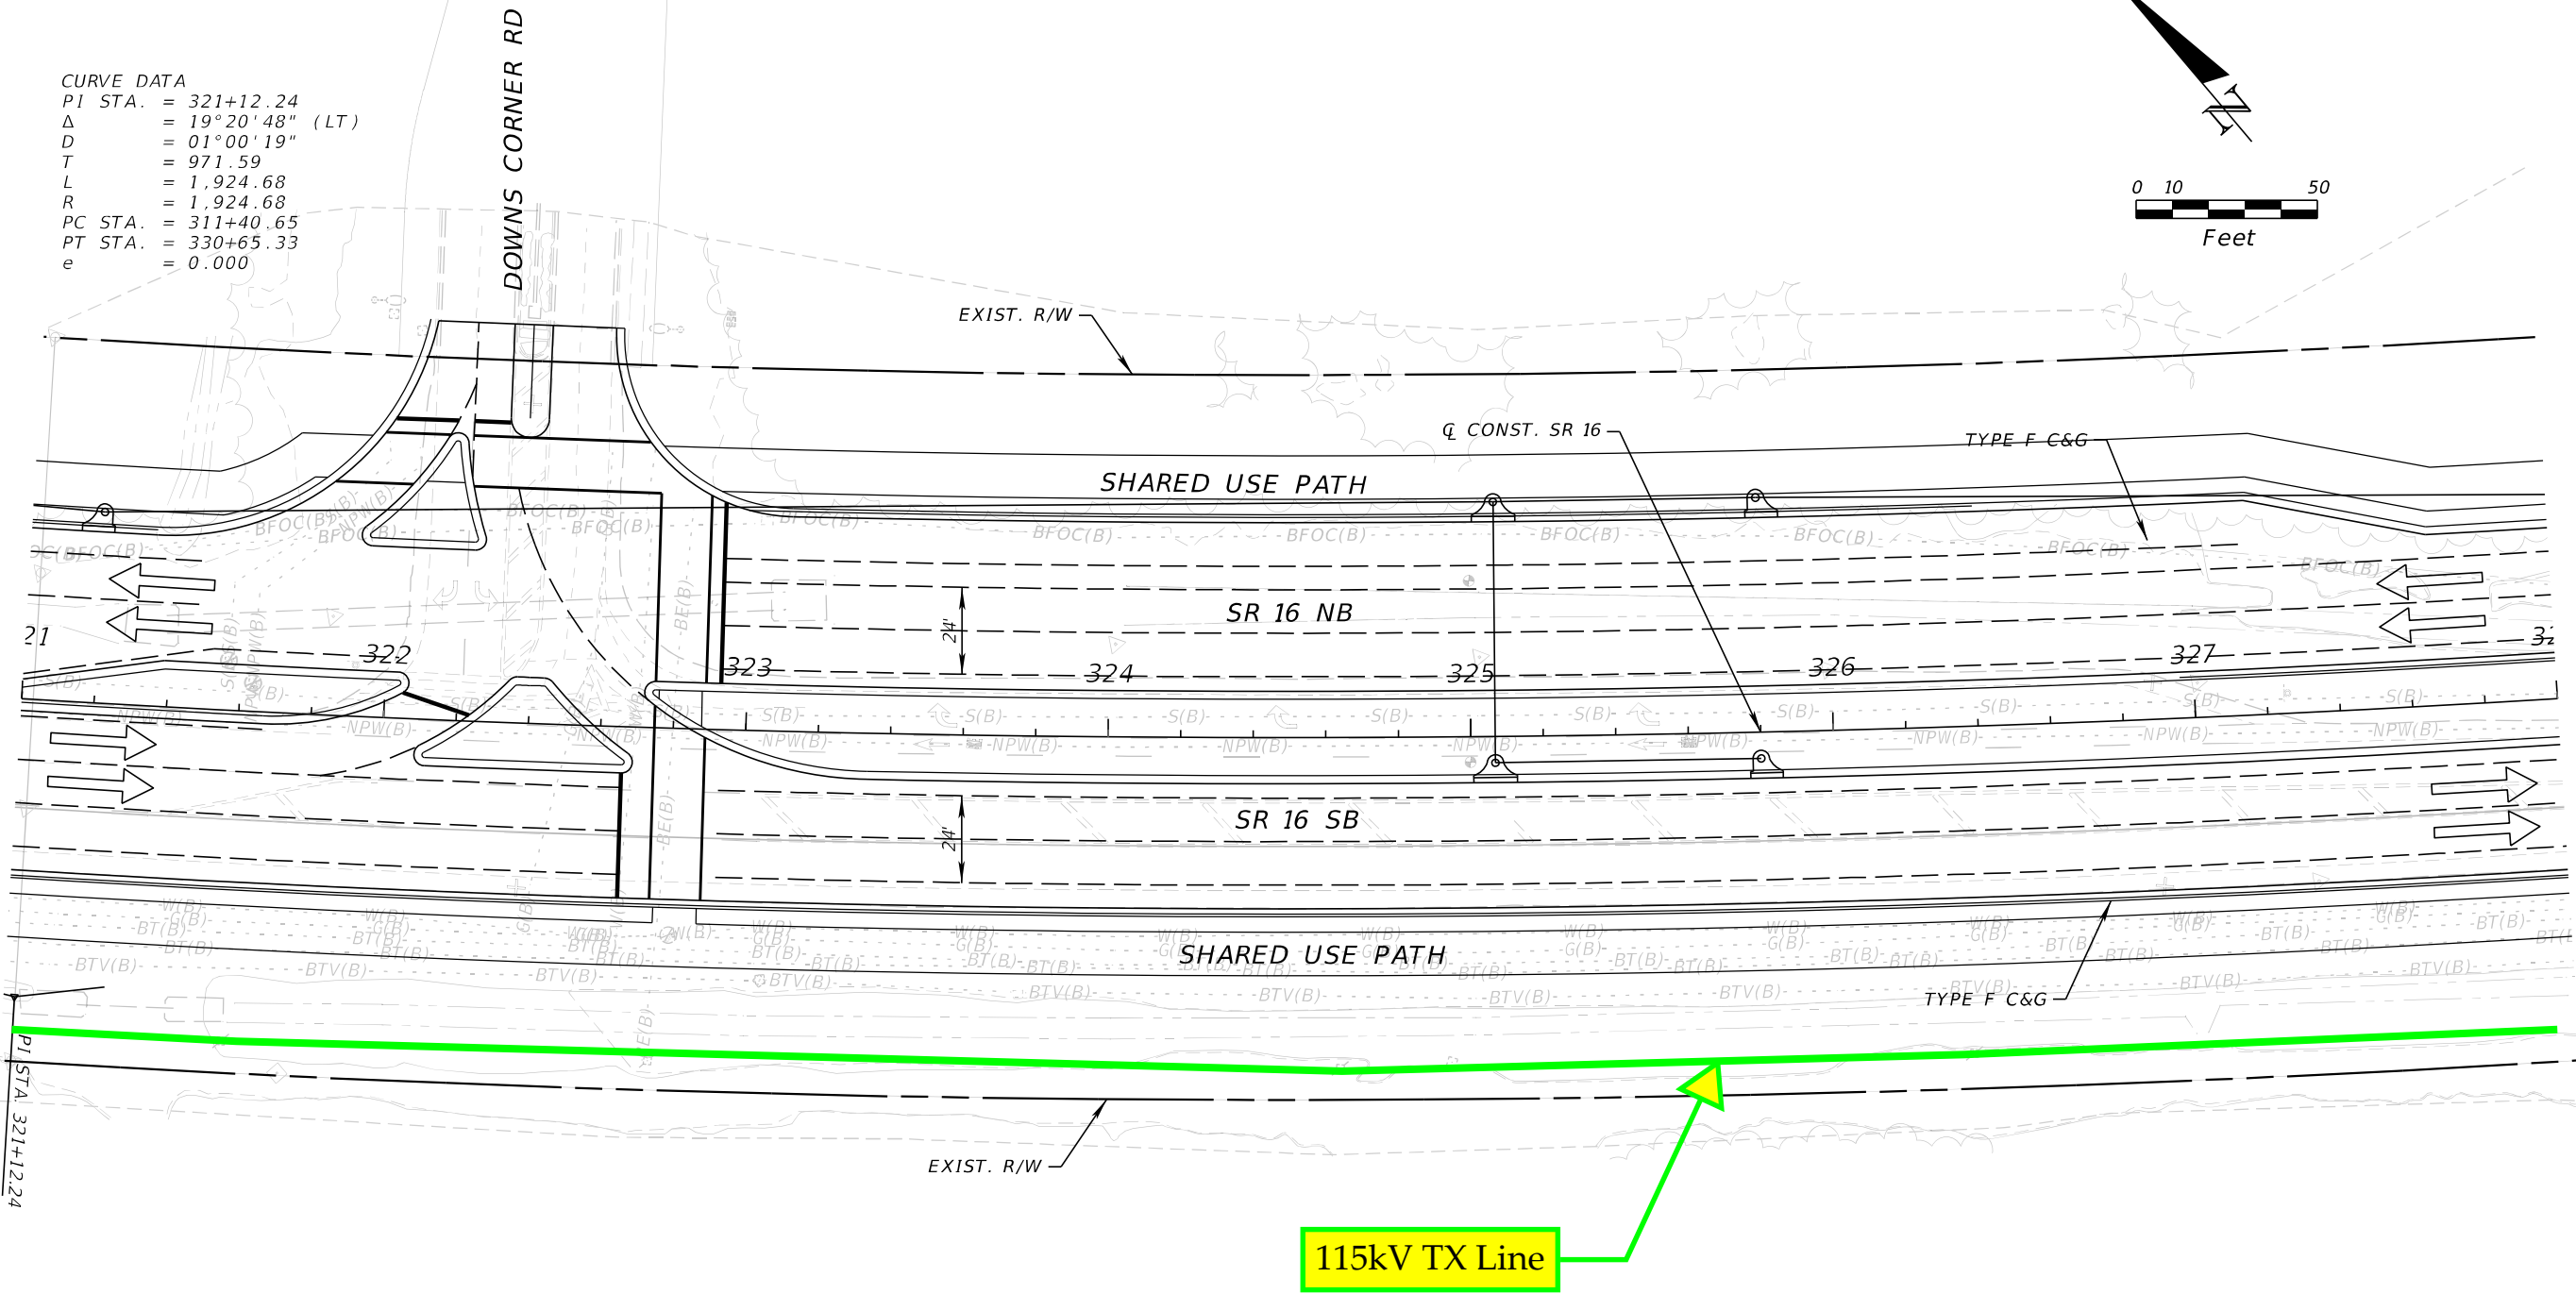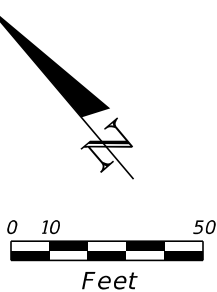


8/5/2024 4:28:58 PM BeattyM
c:\pw_work\ysh_pw\pw_user\0439575\PLAINRD01.dgn

| REVISIONS | | | | ENGINEER OF RECORD | | STATE OF FLORIDA DEPARTMENT OF TRANSPORTATION | | | SHEET NO. |
|-----------|-------------|------|-------------|---|--|--|-----------|----------------------|--------------|
| DATE | DESCRIPTION | DATE | DESCRIPTION | STEPHEN J. PARK, P.E. LICENSE NUMBER: 77656 RS&H, INC. 10748 DEERWOOD PARK BLVD. SOUTH JACKSONVILLE, FL 32256 | | ROAD NO. | COUNTY | FINANCIAL PROJECT ID | |
| | | | | | | SR 16 | ST. JOHNS | 210447-5-52-01 | |

THE OFFICIAL RECORD OF THIS SHEET IS THE ELECTRONIC FILE DIGITALLY SIGNED AND SEALED UNDER RULE 61G15-23.004, F.A.C.


8/5/2024 4:28:59 PM BeattyM
c:\pw_work\ysh_pw\pw_user\0439575\PLANRD01.dgn

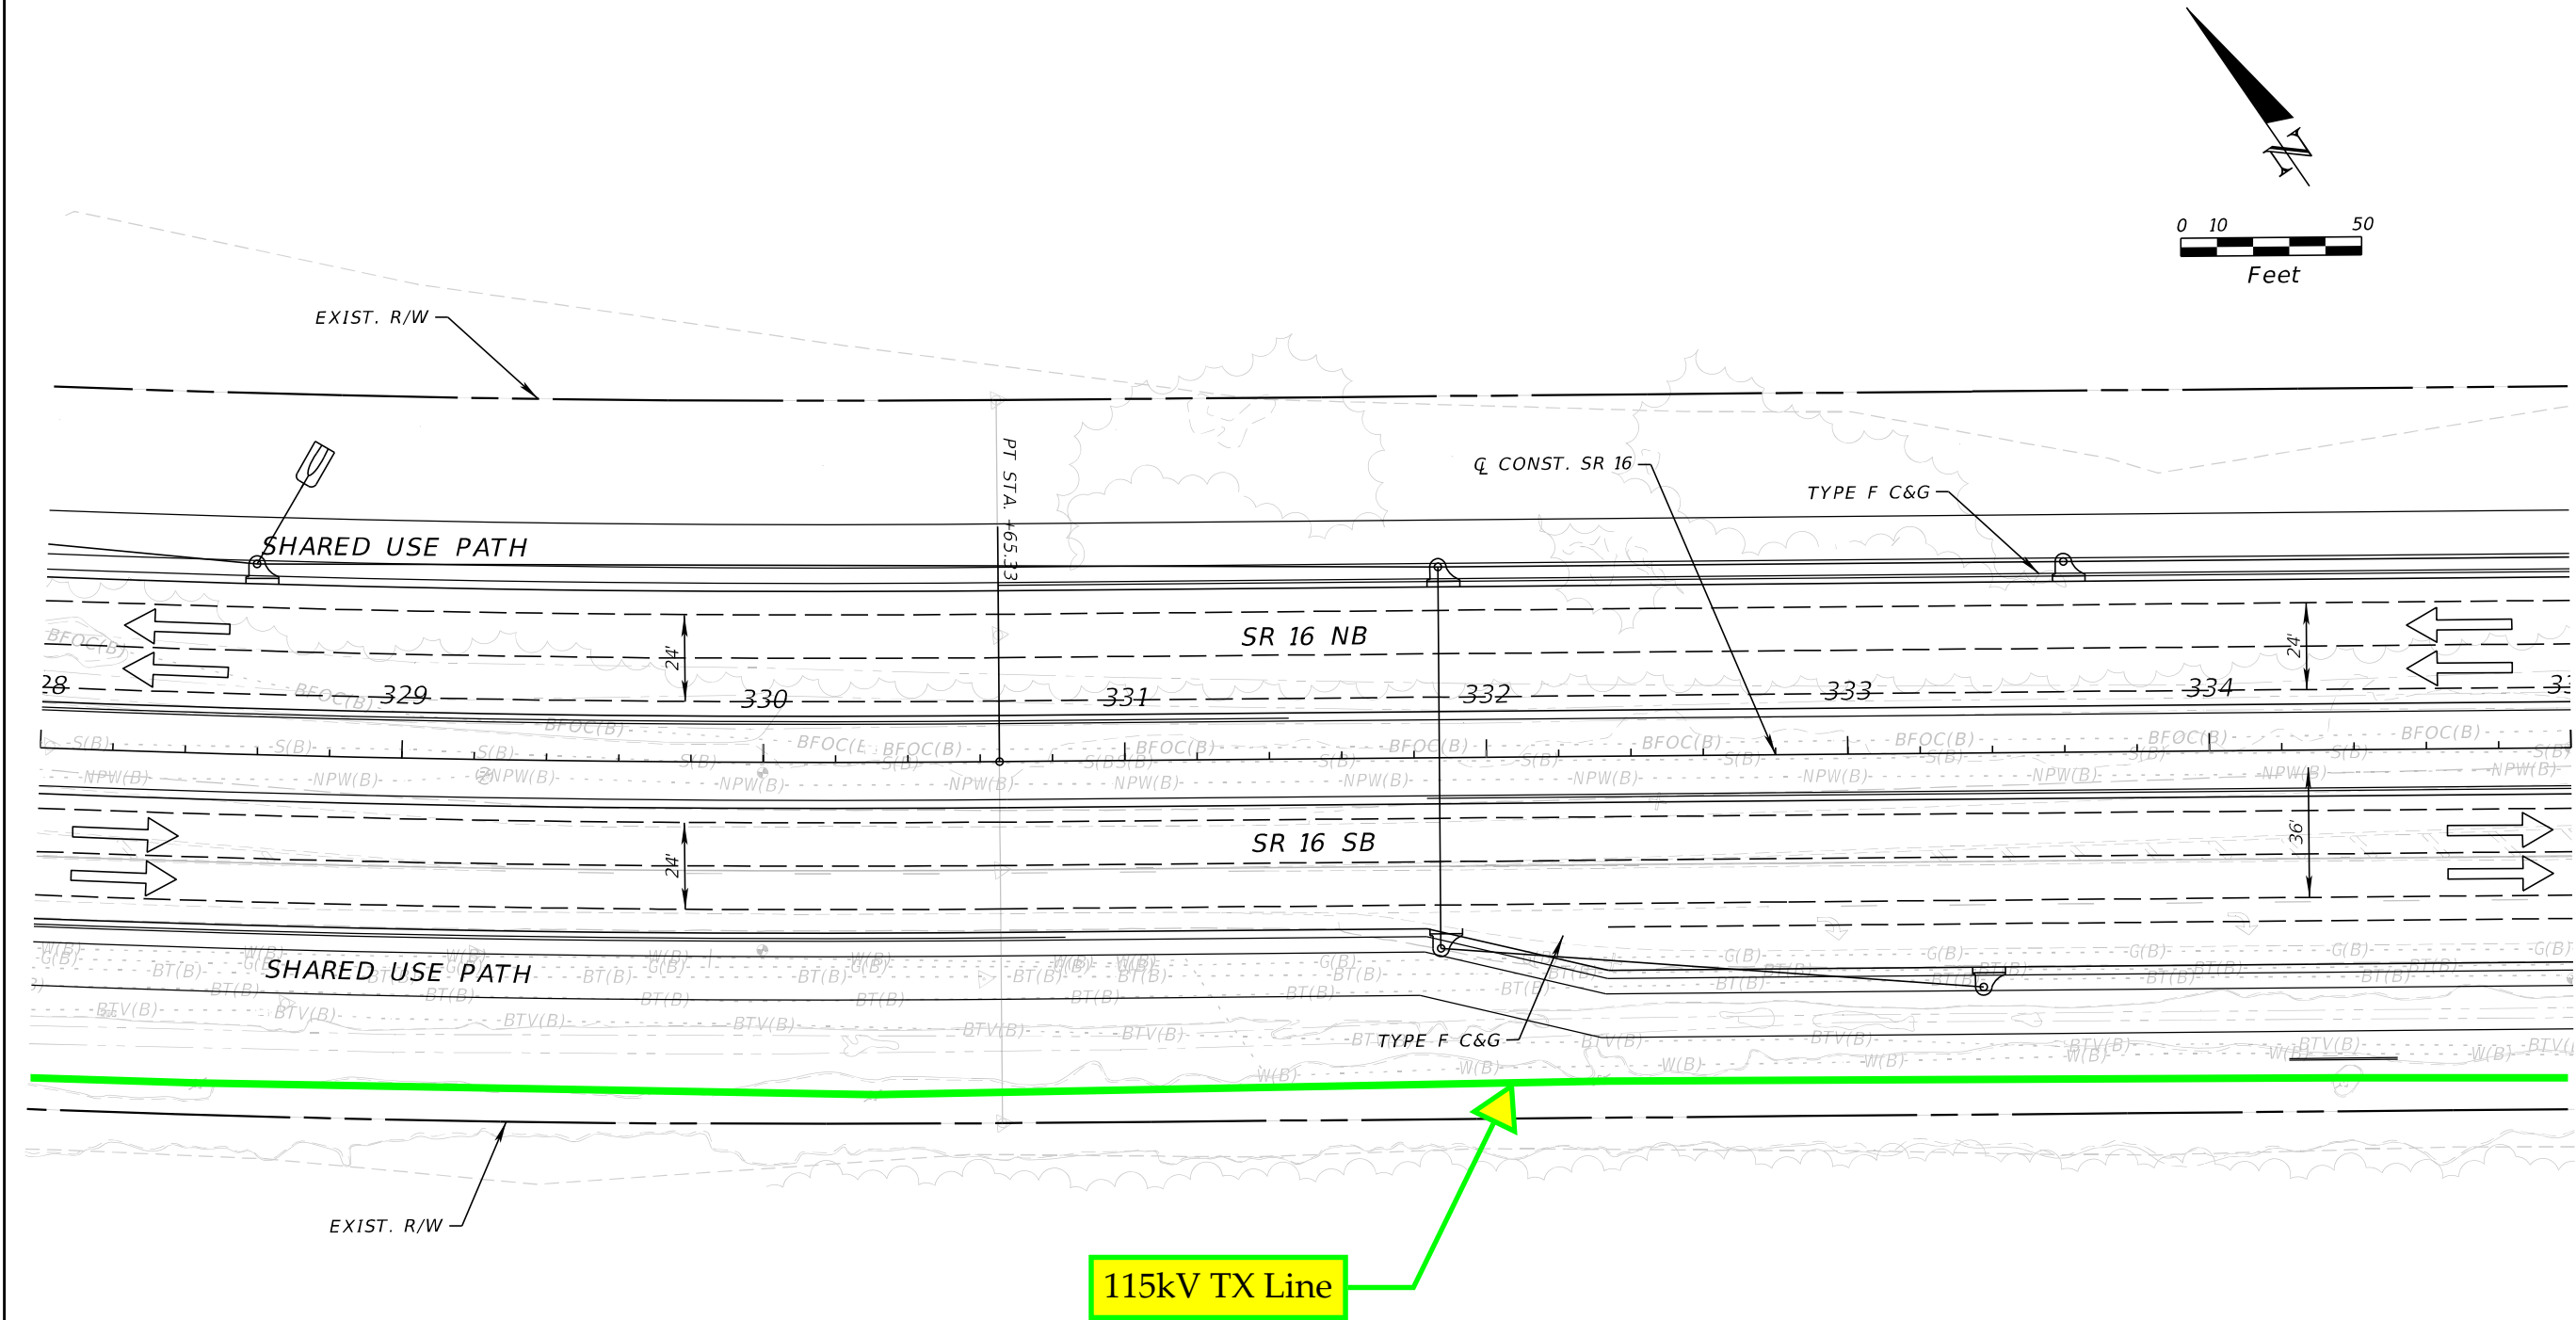

| REVISIONS | | | | ENGINEER OF RECORD | | STATE OF FLORIDA DEPARTMENT OF TRANSPORTATION | | | SHEET NO. |
|-----------|-------------|------|-------------|---|--|--|-----------|----------------------|--------------|
| DATE | DESCRIPTION | DATE | DESCRIPTION | STEPHEN J. PARK, P.E. LICENSE NUMBER: 77656 RS&H, INC. 10748 DEERWOOD PARK BLVD. SOUTH JACKSONVILLE, FL 32256 | | ROAD NO. | COUNTY | FINANCIAL PROJECT ID | |
| | | | | | | SR 16 | ST. JOHNS | 210447-5-52-01 | |

THE OFFICIAL RECORD OF THIS SHEET IS THE ELECTRONIC FILE DIGITALLY SIGNED AND SEALED UNDER RULE 61G15-23.004, F.A.C.

8/5/2024 4:28:59 PM BeattyM
c:\pw_work\ysh_pw\pw_user\00439575\PLANRD01.dgn

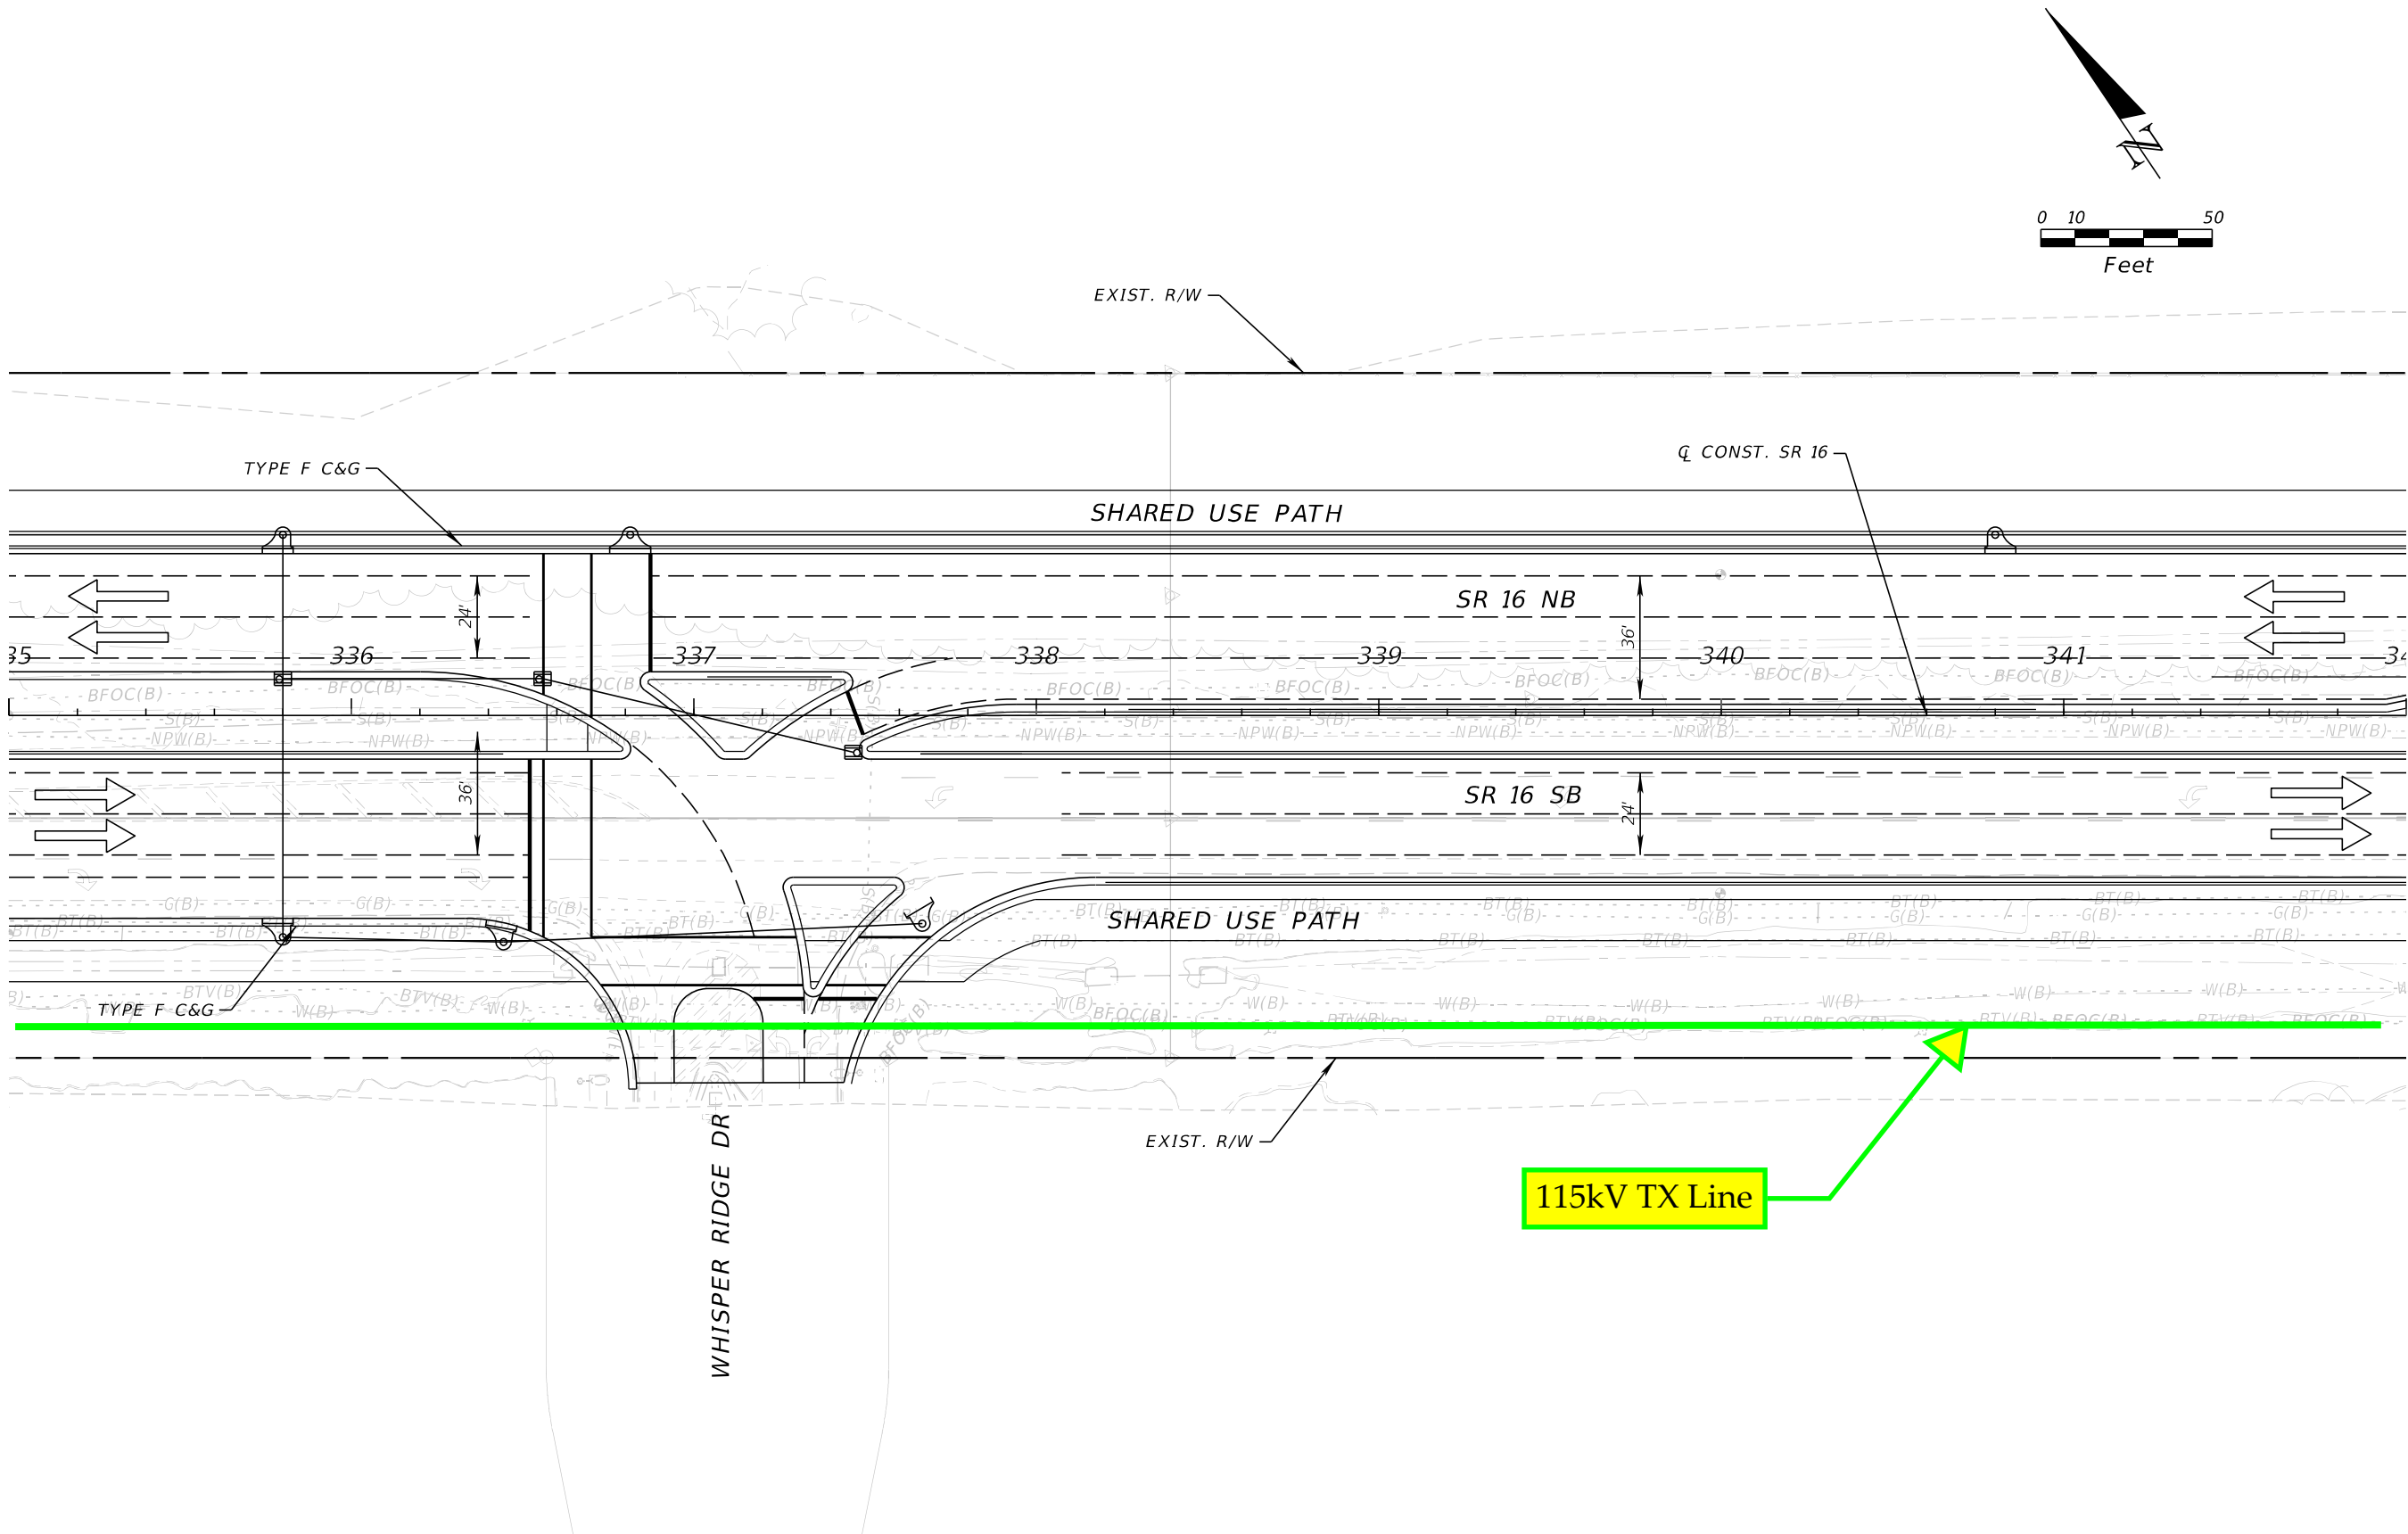


| REVISIONS | | | | ENGINEER OF RECORD | STATE OF FLORIDA DEPARTMENT OF TRANSPORTATION | | | SHEET NO. |
|-----------|-------------|------|-------------|--------------------|--|-----------|----------------------|--------------|
| DATE | DESCRIPTION | DATE | DESCRIPTION | | ROAD NO. | COUNTY | FINANCIAL PROJECT ID | |
| | | | | | SR 16 | ST. JOHNS | 210447-5-52-01 | |

STEPHEN J. PARK, P.E.
LICENSE NUMBER: 77656
RS&H, INC.
10748 DEERWOOD PARK BLVD. SOUTH
JACKSONVILLE, FL 32256

11x17
Plan
Only

THE OFFICIAL RECORD OF THIS SHEET IS THE ELECTRONIC FILE DIGITALLY SIGNED AND SEALED UNDER RULE 61G15-23.004, F.A.C.

8/5/2024 4:29:00 PM BeattyM
c:\pw_work\ysh_pw\pw_user\0439575\PLANRD01.dgn


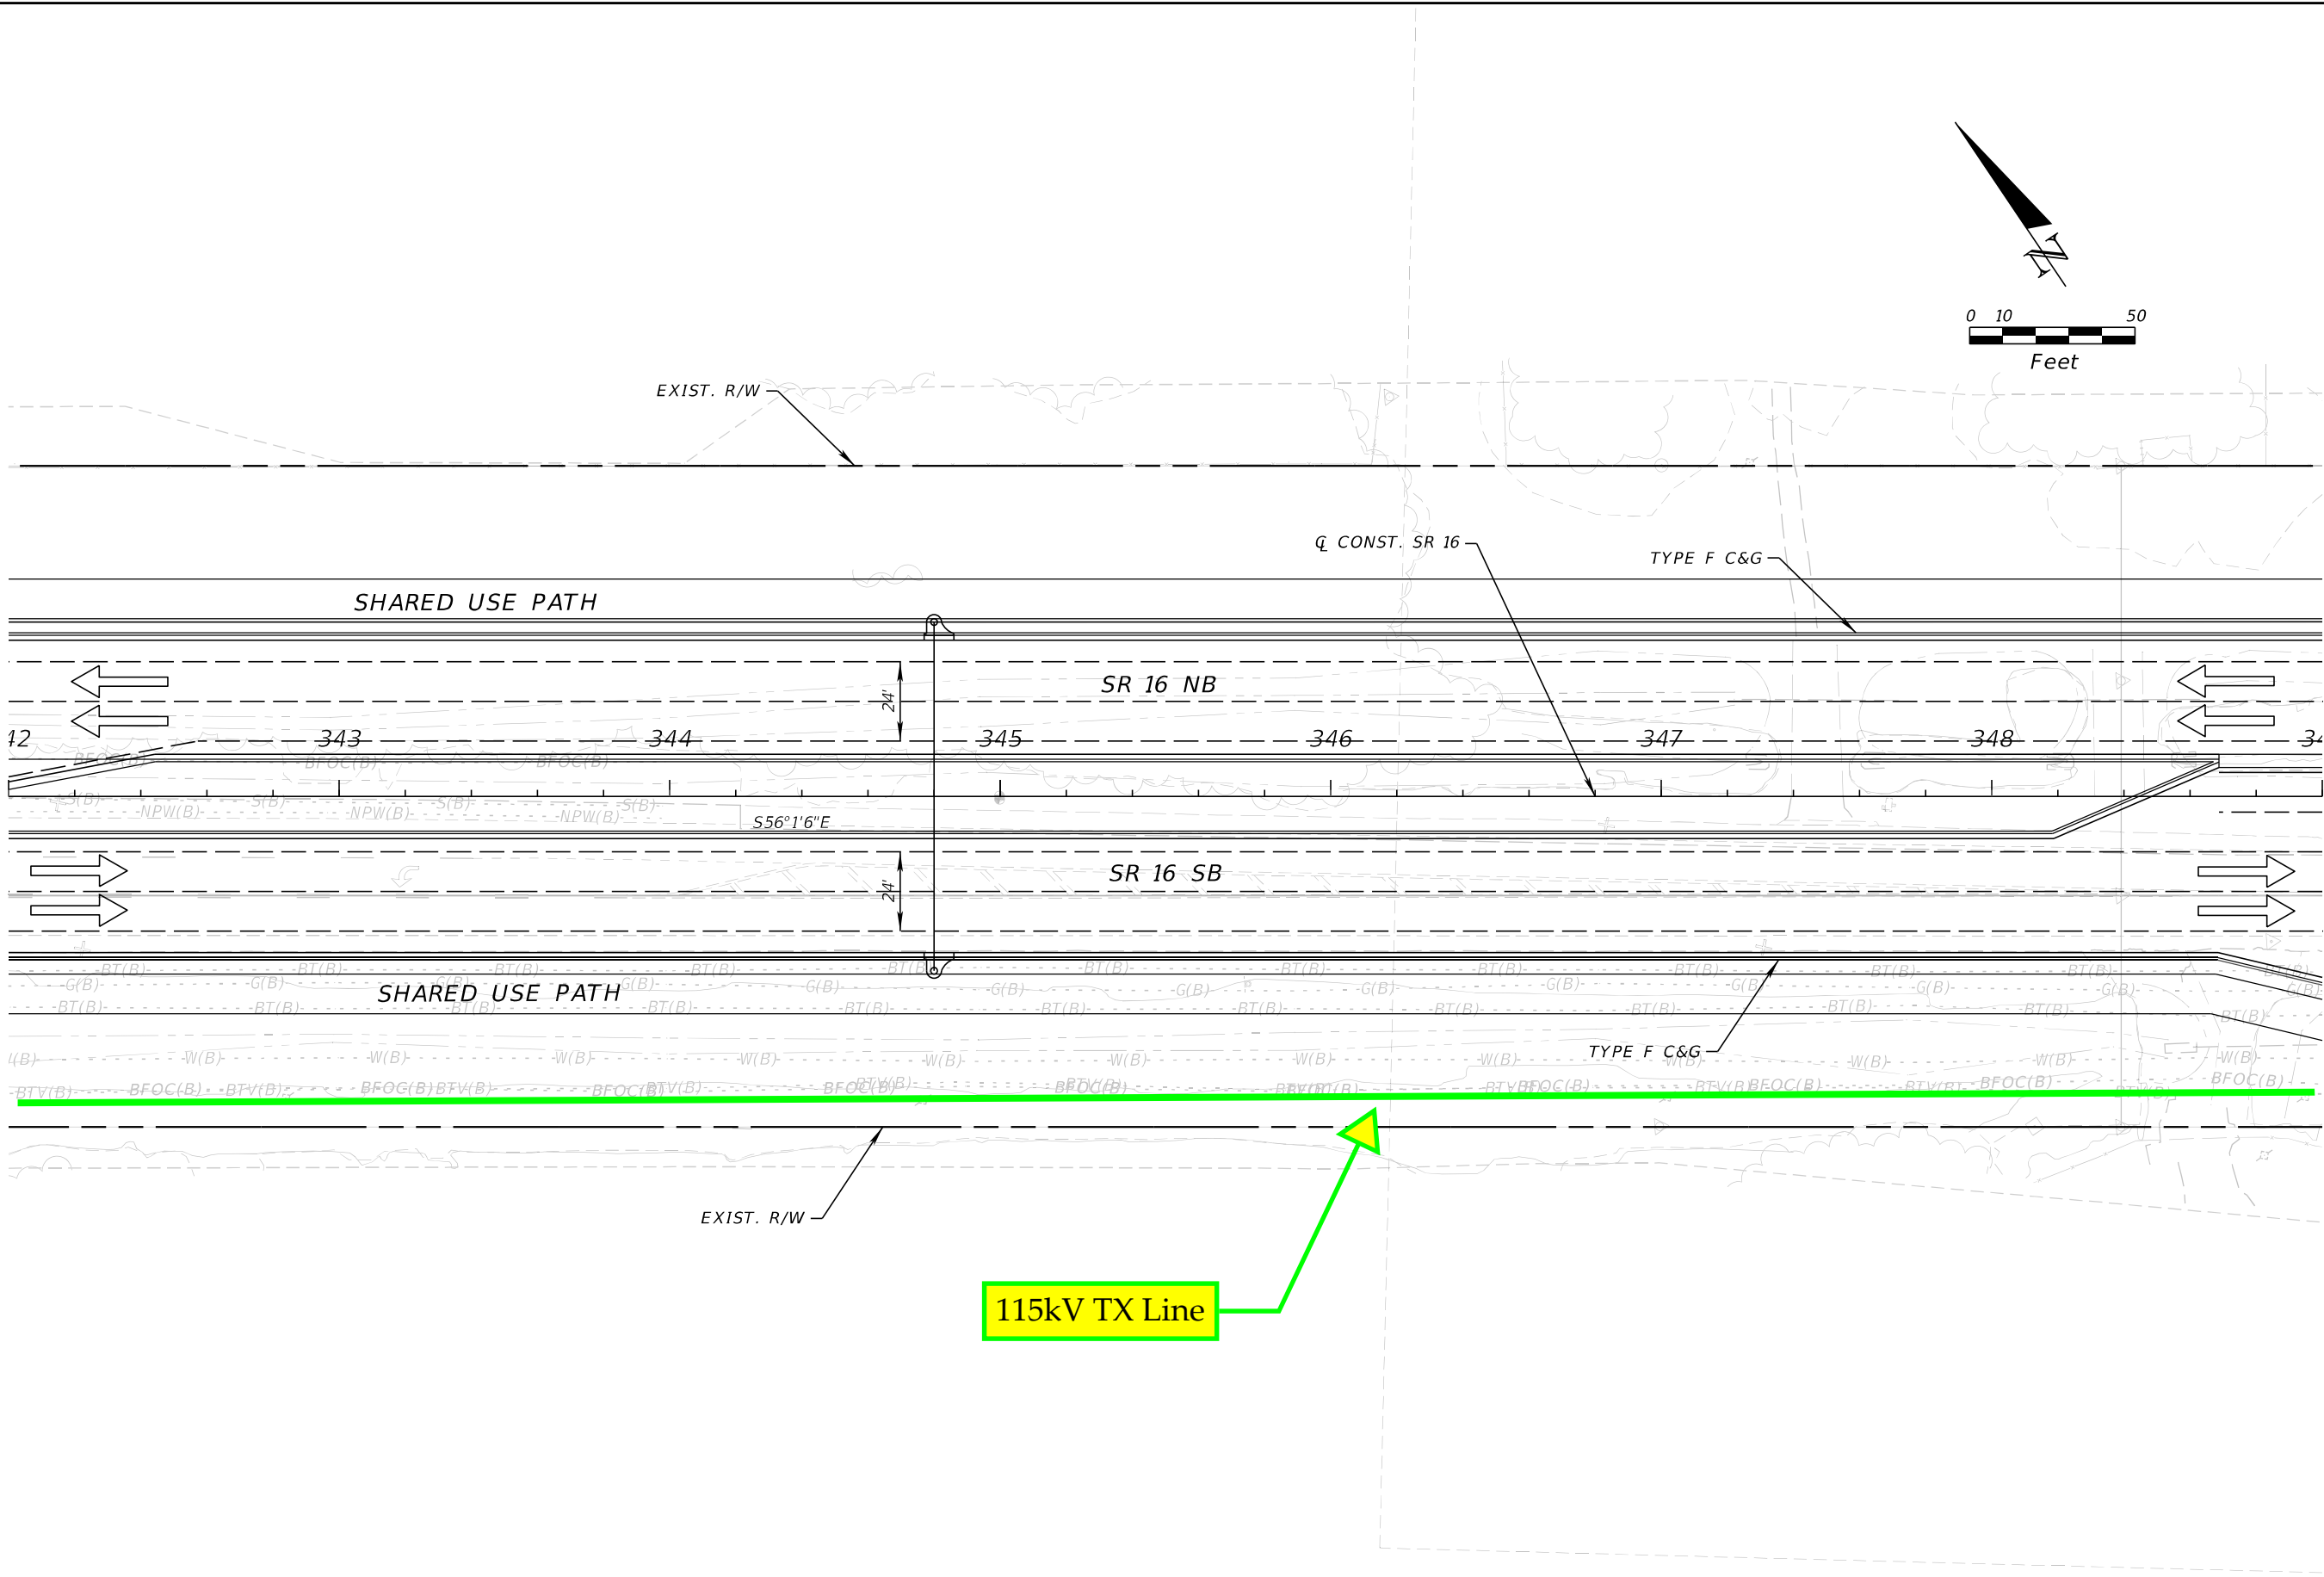


115kV TX Line

| REVISIONS | | | | ENGINEER OF RECORD | | STATE OF FLORIDA DEPARTMENT OF TRANSPORTATION | | | SHEET NO. |
|-----------|-------------|------|-------------|---|--|--|-----------|----------------------|--------------|
| DATE | DESCRIPTION | DATE | DESCRIPTION | STEPHEN J. PARK, P.E. LICENSE NUMBER: 77656 RS&H, INC. 10748 DEERWOOD PARK BLVD. SOUTH JACKSONVILLE, FL 32256 | | ROAD NO. | COUNTY | FINANCIAL PROJECT ID | |
| | | | | | | SR 16 | ST. JOHNS | 210447-5-52-01 | |

THE OFFICIAL RECORD OF THIS SHEET IS THE ELECTRONIC FILE DIGITALLY SIGNED AND SEALED UNDER RULE 61G15-23.004, F.A.C.

TADPOLE PREP

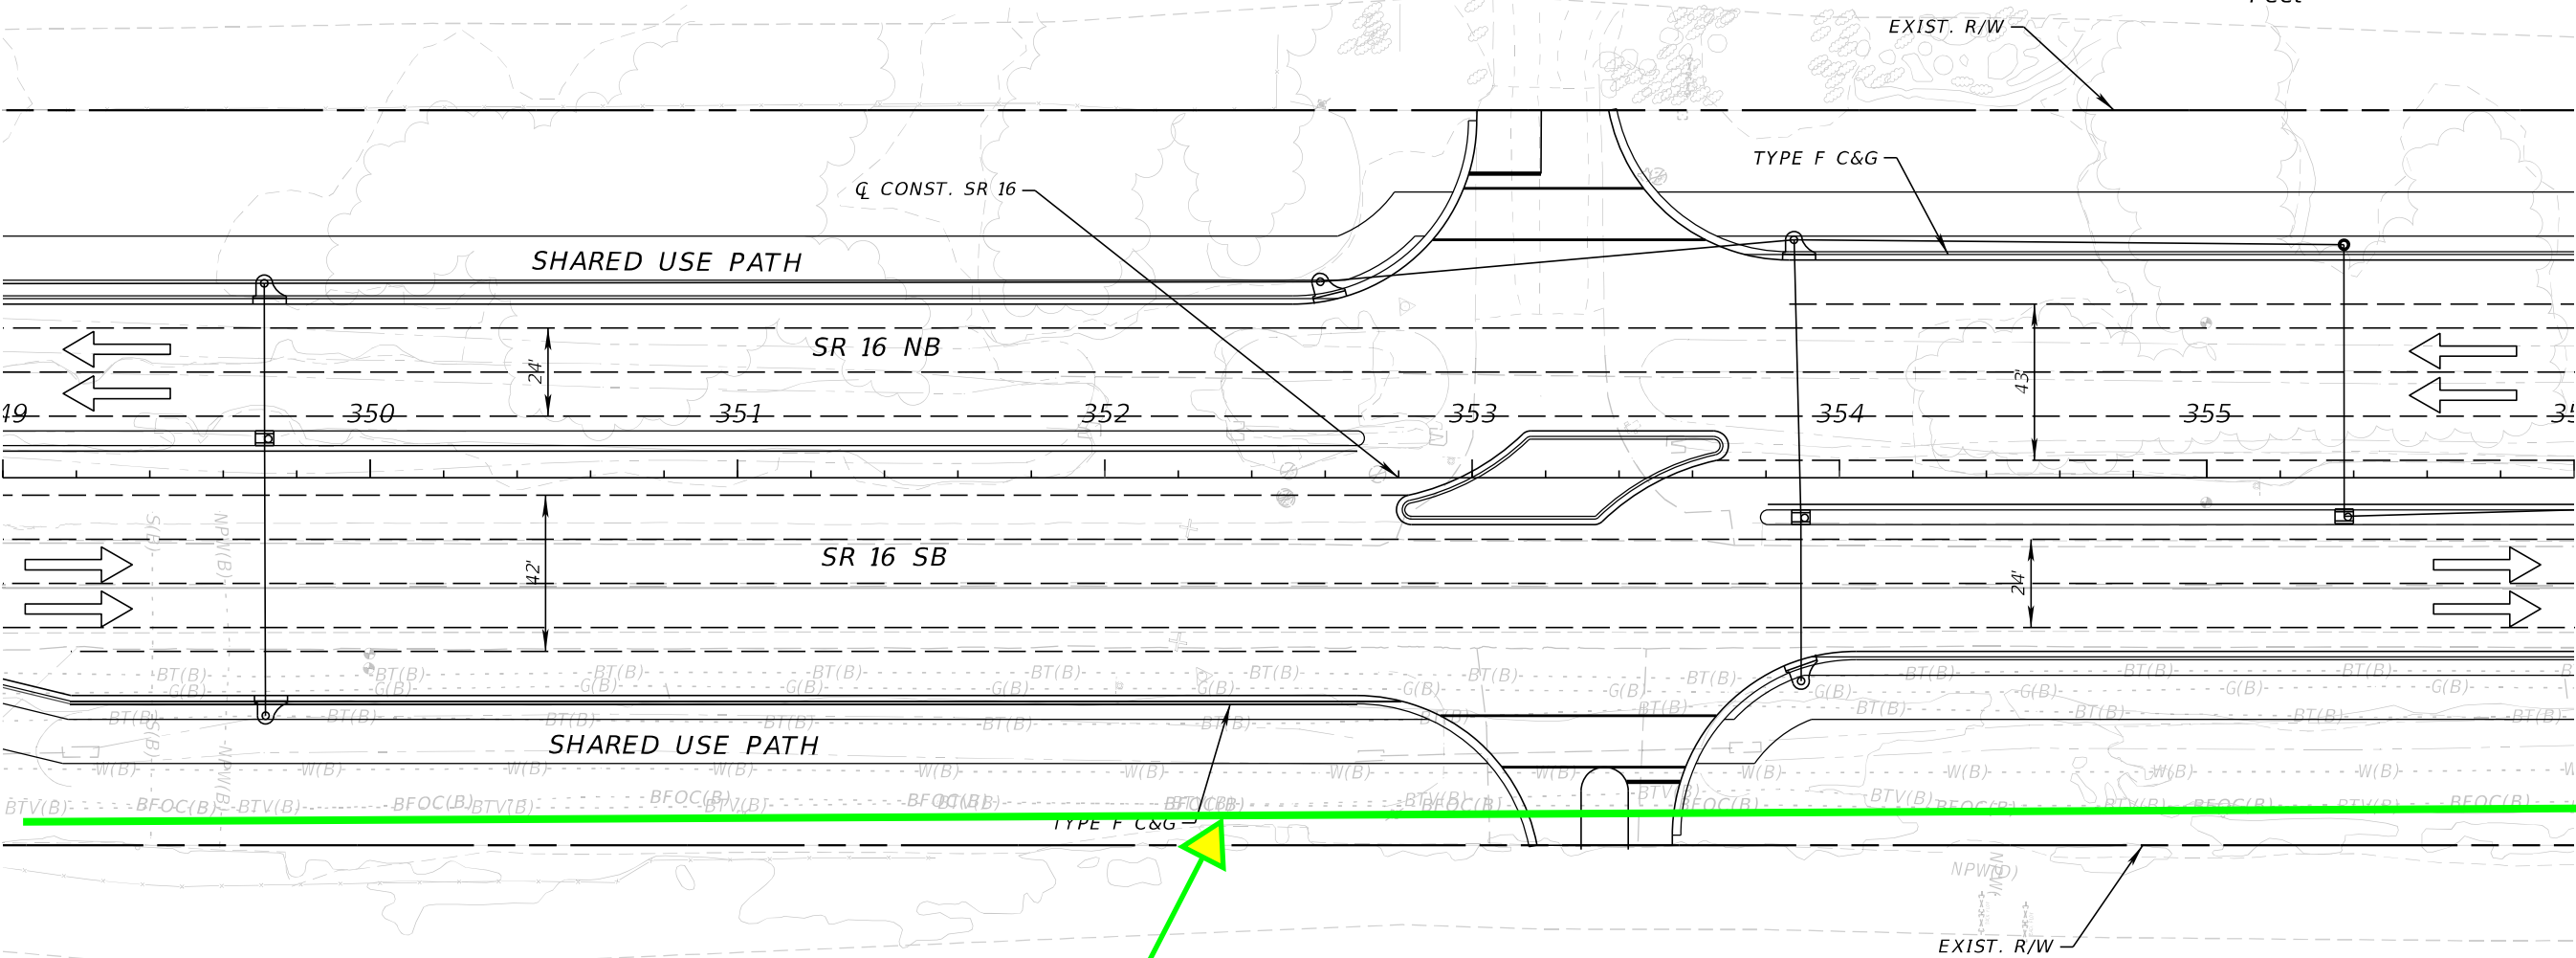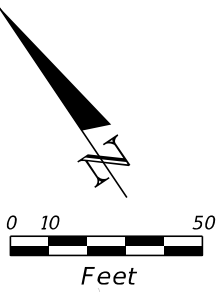

115kV TX Line



SOLUNA (UNDER CONSTRUCTION)

8/5/2024 4:29:01 PM BeattyM
c:\pw_work\sh_pw\pw_user\0439575\PLANRD01.dgn

| REVISIONS | | | | ENGINEER OF RECORD | STATE OF FLORIDA DEPARTMENT OF TRANSPORTATION | | | SHEET NO. |
|-----------|-------------|------|-------------|---|--|-----------|----------------------|-----------------------|
| DATE | DESCRIPTION | DATE | DESCRIPTION | STEPHEN J. PARK, P.E. LICENSE NUMBER: 77656 RS&H, INC. 10748 DEERWOOD PARK BLVD. SOUTH JACKSONVILLE, FL 32256 | ROAD NO. | COUNTY | FINANCIAL PROJECT ID | |
| | | | | | SR 16 | ST. JOHNS | 210447-5-52-01 | |
| | | | | | | | | 11x17 Plan Only |

THE OFFICIAL RECORD OF THIS SHEET IS THE ELECTRONIC FILE DIGITALLY SIGNED AND SEALED UNDER RULE 61G15-23.004, F.A.C.

KINGDOM HALL OF
JEHOVA'S WITNESSES

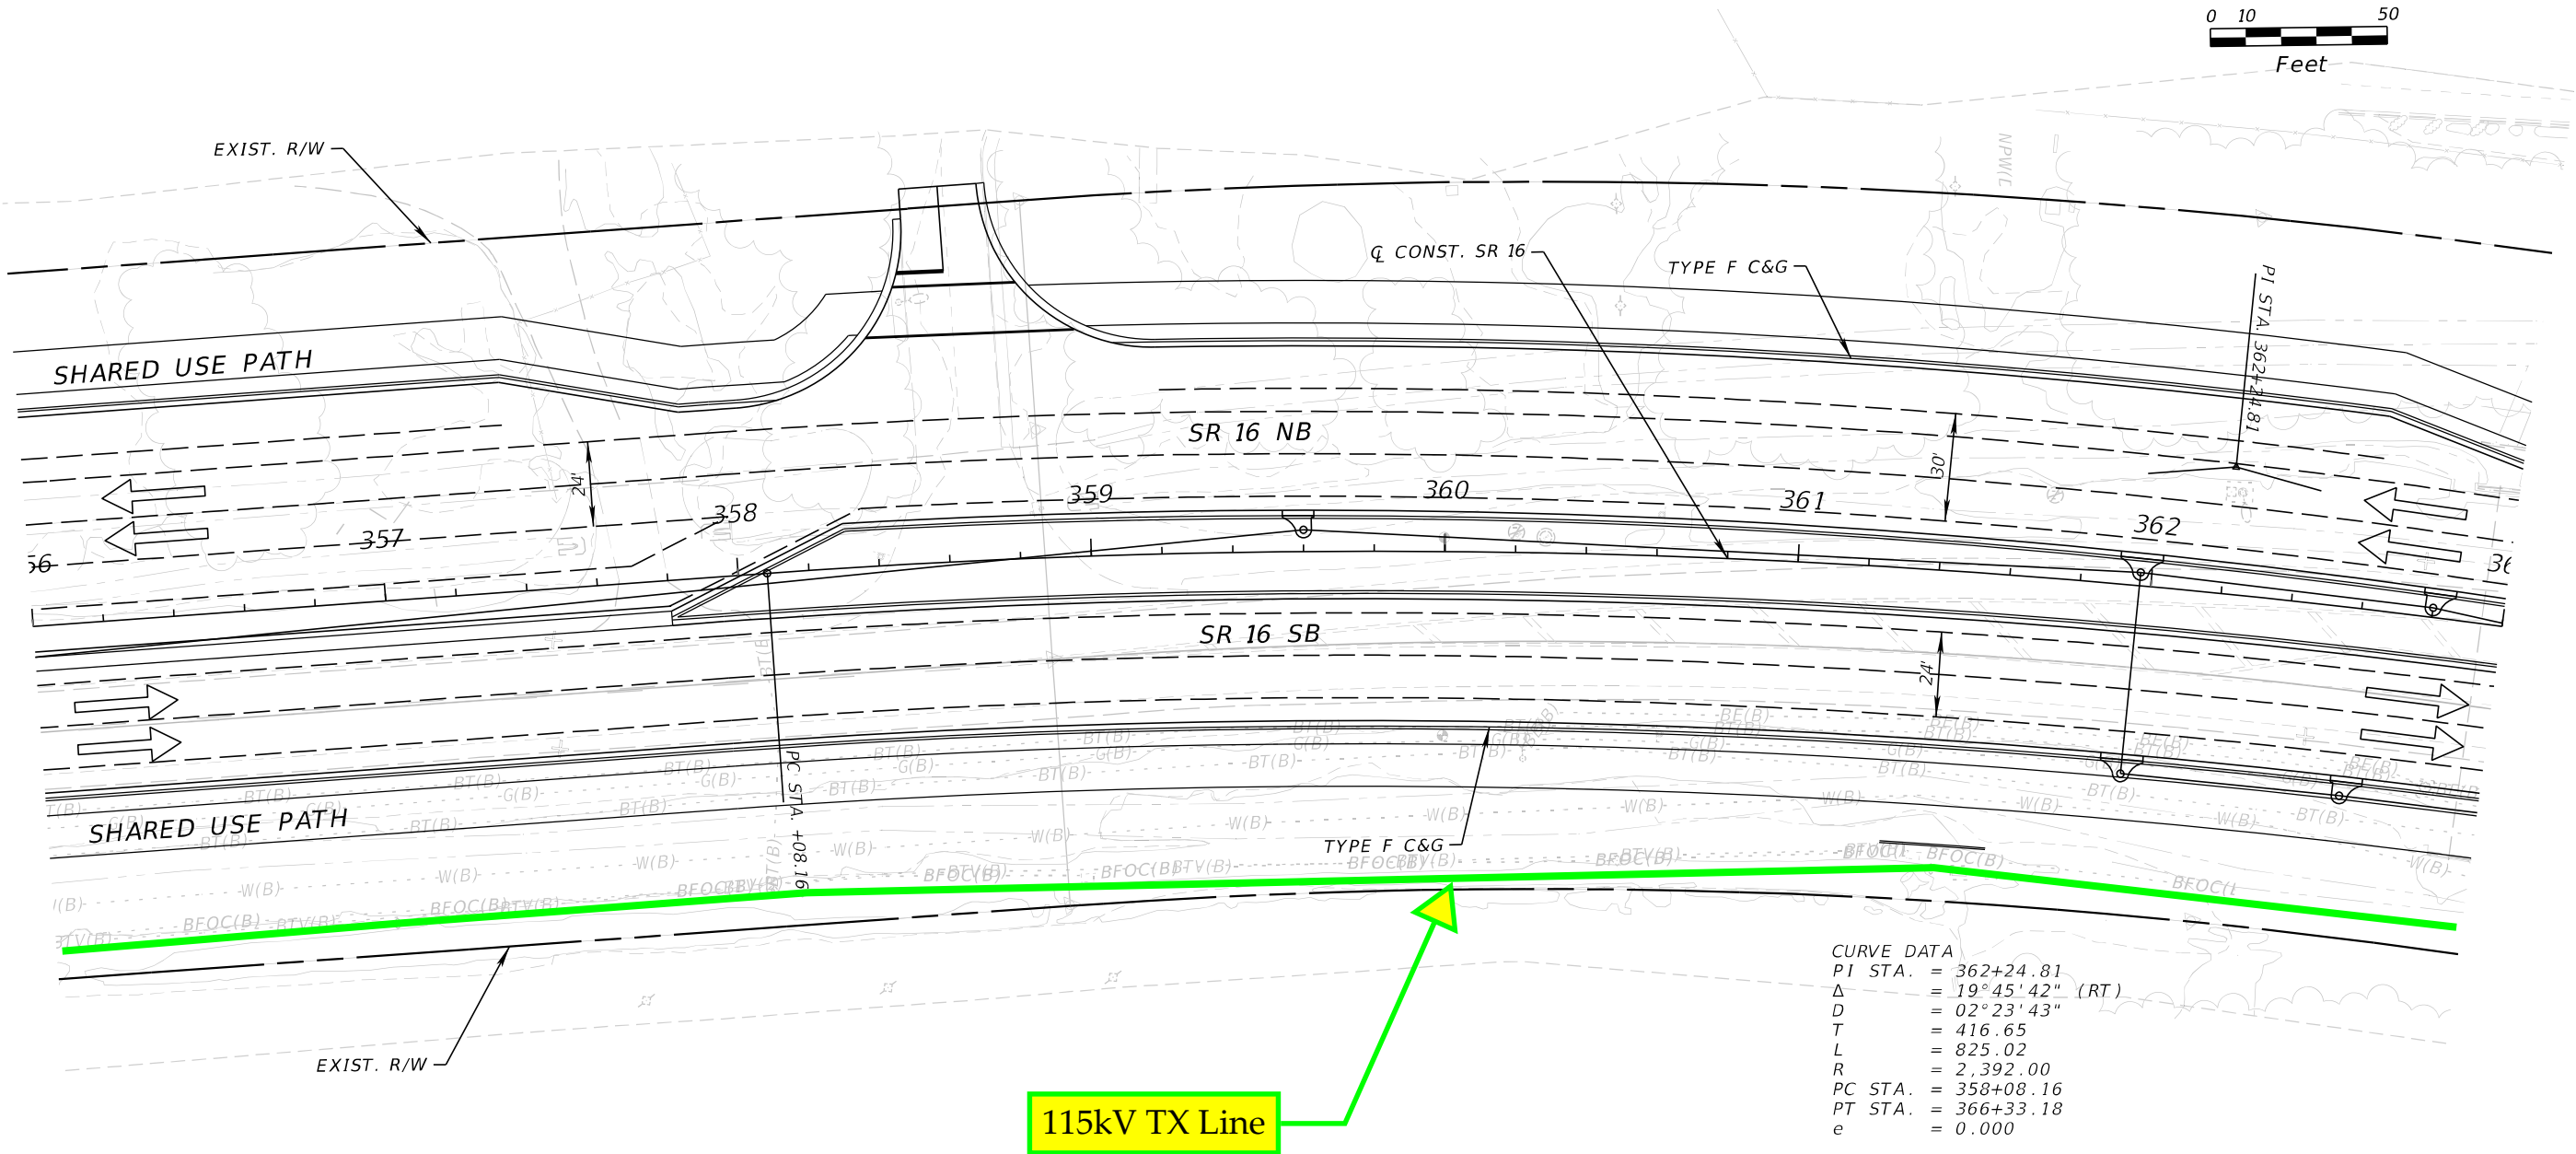
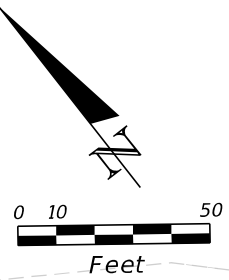


8/5/2024 4:29:01 PM BeattyM
c:\pw_work\sh_pw\pw_user\0439575\PLANRD01.dgn

| REVISIONS | | | | ENGINEER OF RECORD | | STATE OF FLORIDA DEPARTMENT OF TRANSPORTATION | | | SHEET NO. |
|-----------|-------------|------|-------------|---|--|--|-----------|----------------------|--------------|
| DATE | DESCRIPTION | DATE | DESCRIPTION | STEPHEN J. PARK, P.E. LICENSE NUMBER: 77656 RS&H, INC. 10748 DEERWOOD PARK BLVD. SOUTH JACKSONVILLE, FL 32256 | | ROAD NO. | COUNTY | FINANCIAL PROJECT ID | |
| | | | | | | SR 16 | ST. JOHNS | 210447-5-52-01 | |

THE OFFICIAL RECORD OF THIS SHEET IS THE ELECTRONIC FILE DIGITALLY SIGNED AND SEALED UNDER RULE 61G15-23.004, F.A.C.

ATLANTIC SELF STORAGE

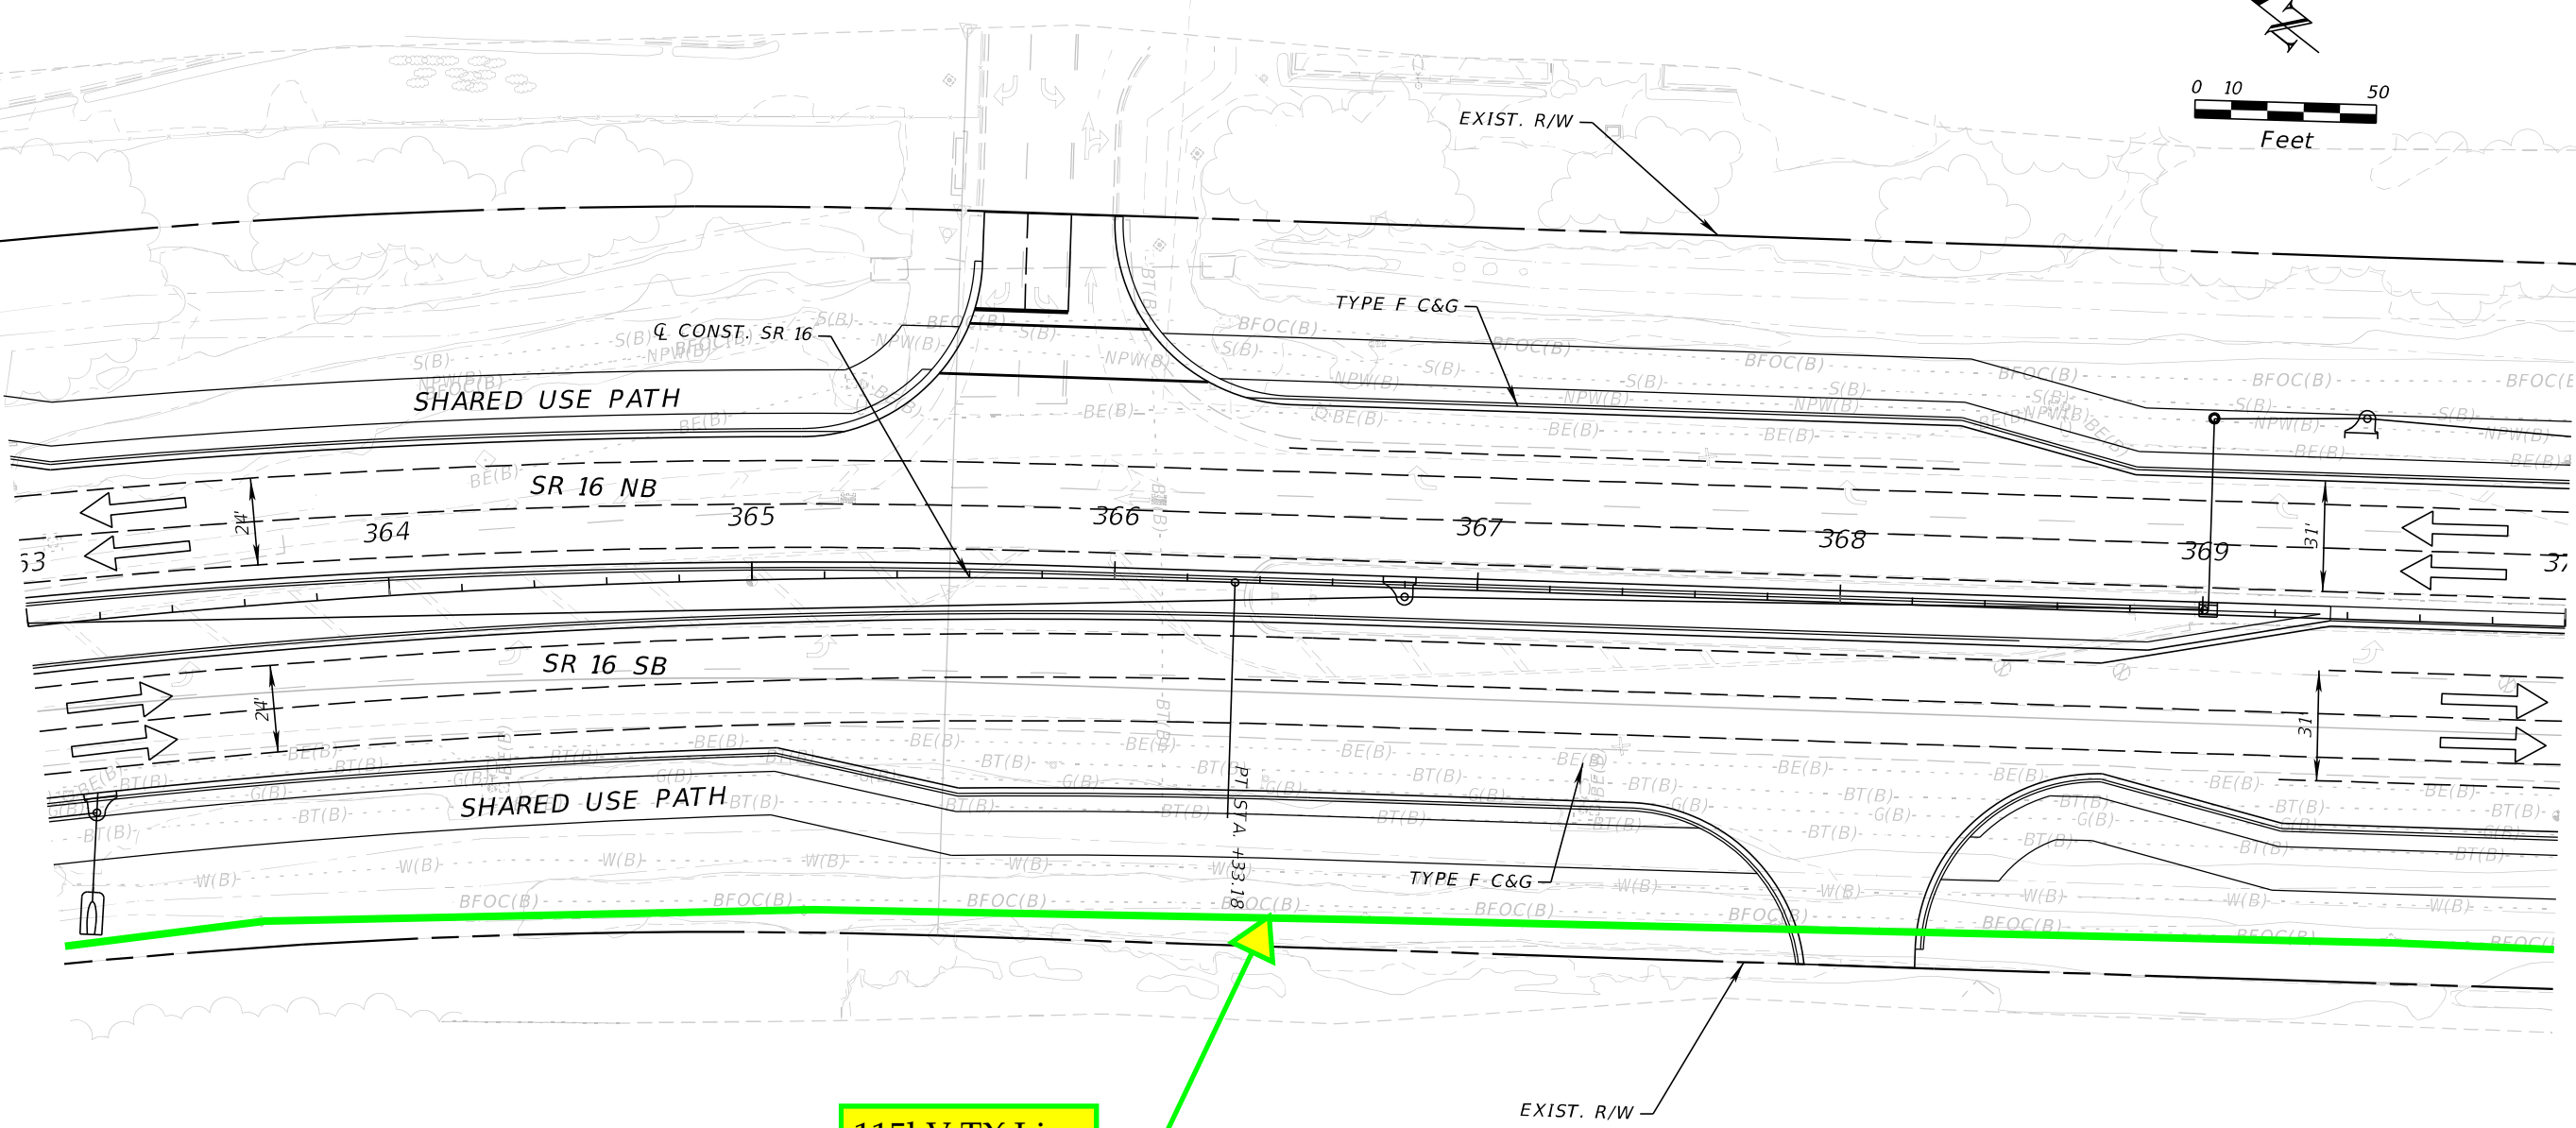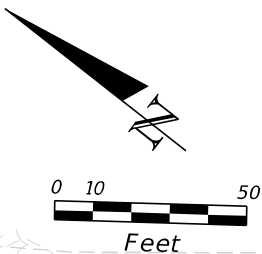


115kV TX Line

8/5/2024 4:29:02 PM BeattyM
c:\pw_work\ysh_pw\pw_user\0439575\PLANRD01.dgn

| REVISIONS | | | | ENGINEER OF RECORD | STATE OF FLORIDA DEPARTMENT OF TRANSPORTATION | | | SHEET NO. |
|-----------|-------------|------|-------------|---|--|-----------|----------------------|-----------------------|
| DATE | DESCRIPTION | DATE | DESCRIPTION | STEPHEN J. PARK, P.E. LICENSE NUMBER: 77656 RS&H, INC. 10748 DEERWOOD PARK BLVD. SOUTH JACKSONVILLE, FL 32256 | ROAD NO. | COUNTY | FINANCIAL PROJECT ID | |
| | | | | | SR 16 | ST. JOHNS | 210447-5-52-01 | |
| | | | | | | | | 11x17 Plan Only |

THE OFFICIAL RECORD OF THIS SHEET IS THE ELECTRONIC FILE DIGITALLY SIGNED AND SEALED UNDER RULE 61G15-23.004, F.A.C.


8/5/2024 4:29:03 PM BeattyM
c:\pw_work\ysh_pw\pw_user\0439575\PLANRD01.dgn

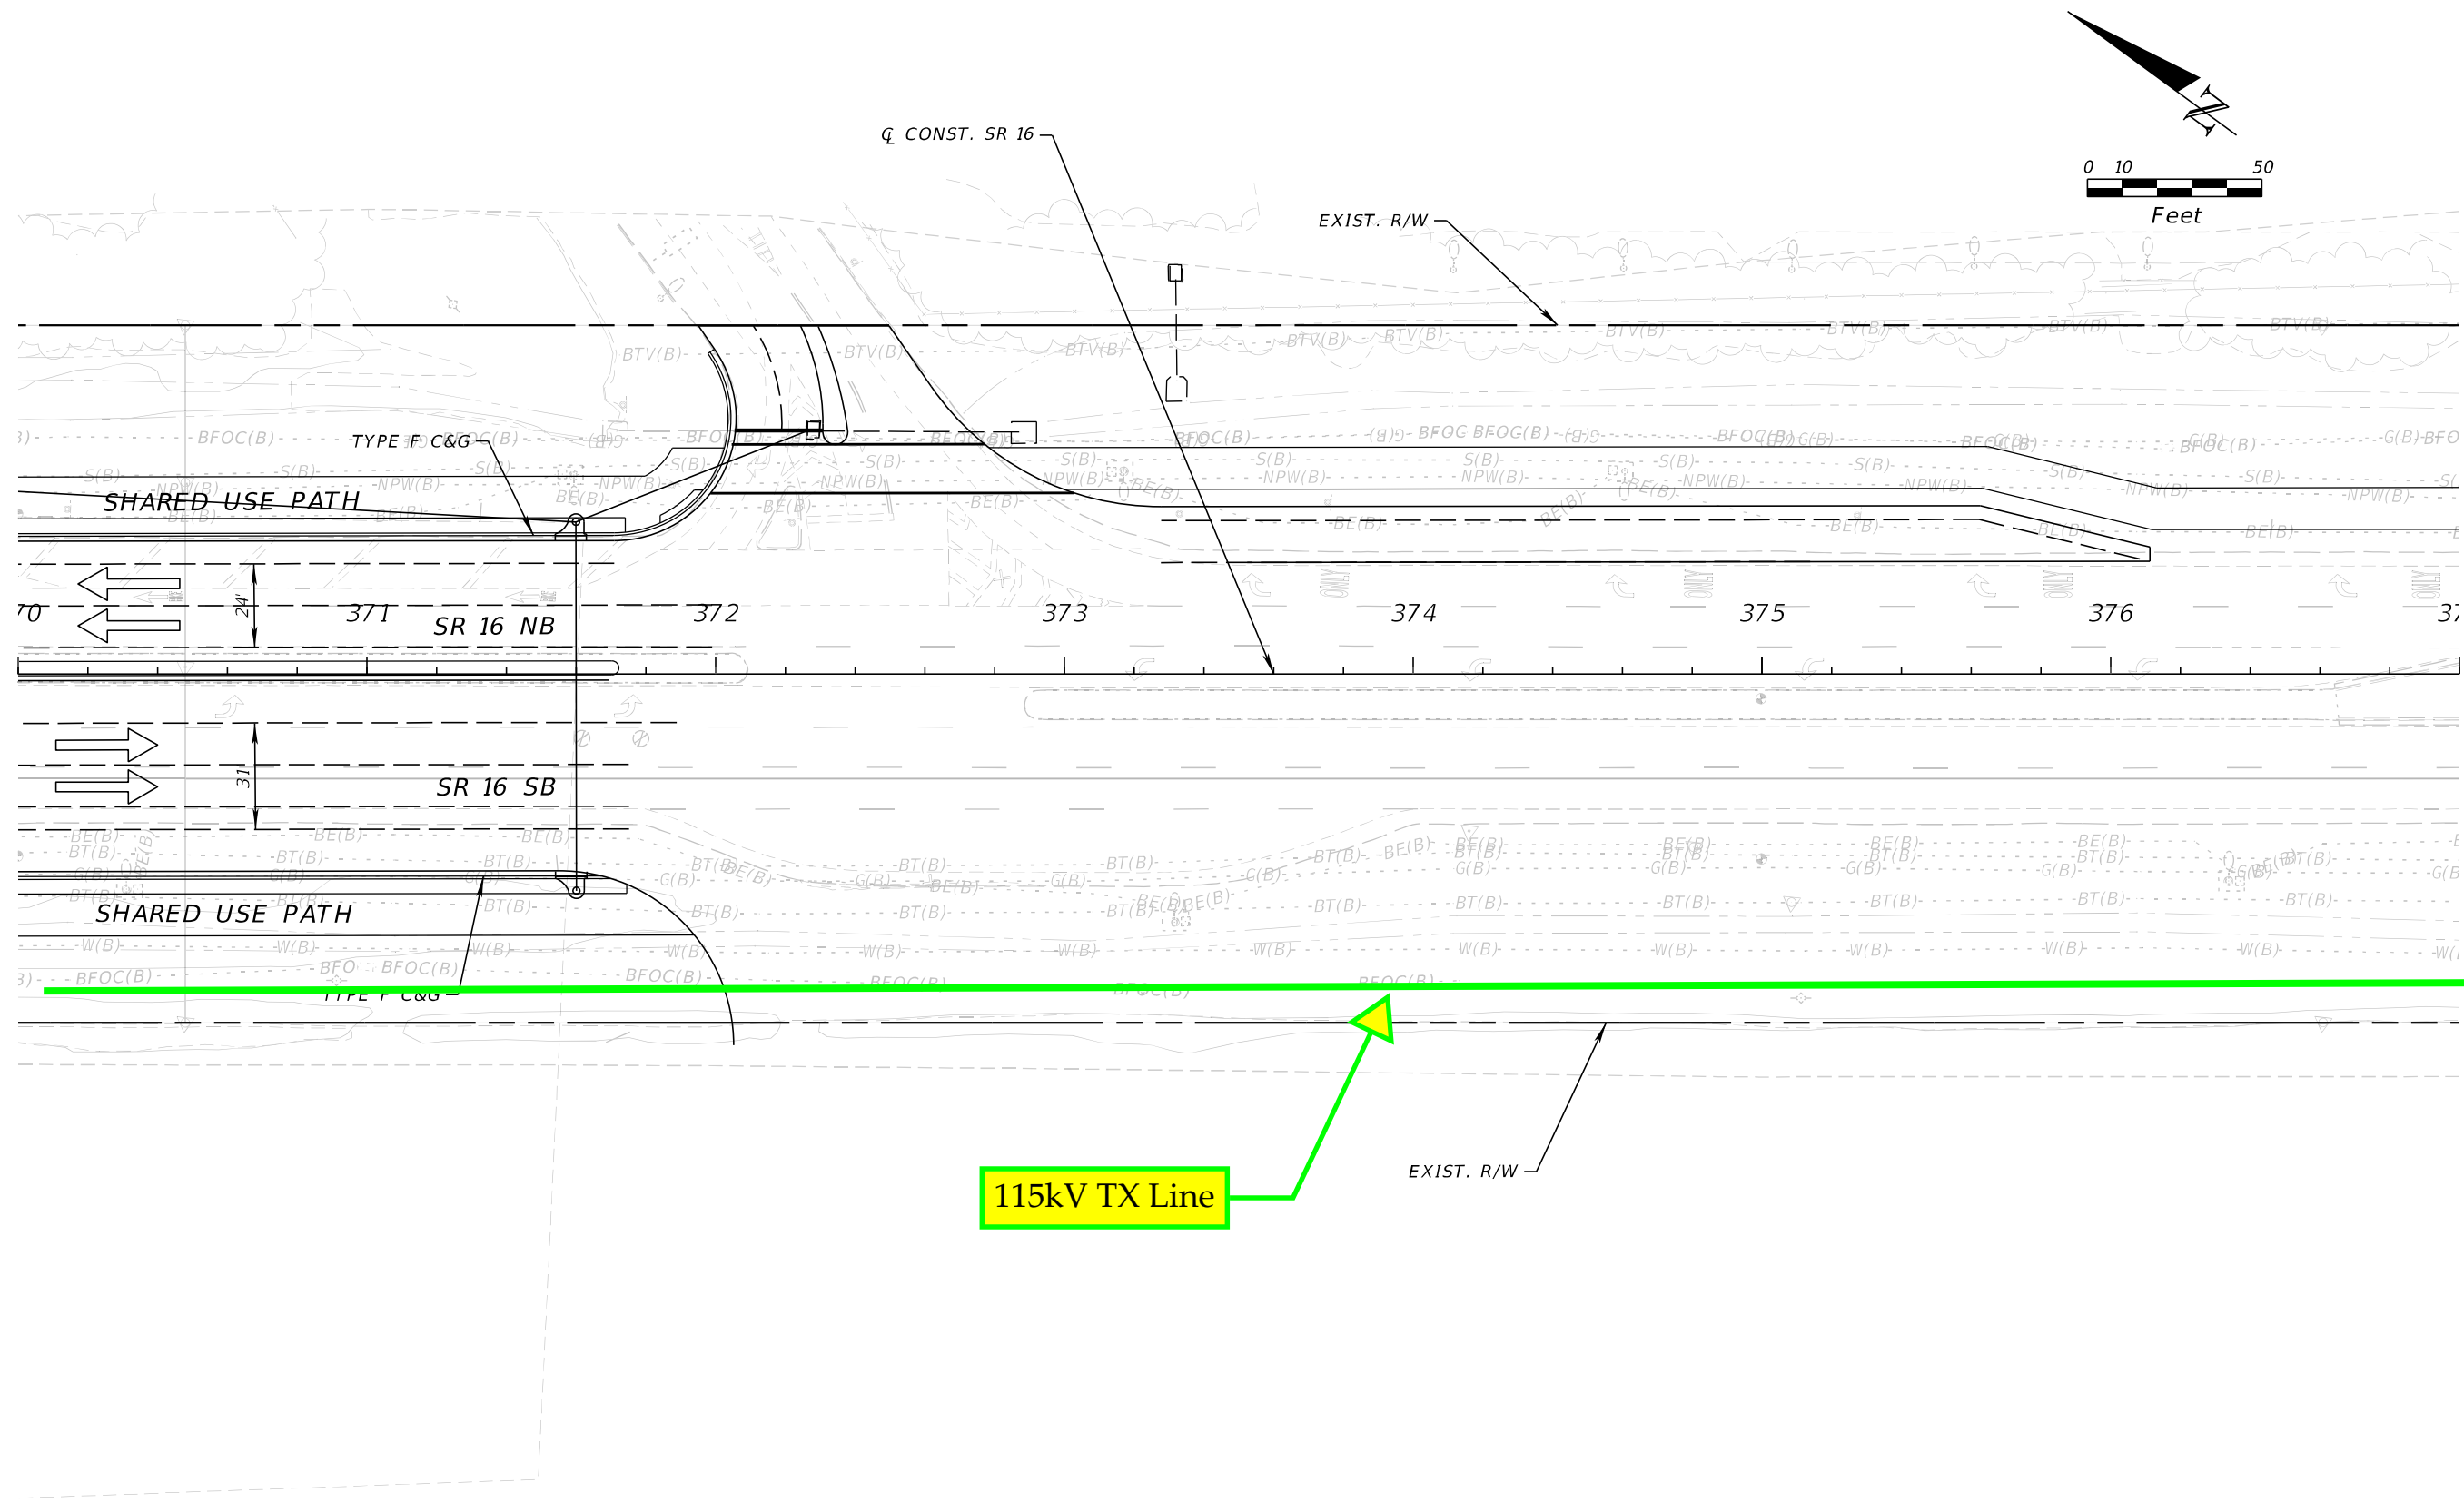

| | | | | | | | | | |
|-----------|-------------|--|------|---|--|--|--|--|-----------------------|
| REVISIONS | | | | ENGINEER OF RECORD | | STATE OF FLORIDA DEPARTMENT OF TRANSPORTATION | | | SHEET NO. |
| DATE | DESCRIPTION | | DATE | DESCRIPTION | | | | | |
| | | | | | | | | | |
| | | | | STEPHEN J. PARK, P.E. LICENSE NUMBER: 77656 RS&H, INC. 10748 DEERWOOD PARK BLVD. SOUTH JACKSONVILLE, FL 32256 | | | | | 11x17 Plan Only |
| | | | | | | | | | |
| | | | | | | | | | |
THE OFFICIAL RECORD OF THIS SHEET IS THE ELECTRONIC FILE DIGITALLY SIGNED AND SEALED UNDER RULE 61G15-23.004, F.A.C.

8/5/2024 4:29:03 PM BeattyM
c:\pw_work\ysh_pw\pw_user\0439575\PLANRD01.dgn



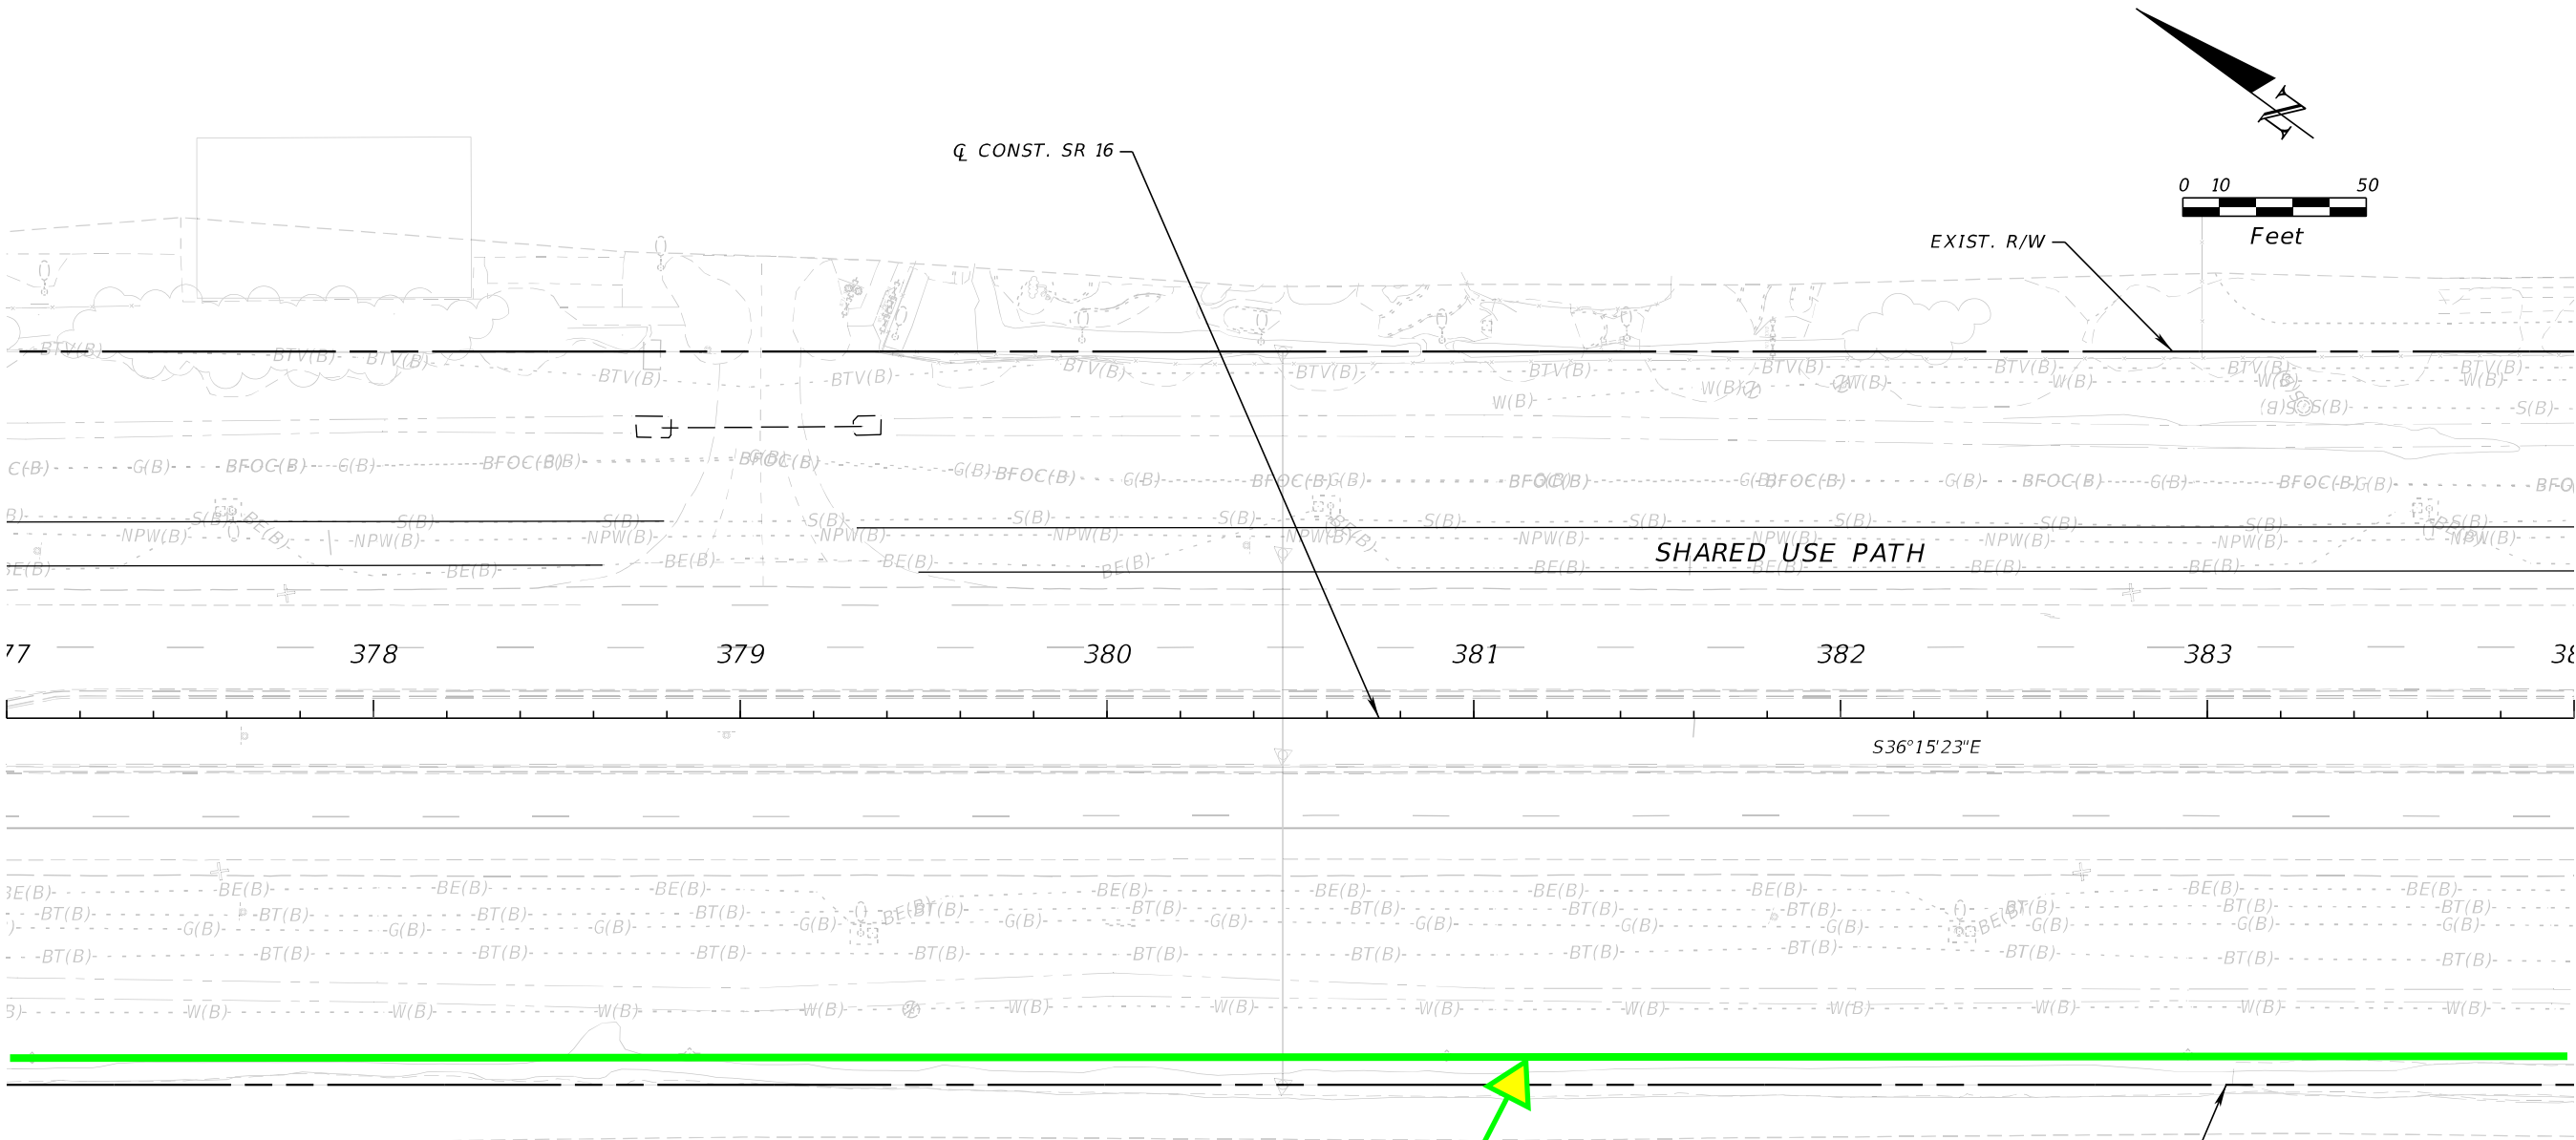


115kV TX Line

| REVISIONS | | | | ENGINEER OF RECORD | | STATE OF FLORIDA DEPARTMENT OF TRANSPORTATION | | | SHEET NO. |
|-----------|-------------|------|-------------|---|--|--|-----------|----------------------|--------------|
| DATE | DESCRIPTION | DATE | DESCRIPTION | STEPHEN J. PARK, P.E. LICENSE NUMBER: 77656 RS&H, INC. 10748 DEERWOOD PARK BLVD. SOUTH JACKSONVILLE, FL 32256 | | ROAD NO. | COUNTY | FINANCIAL PROJECT ID | |
| | | | | | | SR 16 | ST. JOHNS | 210447-5-52-01 | |

THE OFFICIAL RECORD OF THIS SHEET IS THE ELECTRONIC FILE DIGITALLY SIGNED AND SEALED UNDER RULE 61G15-23.004, F.A.C.

SHOPPES AT MILL CREEK

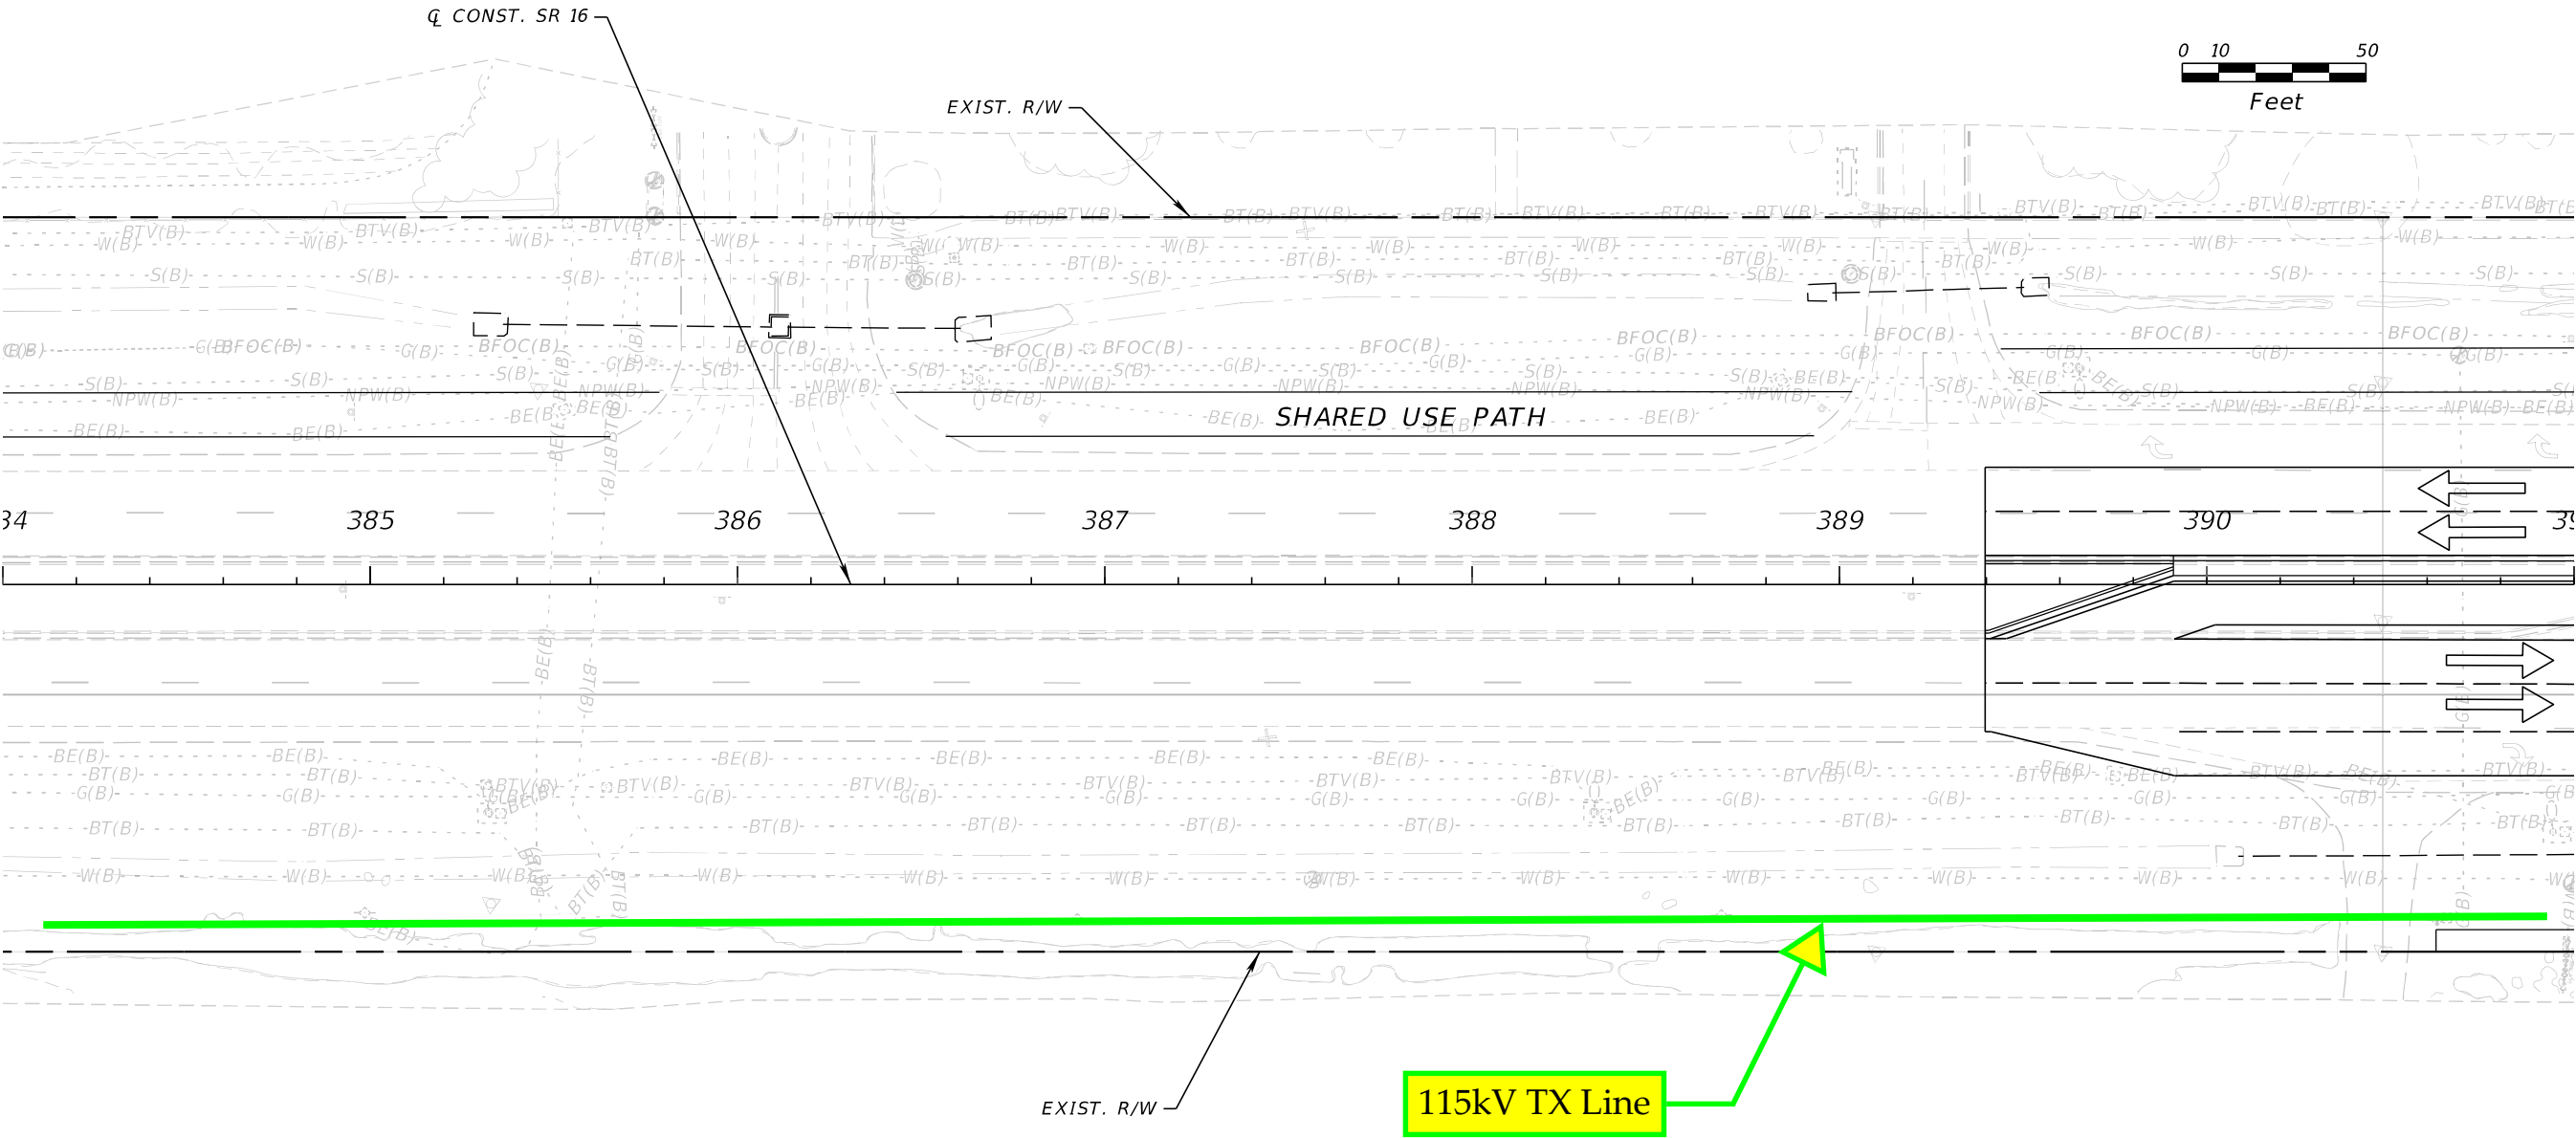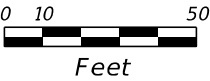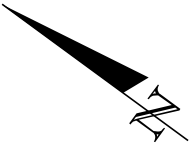

8/5/2024 4:29:04 PM BeattyM
c:\pw_work\ysh_pw\pw_user\00439575\PLANRD01.dgn



| REVISIONS | | | | ENGINEER OF RECORD | | STATE OF FLORIDA DEPARTMENT OF TRANSPORTATION | | | SHEET NO. |
|-----------|-------------|------|-------------|---|--|--|-----------|----------------------|--------------|
| DATE | DESCRIPTION | DATE | DESCRIPTION | STEPHEN J. PARK, P.E. LICENSE NUMBER: 77656 RS&H, INC. 10748 DEERWOOD PARK BLVD. SOUTH JACKSONVILLE, FL 32256 | | ROAD NO. | COUNTY | FINANCIAL PROJECT ID | |
| | | | | | | SR 16 | ST. JOHNS | 210447-5-52-01 | |

THE OFFICIAL RECORD OF THIS SHEET IS THE ELECTRONIC FILE DIGITALLY SIGNED AND SEALED UNDER RULE 61G15-23.004, F.A.C.

SONNY'S BBQ

WENDY'S

SCOTTISH INNS

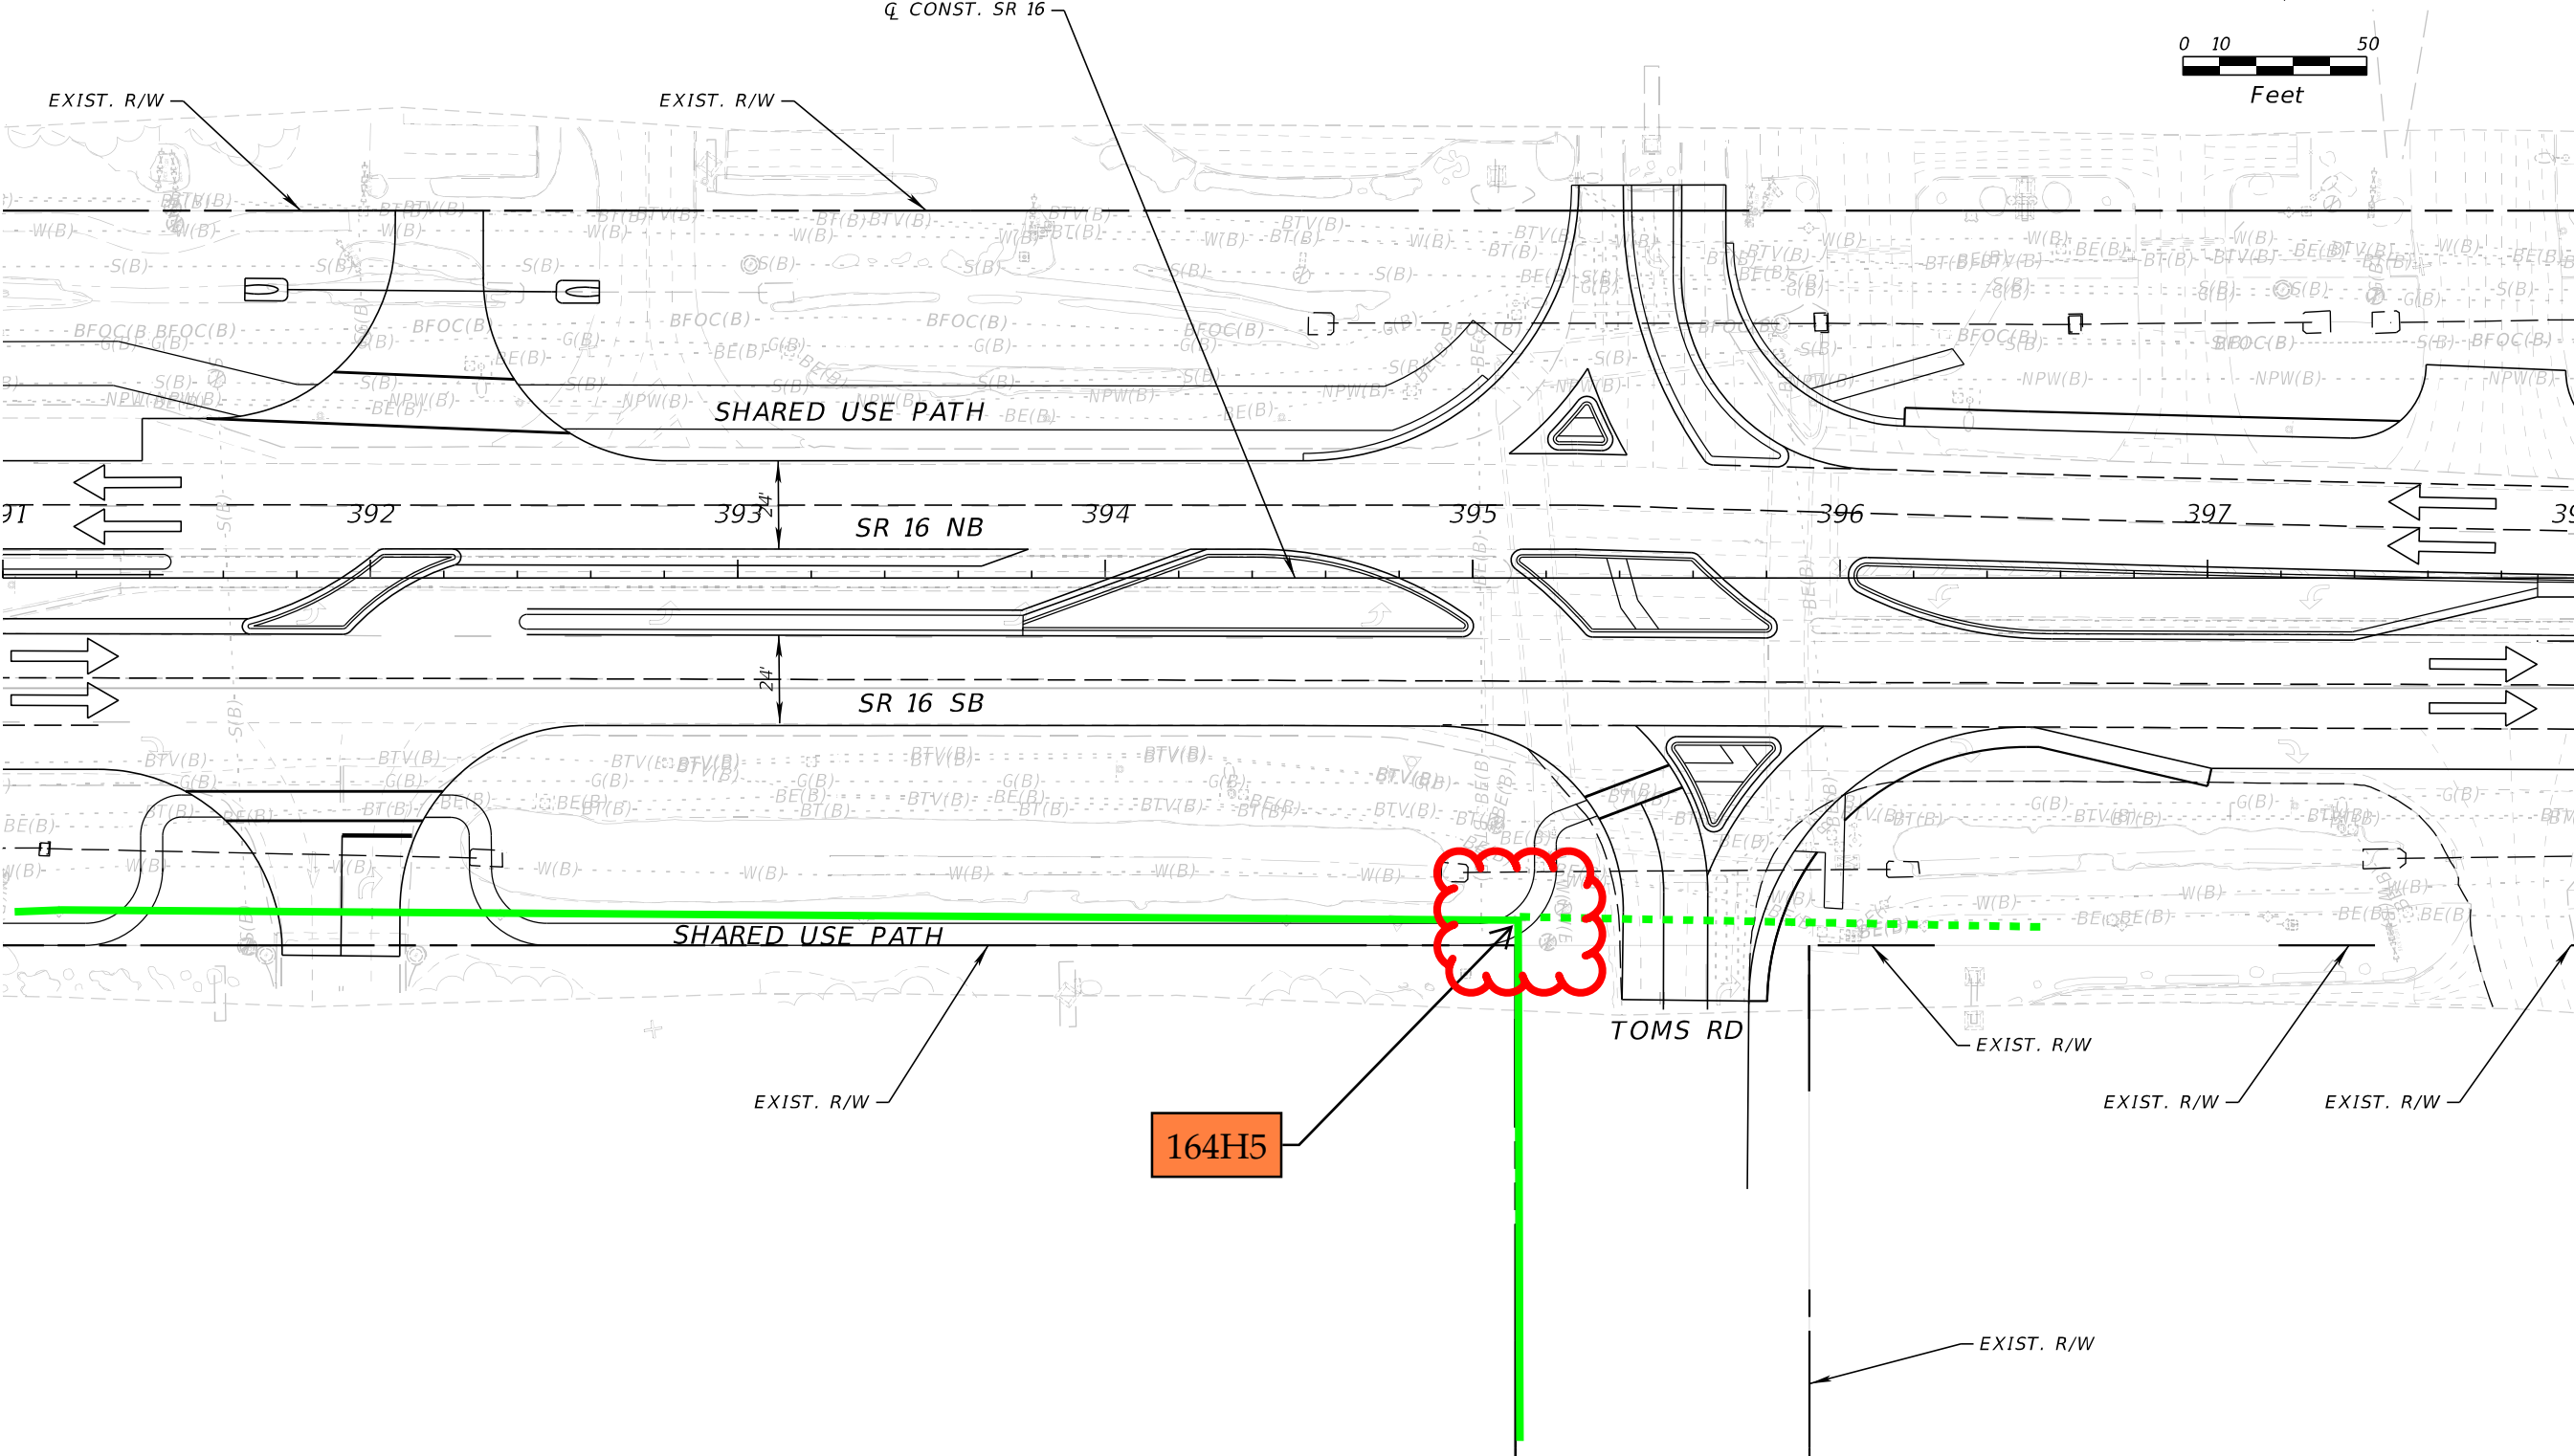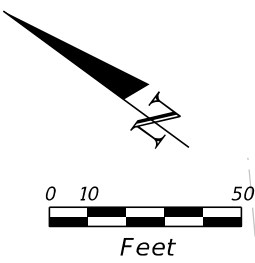

164H5

8/5/2024 4:29:04 PM BeattyM
c:\pw_work\sh_pw\pw_user\00439575\PLANRD01.dgn

| REVISIONS | | | | ENGINEER OF RECORD | | STATE OF FLORIDA DEPARTMENT OF TRANSPORTATION | | | SHEET NO. |
|-----------|-------------|------|-------------|---|--|--|-----------|----------------------|--------------|
| DATE | DESCRIPTION | DATE | DESCRIPTION | STEPHEN J. PARK, P.E. LICENSE NUMBER: 77656 RS&H, INC. 10748 DEERWOOD PARK BLVD. SOUTH JACKSONVILLE, FL 32256 | | ROAD NO. | COUNTY | FINANCIAL PROJECT ID | |
| | | | | | | SR 16 | ST. JOHNS | 210447-5-52-01 | |

THE OFFICIAL RECORD OF THIS SHEET IS THE ELECTRONIC FILE DIGITALLY SIGNED AND SEALED UNDER RULE 61G15-23.004, F.A.C.

Hotwire Communications

Forms and Figures



District 2 Contact Response Form

(Please fill out completely.)



| | |
|--------------------------|--|
| Date: | 8-13-2024 |
| Company Name: | Hotwire Communications |
| Representative Name: | Walter Sancho-Davila |
| Representative Title: | Project Manager - OSP Engineering |
| Representative Phone: | 954-699-0900 |
| Email Address: | walter.sancho-davila@hotmail.com |
| Utility Emergency Phone: | 954-248-7396 |
| FPID # & Description: | 210447-5-52-01 - SR16 From International Golf Pkwy to I-95 (SR9) |

Existing facilities are located (please check all that apply):

- ☐ Within existing FDOT Right-of-Way (between Station: _____ to Station: _____)
- ☐ Vvh requested (Subsurface Utility Vacuum Excavation)
- ☐ Within existing County/City Right-of-Way
- ☐ Within railroad Right-of-Way
- ☐ Within an easement or fee title property (Has compensable interest and may claim reimbursement for required relocation)*
- ☒ Not within project limits (Has no facilities within limits)
- ☐ No Utility Work Schedule (Has facilities within limits but is not affected)
- ☐ Facilities located along Interstate corridor

* Provide any document(s) [i.e. fee title property deed or easement document(s)] within the project limits that formulates the basis for your entitlement to be reimbursed for your utility work. **NOTE:** A preliminary cost estimate for any utility work within this entitled area is required. Any expense incurred by your agency which is determined to be reimbursable, including engineering/design work and physical relocation work, cannot be paid by the Department until a formal contract is executed, noticed to proceed given and the proper invoice is submitted.

Enclosed you will find (please check all that apply):

- ☐ Utility Work Schedule (please submit by email for review – do no upload into PSEE)
- ☐ Marked Plans (RGBs) ☐ Company Utility Plans/Maps
- ☐ Legal Documents ☐ Preliminary Cost Estimate
- ☐ No enclosure and FDOT plans depict facilities correctly

POLE OWNERS: List Joint Pole Users

Comments:

Sign:

Walter Sancho-Davila