


St. Johns County Utility Department

Forms and Figures





1995 NW International Golf Parkway As Built Drawings



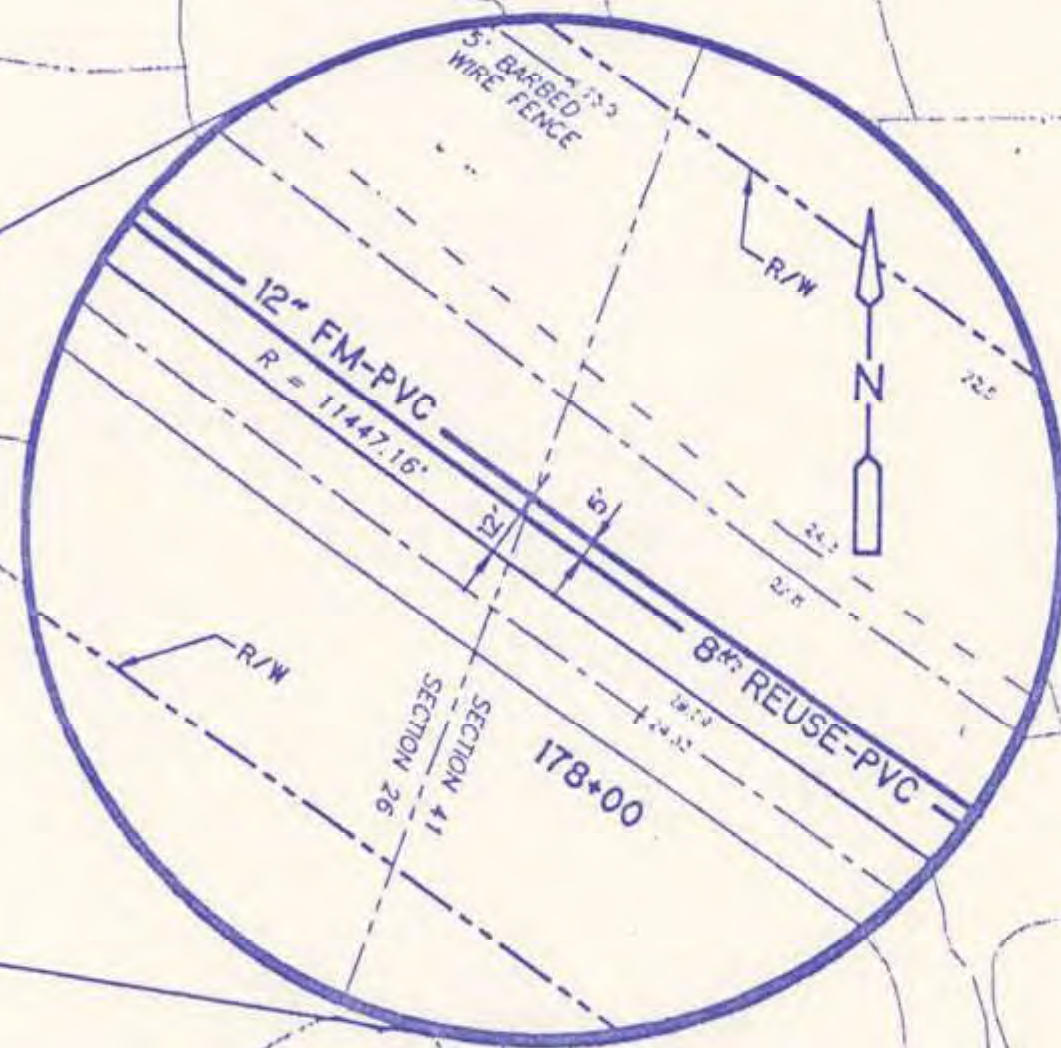



TYPICAL PIPING ROUTING

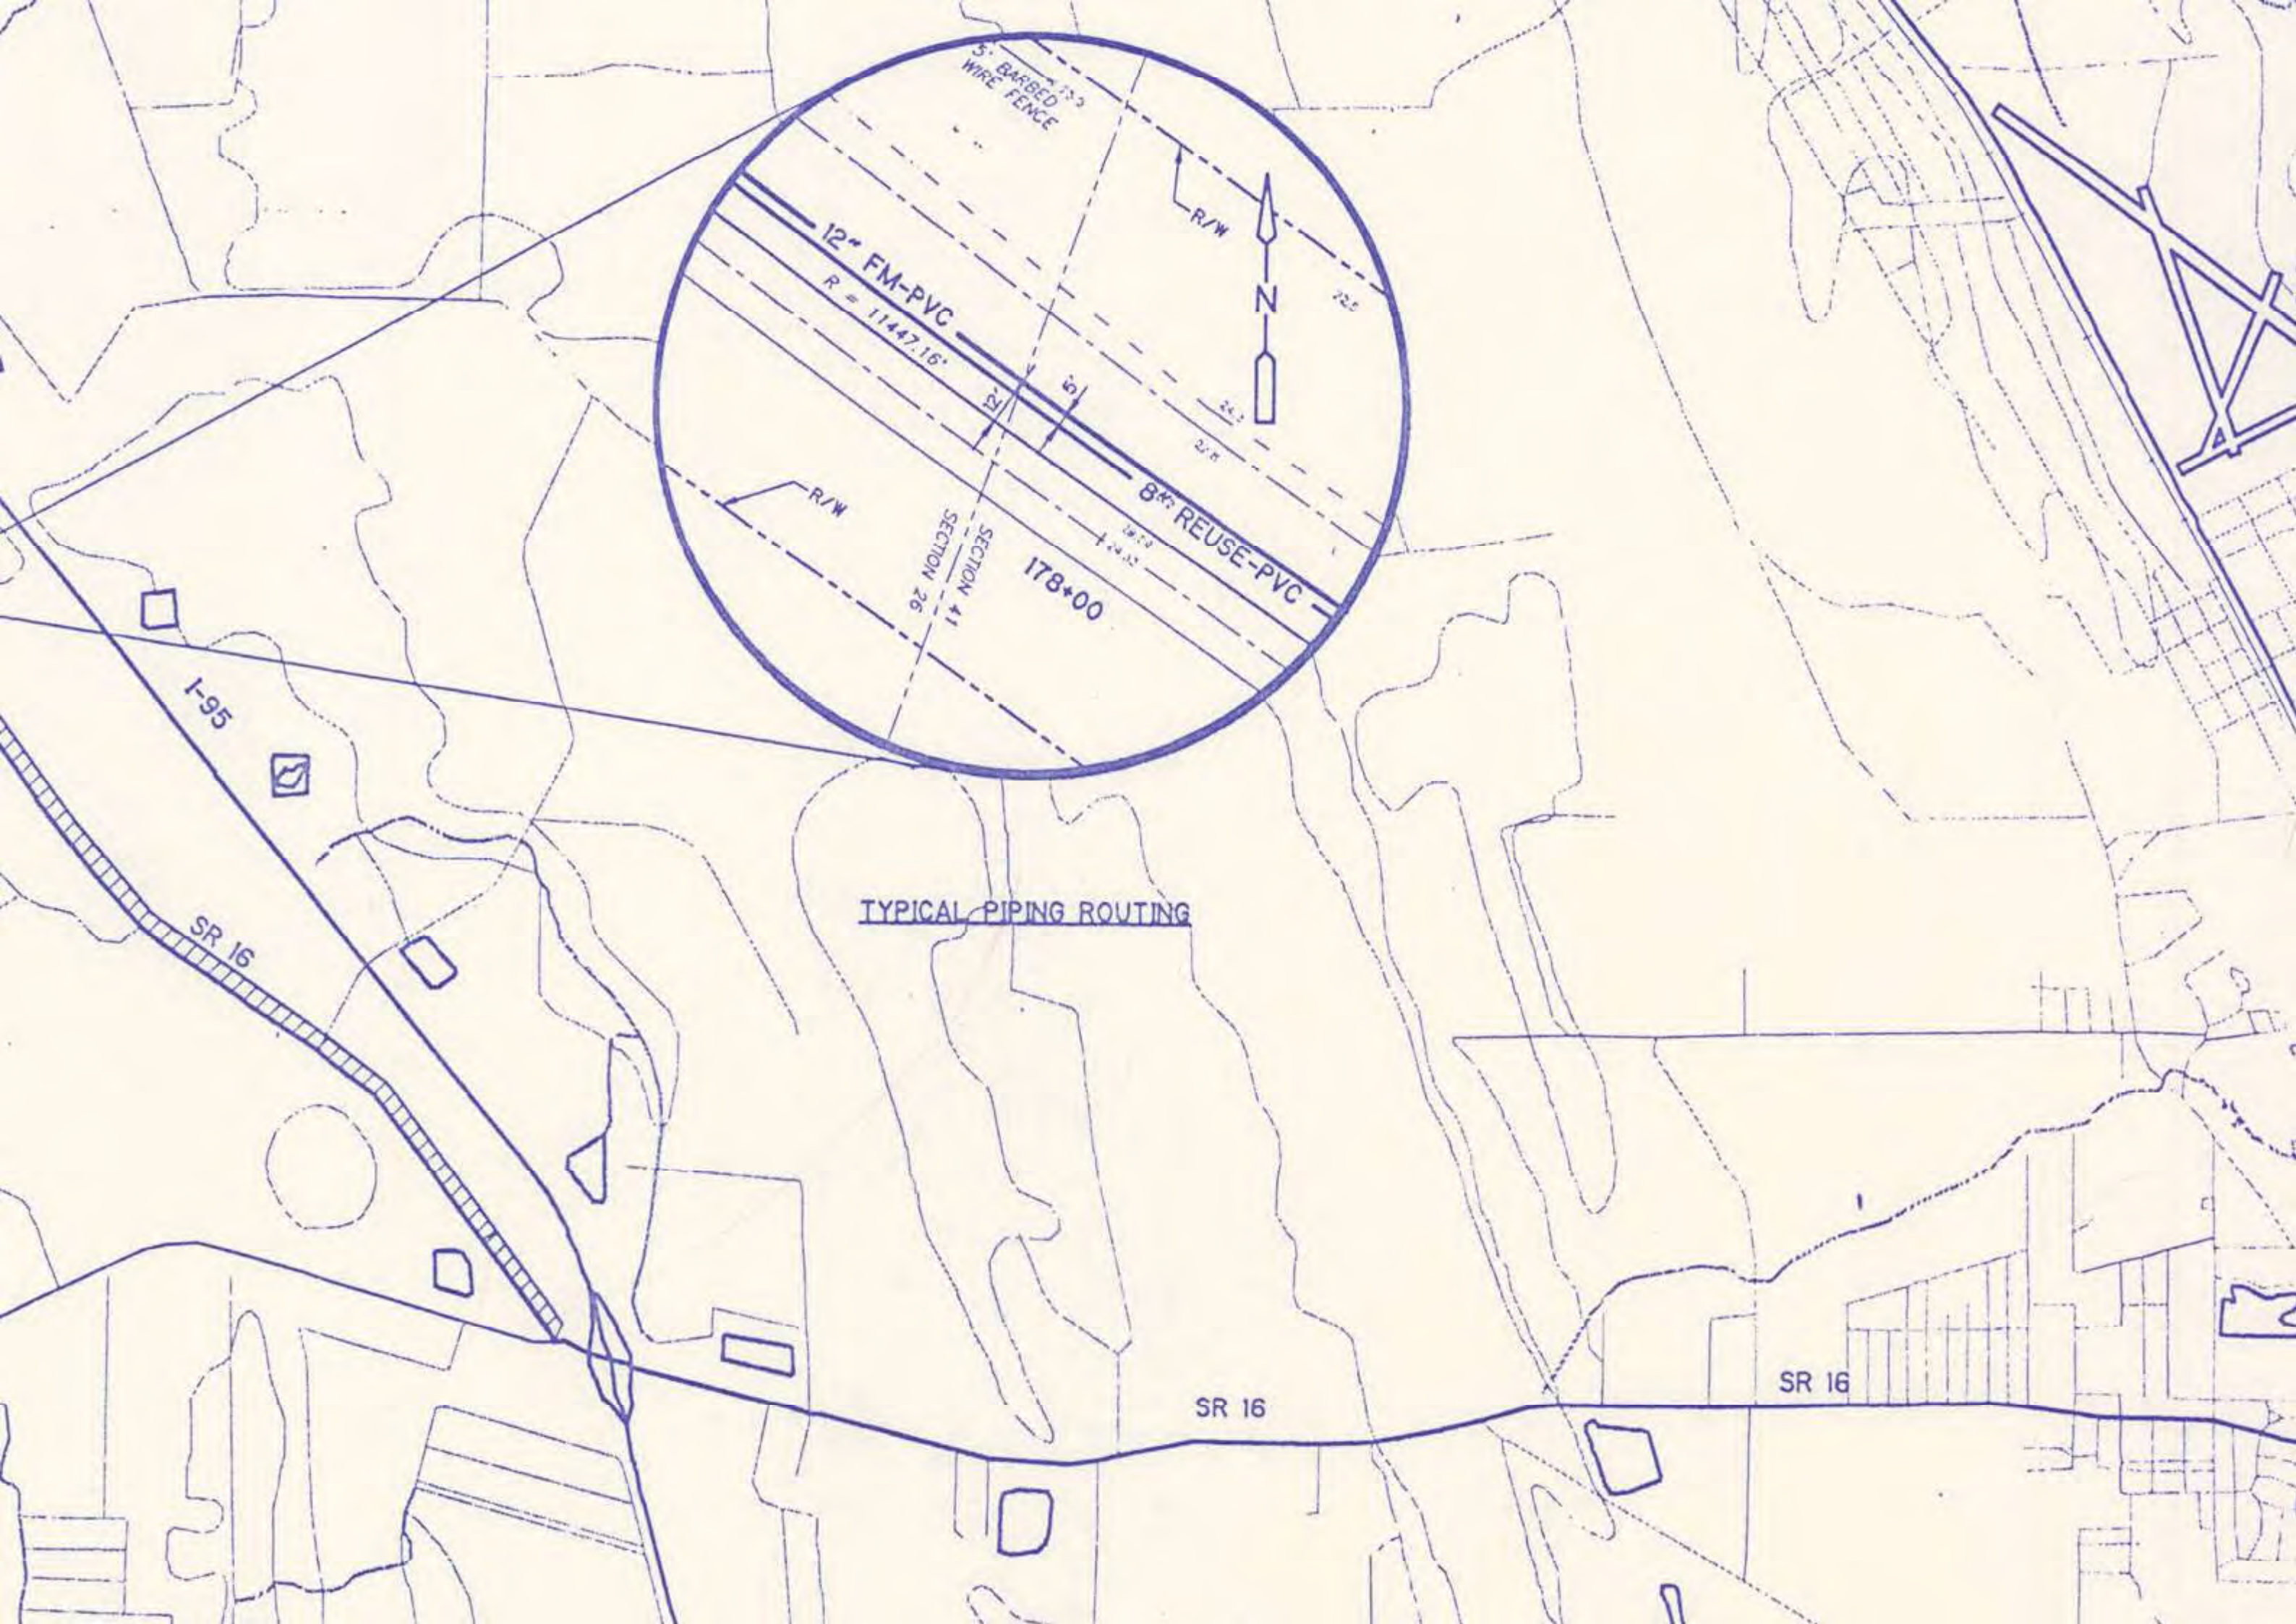


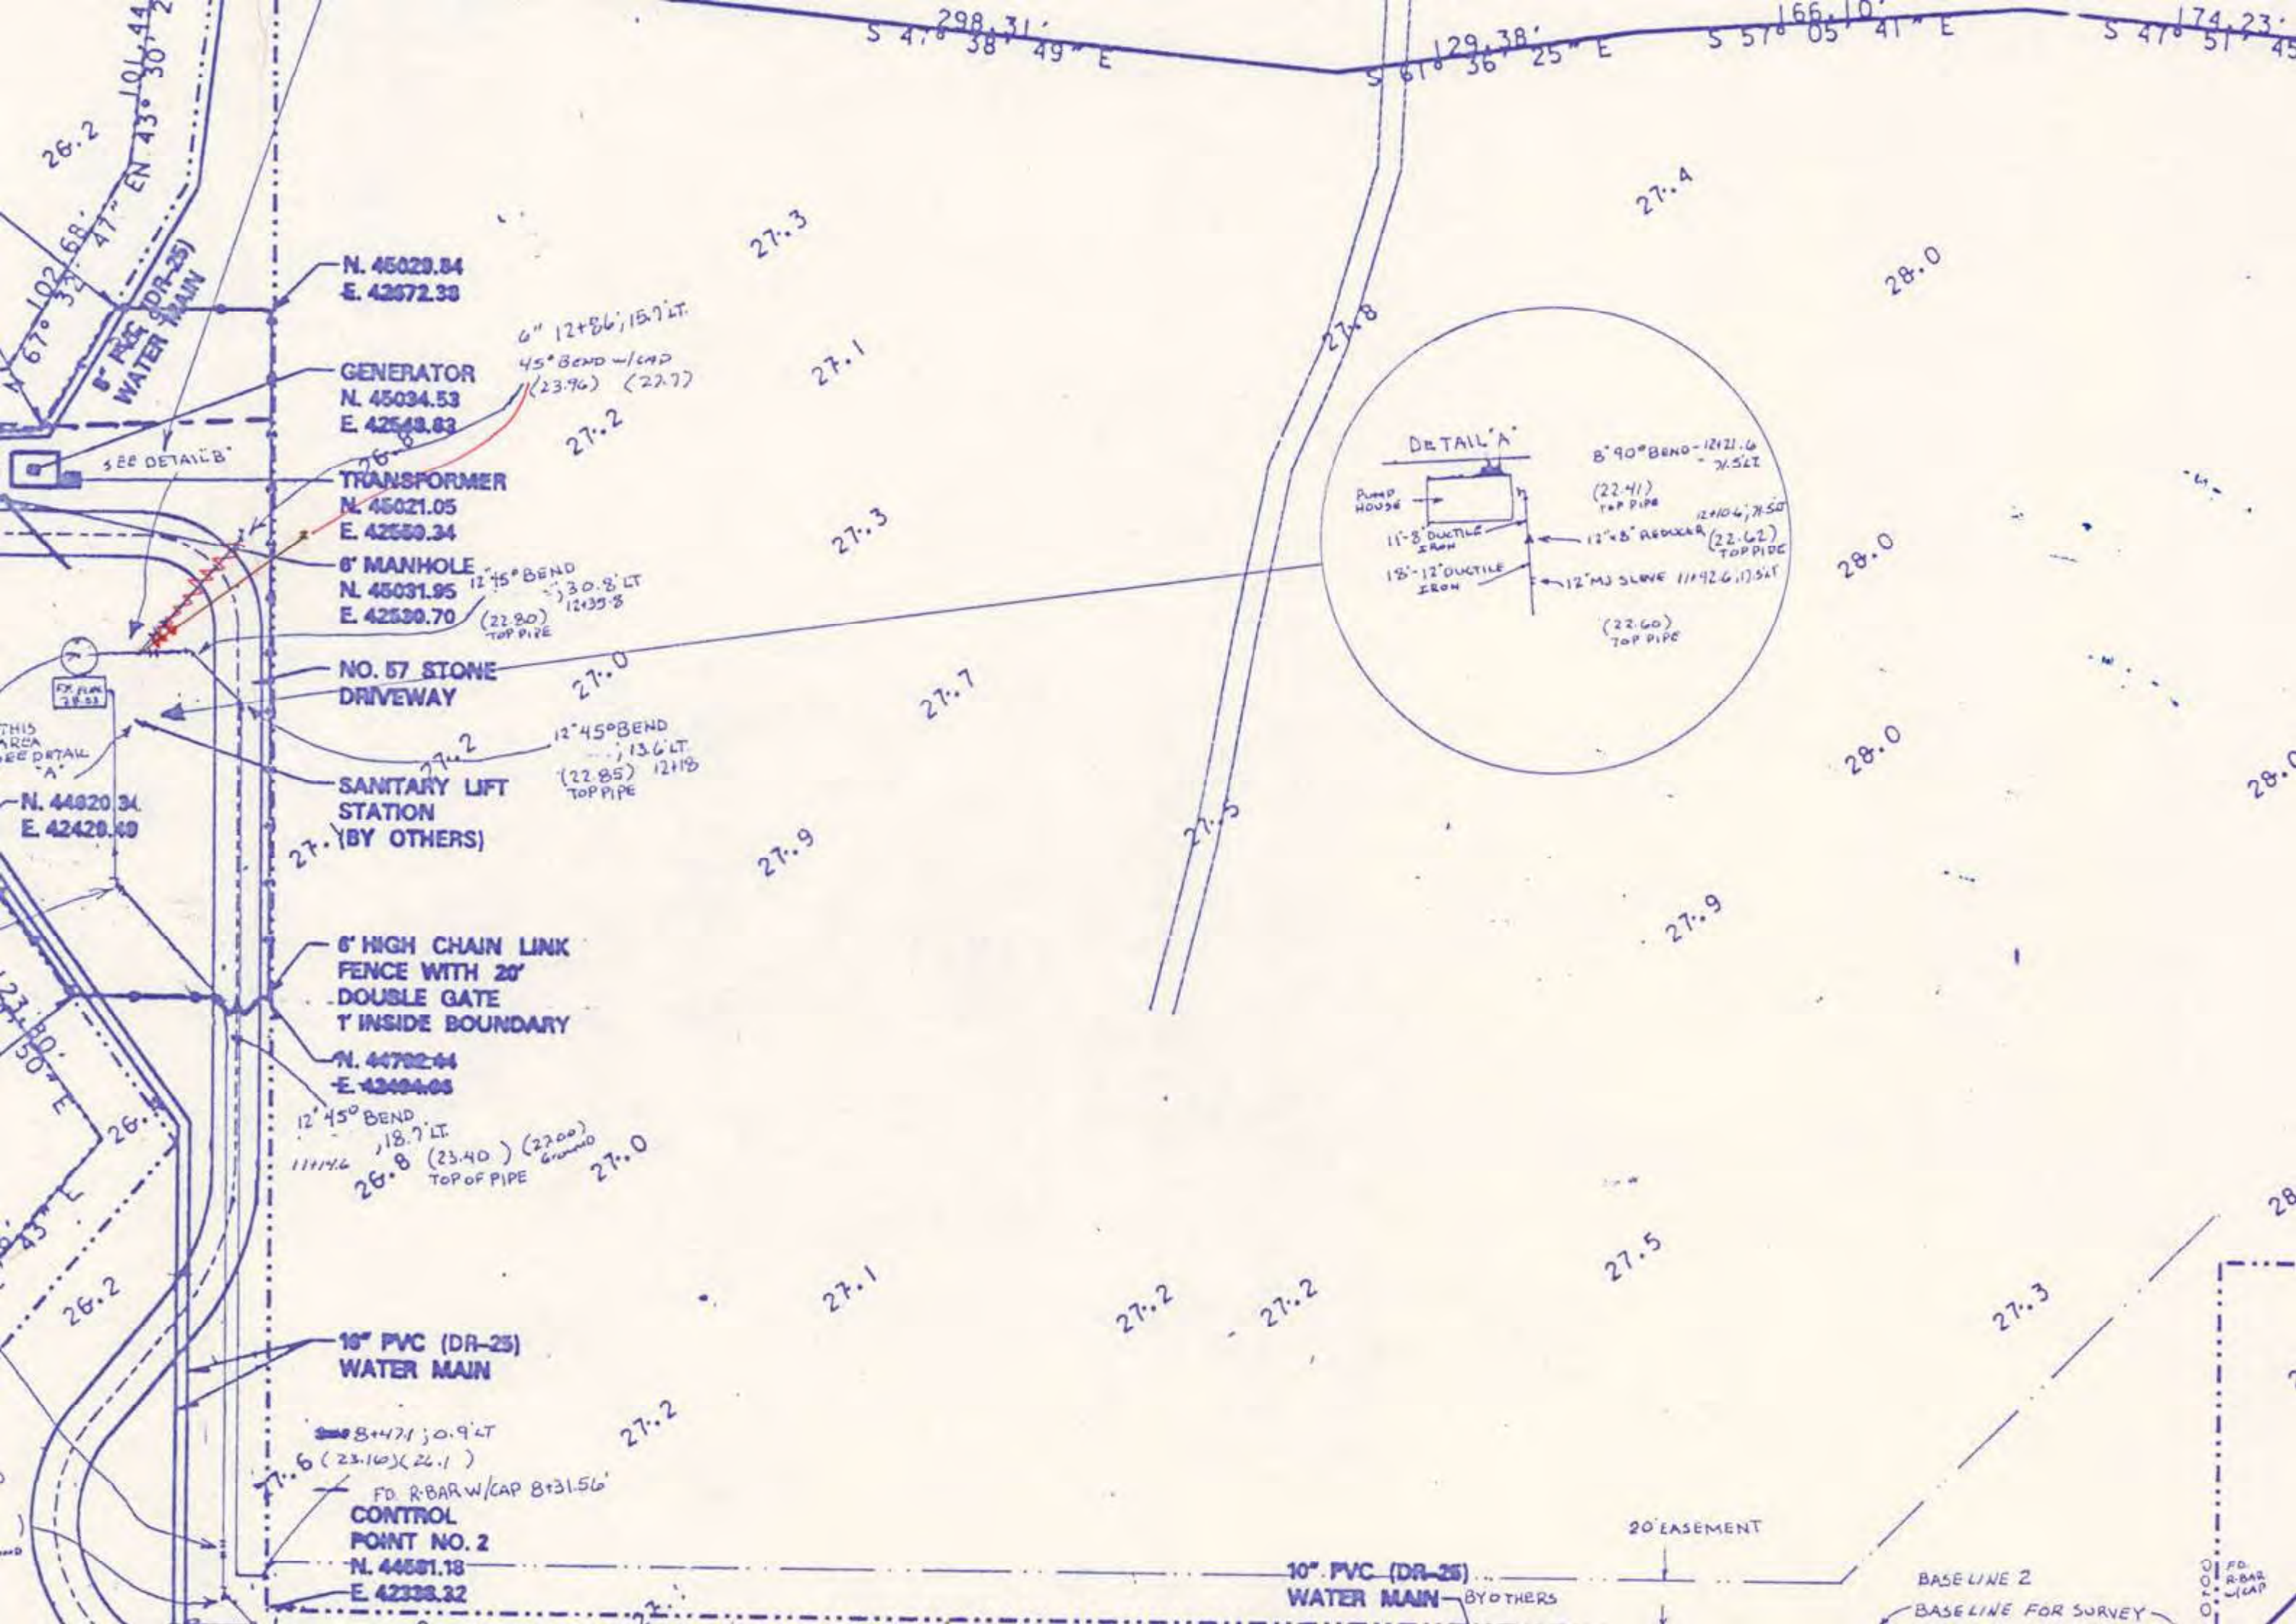

STA 12


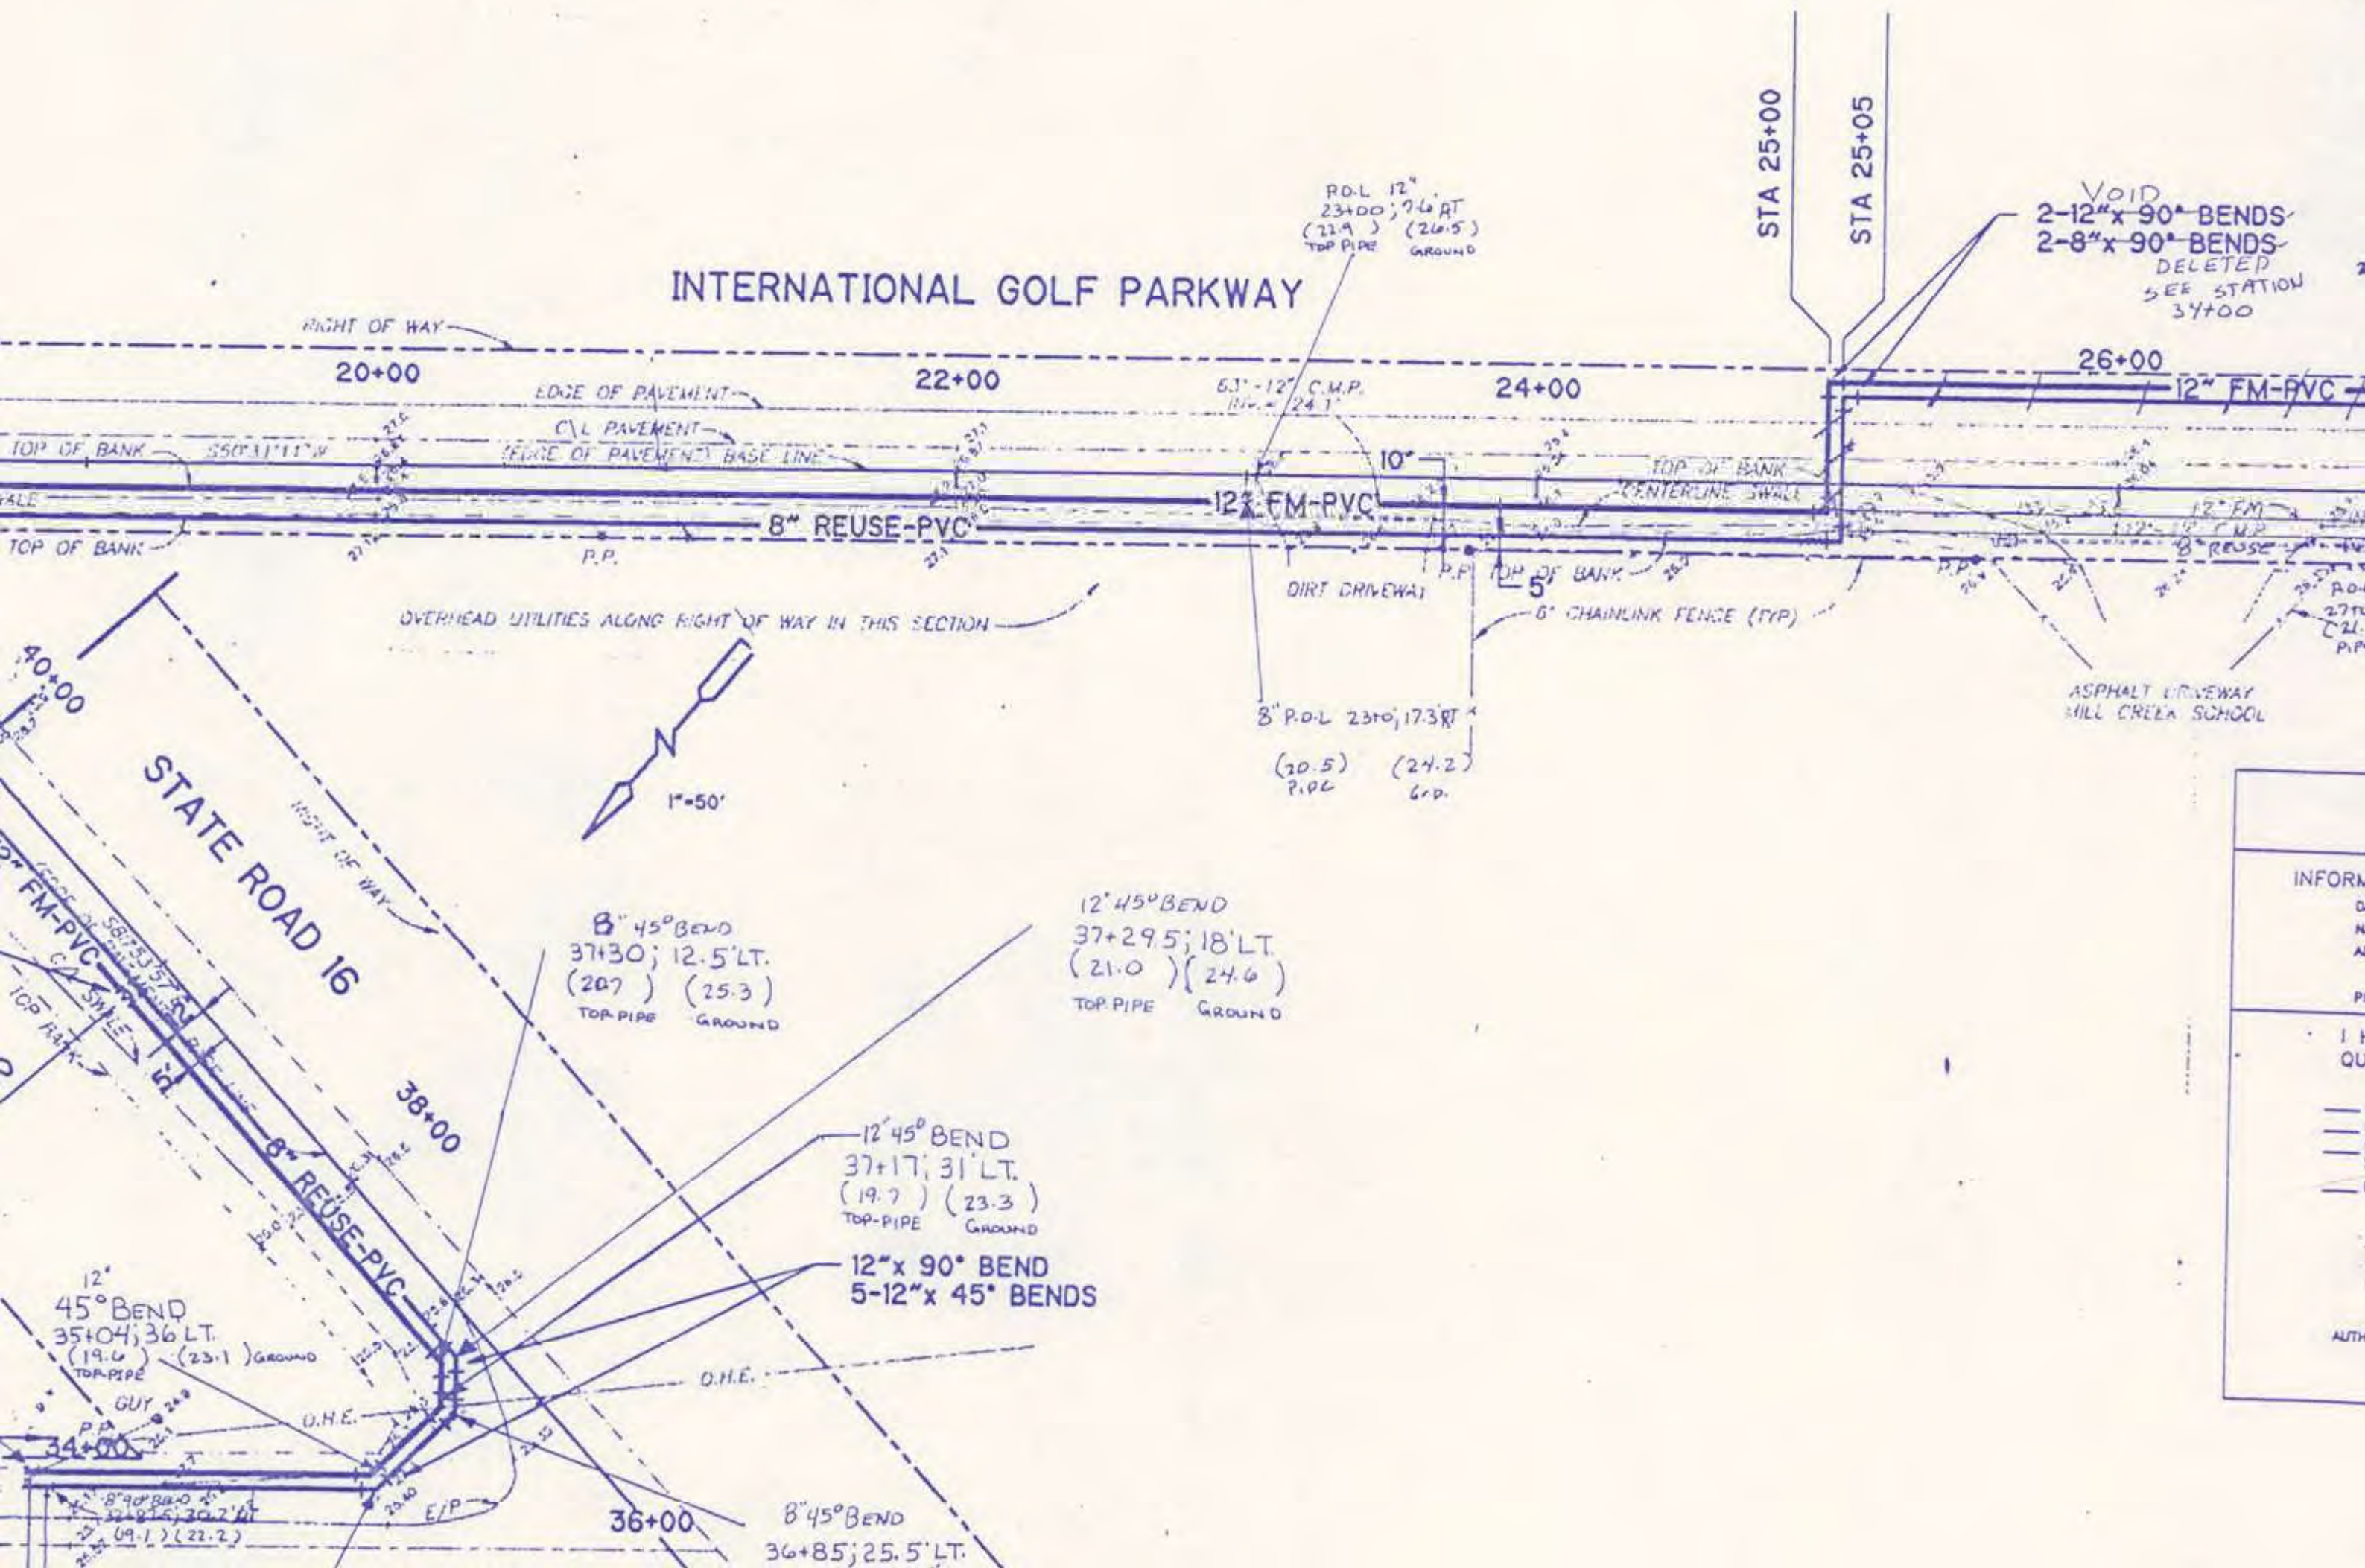


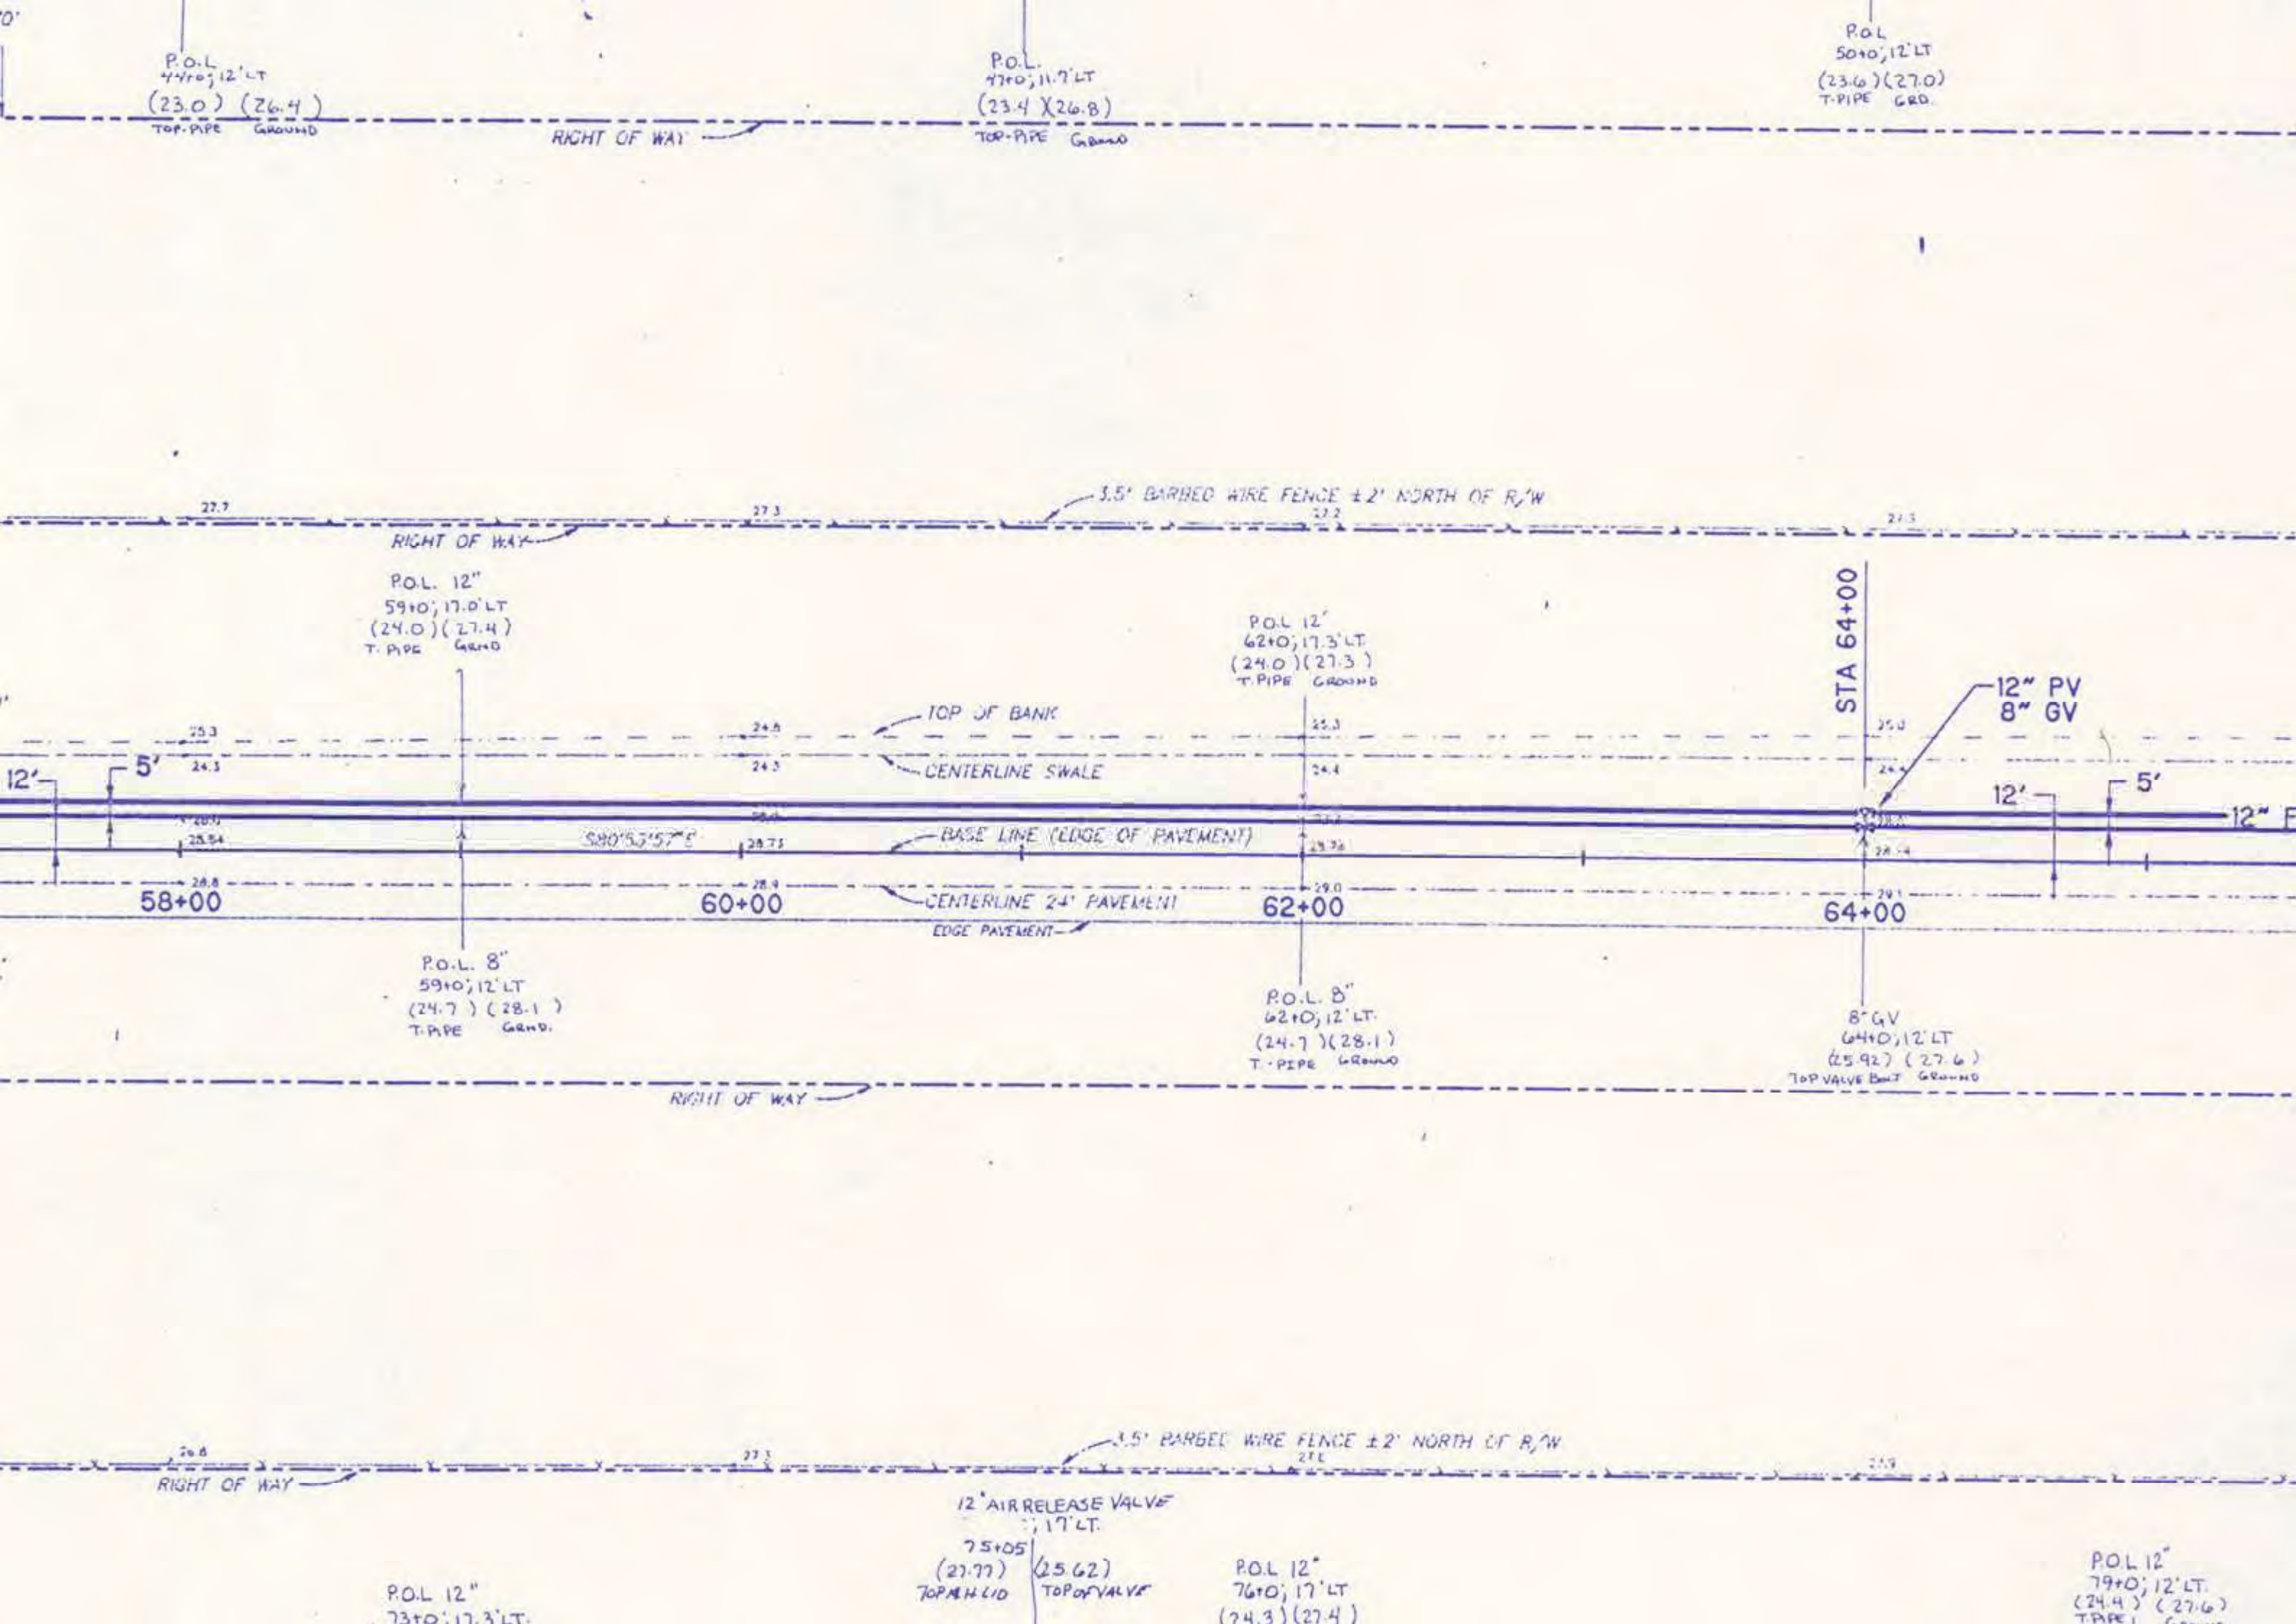


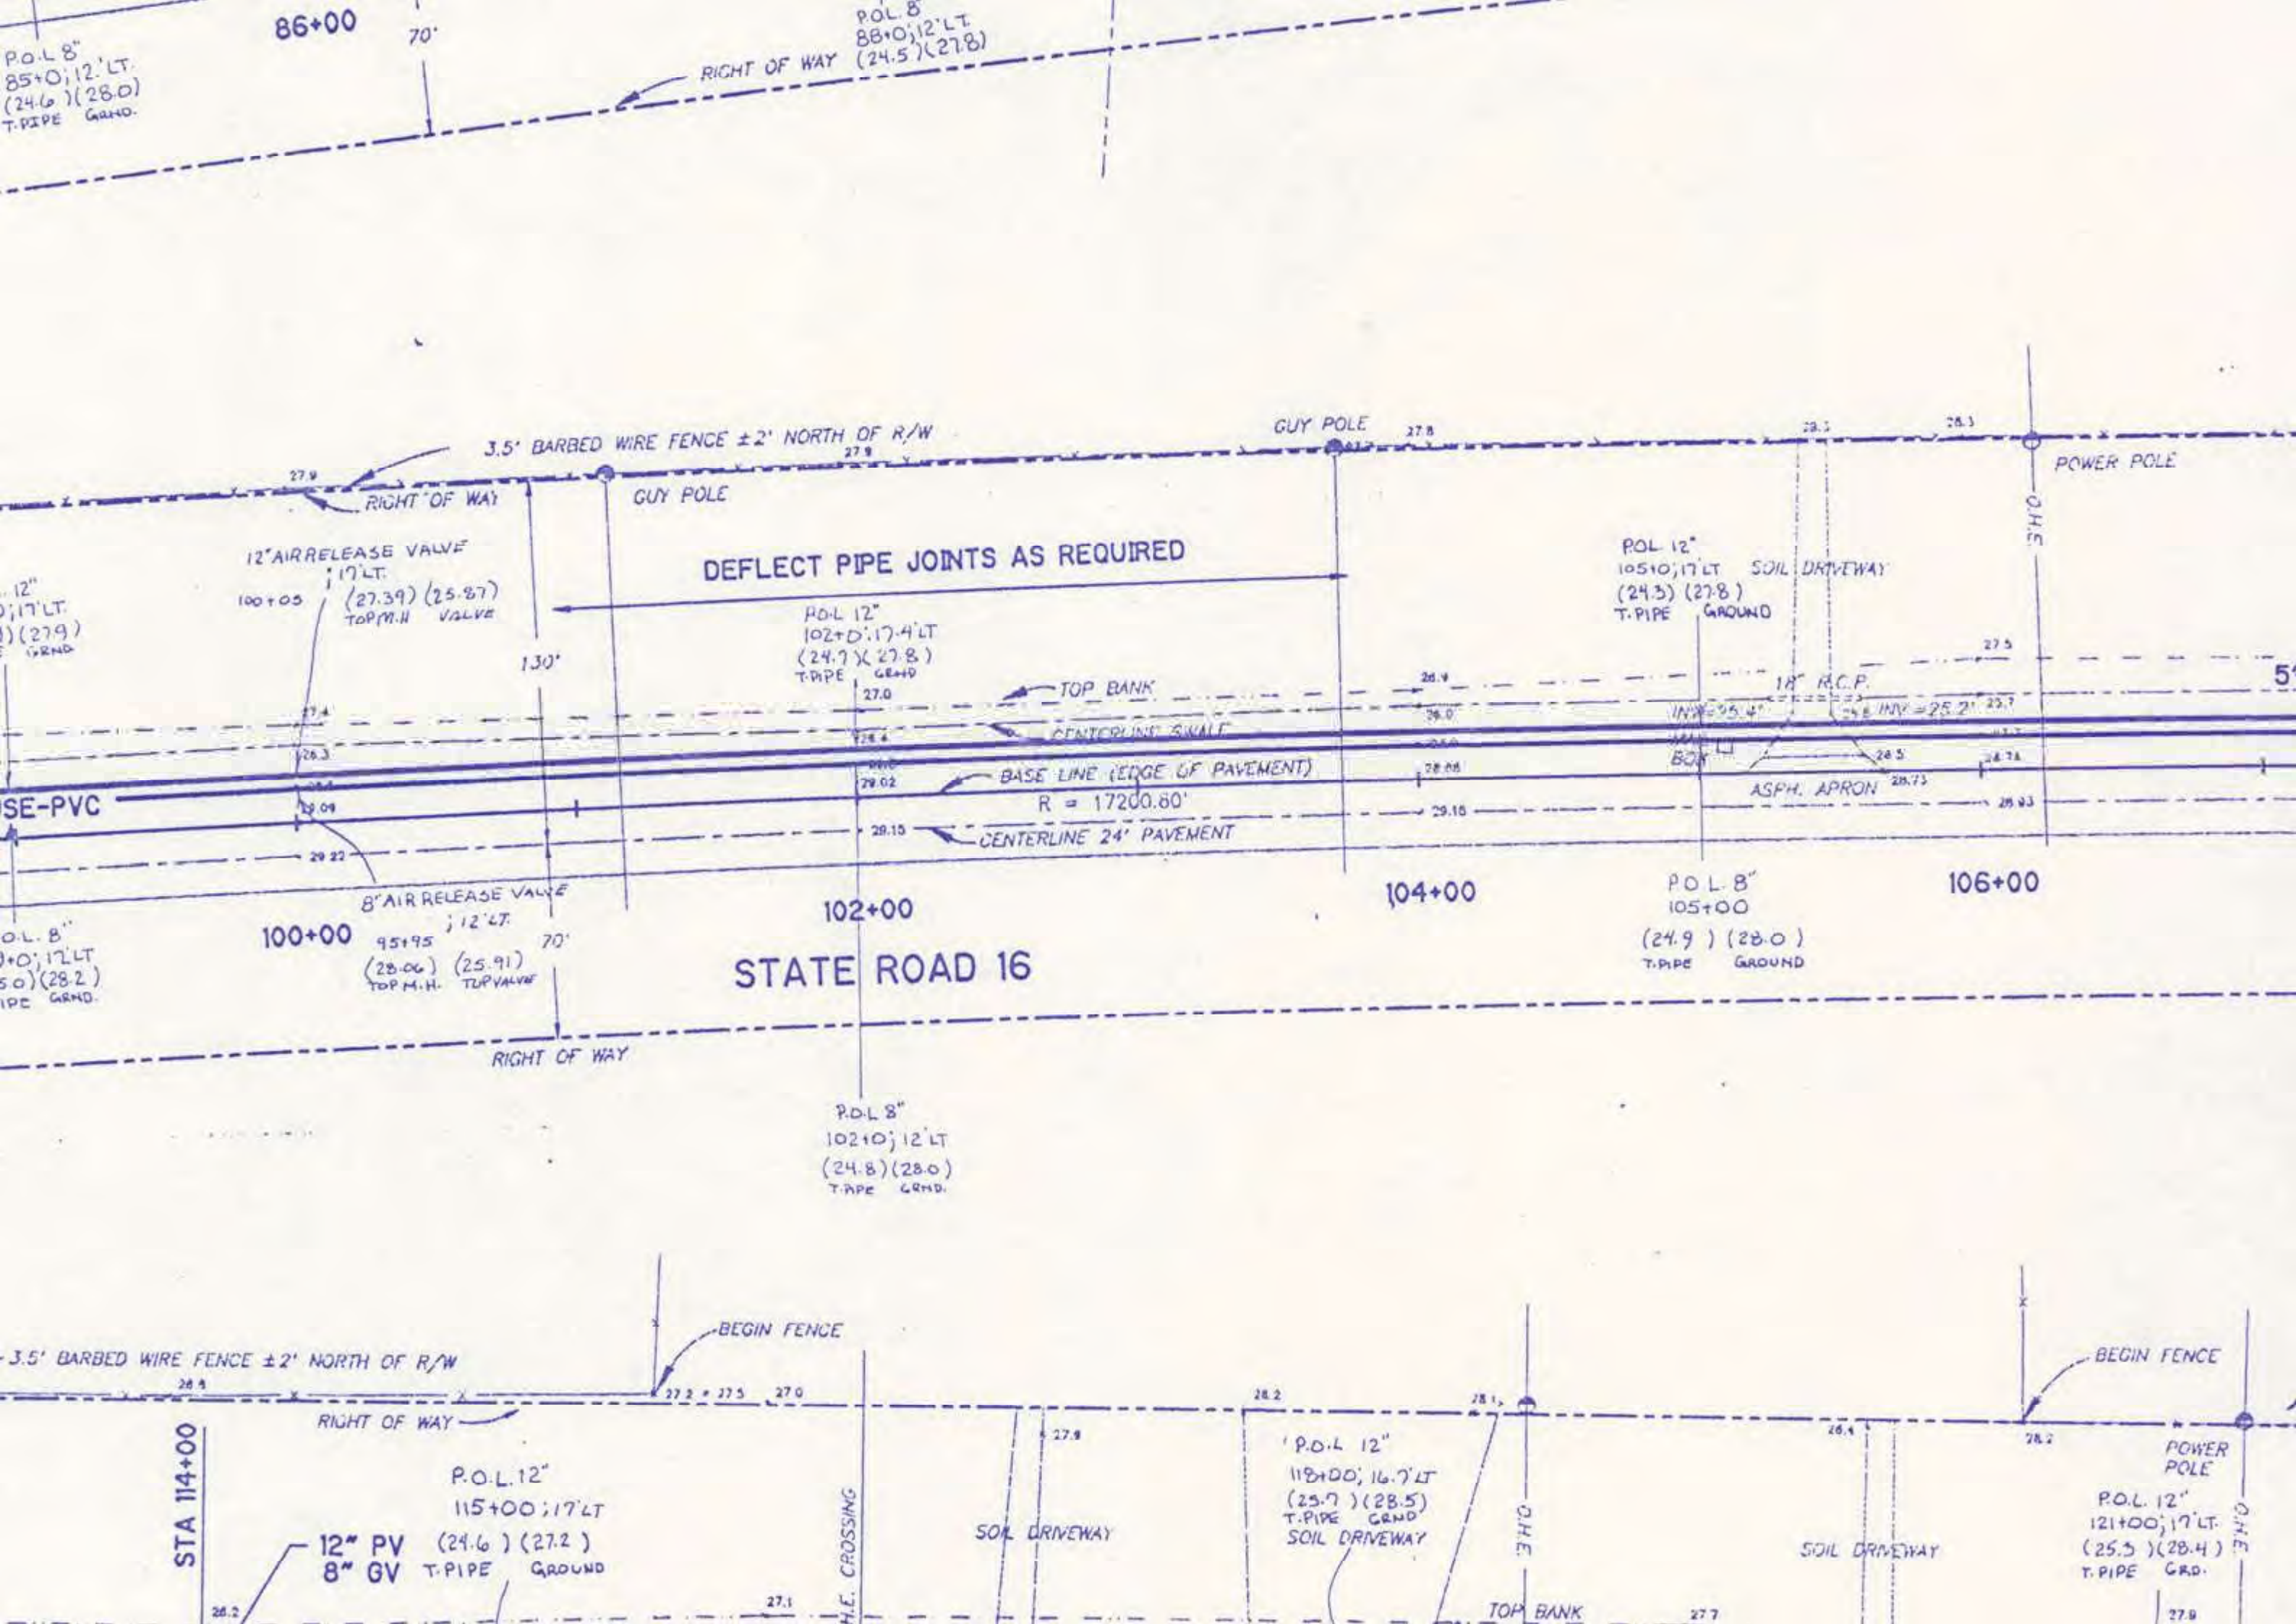



AS BUILT

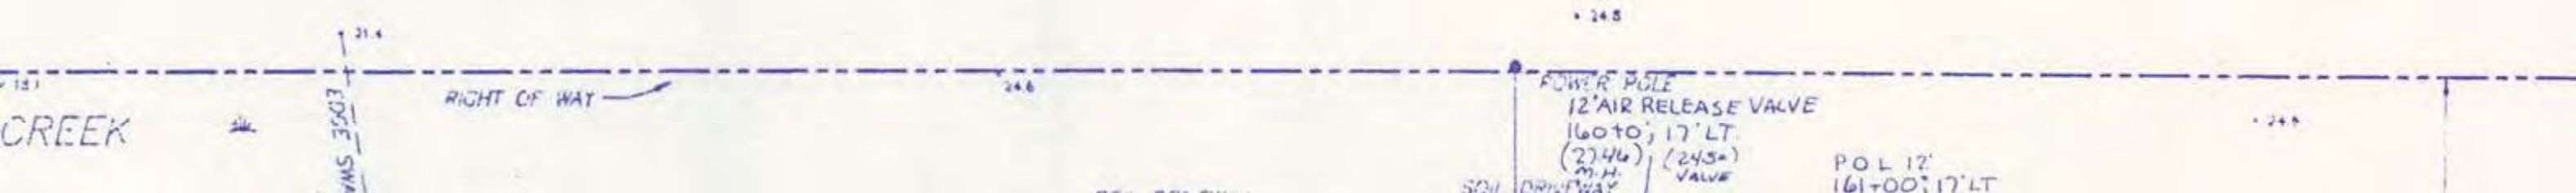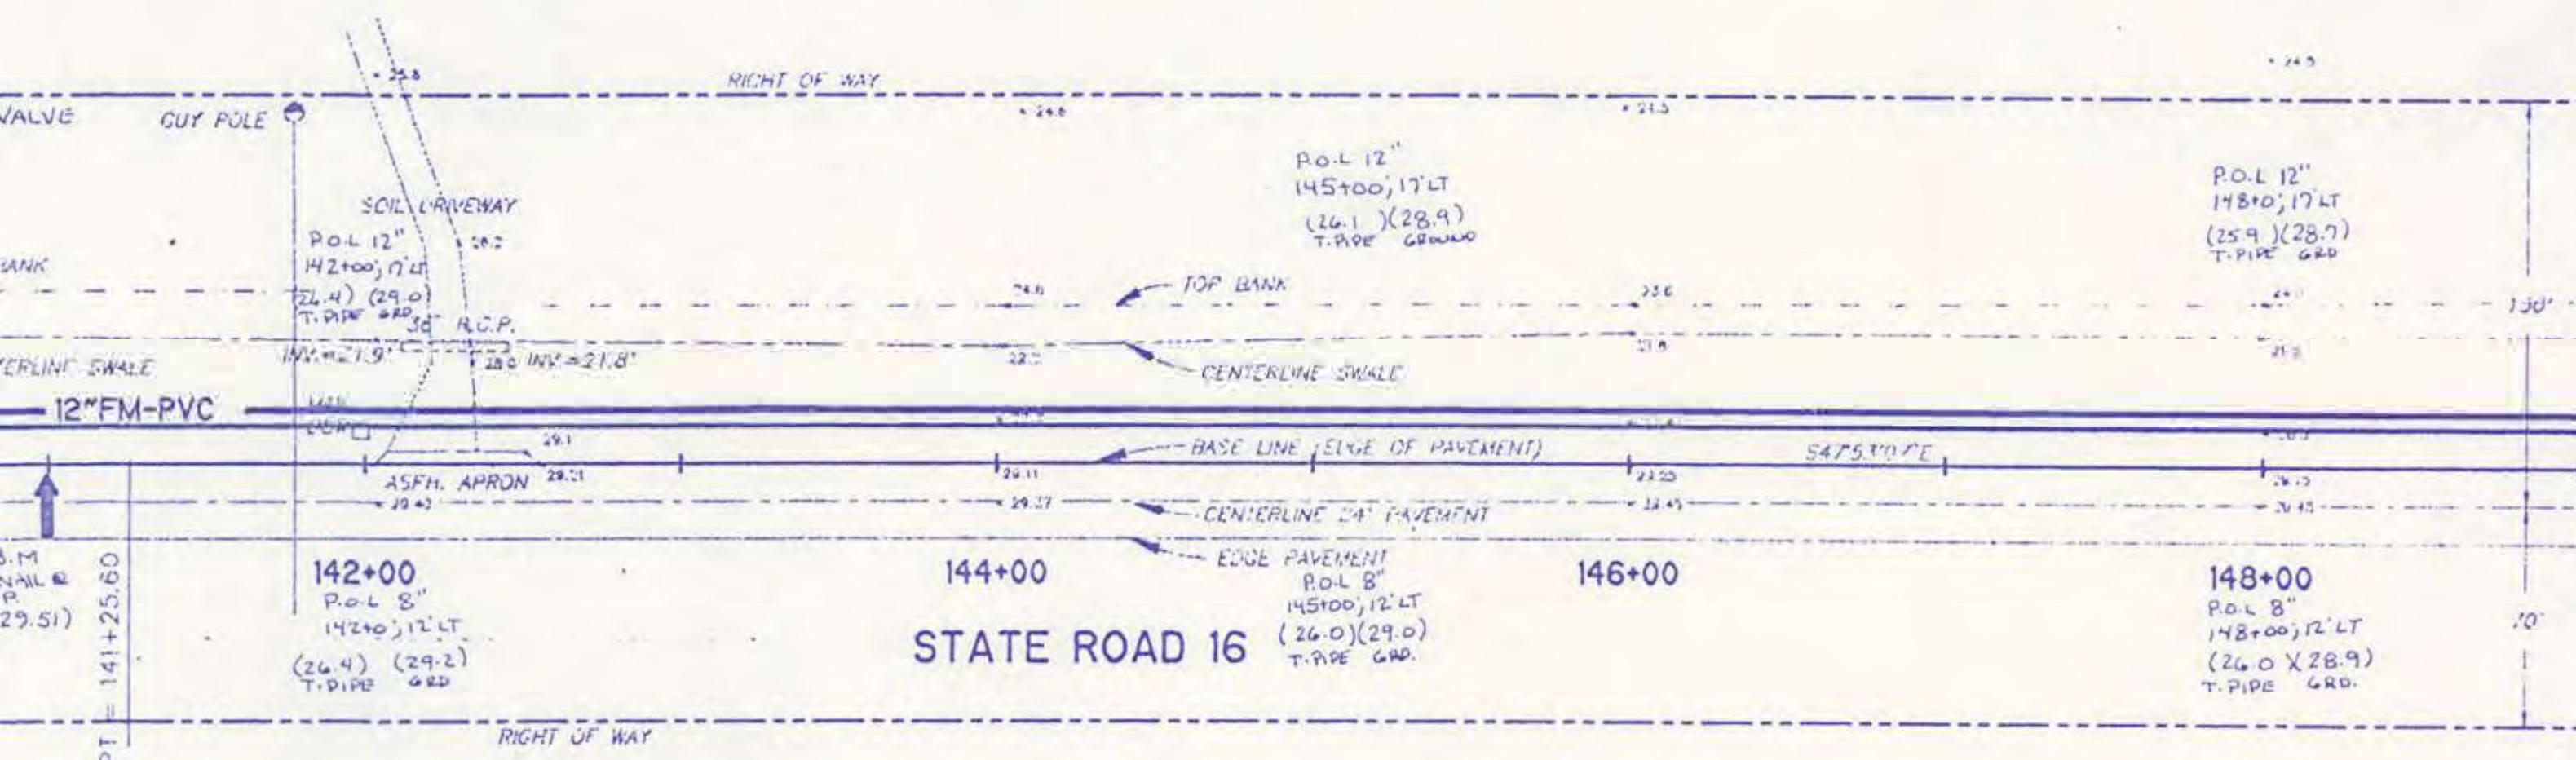

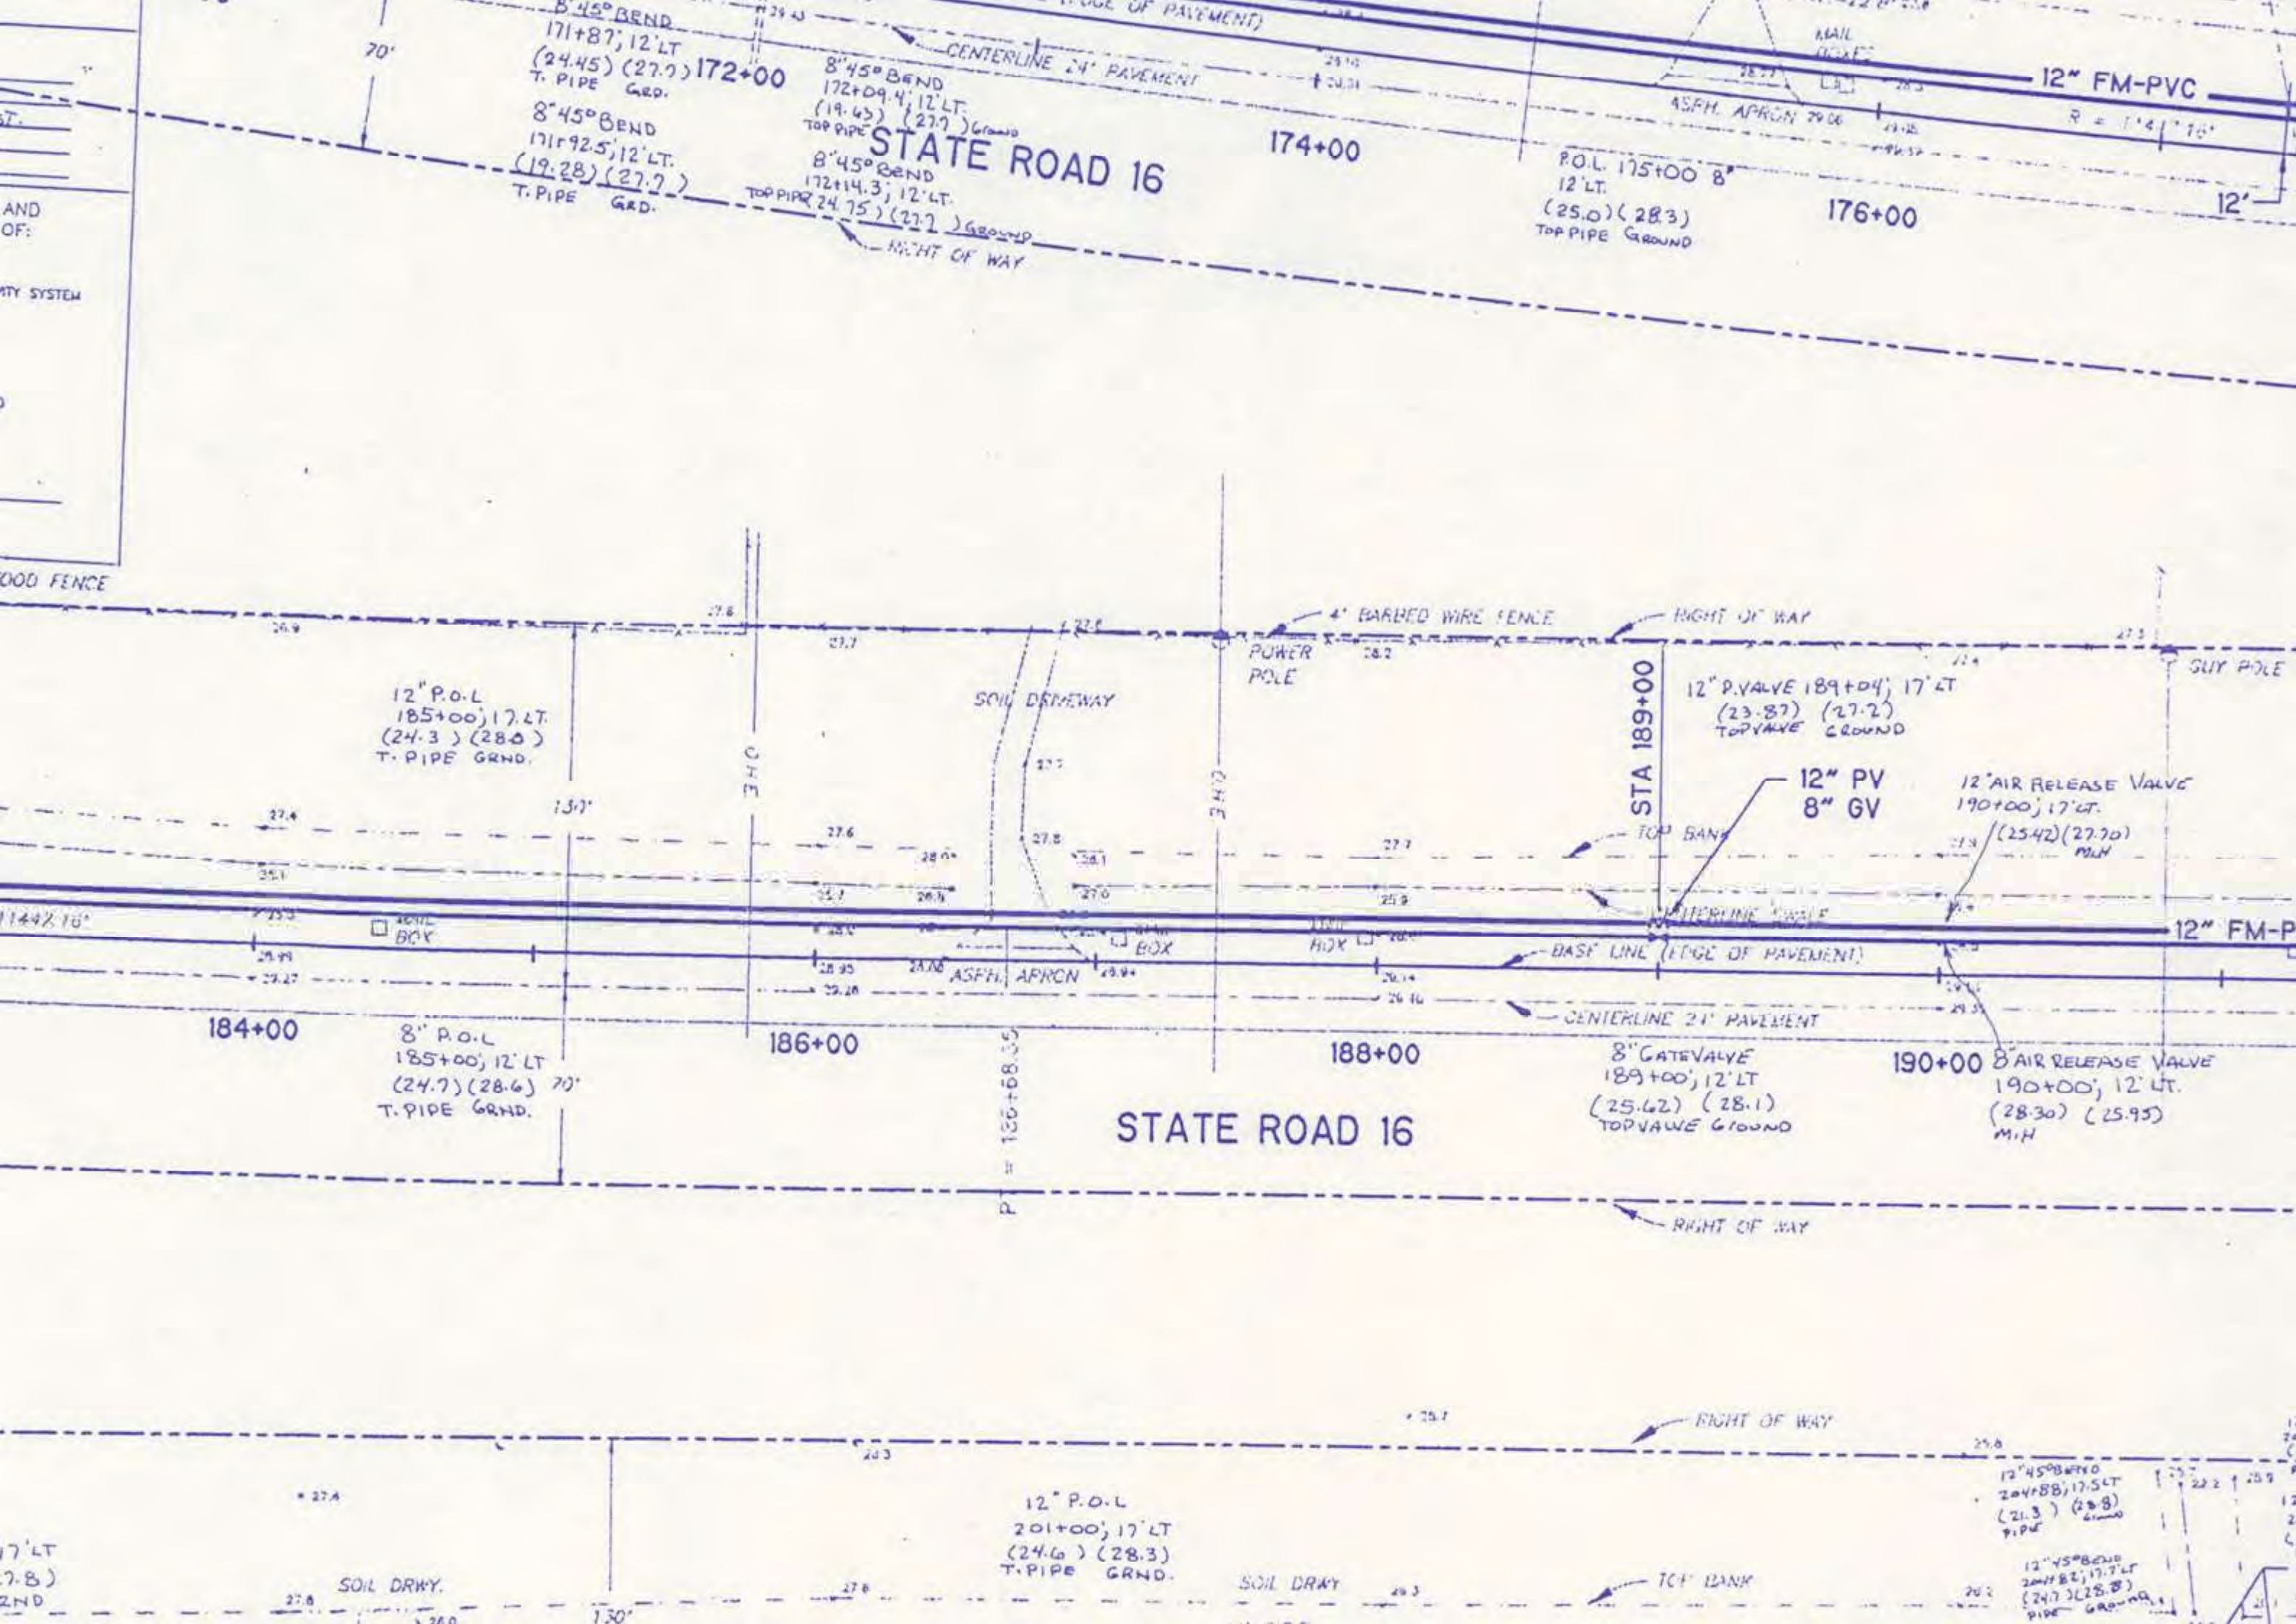

212+00

STATE ROAD 16

215+00

216+00

218+00

AS-BUILT

INFORMATION PROVIDED BY:

DATE: 5-6-96
 NAME: FIGHTEN CONSTRUCTION
 ADDRESS: 1275 COUNTY ROAD 210 WEST
 PHONE #: 808-1818

I HEREBY CERTIFY THAT THE MATERIALS AND
 QUANTITIES USED IN THE CONSTRUCTION OF:

PAVEMENT
 CURB & GUTTER
 STORM & DRAINAGE
 SYSTEM
 UNDERDRAIN
 WATER MAIN
 SANITARY GRAVITY SYSTEM
☒ FORCE MAIN
 LIFT STATION

ARE IN ACCORDANCE WITH THE APPROVED PLANS AND
 CITY SPECIFICATIONS, UNLESS OTHERWISE APPROVED
 BY THE CITY ENGINEER.

AUTHORIZED SIGNATURE

[Signature]
 CONTRACTOR

RIGHT OF WAY

PIPE JOINTS AS REQUIRED

12" P.O.L.
 227+00; 17' LT.
 (24.1) (27.8)
 TOP PIPE GROUND

P.O.L. 12"
 230+00; 17' LT.
 (23.4) (27.1)
 TOP PIPE GROUND

12" P.O.L.
 233+00
 (23.4)
 TOP PIPE

226+00

8" P.O.L.
 227+00; 12' LT.
 (24.8) (28.3)
 TOP PIPE GROUND

228+00

STATE ROAD 16

230+00
 8" P.O.L.
 230+00; 12' LT.
 (24.1) (27.6)
 TOP PIPE GROUND

232+00

8" P.O.L.
 233+00
 (24.4)
 TOP PIPE

RIGHT OF WAY



12" PV. 239+00; 17' LT.
 (23.84) (27.9)
 TOP VALVE GROUND

12" PV
 8" GV


P.O.L. 12"
 242+00; 17' LT.
 (23.8) (26.8)
 TOP PIPE GROUND

P.O.L. 12"
 246+00; 17' LT.
 (24.0) (27.5)
 TOP PIPE GROUND

SOIL GRW

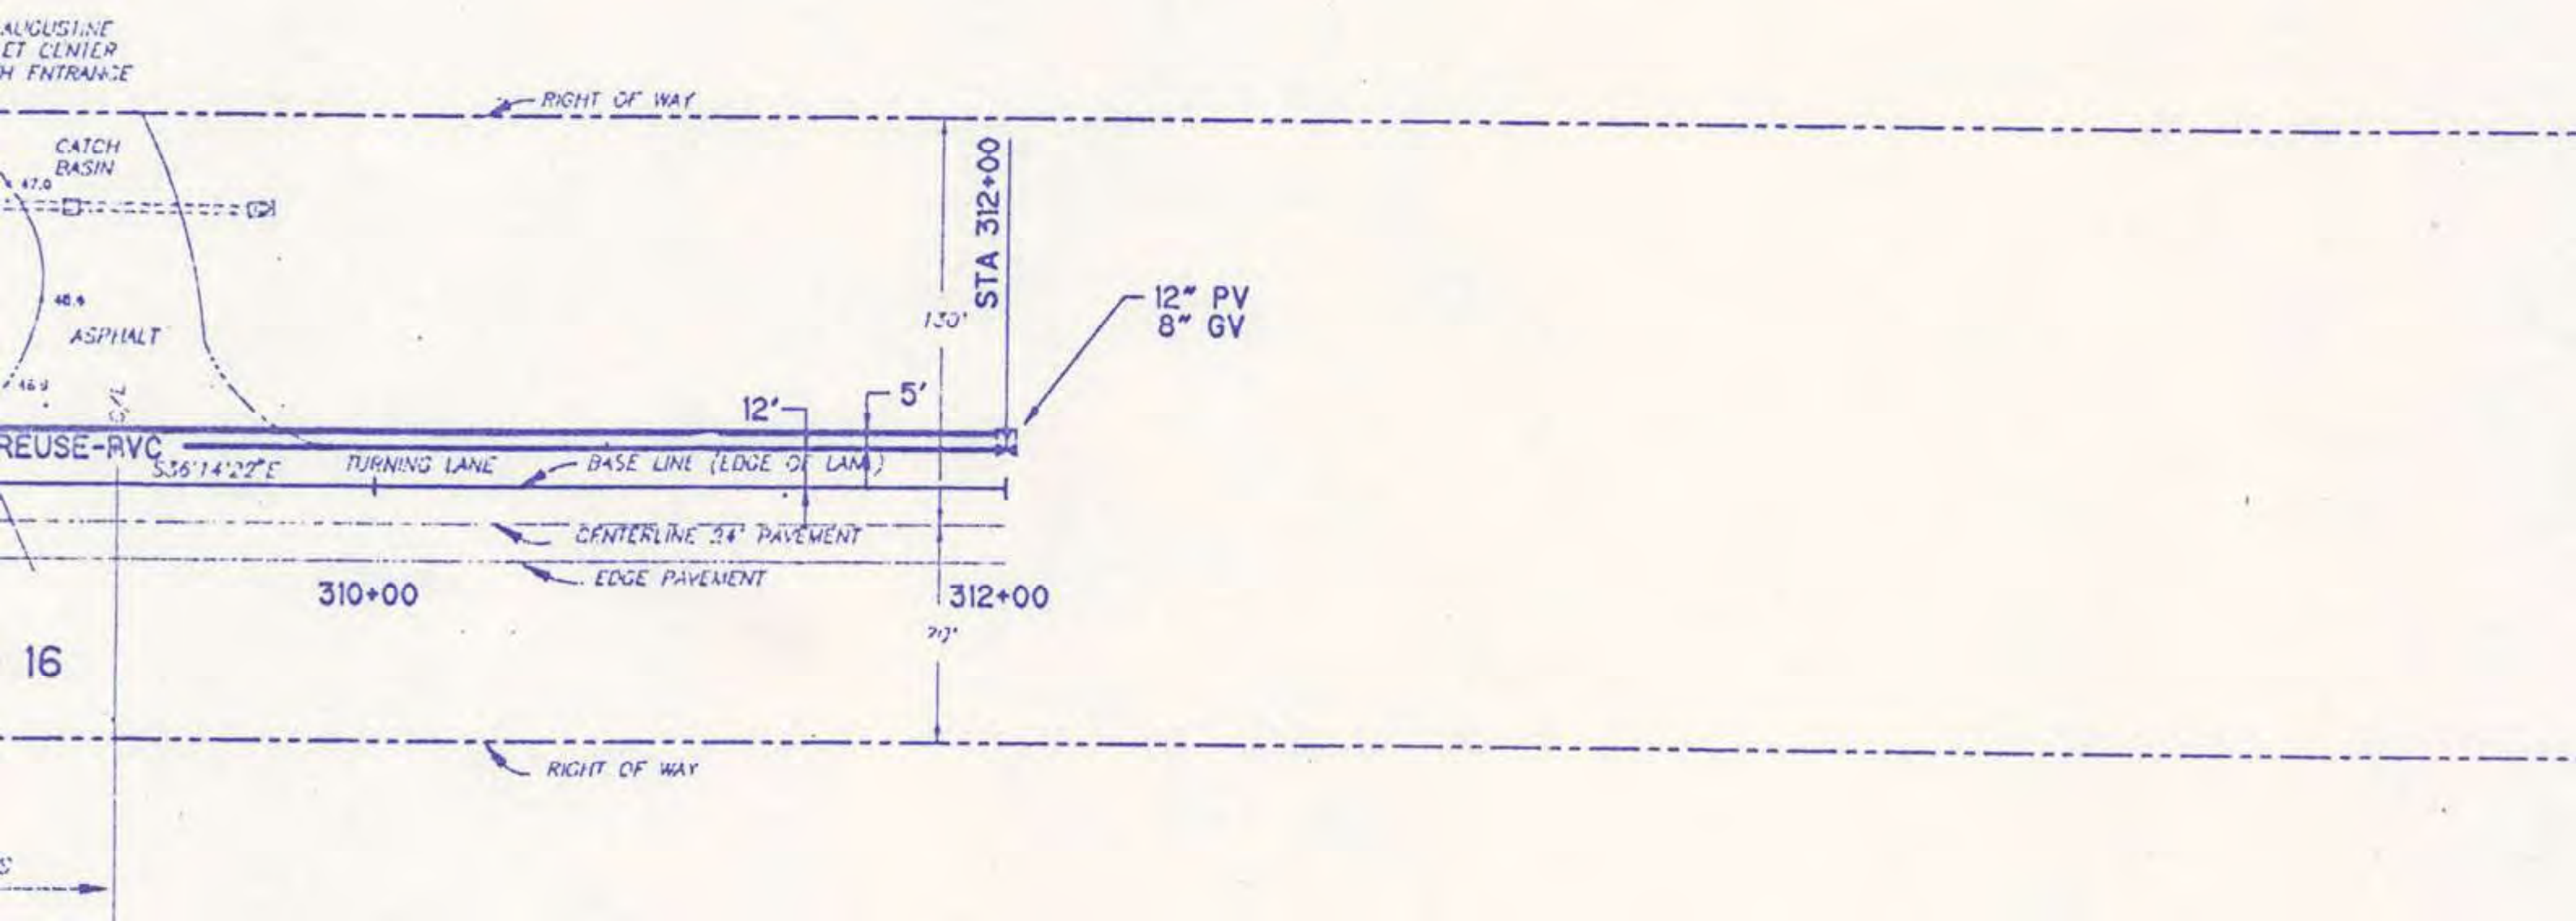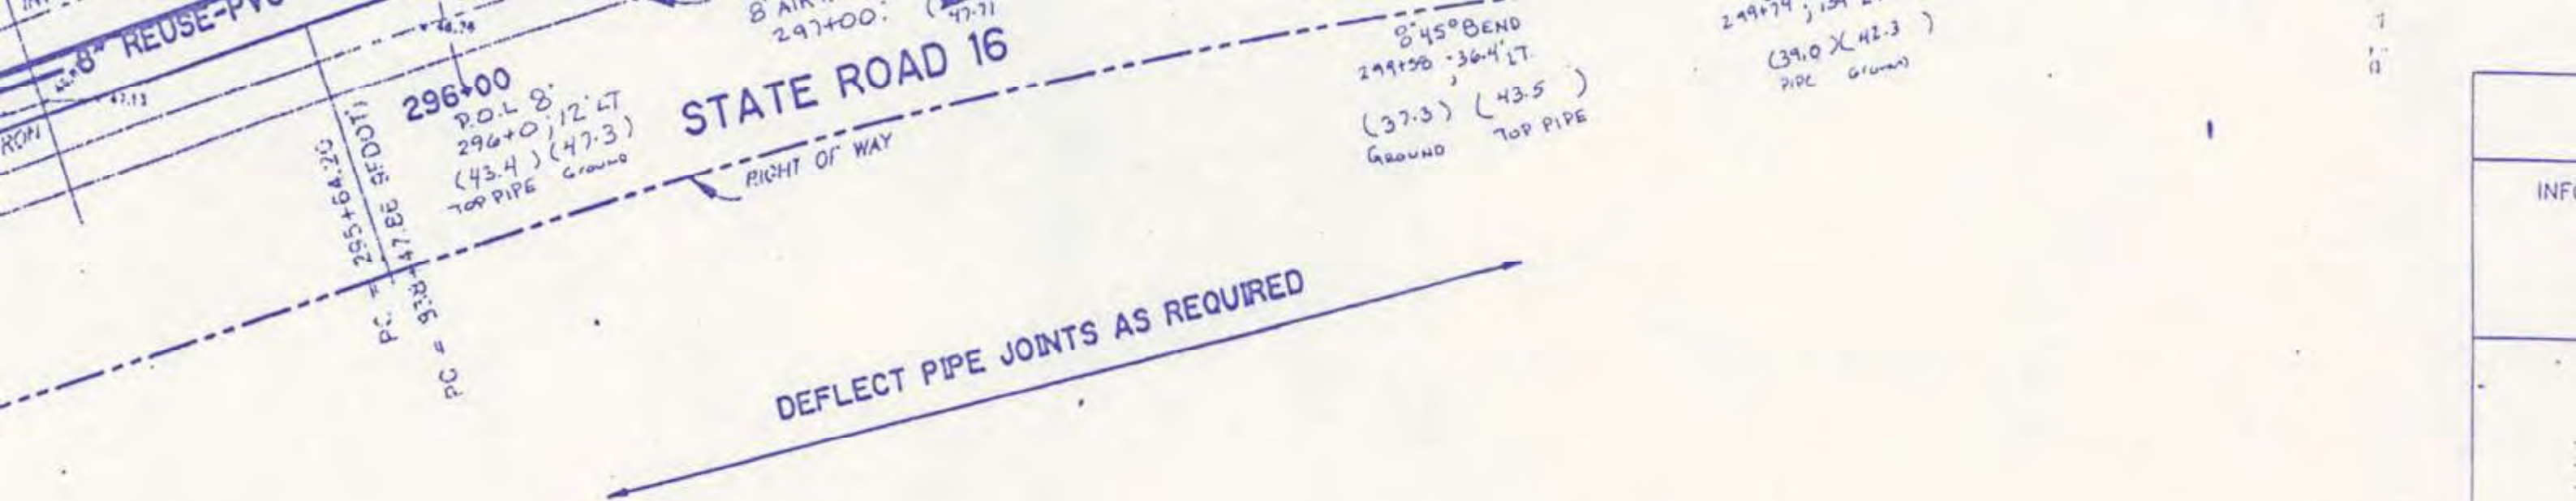



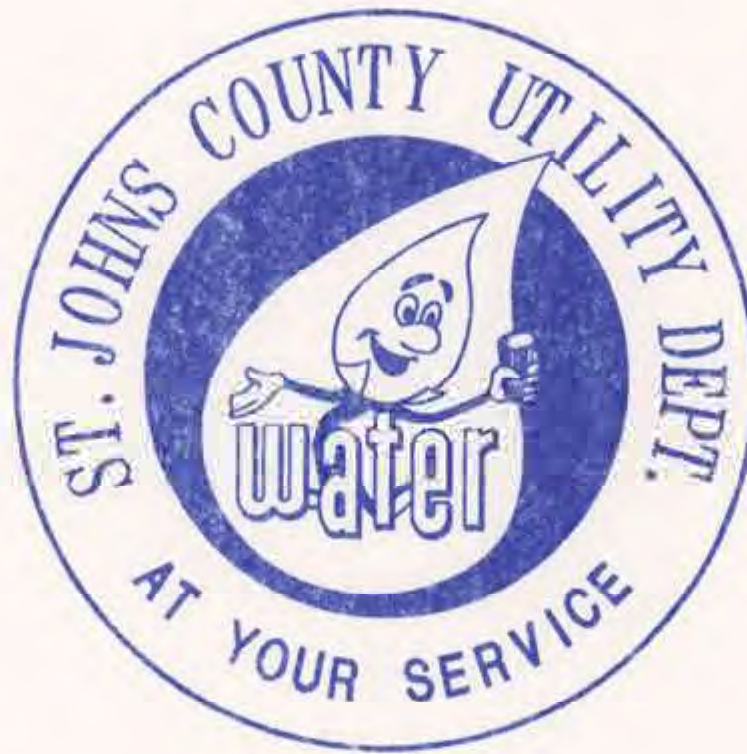








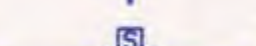
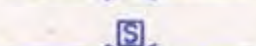











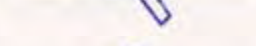
ST. JOHNS COUNTY, FLORIDA




INTERNATIONAL GOLF PARKWAY UTILITIES EXTENSION SECTION A


PLAN
PLAN
[illegible]

	NEEDLE VALVE	FLOOR	H.	FLOOR STAND
	PINCH VALVE	HIGH	H.P.	GATE VALVE
	DIAPHRAGM VALVE	HIGH POINT	INFL.	HARNESSED FLANGE ADAPTER COUPLING
	BUTTERFLY VALVE	INFLUENT	LG.	HOSE BIBB
	PLUG VALVE	LONG	L.P.	HYDRAULIC VALVE ACTUATOR
	3-WAY PLUG VALVE	LOW POINT	MTL.	MECHANICAL JOINT PLUG
	4-WAY PLUG VALVE	MATERIAL	MFG.	PLASTIC BALL VALVE
	CHECK VALVE, GENERAL SYMBOL	MANUFACTURE	MAX.	PLASTIC CHECK VALVE
	BALL CHECK VALVE	MAXIMUM	MECH.	PLUG VALVE
	DOUBLE DOOR CHECK VALVE	MECHANICAL	MET.	SILENT CHECK VALVE
	ANGLE VALVE	METAL	MIN.	UNION
	SOLENOID VALVE	MINIMUM	MTD.	VALVE BOX
	THREE WAY SOLENOID VALVE	MOUNTED	NOM.	VICTAULIC COUPLING (GROOVED ENDS)
	FOUR WAY SOLENOID VALVE	NOMINAL	N.T.S.	VICTAULIC COUPLING (SHOULDERED ENDS)
	MOTOR OPERATED VALVE	NOT TO SCALE	NO.	WALL SLEEVE
	FLAP VALVE	NUMBER	O.C.	WALL PIECE (WITH WATER STOP)
	SHEAR GATE	ON CENTER	OPT.	
	MUD VALVE	OPTION	OPP.	
	FLOOR DRAIN	OPPOSITE	OPNG.	
	OPEN EQUIPMENT DRAIN	OPENING	O/E.	
	ECCENTRIC REDUCER OR REDUCING BUSHING	OR EQUAL	PC.	
	CONCENTRIC REDUCER OR REDUCING BUSHING	PIECE	PT.	
	Y-STRAINER	POINT	LB.	
	CALIBRATION CYLINDER	POUND	PL.	
	AIR RELEASE VALVE	RADIUS	RAD., R.	ASBESTOS CEMENT PIPE
		REQUIRED	REQ'D	BLACK STEEL PIPE
		RIGHT OF WAY	R/W	CAST IRON
		ROOM	RM.	CAST IRON PIPE
		SQUARE	SQ.	CAST IRON SOIL PIPE
		STAINLESS STEEL	S.S.	CONCRETE PRESSURE PIPE
		SIDEWALK	SDWK.	COPPER PIPE
		SHEET	SH., SHT.	DUCTILE IRON PIPE
		SYMMETRICAL	SYMM.	DUCTILE IRON
		SECTION	SEC.	FIBERGLASS REINFORCED PIPE
		STANDARD	ST'D	FLANGE
		STEEL	STL.	GALVANIZED STEEL PIPE
		THICK	THK.	MECHANICAL JOINT
		TYPICAL	TYP.	METAL REINFORCED PLASTIC PIPE
		TEMPORARY	TEMP.	POLYETHYLENE PIPE
		THREADED	THD.	POLYVINYLCHLORIDE
		UTILITY EASEMENT	U.E.	REINFORCED CONCRETE PIPE
		VERTICAL	VERT.	RESTRAINED JOINT
		WEST	W.	SLIP-ON JOINT
		WITH	W/	STEEL PIPE
		WATER LEVEL	W.L.	TIED JOINT
		WEATHERPROOF	WPF.	VITRIFIED CLAY PIPE
		WATER	WTR.	

PIPE

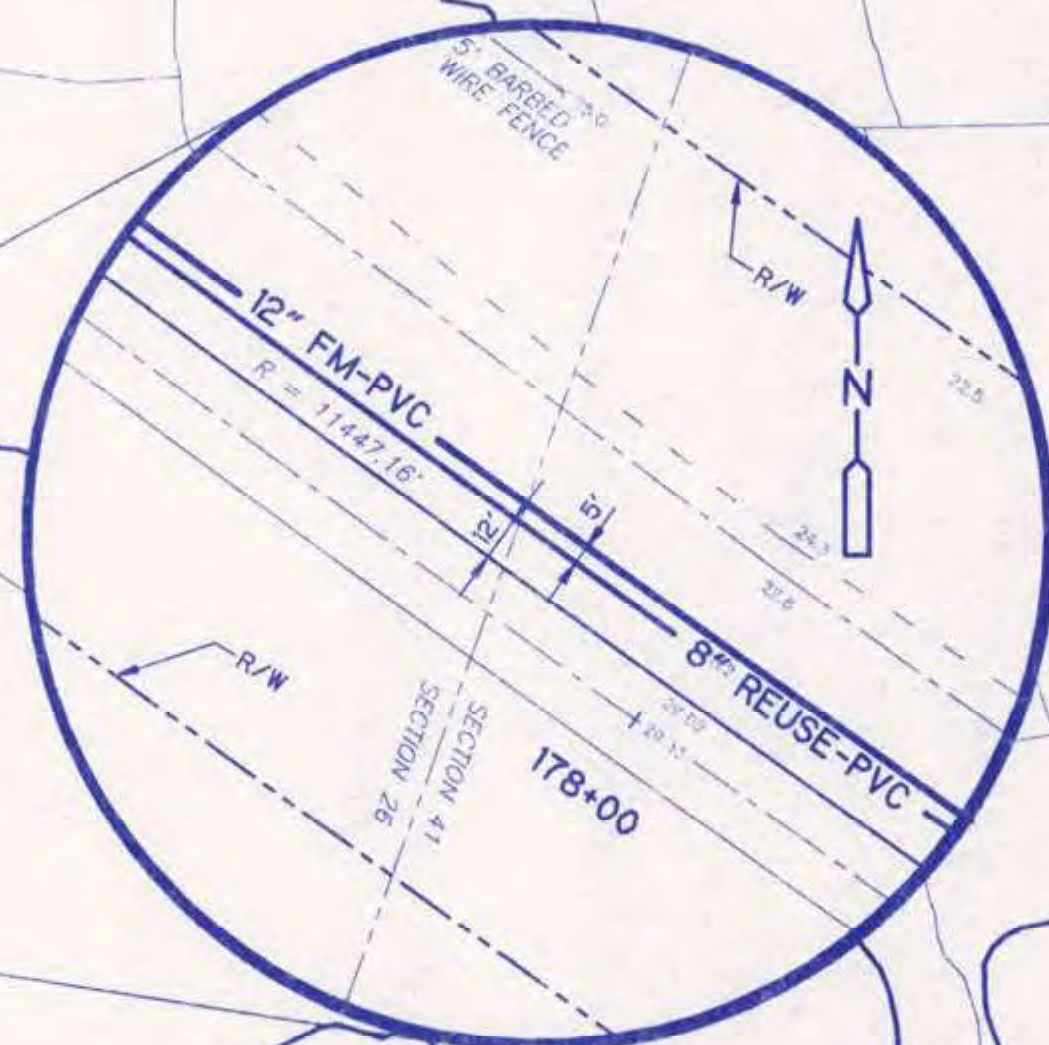

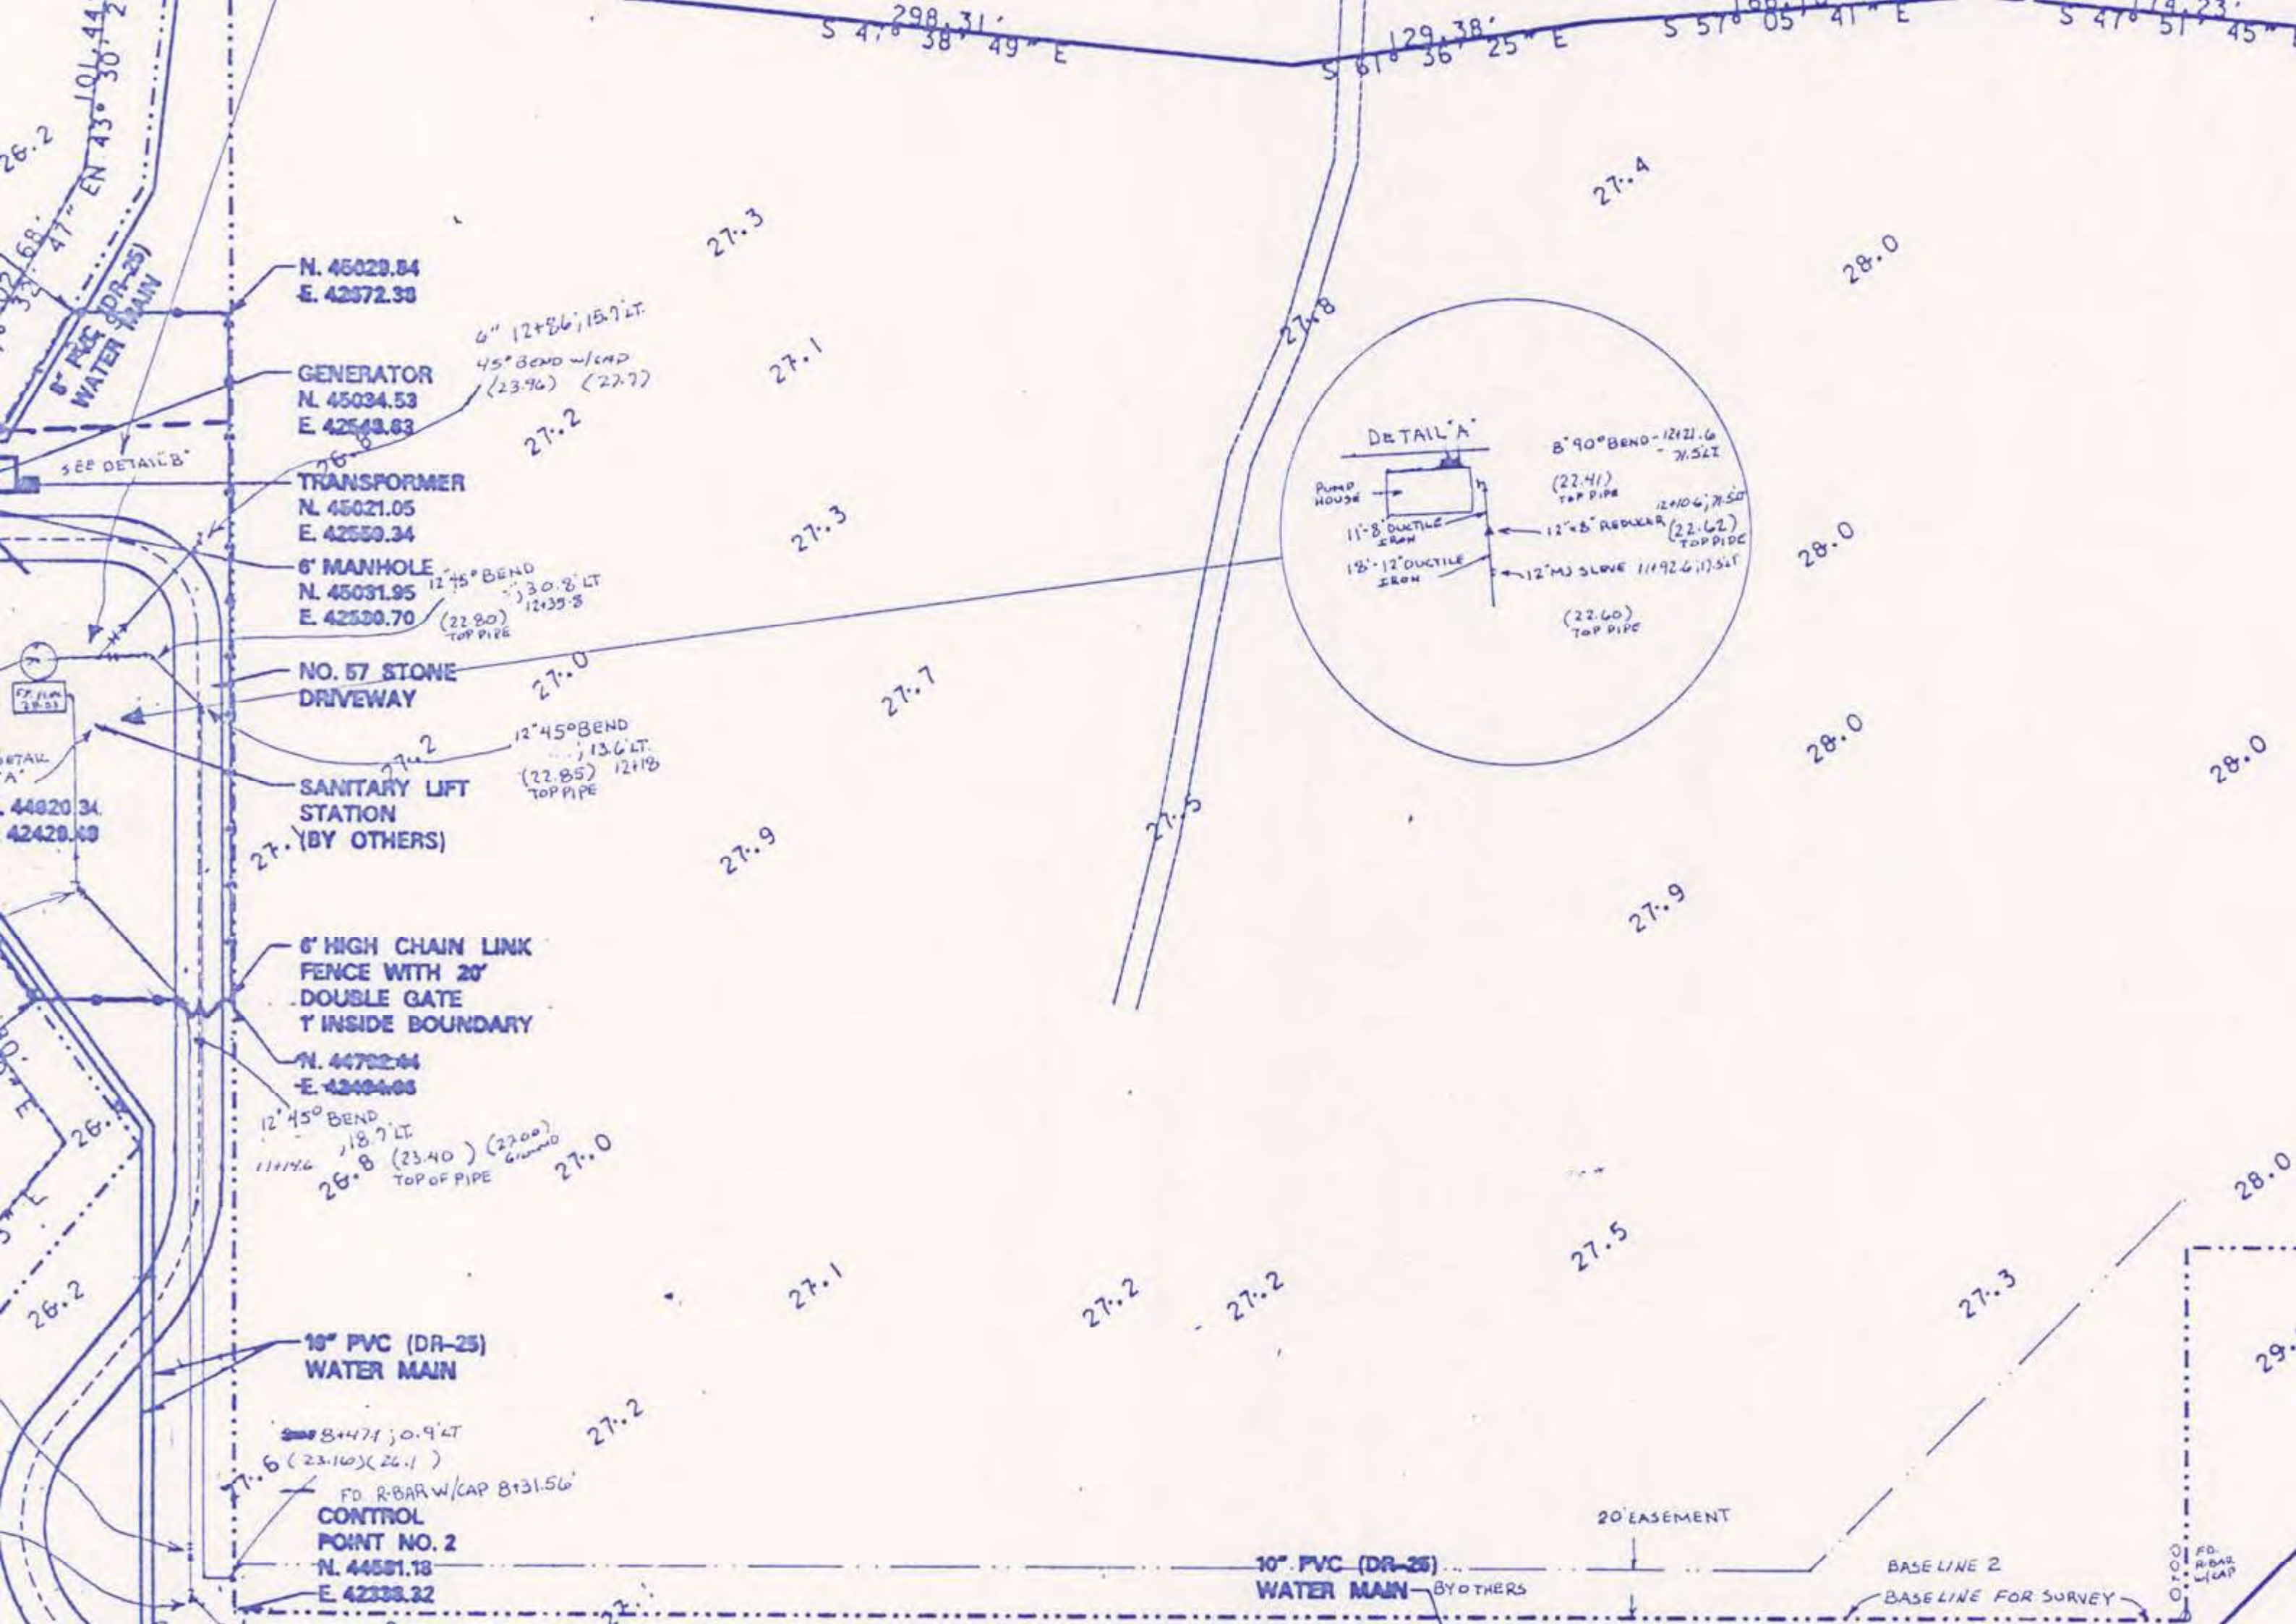


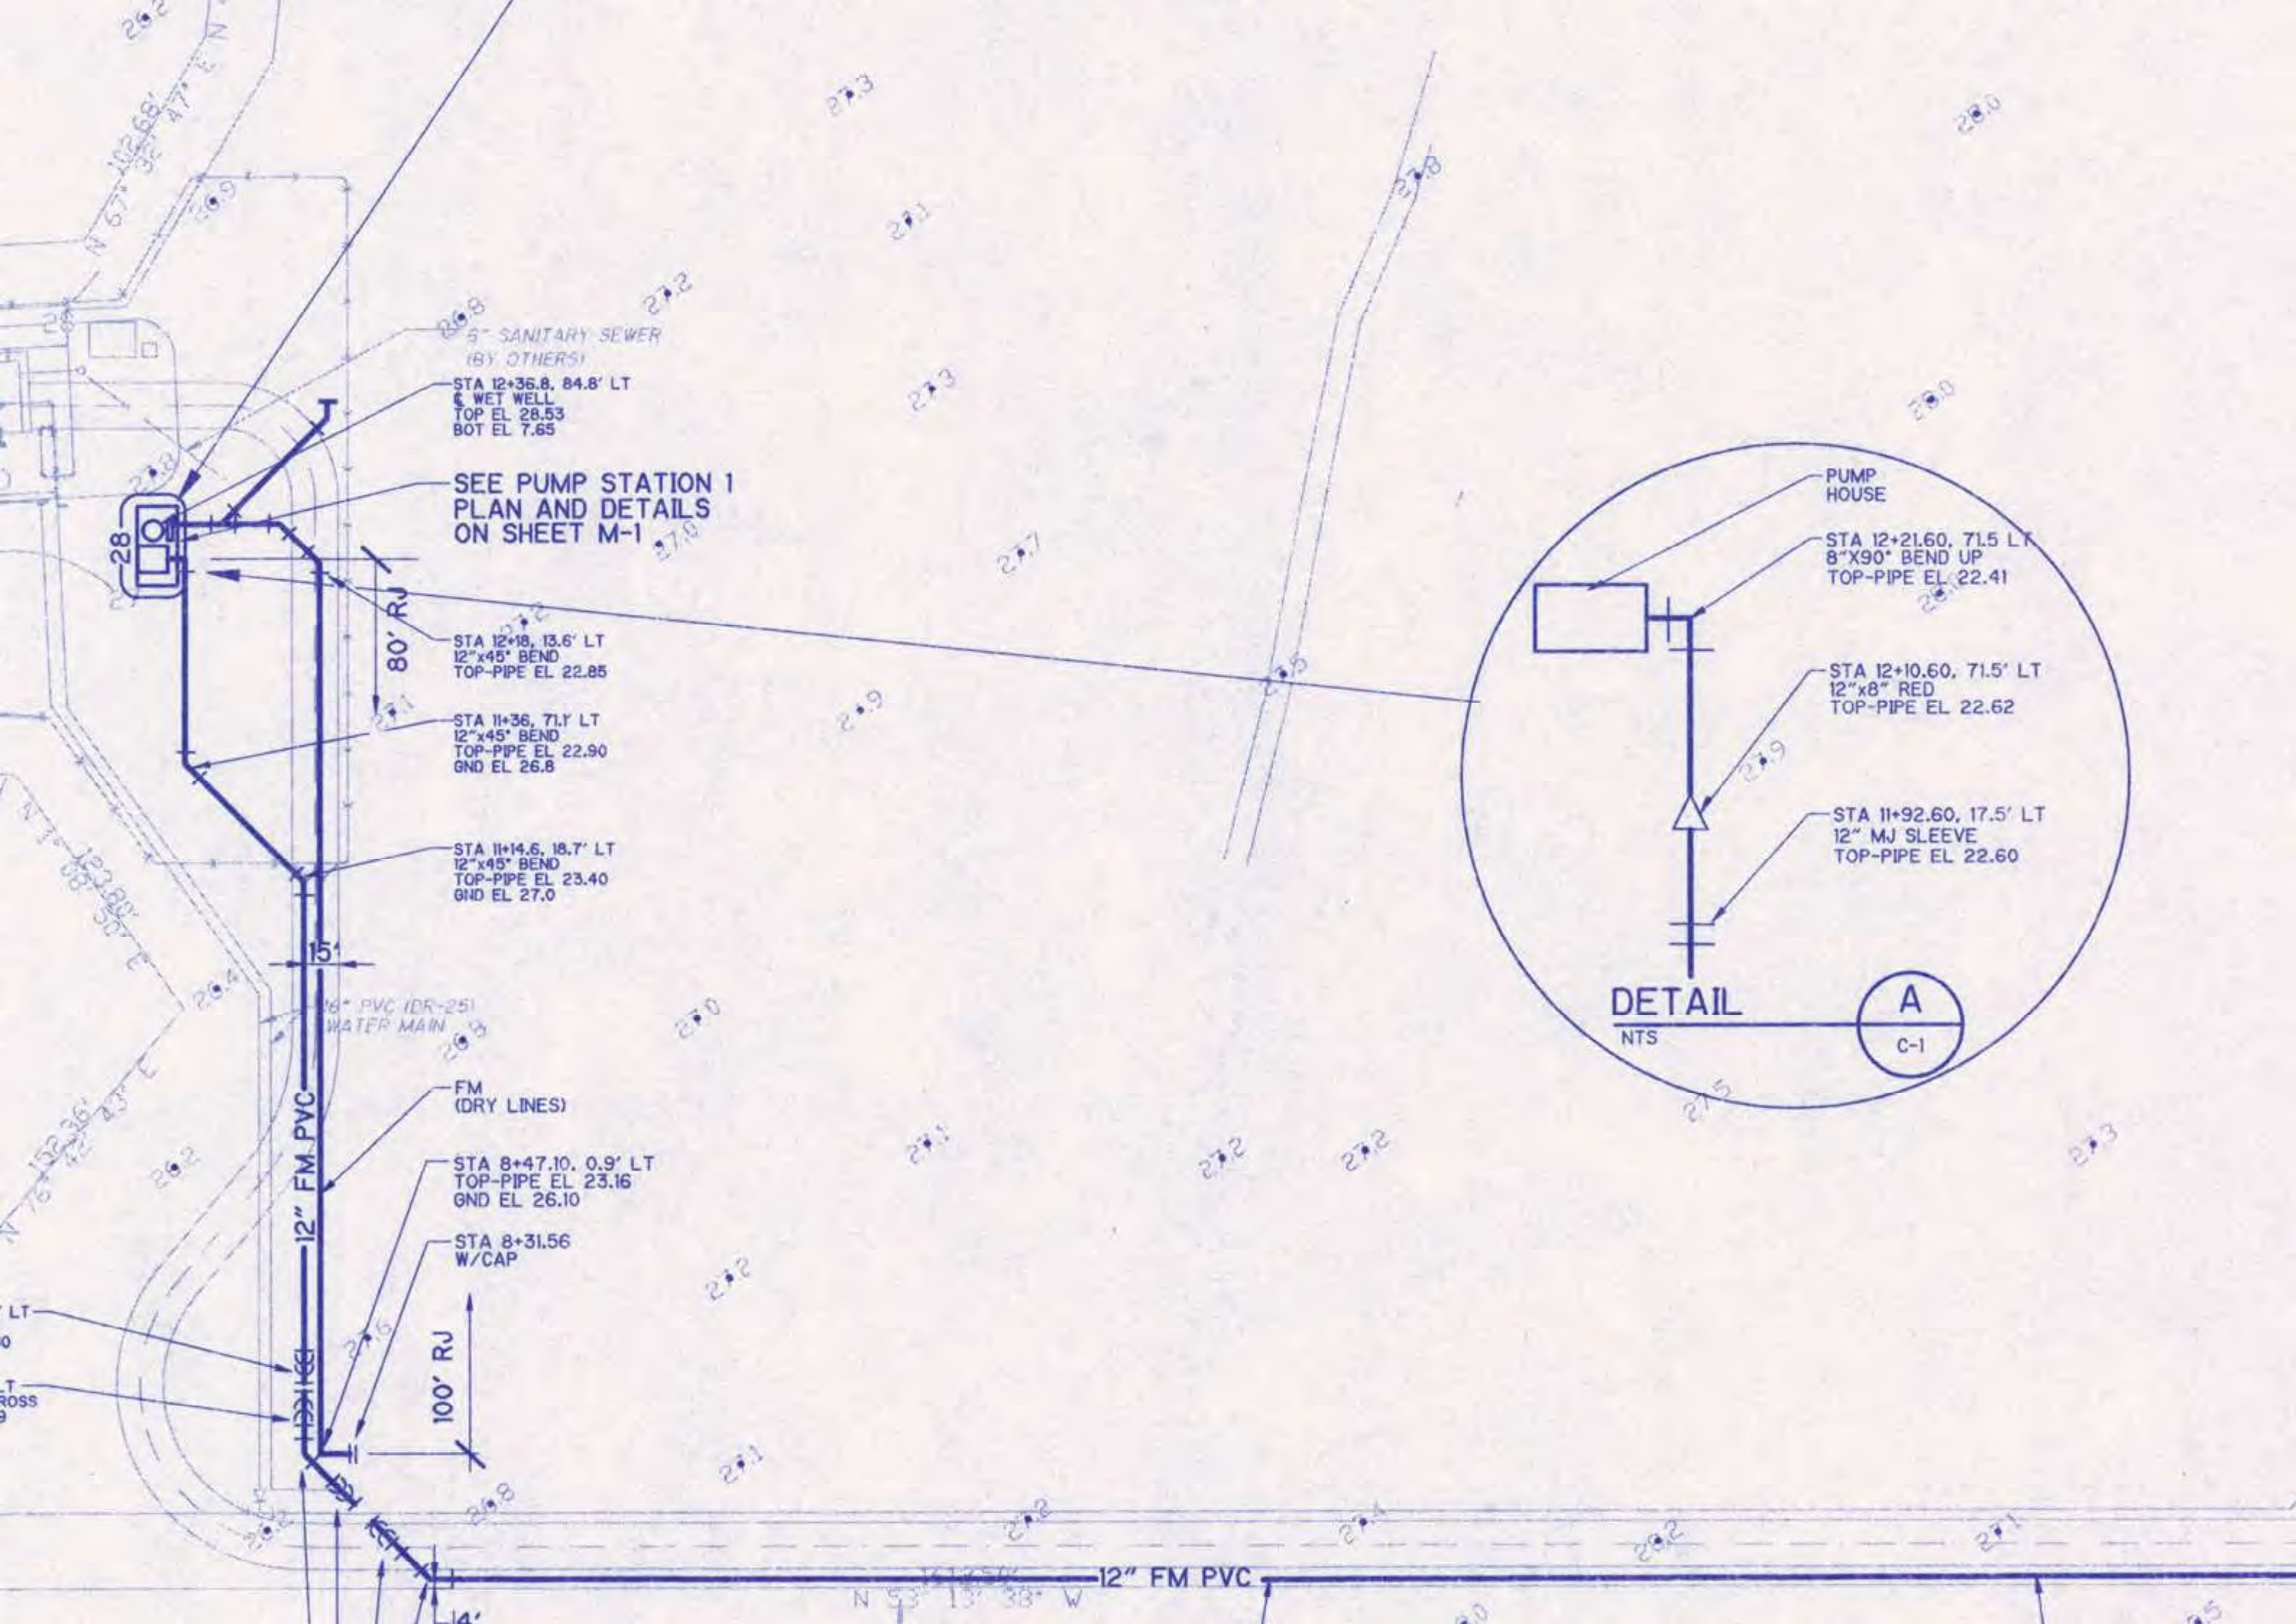



26.9


01+69.46' LT
BEND
PE EL 23.80
L 27.2


WAVE EL 25.8

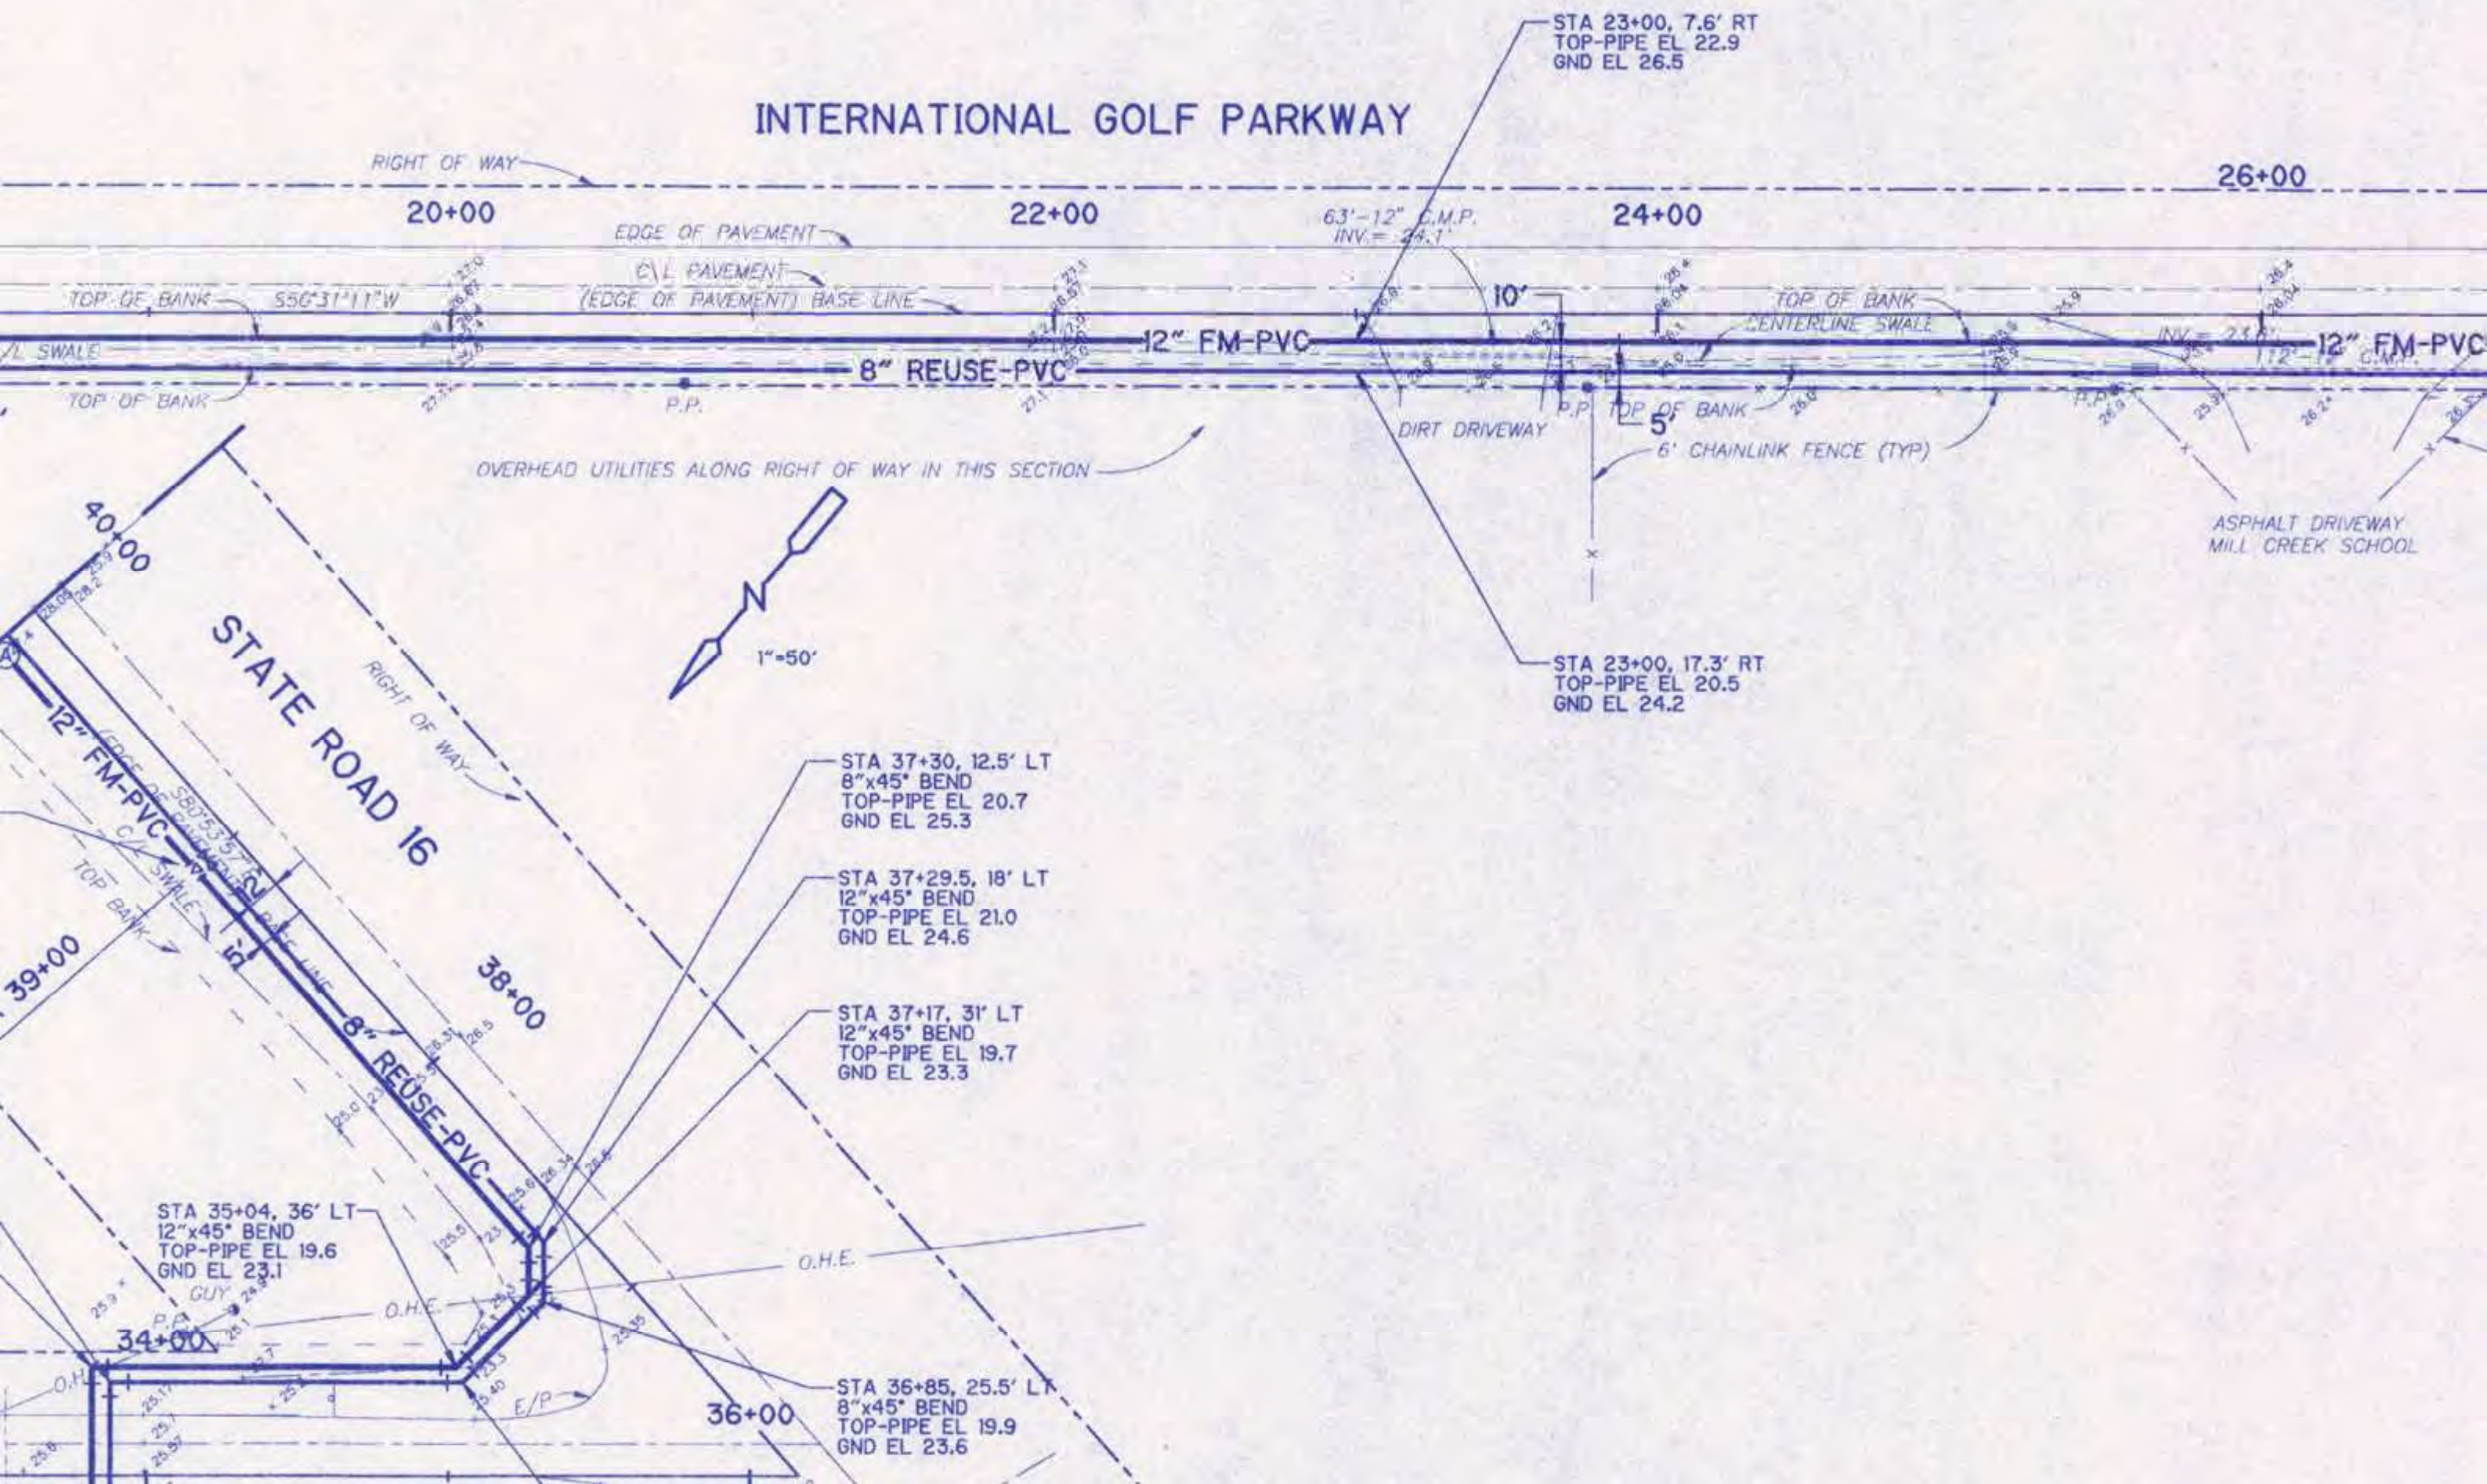


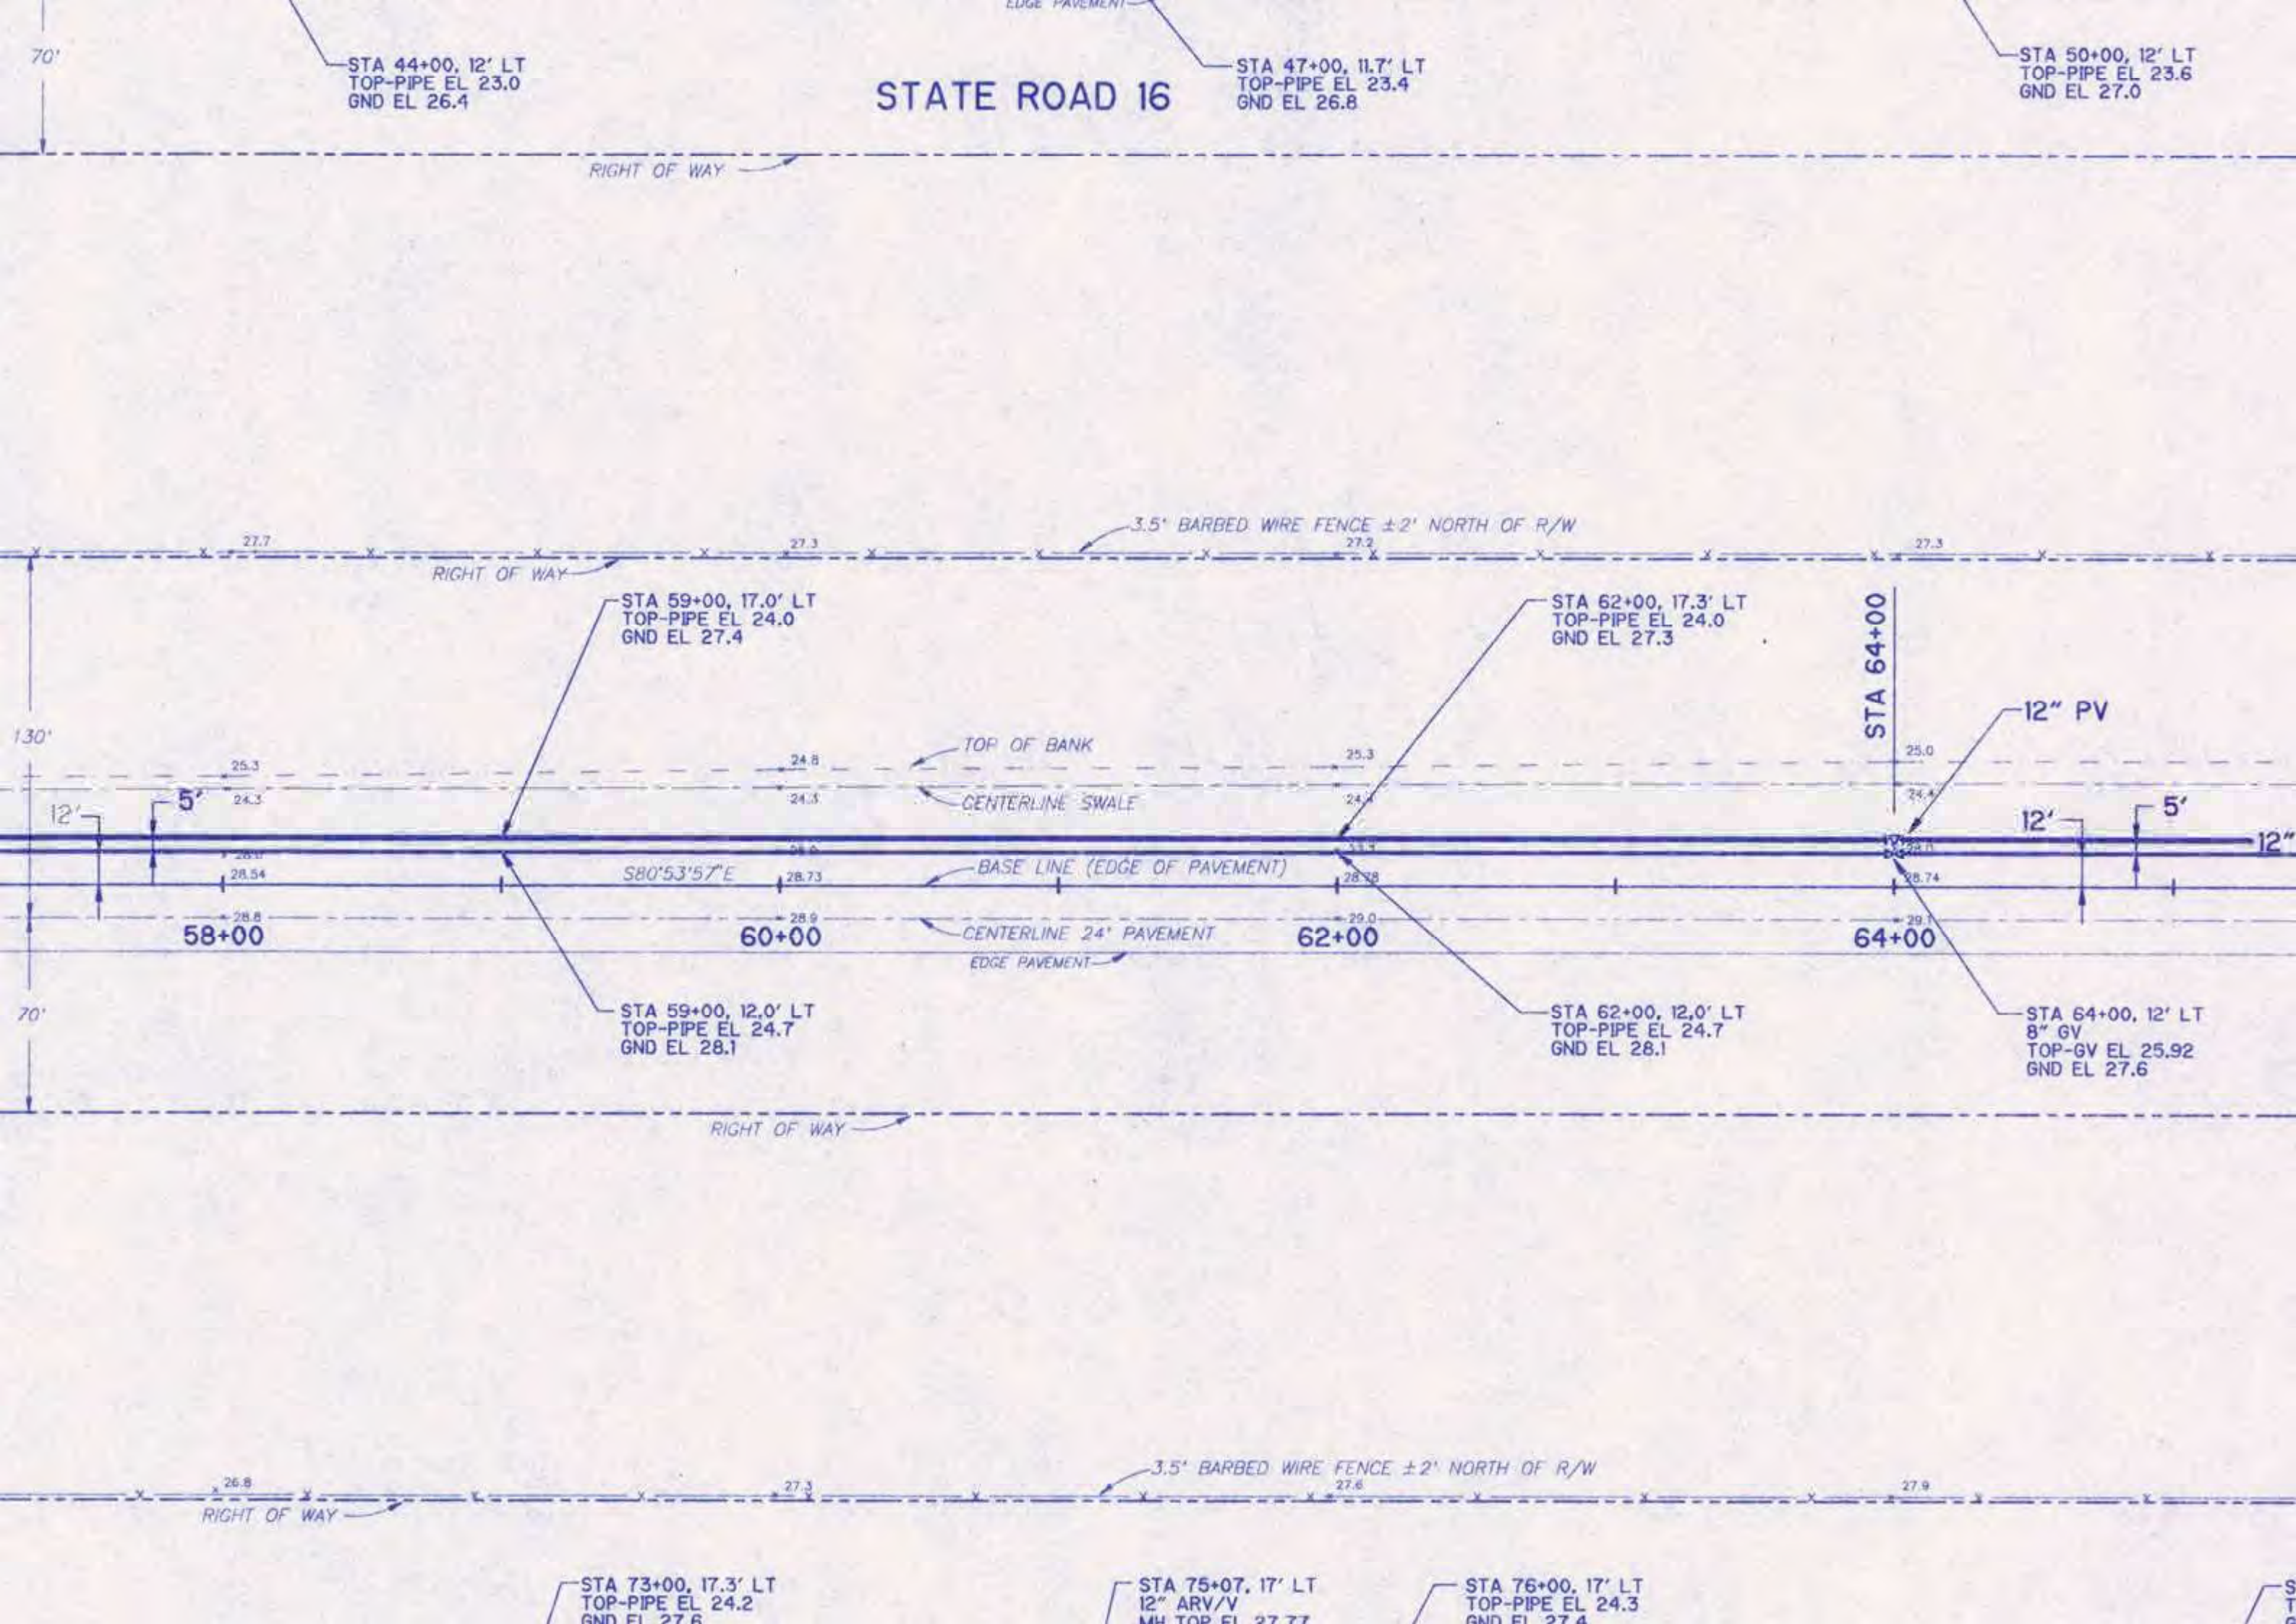


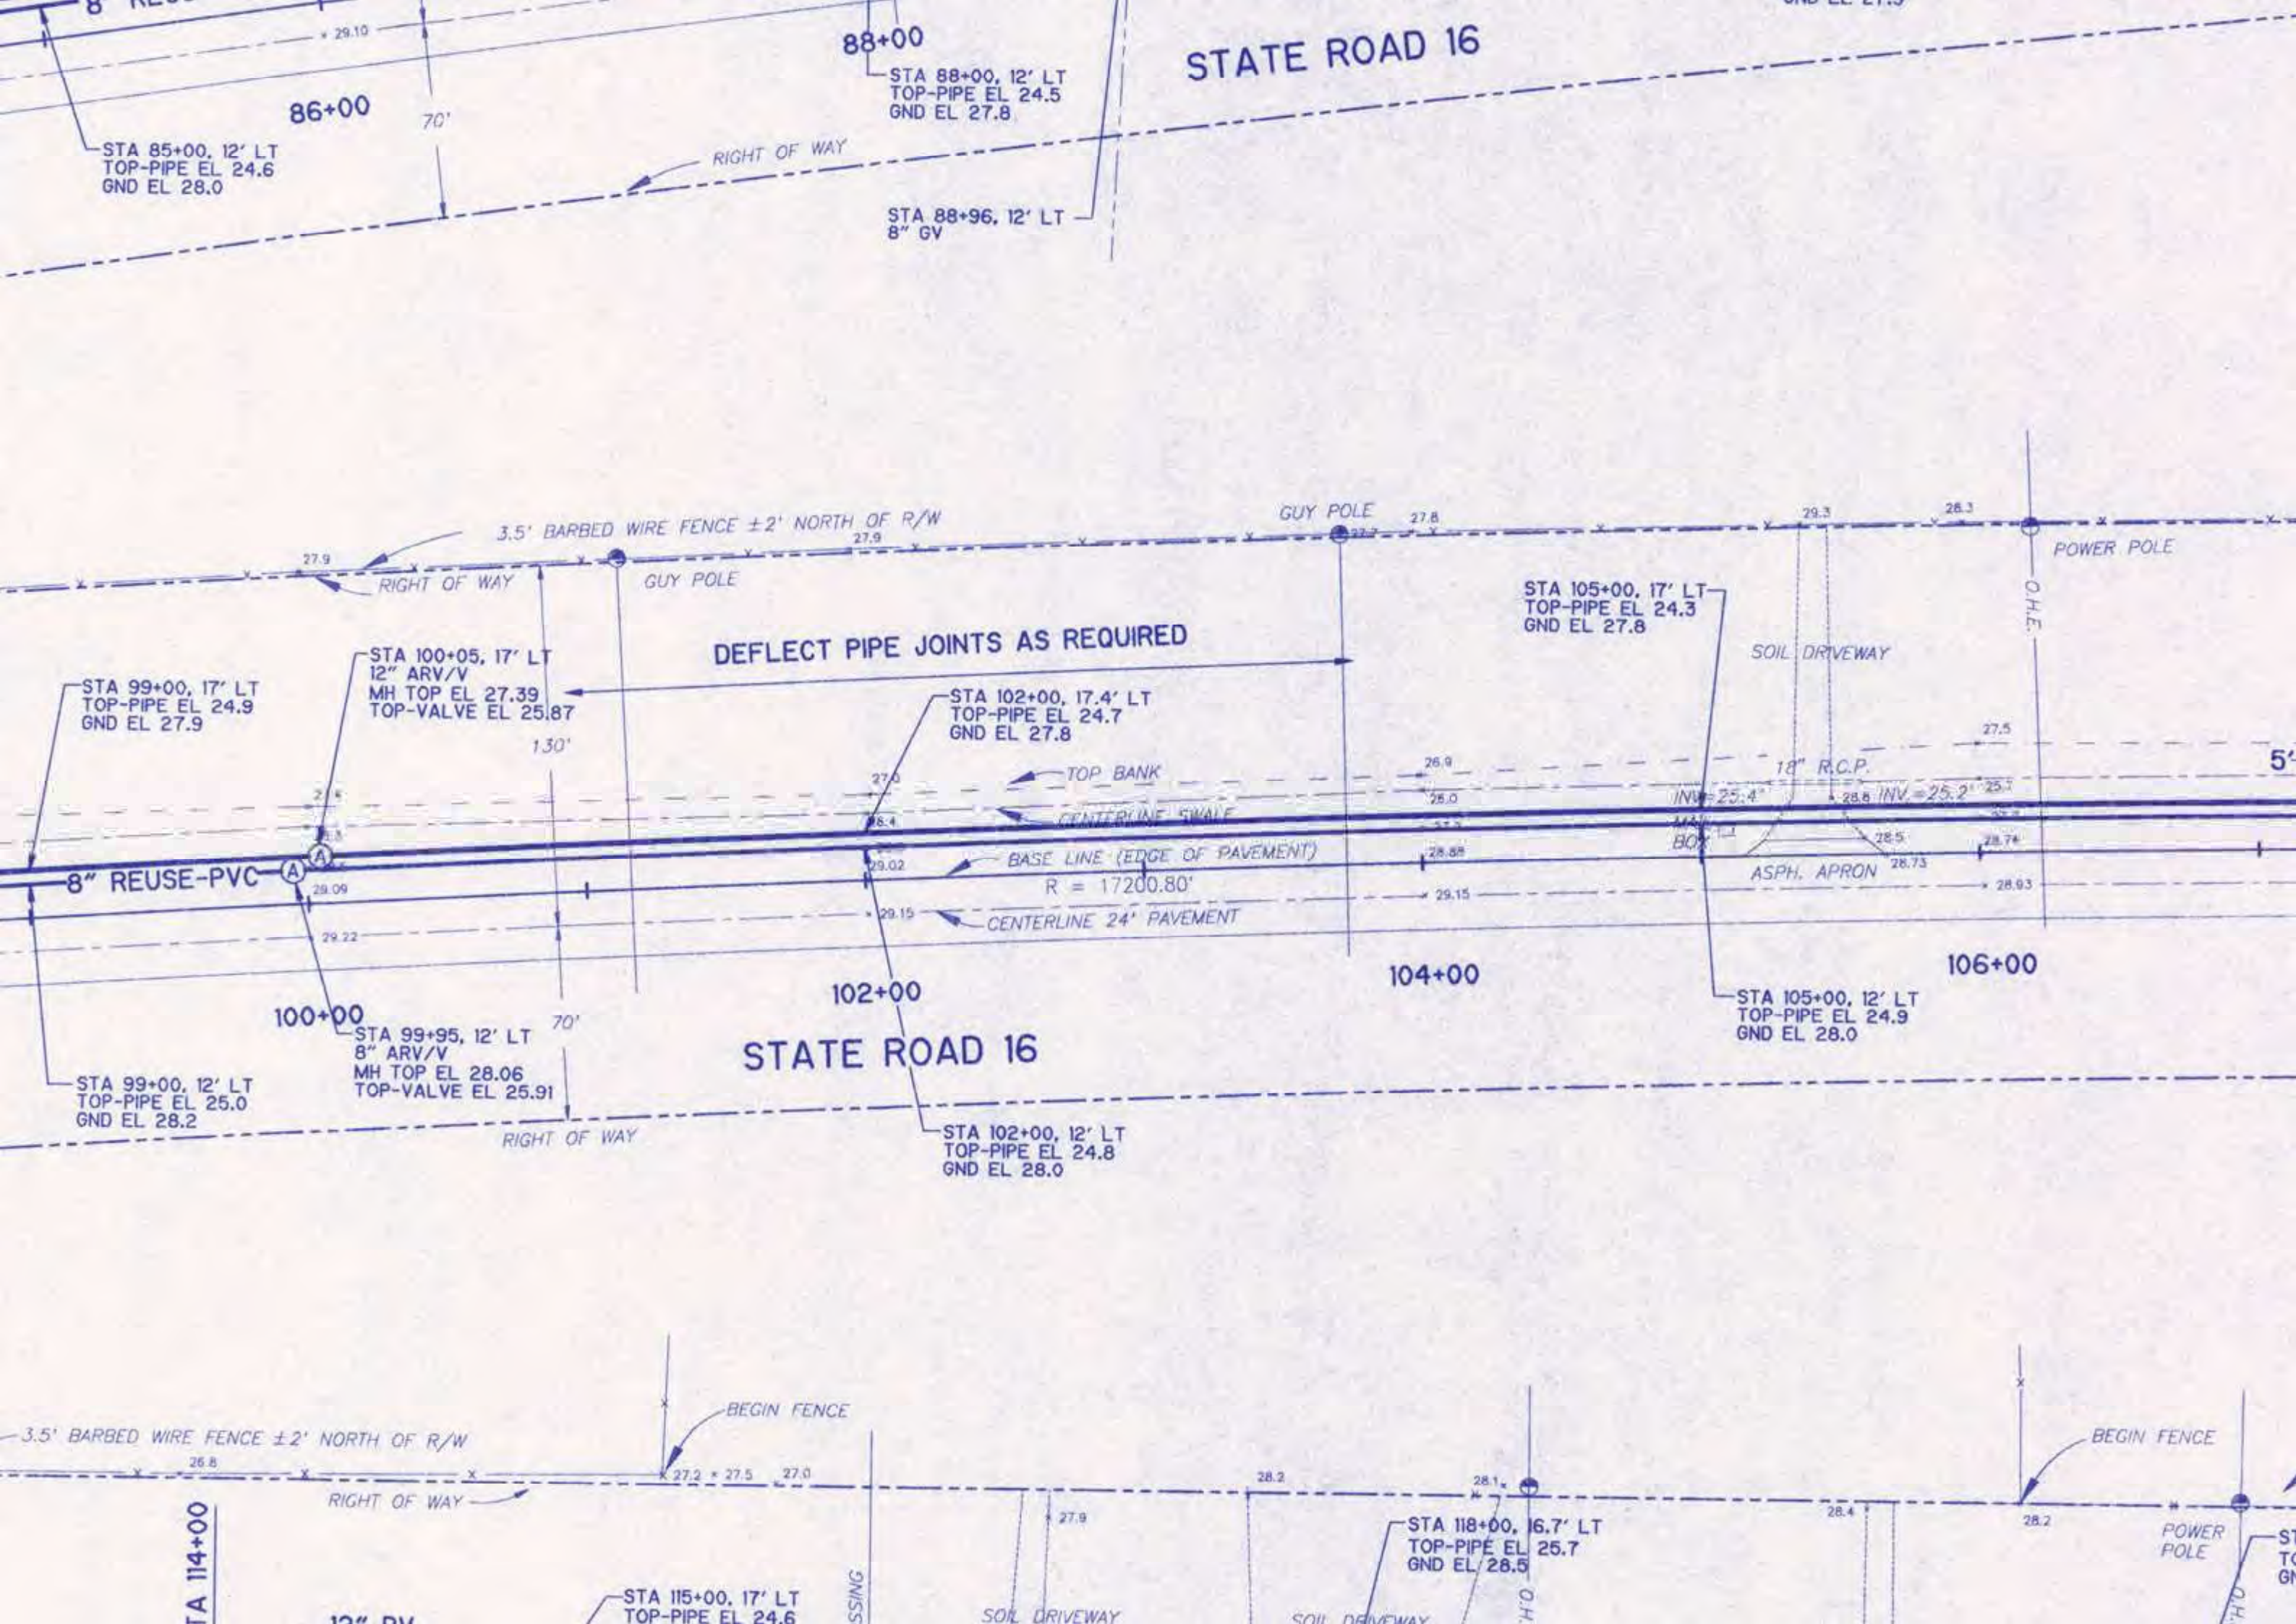

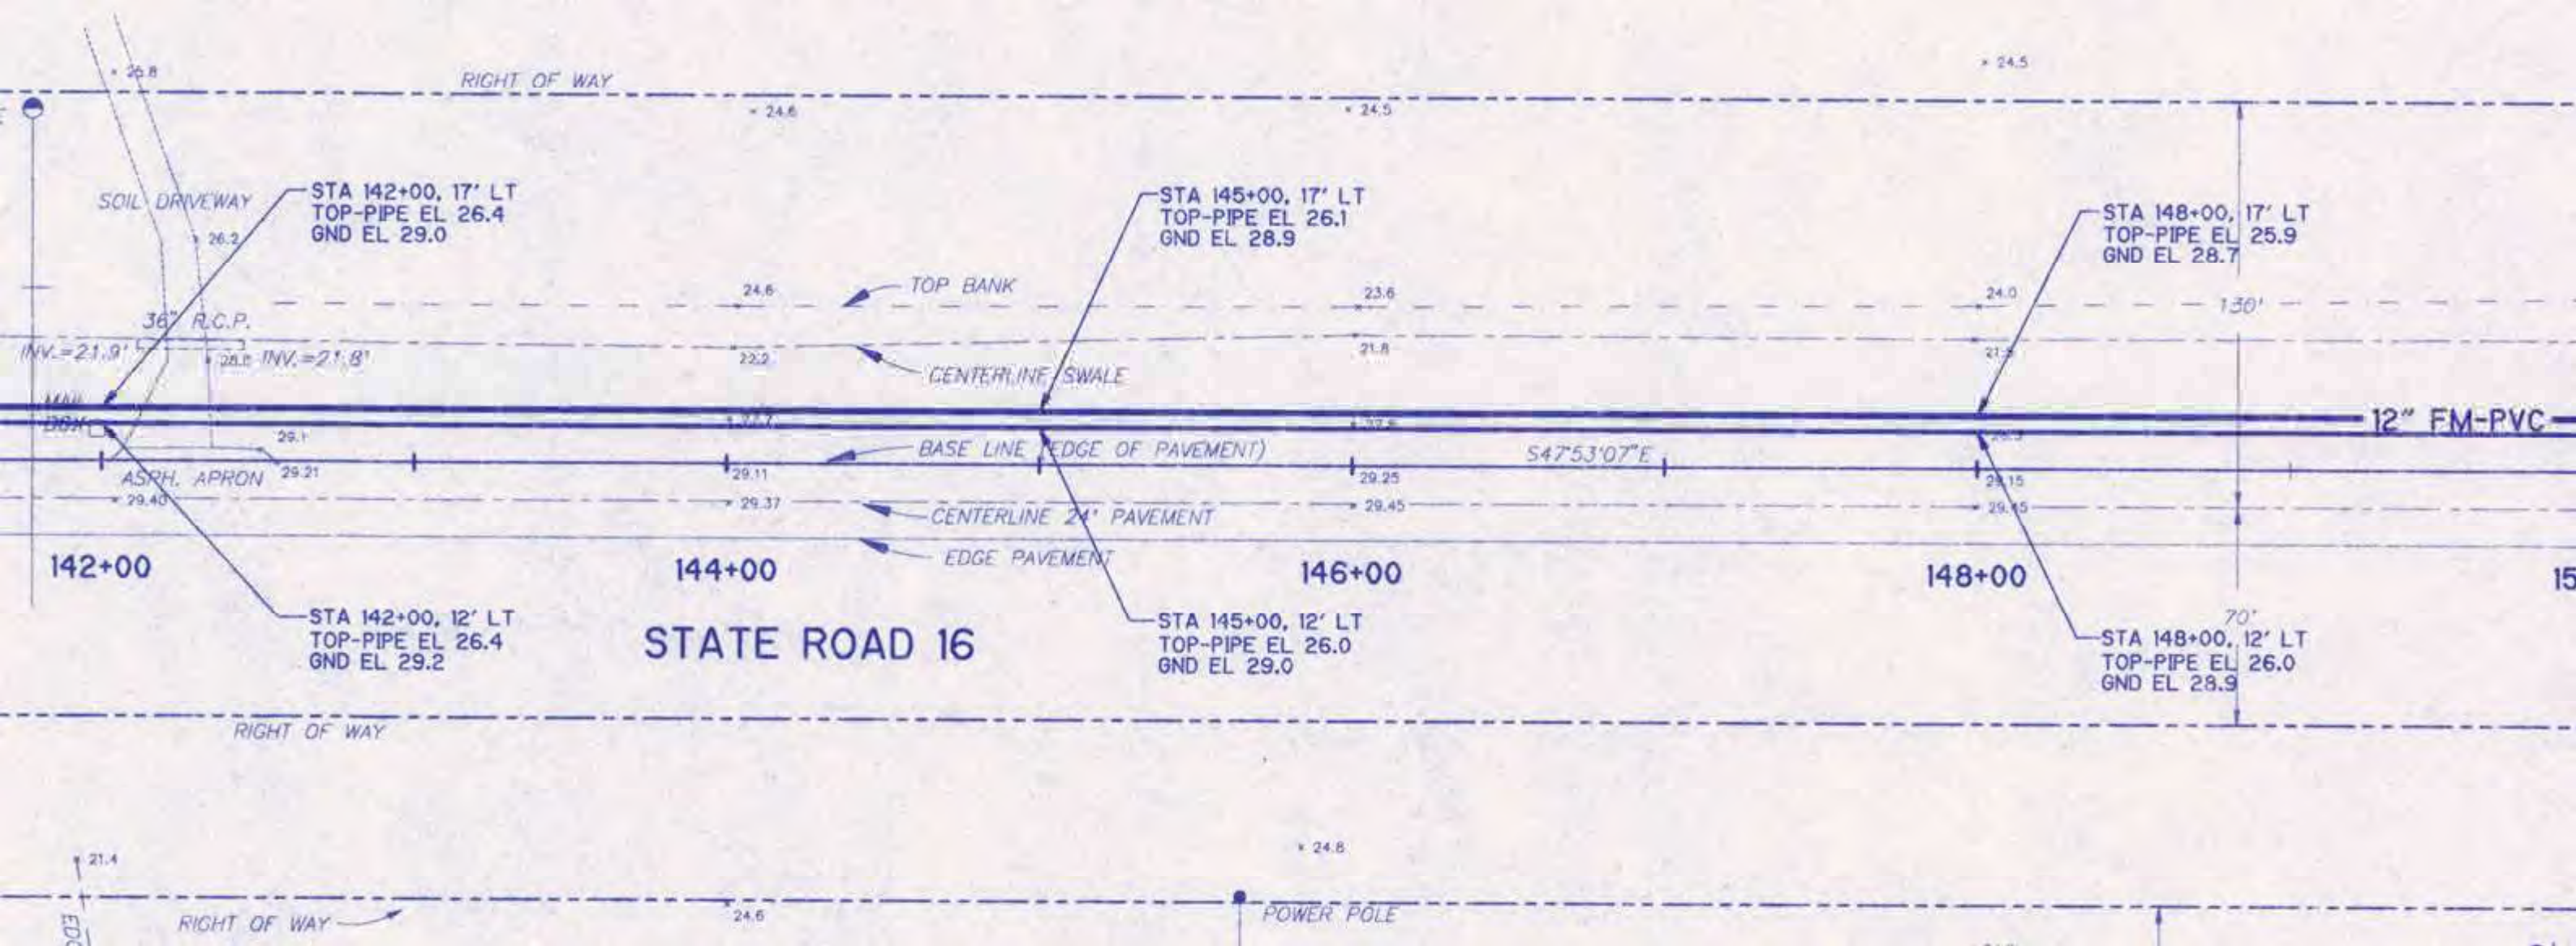

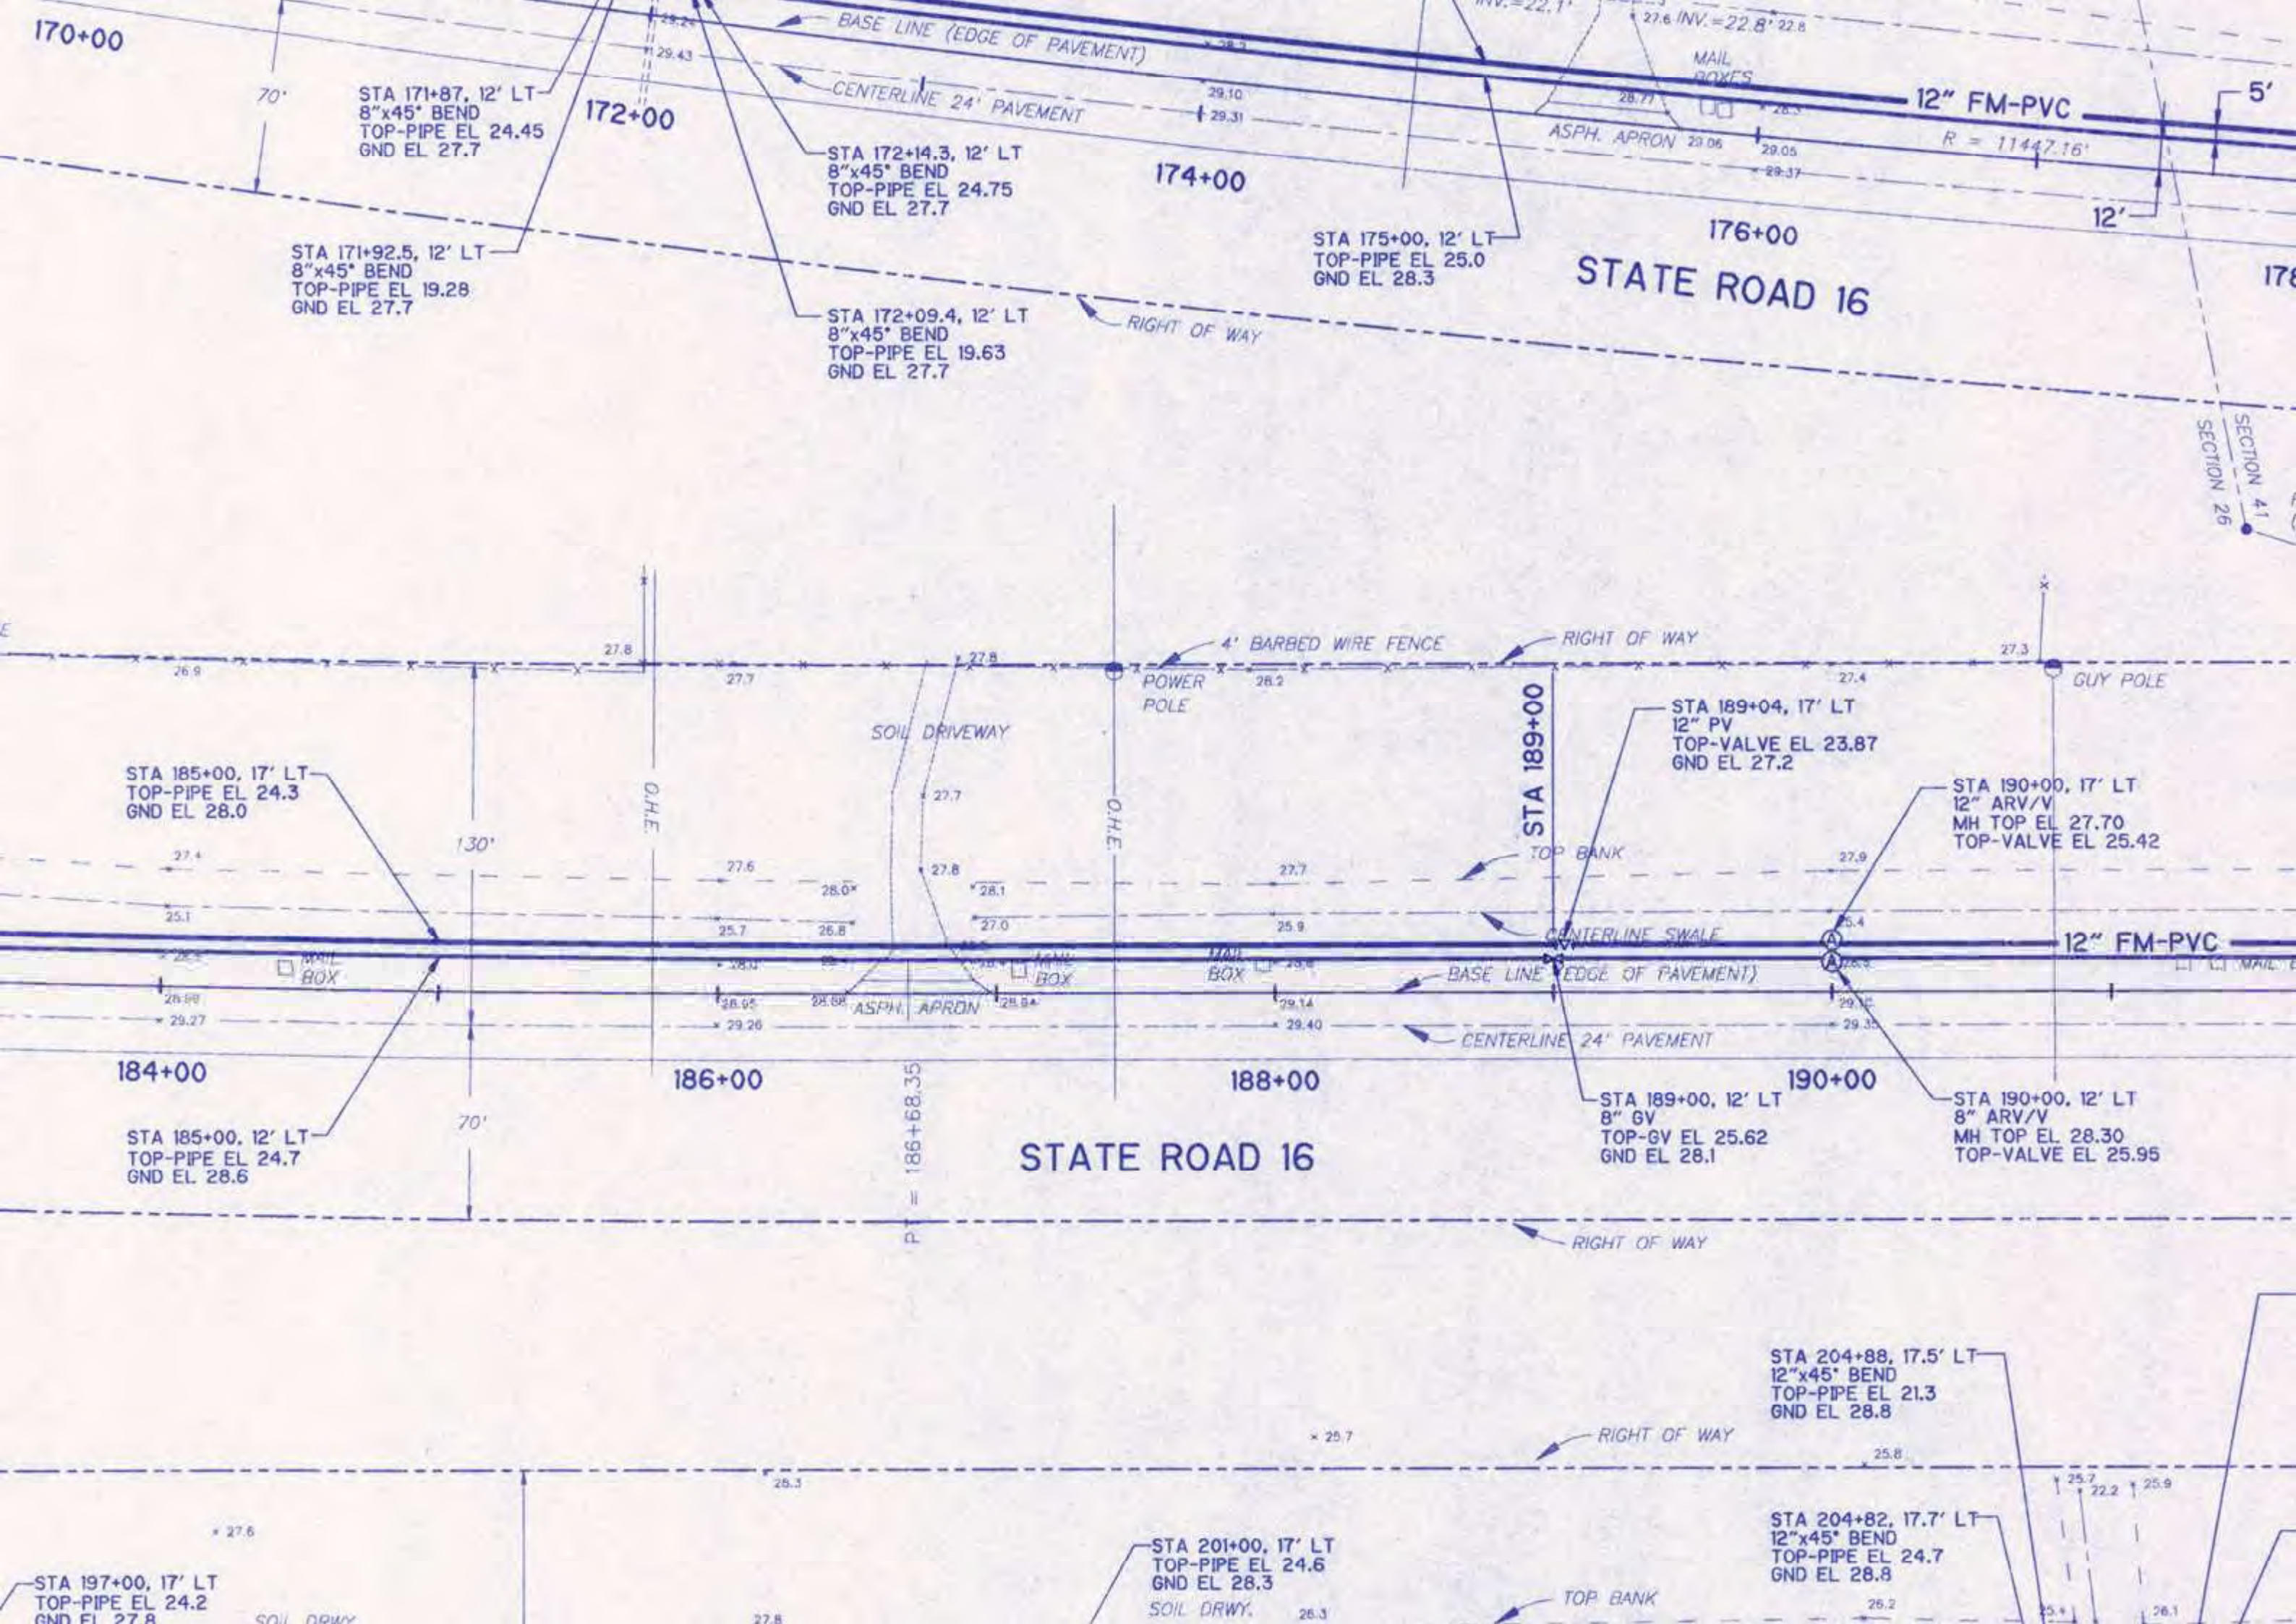

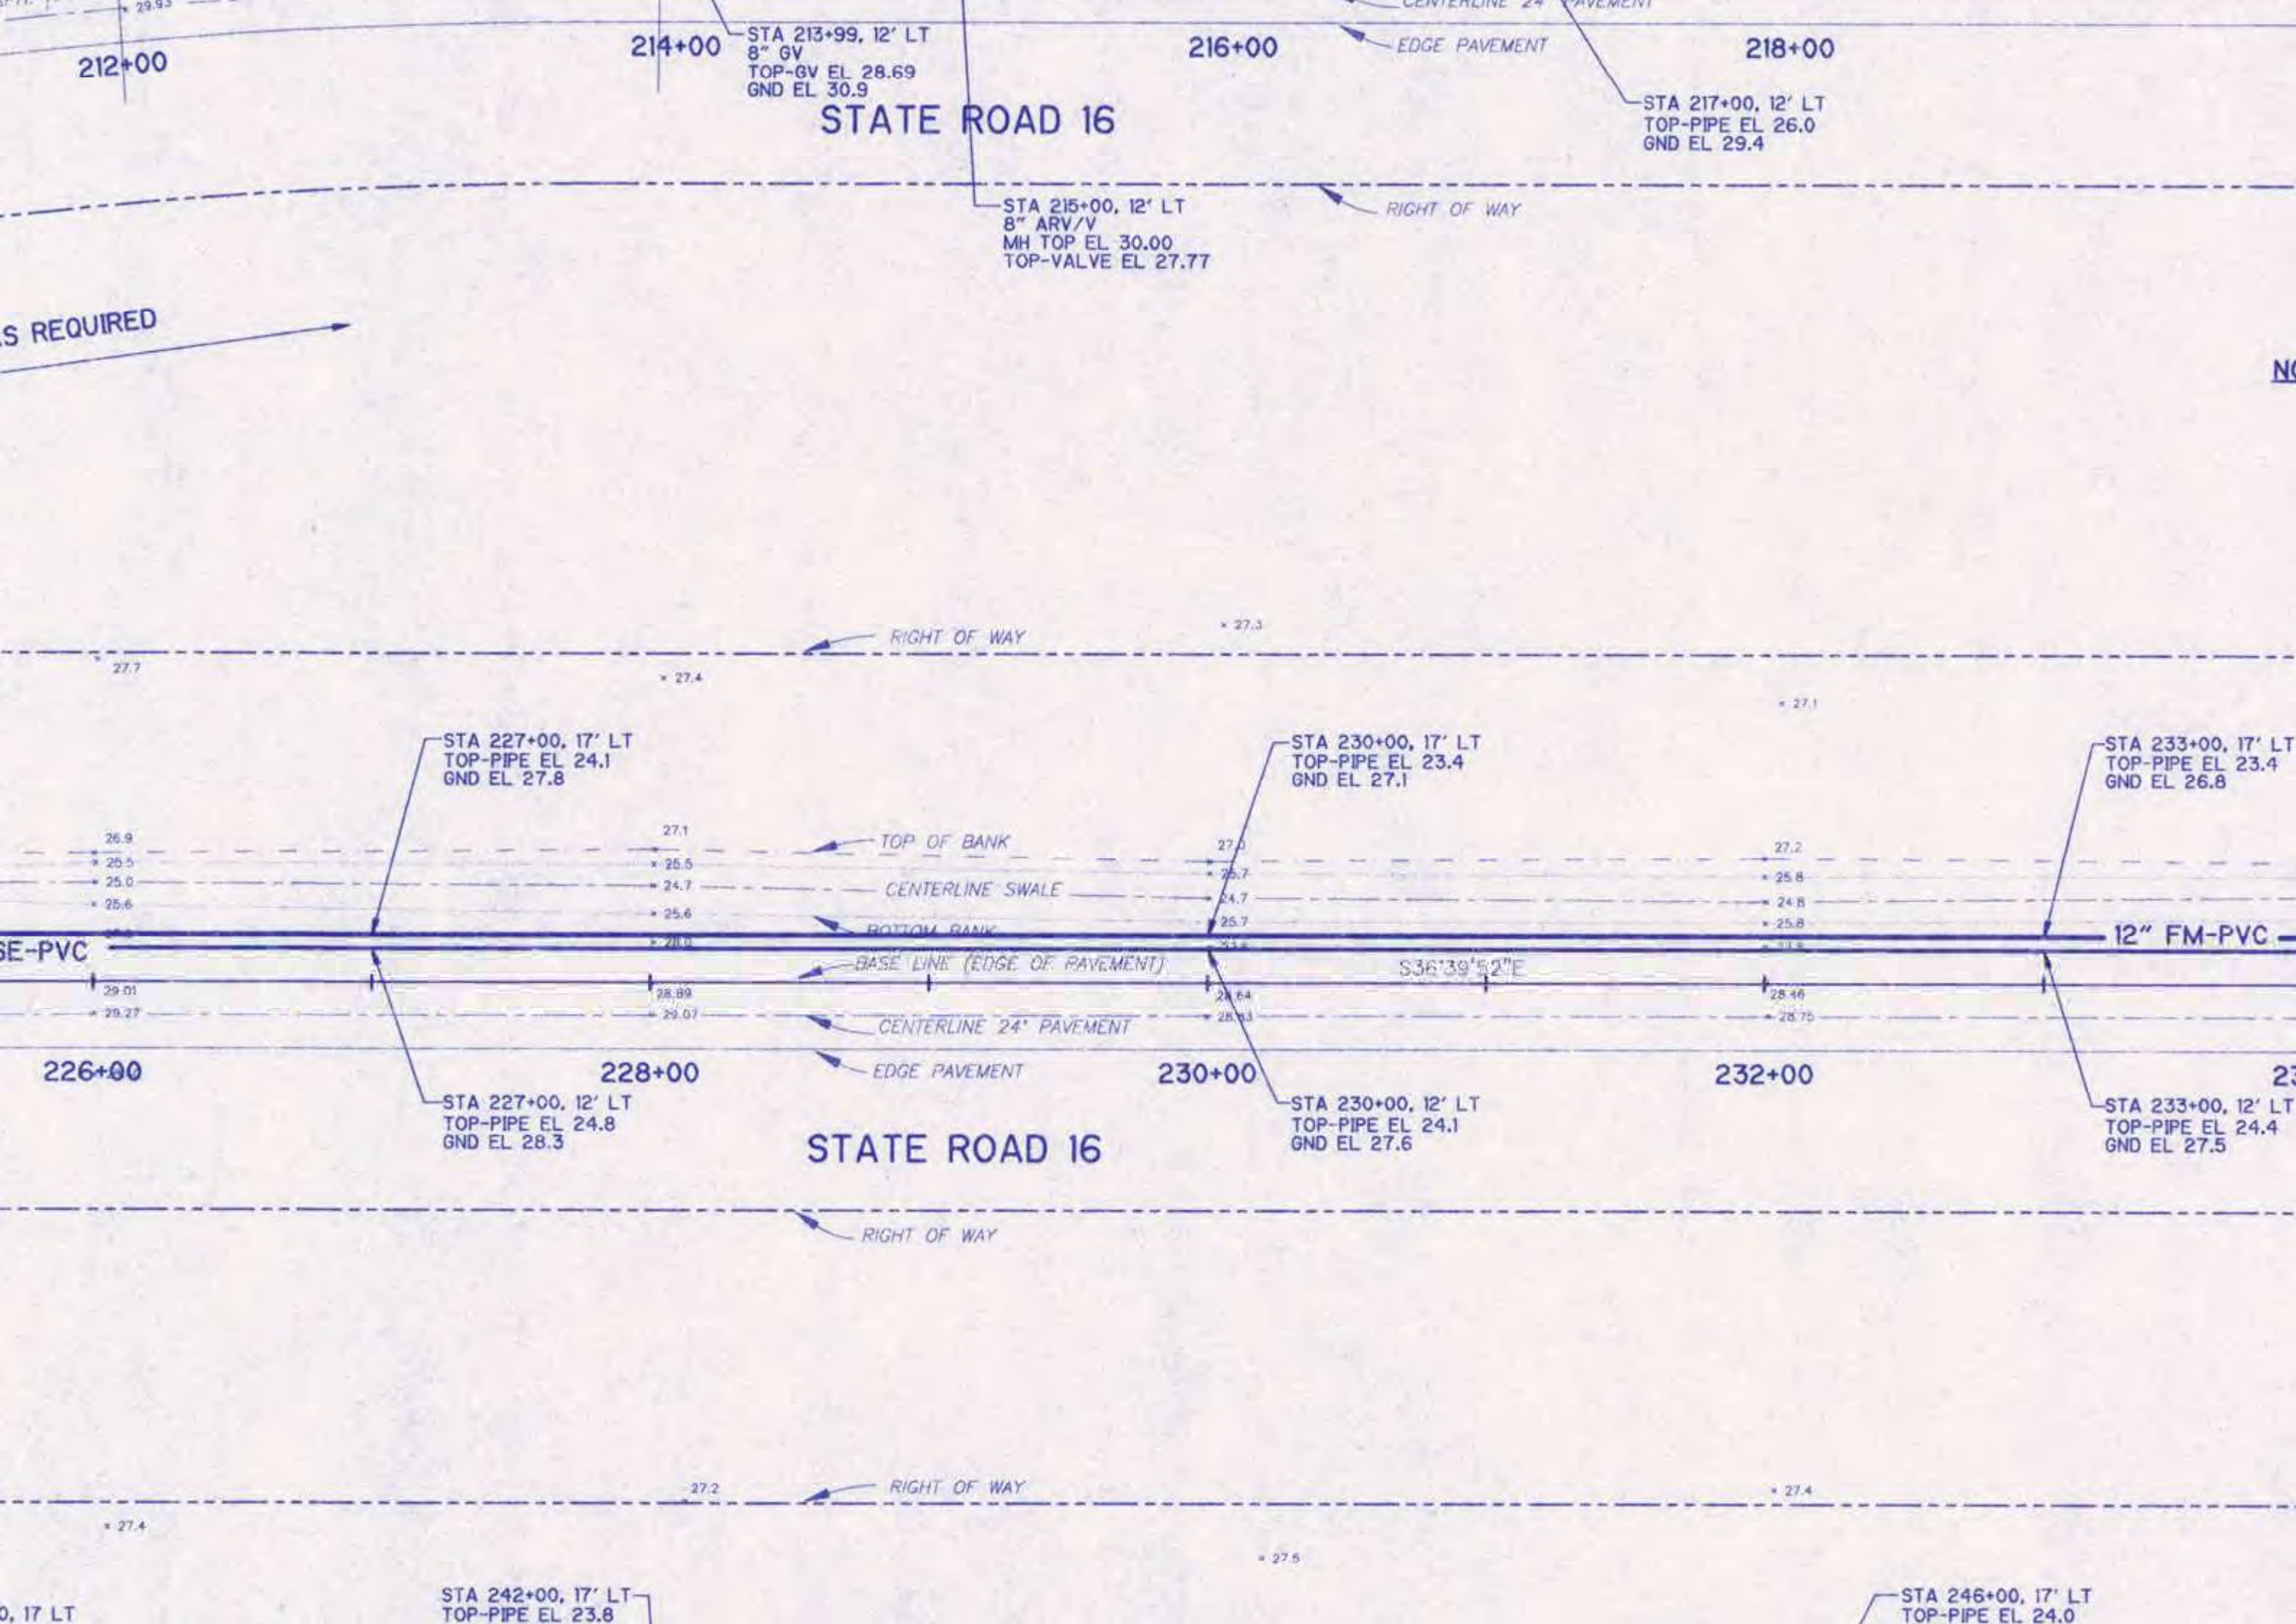

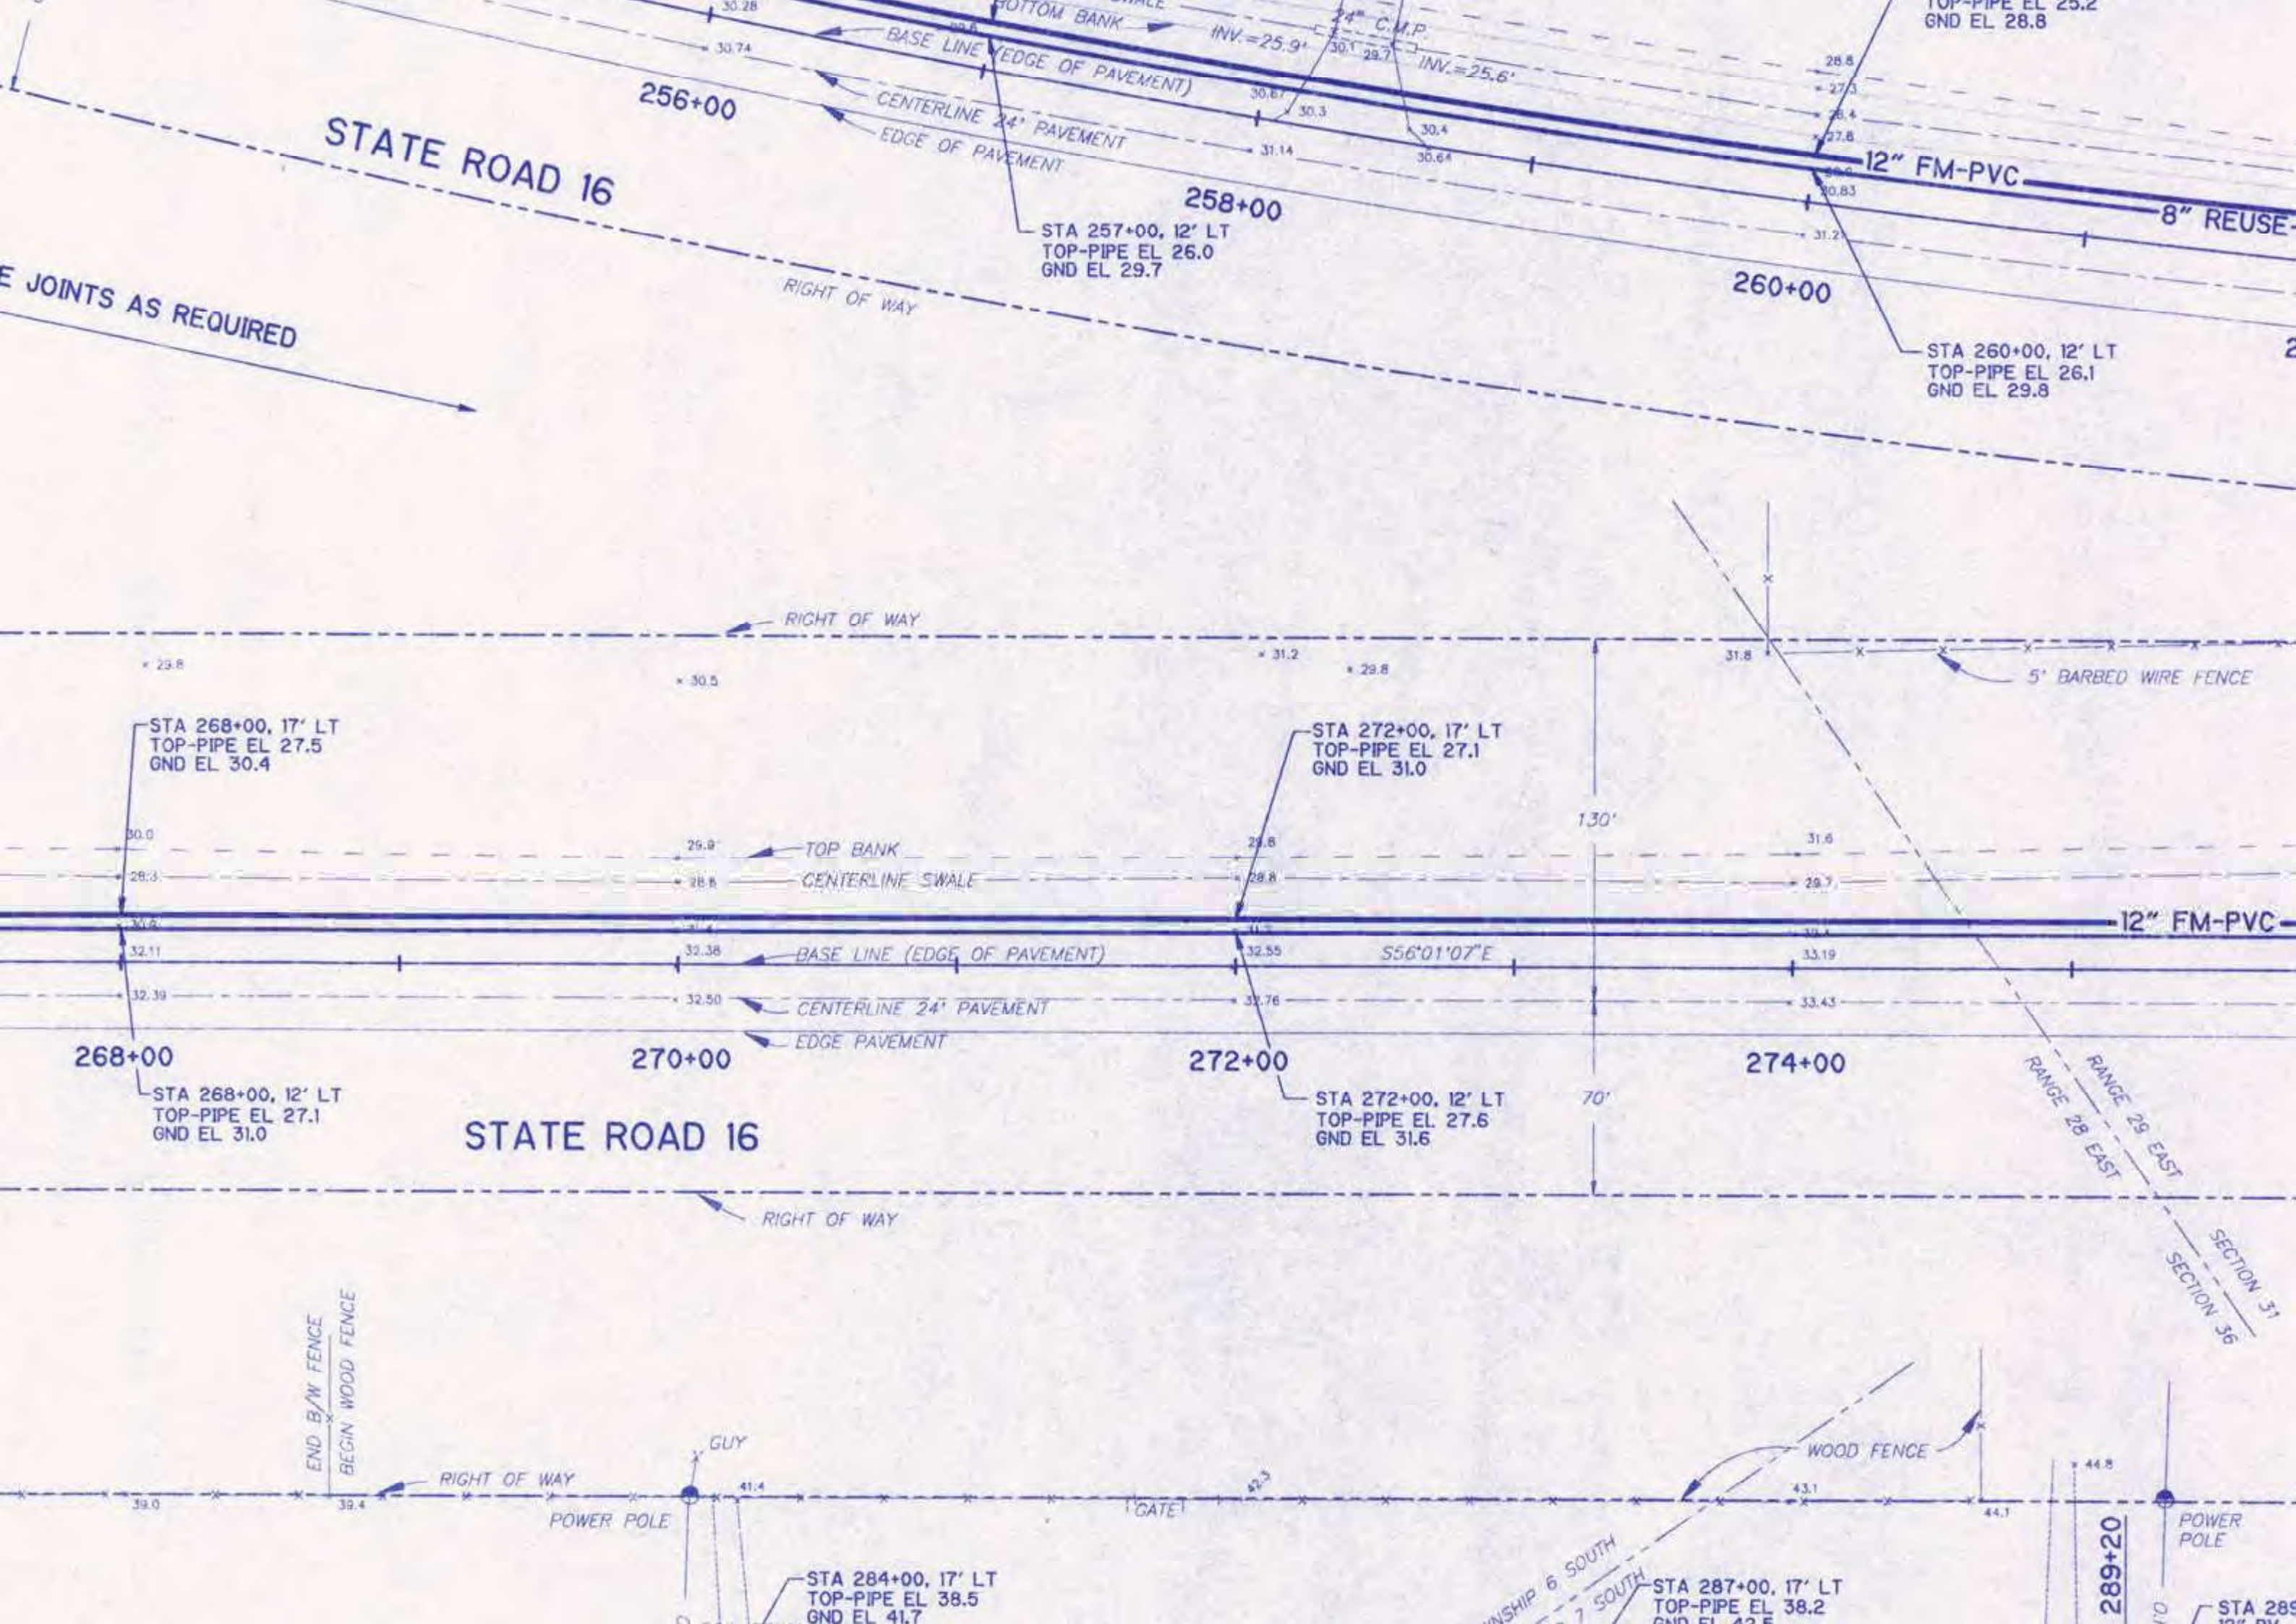




2. BASE MATERIAL SHALL BE PLACED IN TWO OR THREE LAYERS AND EACH LAYER THOROUGHLY ROLLED OR TAMPED TO MINIMUM DENSITY OF 98% BY A.A.S.H.T.O. T-180 SPEC. LBR100
3. ASPHALT CONCRETE PAVEMENT JOINTS SHALL BE MECHANICALLY SAWED.
4. SURFACE TREATED PAVEMENT JOINTS SHALL BE LAPPED AND FEATHERED.
5. NEW SURFACE MATERIAL WILL BE CONSISTENT WITH THE EXISTING SURFACE.
6. WHERE TRAFFIC SIGNALIZATION EXISTS IT SHALL BE THE RESPONSIBILITY OF THE CONTRACTOR TO REPLACE THE SYSTEM DISTURBED IN ACCORDANCE WITH THE GOVERNING AUTHORITY'S REQUIREMENTS.
7. ALL ROADWAY REPLACEMENT SHALL BE IN COMPLIANCE WITH GOVERNING AUTHORITY WHERE CUT IS MADE.
8. FOR PVC PIPE ONLY - INSTALL METALLIC TAPE OVER FULL LENGTH OF PIPE. SEE SPECIFICATIONS.

OPEN CUT PAVEMENT REPAIR

NTS

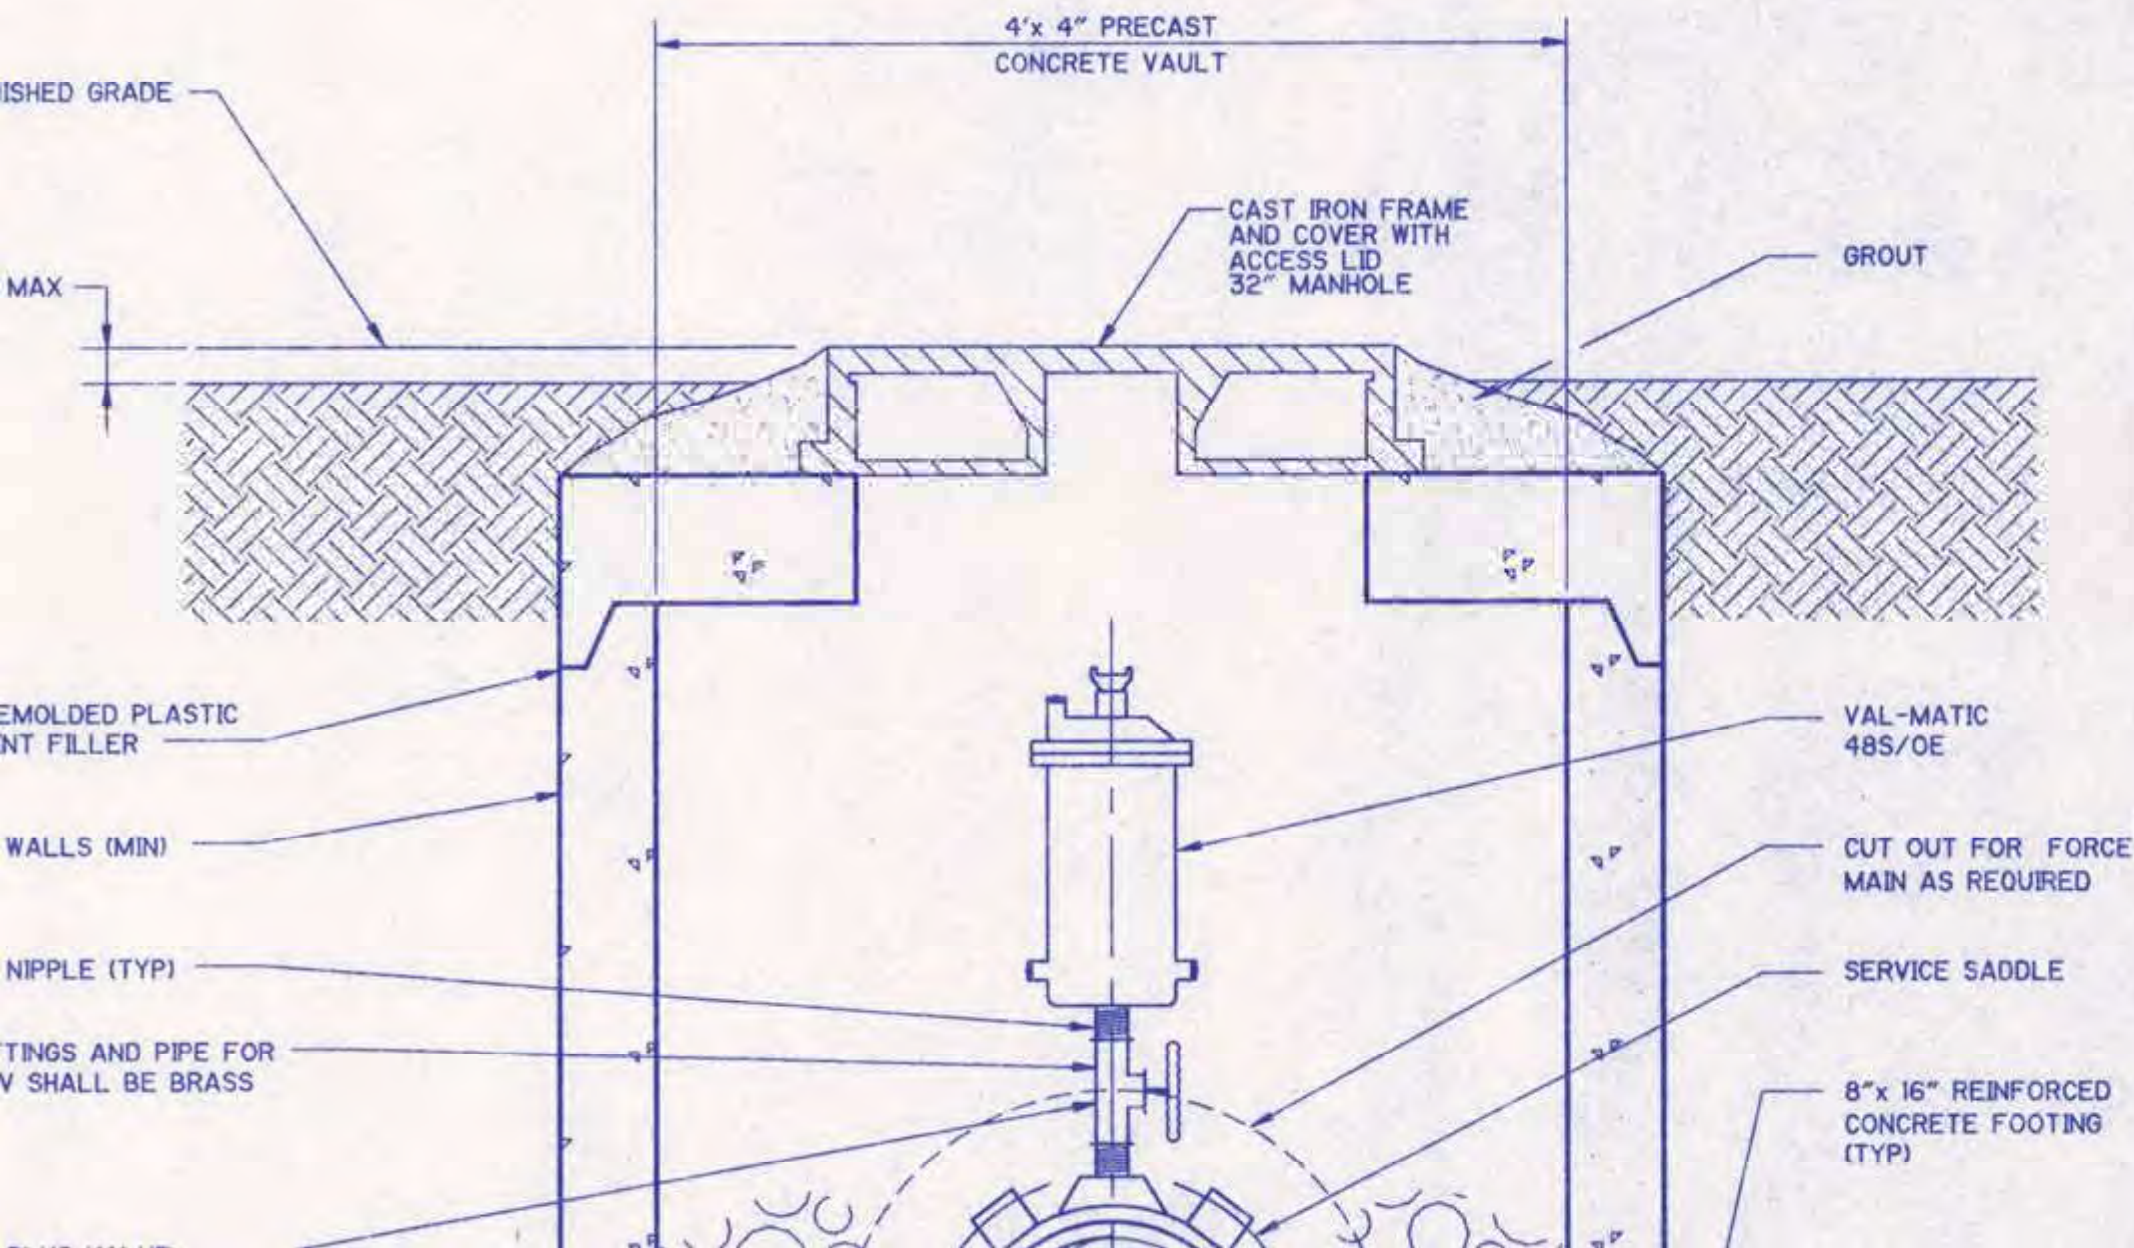


ORIGINAL
EXCAVATION

10" NEW COMPACTED
LIMEROCK 95% PER
AASHTO T-180

LIMEROCK PATCH IN SHOULDER & SWALE

NTS

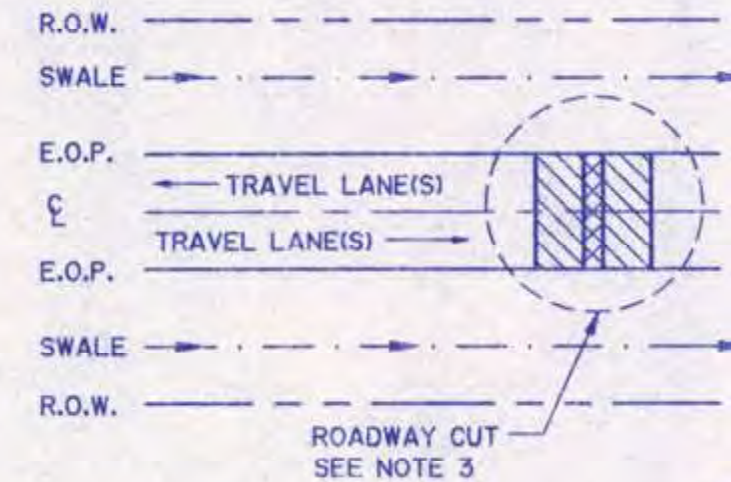

FEATHERING OF OVERLAY
EDGES TO MEET EXISTING SURFACE
COURSE (DISTANCE AS NEEDED)

EXISTING ASPHALT SURFACE COURSE
EXISTING BASE COURSE
EXISTING STABILIZED SUBGRADE

STORM DRAIN 30 INCHES AND LESS

SLEEVED UTILITY INSTALLATIONS

FLOWABLE FILL MATERIAL SHALL BE PROPORTIONED TO PRODUCE A 28 DAY COMPRESSIVE STRENGTH OF 150 POUNDS PER SQUARE INCH (psi). FLOWABLE FILL SHALL BE PLACED FROM THE TOP OF THE PIPE BEDDING TO THE TOP OF THE EXISTING ROADWAY LIMEROCK BASE COURSE.

PIPE DIAMETER OR SPAN WIDTH	'X'
< = 15"	12 INCHES
< = 24"	16 INCHES
< = 30"	24 INCHES

PIPE BEDDING SHA



TO COVER BELOW

ALL LENGTH
THE
CROSSING

TYPE

COVER
R

URERS

LY.


DS OF

STATEMENT


IS SHALL BE LAID TO PROVIDE
WEEN THE INVERT OF THE
S MINIMUM SEPARATION
SO THAT THE SEWER PIPE
E POINT OF CROSSING WITH
D BOTH PIPES SHALL BE
ROSSING OVER A WATER
ES AND JOINTS IN THE
IRRESPECTIVE OF

TER MAIN AND STORM OR


IDE A MINIMUM VERTICAL
F THE FORCE MAIN AND
HE FORCE MAIN.

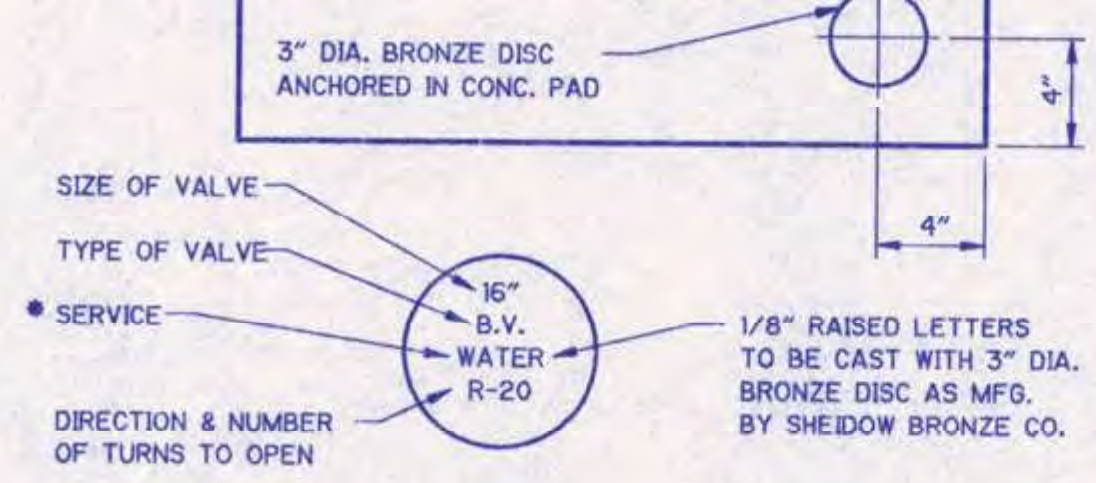

CONCRETE VALVE PAD/IDENT. DISC.
NTS

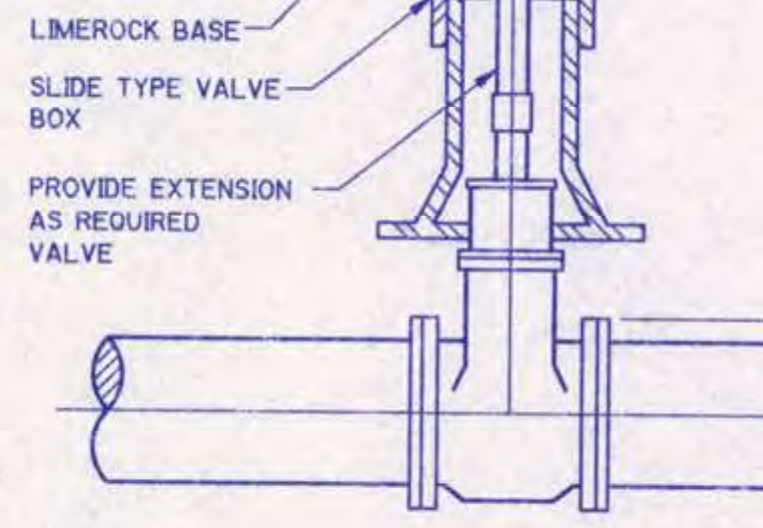


VALVE AND BOX
NTS

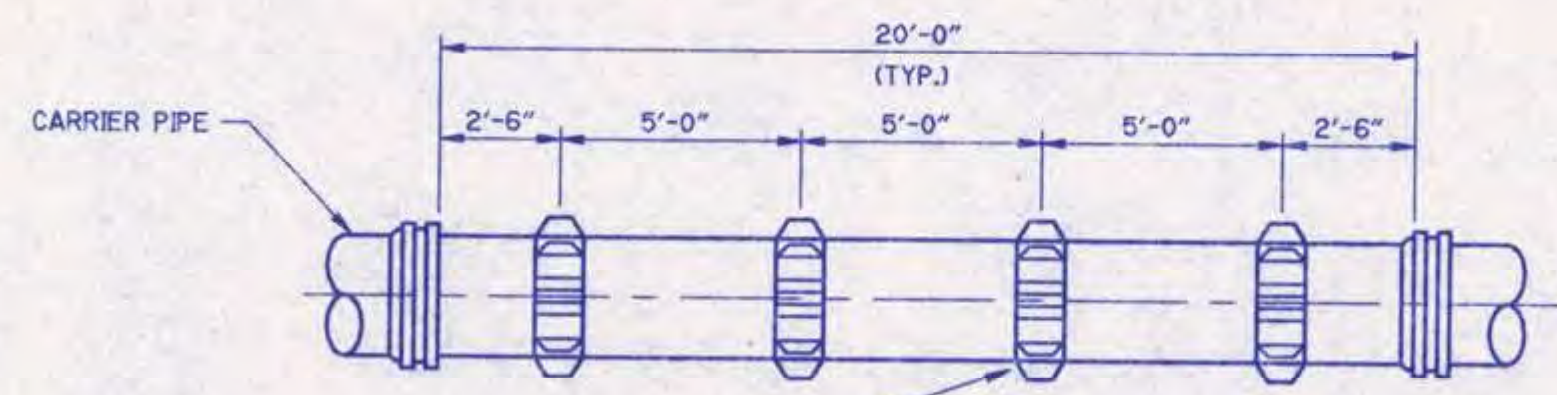

PLASTIC CASING INSULATOR, MODEL PE "FOR PVC CARRIER PIPE APPLICATIONS ONLY" WITH SPECIAL RUNNER HEIGHTS. RUNNER HEIGHT TO BE LARGE ENOUGH, SO THAT IT DOES NOT INTERFERE WITH THE PIPE RESTRAINED JOINTS. PLASTIC CASING INSULATOR BY CASING SEALS AND INSULATORS, INC. OR EQUAL

FOR DUCTILE IRON CARRIER PIPE THE CASING INSULATOR TO BE ALL STAINLESS STEEL CASING SPACER AS MANUFACTURED BY CASCADE WATERWORKS MANUFACTURING COMPANY, YORKVILLE, ILLINOIS OR EQUAL

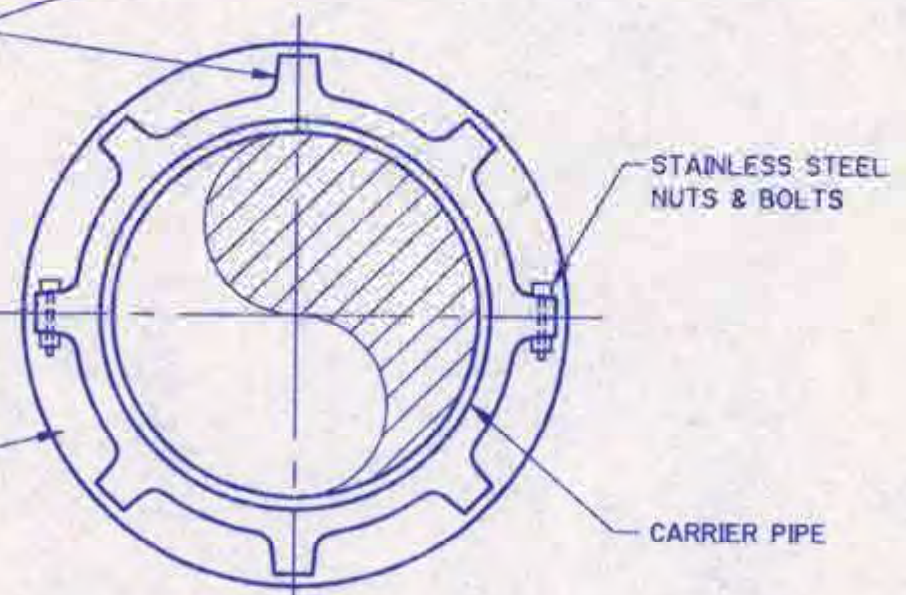

2"X180? RETURN BEND -

SEE SPEC'S. FOR PAINTING

STAINLESS STEEL INSECT SCREEN

OFFSET WITH BENDS AS REQUIRED

2" DIA. GAL'V. STEEL PIPE AND FITTINGS (WELDED ON NEW STEEL CASING)

MECHANICAL OR MASONRY SEAL REQ'D. AROUND PIPE

MAIN

NOTE.

NO

1999 MWS St Johns Mini Golf

Water Sewer

As Built Drawings




2003 MWS Whisper Ridge Sub P1

Water Sewer

As Built Drawings



SECTION 1,36 & 42, TOWNSHIP 6S&7S, RANGE 28E ST. JOHNS COUNTY, FLORIDA

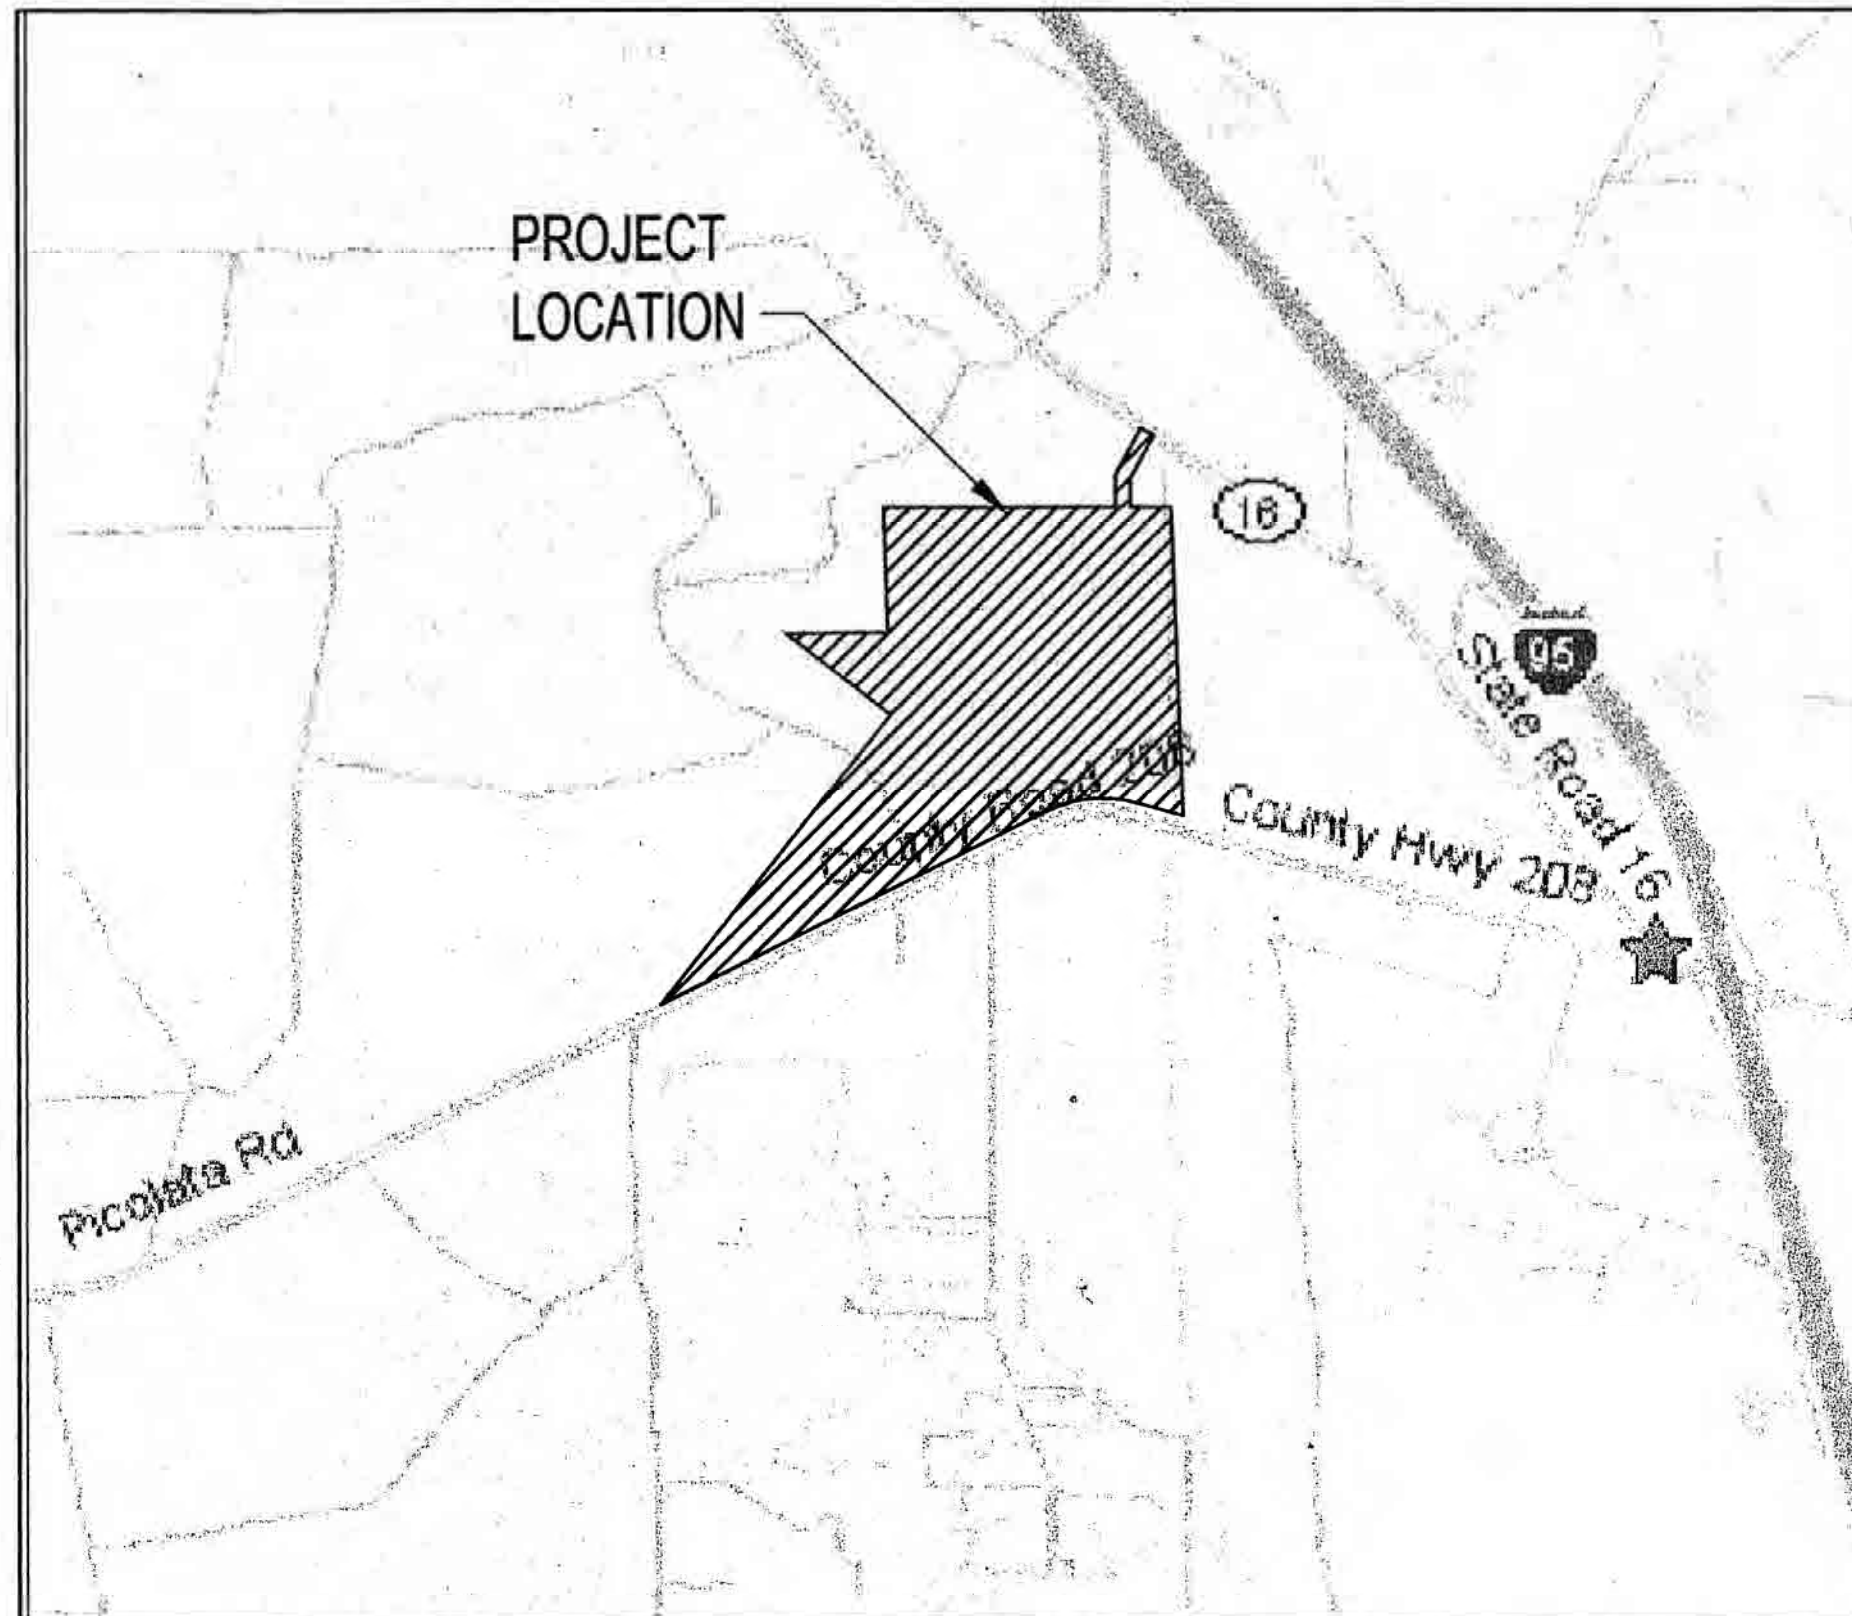

- ~~C1~~
- ~~C2~~
- ~~C3-C5~~
- ~~C6~~
- ~~C7~~
- ~~C8-C16~~
- ~~C17~~
- ~~C18,C19,C19~~
- ~~C20&C21~~
- ~~C22&C23~~
- ~~C24, C25~~
- ~~C28, C30~~
- ~~C31~~
- ~~C37~~
- ~~C38~~
- ~~C39~~
- ~~C40-C42~~
- ~~C43~~
- ~~C44&C45~~
- ~~C46~~
- ~~C47~~
- ~~C48~~
- ~~C49~~
- ~~C50~~
- ~~C51~~
- ~~C52~~
- ~~C53~~
- ~~C54~~

5
268-8558

7
346-0087

ATES

6
721-5758

E 200
250
285-1929

TOP EL. 10" WATER MAIN (30.21)
BOTTOM EL. 24" RCP (32.44)

SEE UTILITY
DETAILS SHEET
10" PVC-
(DR25)

STA. 4+33.1, 18.1' RT., TEE EL. (31.4) 10"x4" MJ TEE
STA. 4+33.3, 15.6' RT., VALVE EL. (32.0) 4" G.V.

STA. 4+30.9, 19.6' RT. FIRE HYDRANT
STA. 4+35.7, 18.7' RT., TEE EL. (31.3) 10"x6" MJ TEE
STA. 4+33.9, 19.8' RT., VALVE EL. (32.2) 6" GATE VALVE
90° BEND, STA. 4+35.8, 19.7' RT., EL. (31.2)

STA. 4+31.9, 19.2' RT., VALVE EL. (32.2) 10" GATE VALVE

PIPE ELEVATIONS AT UTILITY CROSSING
BOTTOM EL. 10" WATER MAIN (31.32)
TOP EL. 30" RCP (29.72)

(2) 10" 22 1/2"
MJ BENDS
STA. 5+99.4, 25.5' RT.
EL. (31.1)

POND 1

10" PVC (DR25)

SEE UTILITY CONFLICT
DETAILS SHEET C45

STA. 15+53.9, 18.9' LT.
VALVE EL. (36.9)
2" BLOWOFF
VALVE

PIPE ELEVATIONS AT UTILITY CROSSING
TOP EL. 10" WATER MAIN (31.80)
BOTTOM EL. 15" RCP (32.69)

4" 22 1/2" MJ BEND
STA. 15+47.0, 25.6' LT.
EL. (33.0)

4" 22 1/2" MJ BEND
STA. 15+28.2, 40.5' LT.
EL. (33.0)

4" PVC WM
STA. 14+92.2, 41.5' LT.
EL. (33.8)


4" 22 1/2" MJ BEND
STA. 14+43.1, 17.2' LT.
EL. (33.8)

SINGLE
WATER SERVICE
STA. 14+11.2, 26.7' LT.

DOUBLE
WATER SERVICE
STA. 15+09.4, 48.7' RT.

DOUBLE
WATER SERVICE
STA. 8+66.6, 28.5' RT.

PIPE ELEVATIONS
BOTTOM EL. 4"
TOP EL. 24" RCP

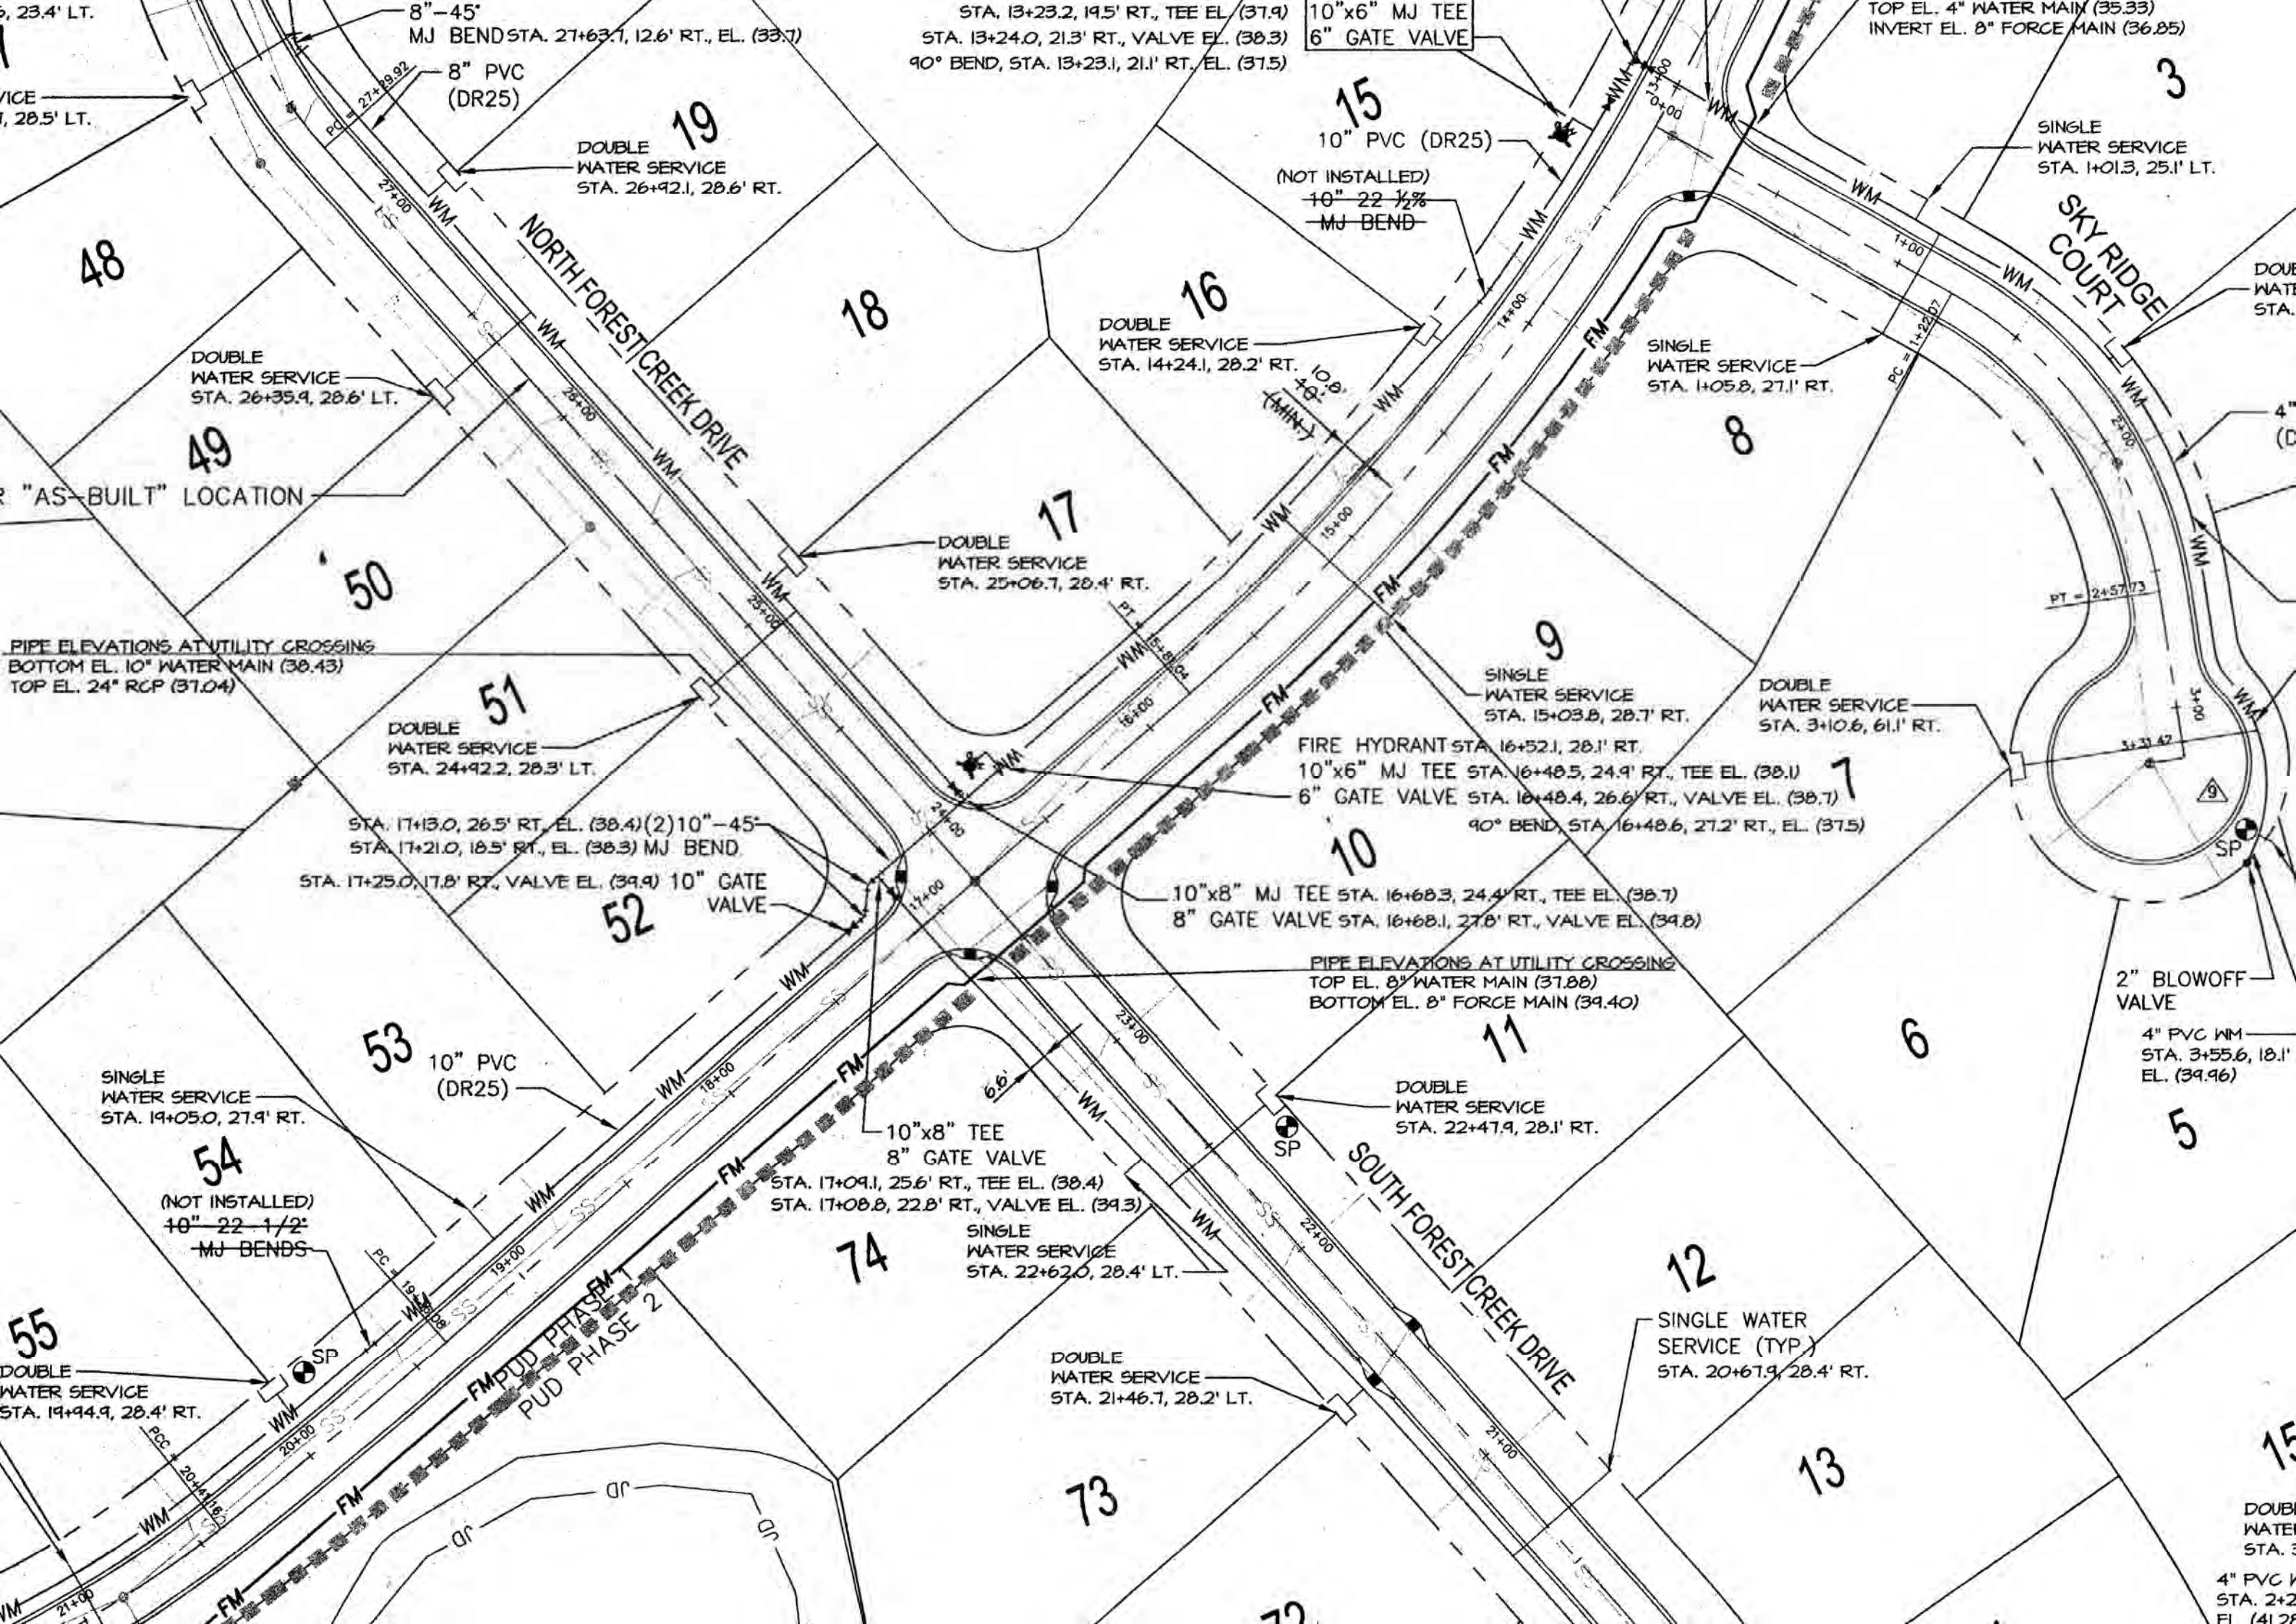

99

98

97

10" PVC
(DR25)

96

HYDRANT
MJ TEE
GATE VALVE


95

LEGEND

PROPERTY BOUNDARY
PROPOSED PAVEMENT
UTILITY EASEMENT
PROPOSED STORM WATER



POND #4

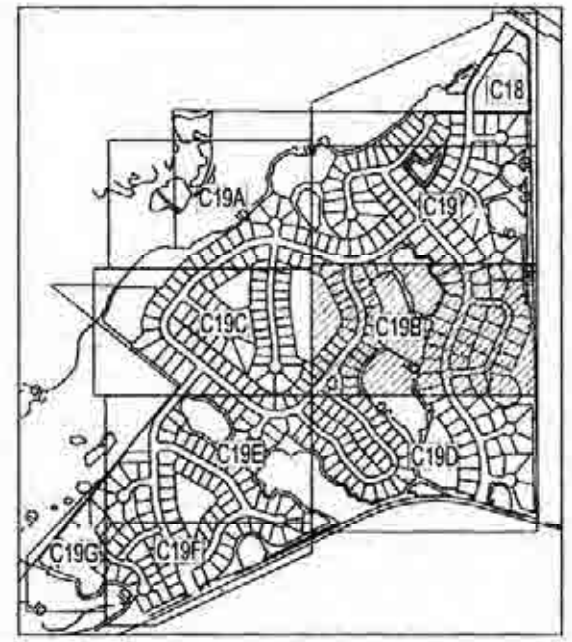

KEY MAP

ARE IN ACCORDANCE WITH THE APPROVED PLANS AND CITY
SPECIFICATIONS, UNLESS OTHERWISE APPROVED BY THE
CITY ENGINEER.

AUTHORIZED SIGNATURE *Mark A. [Signature]*

68

67

33

34

35

36

37

29

66

8" PVC
(DR25)

SOUTH FOREST CREEK DRIVE

65

64

63

FIRE HYDRANT
8"x6" MJ TEE
6" GATE VALVE

8" PVC
(DR25)

JD JD JD JD JD

SP
WM

WM


WM

SECTION.

IS AT UTILITY CROSSING
ER MAIN (26.80)
ORCE MAIN (29.09)


PITS SHALL BE FILLED & COMPACTED IN ACCORDANCE WITH FDOT
SPECIFICATIONS.

2. MAINTENANCE OF TRAFFIC REQUIREMENTS PER FDOT INDEX 602. IT
SHALL BE ALSO APPLICABLE TO THE CONSTRUCTION OF
"EMERGENCY TRAFFIC SIGNALS" AS MAY BE NECESSARY.
3. DEWATERING IS REQUIRED TO CONTROL GROUNDWATER ELEVATION
AROUND THE DRILLING AND RECEIVING PITS.
4. UNDERGROUND UTILITY LOCATION (HORIZONTAL AND VERTICAL)
SHOWN IS BASED ON THE SURVEY DATA PREPARED BY RICHARD
A. MILLER AND ASSOCIATES AND SOFT DIG INFORMATION BY CLARY
& ASSOCIATES, INC.

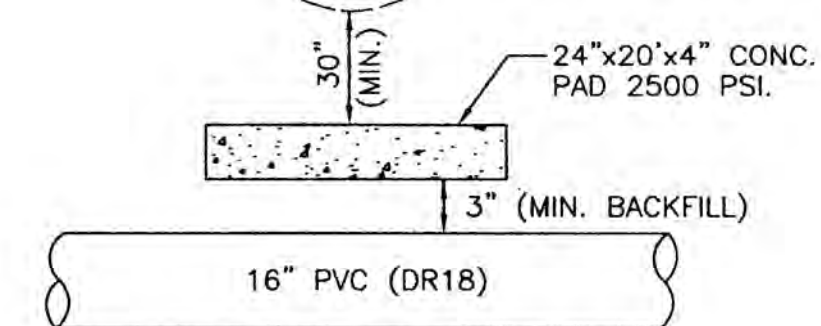

DITCH CROSSING DETAIL

NTS

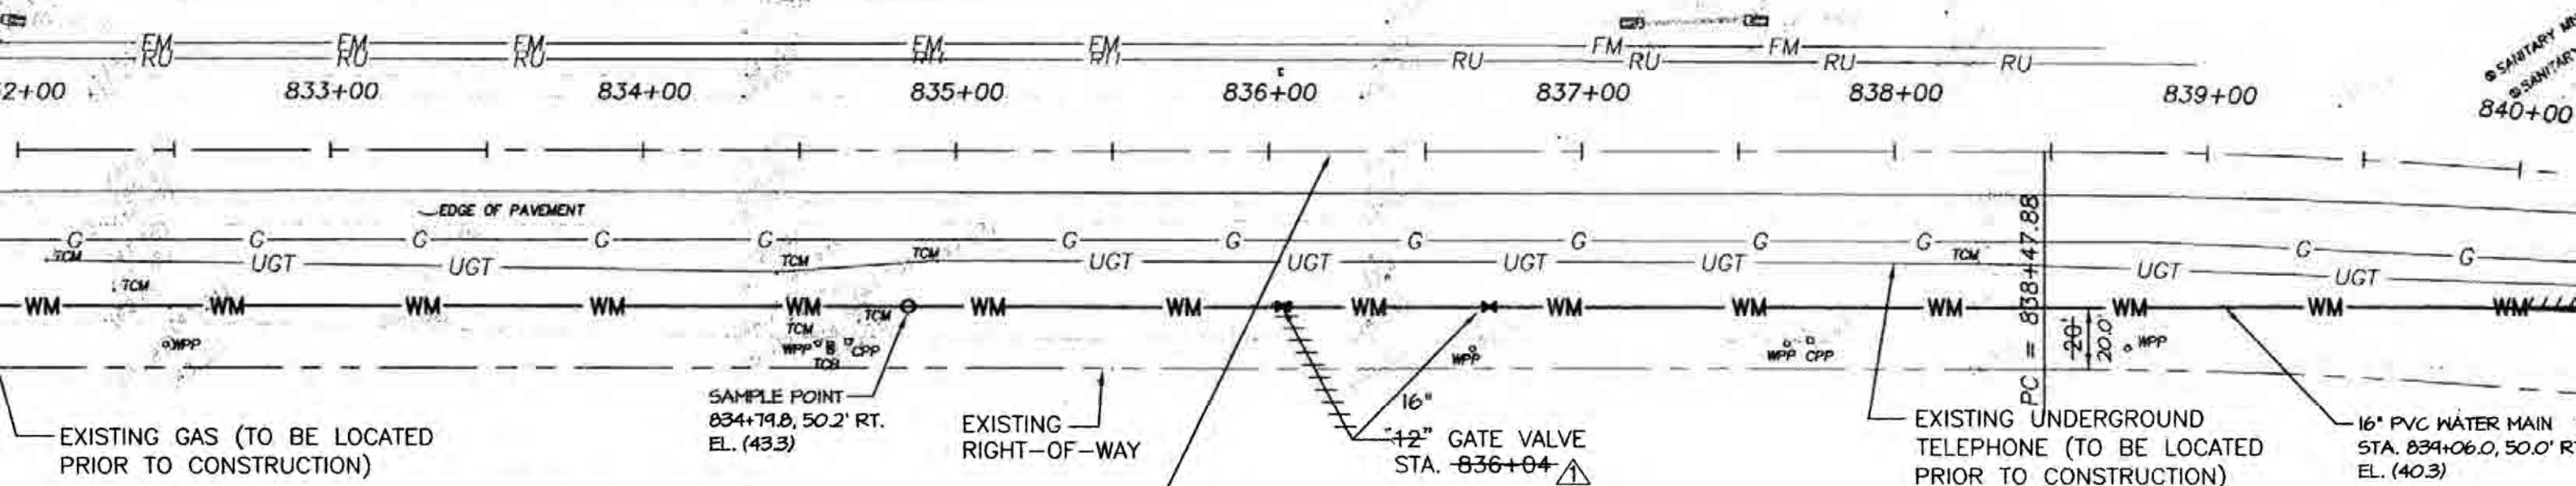

AS BUILT

INFORMATION PROVIDED BY:

NAME: VALLENCOURT CONSTRUCTION CO., INC.
DATE: FEBRUARY 16, 2004
ADDRESS: P.O. BOX 65849
ORANGE PARK, FL 32065
PHONE: (904) 291-9330


I HEREBY CERTIFY THAT THE MATERIALS USED IN THE
CONSTRUCTION OF

PAVEMENT	✓ WATER MAIN
CURB & GUTTER	✓ SANITARY GRAVITY SYSTEM
STORM & DRAINAGE SYSTEM	✓ FORCE MAIN
	✓ LIFT STATION



ARE IN ACCORDANCE WITH THE APPROVED PLANS AND CITY
SPECIFICATIONS, UNLESS OTHERWISE APPROVED BY THE
CITY ENGINEER.



AUTHORIZED SIGNATURE


C/L OF R/W AND BASELINE FOR "AS-BUILT" LOCATION

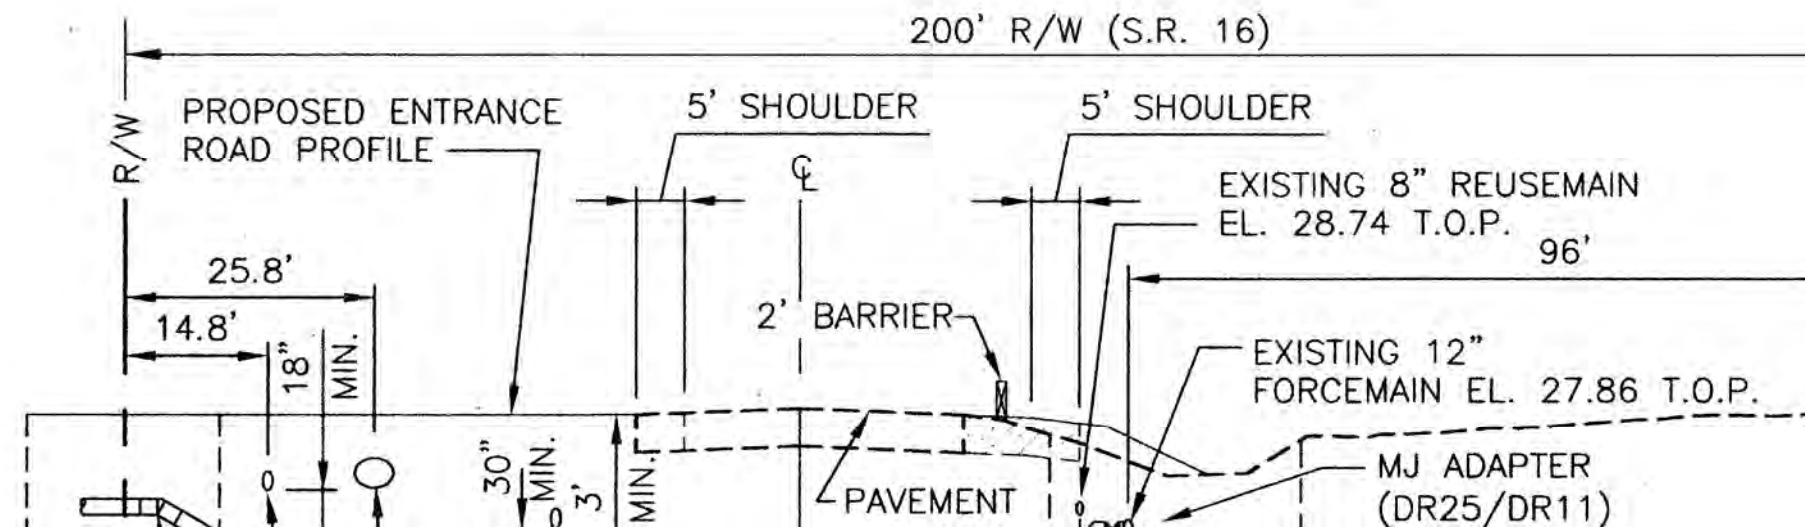



LOCATION

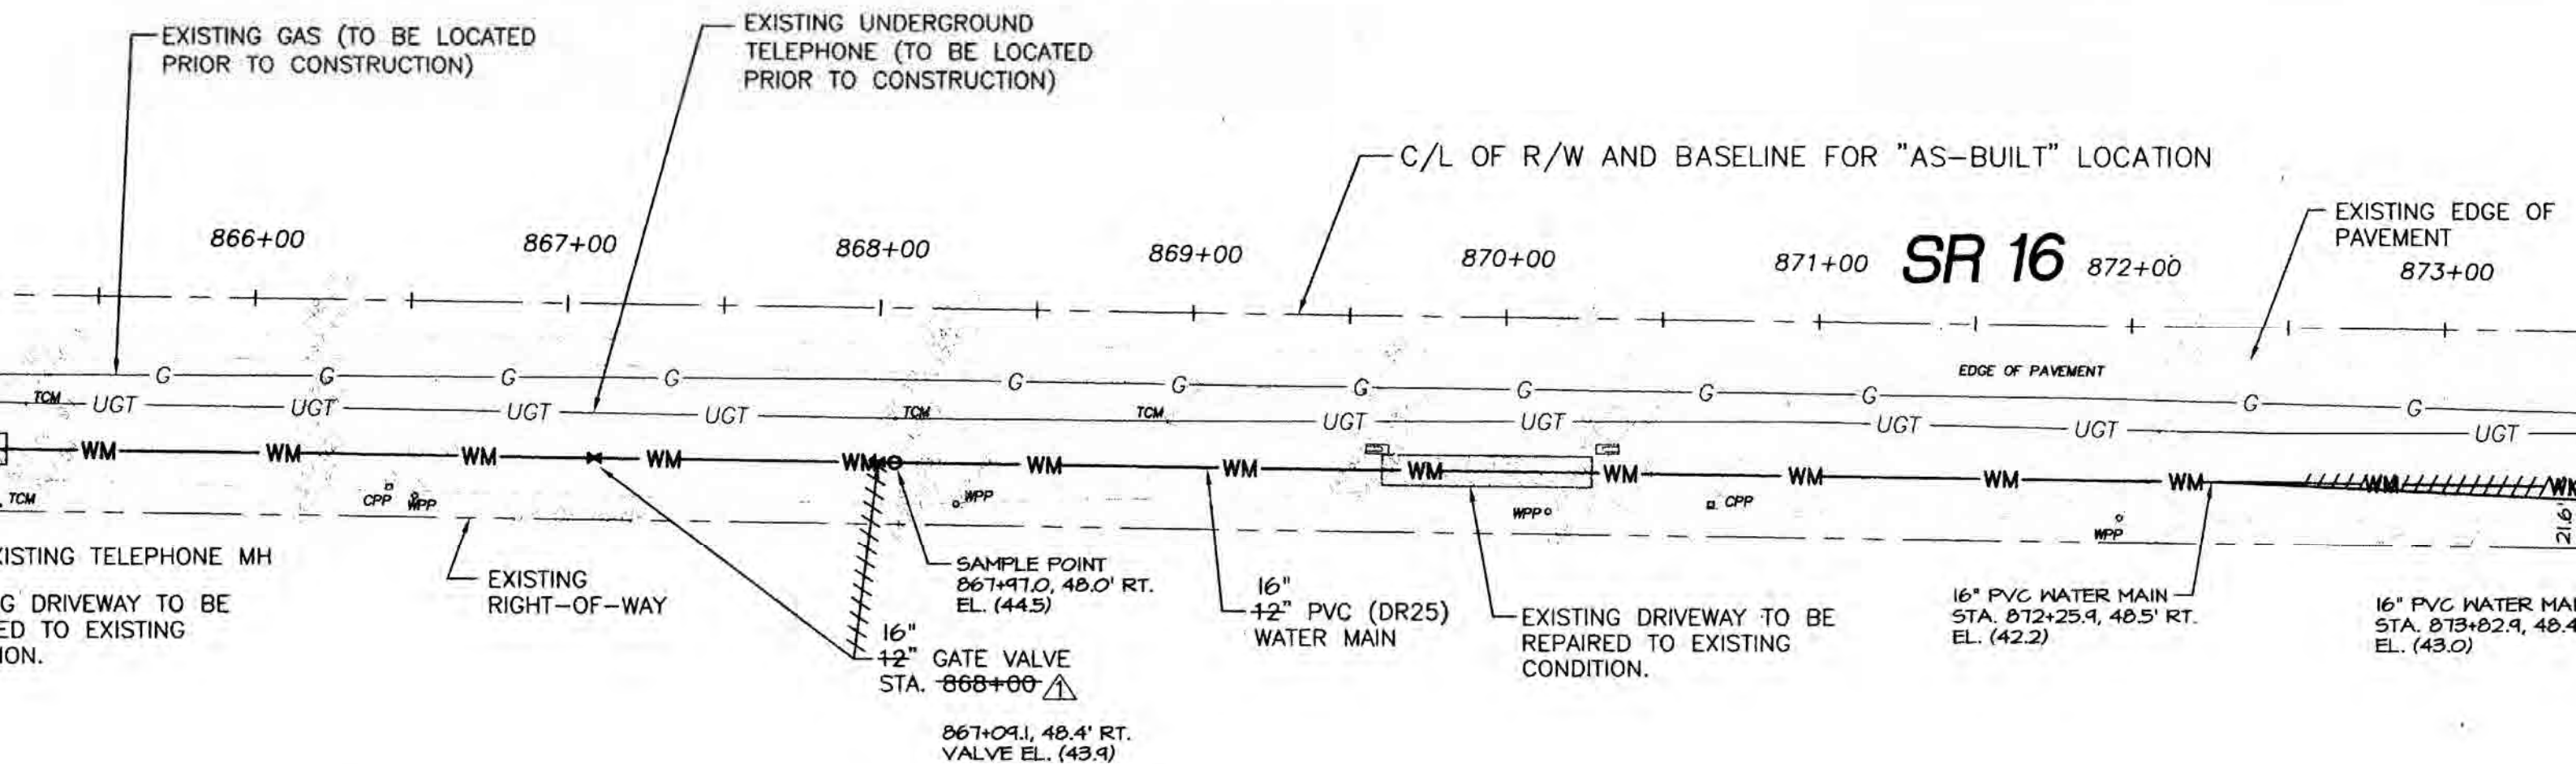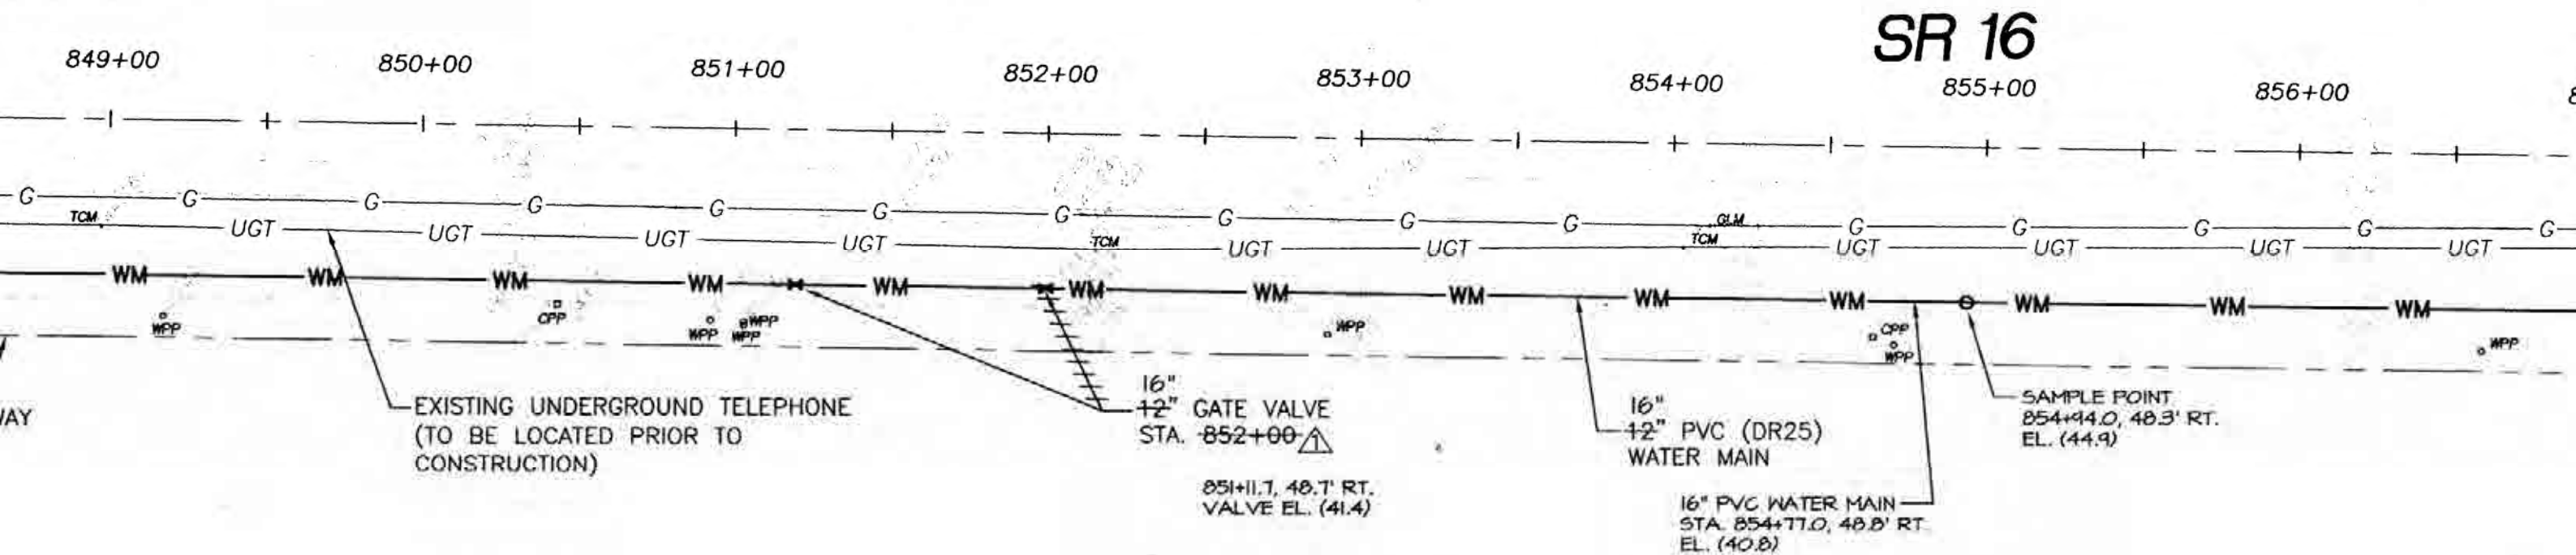

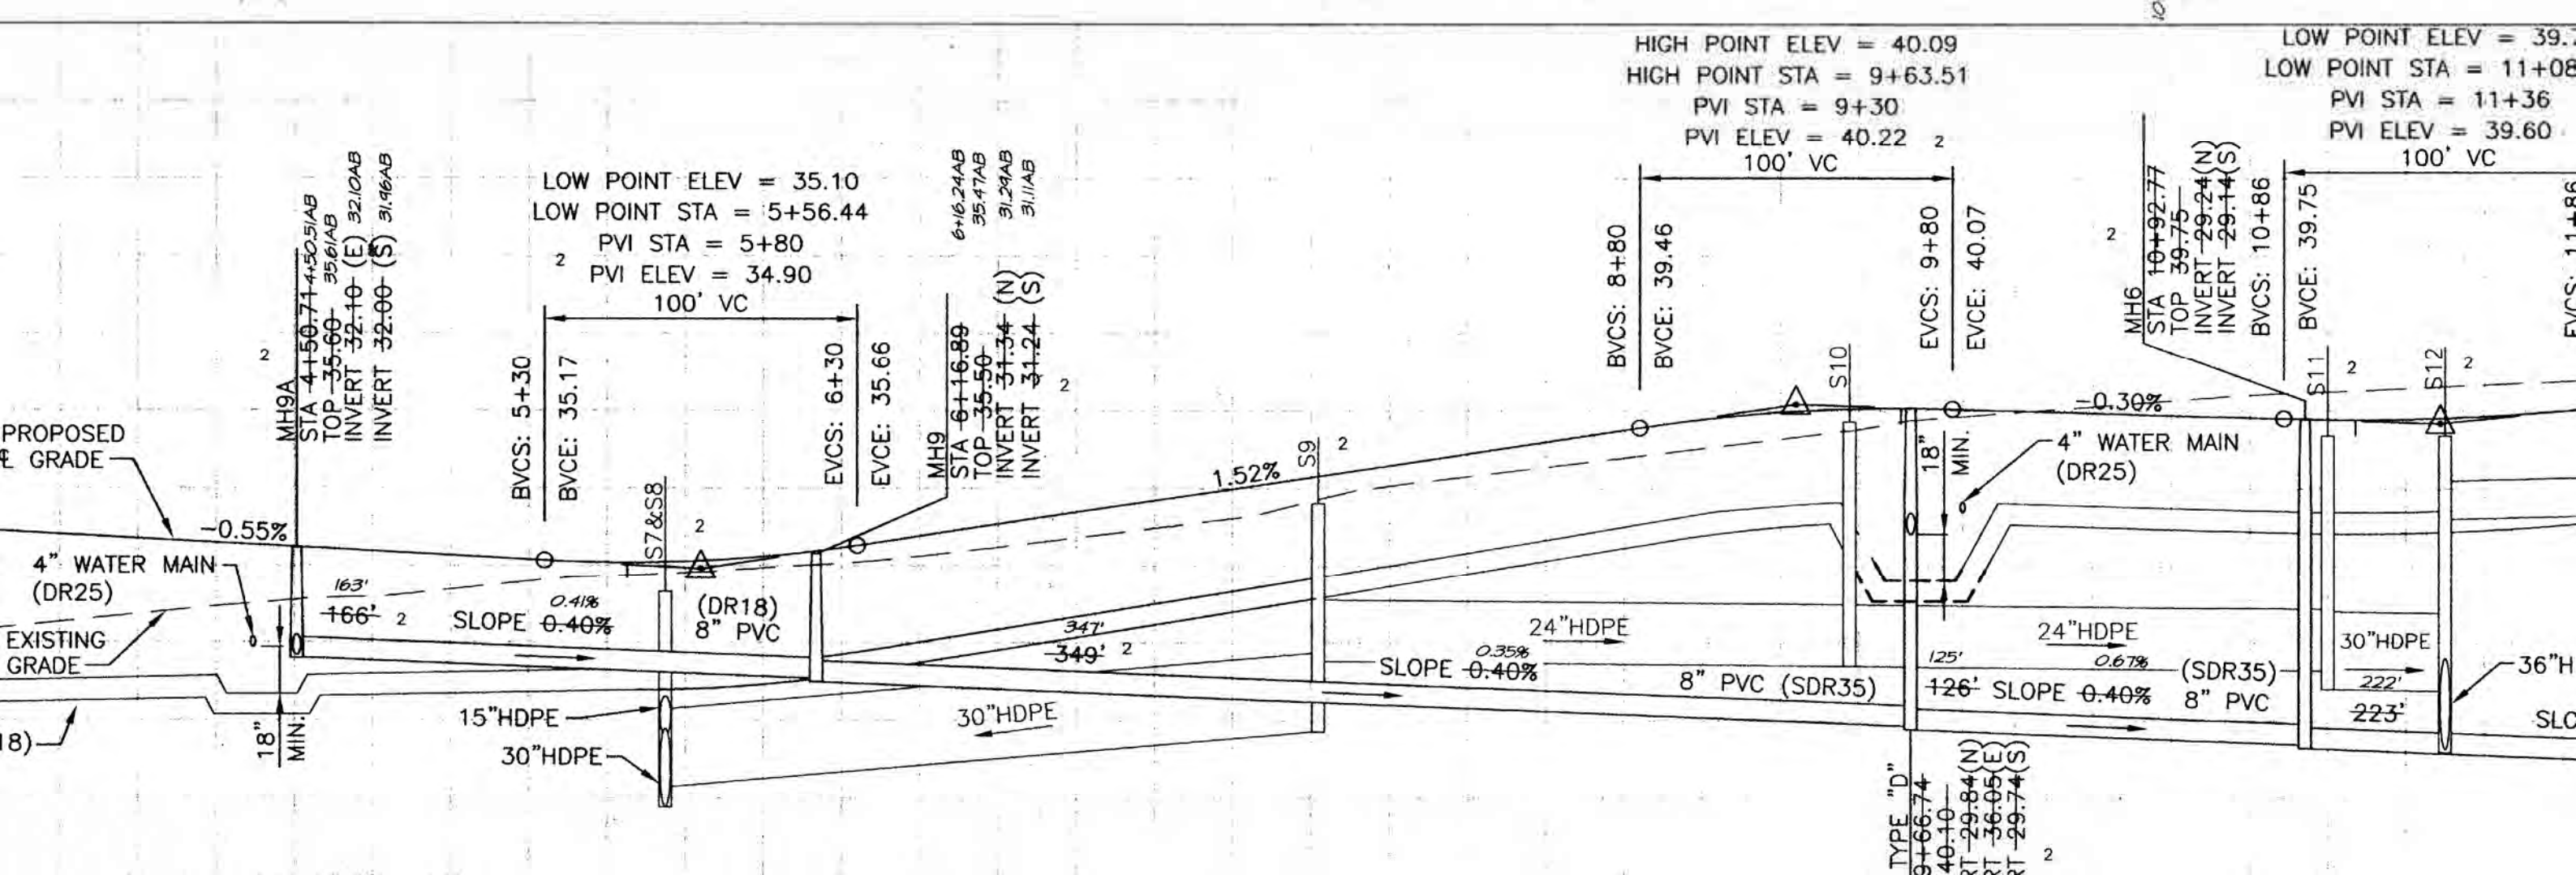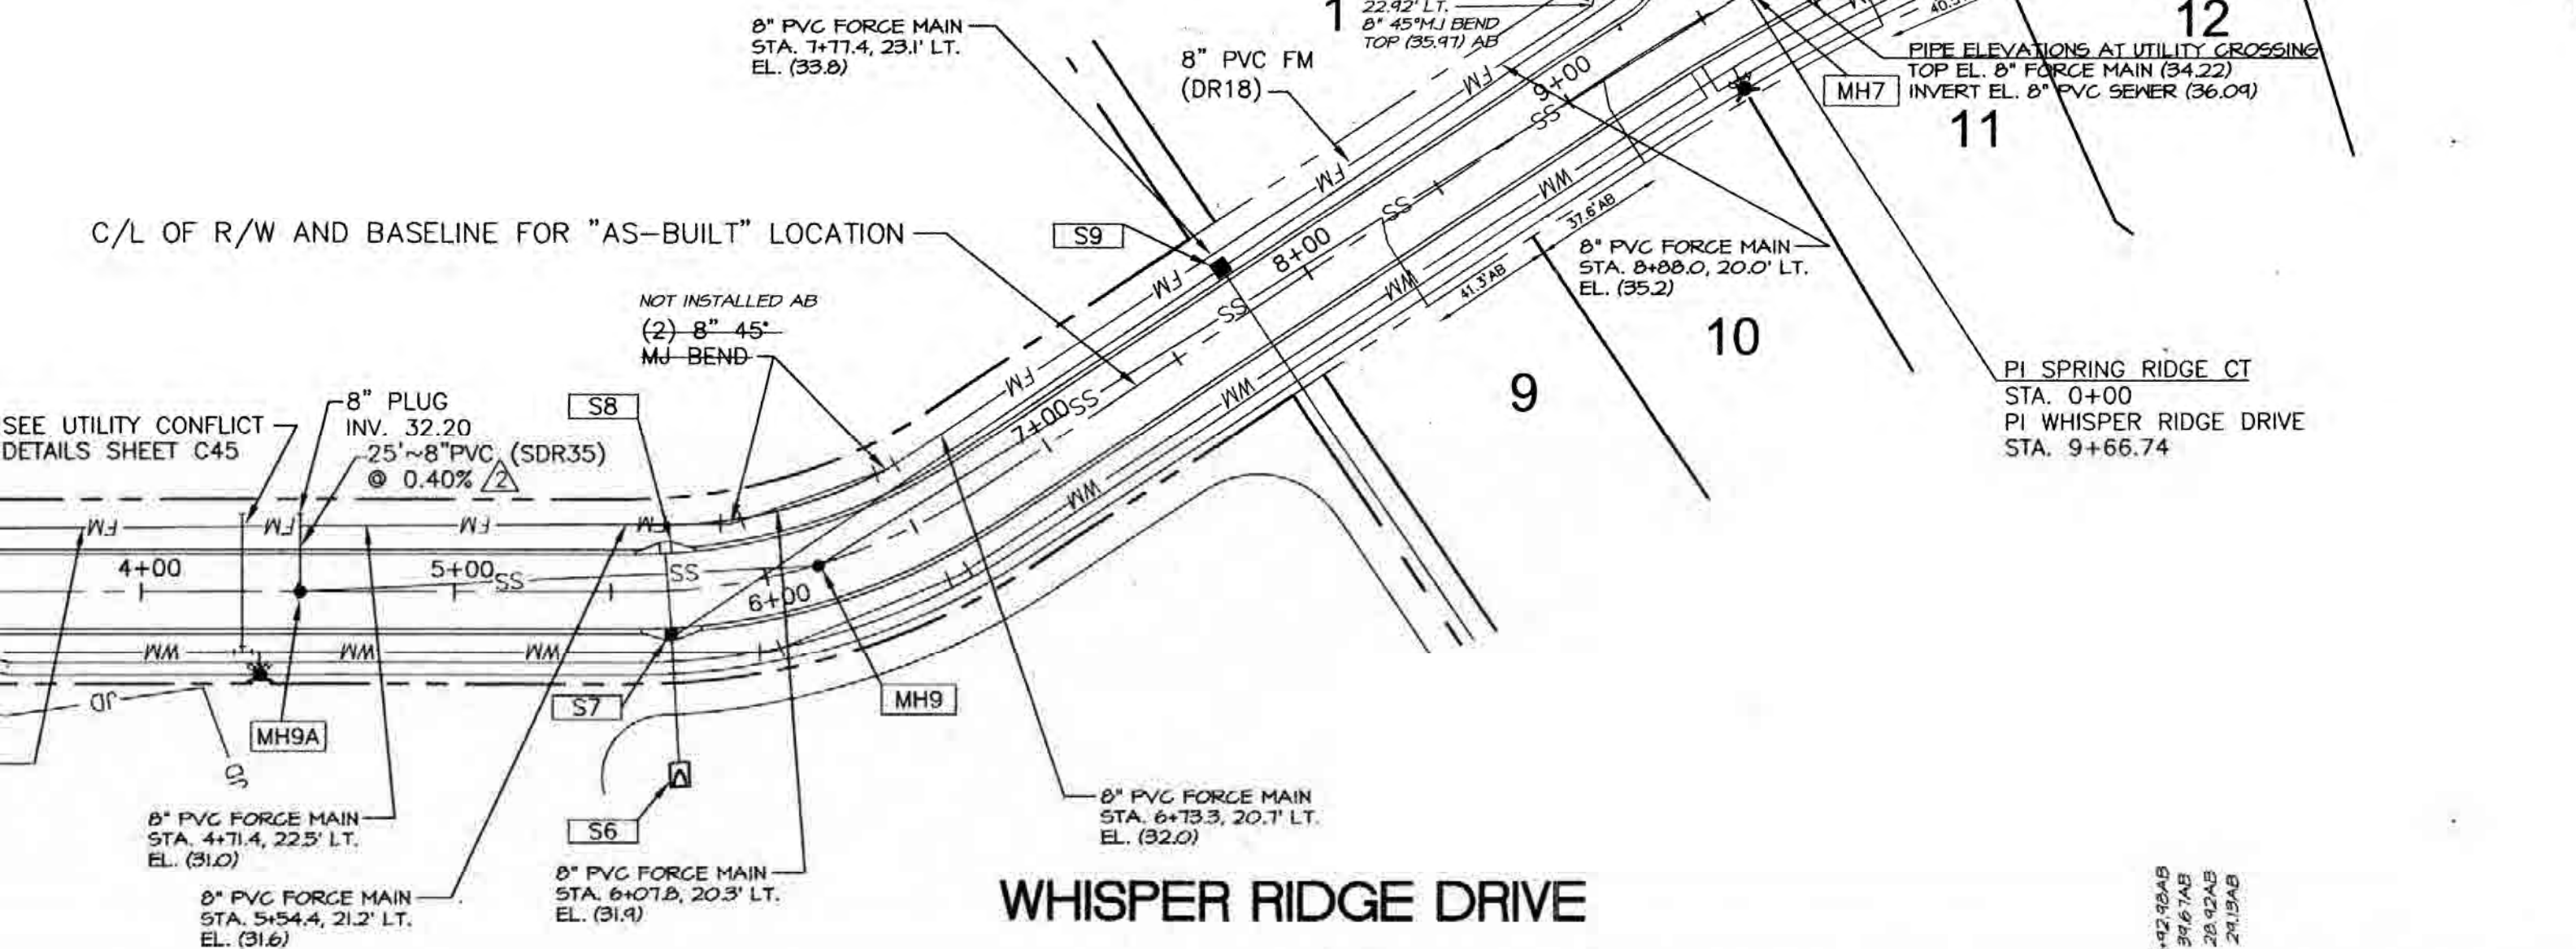


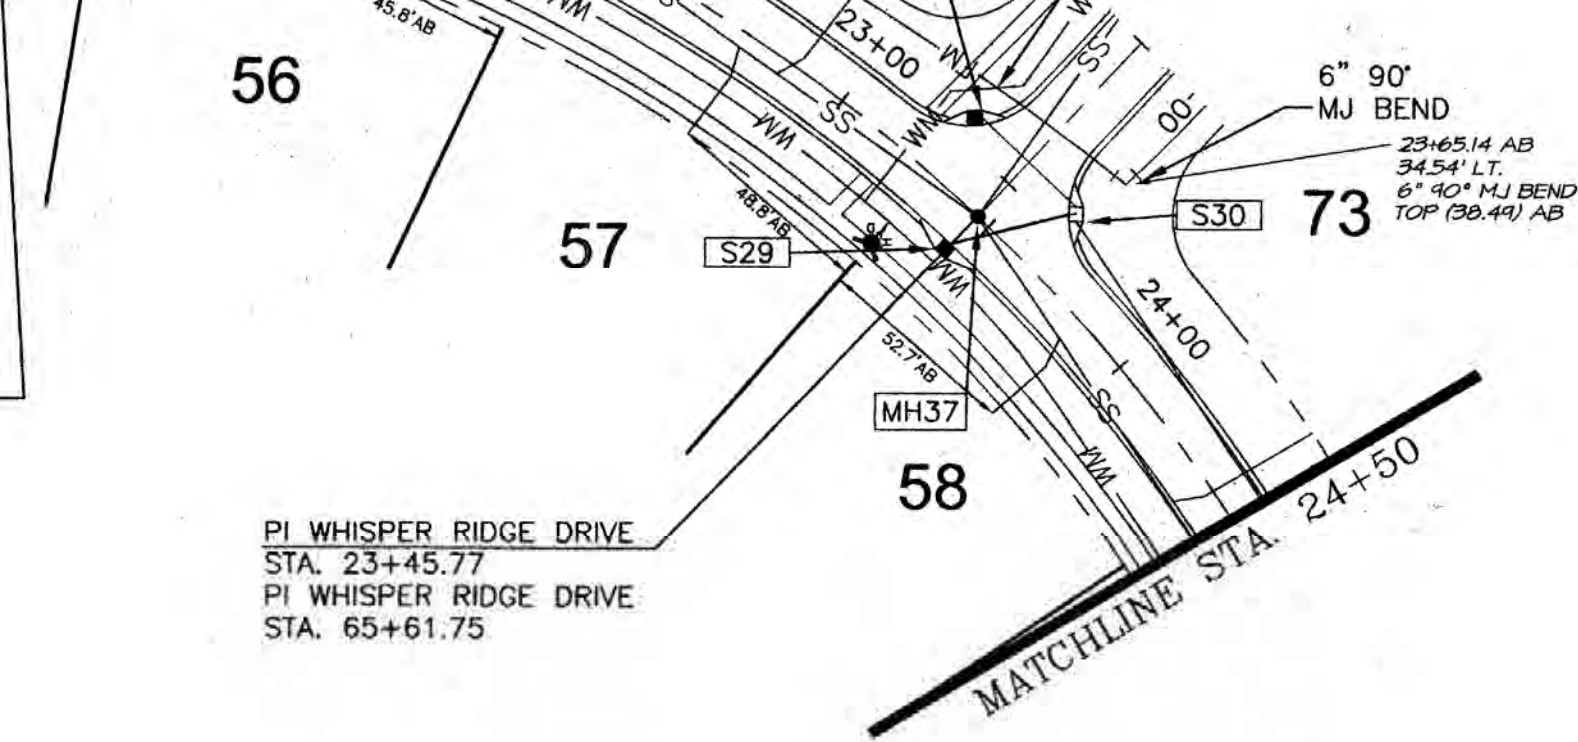



DRIVE

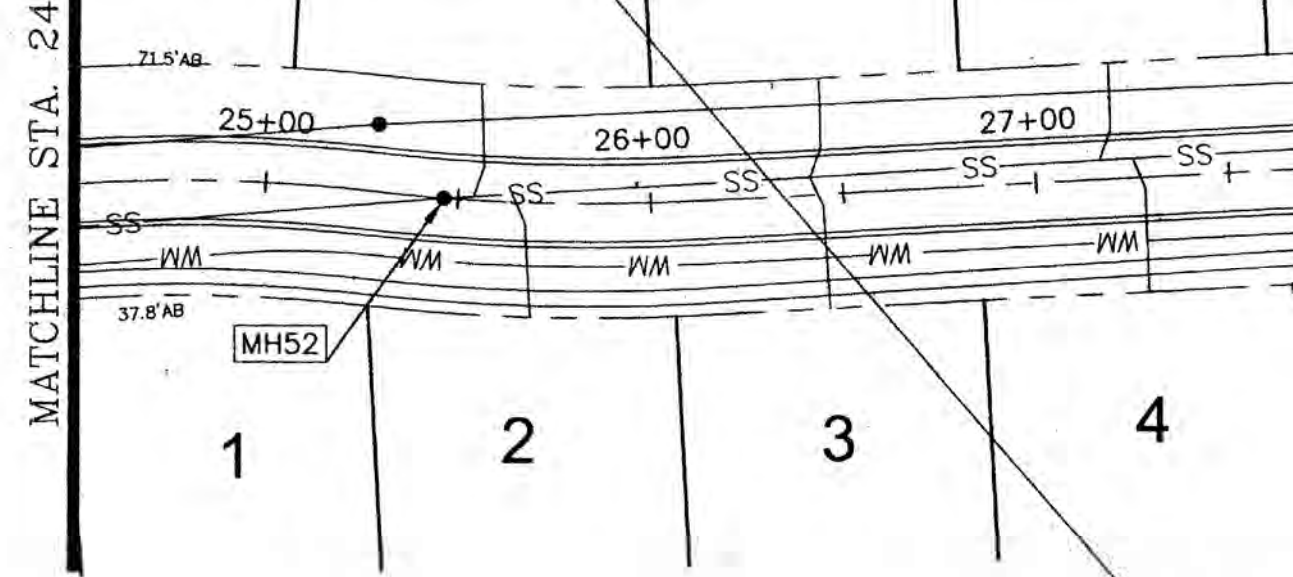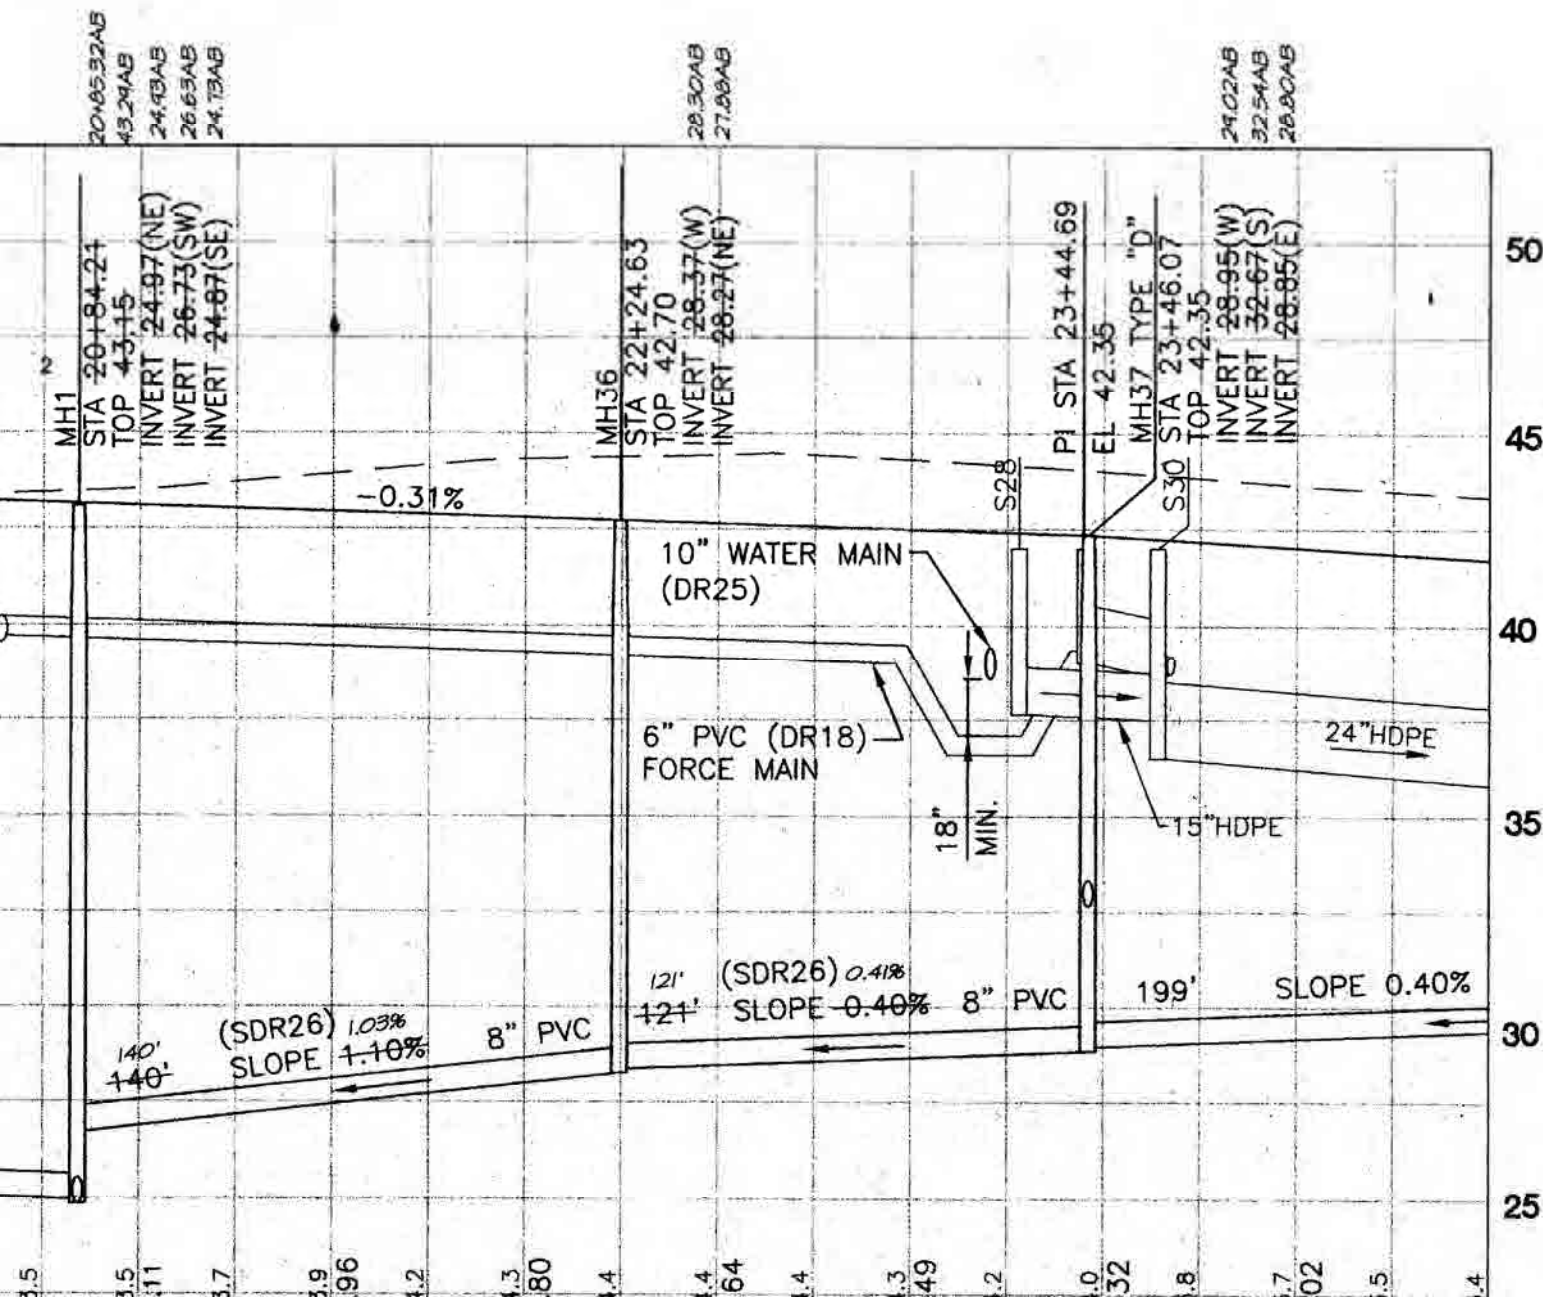

WHISF

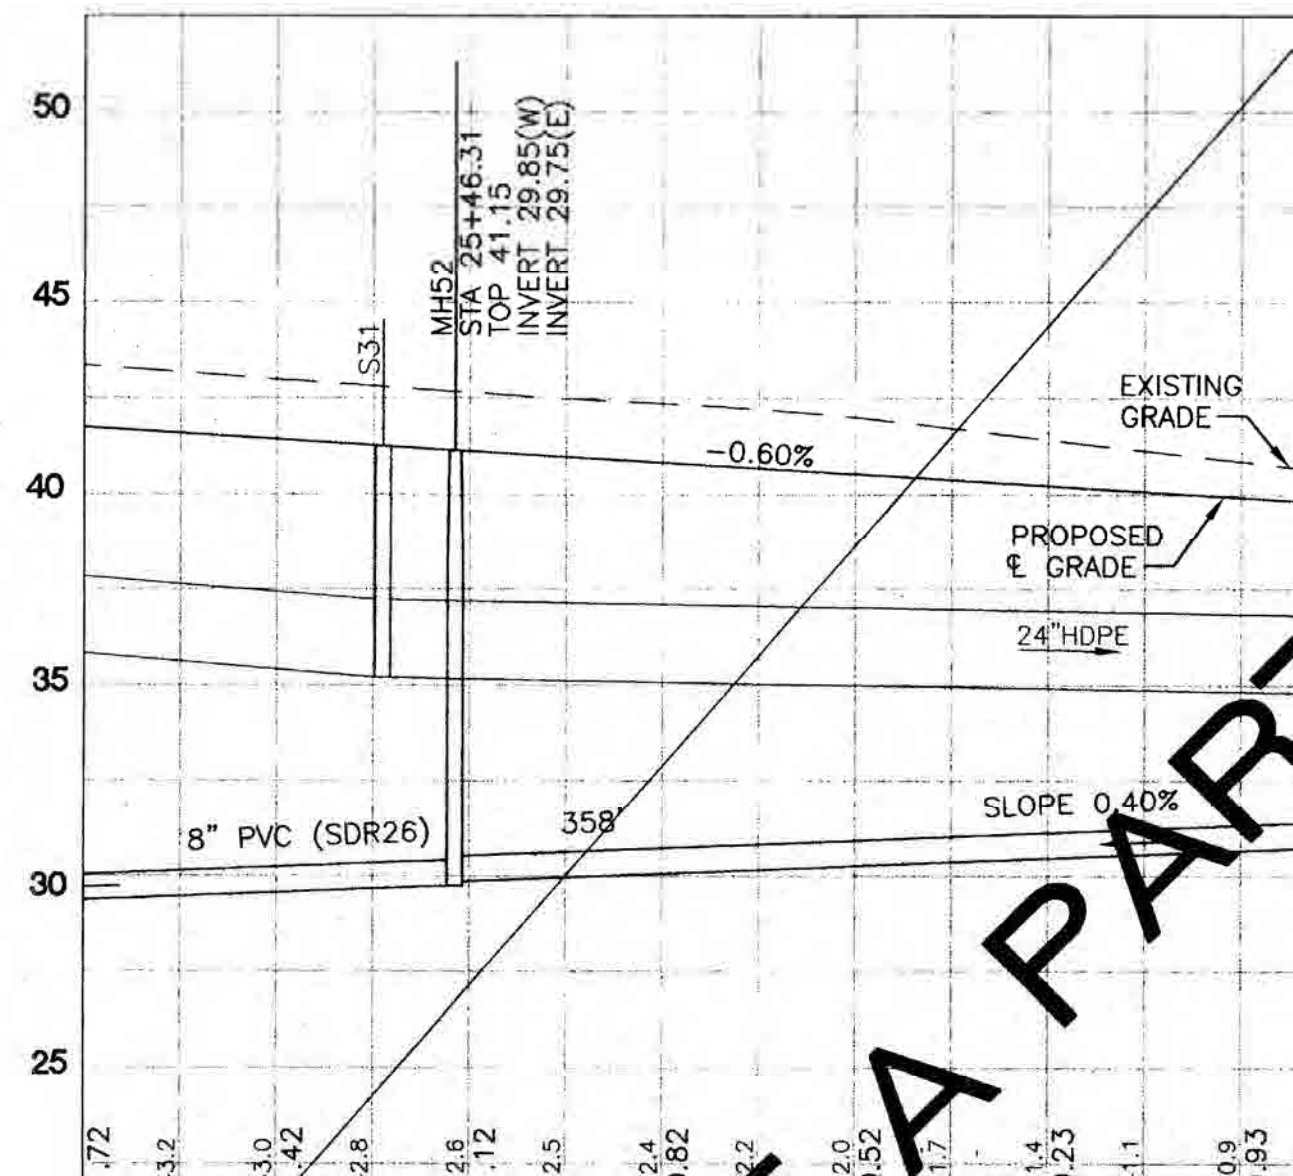

SPRING RIDGE COURT

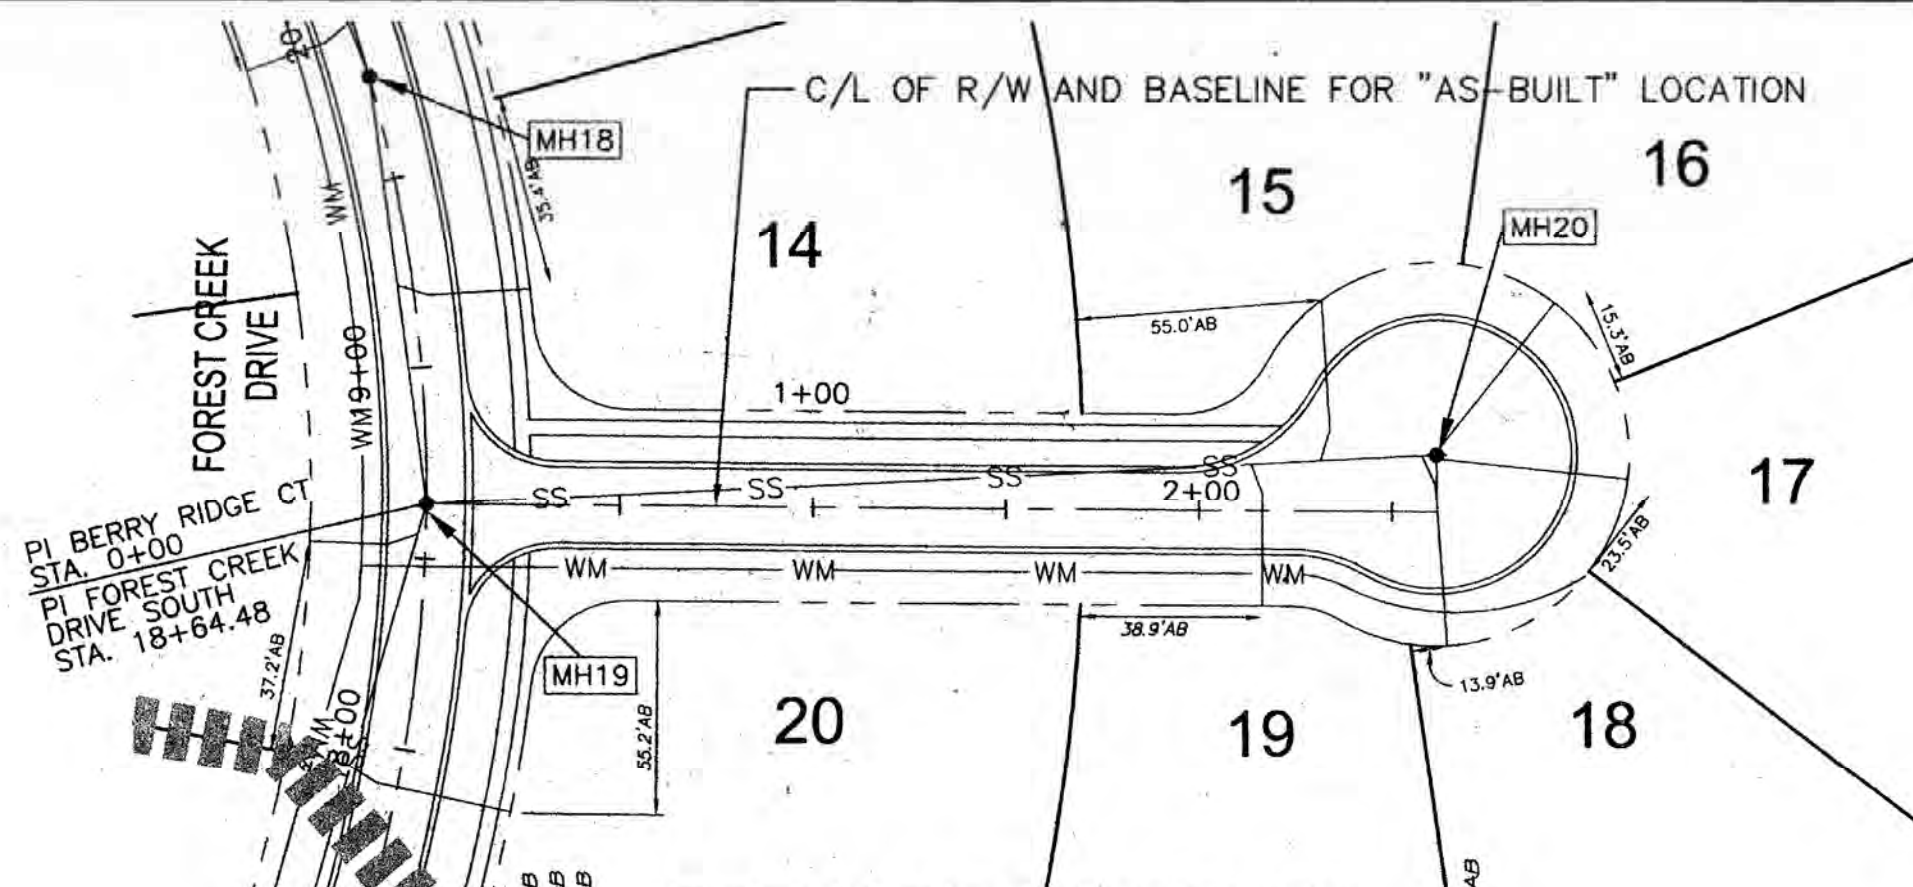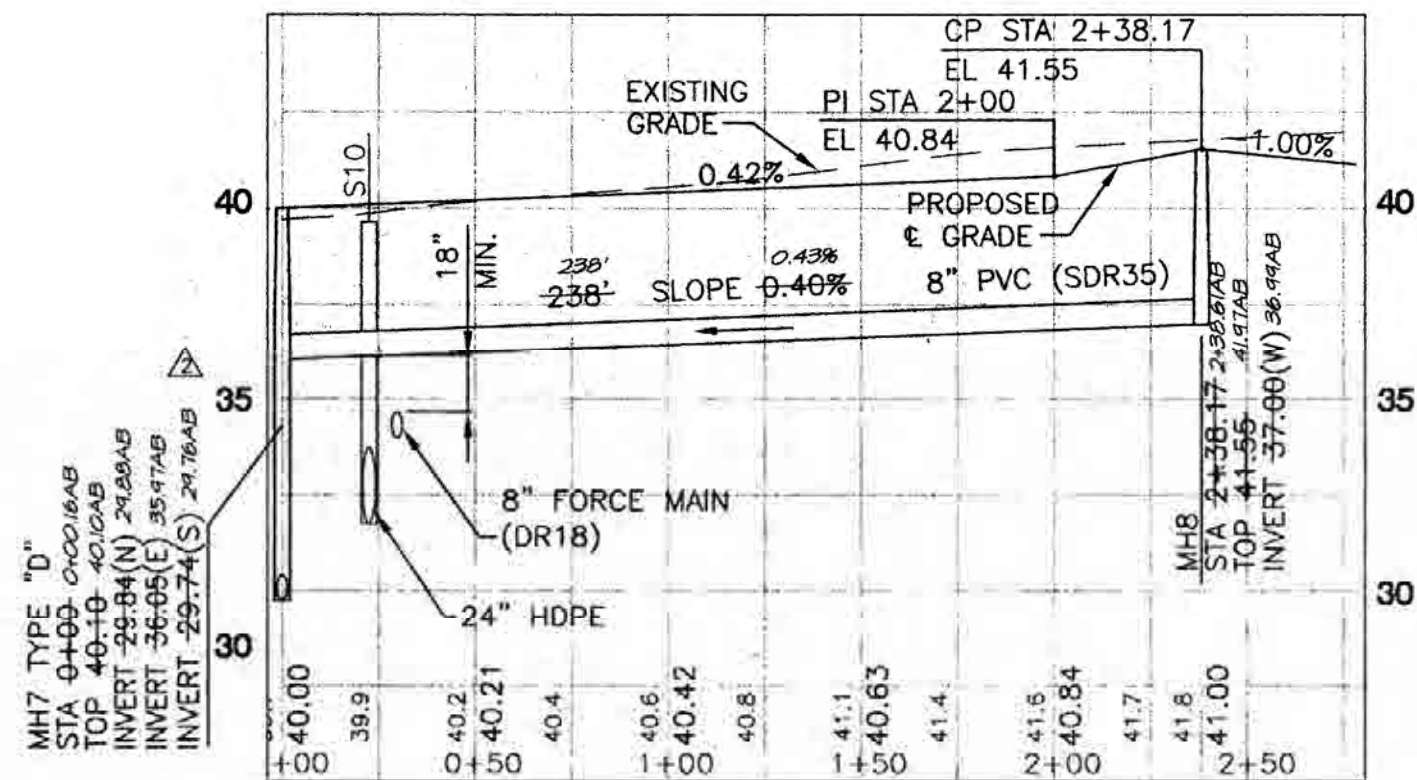

BERRY RIDGE COURT



PI BUCKHORN WAY
STA. 0+00
PI FOREST CREEK DR
SOUTH STA. 5+01.30



INVERT EL. 8" FORCE MAIN (37.67)
TOP EL. 8" PVC SEWER (30.19)

FOREST CREEK DRIVE

LONGNEE DRIVE

S23

31

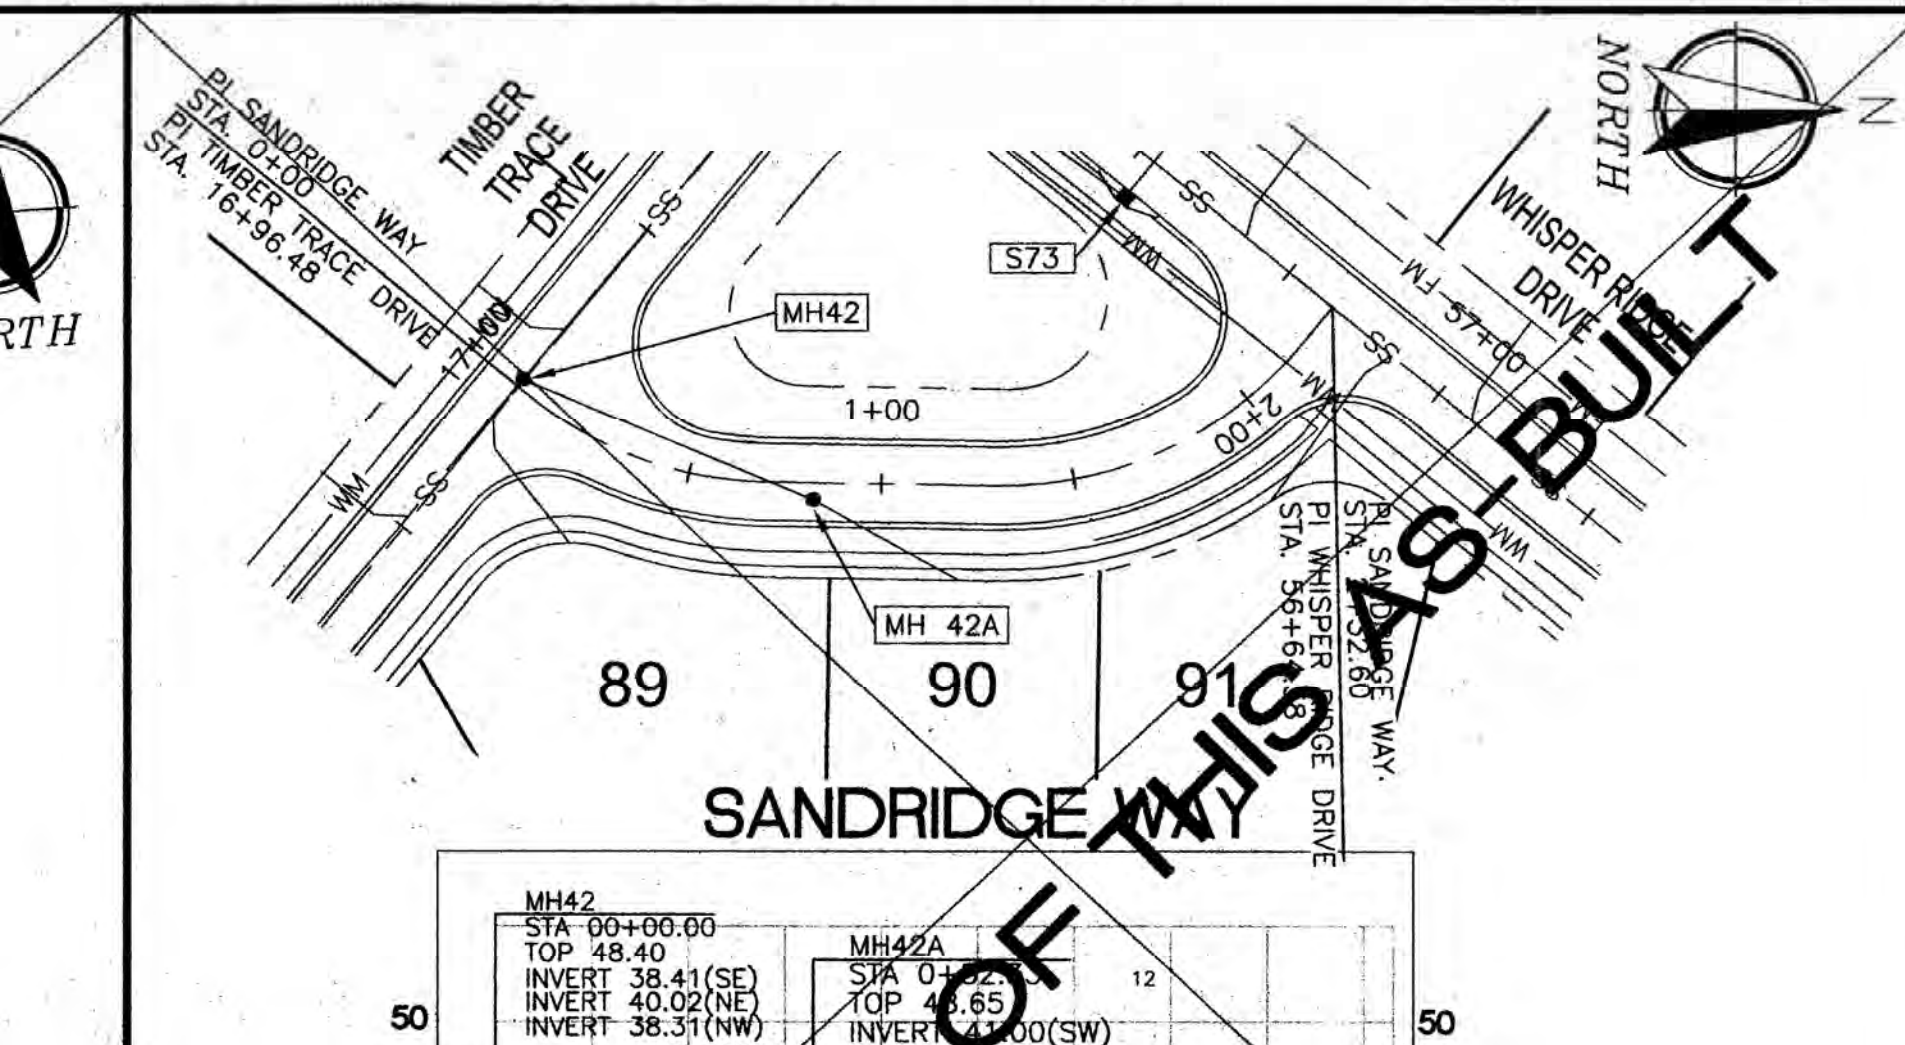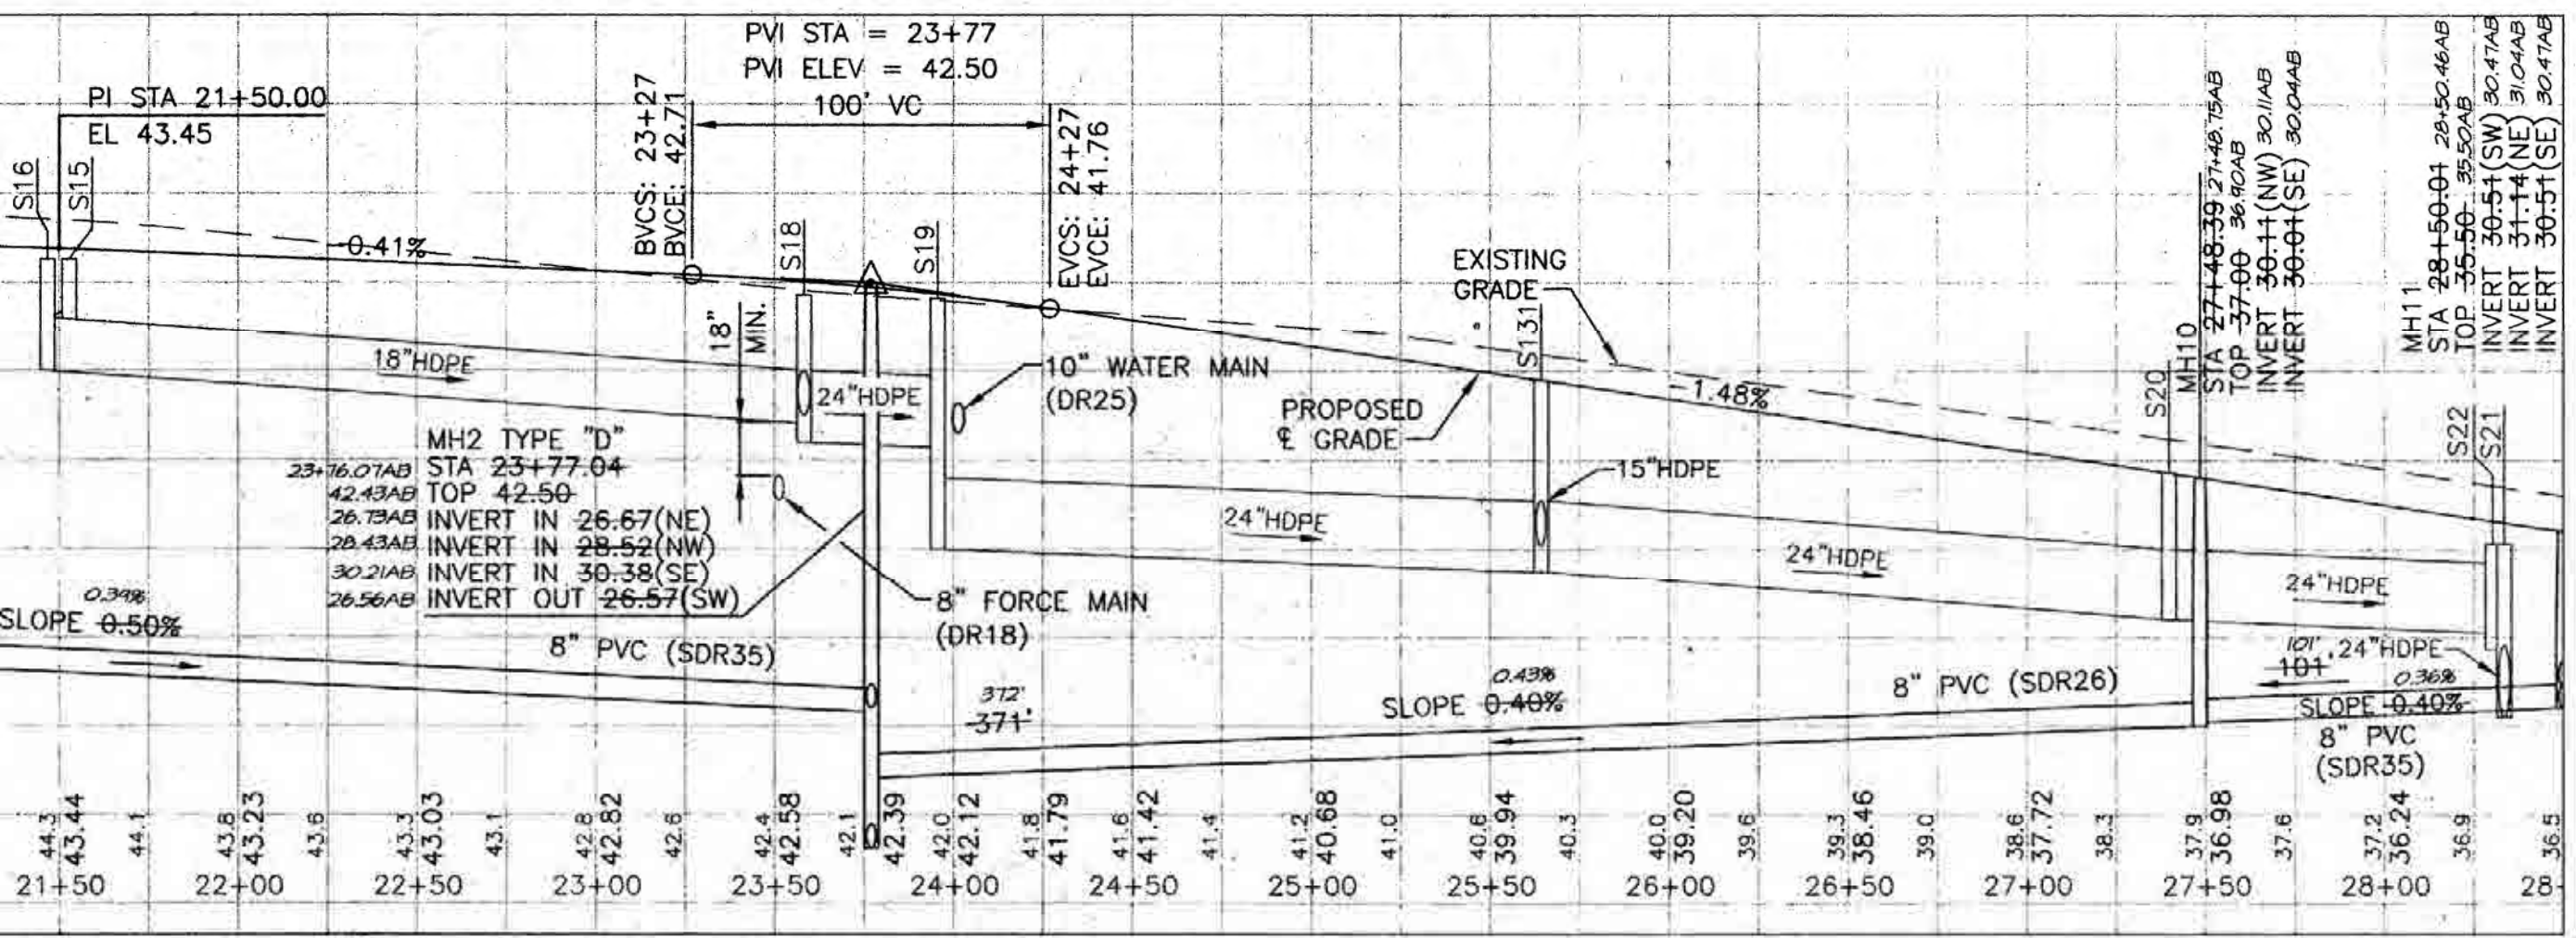

AS BUILT

INFORMATION PROVIDED BY:
NAME: VALLENCOURT CONSTRUCTION CO., INC.
DATE: FEBRUARY 16, 2004
ADDRESS: P.O. BOX 65849
ORANGE PARK, FL 32065
PHONE: (904) 291-9330

I HEREBY CERTIFY THAT THE MATERIALS USED IN THE CONSTRUCTION OF

PAVEMENT	WATER MAIN
CURB & GUTTER	SANITARY GRAVITY SYSTEM
STORM & DRAINAGE SYSTEM	FORCE MAIN
	LIFT STATION

ARE IN ACCORDANCE WITH THE APPROVED PLANS AND CITY SPECIFICATIONS, UNLESS OTHERWISE APPROVED BY THE CITY ENGINEER.

AUTHORIZED SIGNATURE *[Signature]*



AS BUILT

INFORMATION PROVIDED BY:





$V = 34.73$
 $= 7+35.24$
 7+00
 34.60
 VC
 2.72%
 6.60%
 PVC
 35)
 E
 35.9
 34.74
 35.7

40
35
30

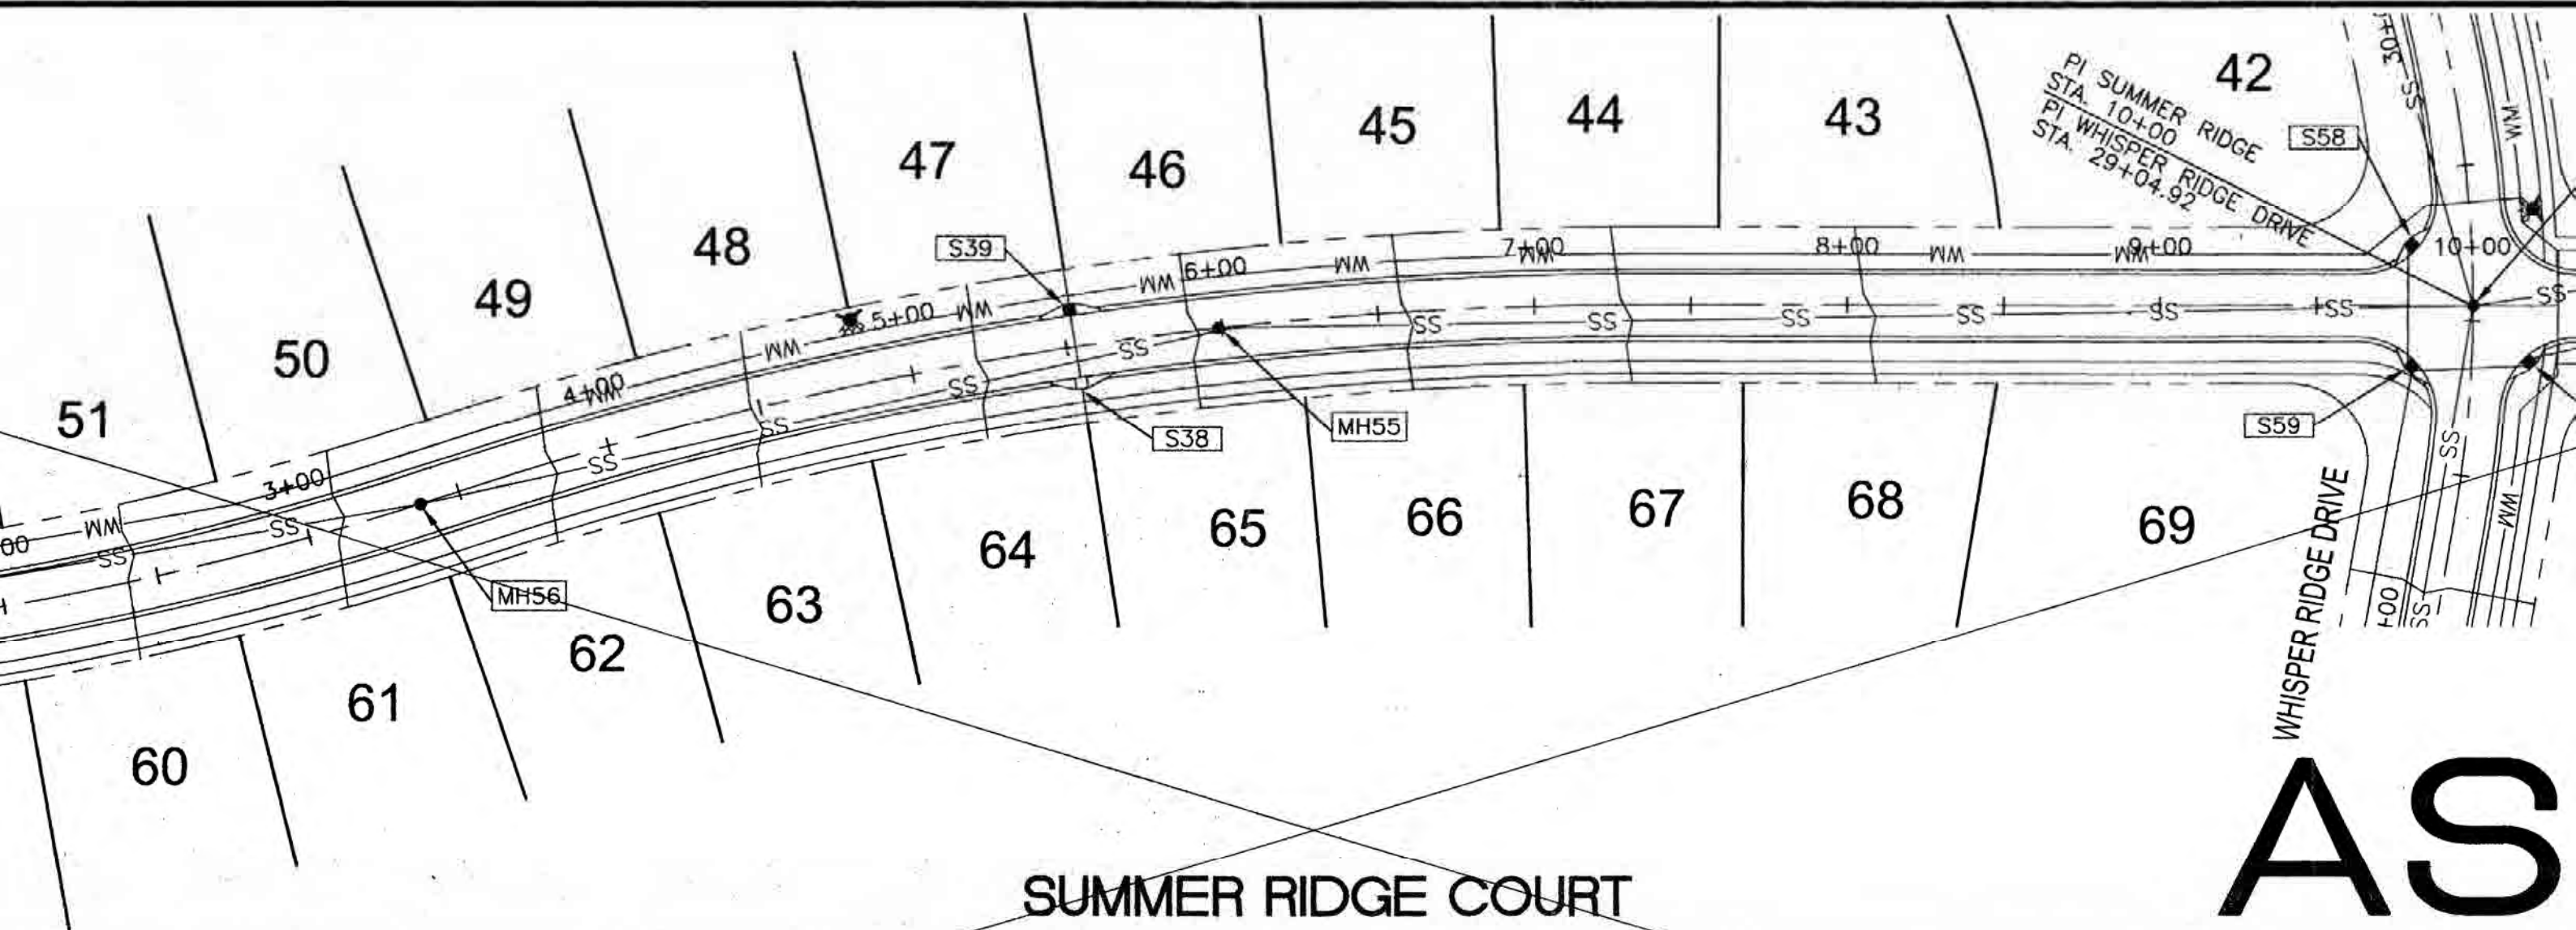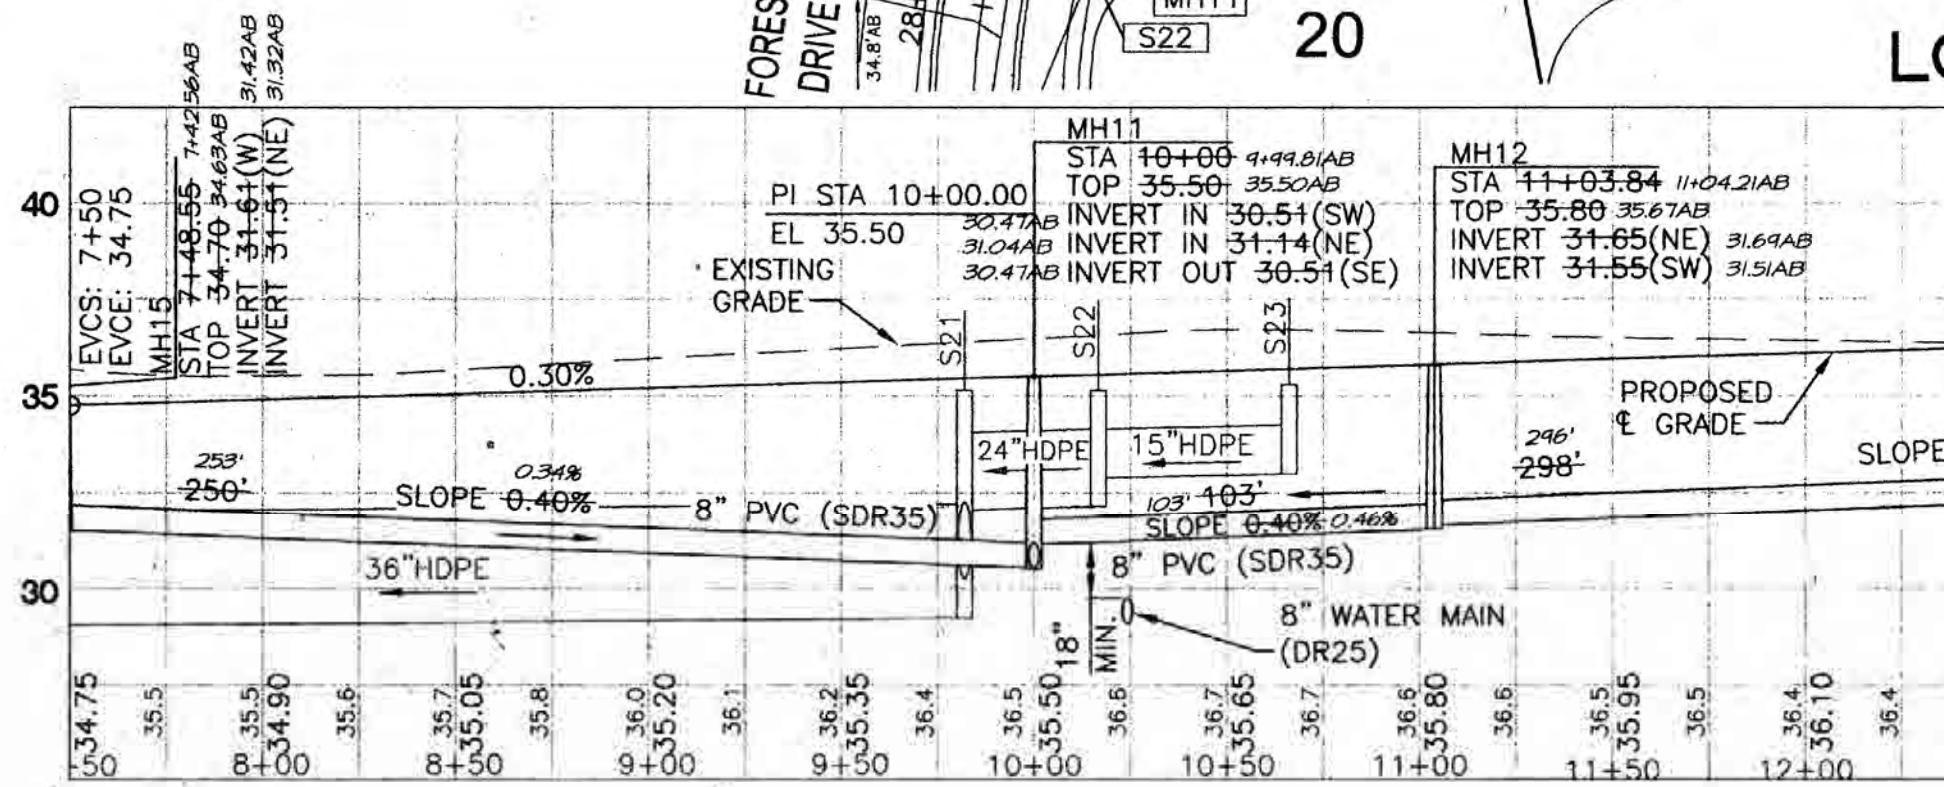

AS

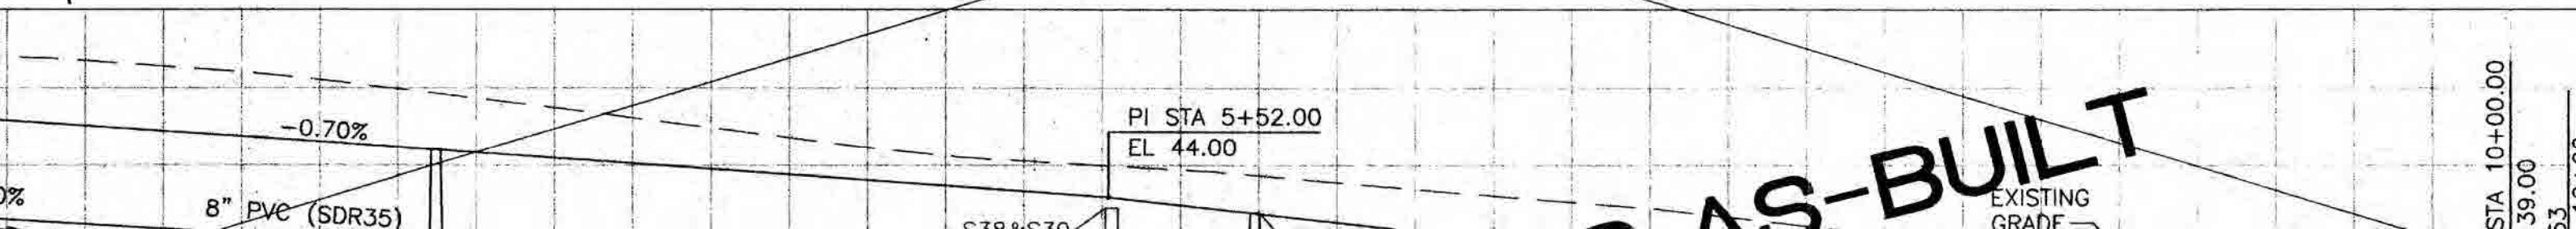

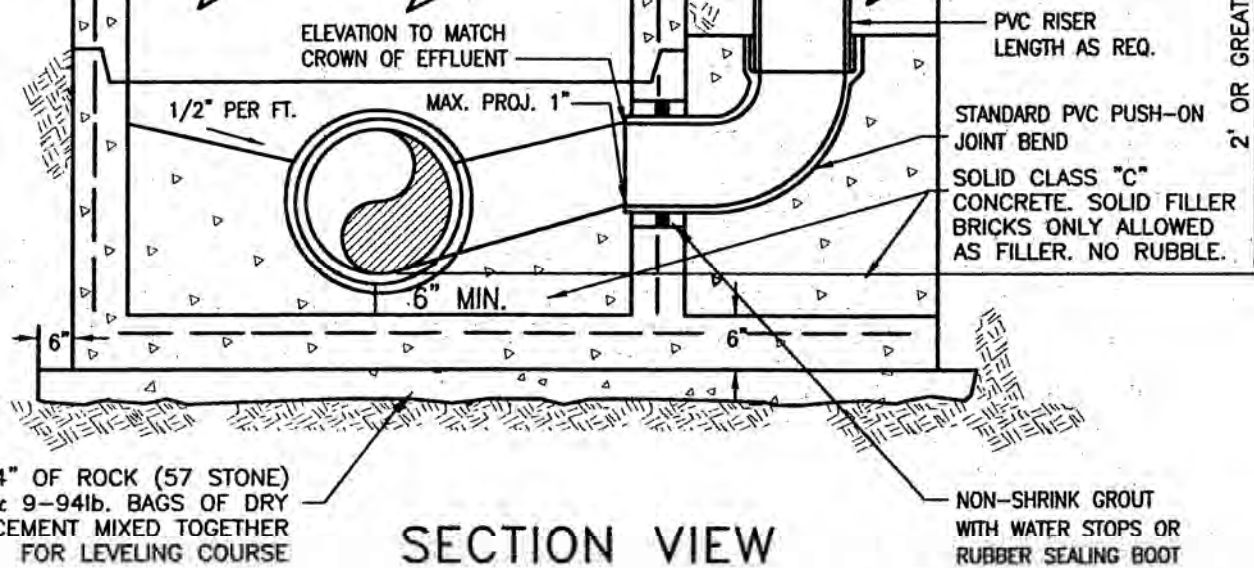


INTERIOR AND EXTERIOR OF MANHOLE AND ADJUSTMENT RINGS SHALL BE GIVEN TWO COATS OF BITUMINOUS WATERPROOFING MATERIAL. DO NOT COAT JOINT OR PIPE OPENING SURFACES. SPECIALTY LINER IS TO BE INSTALLED ON INSIDE OF MANHOLE, BITUMINOUS WATERPROOFING MATERIAL SHALL BE OMITTED ON INTERIOR.

"D" MANHOLE MUST BE USED FOR 2' OR GREATER INFLUENT DROP AND FOR MULTIPLE DROPS. CAST MANHOLE SECTIONS TO BE MANUFACTURED IN ACCORDANCE WITH LATEST EDITIONS OF ASTM C478 4000 LB. CONCRETE, TYPE II CONCRETE.

MANHOLES WITH THREE (3) OR MORE INVERTS ARE REQUIRED TO BE LINED WITH AGRI GRIP OR SPECTRA SHIELD PER S.J.C.U.D. SPECIFICATIONS.

SECTION-STANDARD EXTERIOR DROP MANHOLE (TYPE "D")

CHARLES BASSETT & ASSOCIATES, INC.
SURVEYORS - ENGINEERS - LAND PLANNERS
200 CENTURY 21 DRIVE
JACKSONVILLE, FLORIDA 32216
PHONE (904) 724-9433

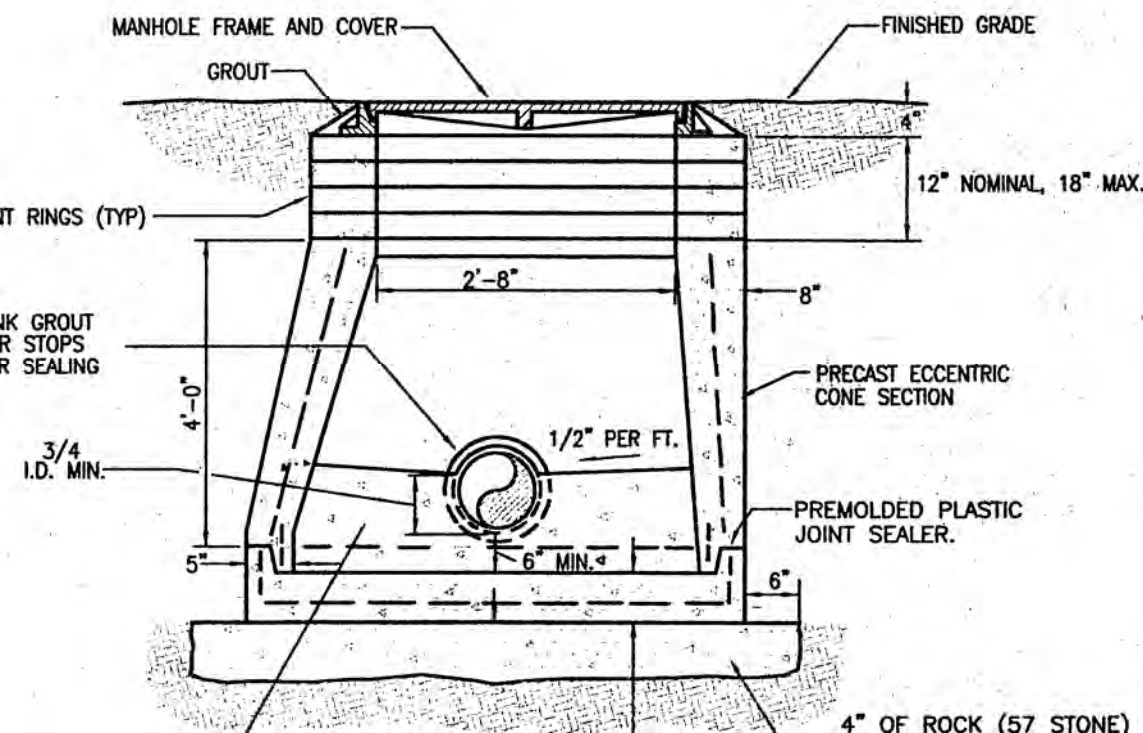

AS BUILT

INFORMATION PROVIDED BY:

NAME: VALLENCOURT CONSTRUCTION CO., INC.
DATE: FEBRUARY 16, 2004
ADDRESS: P.O. BOX 65849
ORANGE PARK, FL 32065
PHONE: (904) 291-9330

I HEREBY CERTIFY THAT THE MATERIALS USED IN THE CONSTRUCTION OF

PAVEMENT	✓	WATER MAIN
CURB & GUTTER	✓	SANITARY GRAVITY SYSTEM
STORM & DRAINAGE SYSTEM	✓	FORCE MAIN
		LIFT STATION


ARE IN ACCORDANCE WITH THE APPROVED PLANS AND CITY SPECIFICATIONS, UNLESS OTHERWISE APPROVED BY THE CITY ENGINEER.

AUTHORIZED SIGNATURE

AS BUILT

INFORMATION PROVIDED BY:


NAME: CHARLES BASSETT & ASSOCIATES, INC.
DATE: FEBRUARY 16, 2004
ADDRESS: 200 CENTURY 21 DRIVE

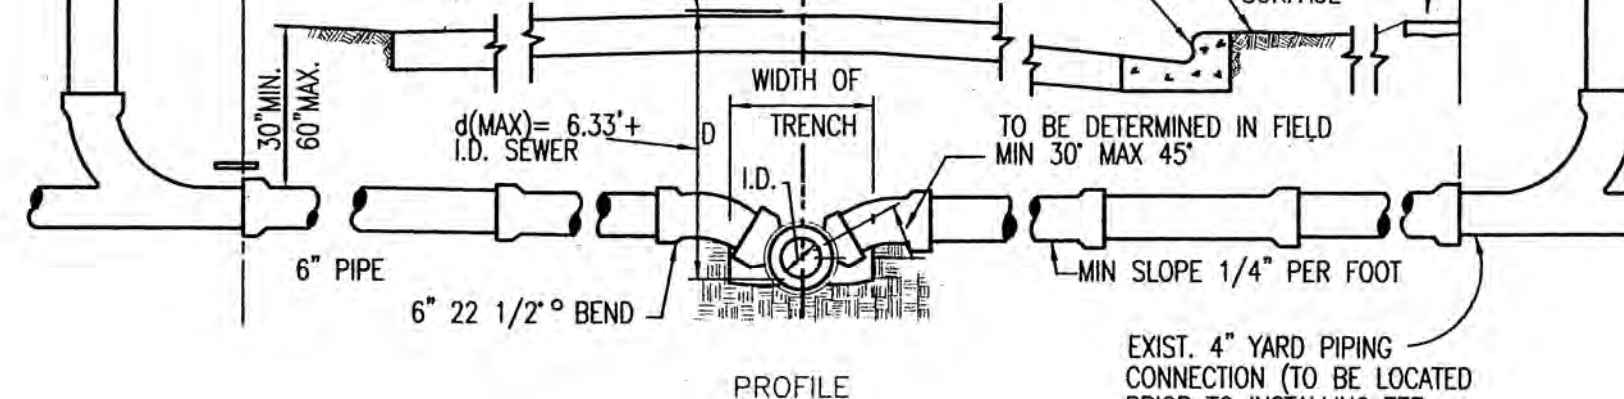

NOTE:


- CLEAN OUTS SHALL BE INSTALLED BY THE UTILITY CONTRACTOR IN ACCORDANCE WITH STANDARD PLUMBING CODE.
- LOCATE SINGLE LATERAL IN THE CENTER OF PROPERTY LOT LINE.
- INVERT OF SERVICE LATERAL SHALL NOT ENTER SEWER MAIN BELOW SPRING LINE.
- DOUBLE WYE SHALL NOT BE USED FOR ST. JOHNS COUNTY UTILITY DEPARTMENT OWNED OR OPERATED SYSTEMS.


SERVICE LATERAL

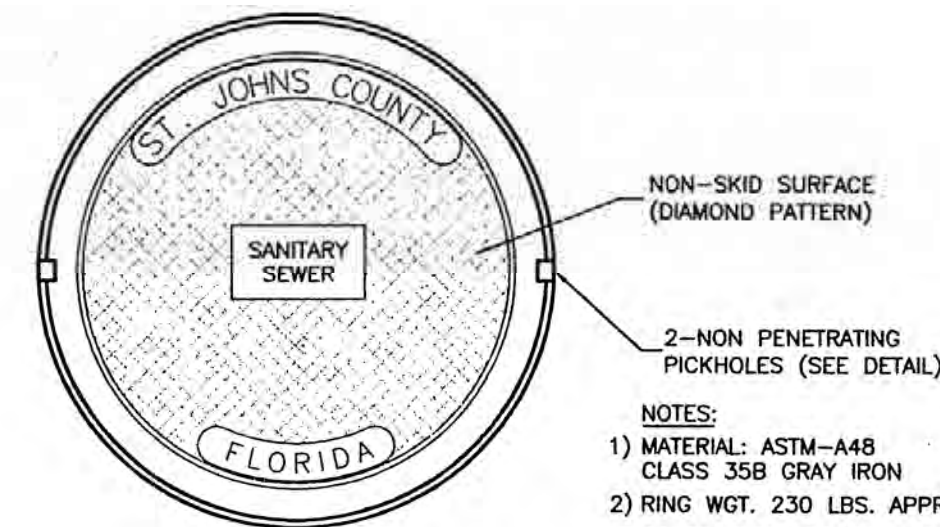

NOTES:

- MATERIAL: ASTM-A48 CLASS 35B GRAY IRON
- RING WGT. 230 LBS. APPROX.
- COVER WGT. 230 LBS. APPROX.
- ALL DIMENSIONS ARE SHOWN IN INCHES

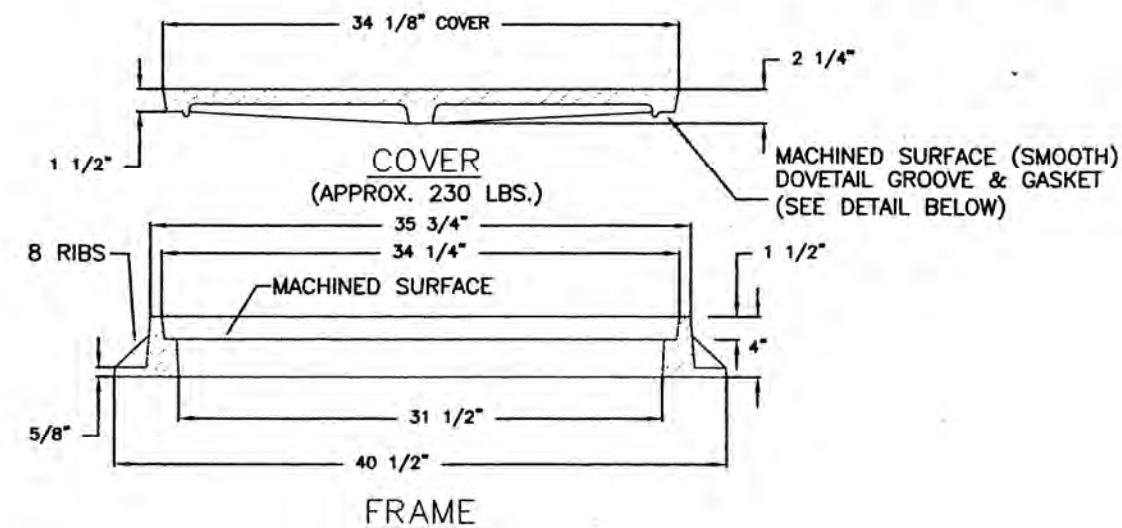

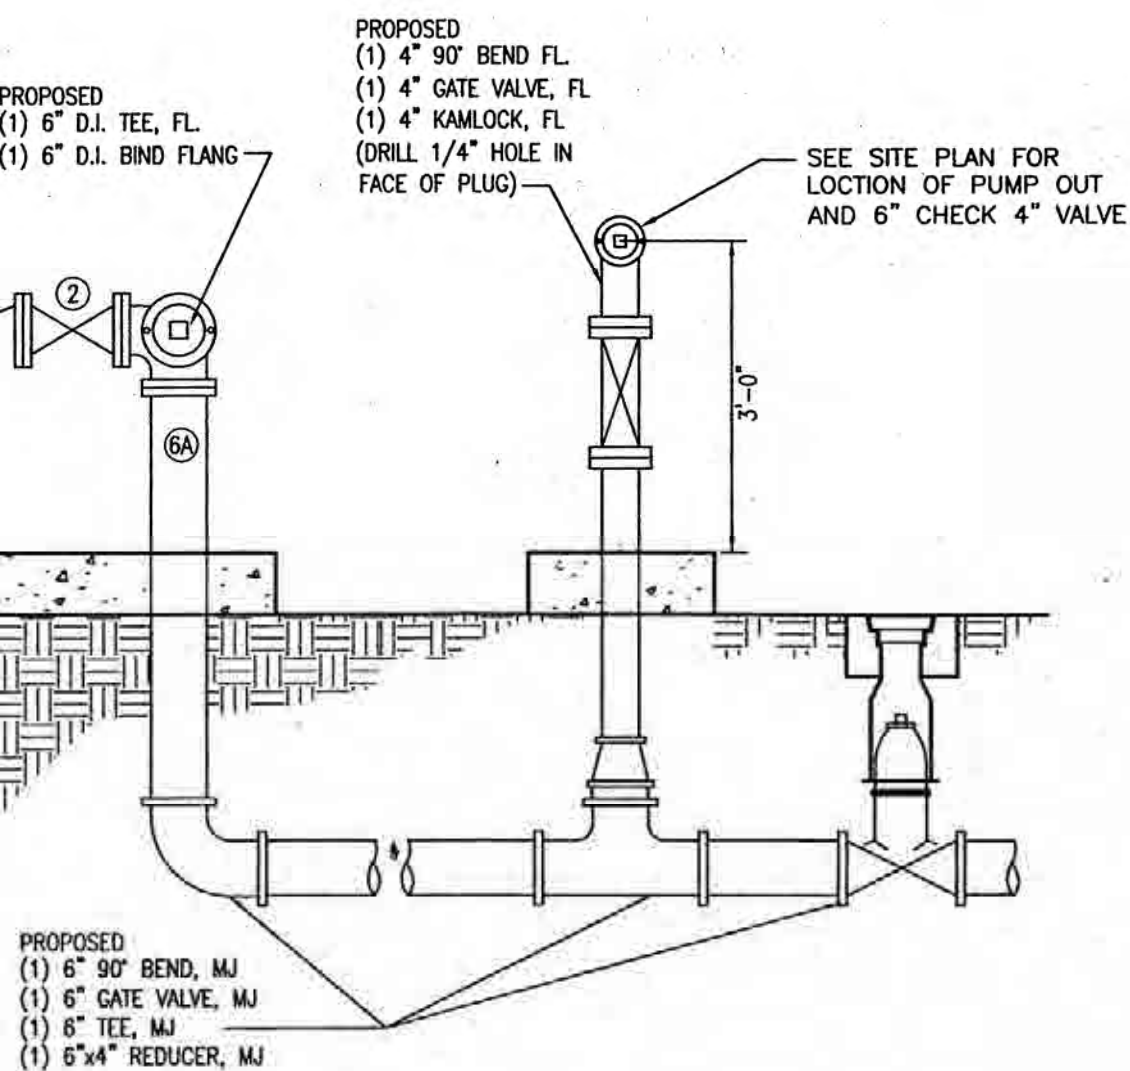

PIPE ROTATED
FOR CLARITY

<h1>AS BUILT</h1>	
INFORMATION PROVIDED BY:	
NAME: <u>VALLENCOURT CONSTRUCTION CO., INC.</u>	
DATE: <u>FEBRUARY 16, 2004</u>	
ADDRESS: <u>P.O. BOX 65849</u>	
<u>ORANGE PARK, FL 32065</u>	
PHONE: <u>(904) 291-9330</u>	
I HEREBY CERTIFY THAT THE MATERIALS USED IN THE CONSTRUCTION OF	
<input type="checkbox"/> PAVEMENT	<input type="checkbox"/> WATER MAIN
<input type="checkbox"/> CURB & GUTTER	<input type="checkbox"/> SANITARY GRAVITY SYSTEM
<input type="checkbox"/> STORM & DRAINAGE SYSTEM	<input type="checkbox"/> FORCE MAIN
	<input checked="" type="checkbox"/> LIFT STATION
ARE IN ACCORDANCE WITH THE APPROVED PLANS AND CITY SPECIFICATIONS, UNLESS OTHERWISE APPROVED BY THE CITY ENGINEER.	
AUTHORIZED SIGNATURE <u>[Signature]</u>	

<h1>AS BUILT</h1>	
INFORMATION PROVIDED BY:	
NAME: <u>CHARLES BASSETT & ASSOCIATES, INC.</u>	
DATE: <u>FEBRUARY 16, 2004</u>	

WETWELL SPECIFICATIONS

THE INTERIOR OF THE WET WELL SHALL BE COATED WITH SPECTRASHIELD. THE SURFACE OF THE EXISTING WET WELL SHALL FIRST BE PREPARED BY GROUTING THE WELL AS REQUIRED TO OBTAIN A SMOOTH SURFACE.

STATION 1 MECHANICAL EQUIPMENT SCHEDULE

1. 6" CHECK VALVE, MUELLER OR M&H SWING-TYPE, LEVER & SPRING OPERATED, IRON BODY, BRONZE MOUNTED
2. 6" PLUG VALVE, DEZURIK, CAST IRON BODY, LEVER ACTUATED
- 2A. PRESSURE SENSOR, RED VALVE, SERIES 40, STAINLESS STEEL 304 BODY FLANGES & VITON SENSING SLEEVE
3. 6" STAINLESS STEEL 316L TEE
4. 6" STAINLESS STEEL SHORT RADIUS 90° BEND
5. 6" STAINLESS STEEL 45° BEND
6. 6" STAINLESS STEEL PIPE
- 6A. 6" DUCTILE IRON PIPE
7. 6" STAINLESS STEEL PUMP BASE
8. 8" INFLUENT PIPE, SDR-18 PVC
9. 6' DIAMETER PRECAST CONCRETE WETWELL, MINIMUM WALL THICKNESS 7" (ASTM C-478)
10. FLYGT PUMP MODEL NO. C-3152, IMPELLER NO. 454, HP 20, 1750 RPM. 3 PHASE, 230 VOLTS (AS APPROVED BY ST. JOHNS COUNTY UTILITY DEPT.)
11. ALUMINUM WETWELL ACCESS COVER WITH A " x " CLEAR DIMENSION AND RECESSED LOCK. MODEL NO. (H-20 LOADING)
12. STAINLESS STEEL GUIDE RAILS
13. LEVEL TRANSDUCER PROVIDED BY PUMP MANUFACTURE
14. PUMP MOTOR CABLE
15. 4" SCHEDULE 80 PVC AIR VENT WITH PROTECTIVE SCREEN
16. STAINLESS STEEL CABLE HOLDER
17. (2) EMERGENCY HIGH LEVEL LIQUID LEVEL SENSORS (ROTO FLOATS TYPE S NO. SPST 120V AC 125 V.A. DIRECT ACTING SUSPENDED)
18. 12" BOTTOM SLAB OVER HANG
19. 12" BOTTOM SLAB THICKNESS

BYPASS LINE:

20. 4" - 90° BEND STAINLESS STEEL
21. 4" - 45° BEND STAINLESS STEEL
22. 4" SCHEDULE 80 STAINLESS STEEL PIPE, LENGTH VARIES.

STATION 2 MECHANICAL EQUIPMENT SCHEDULE

1. 6" CHECK VALVE, MUELLER OR M&H SWING-TYPE, LEVER & SPRING OPERATED, IRON BODY, BRONZE MOUNTED
2. 6" PLUG VALVE, DEZURIK, CAST IRON BODY, LEVER ACTUATED
- 2A. PRESSURE SENSOR, RED VALVE, SERIES 40, STAINLESS STEEL 304 BODY FLANGES & VITON SENSING SLEEVE
3. 6" STAINLESS STEEL 316L TEE
4. 6" STAINLESS STEEL SHORT RADIUS 90° BEND
5. 6" STAINLESS STEEL 45° BEND
6. 6" STAINLESS STEEL PIPE
- 6A. 6" DUCTILE IRON PIPE
7. 6" STAINLESS STEEL PUMP BASE
8. 8" INFLUENT PIPE, SDR-18 PVC
9. 6' DIAMETER PRECAST CONCRETE WETWELL, MINIMUM WALL THICKNESS 7" (ASTM C-478)
10. FLYGT PUMP MODEL NO. C-3152, IMPELLER NO. 454, HP 20, 1750 RPM. 3 PHASE, 230 VOLTS (AS APPROVED BY ST. JOHNS COUNTY UTILITY DEPT.)
11. ALUMINUM WETWELL ACCESS COVER WITH A " x " CLEAR DIMENSION AND RECESSED LOCK. MODEL NO. (H-20 LOADING)
12. STAINLESS STEEL GUIDE RAILS
13. LEVEL TRANSDUCER PROVIDED BY PUMP MANUFACTURE
14. PUMP MOTOR CABLE
15. 4" SCHEDULE 80 PVC AIR VENT WITH PROTECTIVE SCREEN
16. STAINLESS STEEL CABLE HOLDER
17. (2) EMERGENCY HIGH LEVEL LIQUID LEVEL SENSORS (ROTO FLOATS TYPE S NO. SPST 120V AC 125 V.A. DIRECT ACTING SUSPENDED)
18. 12" BOTTOM SLAB OVER HANG
19. 12" BOTTOM SLAB THICKNESS

BYPASS LINE:

20. 4" - 90° BEND STAINLESS STEEL
21. 4" - 45° BEND STAINLESS STEEL
22. 4" SCHEDULE 80 STAINLESS STEEL PIPE, LENGTH VARIES.

2005 MWS Jehovahs Witness State Road 16 Water-Sewer As Built Drawings




*AS-BUILT SURVEY FOR
NORTH CONGREGATION OF JEHOVAH'S WITNESS*


2006 MWS Calvary Baptist Church

Water-Sewer

As Built Drawings



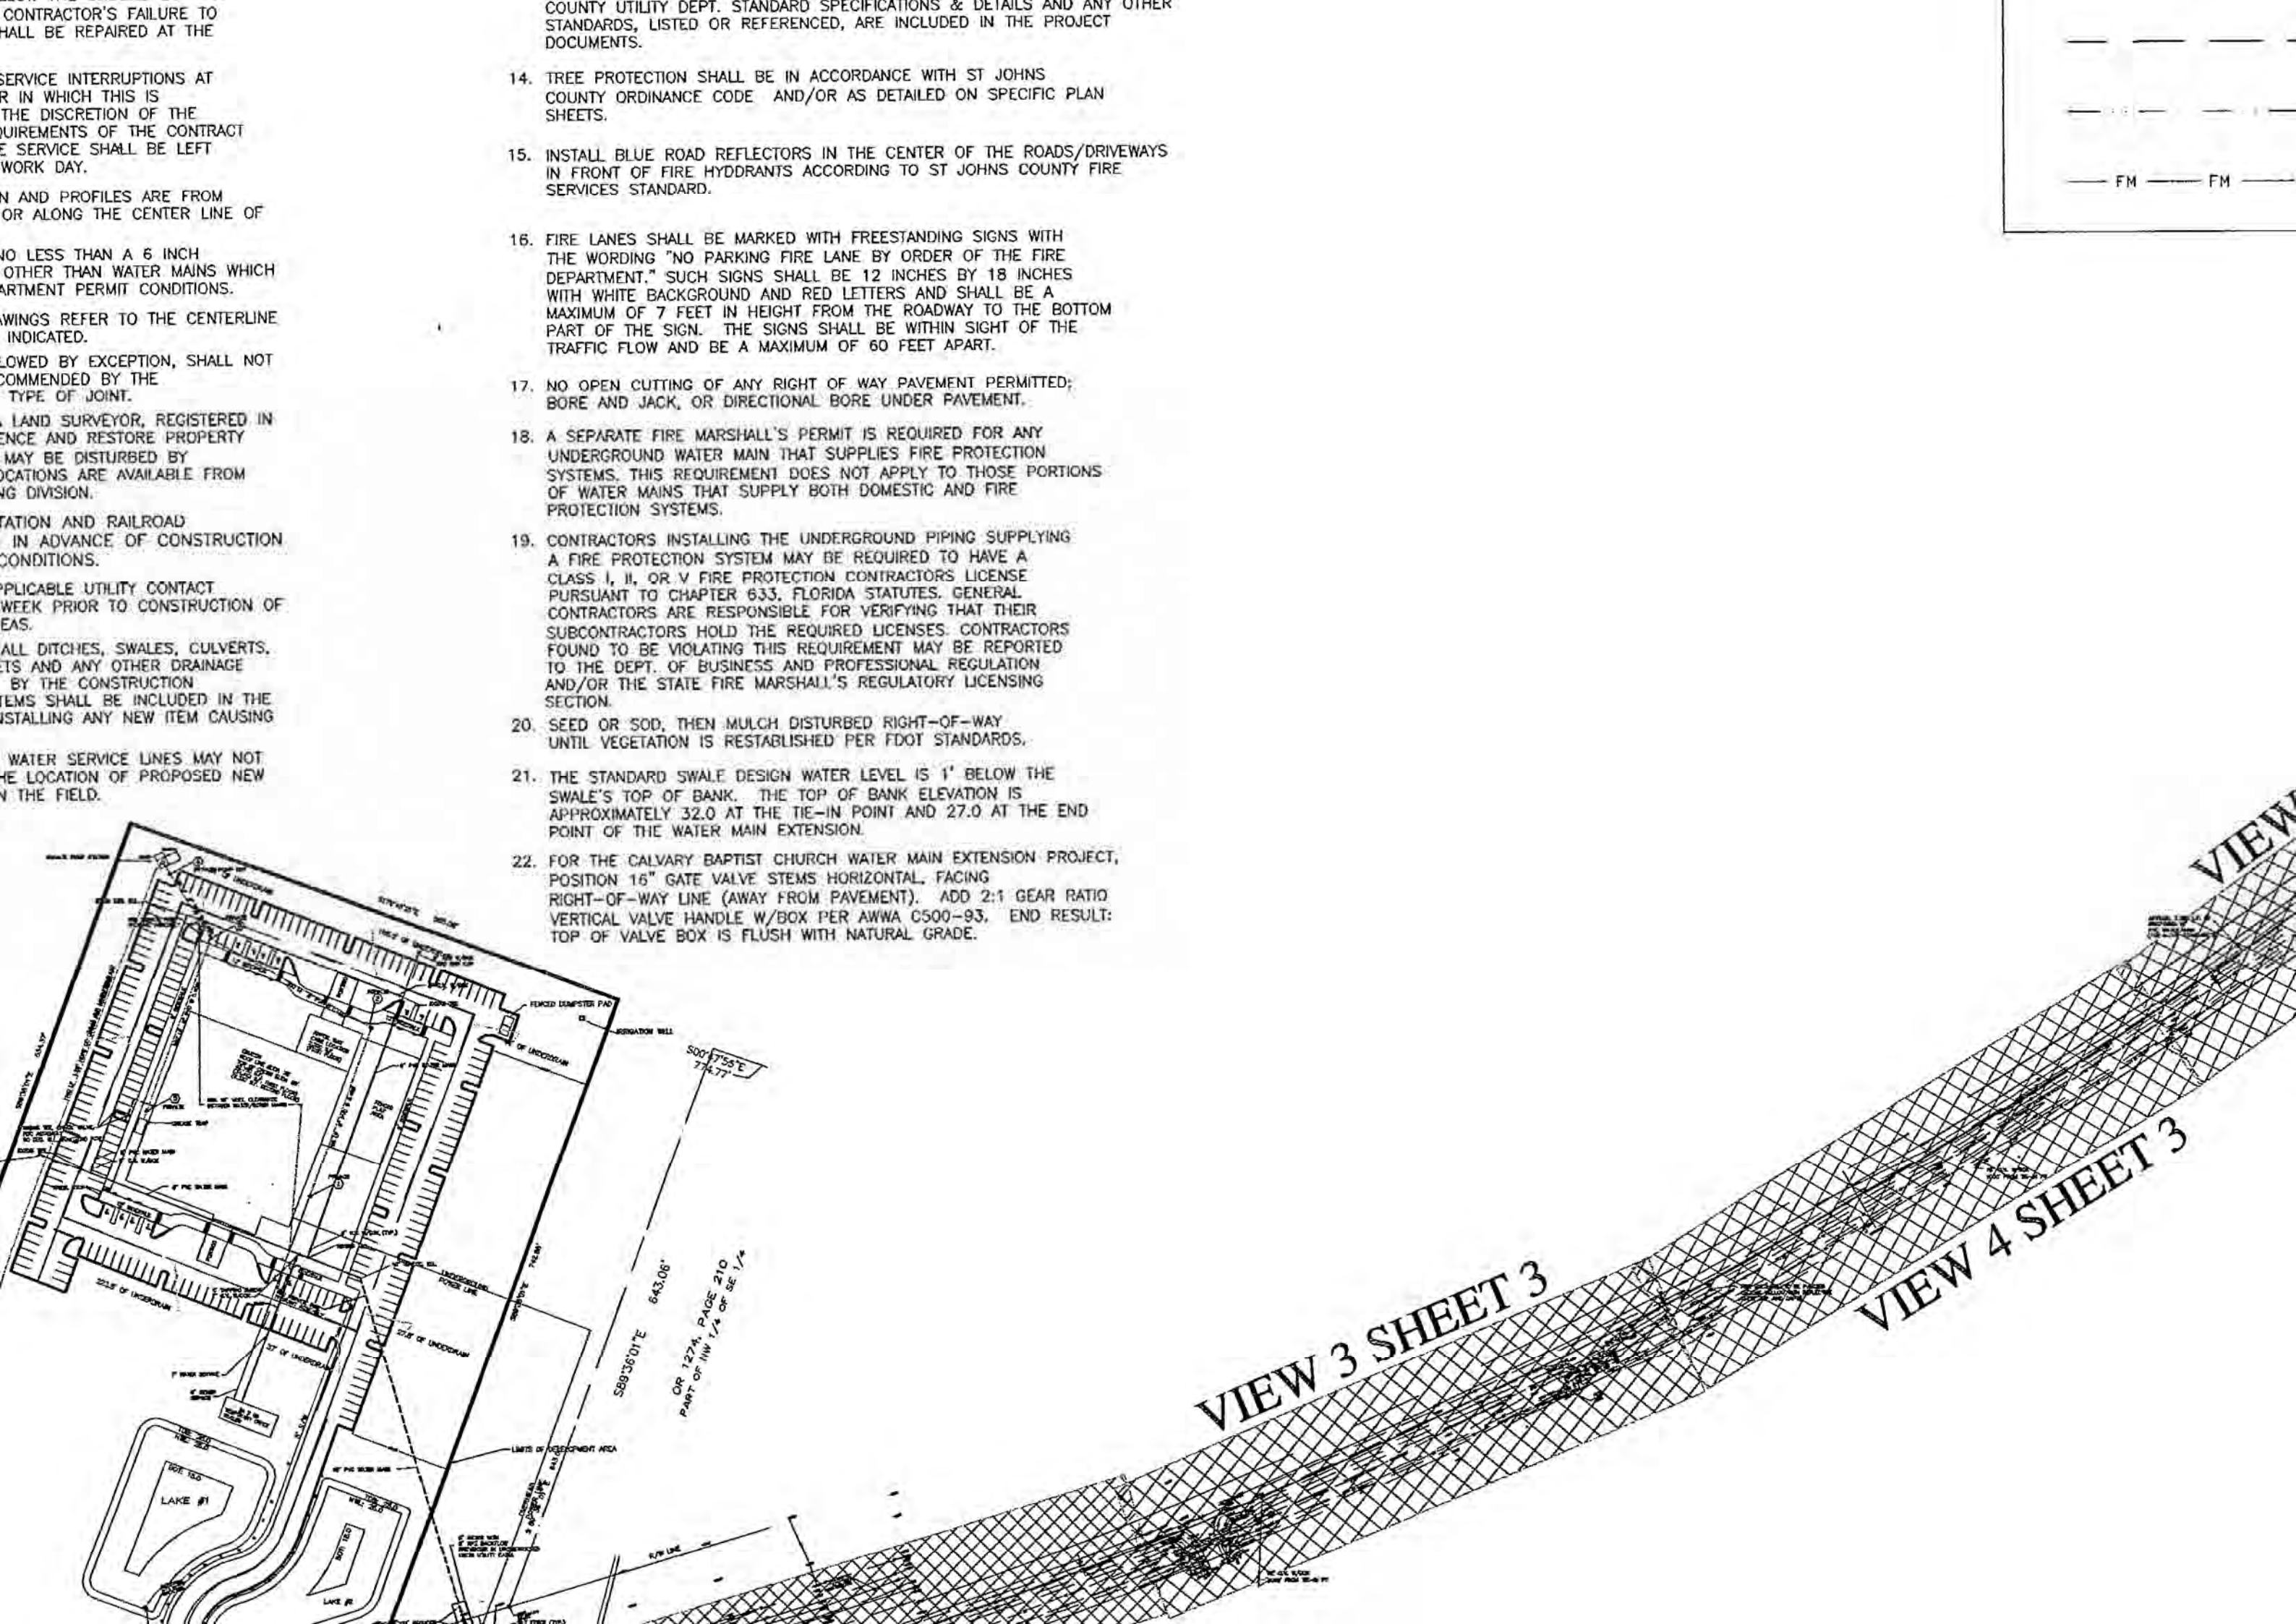

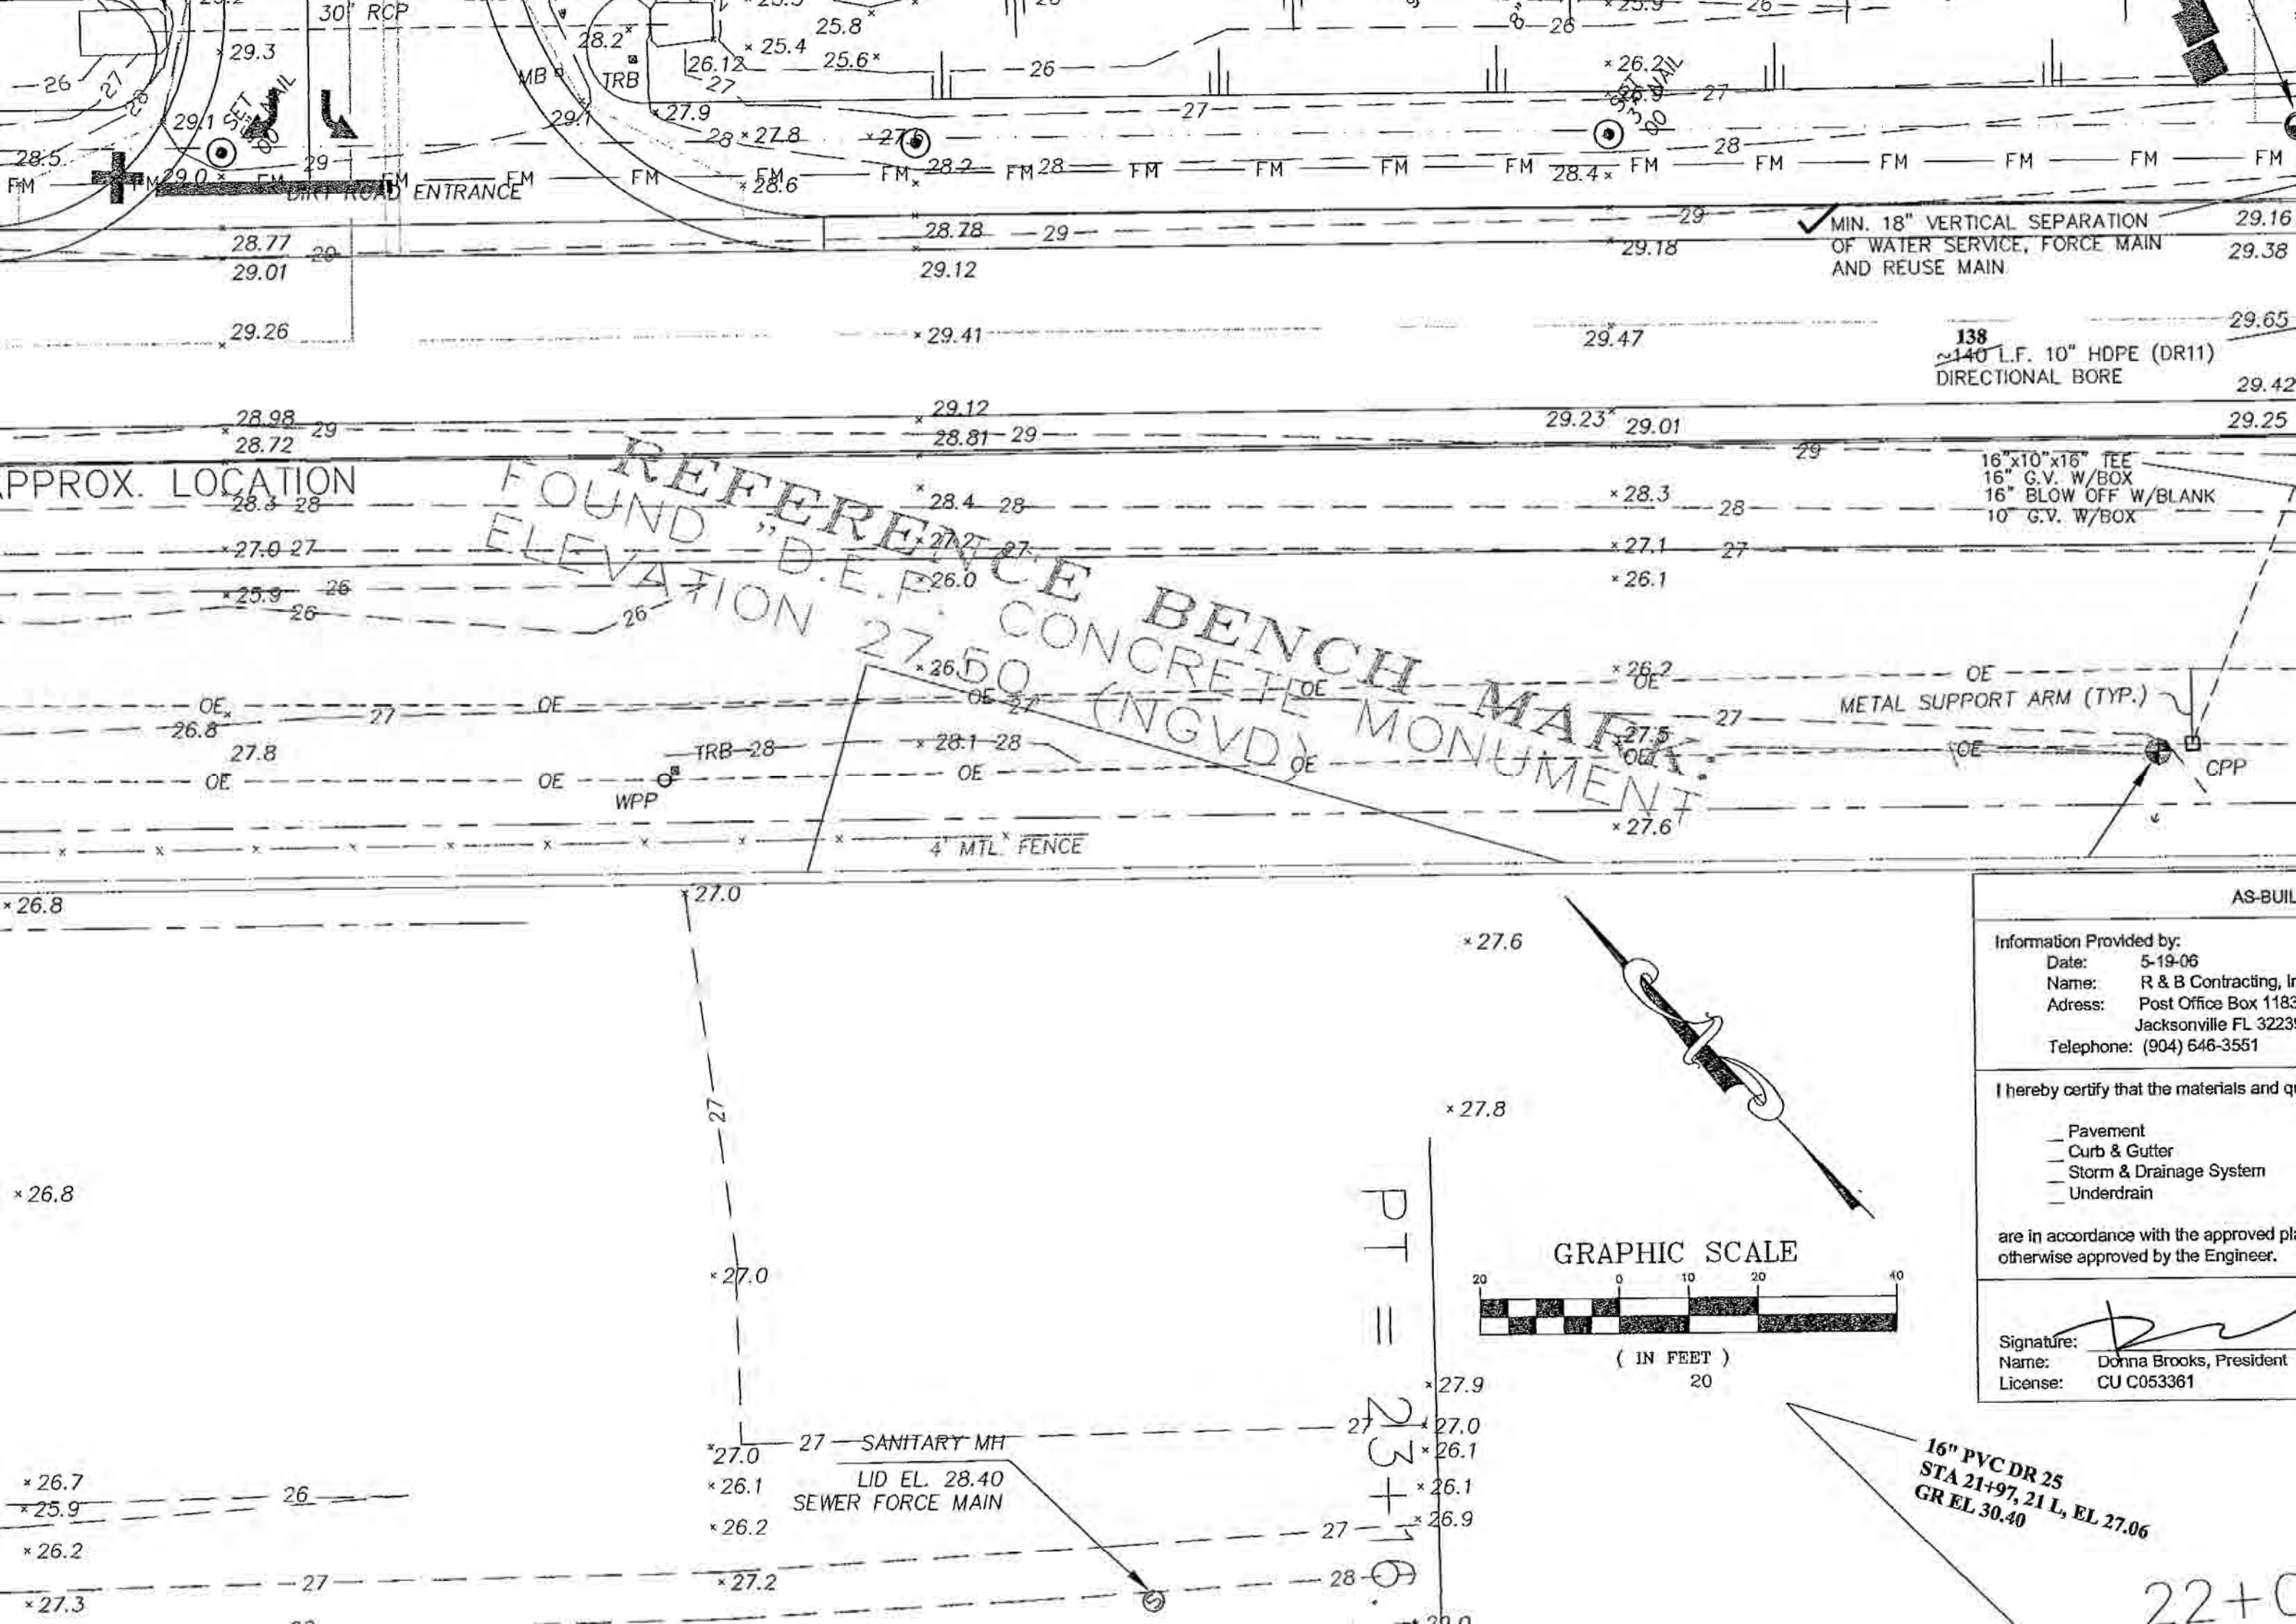

APPROX. LOCATION

REFERENCE FOUND "D.E.P." ELEVATION 27.50 (NGVD) CONCRETE BENCH MARK MONUMENT

MIN. 18" VERTICAL SEPARATION OF WATER SERVICE, FORCE MAIN AND REUSE MAIN

138 ~140 L.F. 10" HDPE (DR11) DIRECTIONAL BORE

16"x10"x16" TEE 16" G.V. W/BOX 16" BLOW OFF W/BLANK 10" G.V. W/BOX

METAL SUPPORT ARM (TYP.)

CPP

4" MTL FENCE

GRAPHIC SCALE

(IN FEET)

Information Provided by:

Date: 5-19-06

Name: R & B Contracting, Inc.

Address: Post Office Box 1183

Jacksonville FL 32233

Telephone: (904) 646-3551

I hereby certify that the materials and workmanship are in accordance with the approved plans and specifications, or otherwise approved by the Engineer.

Signature:

Name: Donna Brooks, President

License: CU C053361

16" PVC DR 25 STA 21+97, 21 L, EL 27.06 GR EL 30.40

22+0

and state and
flash the alarm
ately 60 flashes per

called on the

apacitor. A
apacitor shall be
connected to the
restor shall meet
ANSI/IEEE Std.
.3. Surge
required condition.

third float shall
fourth float shall



ttable elapsed time
deadfront to

device for
on either loss of


h a 30 degree panel
er shall be supplied
urer - Russell Stoll
a disconnect and
used in lieu of the

he pump wet well base,
n to the requirements of
ion for Precast Reinforced
Cement shall meet the
test, Specification for
ed at 4,000 P.S.I. Minimum.
be 1/12 the inside diameter

be cast integrally with
The base section shall be
rse of 2500 P.S.I. concrete
red subgrade. In order to
ton section and insure full
se, the section shall be
set of the concrete leveling

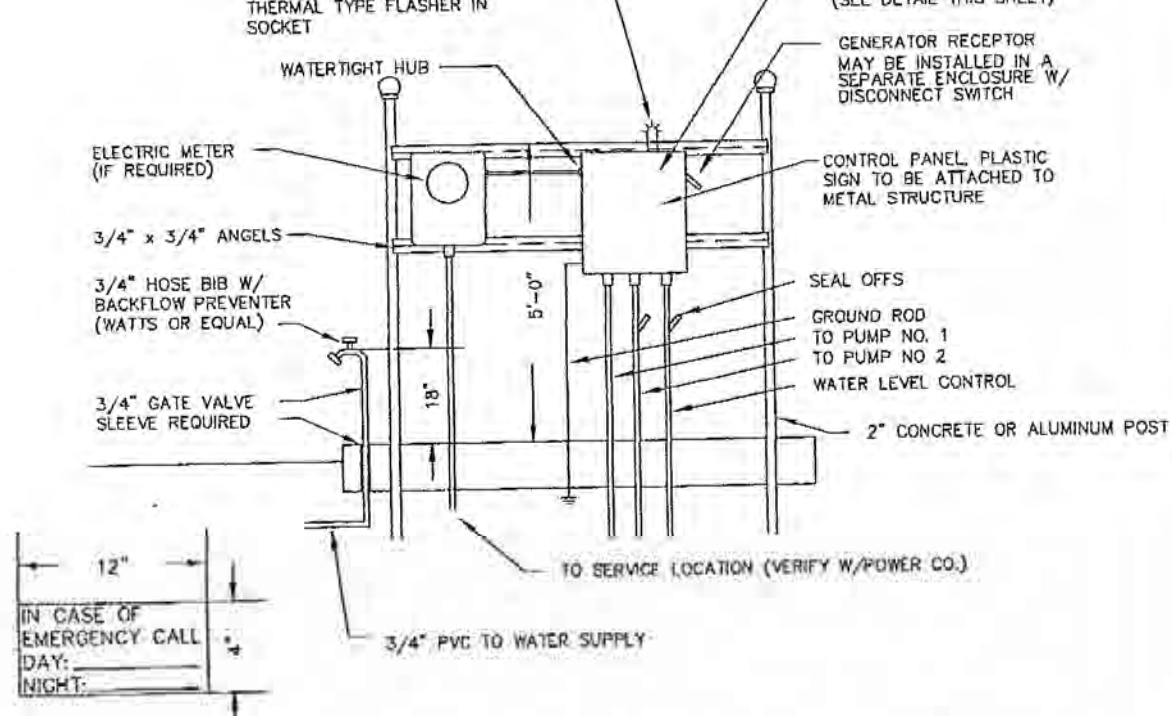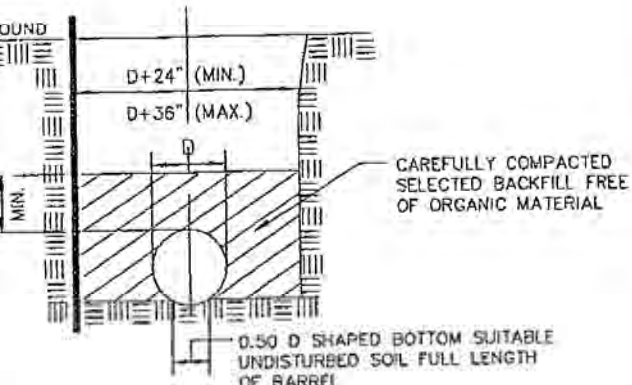

PANEL/METER PEDESTAL DETAIL

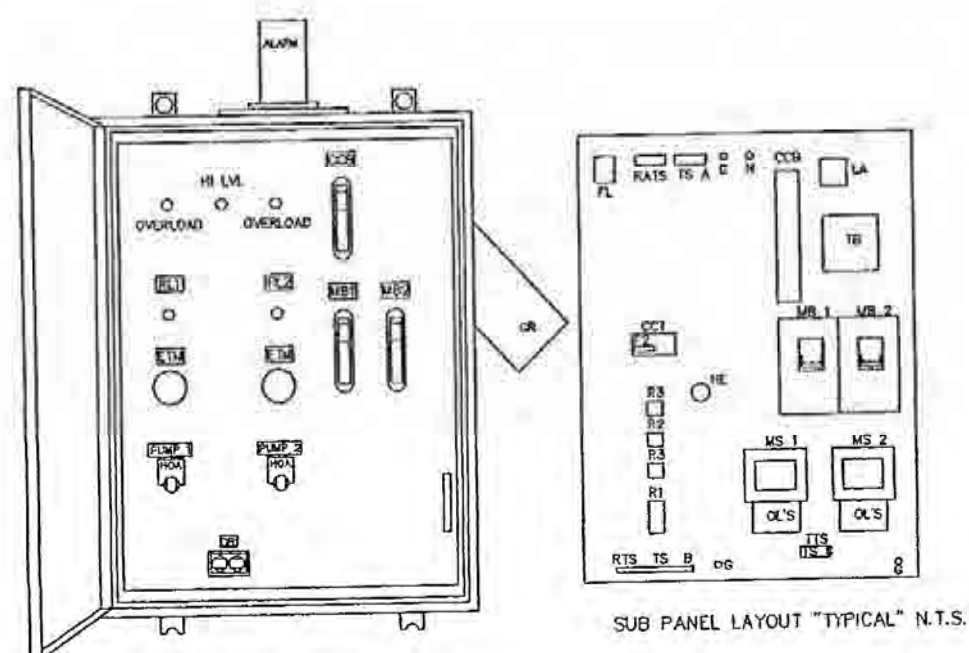


DEAD FRONT LAYOUT "TYPICAL" N.T.S.
ENCLOSURE - N.E.M.A. 3R FIBERGLASS
W/ PADLOCKABLE LATCHED COVER

SUB PANEL LAYOUT "TYPICAL" N.T.S.

CCB	CONTROL CIRCUIT BREAKER	SPM	SINGLE PHASE MODULE
DRB	DUPLEX RECEPTACLE BREAKER	PTS	PUMP TERMINAL STRIP
MB	MOTOR BREAKER	MCB	MAIN CIRCUIT BREAKER
MS	MOTOR STARTER	GR	GENERATOR RECEPTACLE
RL	PUMP RUN INDICATORS	ETM	ELAPSED TIME METER
PL	LEVEL INDICATORS	AB	ALARM BELL
OL	OVERLOAD HEATERS	ASB	ALARM BELL SILENCER
HOA	HAND-OFF-AUTOMATIC SELECTOR	LA	LIGHTNING ARRESTOR
DR	DUPLEX RECEPTACLE	SPM	SINGLE PHASE MODULE
NEUT	NEUTRAL	SC	START CAPACITOR (10)
PAA	PUMP AUTOMATIC ALTERNATOR	RC	RUN CAPACITOR (10)
ATS	ALTERNATOR TEST SWITCH	SR	START RELAY
R	RELAYS	ST	STARTER TERMINAL
CT	CONTROL TRANSFORMER	PTS	PUMP TERMINAL STRIP
GRD	GROUND	RD	DISCHARGE RESISTOR
F	FUSE	ECB	EMERGENCY CIRCUIT BREAKER
RTS	REGULATOR TERMINAL STRIP	VM	VOLTAGE MONITOR
FR	FLOAT REGULATOR	SA	SURGE CAPACITOR


DUPLEX PUMP CONTROL PANEL

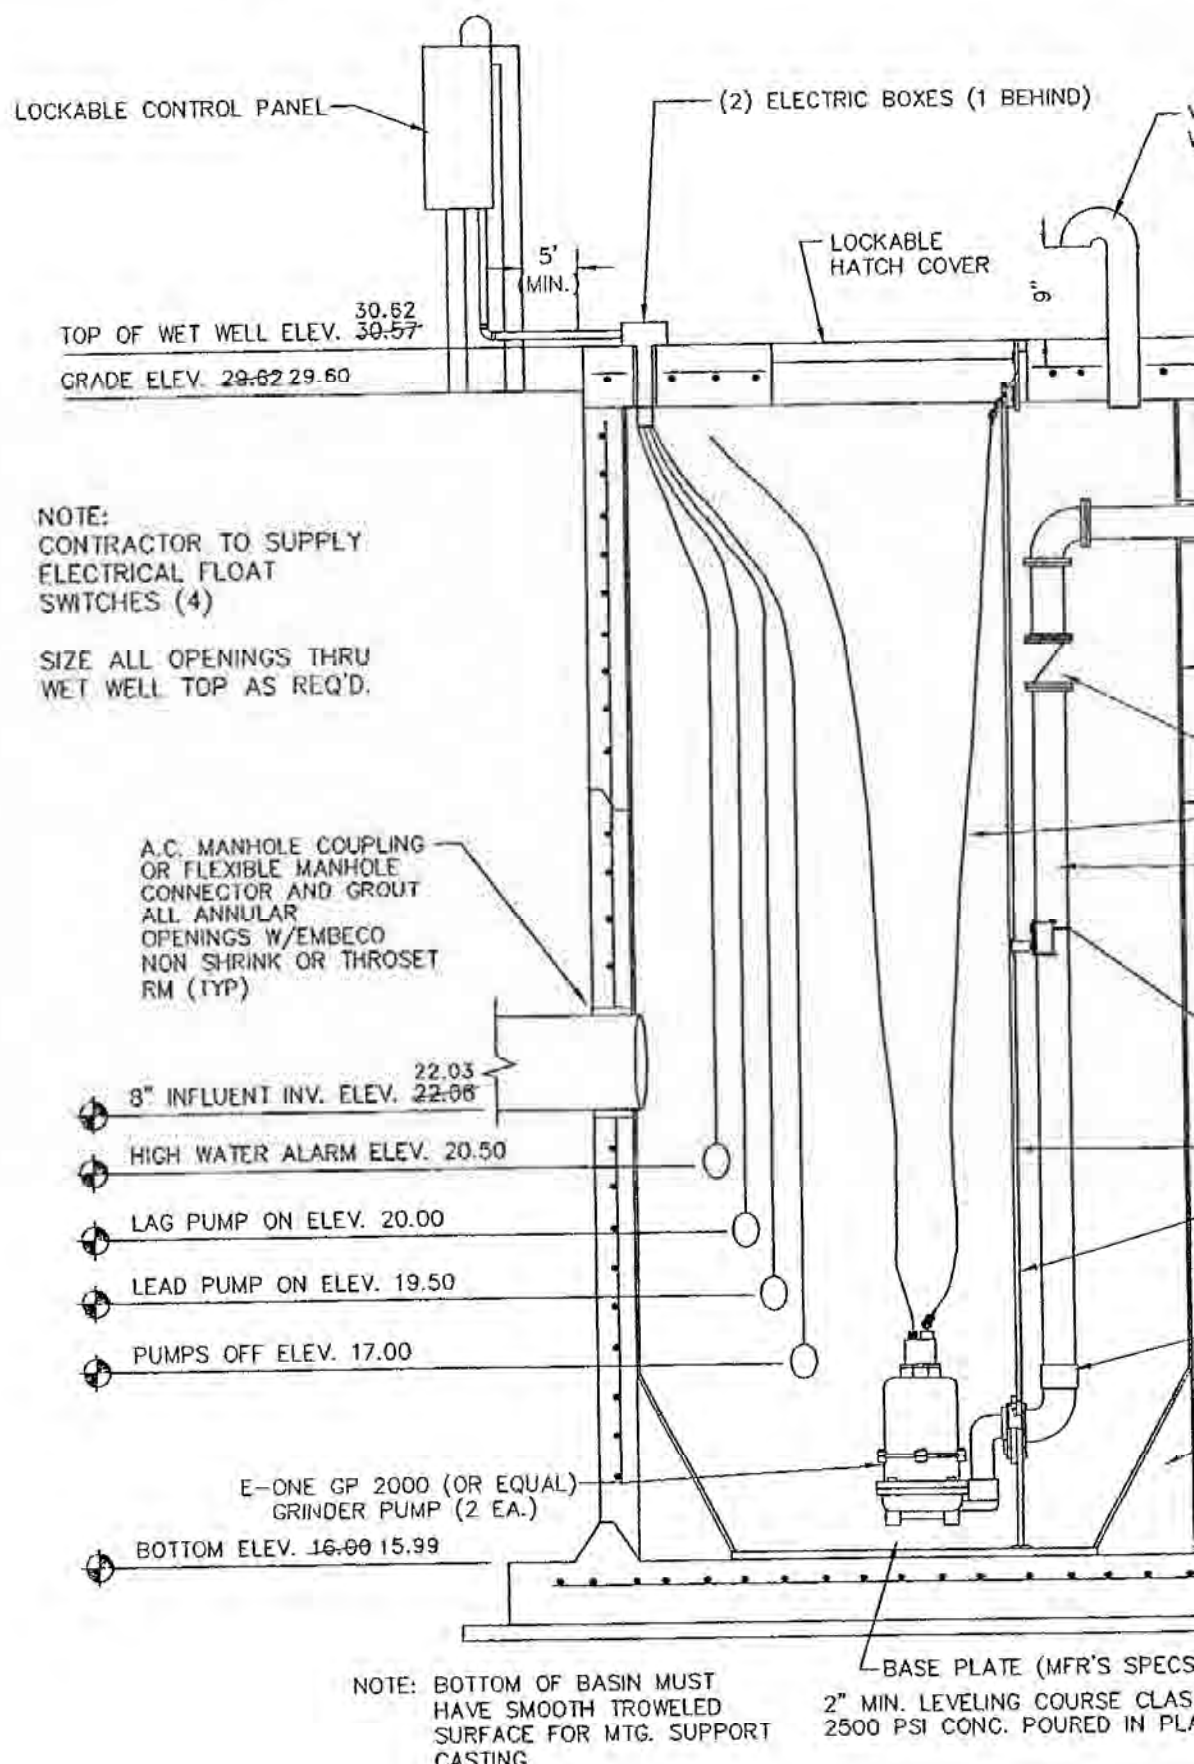


CONCRETE DUPLEX SUBMERSIBLE


2006 Sevilla Phase 2 As Built Drawings



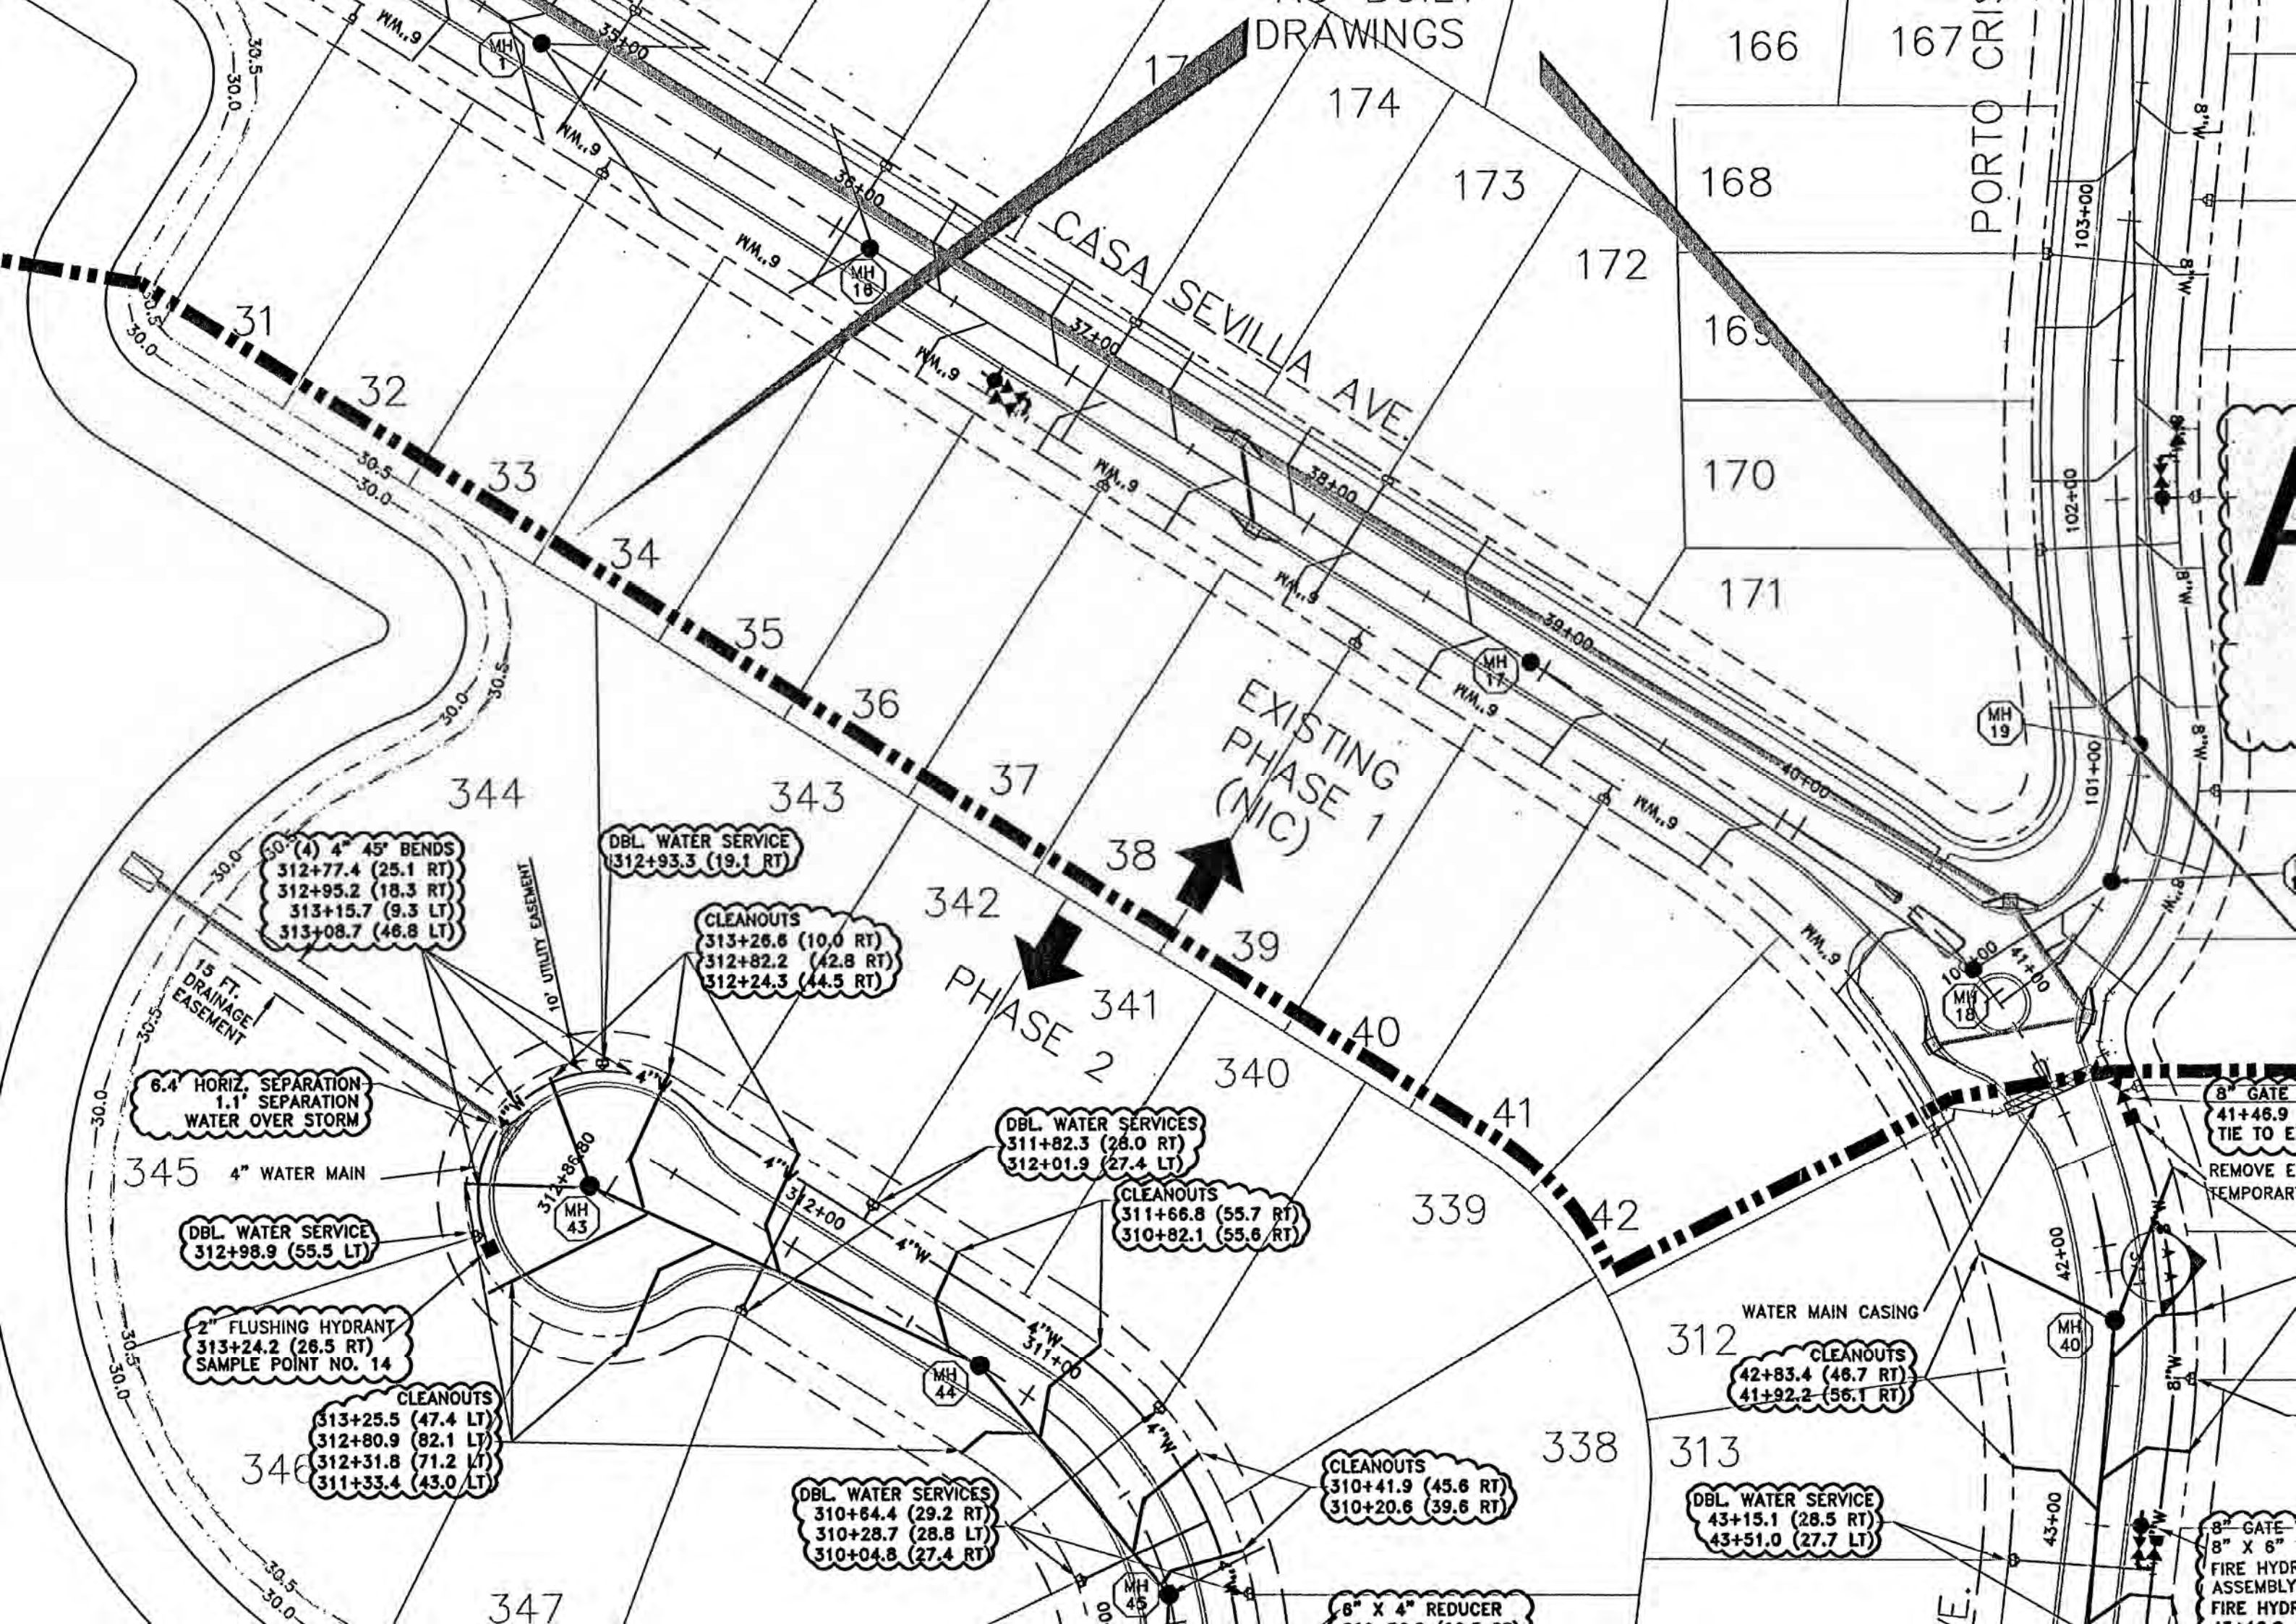




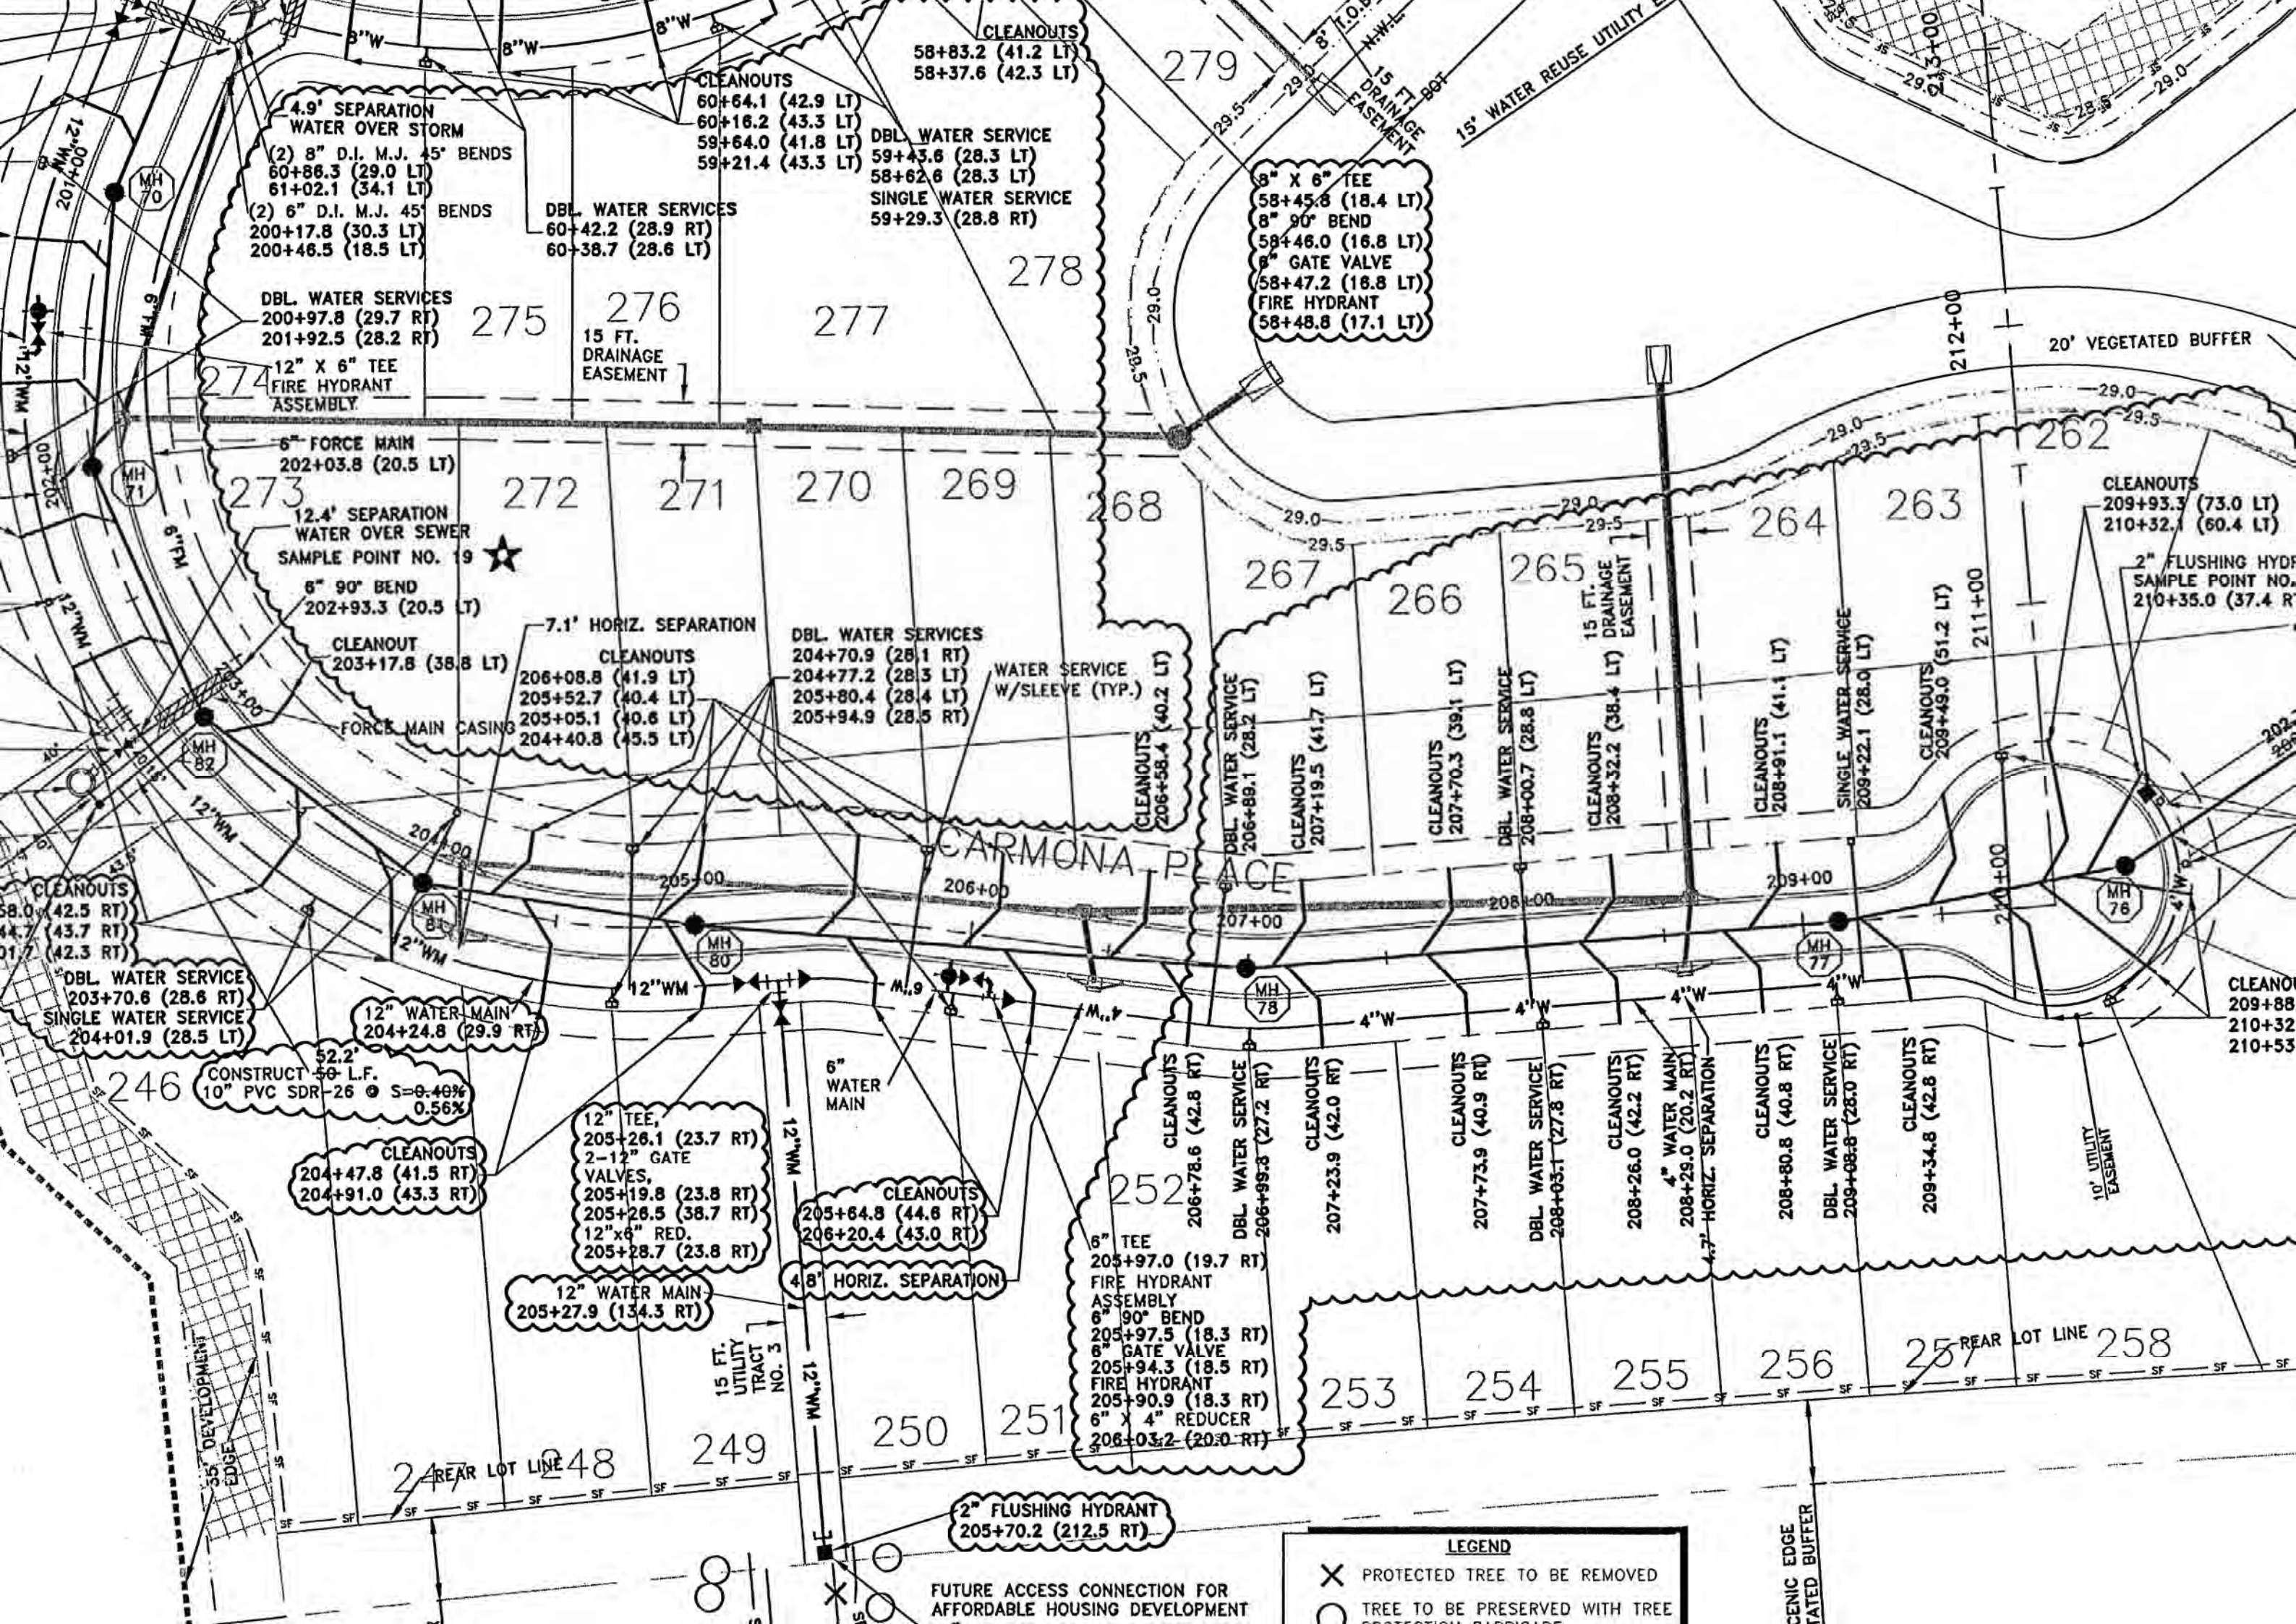

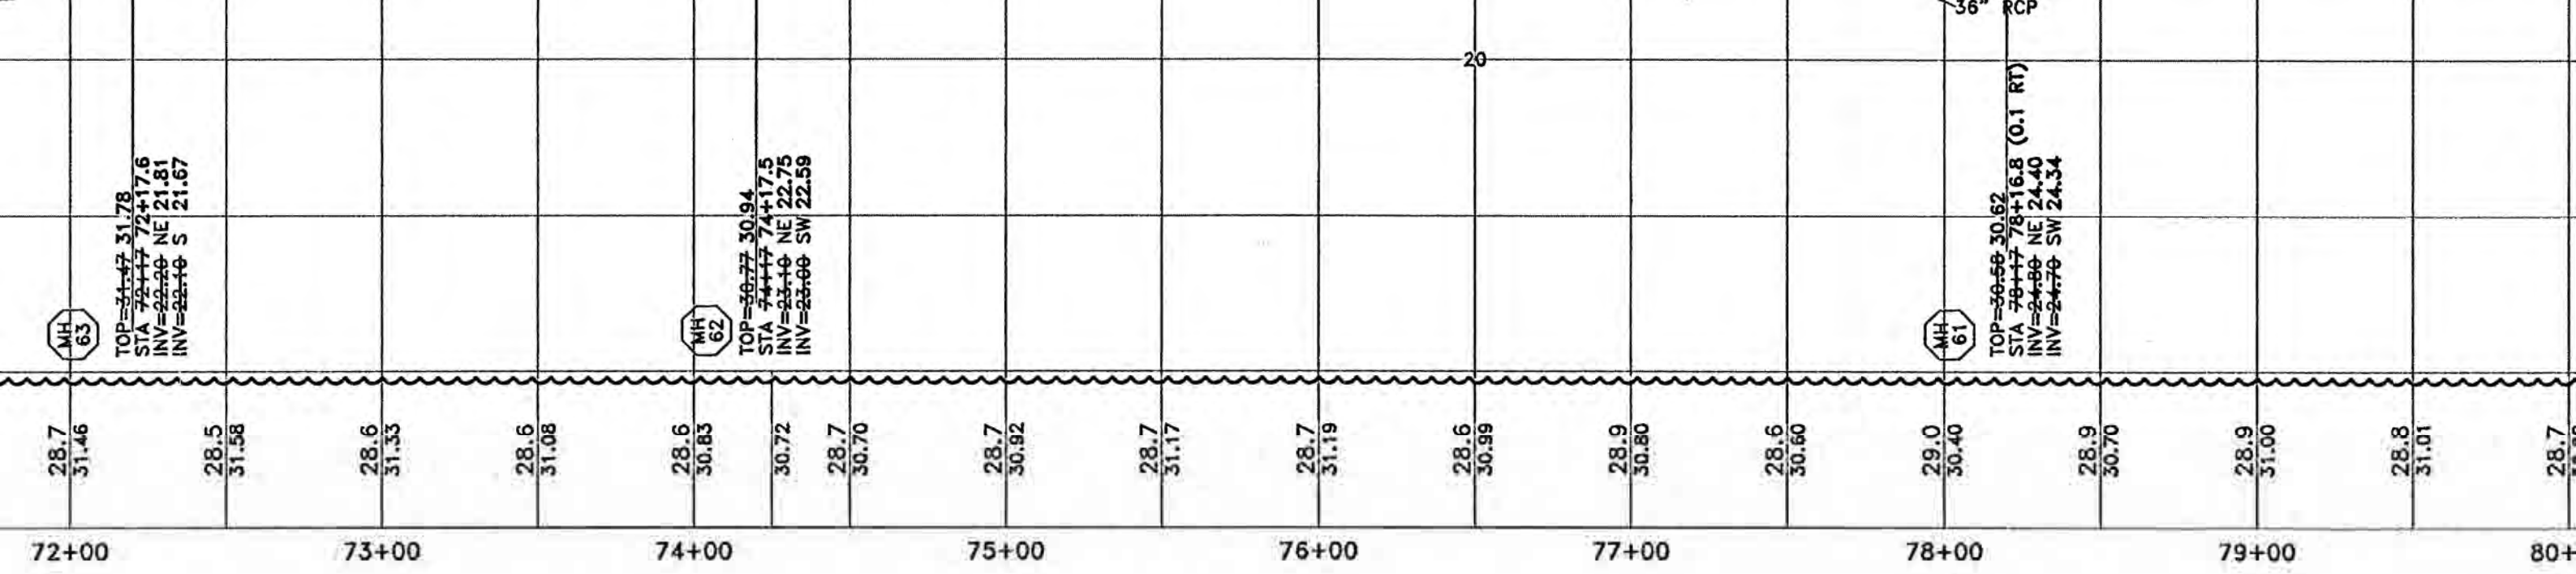


CASA SEVILLA AVE.
(PHASE 2)

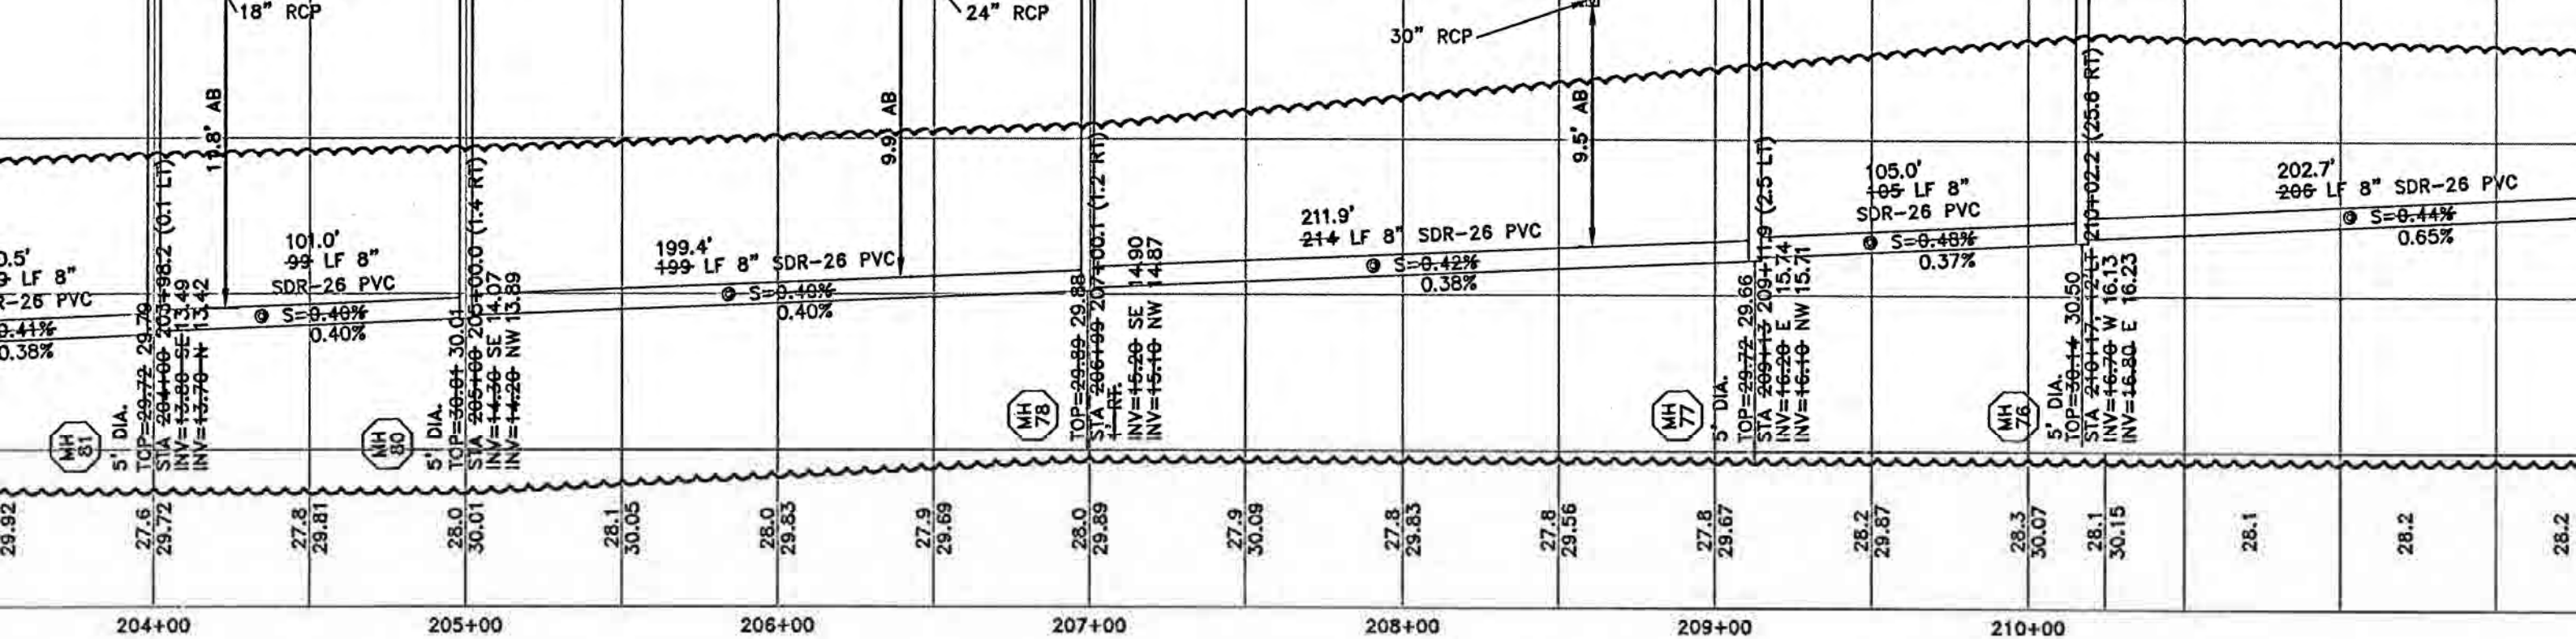


NOTE:
M.H. RIM ELEVATIONS SHALL
MATCH PROPOSED SURROUNDING
FINISHED PAVEMENT ELEVATION.

MONA PLACE(PHASE 2)

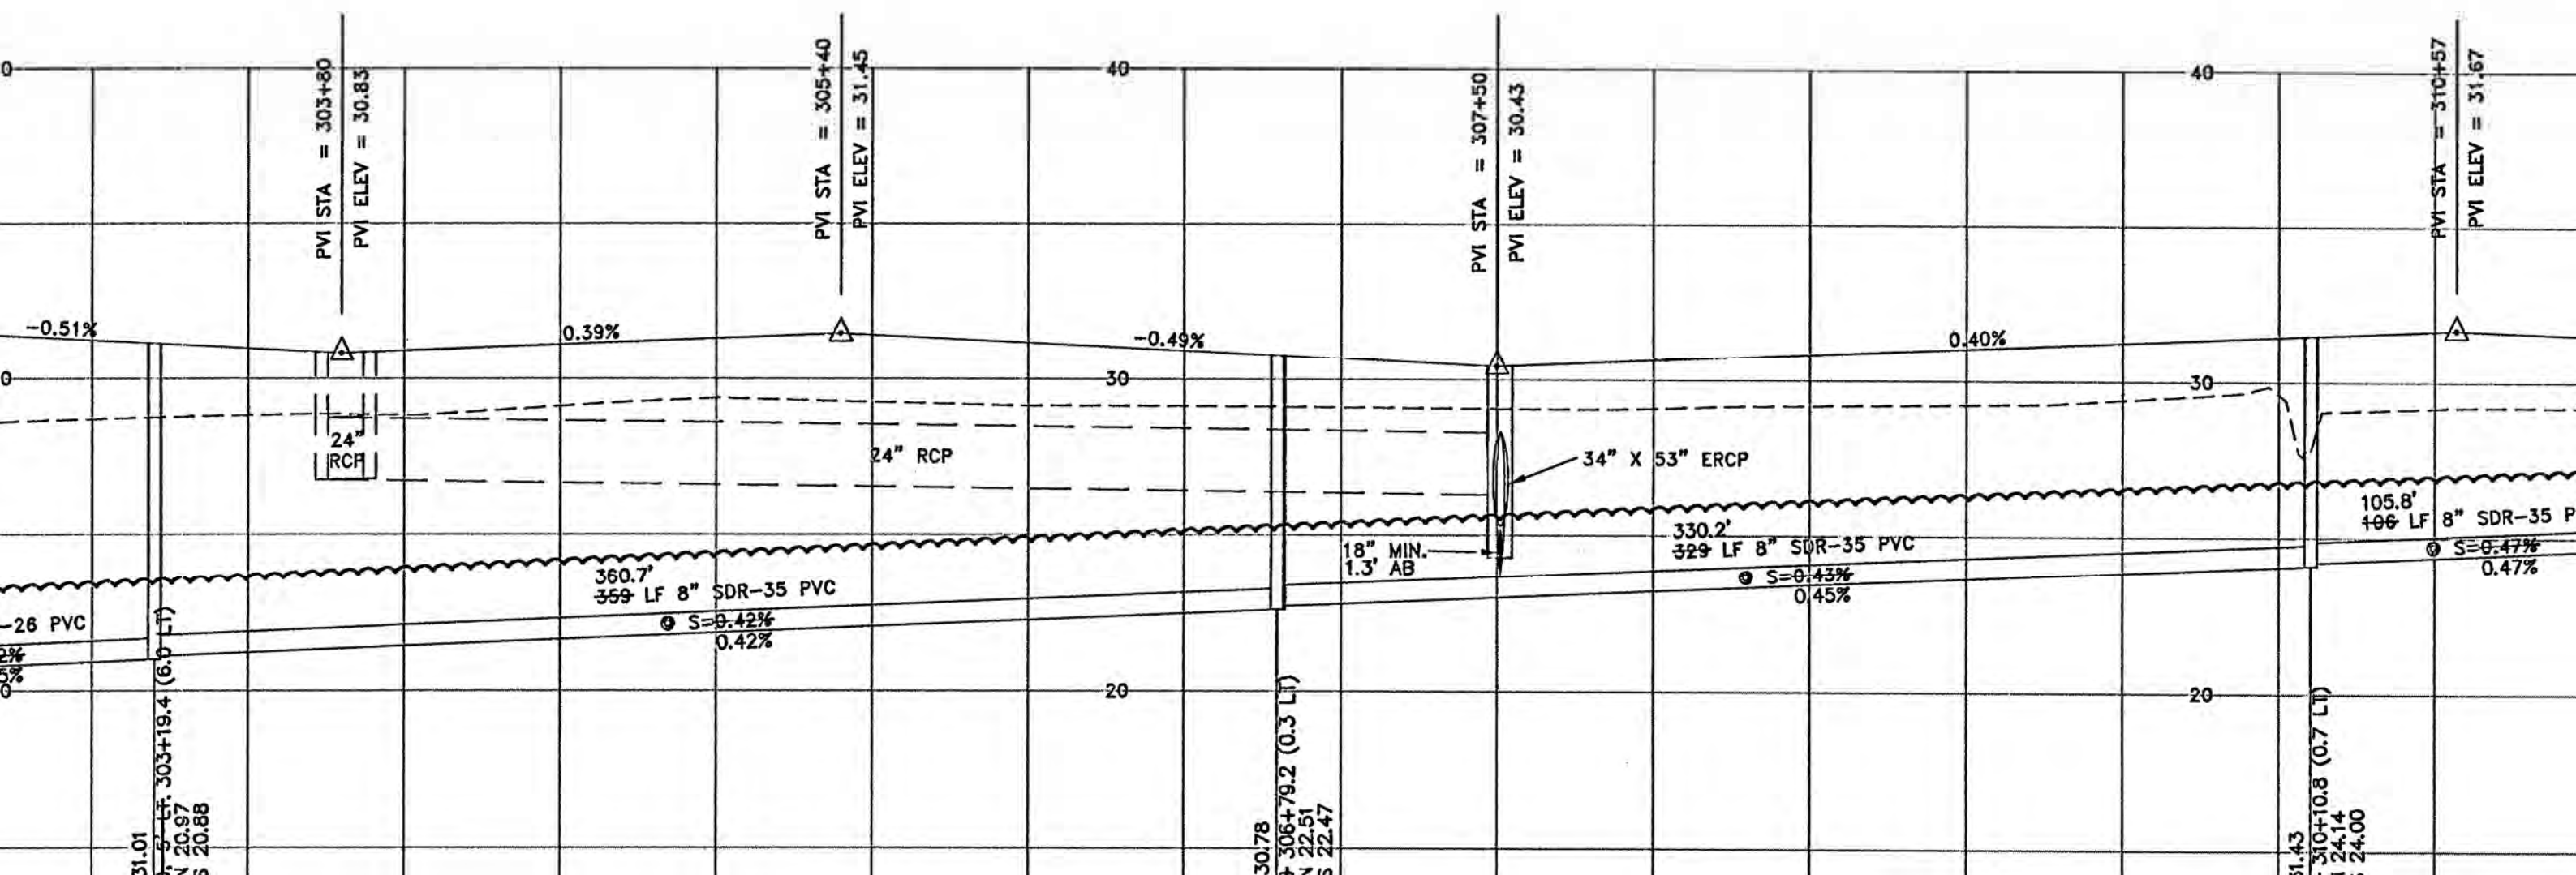

CONTRACTOR SHALL INSTALL A 1" S.S. TAP, NIPPLE AND BALL VALVE (FIP, HAYWARD OR APPROVED EQUAL)

DESIGN POINT 200 GPM AT 62 FT. TDH
PUMP ACCESS HATCH SIZE 34" x 49"

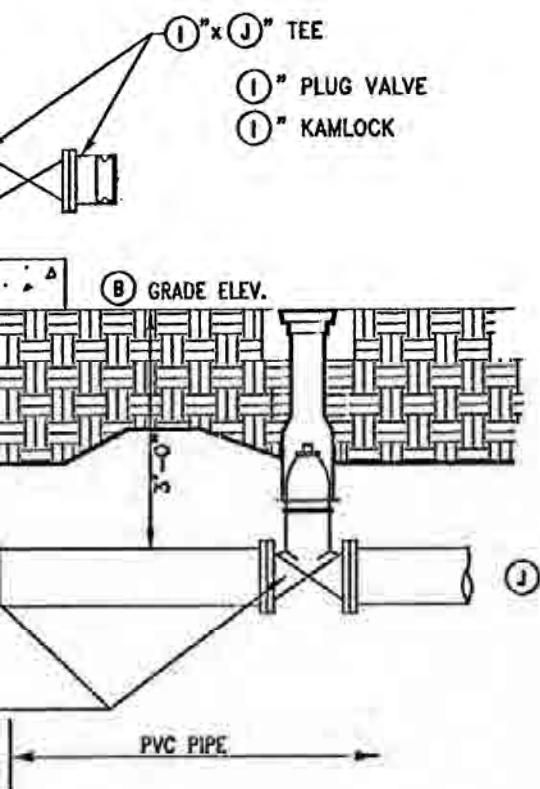

MECHANICAL EQUIPMENT SCHEDULE

- ① CHECK VALVE, MUELLER OR M&H SWING-TYPE, LEVER & SPRING OPERATED, IRON BODY, BRONZE MOUNTED
- ② PLUG VALVE, DEZURIK, CAST IRON BODY, LEVER ACTUATED
- ②A CONTRACTOR TO INSTALL PRESSURE SENSOR, ONYX, PART #160-0400-22-09-03, PSW-STAINLESS STEEL, VITON SEAL, SILICON FILL W/ 1/2" NPT CONNECTION INCLUDING A PRESSURE TRANSMITTER, ABB PART #264HSPSBA1 CALIBRATOR 0-150 PSI (OR S.J.C.U.D. APPROVED EQUAL)
- ③ STAINLESS STEEL TEE
- ④ STAINLESS STEEL SHORT RADIUS 90° BEND
- ⑤ STAINLESS STEEL 45° BEND
- ⑥ 316 STAINLESS STEEL PIPE
- ⑦ DUCTILE IRON PUMP BASE
- ⑧ INFLUENT PIPE (SEE PLANS)
- ⑨ CONCRETE WETWELL
- ⑩ FLYGT PUMP (AS APPROVED BY ST. JOHNS COUNTY UTILITY DEPARTMENT)
- ⑪ ALUMINUM WETWELL ACCESS COVER (OPENING PER PUMP MANUFACTURER)
- ⑫ STAINLESS STEEL GUIDE RAILS
- ⑬ LEVEL TRANSDUCER, HIGH AND LOW ALARM FLOATS PROVIDED BY PUMP MANUFACTURER
- ⑭ PUMP MOTOR CABLE
- ⑮ 4" TEE SCHEDULE 80 PVC AIR VENT WITH PROTECTIVE SCREENS
- ⑯ STAINLESS STEEL CABLE HOLDER
- ⑰ 1" STAINLESS BLOW OFF LINE TO WETWELL-SECURE LINE TO WETWELL SLAB W/ UNISTRUT.

(SEE TABLES) DIAMETER
PRECAST CONCRETE WETWELL

1" PVC SCH. 80 SLEEVE
THROUGH CONC. SLAB.
PVC BALL VALVE W/VITON
SEAL (OR APPROVED EQUAL)
.5 (8") ABOVE GRADE.

SCH 40 PVC ELECTRICAL SERVICE
CONDUIT TO ELECTRICAL POWER
DISTRIBUTION SERVICE CONNECTION
(NOTE: ELECTRICAL TRANSFORMERS
SHALL NOT BE INSIDE THE
S.J.C.U.D. EASEMENT.)

WETWELL SLAB
PT#2 ELEV.
(SEE BELOW)

REAR PL
LEFT ELEV.
(SEE BELOW)

STATION

STATION NO.	EOP/ CENTER DRIVE	ROW/ CENTER DRIVE	ROW/ RIGHT PL	ROW/ LEFT PL	MANH TOP
LIFT STATION #1	30.07	30.20	30.30	30.30	31.2

NOTE:
CONTROL PANEL TO BE BOLTED
TO 4" POST. BOLTS SHALL BE
DRILLED THROUGH POSTS FOR
RIGIDITY (BRACKES -4-TYPICAL)

EMERGENCY POWER CONNECTOR

PUMP STATION PANEL WITH NEMA 3R SS
ENCLOSURE AND DEAD FRONT INNER DOOR

72"

MIN 10'-0"x4" DIA ALUMINUM SUPPORT PIPES W/ PIPE CAPS
@ 6'-0" ABOVE CONCRETE PAD. PROVIDE MASTIC SEAL COATING
ON ALL SURFACES BELOW GRADE OR EMBEDDED IN CONCRETE.

F.P.L. METER

WARNING LIGHT

UL SERVICE ENTRANCE DISCONNECT SWITCH NEMA 4X SS ENCL

MOUNTING SPACE FOR FUTURE RTU
ALUMINUM SUPPORT CHANNEL (1-5/8"x1-5/8")

1" PVC SCH. 80 SLEEVE
THROUGH CONC. SLAB.
1" PVC BALL VALVE W/VITON SEAL
1/2" PVC BALL VALVE W/VITON SEAL
(OR APPROVED EQUAL)
1" x 1/2" TEE
(1 FOOT ABOVE GRADE)

2" SCH 80 PVC SLEEVE WITH LONG
RADIUS ELLS, FOR STATIC WATER LINE


10'x5/8" COPPER CLAD STEEL GROUND ROD

4" ALUMINUM CONDUITS
WITH PVC CAP

SCH 80 PVC
CONDUIT

2008 NW Veteran Affairs As Built Drawings



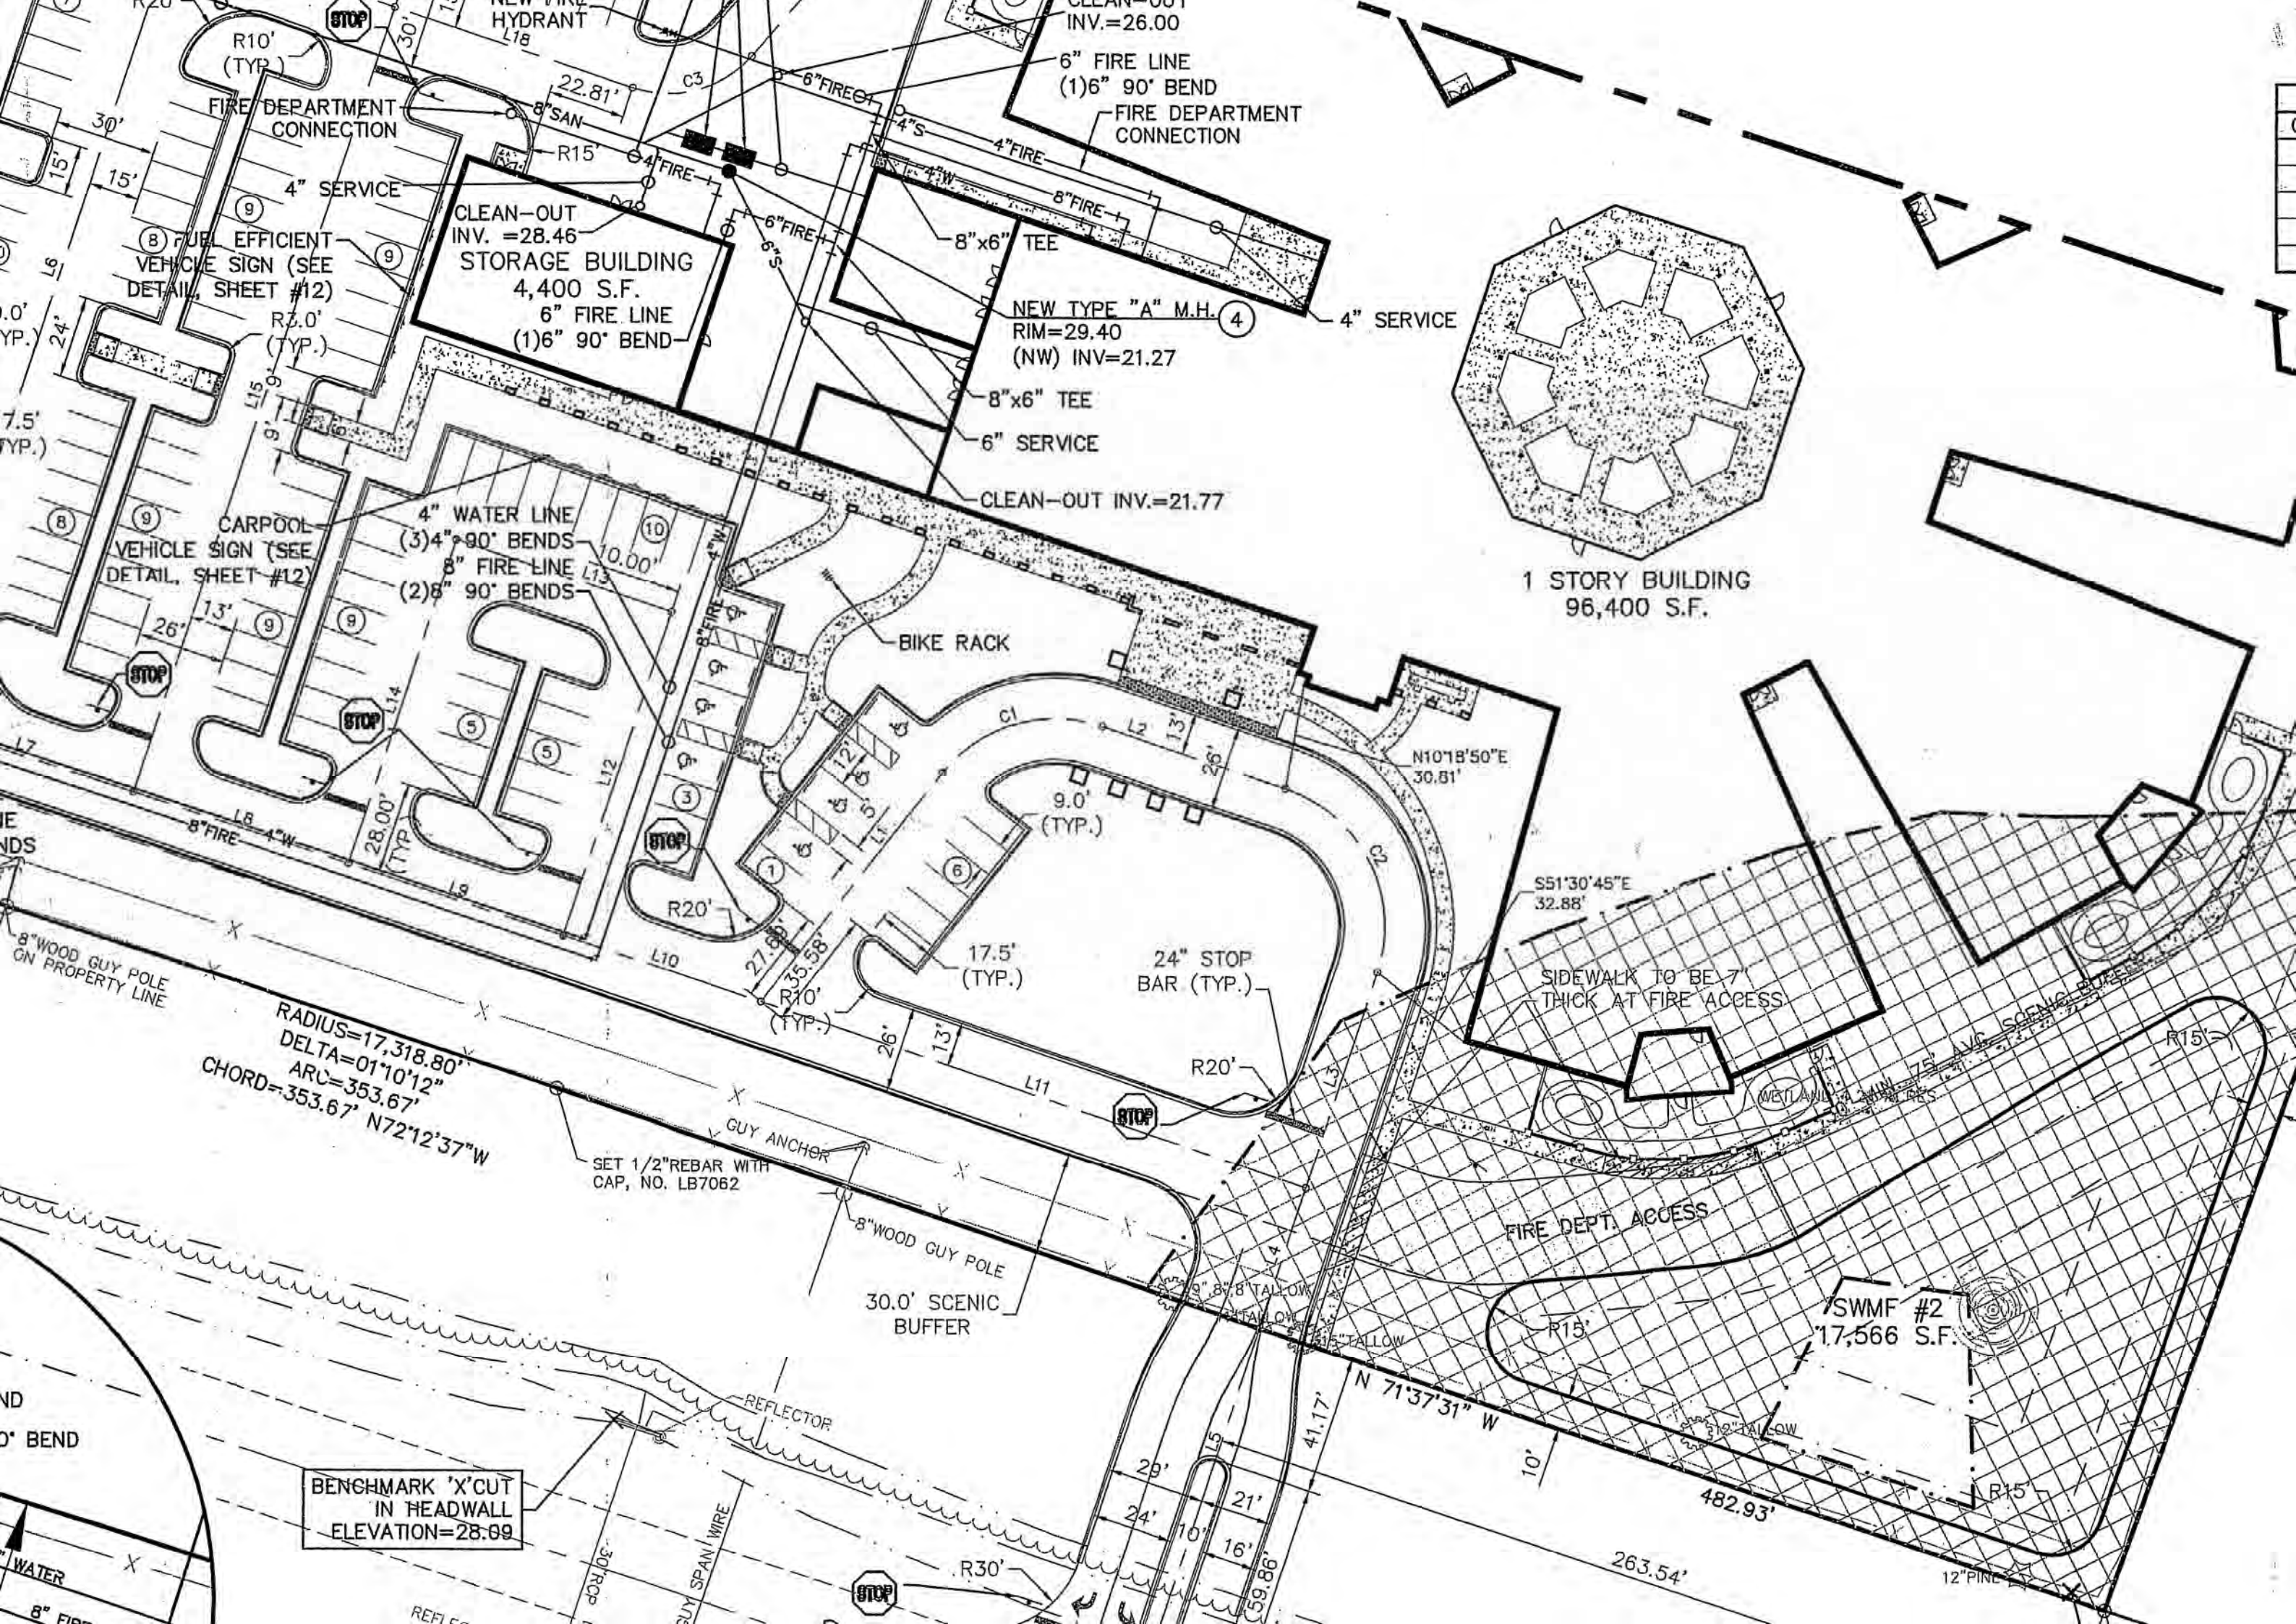

CLEAN-OUT
INV. =28.46
STORAGE BUILDING
4,400 S.F.
6" FIRE LINE
(1)6" 90° BEND


NEW TYPE "A" M.H.
RIM=29.40
(NW) INV=21.27

1 STORY BUILDING
96,400 S.F.

RADIUS=17,318.80'
DELTA=01°10'12"
ARC=353.67'
CHORD=353.67' N72°12'37"W

BENCHMARK "X" CUT
IN HEADWALL
ELEVATION=28.69

SWMF #2
17,566 S.F.

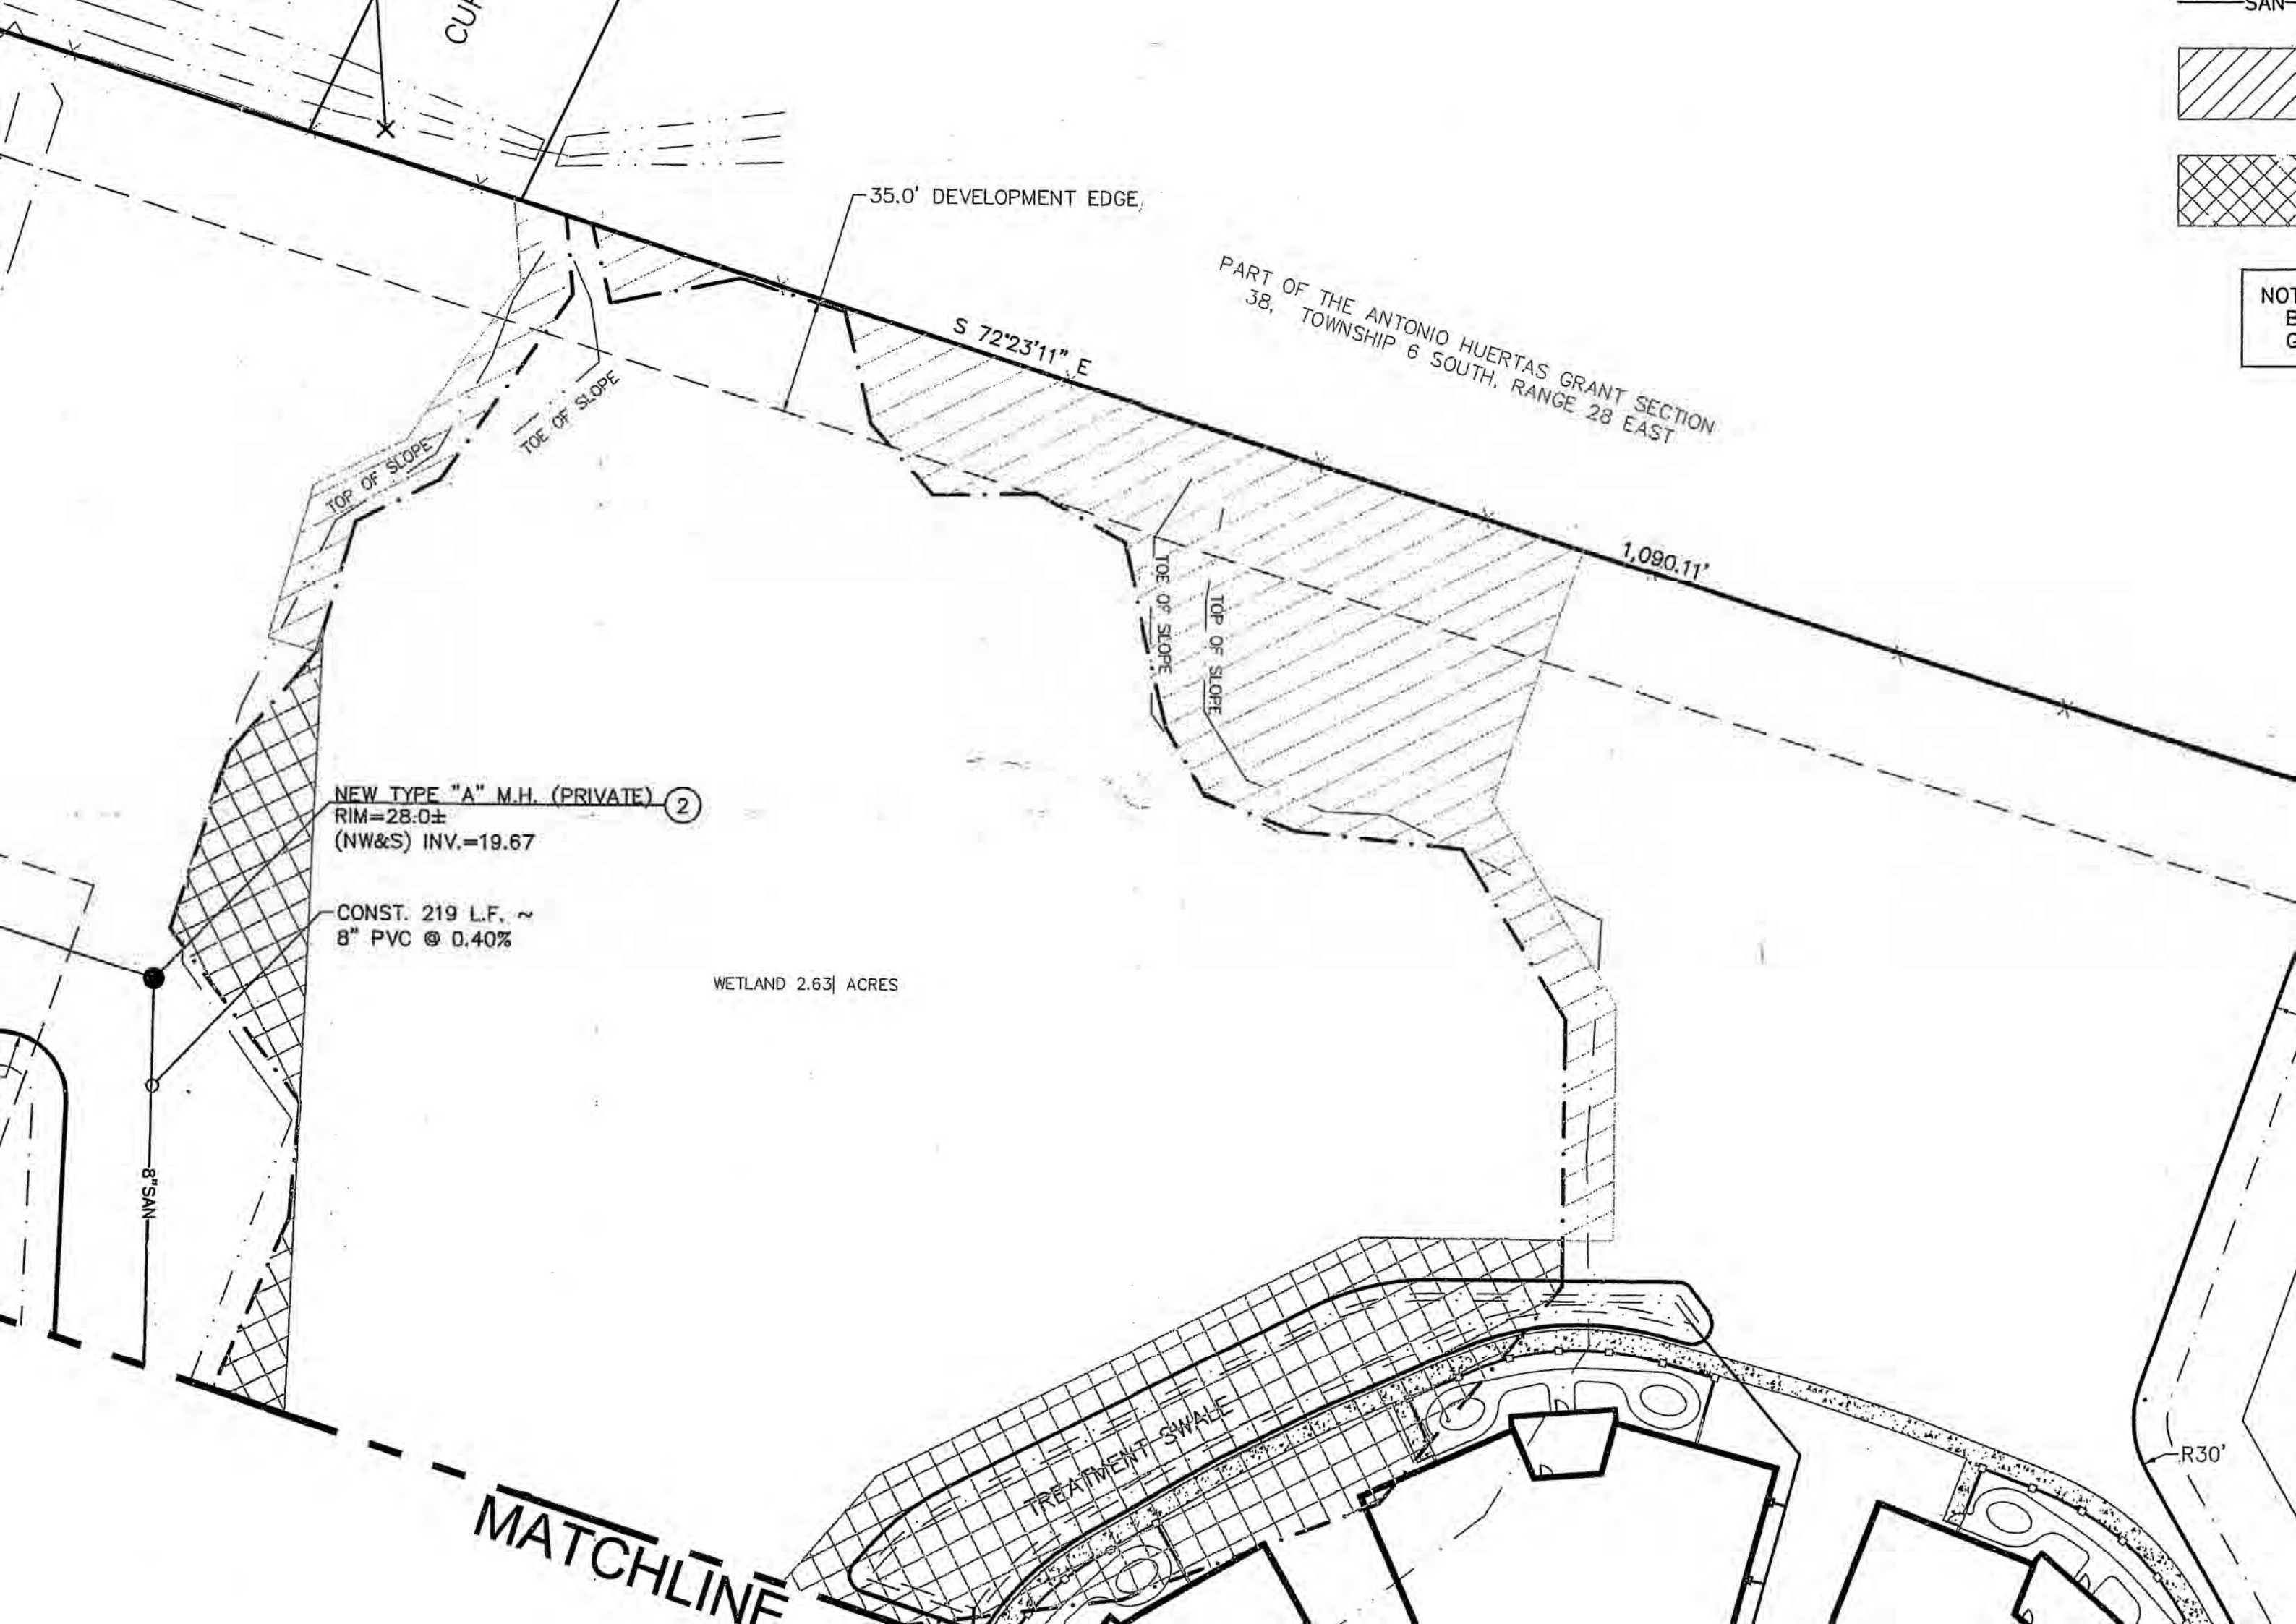

35.0' DEVELOPMENT EDGE

PART OF THE ANTONIO HUERTAS GRANT SECTION
38, TOWNSHIP 6 SOUTH, RANGE 28 EAST

S 72°23'11" E

1,090.11'

NEW TYPE "A" M.H. (PRIVATE) ②
RIM=28.0±
(NW&S) INV.=19.67


CONST. 219 L.F. ~
8" PVC @ 0.40%

WETLAND 2.63 ACRES

TREATMENT SWALE

MATCHLINE

R30'

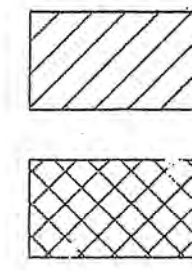

2009 NW Turnbull Booster Pump Station As Built Drawings



ST. JOHNS COUNTY, FLORIDA

PREPARED FOR ST. JOHNS COUNTY UTILITY DEPARTMENT

1205 STATE ROAD 16
ST. AUGUSTINE, FLORIDA 32084
PHONE: (904) 209-2626
FAX: (904) 209-2627

AS-BUILT

AS-BUILT CERTIFICATIONS	
CONTRACTOR'S STATEMENT	SURVEYOR'S STATEMENT
DATE: <u>9/21/12</u> CO. NAME: <u>Ortega</u> ADDRESS: <u>6415 Greenland Rd</u> <u>Jacksonville, FL 32258</u> PHONE #: <u>904.228-2181</u>	I HEREBY CERTIFY THAT THE <input checked="" type="checkbox"/> PAVEMENT <input checked="" type="checkbox"/> CURB & GUTTER <input checked="" type="checkbox"/> STORM & DRAINAGE <input checked="" type="checkbox"/> WATER MAIN <input checked="" type="checkbox"/> SANITARY GRAVITY SYSTEM <input checked="" type="checkbox"/> FORCE MAIN

WMD.
1
GN-
2
3A-
4A-
5A-
6
7A-
8
9
10
11A-

STORM PIPE, STRUCTURES,
ELEMENTS SHALL BE
BACKFILL, PROPERLY
TECHNICAL REPORT.

TION OF ALL SURVEY AND
S DISTURBED, THE
SURVEYOR OF RECORD FOR

LED UNDER PAVEMENT MUST
SUBGRADE FOR PAVEMENT.

HIS CONSTRUCTION WITH
OF ANY CONFLICT
TIFY THE ENGINEER AND
RUCTION.

AWINGS ON ALL MATERIALS
VAL PRIOR TO PURCHASE
RM PIPE OR STRUCTURE.

E RATE MAPS PANEL NO.

NS, DETAILS AND NOTES
RATOR IS TO COORDINATE
O CLEARING OPERATIONS.

REFERENCED BY ST. JOHNS
VEYING AND MAPPING
AS PUBLISHED BY
88, FEET).

VEY PROVIDED BY ST.
S SURVEYING AND MAPPING

Y PROVIDED BY DEGROVE
AME 2002201 (PORTIONS
HNS COUNTY LAND
PPING DIVISION DATED

COMPLETE ACCORDANCE WITH
SPECIFICATIONS AND ALL
NDARD DETAILS AND
CTION, THE WORK SHALL
RDANCE WITH THE
TECHNICAL ENGINEER'S

MATERIAL SHALL BE REMOVED
SS DIRECTED OTHERWISE BY

INCLUDING BENCHMARKS, IS
04.00 OF THE ST. JOHNS
CTION 15, "AS-BUILTS" OF
TO SCHEDULING A FINAL
ING DEPARTMENT OR THE

NSPECTOR SHALL BE
SSARY SITE WORK
NAL INSPECTION.

T OF TRANSPORTATION
D BY THE LATEST FDOT

PACTS, WETLAND MITIGATION
ON THESE PLANS MATCH
E ST. JOHNS RIVER WATER
L IS PENDING FINAL REVIEW

CONTRACTOR IS
NOTICE OF COMMENCEMENT
TO THE FLORIDA
ON. CONTACT NPDES
FLORIDA DEPARTMENT OF
TONE ROAD, TALLAHASSEE,

INTERVALS ALONG POND BANK FOR ALL POND CONSTRUCTION.
ALL DIMENSIONS AND ELEVATIONS ON THE CONTROL STRUCTURE
DETAILS SHALL BE SHOWN ON AS-BUILT DRAWINGS.
CONTRACTOR SHALL SHOW ALL CASING AND SLEEVE LOCATIONS
AND INVERT ELEVATIONS. ALL DEVIATIONS FROM PLANS SHALL
BE CLEARLY INDICATED ON THE AS-BUILT DRAWINGS.

7. ALL PAVEMENT MARKING SHALL BE EXTRUDED THERMOPLASTIC, IN ACCORDANCE WITH FDOT SPECIFICATIONS. REFLECTIVE PAVEMENT MARKERS SHALL BE INSTALLED IN ACCORDANCE WITH FDOT STANDARDS AND SPECIFICATIONS.
8. THE CONTRACTOR SHALL PROVIDE ACCESSIBLE RAMPS AT ALL SIDEWALK AND CURB CONNECTIONS. ACCESSIBLE RAMPS SHALL MEET ALL APPLICABLE ADA AND ST. JOHNS COUNTY REQUIREMENTS.
9. FOR SPECIAL PAVING AND DRAINAGE DETAILS SEE DRAWING NO. 6. FOR ALL STANDARD DETAILS SEE ST. JOHNS COUNTY LDC AND STANDARD DETAILS, LATEST REVISIONS.
10. STORM DRAINS SHOWN IN PUBLIC RIGHT-OF-WAYS OR OTHERWISE INDICATED AS "TV REQUIRED" SHALL BE VIDEO INSPECTED AND RECORDED IN ACCORDANCE WITH ST. JOHNS COUNTY LDC.
11. A PRE-CONSTRUCTION/PRE PERMIT MEETING WITH ST. JOHNS COUNTY IS REQUIRED PRIOR TO STARTING ANY SITE ACTIVITIES. PRE CONSTRUCTION MEETING CAN BE HELD IN CONJUNCTION WITH SJUCUD/JEA PRECONSTRUCTION CONFERENCE IF APPLICABLE. CONTACT CARL COLEE AT 904-209-0736 TO SCHEDULE A MEETING.
12. ALL DETECTABLE WARNING SURFACES FOR SIDEWALK AT CURB CUT HANDICAP RAMPS UNDER THE JURISDICTION OF ST. JOHNS COUNTY SHALL BE A COUNTY APPROVED YELLOW COLORED COMPOSITE MATERIAL ANCHORED IN THE CONCRETE SIDEWALK RAMP. ANCHORED COMPOSITE WARNING AREA INSERTS ARE TO BE COLORED "SAFETY YELLOW", ARE TO BE SET INTO THE CONCRETE AND ARE TO BE FLUSH WITH CONCRETE SURFACE ALONG ALL FOUR SIDES. DESIGN DIMENSIONS OF DETECTABLE WARNING AREA SHALL CONFORM TO FLORIDA DEPARTMENT OF TRANSPORTATION (FDOT) STANDARD INDES 304, SHEETS 1 THROUGH 6, AND 28 CODE OF FEDERAL REGULATIONS (CFR) PART 36, APPENDIX A LATEST REVISION, AS WELL AS APPLICABLE COUNTY REQUIREMENTS. ACCEPTABLE PRODUCTS ARE CAST IN PLACE COMPOSITE TACTILE BY ADA SOLUTIONS, INC., AND CAST IN PLACE DETACTABLE WARNING PANEL BY ARMORCAST. THE STANDARD COLOR FOR THE DETECTABLE WARNING SURFACE SHALL BE YELLOW. A DIFFERENT CONTRASTING COLOR MAY BE APPROVED WHEN SUBMITTED AS PART OF A UNIFORM SIGNAGE PLAN FOR A DEVELOPMENT. ANY TYPE OF ADHESIVE OR GLUE DOWN MATS; STAMPED CONCRETE OR ANY VARIATION OTHER THAN WHAT IS SPECIFIED ABOVE WILL NOT BE ACCEPTED BY THE COUNTY. THE COUNTY WILL CONSIDER ALTERNATIVES THAT ARE EQUAL TO THE PRODUCTS SPECIFIED ABOVE. THE COUNTY ENGINEER AND THE CHIEF ENGINEER FOR DEVELOPMENT SERVICES WILL HAVE THE SOLE RESPONSIBILITY FOR DETERMINING THE PRODUCT ACCEPTABILITY.
13. ALL EROSION AND SEDIMENT CONTROL MEASURES, INCLUDING SILT FENCE, HAY BALES, AND FILTER FABRIC INSIDE DRAINAGE STRUCTURES SHALL BE REMOVED PRIOR TO FINAL INSPECTION, UNLESS OTHERWISE DIRECTED BY THE OWNER OR THE ENGINEER.

11. THE CONTRACTOR SHALL MINIMIZE SERVICE INTERRUPTIONS AND MAINTAIN ANY EXISTING WA ALL TIMES. THE CONTRACTOR SHALL BE RESPONSIBLE FOR NOTIFICATION OF AFFECTED CU INTERRUPTION OF SERVICE.
12. ALL ELECTRICAL CONDUIT WORK SHALL BE COMPLETED PRIOR TO THE PRESSURE TESTING C OUTFALL PIPING. ALL PRESSURE TESTING AND PUMP TESTING SHALL BE WITNESSED BY ST
13. ALL UTILITY MAINS 12" AND LARGER SHALL HAVE 42" MINIMUM COVER AND 54" MAXIMUM SHALL HAVE 30" MINIMUM COVER UNDER UNPAVED AREAS AND 36" MINIMUM COVER FROM ADDITIONAL COVER IS REQUIRED FOR VALVE INSTALLATION CLEARANCE FOR PIPE GREATER CONTRACTOR TO PROTECT INSTALLED PIPING UNTIL FINAL ACCEPTANCE BY F.D.E.P AND ST. CONFLICTS.
14. ALL UTILITY MAINS SHALL BE FLUSHED IN ACCORDANCE WITH, AND UNDER THE DIRECTION
15. HORIZONTAL AND VERTICAL SEPARATION BETWEEN WATER MAINS AND REUSE MAINS AND HA REUSE MAINS TO OTHER UTILITIES SHALL BE IN ACCORDANCE WITH ST. JOHNS COUNTY UTIL
16. ALL GATE VALVES SHALL BE ST. JOHNS COUNTY UTILITY DEPARTMENT STANDARD. VALVES RESILIENT SEAT. ALL VALVES SHALL OPEN BY TURNING TO THE LEFT. VALVES SHALL BE PRESSURE.
17. ALL NEW AND / OR RELOCATED WATER MAIN AND REUSE MAIN PIPE AND FITTINGS SHALL AND JOINT MATERIALS USED IN THE JOINTS SHALL CONFORM WITH ALL APPLICABLE AWWA PLUMBING SHALL CONTAIN NO MORE THAN EIGHT PERCENT LEAD AND ALL SOLDERS AND FI
18. IF SOLVENT CONTAMINATION IS FOUND IN THE PIPE TRENCH, WORK SHALL BE STOPPED AND PERMITTING AGENCY, DUCTILE IRON PIPE, FITTINGS AND SOLVENT RESISTANT GASKET MATER AREA. THE DUCTILE PIPE SHALL EXTEND AT LEAST 100 FEET BEYOND ANY SOLVENT NOTED AN IMPERMEABLE MAT AND COVERED WITH A WATERPROOF COVERING. THE PROPER AUTHO PROPER DISPOSAL.
19. ALL UTILITY MAINS ARE DESIGNED TO FINISHED GRADES AND SHALL BE PROTECTED UNTIL V COUNTY UTILITY DEPARTMENT.
20. THE CONTRACTOR SHALL INSTALL ANY ADDITIONAL AIR RELEASE VALVES AT CHANGES IN E NOT IDENTIFIED ON THESE DESIGN PLANS.
21. ALL EROSION AND SEDIMENT CONTROL MEASURES, INCLUDING SILT FENCE, HAY BALES, AND SHALL BE REMOVED PRIOR TO FINAL INSPECTION, UNLESS OTHERWISE DIRECTED BY THE OW
22. THESE ENGINEERING DRAWINGS MAY NOT SHOW ALL OF THE STANDARD DETAILS REQUIRED IS THE CONTRACTOR'S RESPONSIBILITY THAT THE CONSTRUCTION BE IN ACCORDANCE WITH A COUNTY UTILITIES STANDARD DETAILS AND SPECIFICATIONS. THE CONTRACTOR SHALL OBTAIN DETAILS AND SPECIFICATIONS FROM THE DEPARTMENT OF PUBLIC WORKS AS WELL AS A CO DETAILS AND SPECIFICATIONS PRIOR TO BEGINNING CONSTRUCTION.

AS-BUILT


CONTRACTOR'S STATEMENT


DATE: 9/21/12
CO. NAME: See Cover
ADDRESS: _____
PHONE #: _____

I HEREBY CERTIFY THAT THE MATERIALS USED IN THE
CONSTRUCTION OF


<input type="checkbox"/> PAVEMENT	<input type="checkbox"/> WATER MAIN
<input type="checkbox"/> CURB & GUTTER	<input type="checkbox"/> SANITARY GRAVITY SYSTEM
<input type="checkbox"/> STORM & DRAINAGE SYSTEM	<input type="checkbox"/> FORCE MAIN
	<input type="checkbox"/> LIFT STATION

ARE IN ACCORDANCE WITH THE APPROVED PLANS AND CITY
SPECIFICATIONS, UNLESS OTHERWISE APPROVED BY THE
CITY ENGINEER.

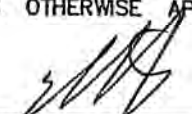
AUTHORIZED SIGNATURE: 

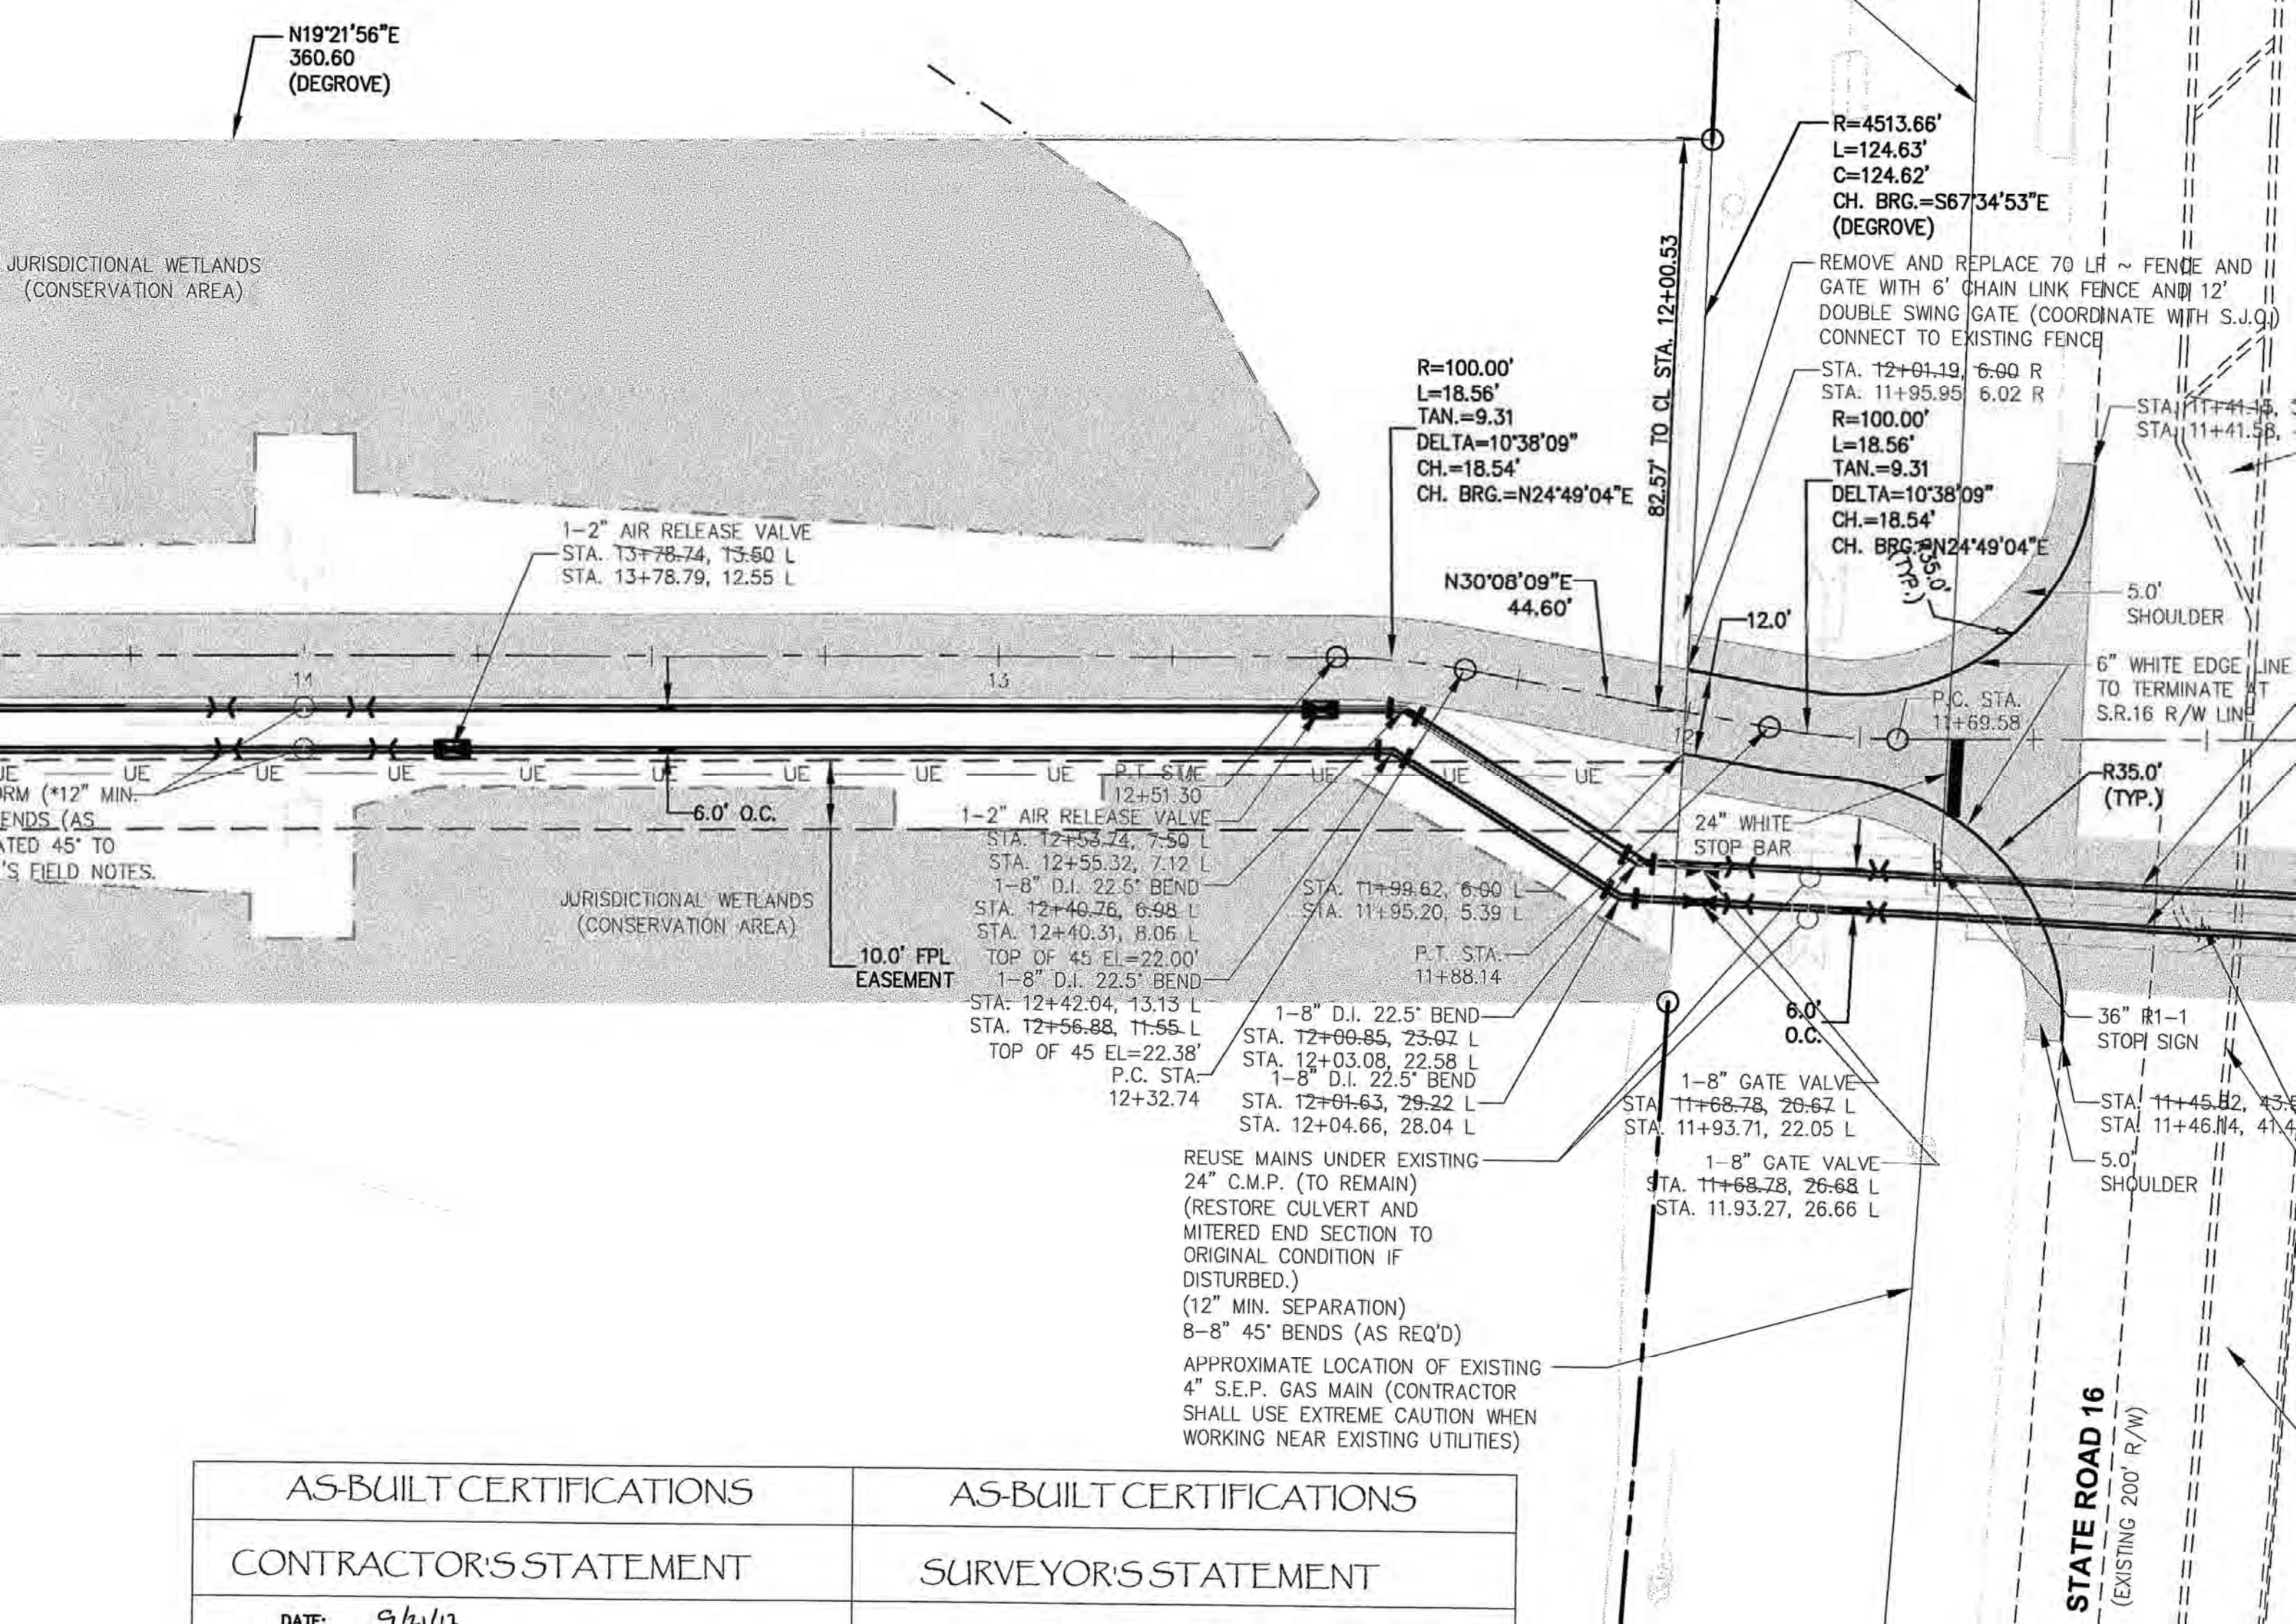

AS-BUILT CERTIFICATIONS	AS-BUILT CERTIFICATIONS
CONTRACTOR'S STATEMENT	SURVEYOR'S STATEMENT
DATE: 9/1/12	

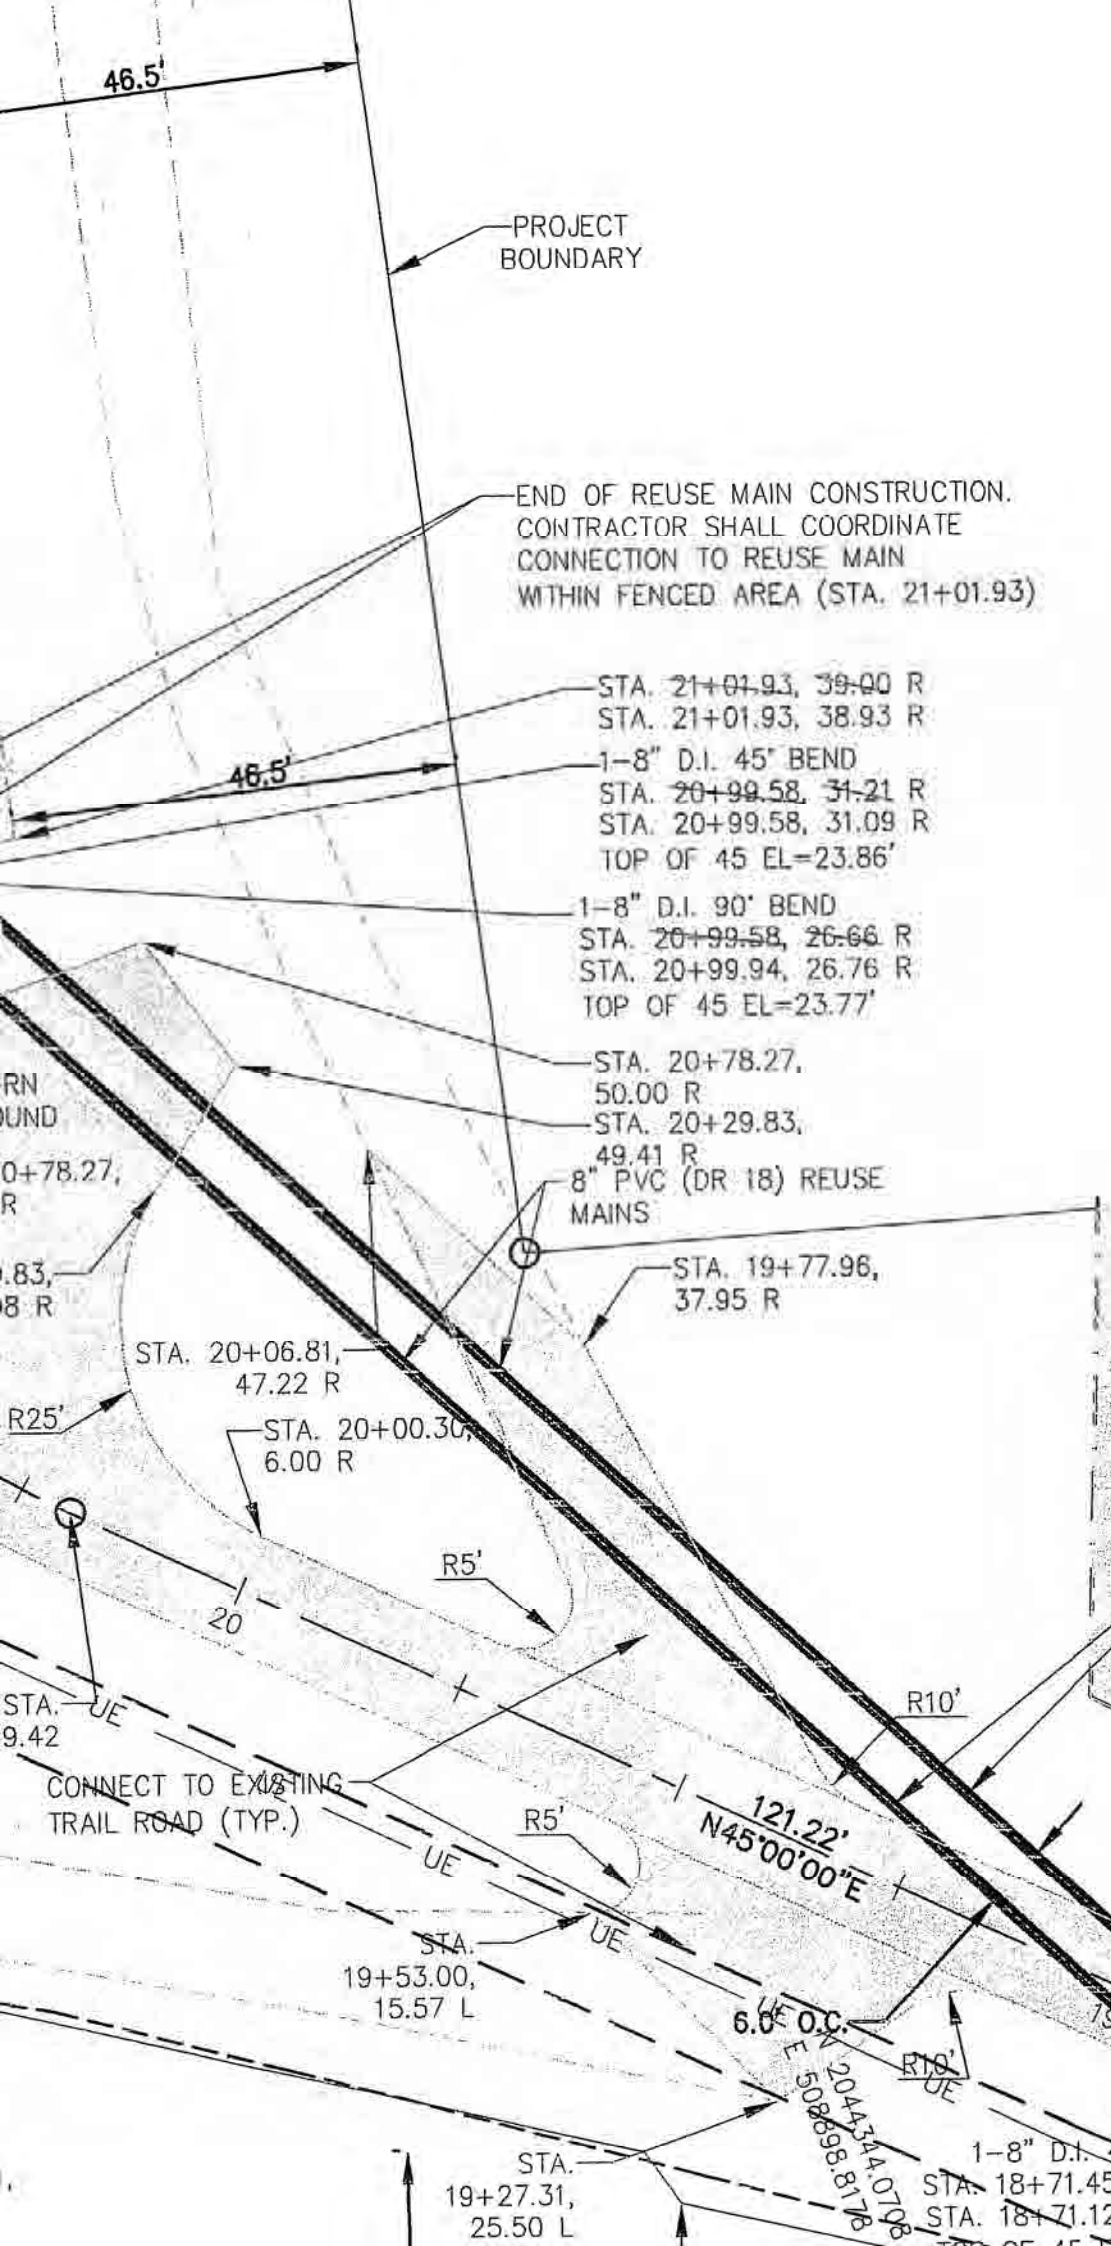

AS-BUILT CERTIFICATIONS	AS-BUILT CERTIFICATIONS								
CONTRACTOR'S STATEMENT	SURVEYOR'S STATEMENT								
<p>DATE: <u>9/21/12</u> CO. NAME: <u>SEE COVER</u> ADDRESS: _____ PHONE #: _____</p> <p>I HEREBY CERTIFY THAT THE MATERIALS USED IN THE CONSTRUCTION OF</p> <table><tr><td><input type="checkbox"/> PAVEMENT</td><td><input type="checkbox"/> WATER MAIN</td></tr><tr><td><input type="checkbox"/> CURB & GUTTER</td><td><input type="checkbox"/> SANITARY GRAVITY SYSTEM</td></tr><tr><td><input type="checkbox"/> STORM & DRAINAGE SYSTEM</td><td><input type="checkbox"/> FORCE MAIN</td></tr><tr><td></td><td><input type="checkbox"/> LIFT STATION</td></tr></table> <p>ARE IN ACCORDANCE WITH THE APPROVED PLANS AND CITY SPECIFICATIONS, UNLESS OTHERWISE APPROVED BY THE CITY ENGINEER.</p> <p>AUTHORIZED SIGNATURE: <u>[Signature]</u></p>		<input type="checkbox"/> PAVEMENT	<input type="checkbox"/> WATER MAIN	<input type="checkbox"/> CURB & GUTTER	<input type="checkbox"/> SANITARY GRAVITY SYSTEM	<input type="checkbox"/> STORM & DRAINAGE SYSTEM	<input type="checkbox"/> FORCE MAIN		<input type="checkbox"/> LIFT STATION
<input type="checkbox"/> PAVEMENT	<input type="checkbox"/> WATER MAIN								
<input type="checkbox"/> CURB & GUTTER	<input type="checkbox"/> SANITARY GRAVITY SYSTEM								
<input type="checkbox"/> STORM & DRAINAGE SYSTEM	<input type="checkbox"/> FORCE MAIN								
	<input type="checkbox"/> LIFT STATION								
<p>I HEREBY CERTIFY THAT THE</p> <table><tr><td><input checked="" type="checkbox"/> PAVEMENT</td><td><input checked="" type="checkbox"/> WATER MAIN</td></tr><tr><td><input checked="" type="checkbox"/> CURB & GUTTER</td><td><input checked="" type="checkbox"/> SANITARY GRAVITY SYSTEM</td></tr><tr><td><input checked="" type="checkbox"/> STORM & DRAINAGE SYSTEM</td><td><input checked="" type="checkbox"/> FORCE MAIN</td></tr><tr><td></td><td><input checked="" type="checkbox"/> LIFT STATION</td></tr></table> <p>I HEREBY CERTIFY, that this map graphically depicts the results of a field survey made under my responsible direction and complies with the latest Minimum Technical Standards for Surveys as promulgated by the Florida State Board of Professional Surveyors and Mappers, Chapter 5J-17.051 & 5J-17.052, Florida Administrative Code; Pursuant to Section 472.027, Florida Statutes; subject to all notes and notations shown hereon.</p> <p>SIGNATURE: <u>[Signature]</u> ALBERT D. BRADSHAW FLA. REG. LAND SURVEYOR'S NO. 5257</p> <p>BRADSHAW-NILES & ASSOCIATES, INC. SURVEYING AND MAPPING CONSULTANTS LICENSED BUSINESS NO. 6514 2005 BUSINESS PARK CIRCLE, SUITE 310 ST. AUGUSTINE, FLORIDA 32085 (407) 829-2321 FAX (407) 829-2320</p>		<input checked="" type="checkbox"/> PAVEMENT	<input checked="" type="checkbox"/> WATER MAIN	<input checked="" type="checkbox"/> CURB & GUTTER	<input checked="" type="checkbox"/> SANITARY GRAVITY SYSTEM	<input checked="" type="checkbox"/> STORM & DRAINAGE SYSTEM	<input checked="" type="checkbox"/> FORCE MAIN		<input checked="" type="checkbox"/> LIFT STATION
<input checked="" type="checkbox"/> PAVEMENT	<input checked="" type="checkbox"/> WATER MAIN								
<input checked="" type="checkbox"/> CURB & GUTTER	<input checked="" type="checkbox"/> SANITARY GRAVITY SYSTEM								
<input checked="" type="checkbox"/> STORM & DRAINAGE SYSTEM	<input checked="" type="checkbox"/> FORCE MAIN								
	<input checked="" type="checkbox"/> LIFT STATION								

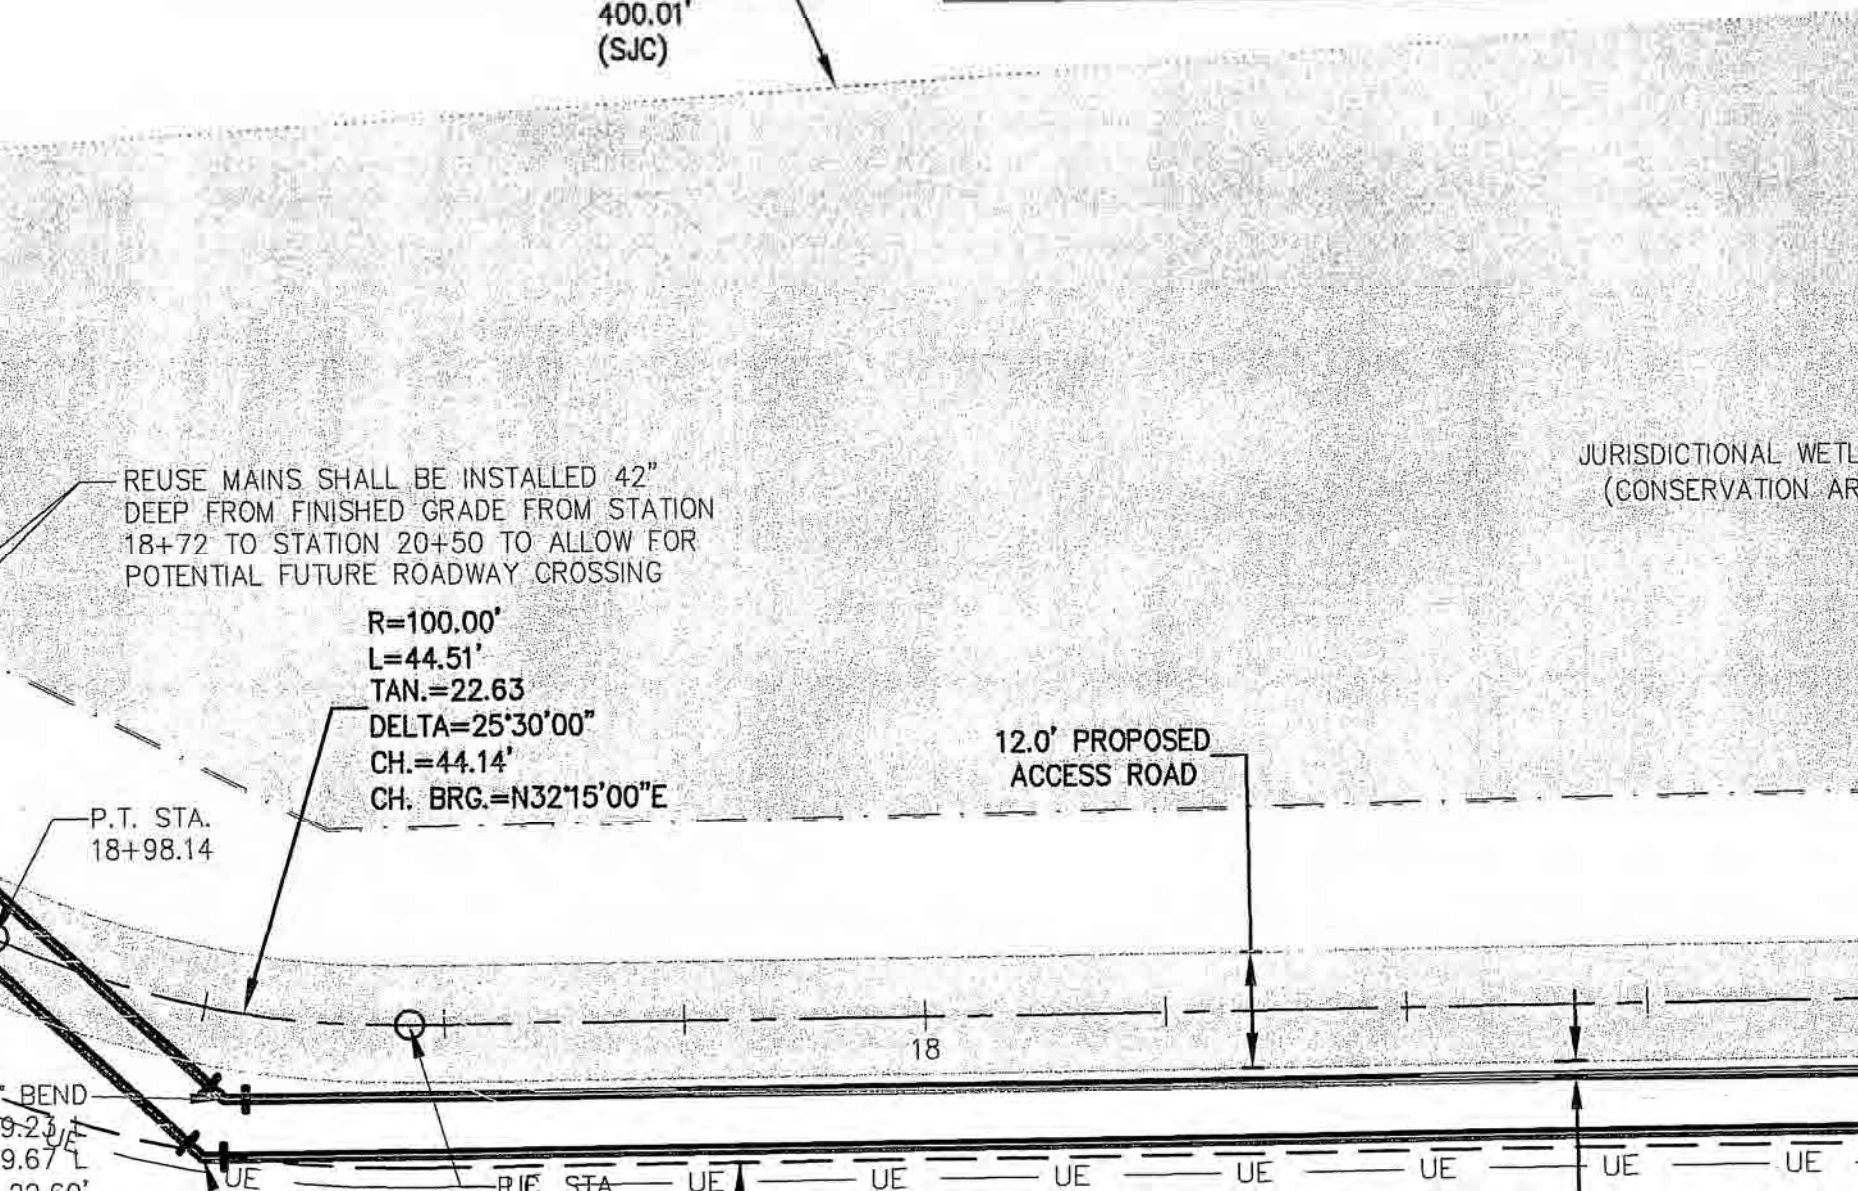

AUTHORIZED SIGNATURE

JURISDICTIONAL
WETLANDS
(CONSERVATION
AREA)
(ISOLATED)

-SWALE #1
CONSTRUCT V-SWALE
WITH 4:1 SIDE SLOPES,
(SEED AND MULCH ALL
4:1 SLOPES, TYP.)

-EXISTING TRAIL ROAD

- TRANSITION TO
EXISTING TRAIL ROAD
AT 20:1 SLOPE

EL. = 26.80

$$\frac{24.5 \pm}{N.G.}$$
~~24.5%~~
N.G.

24.45
N.G.

$$\frac{2.4}{2.2}$$

23.6 ±
N.C.

TRANSITION TO —
EXISTING TRAIL ROAD
—AT 20:1 SLOPE—

4:1 SLOPE TO MEET NATURAL
GRADE AT WEST SIDE OF
TRAIL ROAD (SEED AND MULCH
ALL DISTURBED AREA) (SEE
TYPICAL SECTION, THIS SHEET)

JURISDICTIONAL
WETLANDS
(CONSERVATION AREA)

KEY MAP
N.T.S.

PROPOSED
DISPERSION
BASIN #1

TOP OF BANK

MATCHLINE B

TOP OF BANK

~~23.81~~
~~N.G.~~~~23.81~~ G.

~~24.01~~
~~N.G.~~

~~24.4~~

16 RIGHT-OF-WAY (EXISTING)

PVI STA = 11+80.00
ELEV = 26.80

-1.60%

0.00%

CENTERLINE OF
ACCESS ROAD

APPROXIMATE LOCATION OF
EXISTING 4" S.E.P. GAS MAIN.
CONTRACTOR SHALL LOCATE
EXISTING GAS MAIN AND
PROVIDE 12" MIN. CLEARANCE
AND 36" MIN. COVER (BENDS
AS REQ'D, COORDINATE WITH
GAS COMPANY AS REQUIRED)

APPROXIMATE LOCATION OF
EXISTING 24" C.M.P. CULVERT

EXISTING
GRADE

PROPOSED 24"
R.C.P. CULVERT

8" FIBERGLASS PVC (DR 18) REUSE MAINS

INVERT OF PIPE
EL. = 22.4±

AIR RELEASE
VALVE AT STA.
12+53.74 (SEE
SITE AND UTILITY
PLAN)

CONTRACTOR SHALL CONSTRUCT
REUSE MAINS WITH 36" MIN.
COVER FROM FINISHED GRADE
FROM S.R. 16 TO STA. 18+72

AIR RELEASE
VALVE AT STA.
13+78.74 (SEE
SITE AND UTILITY
PLAN)

PROPOSED 8" REUSE MAINS
UNDER EXISTING STORM
(12" MIN. CLEARANCE)

20" STEEL CASINGS WITH
SPACES PER SJCUD SPECS.
(SEE PLAN)

ING 8"
LD
ISTING
U)

07/13/09

A1

27.28

26.80

26.80

11+00

11+50

12+00


12+50

13+00

13+50


14+00


ROAD B

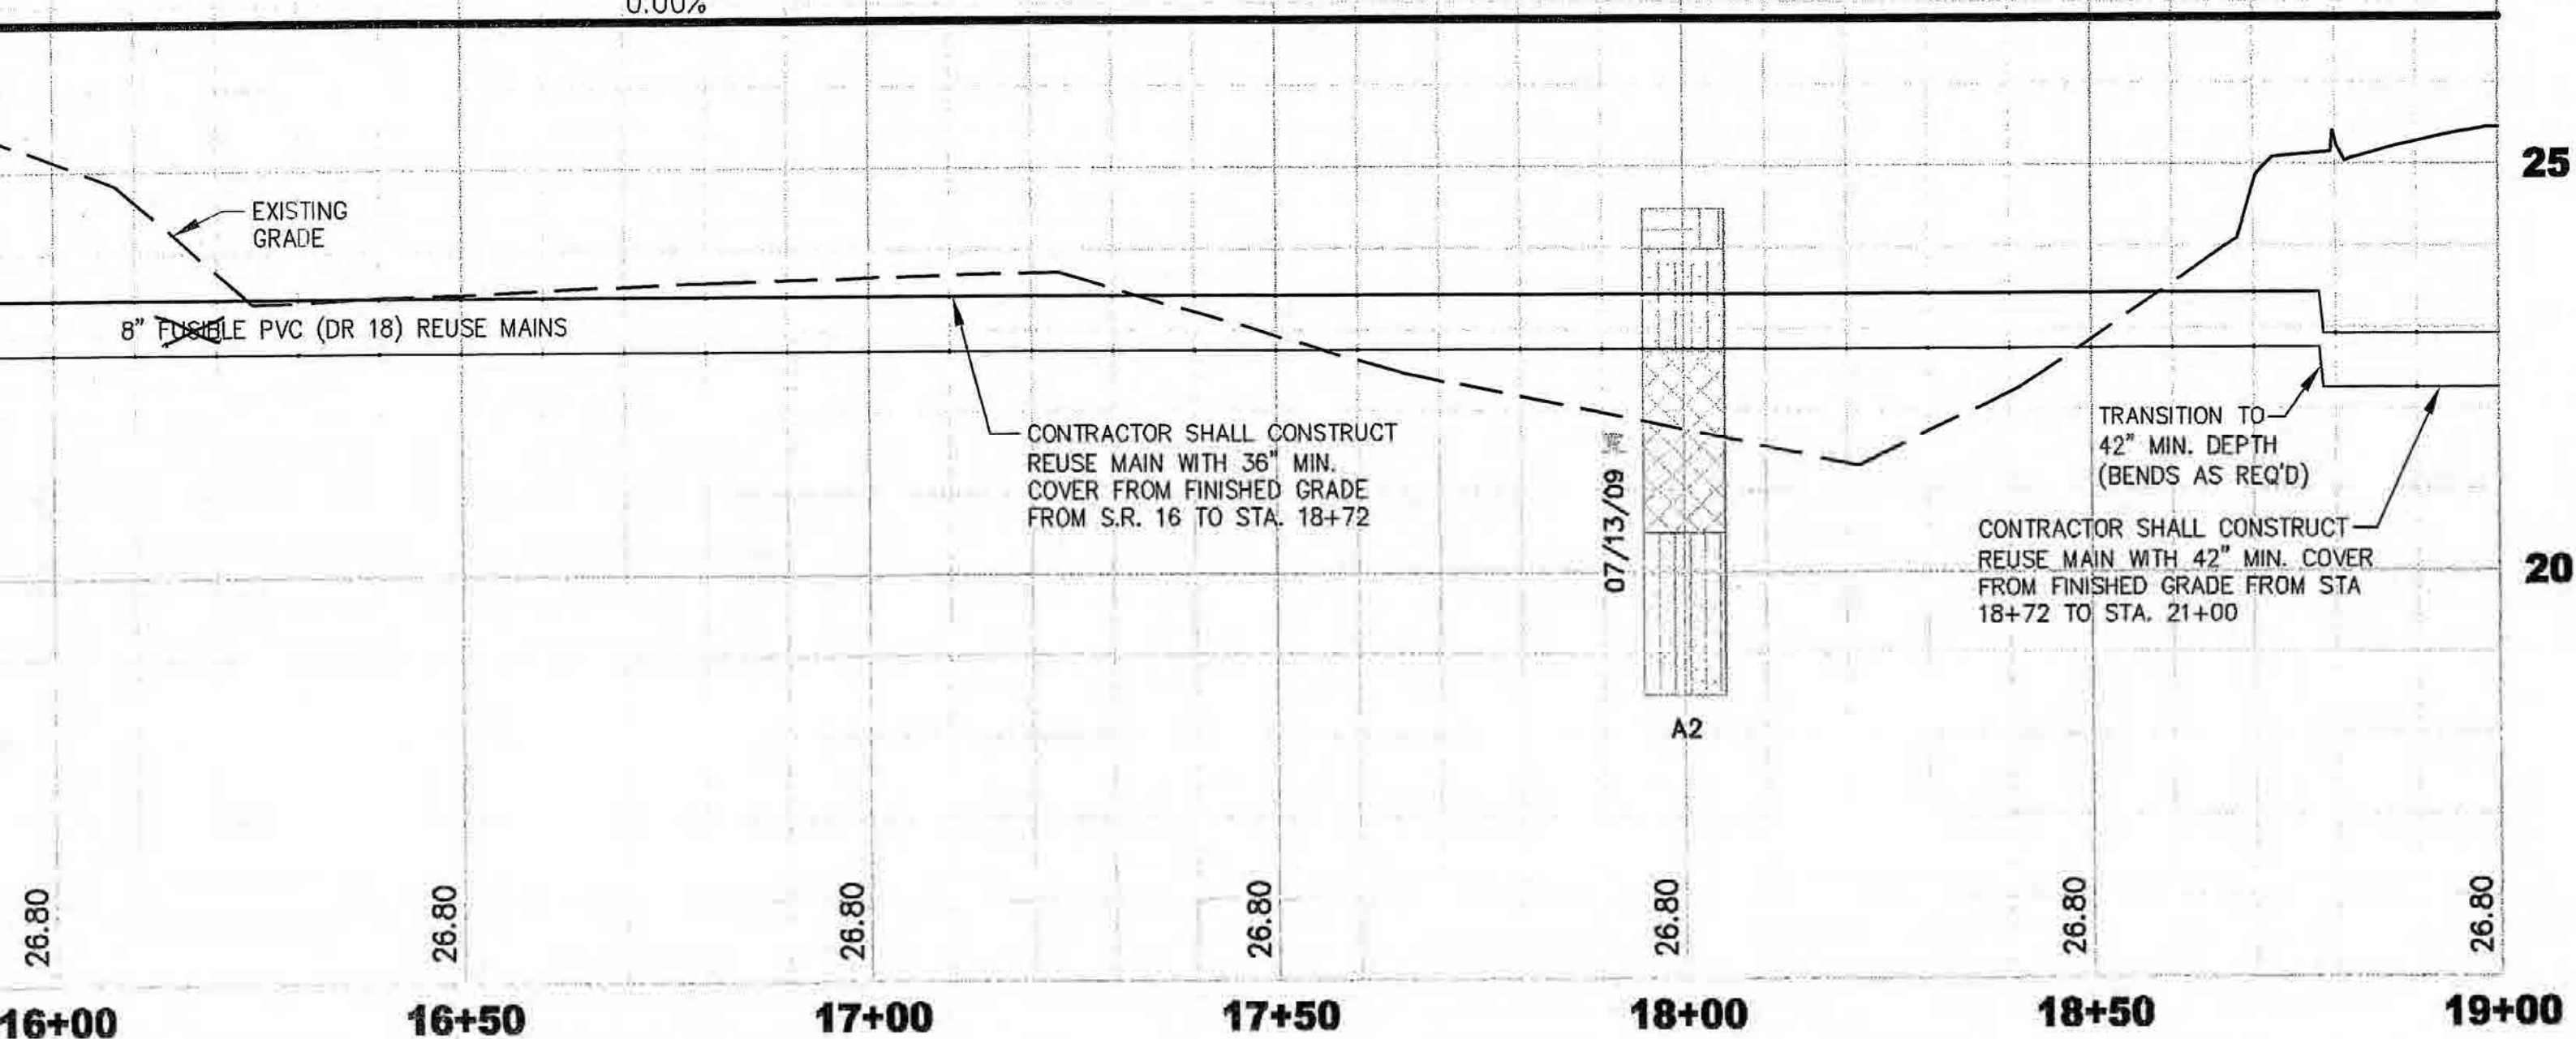

ROAD B

30(14+50.00-19+00.00)

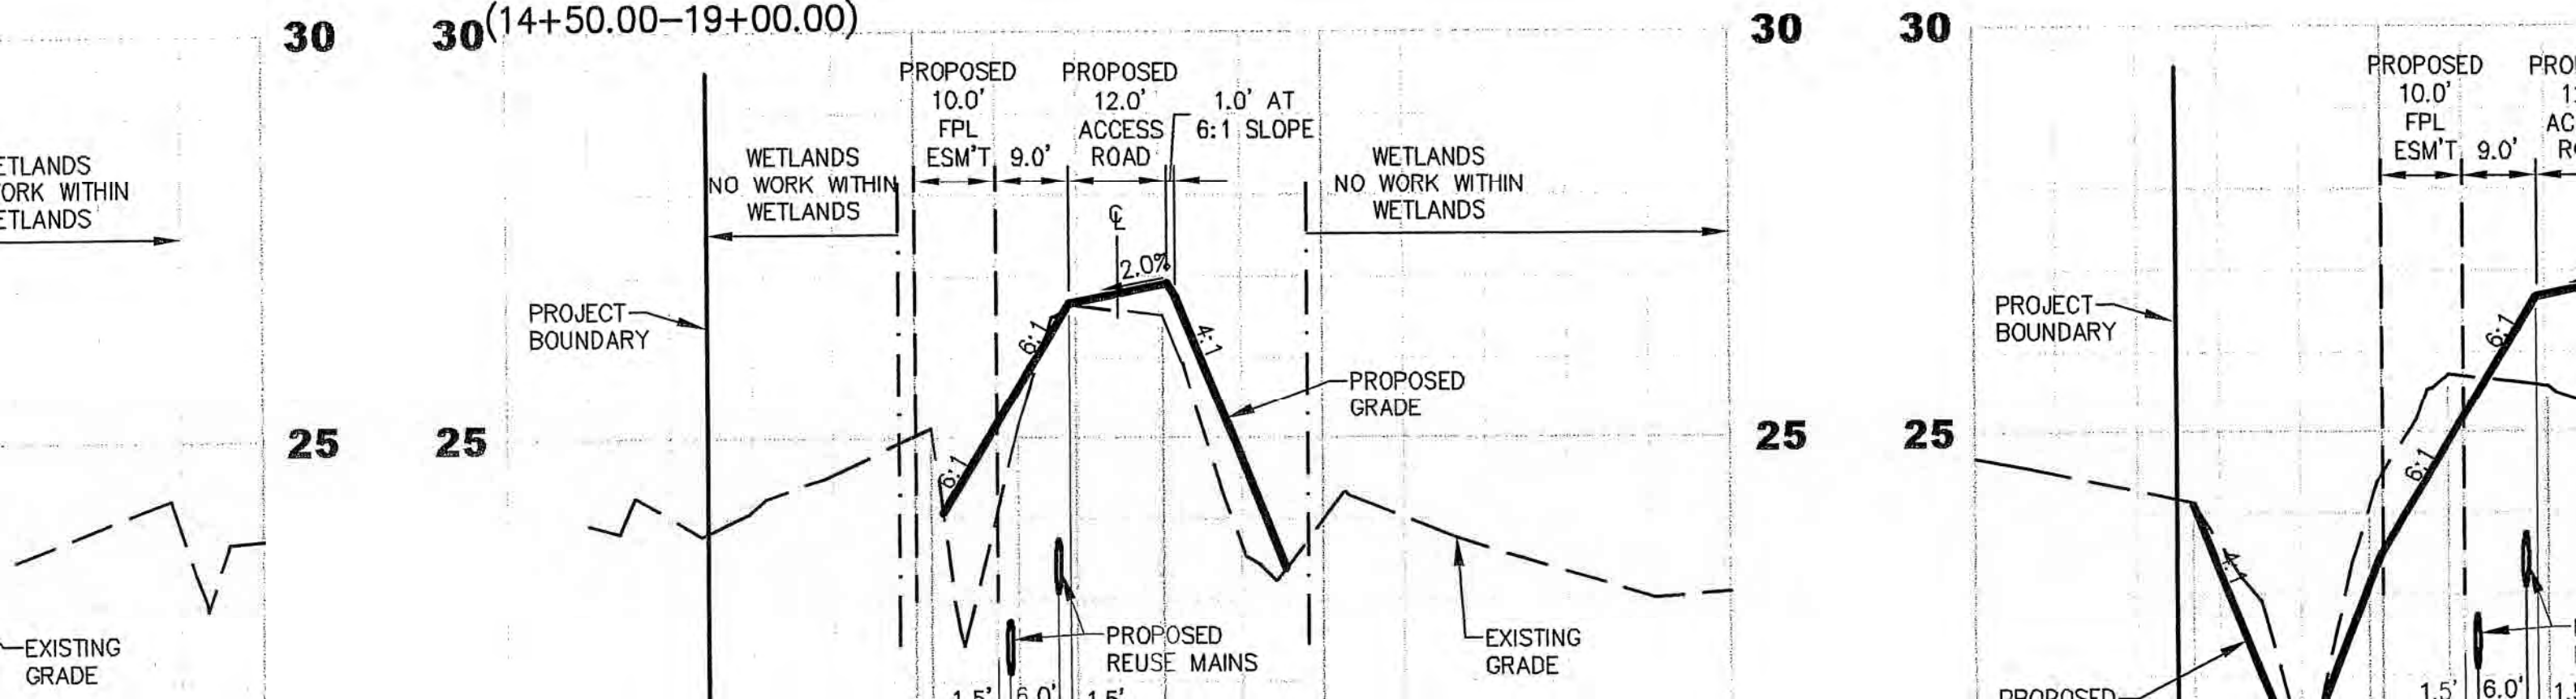

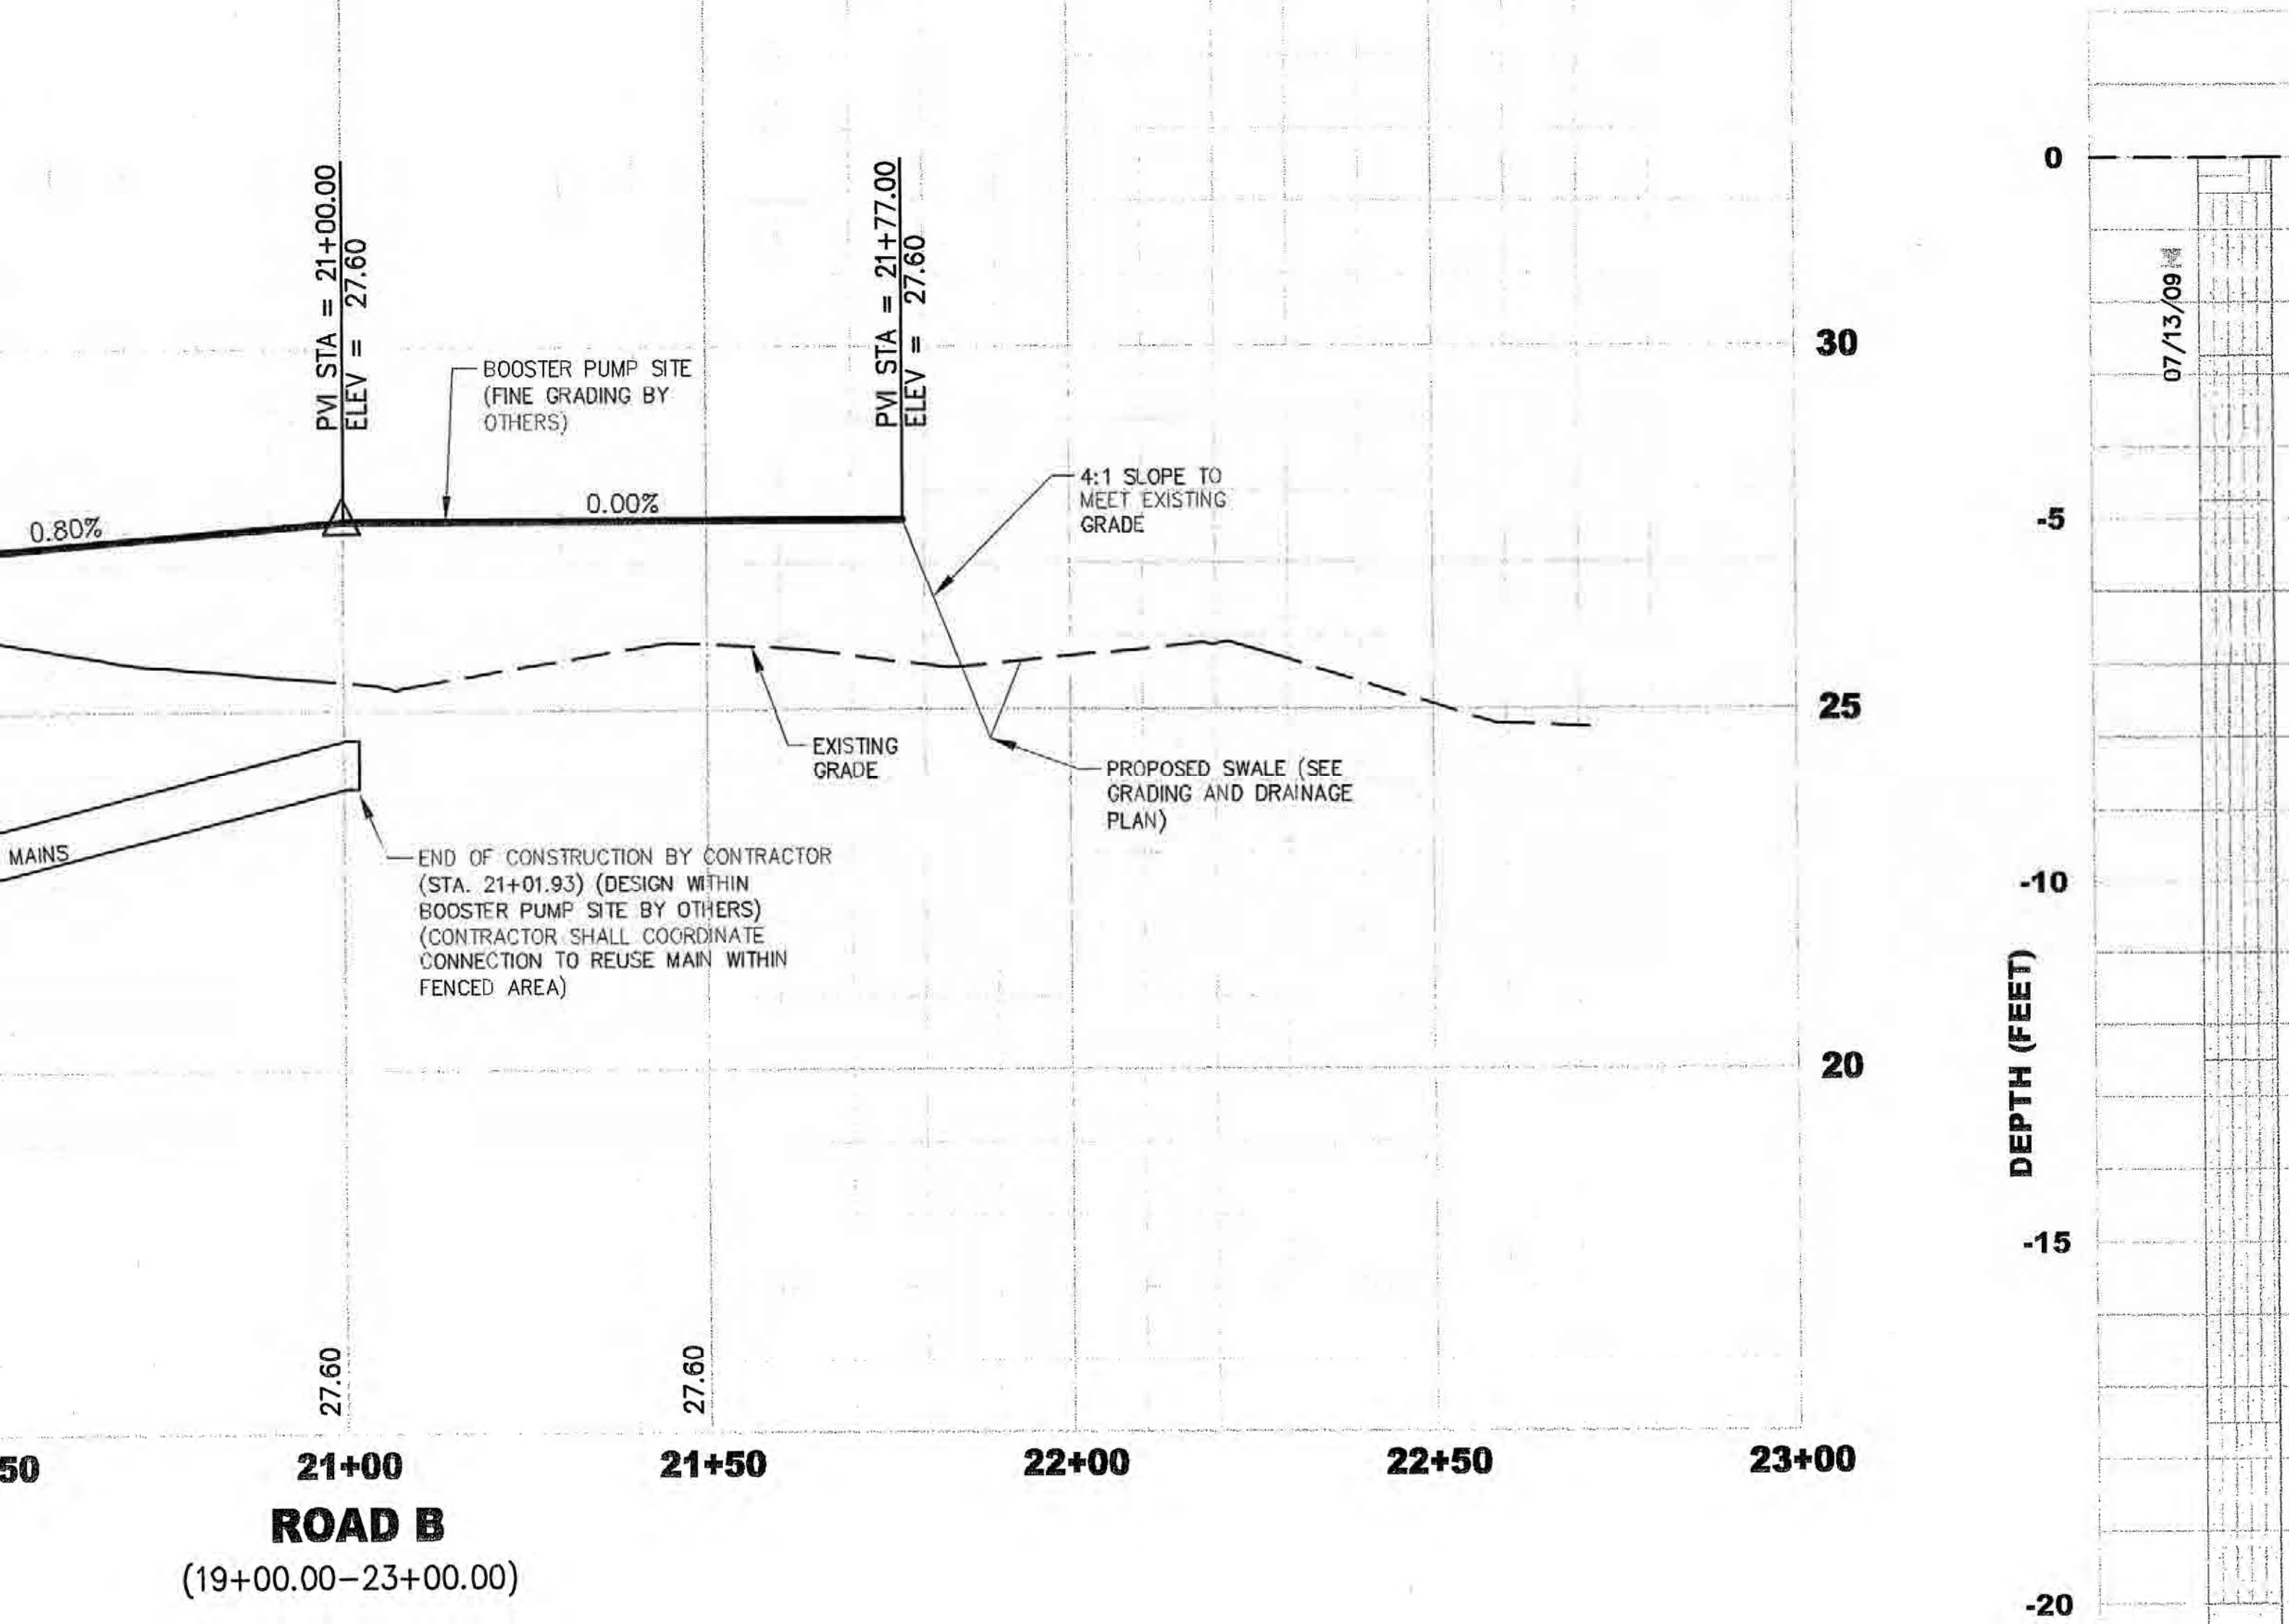


ING
ICES

THE PIPE TO
SIDE OF BEND
ORDANCE WITH
ANICAL
ALL JOINTS
DE OF EXIST.
MECHANICALLY

ING
ICES

3/4" FRICTION COURSE FC-5

3" TYPE SP STRUCTURAL COURSE PLACED IN (2) 1 1/2" LIFTS
(TRAFFIC LEVEL D)

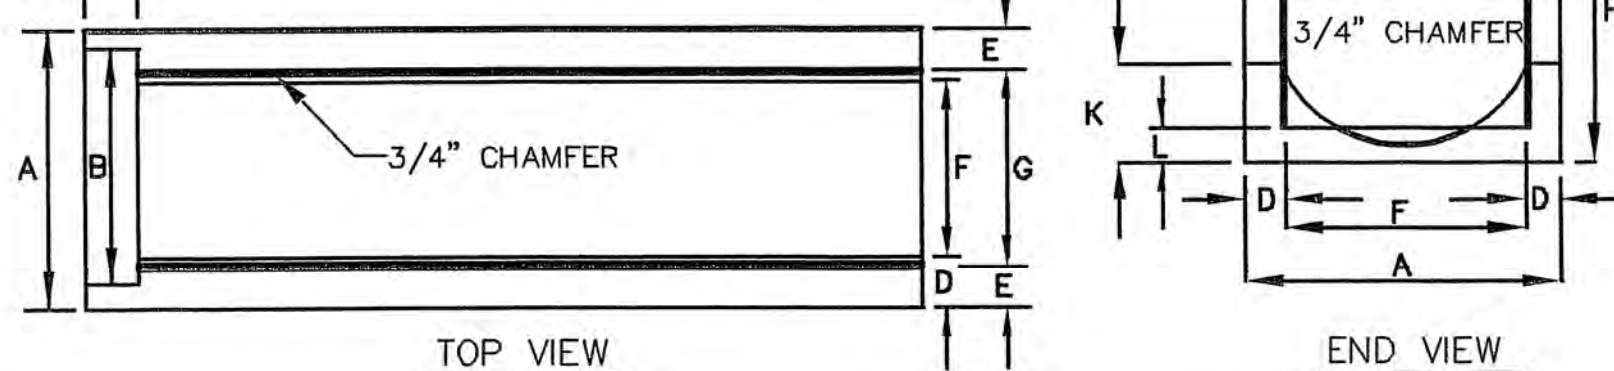

RCP/CMP	A	B	C	D	E	F	G	H	J	K	L	M	N
15" - 18"	2'-7"	2'-1"	6"	6"	6 3/4"	1'-6"	1'-7"	2'-10"	2'-4"	8"	6"	6'-10"	7'-0"
24"	2'-11"	2'-8"	6"	5"	4 1/2"	1'-11"	2'-0"	3'-6"	3'-1"	7 1/2"	5"	10'-0"	10'-3 1/2"
30"	3'-6"	3'-2"	6"	6"	5 1/2"	2'-5"	2'-6 1/2"	3'-9"	3'-5"	7"	5"	11'-5"	11'-8 1/4"
36"	4'-1"	3'-10"	6"	7"	5 1/2"	2'-9"	3'-0"	4'-6"	4'-0"	6"	6"	14'-0"	14'-4 1/2"

NOTES:

- MITERED END SECTION SHALL MATCH SIDE SLOPE OF LAKE BANK.
- PIPE LENGTH SHOWN ON PLANS ARE FROM BACK OF MITERED END SECTION TO CENTER OF STRUCTURE

STANDARD MITERED END SECTION

N.T.S.

CONTRACTOR'S STATEMENT

DATE: 9/11/12
CO. NAME: SEE COVER
ADDRESS: _____
PHONE #: _____

I HEREBY CERTIFY THAT THE MATERIALS USED IN THE CONSTRUCTION OF

☐ PAVEMENT ☐ WATER MAIN
☐ CURB & GUTTER ☐ SANITARY GRAVITY SYSTEM
☐ STORM & DRAINAGE SYSTEM ☐ FORCE MAIN
☐ LIFT STATION

ARE IN ACCORDANCE WITH THE APPROVED PLANS AND CITY SPECIFICATIONS, UNLESS OTHERWISE APPROVED BY THE CITY ENGINEER.

AUTHORIZED SIGNATURE: [Signature]

NOM. PIPE SIZE (IN.)	L = MIN.	
	ELBOW	
	11.25°	22.5°
8	10	10

NOTES:

- MECHANICAL LENGTH AS SHOWN
 - 25' MIN. C
 - (*) 25' MI
 - (**) LENG
 - DISTANCES
 - SEE PLAN
 - RESTRAINED LENGTH CALC
- INPUT:
- PIPE MATER
 - SAFETY FA
 - DEPTH OF
 - GATE VALV

MECH

MILL
3/4"

EXIST.
PAVEMENT

COMPACTED LIMEROCK BA
100, 100% MAXIMUM DEN
UNDER TOLERANCE) (A.A.
T-180) PRIMED ENTIRE W

BA
(SI

JURISDICTIONAL WETLANDS
(CONSERVATION AREA)

SILT FENCE /
LIMITS OF
CLEARING (TYP.)

PROPOSED
ACCESS ROAD

HAY BALE WITH
SILT FENCE IN
EXISTING DITCH

SELECTIVE
CLEARING
(TYP.)

JURISDICTIONAL WETLANDS
(CONSERVATION AREA)

HAY BALE WITH
SILT FENCE IN
EXISTING
ROADSIDE SWALE

STATE ROAD 16
(EXISTING 200' R/W)

S-BUILT

CLEARING
(TYP.)

PROJECT
BOUNDARY

EXISTING
TRAIL ROAD

PROPOSED
ACCESS ROAD

CONTRACTOR'S STATEMENT

DATE: 9/21/12
CO. NAME: SEE COVER
ADDRESS: _____
PHONE #: _____

I HEREBY CERTIFY THAT THE MATERIALS USED IN THE
CONSTRUCTION OF

___ PAVEMENT	___ WATER MAIN
___ CURB & GUTTER	___ SANITARY GRAVITY SYSTEM
___ STORM & DRAINAGE SYSTEM	___ FORCE MAIN
	___ LIFT STATION

ARE IN ACCORDANCE WITH THE APPROVED PLANS AND CITY
SPECIFICATIONS, UNLESS OTHERWISE APPROVED BY THE
CITY ENGINEER.

AUTHORIZED SIGNATURE: _____

KEY MAP
N.T.S.

CLEARING NOTES)

WETLANDS


NATURAL / VEGETATIVE
UPLAND BUFFER

SILT FENCE /
LIMITS OF CLEARING

TREE TO REMAIN

JURISDICTIONAL WETLANDS
(CONSERVATION AREA)


AREA TO BE
CLEARED (TYP.)

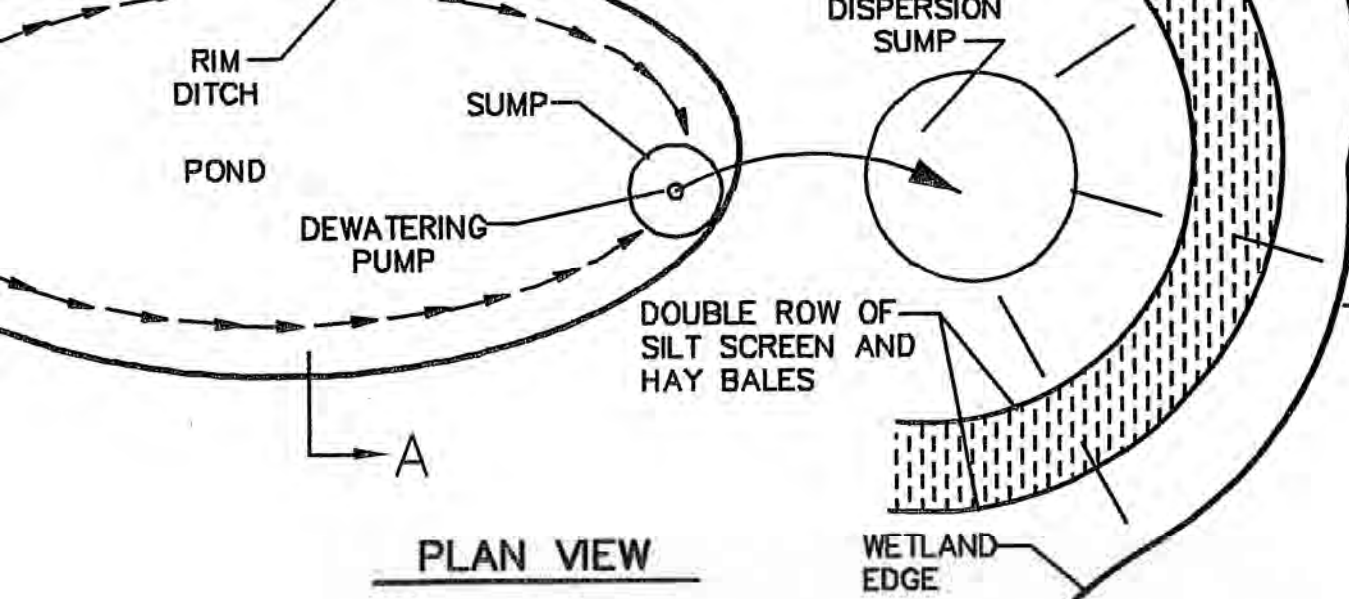

PLAN VIEW


TEMPORARY DEWATERING DETAIL

N.T.S.

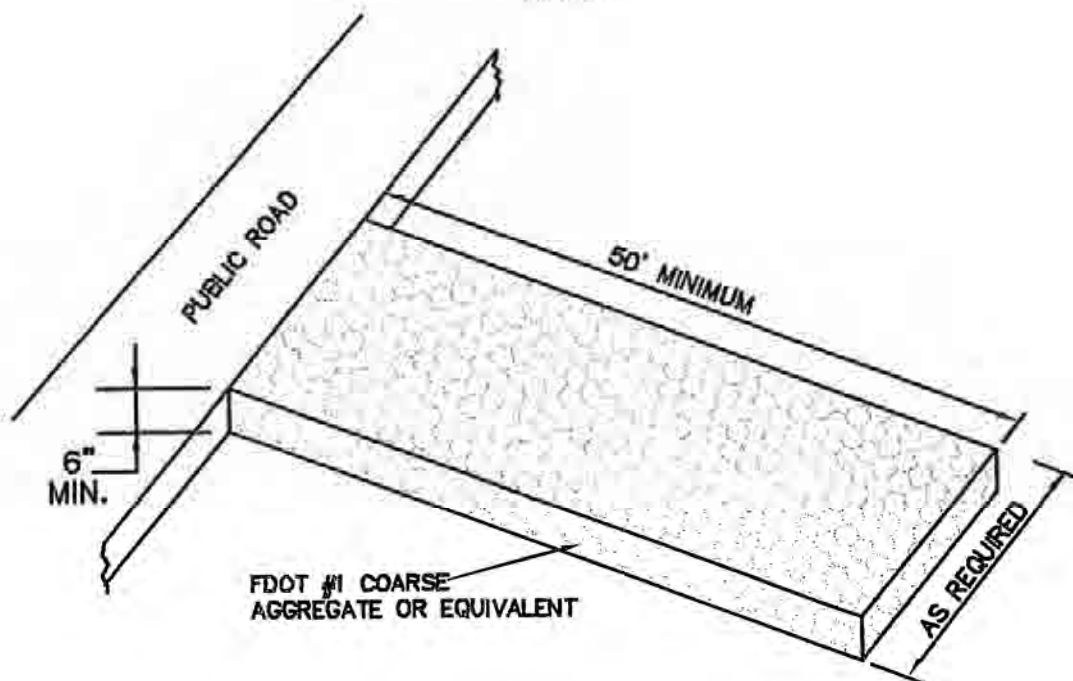


STABILIZED CONSTRUCTION ENTRANCE

N.T.S.

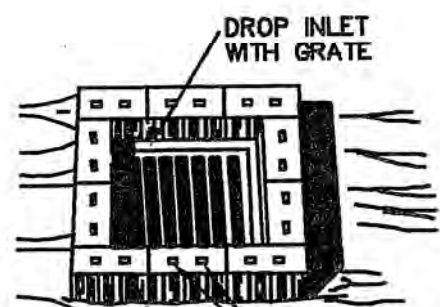


STRAW BALES
STAKED WITH 2
STAKES PER BALE


COMPACTED SOIL
TO PREVENT PIPING
RUNOFF WATER
WITH SEDIMENT

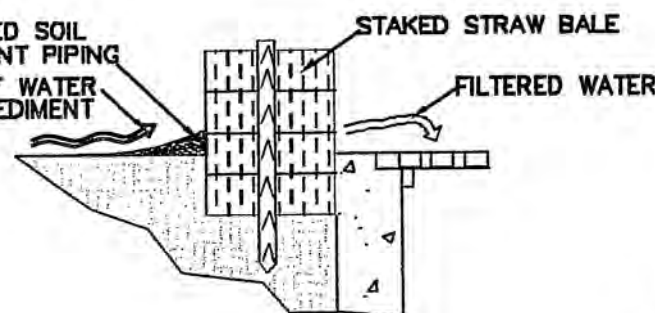

BINDING WIRE OR TWINE

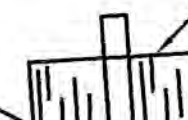


COMPACTED SOIL TO PREVENT PIPING

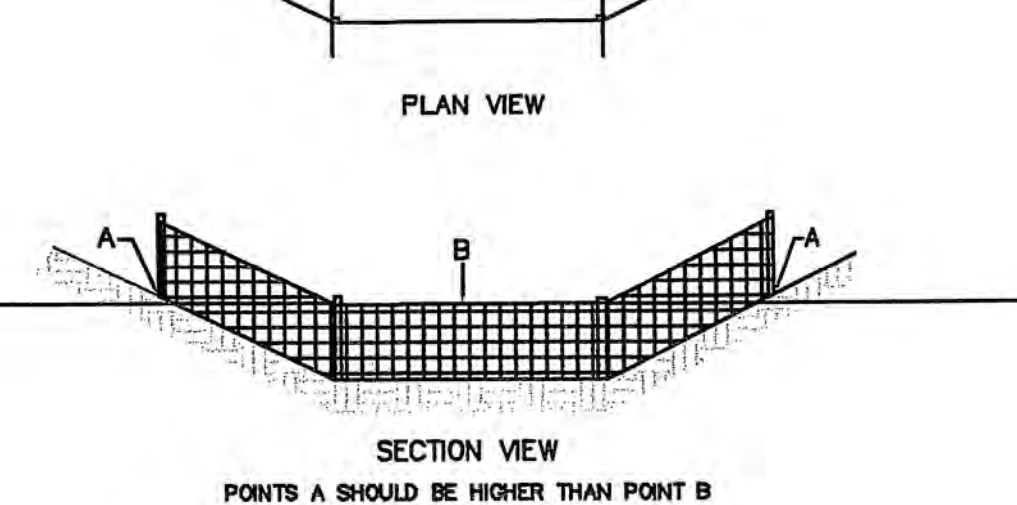

PROPER PLACEMENT OF A FILTER BARRIER IN DRAINAGE WAY

N.T.S.

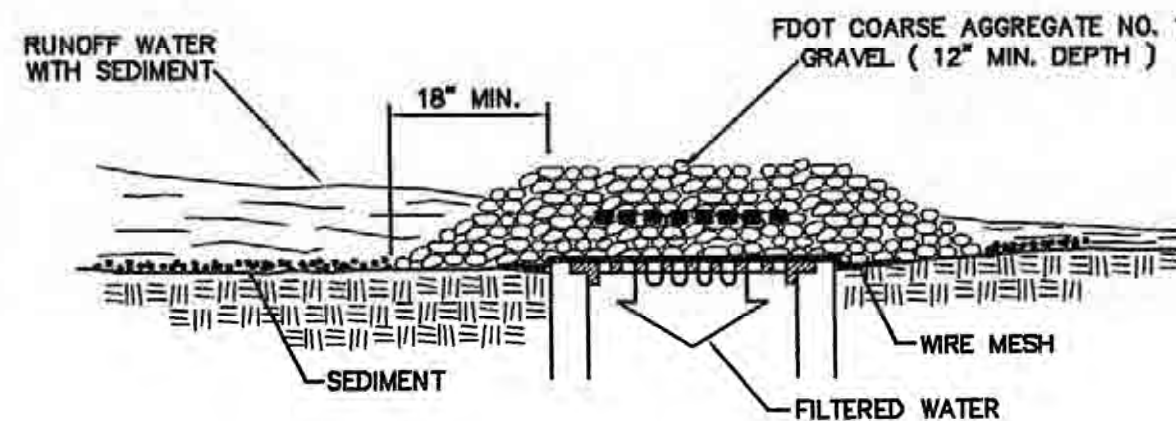


SPECIFIC APPLICATION

THIS METHOD OF INLET PROTECTION IS APPLICABLE WHERE HEAVY CONCENTRATED FLOWS ARE EXPECTED, BUT NOT WHERE PONDING AROUND THE STRUCTURE MIGHT CAUSE EXCESSIVE INCONVENIENCE OR DAMAGE TO ADJACENT STRUCTURES AND UNPROTECTED AREAS.


GRAVEL AND WIRE MESH DROP INLET SEDIMENT FILTER

N.T.S.


1. EXCAVATE THE TRENCH

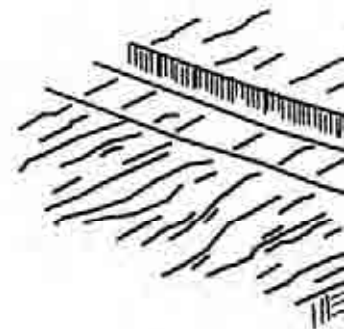

3. WEDGE LOOSE STRAW

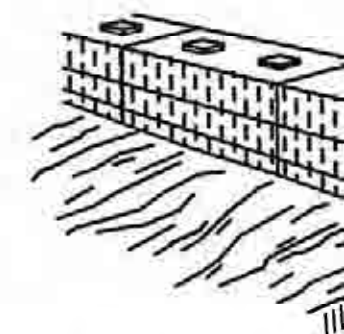

1. SET THE STAKES.

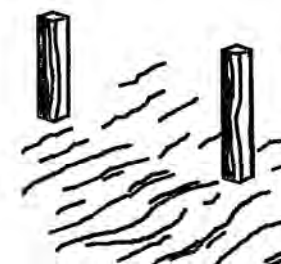

IF REQUIRED SITE IS STABILIZED, REMOVE ANY
Y GRADING TEMPORARY DIVERSION
SWALES/DIKES AND RESEED/SOD
REAS AND AS REQUIRED
AS

ONSTRUCTION OF THE BUILDING WILL BE TAKING
ING ALL THE SEQUENCE STEPS LISTED ABOVE

ING OF CONTROLS/MEASURES

ENCE OF MAJOR ACTIVITIES, THE SILT FENCES AND
STRUCTION ENTRANCE AND SEDIMENT BASIN WILL BE
EARING OR GRADING OF ANY OTHER PORTIONS OF
ASURES SHALL BE INITIATED AS SOON AS PRACTICAL
WHERE CONSTRUCTION ACTIVITIES HAVE TEMPORARILY
ONCE CONSTRUCTION ACTIVITY CEASES PERMANENTLY
LL BE STABILIZED PERMANENTLY IN ACCORDANCE
E ENTIRE SITE IS STABILIZED, THE ACCUMULATED
FROM THE SEDIMENT TRAPS AND THE EARTH
ADED/REMOVED AND STABILIZED IN ACCORDANCE
MENT AND EROSION CONTROL PLAN (DRAWING NO.

CONTROLS

RESPONSIBILITY TO IMPLEMENT THE EROSION AND
OWN ON THE SEDIMENT AND EROSION CONTROL PLAN.
ORS RESPONSIBILITY TO ENSURE THESE CONTROLS ARE
MAINTAINED AND FUNCTIONING PROPERLY TO PREVENT
ER FROM LEAVING THE PROJECT SITE. THE CONTRACTOR
AND TURBIDITY CONTROLS SHOWN ON THE SEDIMENT
AN AND ADD ADDITIONAL CONTROL MEASURES, AS
SITE MEETS ALL FEDERAL, STATE AND LOCAL EROSION
REQUIREMENTS. ANY CHANGES OR ADDITIONS TO THE
CONTROL PLAN MUST BE NOTED ON THE CONTRACTOR'S
DATE AND TIME IMPLEMENTED. THE FOLLOWING BEST
WILL BE IMPLEMENTED BY THE CONTRACTOR AS REQUIRED
MENT CONTROL PLAN AND AS REQUIRED TO MEET THE
REQUIREMENTS IMPOSED ON THE PROJECT SITE BY THE

CONTROLS

STRAW BALE BARRIERS CAN BE USED BELOW
JECT TO SHEET AND RILL EROSION WITH THE
:
UM SLOPE BEHIND THE BARRIER IS 33 PERCENT.
OR DITCH LINES WHERE THE MAXIMUM
MINAGE AREA IS NO GREATER THAN 2 ACRES.
ESS IS REQUIRED FOR LESS THAN 3 MONTHS.
OULD BE MADE TO LIMIT THE USE OF STRAW BALE
UCTED IN LIVE STREAMS OR IN SWALES WHERE
SSIBILITY OF A WASHOUT. IF NECESSARY, MEASURES
TO PROPERLY ANCHOR BALES TO INSURE
T.

: FILTER FABRIC BARRIERS CAN BE USED BELOW
JECT TO SHEET AND RILL EROSION WITH THE
:
UM SLOPE BEHIND THE BARRIER IS 33 PERCENT.
OR DITCH LINES WHERE THE MAXIMUM
MINAGE AREA IS NO GREATER THAN 2 ACRES.

ILTER FABRIC: BRUSH BARRIER MAY BE USED

11. TEMPORARY REGRASSING : IF, AFTER 14 DAYS FROM SEEDING, THE TEMPORARY GRASSED AREAS HAVE NOT ATTAINED A MINIMUM OF 75 PERCENT GOOD GRASS COVER, THE AREA WILL BE REWORKED AND ADDITIONAL SEED APPLIED SUFFICIENT TO ESTABLISH THE DESIRED VEGETATIVE COVER.
12. MAINTENANCE: ALL FEATURES OF THE PROJECT DESIGNED AND CONSTRUCTED TO PREVENT EROSION AND SEDIMENT SHALL BE MAINTAINED DURING THE LIFE OF THE CONSTRUCTION SO AS TO FUNCTION AS THEY WERE ORIGINALLY DESIGNED AND CONSTRUCTED.
13. PERMANENT EROSION CONTROL: THE EROSION CONTROL FACILITIES OF THE PROJECT SHOULD BE DESIGNED TO MINIMIZE THE IMPACT ON THE OFFSITE FACILITIES.
14. PERMANENT SEEDING: ALL AREAS WHICH HAVE BEEN DISTURBED BY CONSTRUCTION WILL, AS A MINIMUM, BE SEED. THE SEEDING MIX MUST PROVIDE BOTH LONG-TERM VEGETATION AND RAPID GROWTH SEASONAL VEGETATION. SLOPES STEEPER THAN 4:1 SHALL BE SEED AND MULCHED OR SODDED.

STRUCTURAL PRACTICES

1. TEMPORARY DIVERSION DIKE: TEMPORARY DIVERSION DIKES MAY BE USED TO DIVERT RUNOFF THROUGH A SEDIMENT-TRAPPING FACILITY.
2. TEMPORARY SEDIMENT TRAP: A SEDIMENT TRAP IS USUALLY INSTALLED IN AN DRAINAGEWAY AT A STORM DRAIN INLET OR AT OTHER POINTS OF DISCHARGE FROM A DISTURBED AREA WITH THE FOLLOWING LIMITATIONS:
A. THE SEDIMENT TRAP MAY BE CONSTRUCTED EITHER INDEPENDENTLY OR IN CONJUNCTION WITH A TEMPORARY DIVERSION DIKE.
3. OUTLET PROTECTION: APPLICABLE TO THE OUTLETS OF ALL PIPES AND PAVED CHANNEL SECTIONS WHERE THE VELOCITY OF FLOW AT DESIGN CAPACITY OF THE OUTLET WILL EXCEED THE PERMISSIBLE VELOCITY OF THE RECEIVING CHANNEL OR AREA.
4. SEDIMENT BASIN: WILL BE CONSTRUCTED AT THE COMMON DRAINAGE LOCATIONS THAT SERVE AN AREA WITH 10 OR MORE DISTURBED ACRES AT ONE TIME, THE PROPOSED STORM WATER PONDS (OR TEMPORARY PONDS) WILL BE CONSTRUCTED FOR USE AS SEDIMENT BASINS. THESE SEDIMENT BASINS MUST PROVIDE A MINIMUM OF 3,600 CUBIC FEET OF STORAGE PER ACRE DRAINED UNTIL FINAL STABILIZATION OF THE SITE. THE 3,600 CUBIC FEET OF STORAGE AREA PER ACRE DRAINED DOES NOT APPLY TO FLOWS FROM OFFSITE AREAS AND FLOWS FROM ONSITE AREAS THAT ARE EITHER UNDISTURBED OR HAVE UNDERGONE FINAL STABILIZATION WHERE SUCH FLOWS ARE DIVERTED AROUND BOTH THE DISTURBED AREA AND THE SEDIMENT BASIN. ANY TEMPORARY SEDIMENT BASINS CONSTRUCTED MUST BE BACKFILLED AND COMPACTED IN ACCORDANCE WITH THE SPECIFICATIONS FOR STRUCTURAL FILL. ALL SEDIMENT COLLECTED IN PERMANENT OR TEMPORARY SEDIMENT TRAPS MUST BE REMOVED UPON FINAL STABILIZATION.

OTHER CONTROLS

WASTE DISPOSAL

WASTE MATERIALS

ALL WASTE MATERIALS EXCEPT LAND CLEARING DEBRIS SHALL BE COLLECTED

- * PRODUCTS WILL BE KEPT IN THEIR ORIGINAL CONTAINERS WITH THE ORIGINAL MANUFACTURER'S LABEL.
- * SUBSTANCES WILL NOT BE MIXED WITH ONE ANOTHER UNLESS RECOMMENDED BY THE MANUFACTURER.
- * WHENEVER POSSIBLE, ALL OF A PRODUCT WILL BE USED UP BEFORE DISPOSING OF THE CONTAINER.
- * MANUFACTURER'S RECOMMENDATIONS FOR PROPER USE AND DISPOSAL WILL BE FOLLOWED.
- * THE SITE SUPERINTENDENT WILL INSPECT DAILY TO ENSURE MATERIALS ONSITE RECEIVE PROPER USE AND DISPOSAL.

HAZARDOUS PRODUCTS

THESE PRACTICES ARE USED TO REDUCE THE RISKS ASSOCIATED WITH HAZARDOUS MATERIALS.

- * PRODUCTS WILL BE KEPT IN ORIGINAL CONTAINERS UNLESS THEY ARE NOT RESEALABLE.
- * ORIGINAL LABELS AND MATERIAL SAFETY DATA WILL BE RETAINED; THEY CONTAIN IMPORTANT PRODUCT INFORMATION.
- * IF SURPLUS PRODUCT MUST BE DISPOSED OF, MANUFACTURER'S OR LOCAL AND STATE RECOMMENDED METHODS FOR PROPER DISPOSAL WILL BE FOLLOWED.

PRODUCT SPECIFIC PRACTICES

THE FOLLOWING PRODUCT SPECIFIC PRACTICES WILL BE FOLLOWED ONSITE:

PETROLEUM PRODUCTS

ALL ONSITE VEHICLES WILL BE MONITORED FOR LEAKS AND RECEIVE REGULAR PREVENTIVE MAINTENANCE TO REDUCE THE CHANCE OF LEAKAGE. PETROLEUM PRODUCTS WILL BE STORED IN TIGHTLY SEALED CONTAINERS WHICH ARE CLEARLY LABELED. ANY ASPHALT SUBSTANCES USED ONSITE WILL BE APPLIED ACCORDING TO THE MANUFACTURER'S RECOMMENDATIONS.

FERTILIZERS

FERTILIZERS USED WILL BE APPLIED ONLY IN THE MINIMUM AMOUNTS RECOMMENDED BY THE MANUFACTURER. ONCE APPLIED, FERTILIZER WILL BE WORKED INTO THE SOIL TO LIMIT EXPOSURE TO STORM WATER. STORAGE WILL BE IN A COVERED AREA. THE CONTENTS OF ANY PARTIALLY USED BAGS OF FERTILIZER WILL BE TRANSFERRED TO A SEALABLE PLASTIC BIN TO AVOID SPILLS.

PAINTS

ALL CONTAINERS WILL BE TIGHTLY SEALED AND STORED WHEN NOT REQUIRED FOR USE. EXCESS PAINT WILL NOT BE DISCHARGED TO THE STORM SEWER SYSTEM BUT WILL BE PROPERLY DISPOSED OF ACCORDING TO MANUFACTURERS' INSTRUCTIONS OR STATE AND LOCAL REGULATIONS.

CONCRETE TRUCKS

CONCRETE TRUCKS WILL NOT BE ALLOWED TO WASH OUT OR DISCHARGE SURPLUS CONCRETE OR DRUM WASH WATER ON THE SITE.

SPILL CONTROL PRACTICES

IN ADDITION TO THE GOOD HOUSEKEEPING AND MATERIAL MANAGEMENT PRACTICES DISCUSSED IN THE PREVIOUS SECTIONS OF THIS PLAN, THE FOLLOWING PRACTICES WILL BE FOLLOWED FOR SPILL PREVENTION AND CLEANUP:

MANUFACTURERS' RECOMMENDED METHODS FOR SPILL CLEANUP WILL BE CLEARLY POSTED ON SITE AND SITE PERSONNEL WILL BE MADE AWARE OF THE PROCEDURES AND THE LOCATION OF THE INFORMATION AND CLEANUP SUPPLIES.

MATERIALS AND EQUIPMENT NECESSARY FOR SPILL CLEANUP WILL BE KEPT IN THE MATERIAL STORAGE AREA ONSITE. EQUIPMENT AND MATERIALS WILL

INCLUDE BUT NOT BE LIMITED TO BROOMS, DUST PANS, MOPS, RAGS, GLOVES, GOGGLES, LIQUID ABSORBENT (I.e. KITTY LITTER OR EQUAL), SAND, SAWDUST, AND PLASTIC AND METAL TRASH CONTAINERS SPECIFICALLY FOR THIS PURPOSE.

UTILIZATION MEASURES

DATE OF NEXT TURBANCE	STABILIZED ? (YES/NO)	STABILIZED WITH	CONDITION

ON OR BEFORE _____

EUSE BOOSTER PUMP STATION

POLLUTION PREVENTION PLAN AND MAINTENANCE REPORT FORM

SEDIMENT BASIN

ENT	ANY EVIDENCE OF OVERTOPPING OF THE EMBANKMENT ?	CONDITION OF OUTFALL FROM SEDIMENT BASIN

ON OR BEFORE _____

IN: _____

OTHER CONTROLS

DOES ALL TRAFFIC IS THE CULVERT

TO BE PERFORMED BY:

CATCH BASIN/CURB INLET/OUTFAL

STRUCTURE/ OUTFALL	ARE TURBIDITY CONTROLS IN PLACE	ANY EVIDENCE OF CLOGGING/WASHOUT OR BYPASSING ?

MAINTENANCE REQUIRED FOR CATCH BASIN/CURB INLETS/

TO BE PERFORMED BY:

TURNBULL IN-LINE REUSE B

STORM WATER POLLUTION INSPECTION AND MAINTENANCE

CHANGES REQUIRED TO THE POLLUTION PREVENTION PLAN:

REASONS FOR CHANGES:

PARCEL
BOUNDARY

STATE ROAD 16
(EXISTING 200' R/W)

PARCEL
BOUNDARY

WETLAND IMPACT
A1 = 0.08 AC.±

WETLAND IMPACT
B2 = 0.01 AC.±

PROPOSED
ACCESS
ROAD

WETLAND CUT
DITCH IMPACT
B3 = 0.10 AC.±


JURISDICTIONAL WETLANDS
(CONSERVATION AREA)
(TO REMAIN)
(0.20 AC.±)

AS-BUILT

CONTRACTOR'S STATEMENT

DATE: 9/21/12
CO. NAME: SEE COVER
ADDRESS:

AS-BUILT

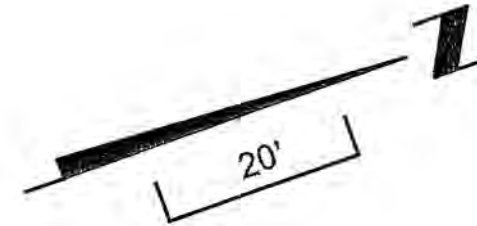

CONTRACTOR'S STATEMENT

DATE: 9/24/12
CO. NAME: SEE COVER
ADDRESS: _____
PHONE #: _____

I HEREBY CERTIFY THAT THE MATERIALS USED IN THE CONSTRUCTION OF

<input type="checkbox"/> PAVEMENT	<input type="checkbox"/> WATER MAIN
<input type="checkbox"/> CURB & GUTTER	<input type="checkbox"/> SANITARY GRAVITY SYSTEM
<input type="checkbox"/> STORM & DRAINAGE SYSTEM	<input type="checkbox"/> FORCE MAIN
	<input type="checkbox"/> LIFT STATION

ARE IN ACCORDANCE WITH THE APPROVED PLANS AND CITY SPECIFICATIONS, UNLESS OTHERWISE APPROVED BY THE CITY ENGINEER.

AUTHORIZED SIGNATURE: _____

PROJECT
BOUNDARY

PROPOSED
ACCESS
ROAD

WETLAND CUT
DITCH IMPACT
A2 = 0.12 AC.±

EXTENTS OF
IMPACTS (TYP.)

WETLAND IMPACT
A3 = 0.02 AC.±

UP
DESCRIP
IMPACT
TOTAL

ANS. THE CONTRACTOR SHALL RESPOND
ED BY THE PROJECT ENGINEER WITHOUT
CONTRACTOR SHALL ALSO RESPOND WITHIN
E PROJECT ENGINEER TO ANY REQUESTS
DIFICATION TO THE TRAFFIC CONTROL PLAN

ONLY AND DO NOT REPRESENT

XCEPT FLAGGERS) AND THEIR ACTIVITIES
SIDE OF THE PAVEMENT.

MAINTAINED AT ALL TIMES.

ALL NOT BE ALLOWED BETWEEN THE
5:00 PM TO 7:00 PM. ANY NIGHT TIME
RESENCE OF AN OFF-DUTY LAW
ATROL CAR.

ING CONDITIONS AT PROJECT BEGINNING
NEER.

ST MOUNTED. WHEN NO WORK IS BEING
N TO TWO-WAY TRAFFIC, THE "ONE-LANE
FULLY COVERED.

ONTRACTOR SHALL REFER TO STANDARD

MENT OF TRANSPORTATION (FDOT)
Y THE LATEST FDOT DESIGN STANDARDS

INDEX NO. 603.

2. TIE IN PROPOSED REUSE MAINS TO EXISTING REUSE MAIN AS SHOWN IN THE T.C.P. (SEE SHEET
NO. 13).

3. PROVIDING SMOOTH TRANSITION, TIE ROAD BACK TO EXISTING STATE ROAD 16 AS SHOWN IN THE
T.C.P. (SEE SHEET NO. 13).

4. RESTORE AREA TO PRE-CONSTRUCTION (OR BETTER) CONDITIONS.


PHASE III (NO PLANS)

1. MILL AND RESURFACE SR 16 (SEE THE LIMITS AS SHOWN ON SHEET NO. 3A)

2. FOR PLACEMENT OF TRAFFIC CONTROL DEVICES REFER TO PHASES I AND II (AND F.D.O.T.
STANDARD INDEX NO. 603).

3. PLACE PERMANENT PAVEMENT MARKINGS ON SR 16 (AS SHOWN ON SHEET NO. 3A). REFER TO
F.D.O.T. STANDARD INDEX NO. 607.

AS-BUILT

CONTRACTOR'S STATEMENT	
DATE:	9/21/12
CO. NAME:	SEE COVER
ADDRESS:	
PHONE #:	
I HEREBY CERTIFY THAT THE MATERIALS USED IN THE CONSTRUCTION OF	
<input type="checkbox"/> PAVEMENT	<input type="checkbox"/> WATER MAIN
<input type="checkbox"/> CURB & GUTTER	<input type="checkbox"/> SANITARY GRAVITY SYSTEM
<input type="checkbox"/> STORM & DRAINAGE SYSTEM	<input type="checkbox"/> FORCE MAIN <input type="checkbox"/> LIFT STATION
ARE IN ACCORDANCE WITH THE APPROVED PLANS AND CITY SPECIFICATIONS, UNLESS OTHERWISE APPROVED BY THE CITY ENGINEER.	
AUTHORIZED SIGNATURE:	


ON

PHASE II T.C.P. TYPICAL SECTION

N.T.S.

TYPE I OR TYPE II BARRICADES OR
DRUMS ON TAPER SHALL BE 20'.

DRUMS ON TANGENT SHALL BE 50'.

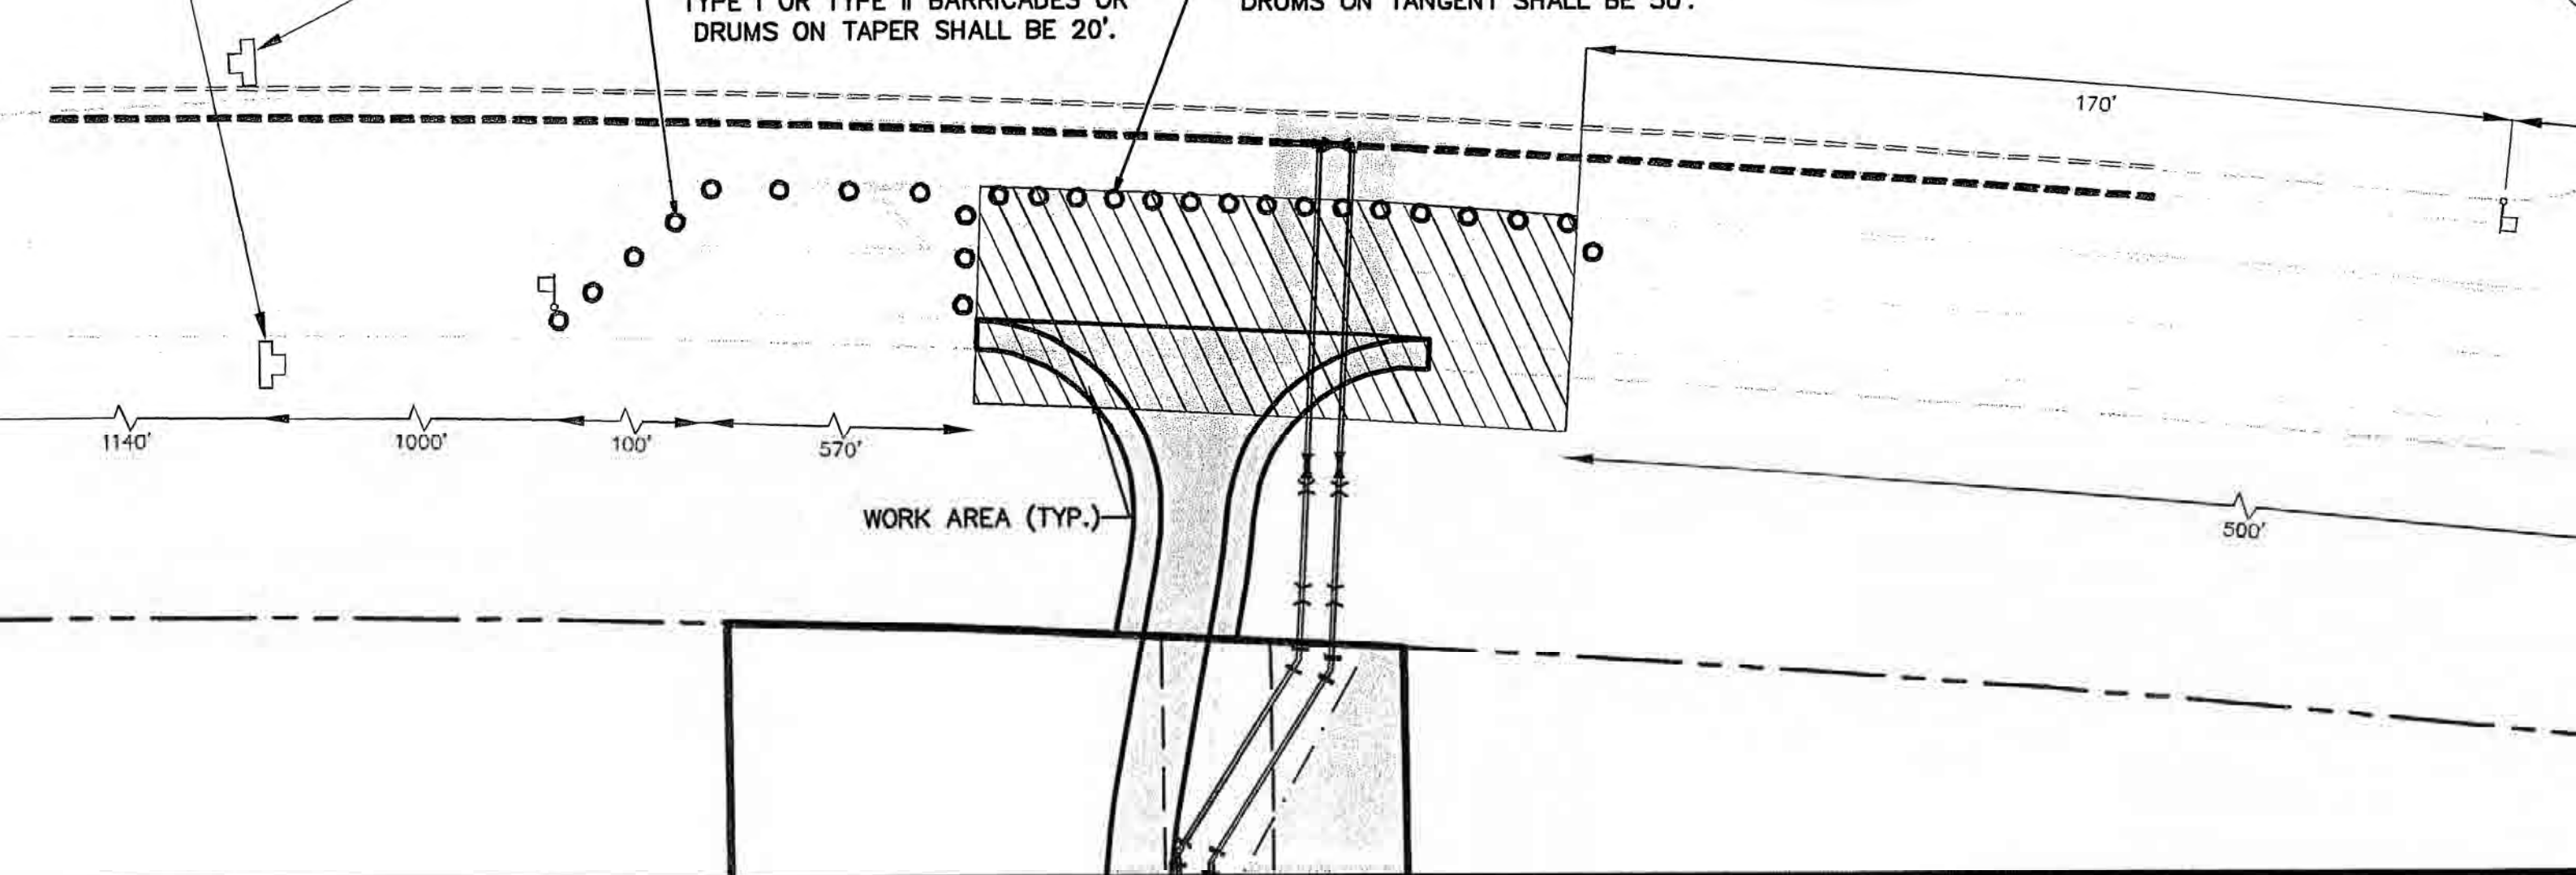

PHASE II


TOR'S STATEMENT

HAT THE MATERIALS USED IN THE

___ WATER MAIN
___ SANITARY GRAVITY SYSTEM
___ FORCE MAIN
___ LIFT STATION



E WITH THE APPROVED PLANS AND CITY
LESS OTHERWISE APPROVED BY THE

URE: 

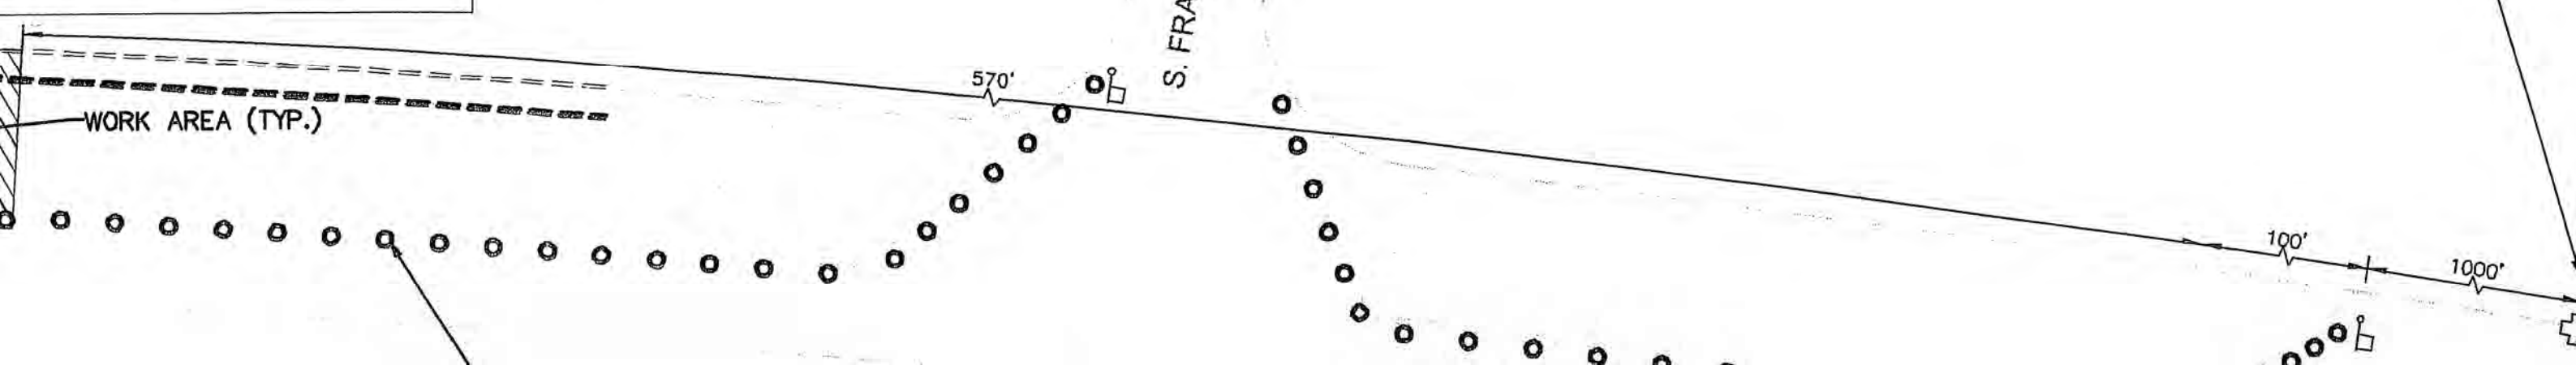

2014 MSW Watermain Interconnect State Road 16 As Built Drawings



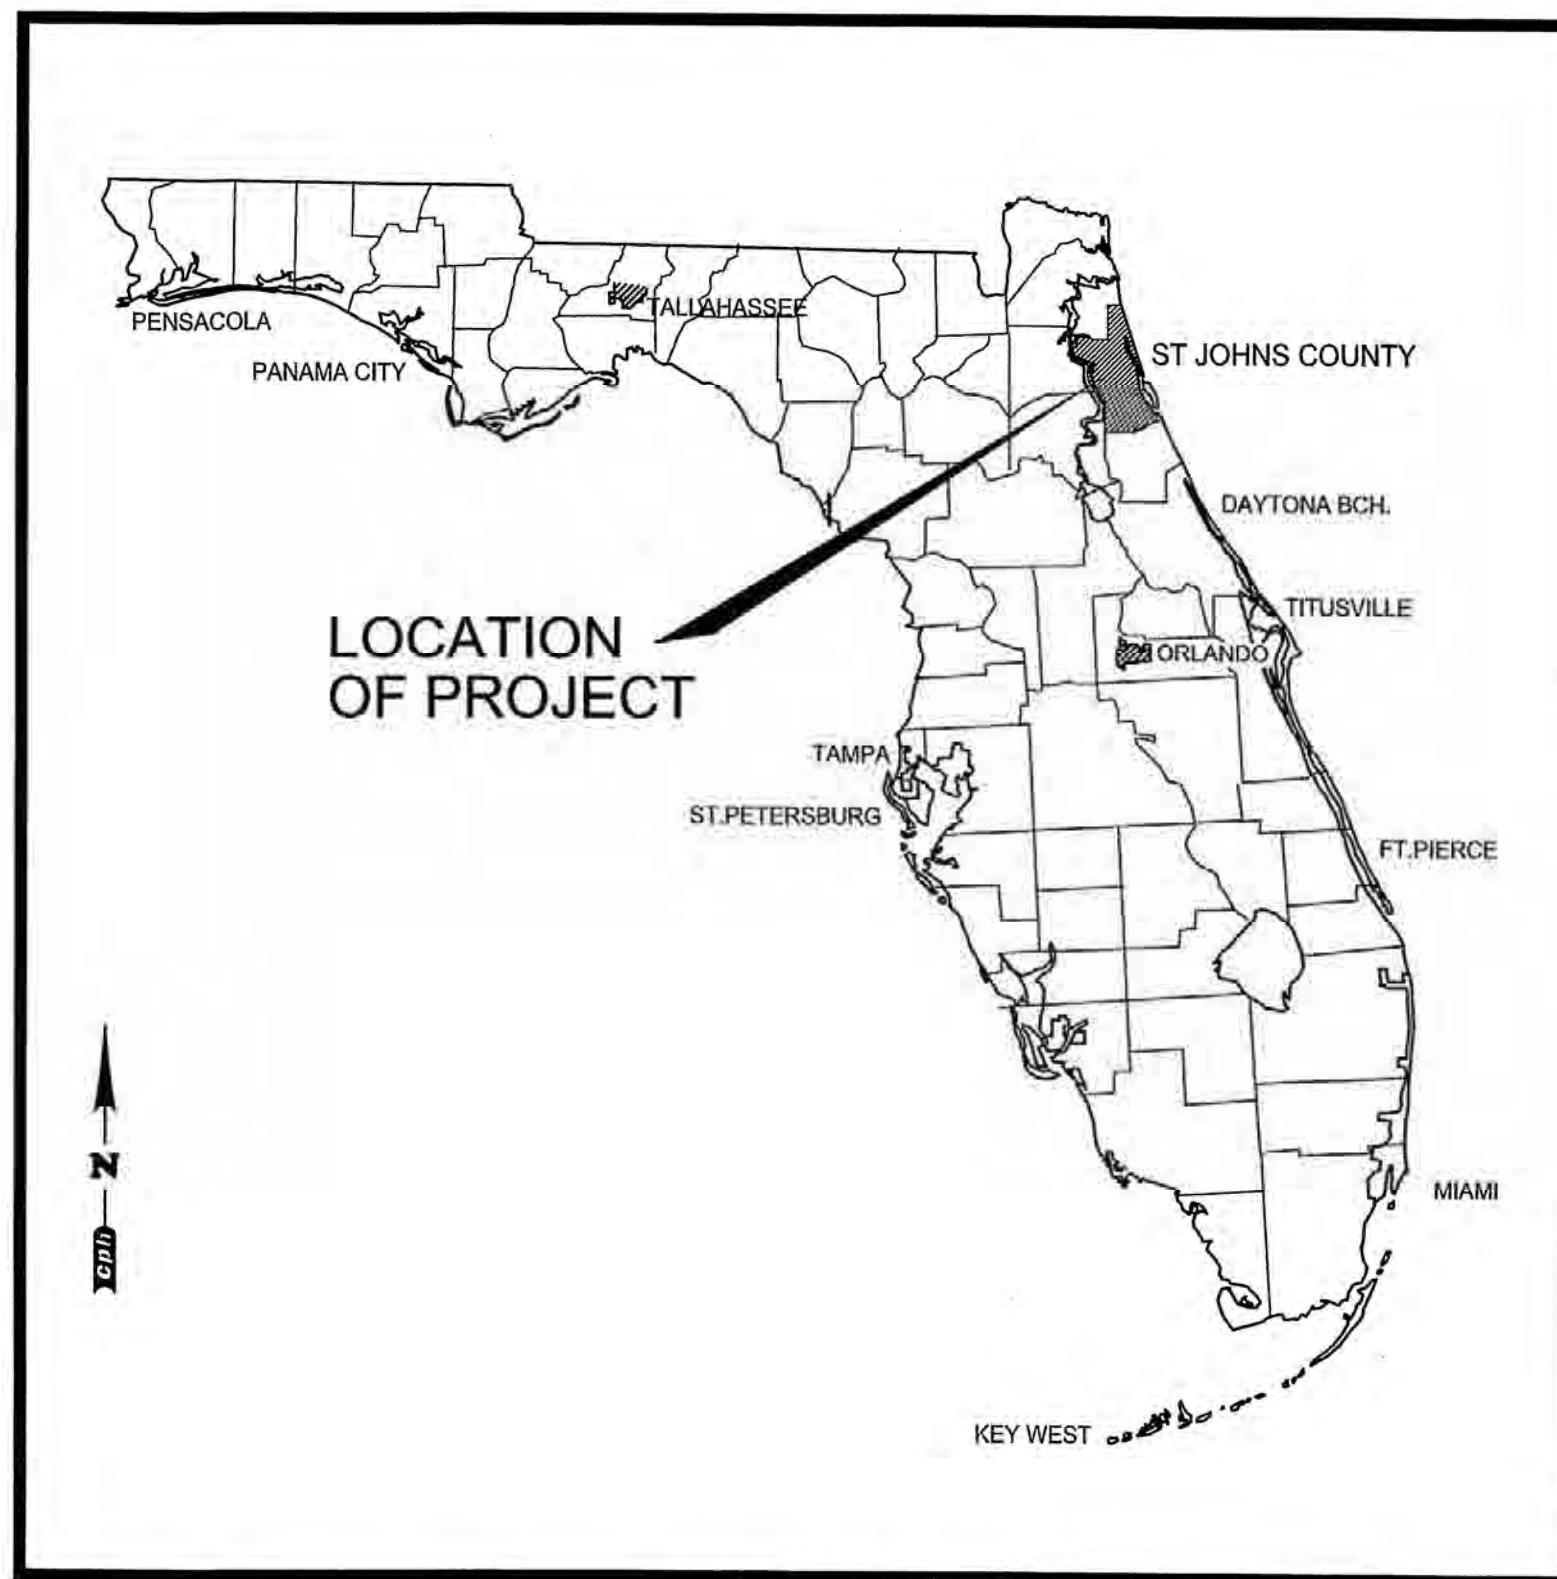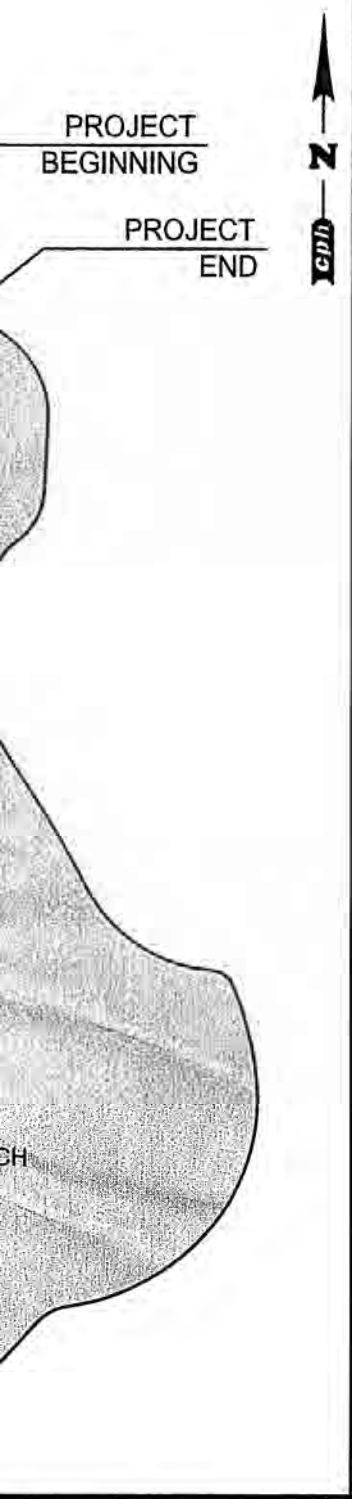

Florida Map

N.T.S.

ATLANTIC DIRECTIONAL DRILLING, INC. BORE LOG

Contractor: Masci
Job Name: SR 16 Wm Connection
Footage: 375 ft
Start Station #: 699+35
End Station #: 695+60
Print #: 9410"
Pipe Size: 20" EPVC 12m

ATLANTIC DIRECTIONAL DRILLING, INC. BORE LOG

Contractor: Masci
Job Name: SR 16 Wm Interconnect
Footage: 120'
Start Station #: 747+20
End Station #: 748+40
Print #: 13
Pipe Size: 20" EPVC 12m

NOTICE

THIS SET OF PLANS IS NOT VALID FOR CONSTRUCTION PURPOSES WITHOUT BEING STAMPED "APPROVED FOR CONSTRUCTION BY CPH INC." PLANS WITHOUT THIS STAMP ARE GIVEN FOR INFORMATIONAL PURPOSES ONLY.


Surveyor's Notes:

- "SURVEY MAP AND REPORT OR THE COPIES THEREOF ARE NOT VALID WITHOUT THE SIGNATURE AND THE ORIGINAL RAISED SEAL OF LICENSED SURVEYOR AND MAPPER."
- "ADDITIONS OR DELETIONS TO SURVEY MAPS OR REPORTS BY THE SIGNING PARTY OR PARTIES IS PROHIBITED WITHOUT WRITTEN PERMISSION OF THE SIGNING PARTY OR PARTIES."
- THE TWO SITE BENCHMARKS FOR THIS TOPOGRAPHIC SURVEY ARE ON THE RESPECTIVE SURVEY FILE. THIS FIELDWORK WAS PERFORMED USING A TOPCON LEVEL MODEL # AT-G4, AND REFERENCES THE FIELD PUBLISHED BENCHMARKS AS ESTABLISHED BY THE NORTH AMERICAN DATUM OF 1988 (NAVD '88) AND SAID ELEVATIONS ARE BASED ON VERTICAL CONTROL BENCHMARKS SUPPLIED BY ST. JOHNS COUNTY ENGINEERING DEPARTMENT FOR STATE ROAD 16 WATER MAIN.
 - DESIGNATION #1 SURVEY DISK STAMPED H 482, ELEVATION 10.00'
 - DESIGNATION #2 SURVEY DISK STAMPED J 482, ELEVATION 10.00'
- SITE BENCHMARKS ARE AS LISTED ON SHEET 3.
- THIS SURVEY IS NOT VALID WITHOUT SHEETS 1, 3 THROUGH 10.
- THE LAST DAY FIELD WORK WAS PERFORMED WAS SEPTEMBER 10, 2014.
- BEARINGS SHOWN HEREON ARE RELATIVE TO BASELINE SURVEY CENTERLINE OF CONSTRUCTION BEING S80°53'55"E.
- HORIZONTAL WELL-IDENTIFIED FEATURES IN THIS SURVEY AND MAP HAVE BEEN MEASURED TO AN ESTIMATED HORIZONTAL POSITIONAL ACCURACY OF 0.07'. THE EQUIPMENT USED TO LOCATE THE FEATURES WAS TOTAL STATION MODEL # GPT-3005W.
- THIS SURVEY WAS PREPARED WITHOUT THE BENEFIT OF AN ADEQUATE OPINION OF TITLE. NO INSTRUMENTS OF RECORD REFLECTING EASES, RIGHTS-OF-WAY, AND/OR OWNERSHIP WERE FURNISHED TO THE SURVEYOR EXCEPT AS NOTED.
- NO UNDERGROUND UTILITIES, FOUNDATIONS OR IMPROVEMENTS WERE LOCATED EXCEPT AS SHOWN.
- VERTICAL FEATURE ACCURACY: ELEVATIONS OF WELL-IDENTIFIED FEATURES CONTAINED IN THIS SURVEY AND MAP HAVE BEEN MEASURED TO AN ESTIMATED VERTICAL POSITIONAL ACCURACY OF 0.04'.
- THIS IS NOT A BOUNDARY SURVEY.
- DIMENSIONS ARE SHOWN RELATIVE TO UNITED STATES STANDARD FEET. DECIMALS THEREOF, UNLESS THE OBJECT SHOWN IS COMMONLY KNOWN IN INCHES, I.E. TREE DIAMETER, PIPE DIAMETER, ETC. TREES OR


INV = INVERT
MH = MAN HOLE
ATT = AMERICAN TELEPHONE & TELEGRAPH

X24.5 = ELEVATION SHOT

 
CONC = CONCRETE


 = WATER METER

TOB = TOP OF BANK


 = WOOD OR METAL POST

 = SINGLE POST SIGN

 = DOUBLE POST SIGN

 
BH- = BORING HOLE LOCATION


 = TREE LINE

 = IRRIGATION CONTROL BOX


FND = FOUND

 
 CM = CONCRETE MONUMENT

 N&D = NAIL AND DISK

 IP = IRON PIPE

  IR = IRON ROD

 SIR TR = SET 1/2" IR WITH RED CAP "SJC TRAV"

 SND TR = SET NAIL AND DISK "SJC TRAV"

SMS = SET MAG SPIKE

NO ID = NO IDENTIFICATION STAMPED

PC = POINT OF CURVE

 = WOOD UTILITY POLE
 = WOOD UTILITY POLE WITH GUY ANCHOR
 = UNDERGROUND UTILITY MARKER
 = TELEPHONE HAND HOLE
 = TELEPHONE MAN HOLE
 = ELECTRIC BOX
 = BACK-FLOW PREVENTER
 = GAS VALVE
 = LIGHT POLE
— = UNDERGROUND MARKINGS—CABLE
— = UNDERGROUND MARKINGS—ELECTRIC
— = UNDERGROUND MARKINGS—GAS
— = UNDERGROUND MARKINGS—WATER
 = UNDERGROUND MARKINGS—FLAG

FDOT = FLORIDA DEPARTMENT OF TRANSPORTATION

PCC = POINT OF COMPOUND CURVE

PT = POINT OF TANGENT

PI = POINT OF INTERSECTION

PRC = POINT OF REVERSE CURVE

LT = LEFT


RT = RIGHT


BP = BEGIN POINT


EP = END POINT



C/L = CENTERLINE



THE NAD 83/90. ST. JOHNS CO
5. THIS IS A TOPOGRAPHIC SURV
6. BENCHMARK BASIS: NGS PUBL
7. THE INTENDED FEATURES LOC
8. THE UNDERGROUND MARKING
9. THE PROPERTY LINES AND RIG
MONUMENTATION.
10. SEE STATE ROAD DEPARTMEN
11. AERIAL PHOTOGRAPHY, IF SHO


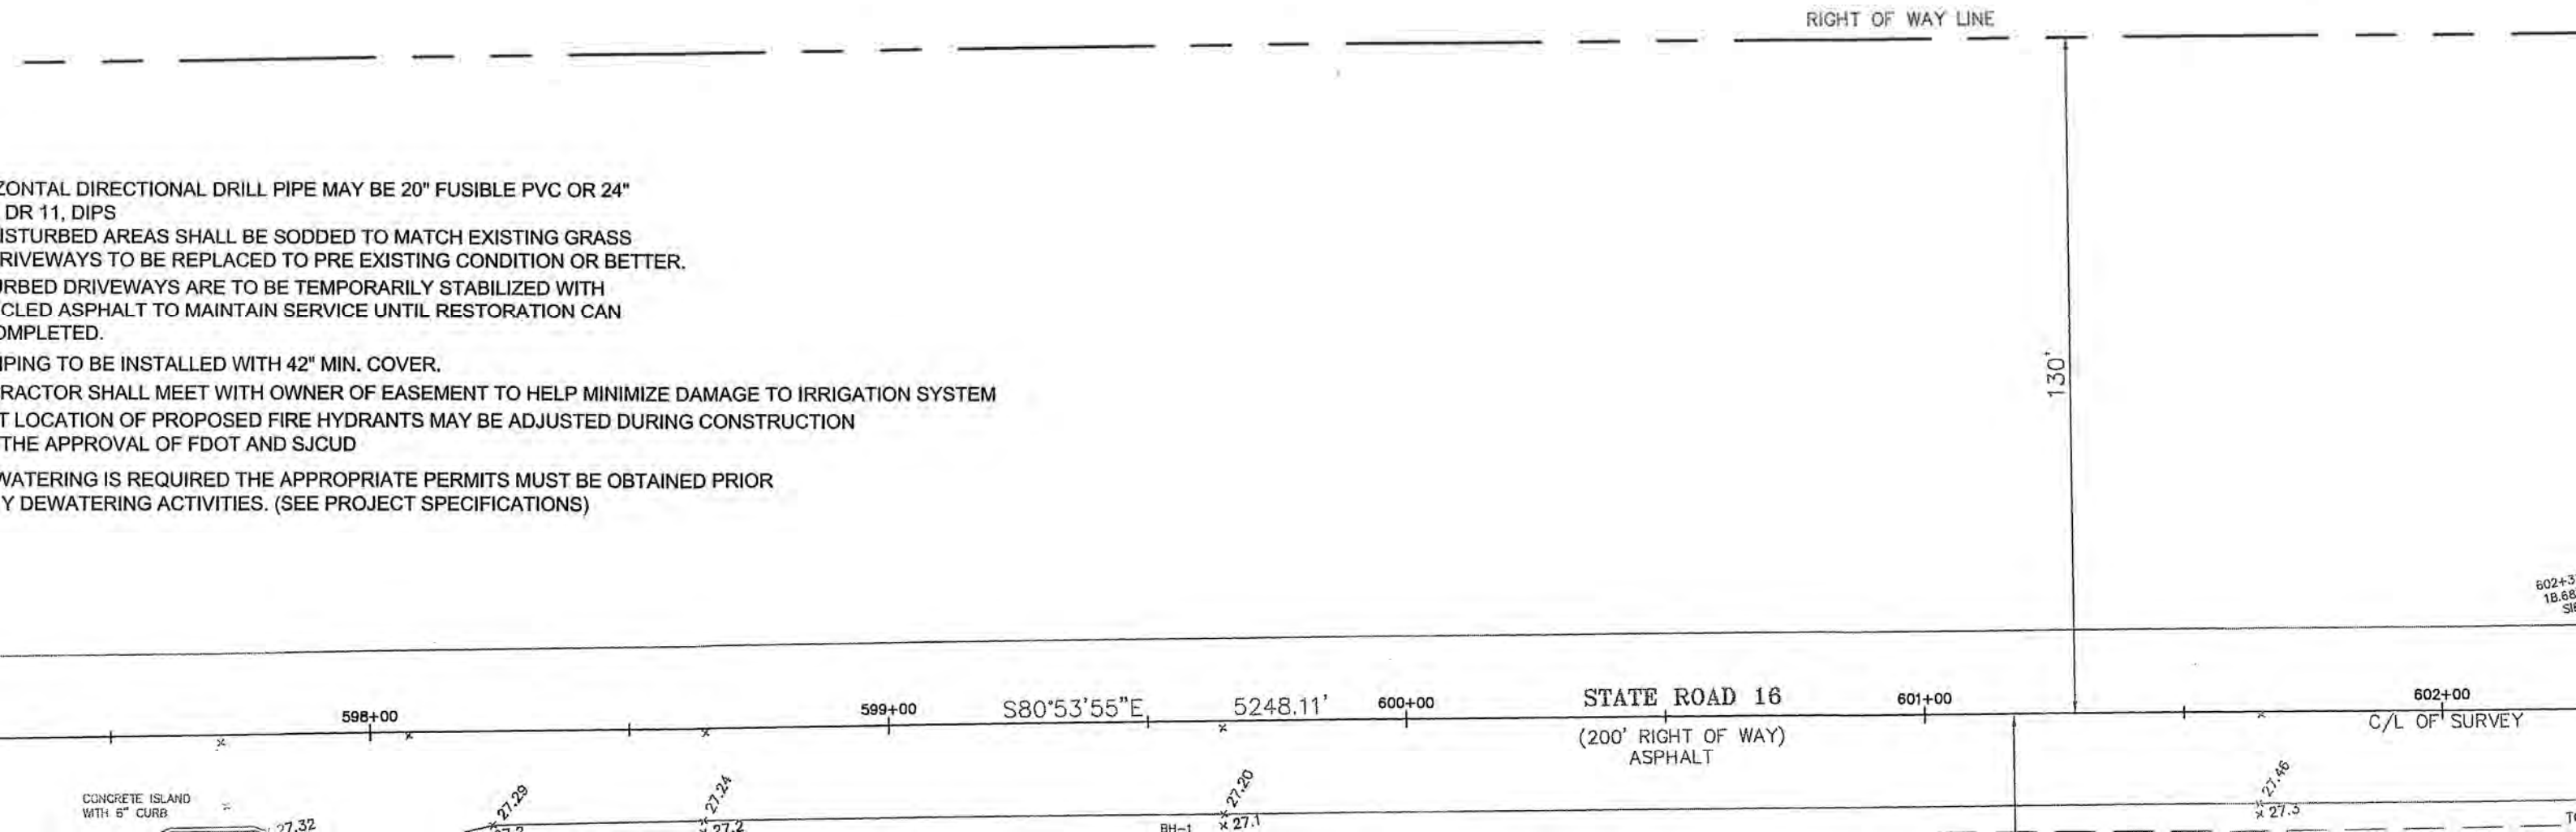


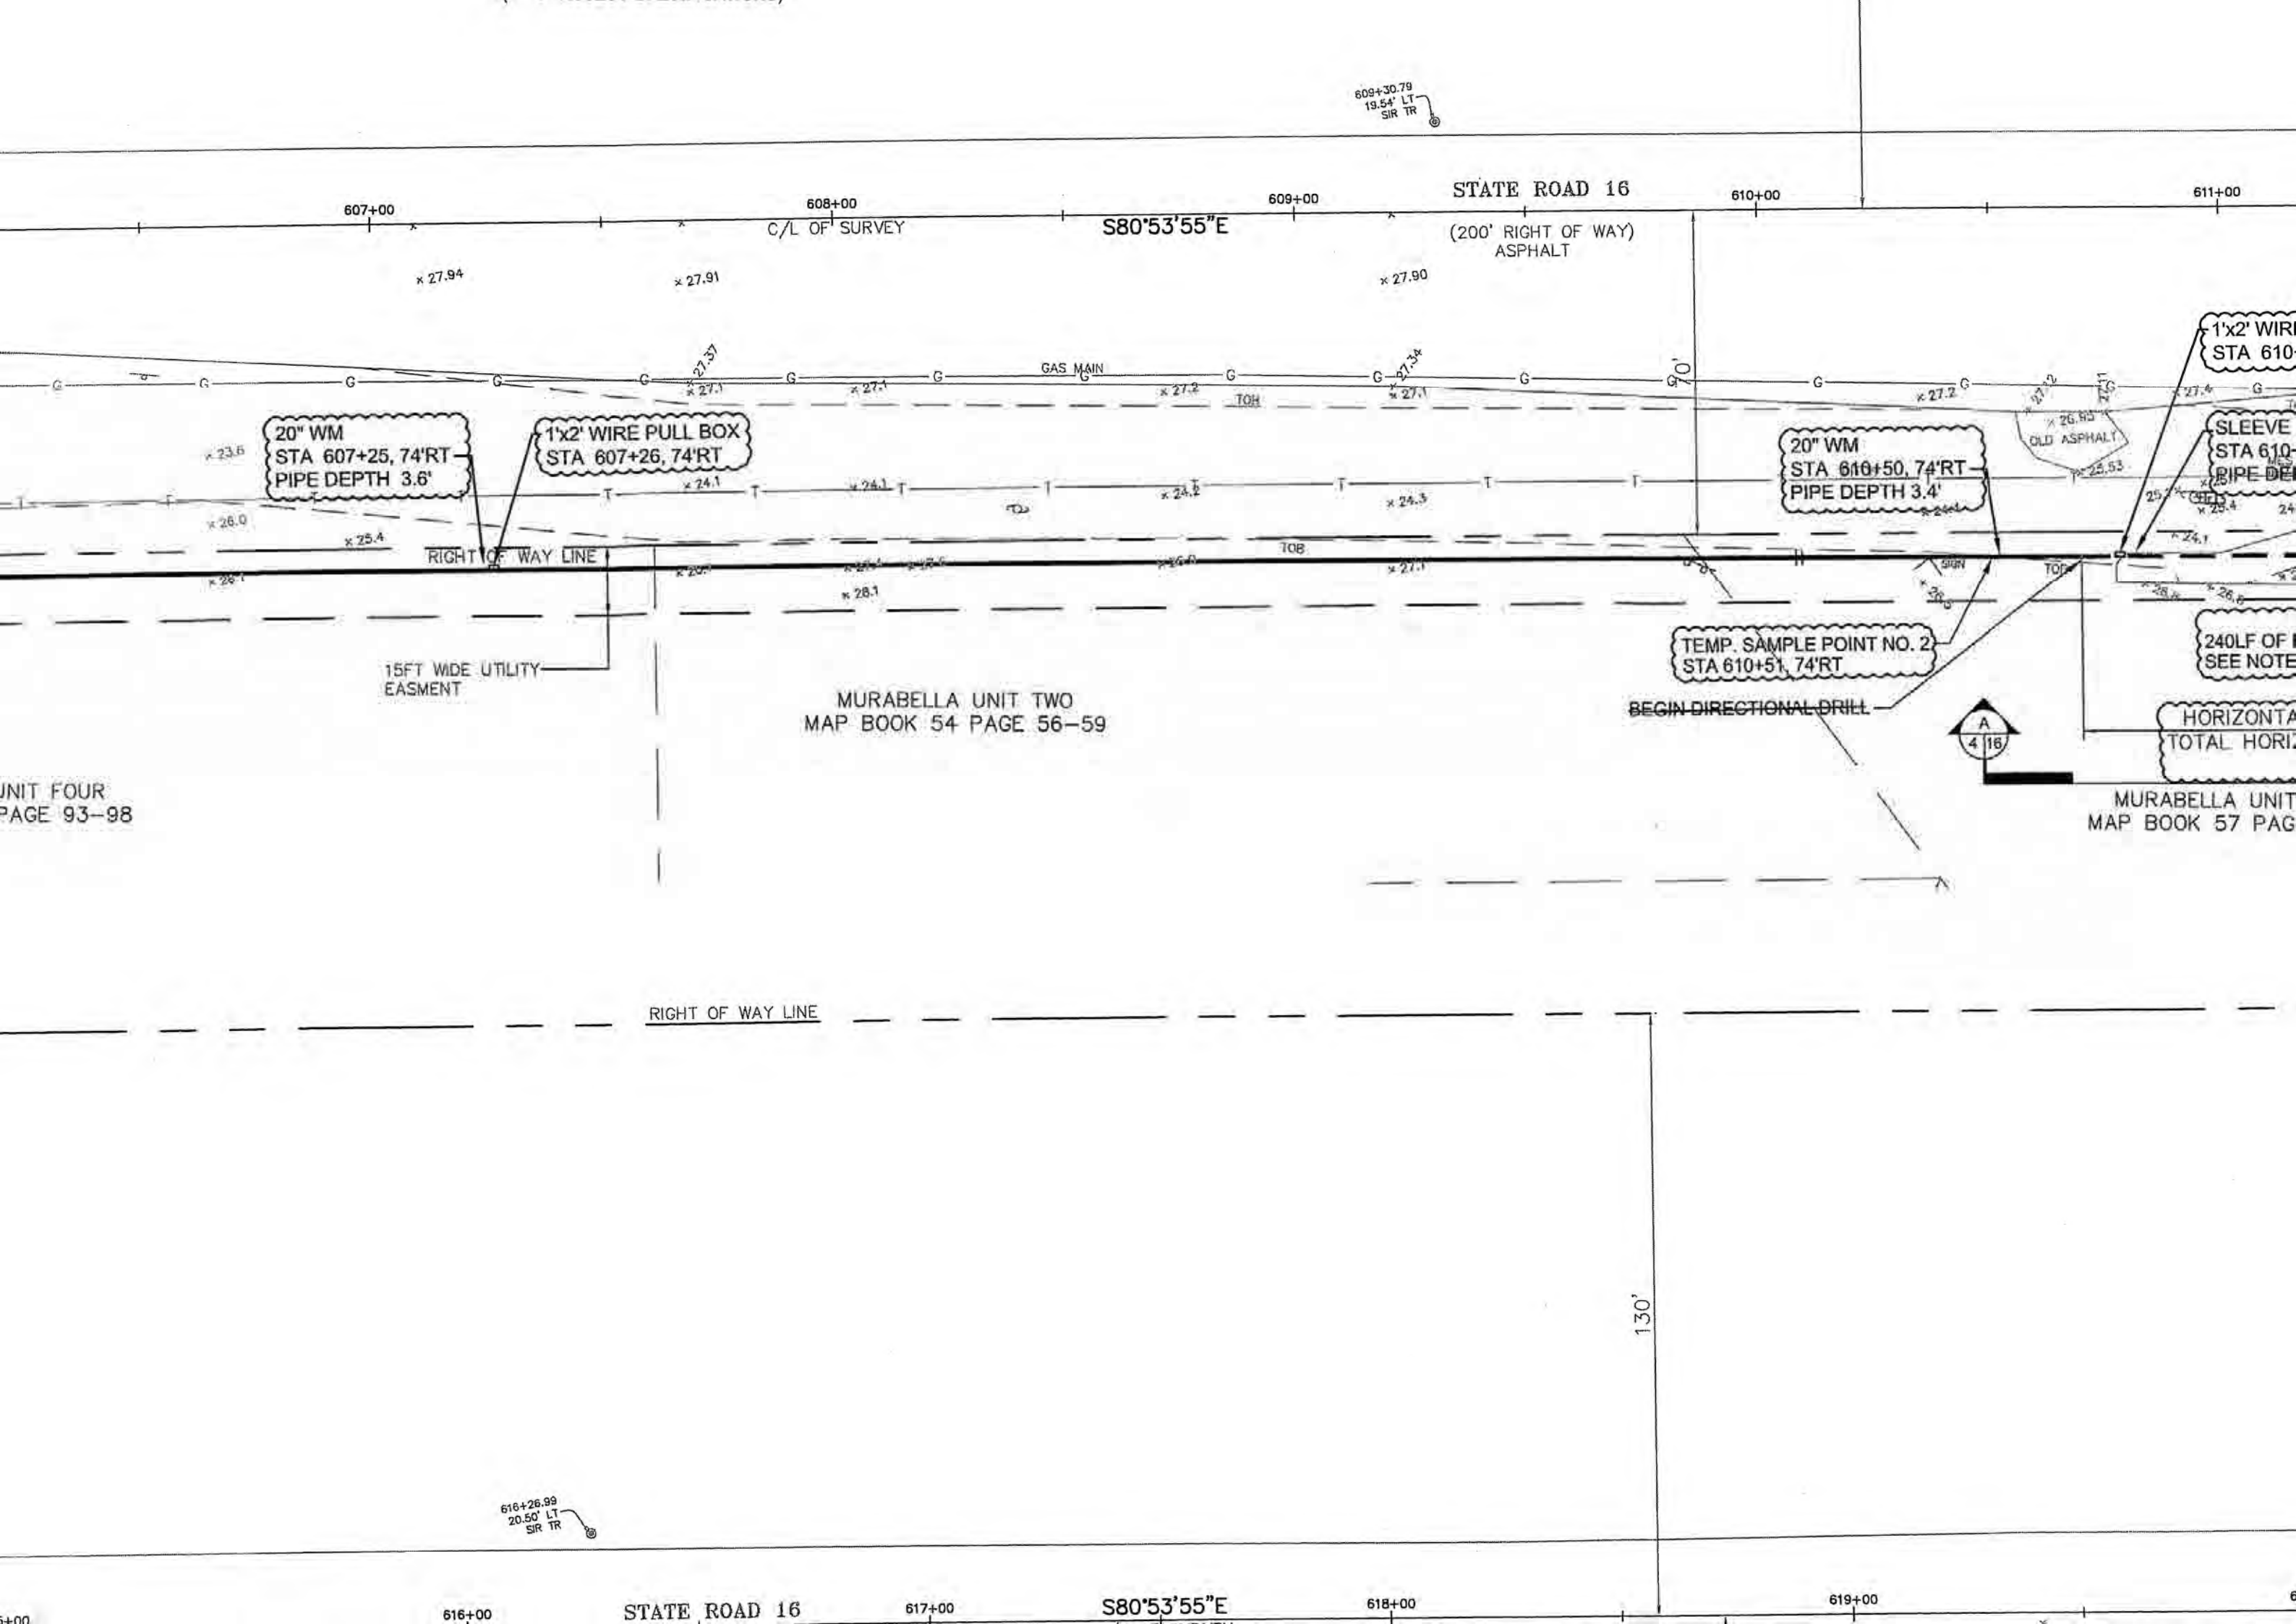

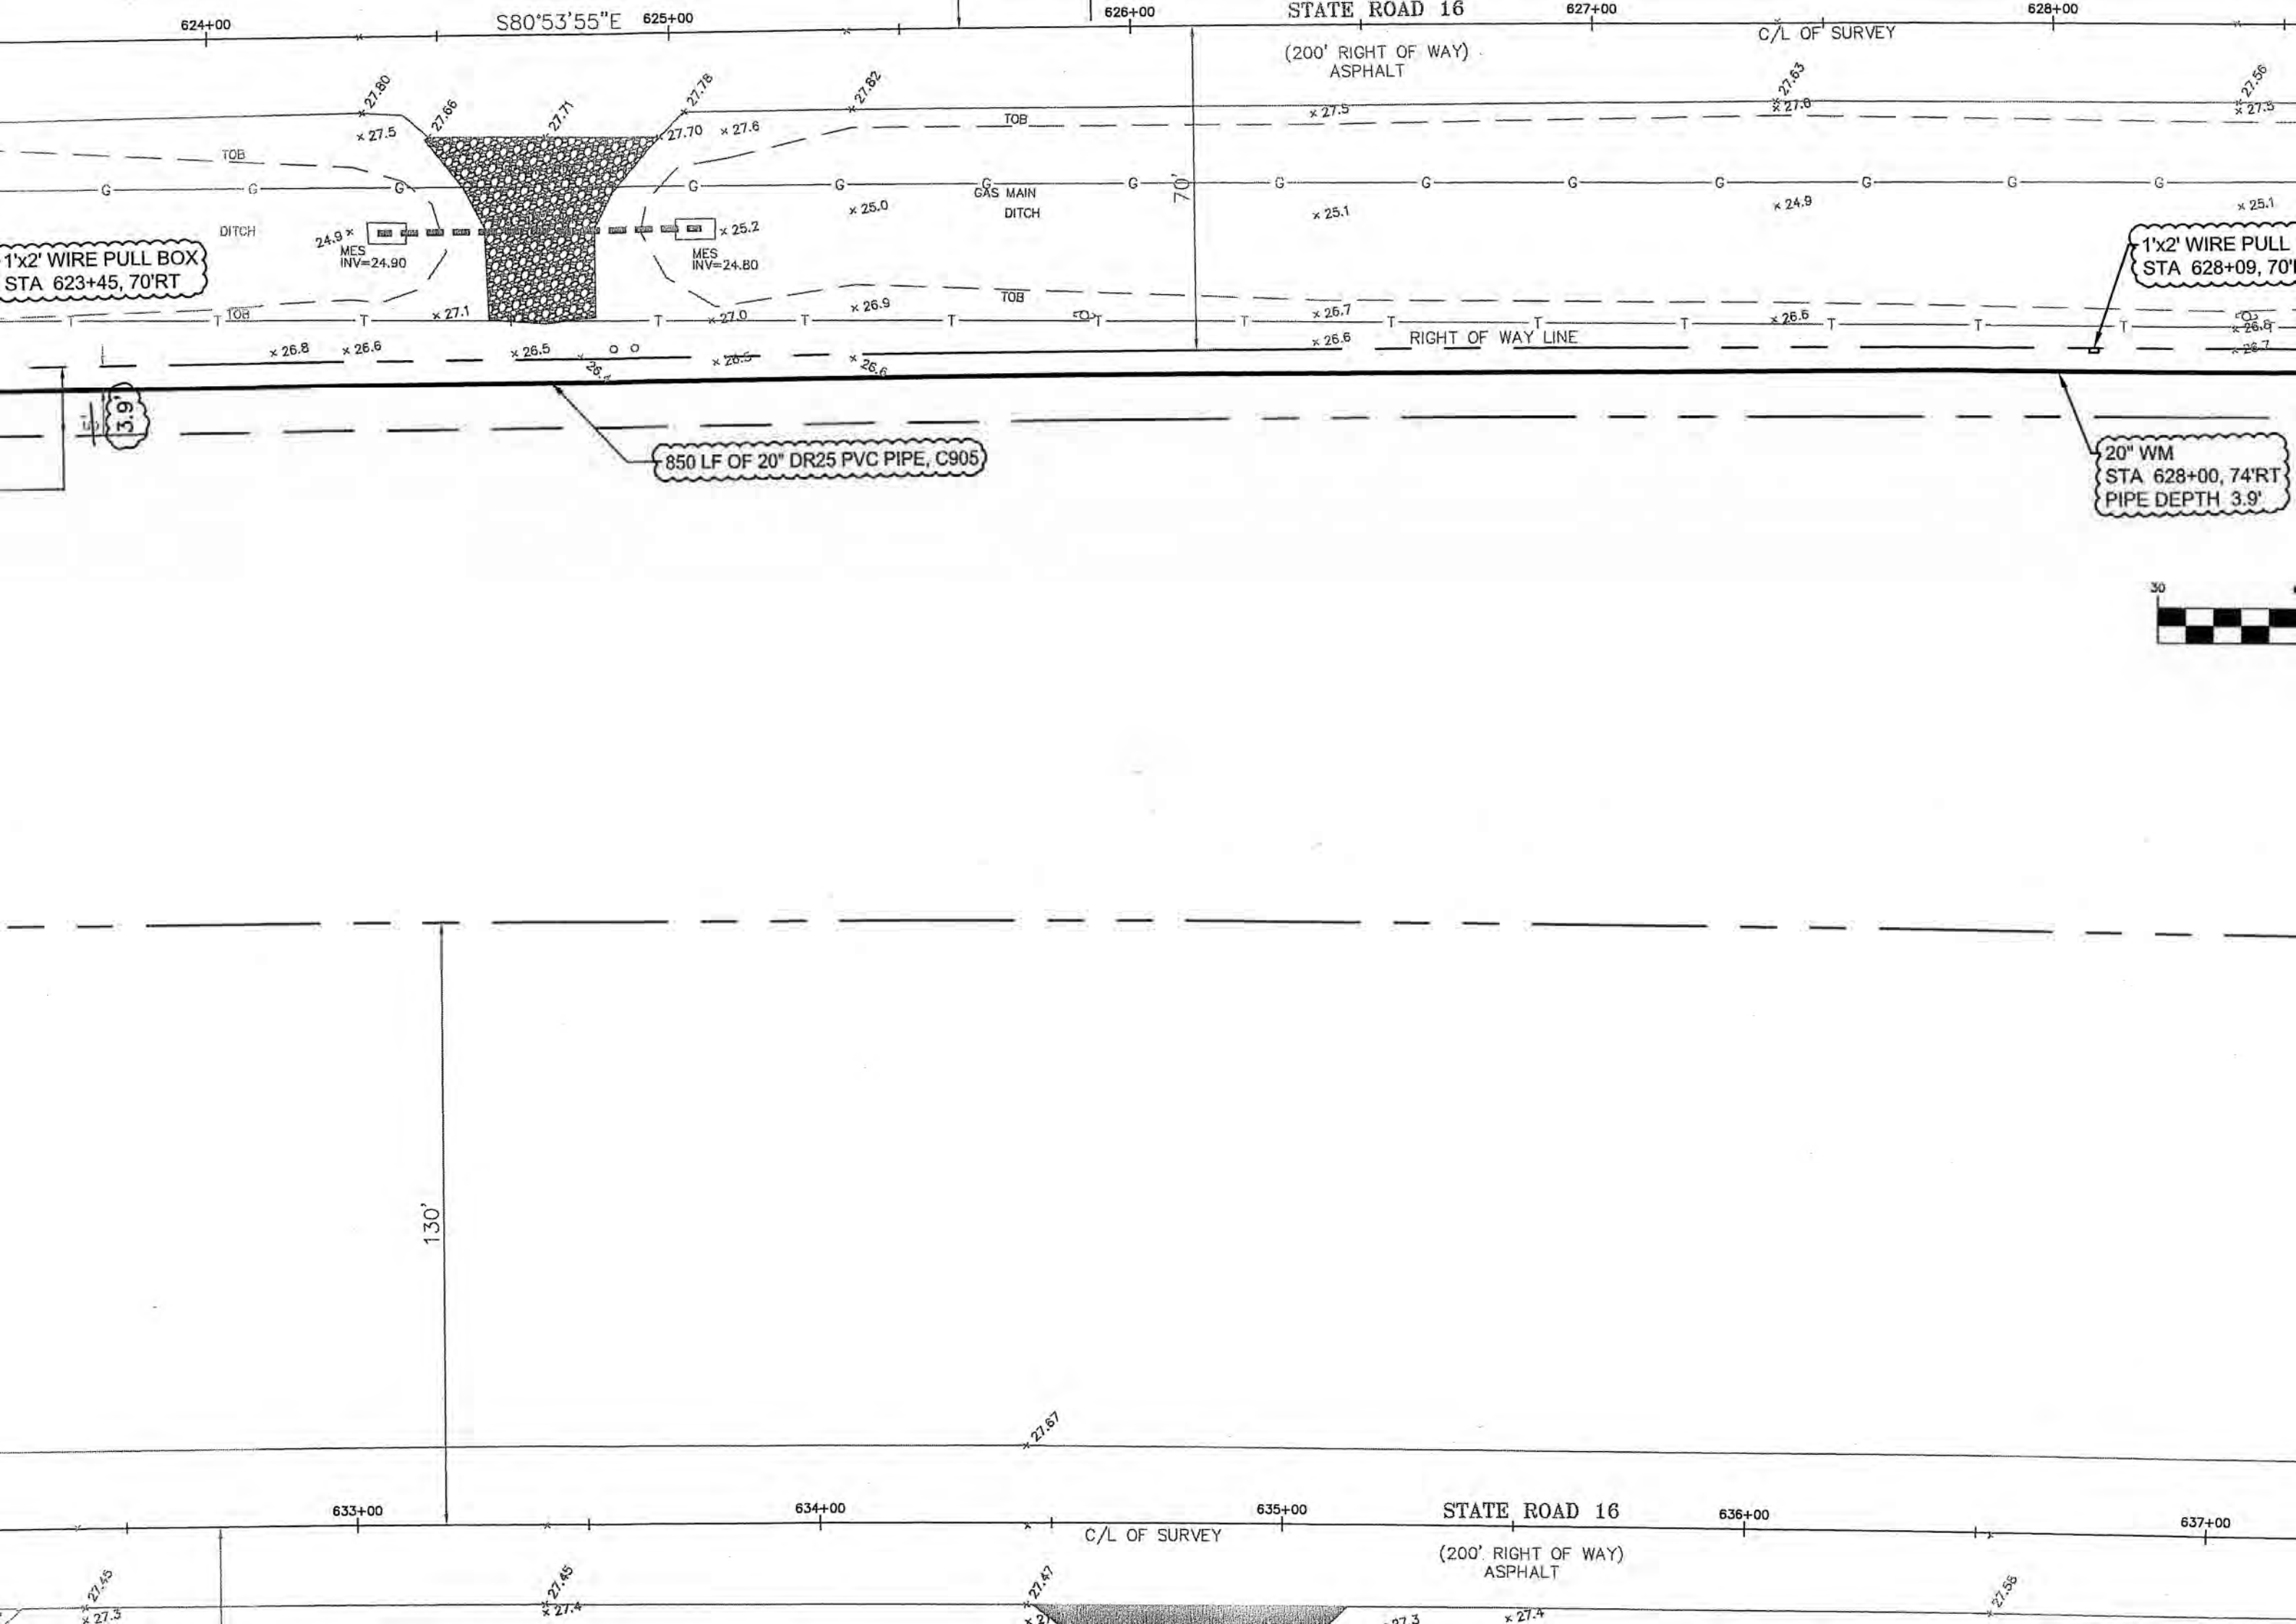

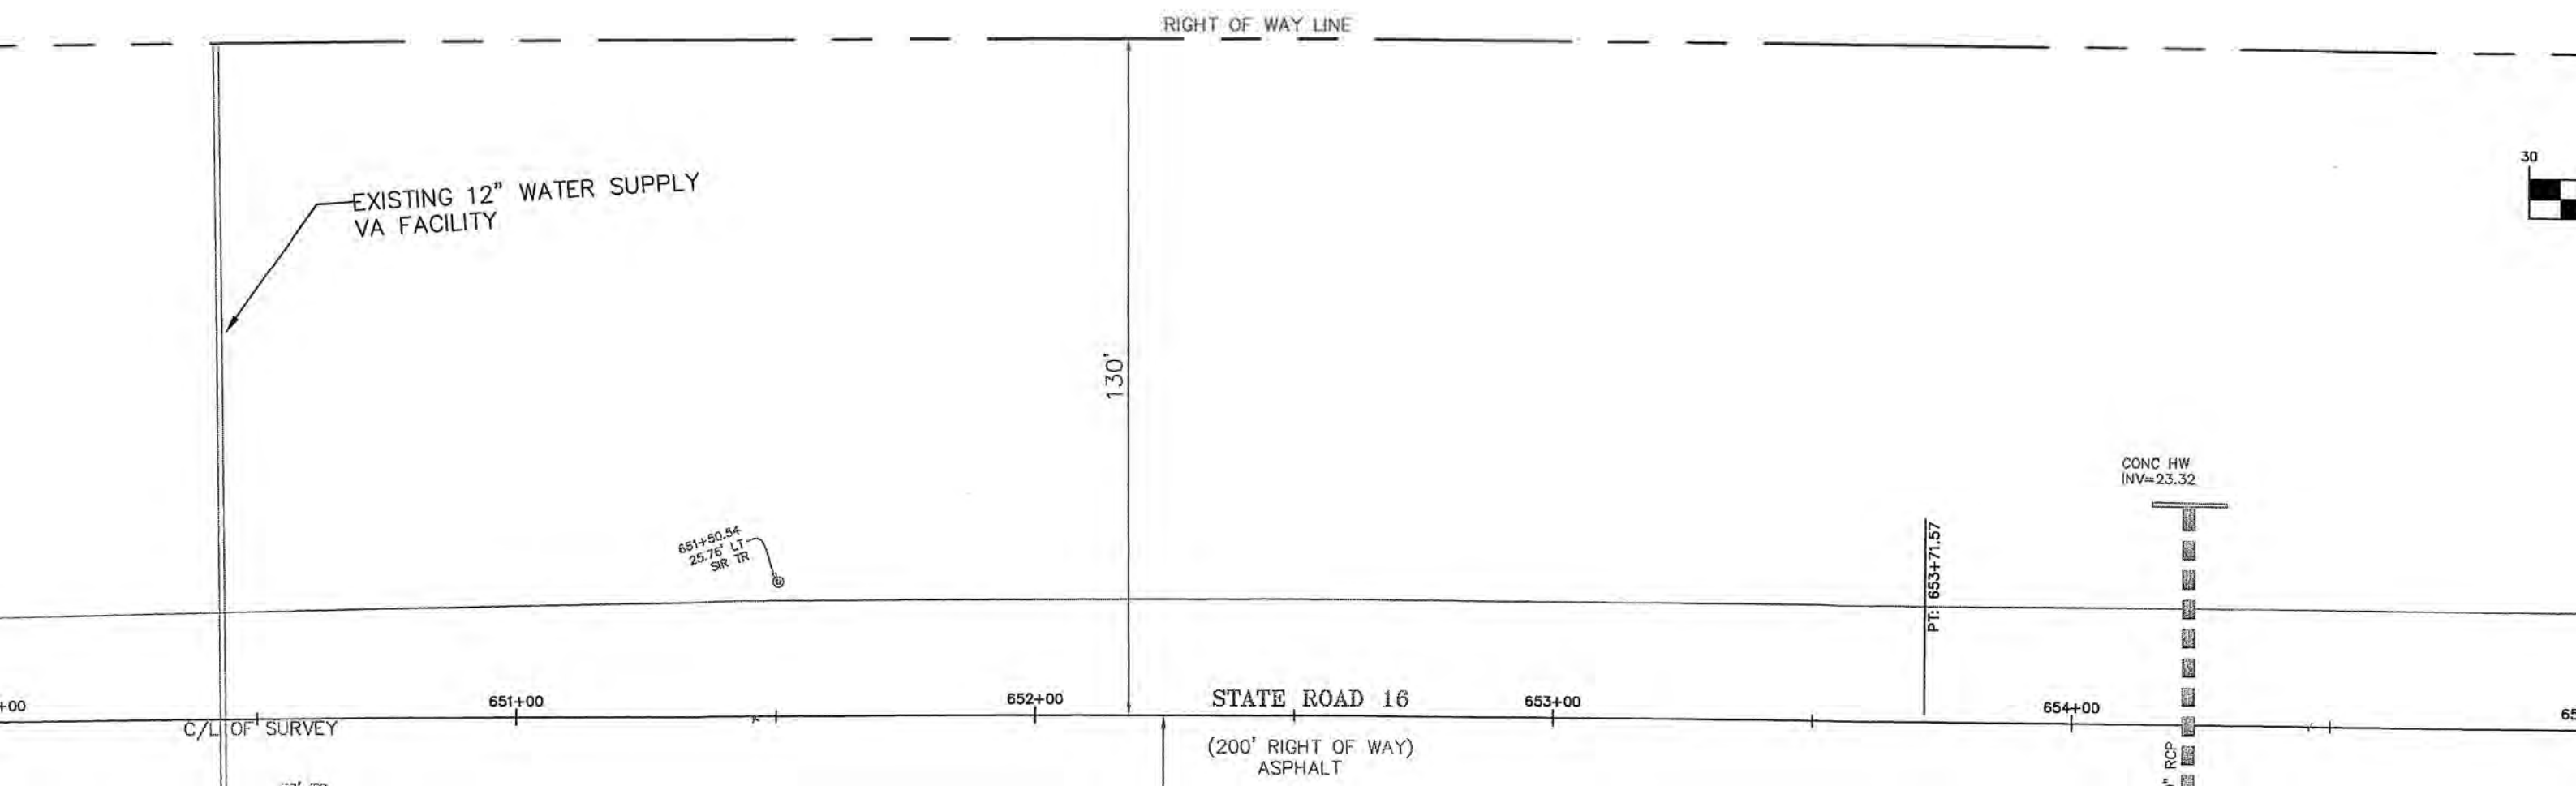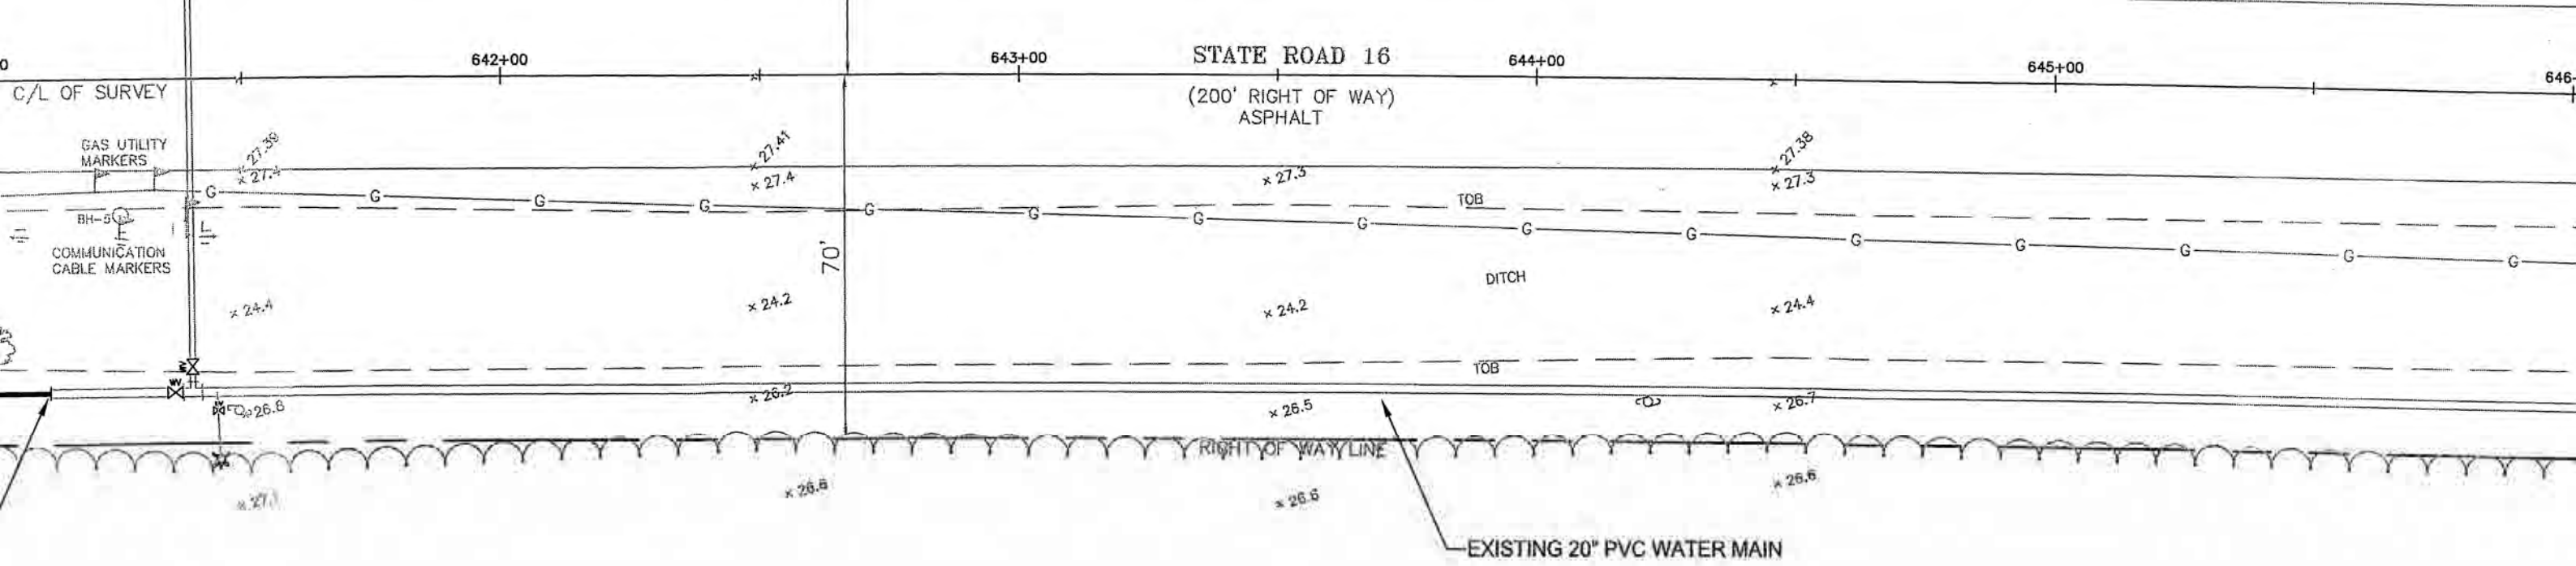

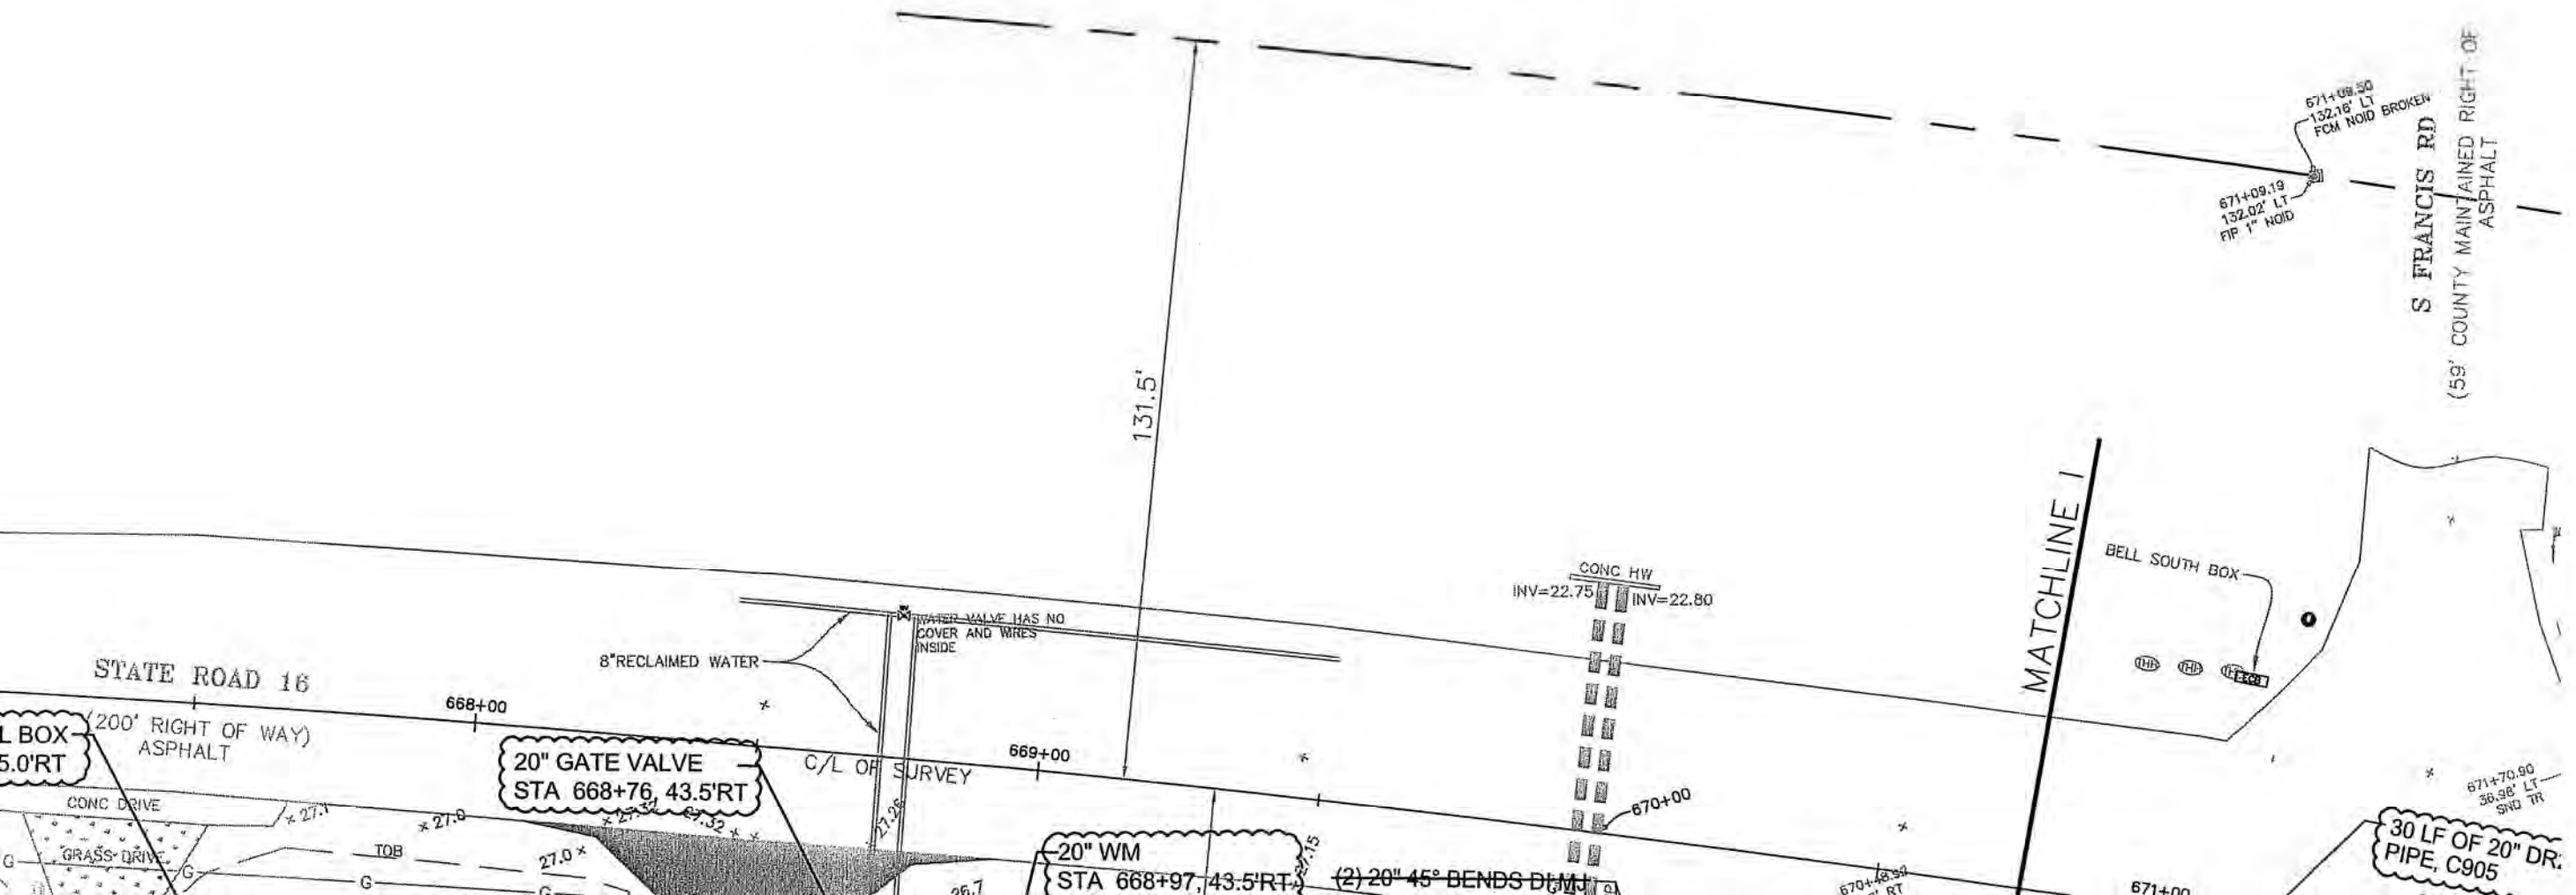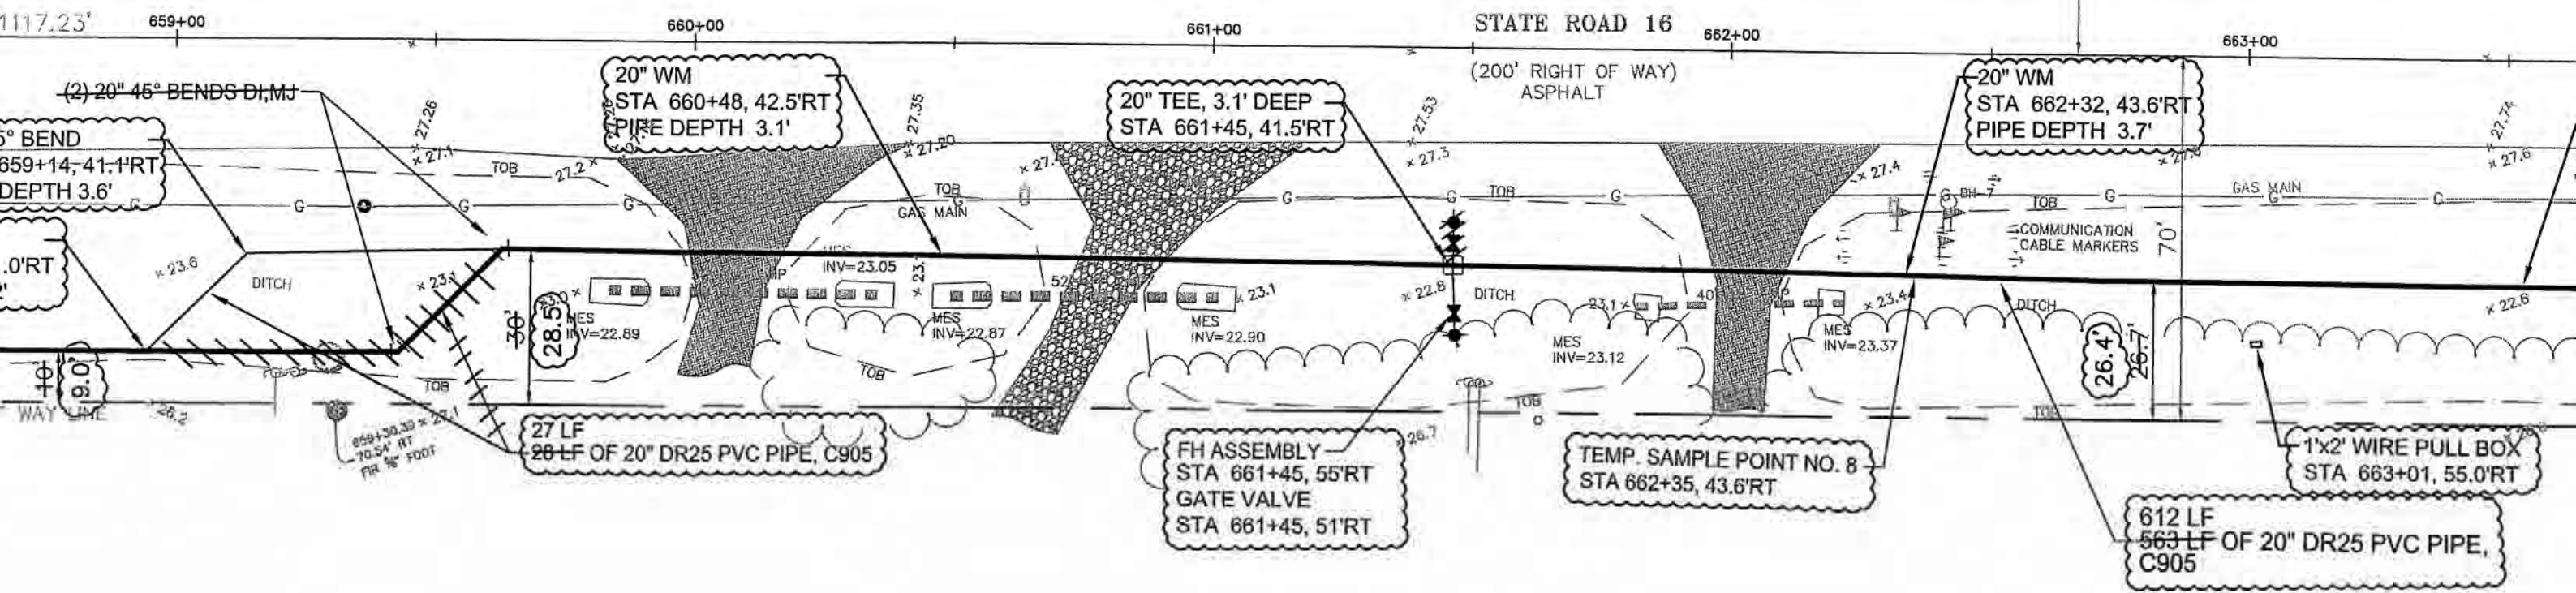


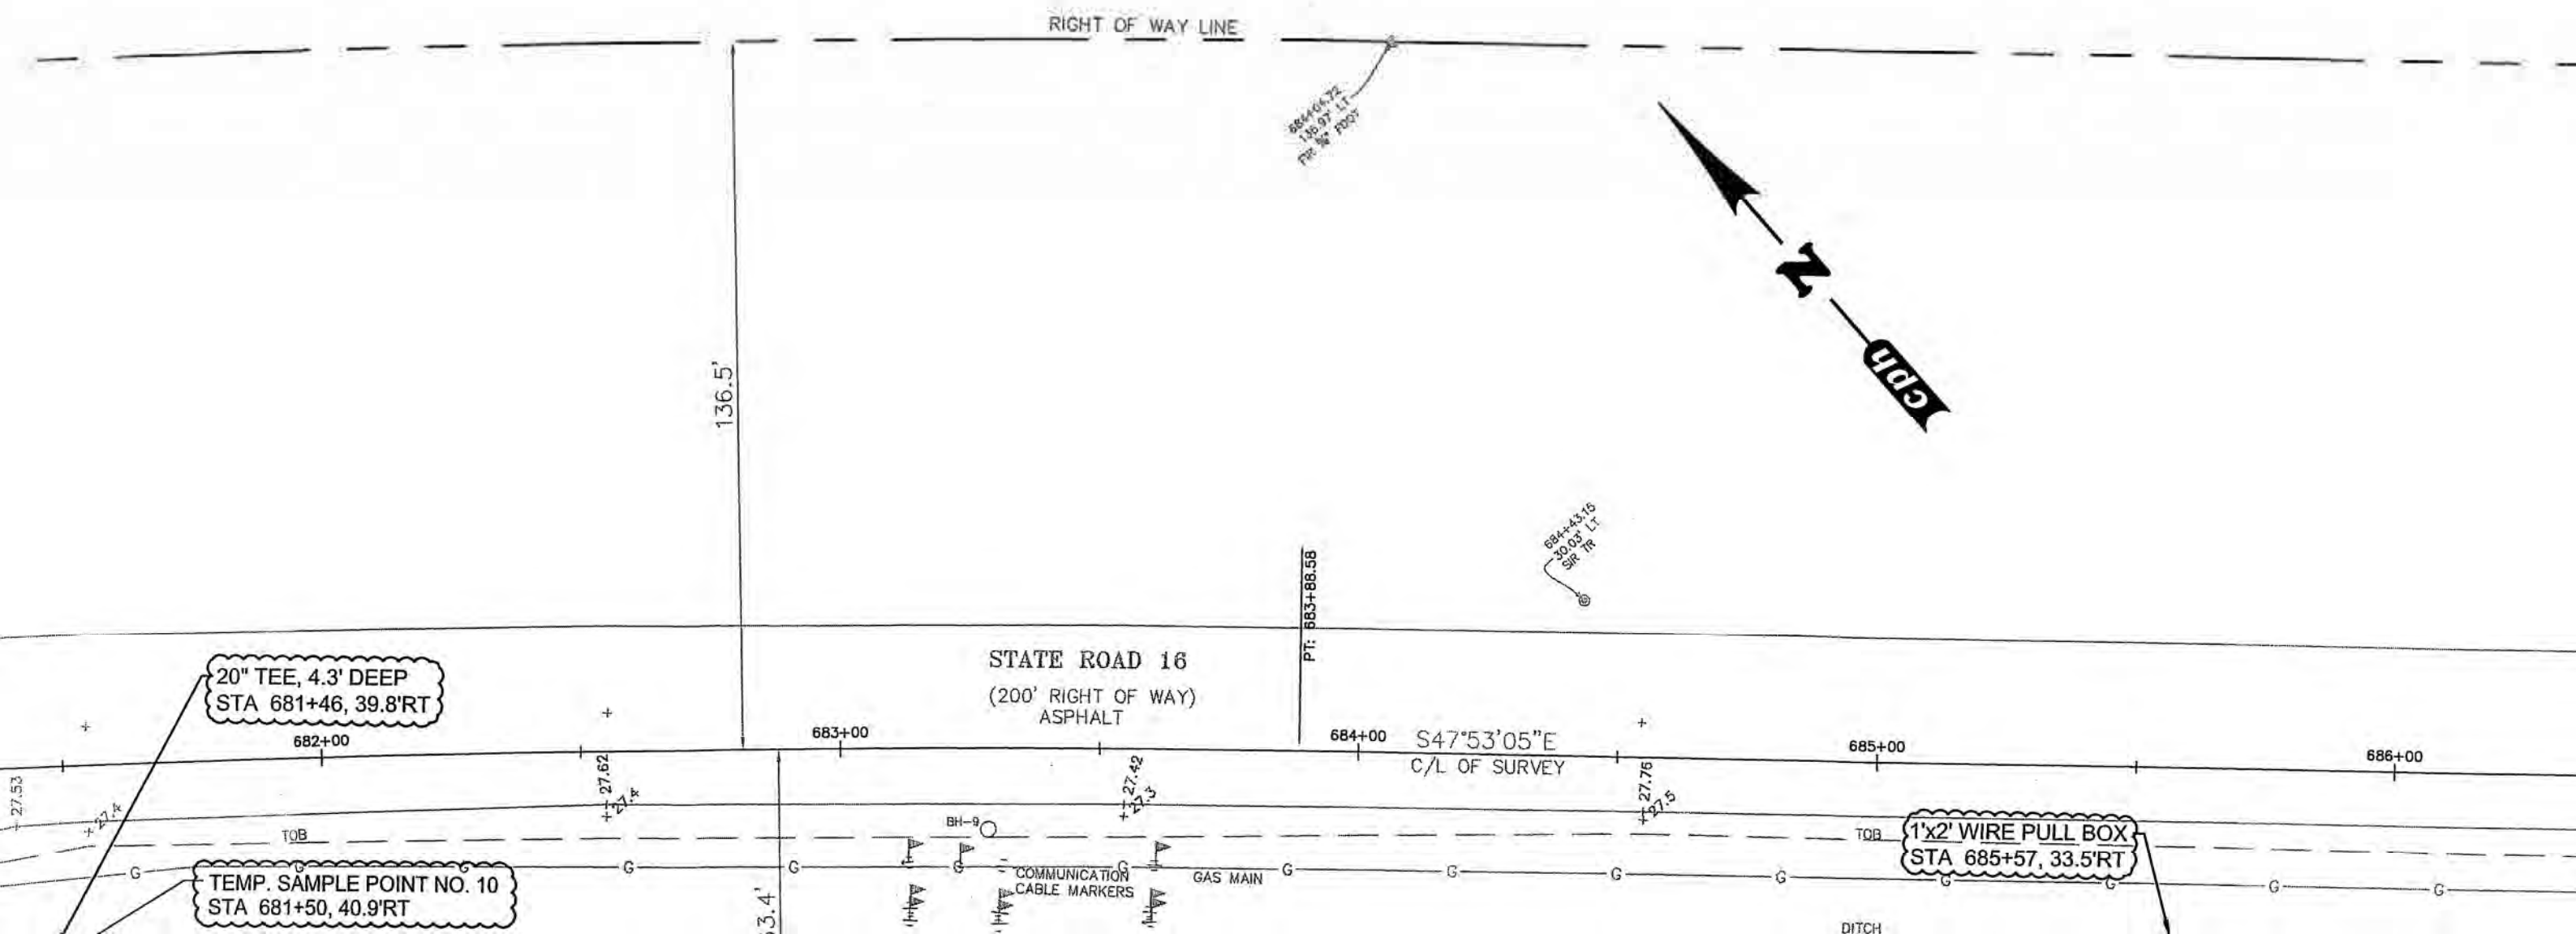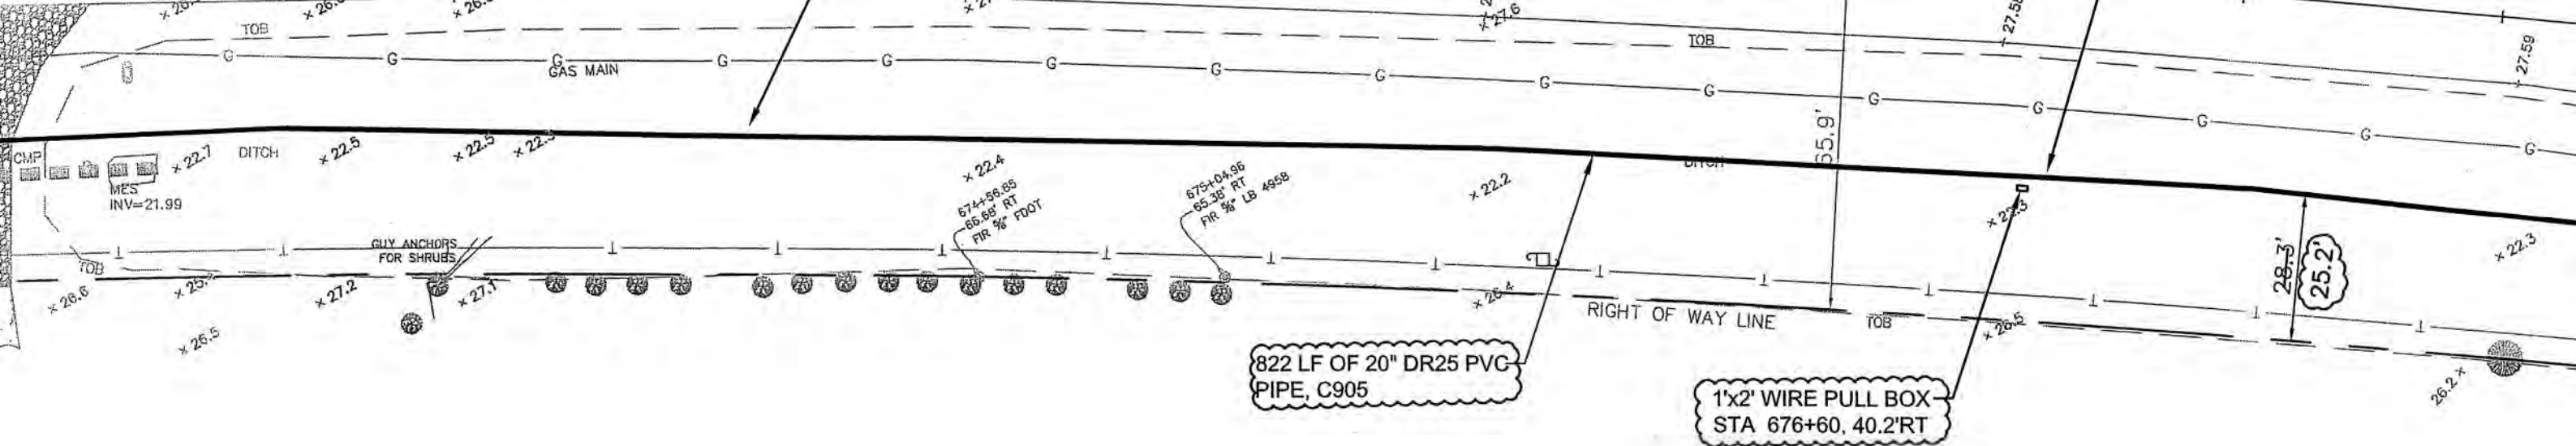


RIGHT OF WAY LINE


NOTES:


- 1 HORIZONTAL DIRECTIONAL DRILL PIPE MAY BE 20" FUSIBLE HDPE DR 11, DIPS
- 2 ALL DISTURBED AREAS SHALL BE SODDED TO MATCH EXIS
- 3 ALL DRIVEWAYS TO BE REPLACED TO PRE EXISTING COND
- 4 DISTURBED DRIVEWAYS ARE TO BE TEMPORARILY STABIL RECYCLED ASPHALT TO MAINTAIN SERVICE UNTIL RESTOR BE COMPLETED.
- 5 ALL PIPING TO BE INSTALLED WITH 42" MIN. COVER.
- 6 EXACT LOCATION OF PROPOSED FIRE HYDRANTS MAY BE DURING CONSTRUCTION WITH THE APPROVAL OF FDOT AN
- 7 IF DEWATERING IS REQUIRED THE APPROPRIATE PERMITS TO ANY DEWATERING ACTIVITIES. (SEE PROJECT SPECIFIC



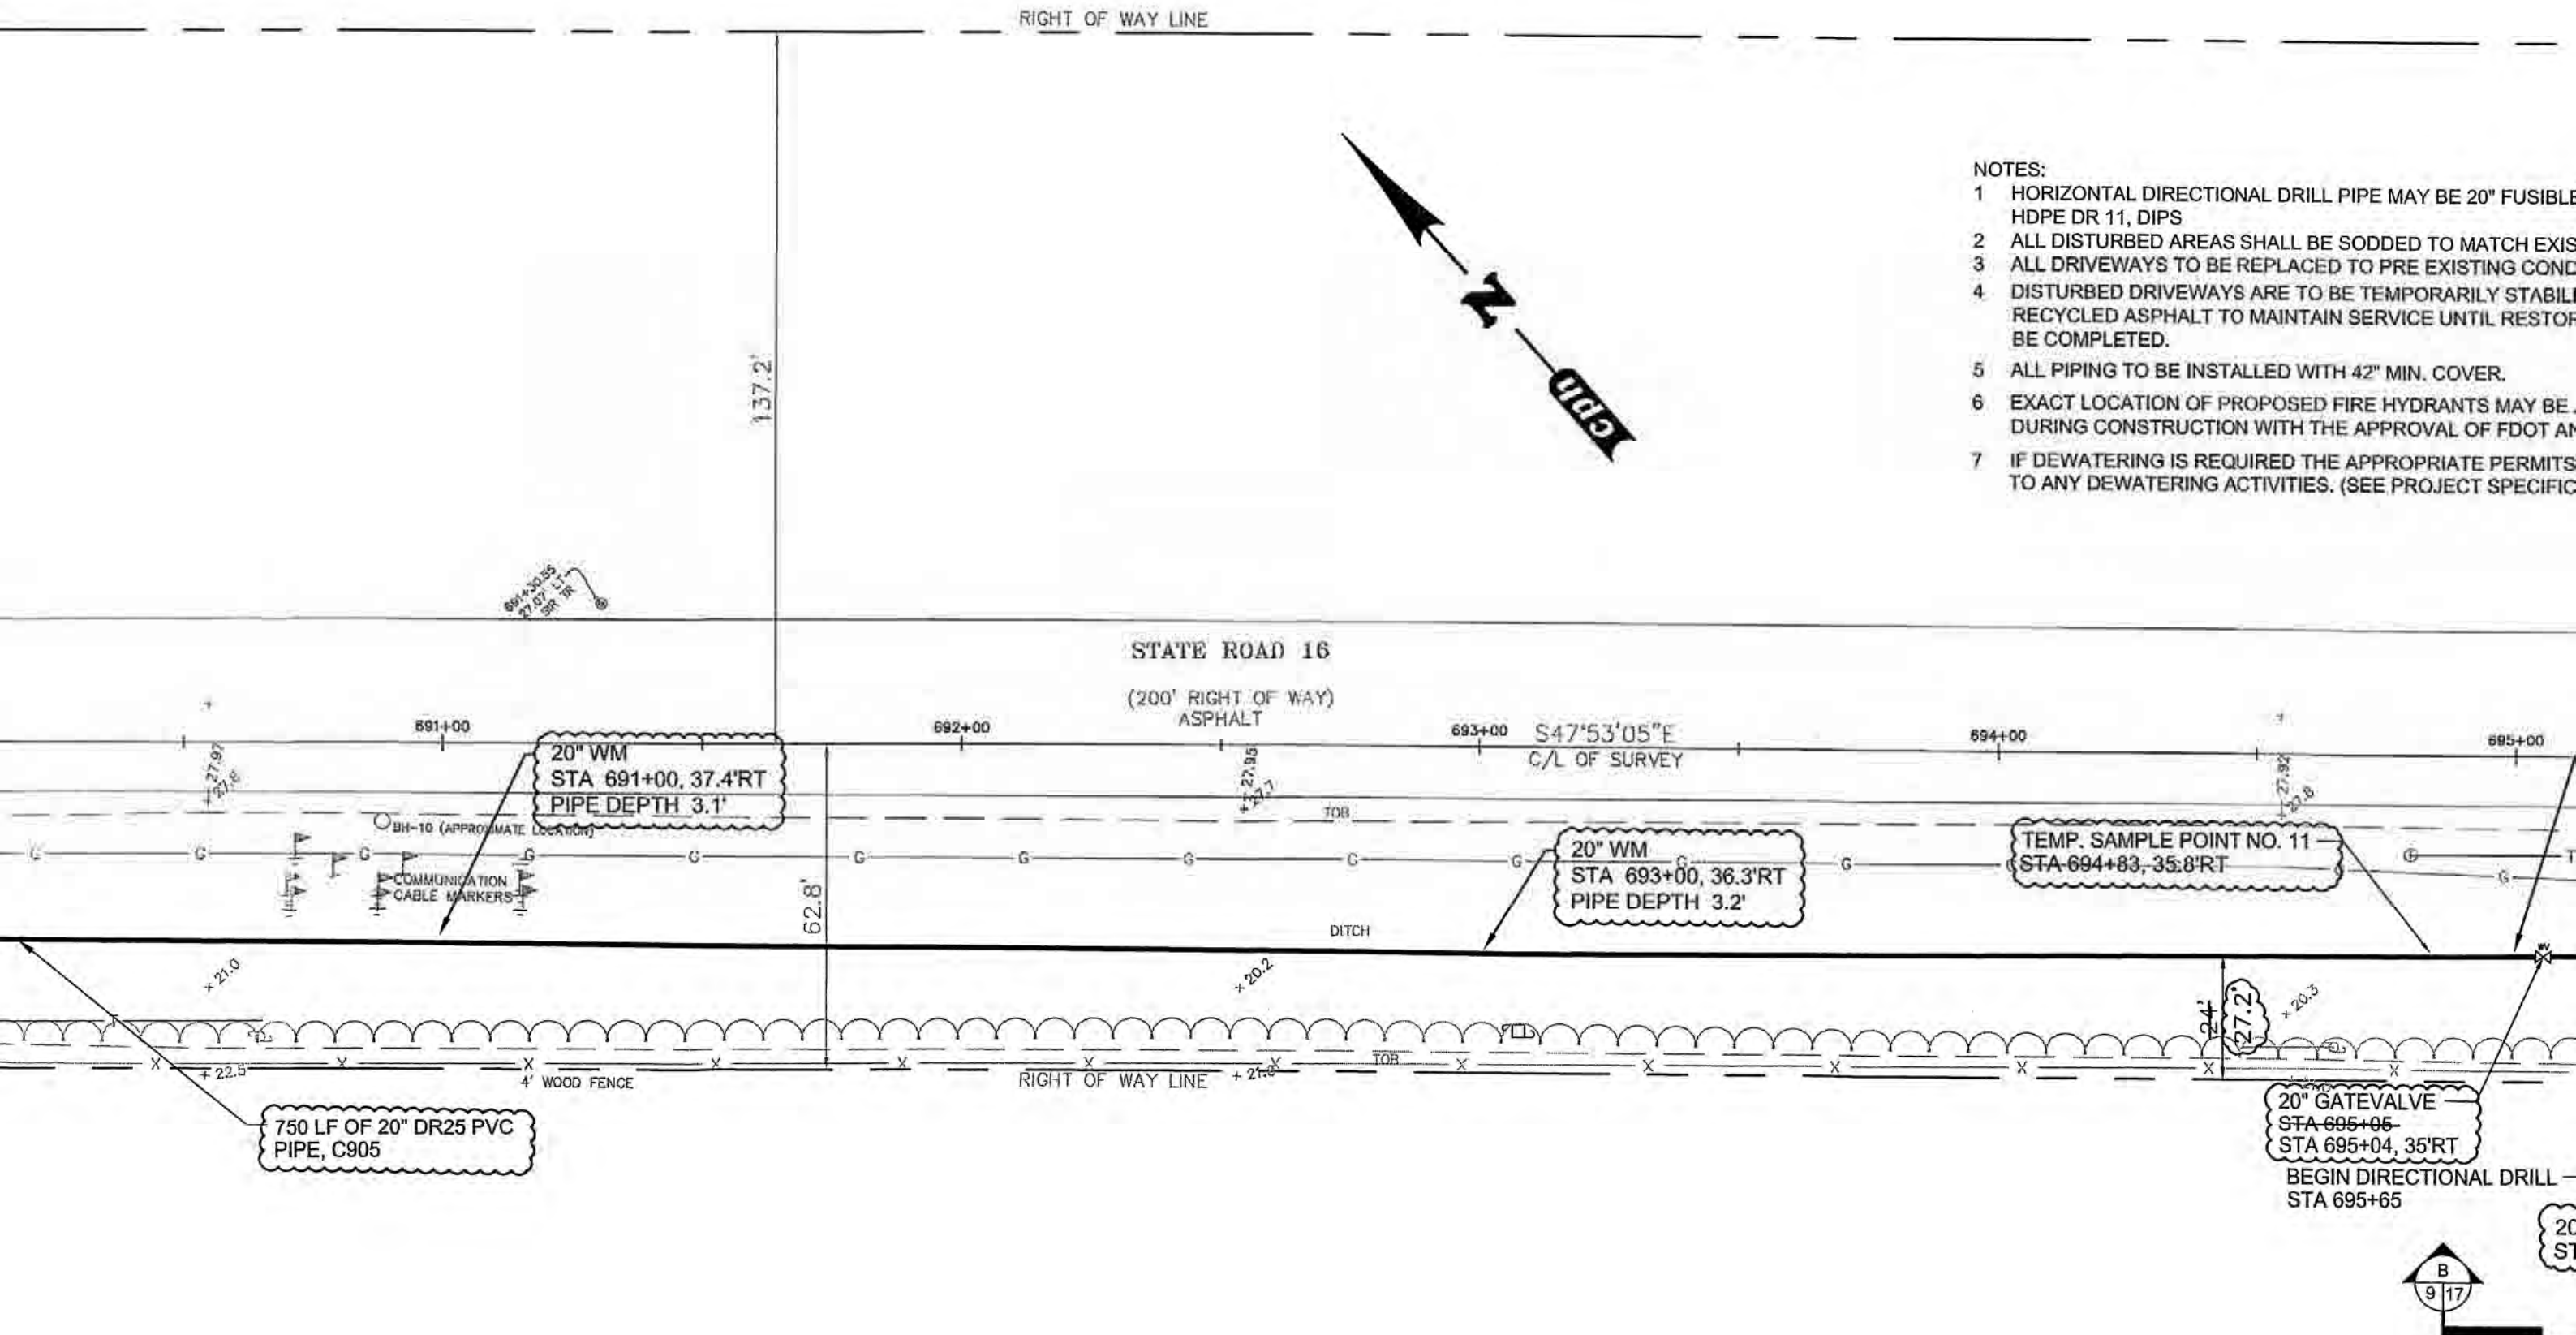




- 1 HORIZONTAL DIRECTIONAL DRILL PIPE MAY BE 20" FUSIBLE
HDPE DR 11, DIPS
- 2 ALL DISTURBED AREAS SHALL BE SODDED TO MATCH EXIS
- 3 ALL DRIVEWAYS TO BE REPLACED TO PRE EXISTING COND
- 4 DISTURBED DRIVEWAYS ARE TO BE TEMPORARILY STABIL
RECYCLED ASPHALT TO MAINTAIN SERVICE UNTIL RESTOR
BE COMPLETED.
- 5 ALL PIPING TO BE INSTALLED WITH 42" MIN. COVER.
- 6 EXACT LOCATION OF PROPOSED FIRE HYDRANTS MAY BE A
DURING CONSTRUCTION WITH THE APPROVAL OF FDOT AN
- 7 IF DEWATERING IS REQUIRED THE APPROPRIATE PERMITS
TO ANY DEWATERING ACTIVITIES. (SEE PROJECT SPECIFIC

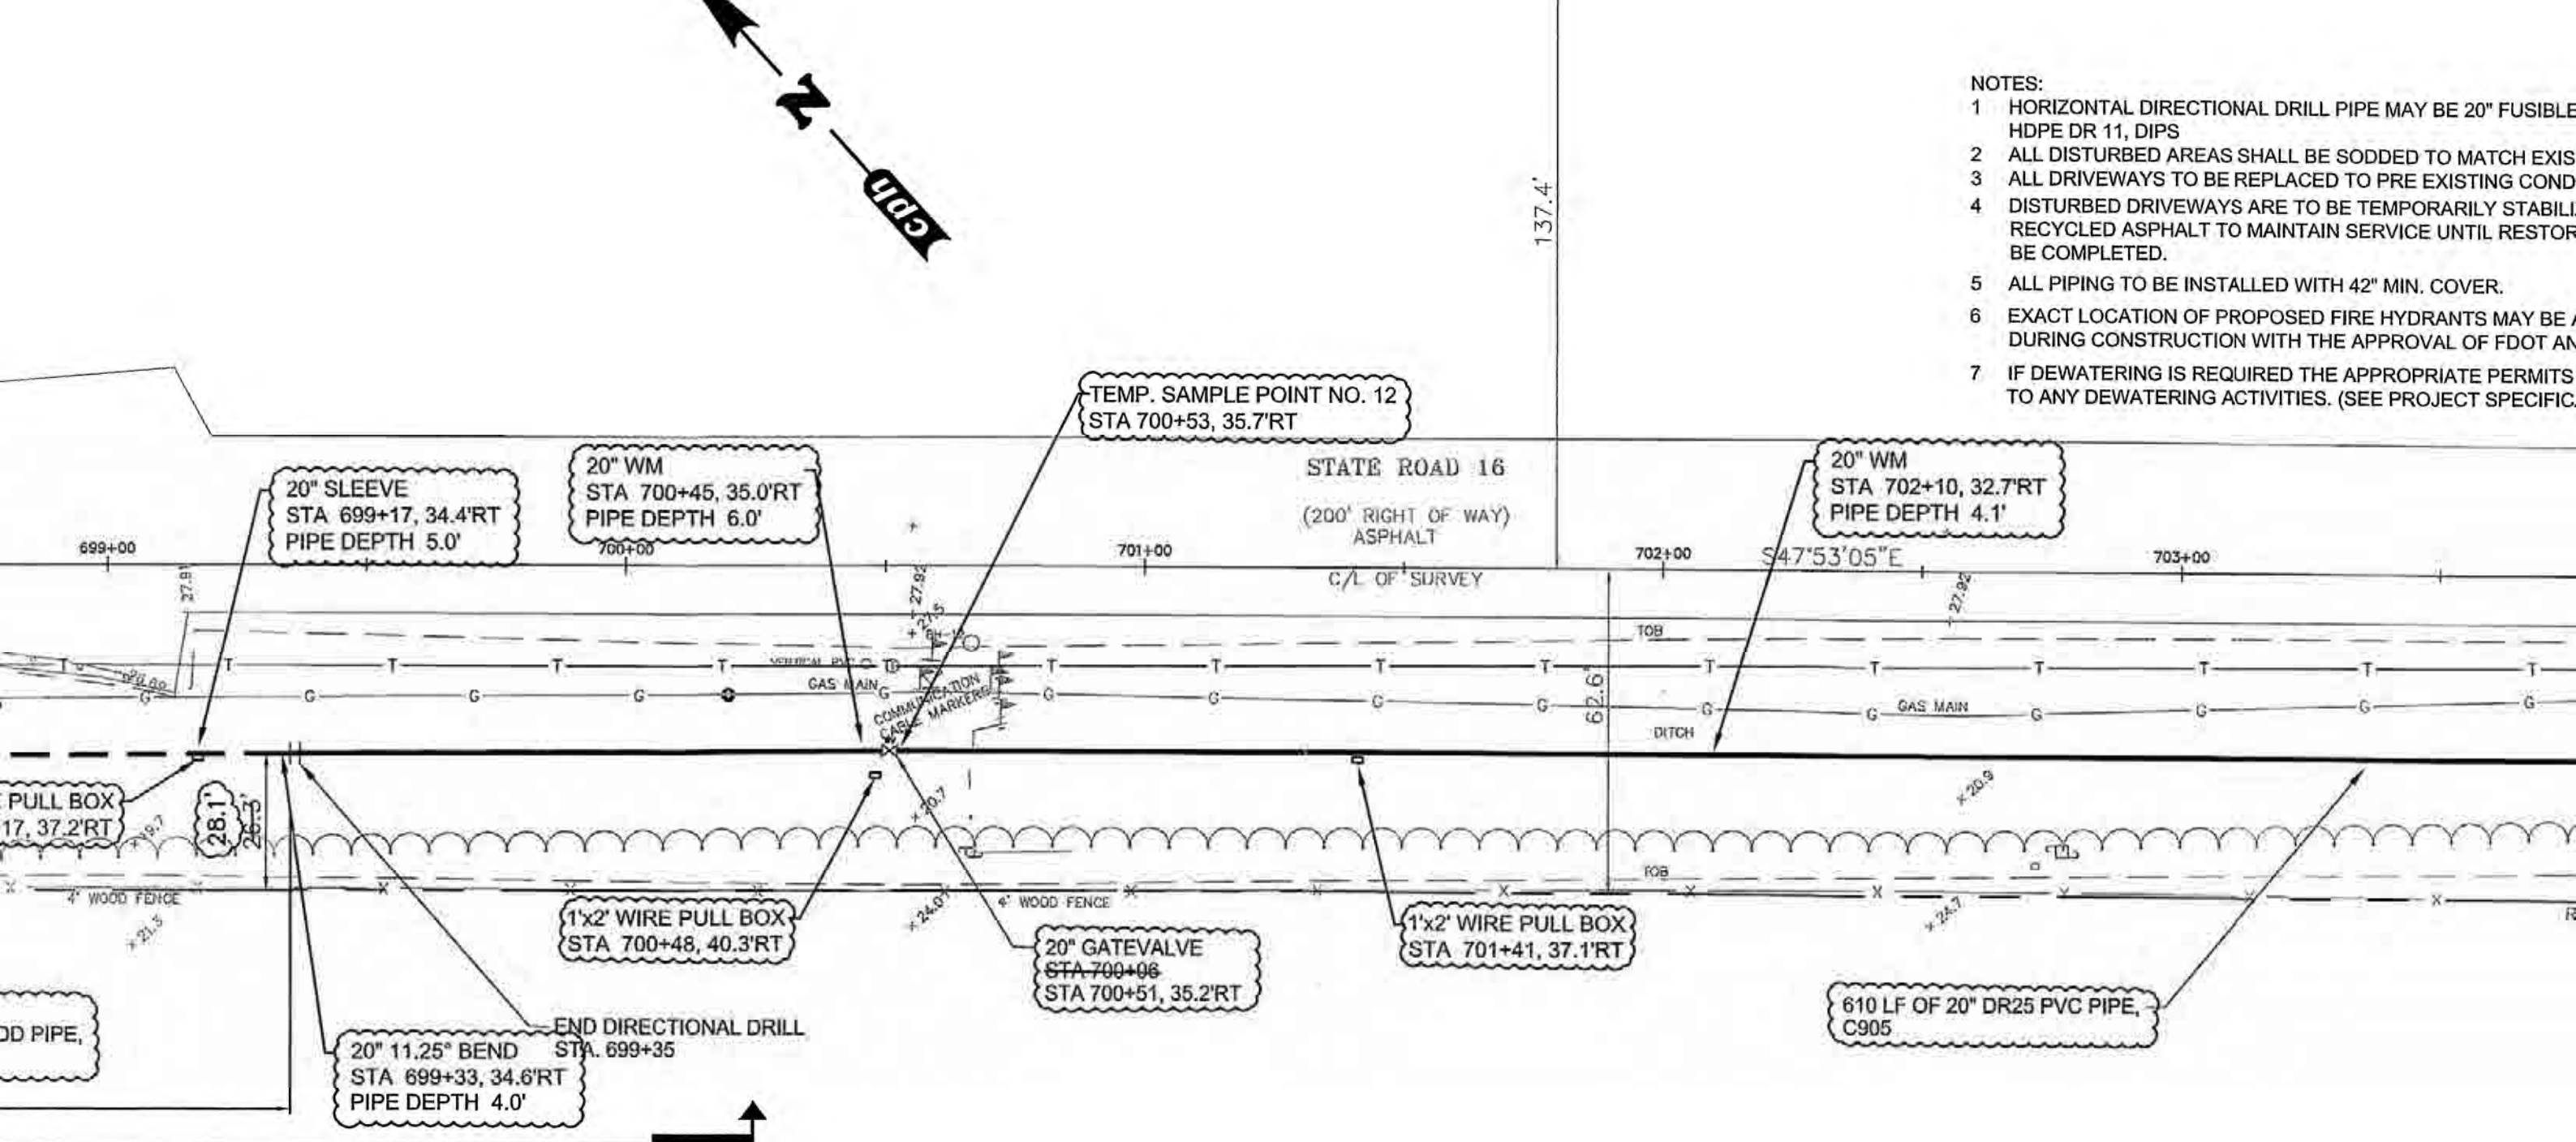


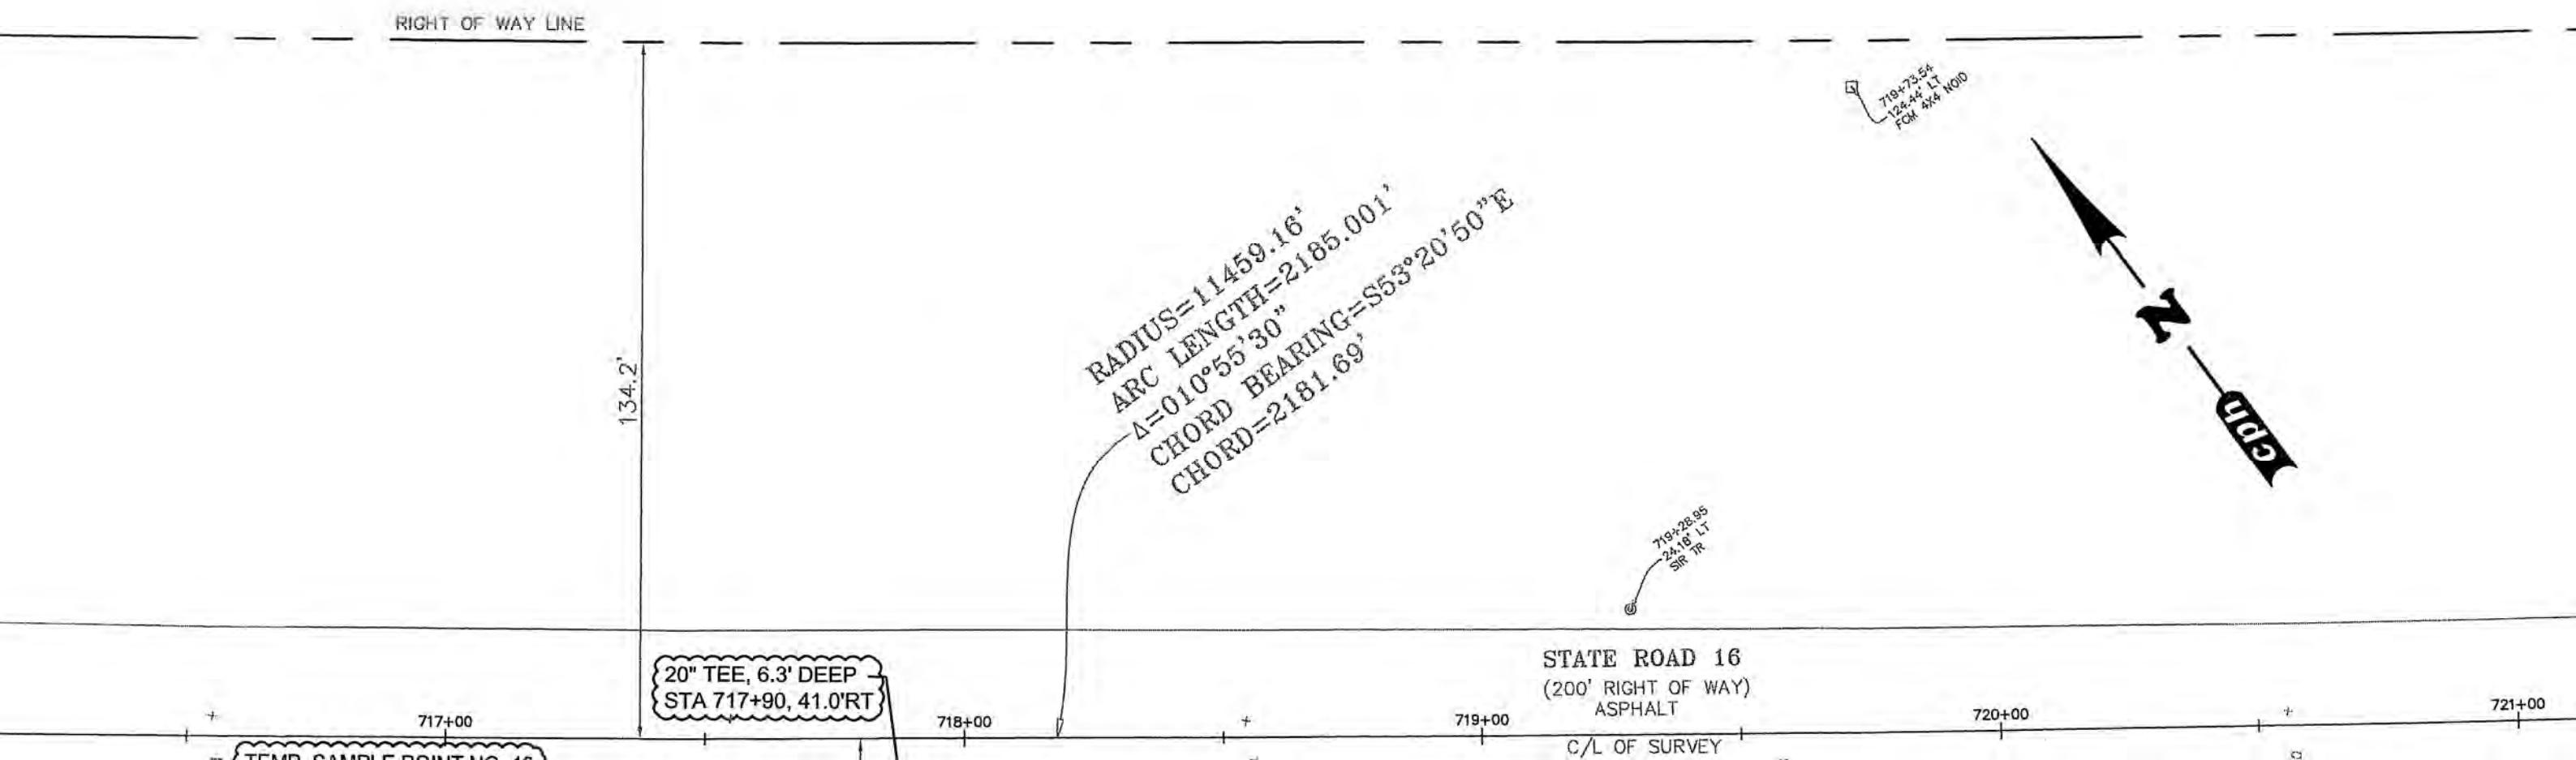


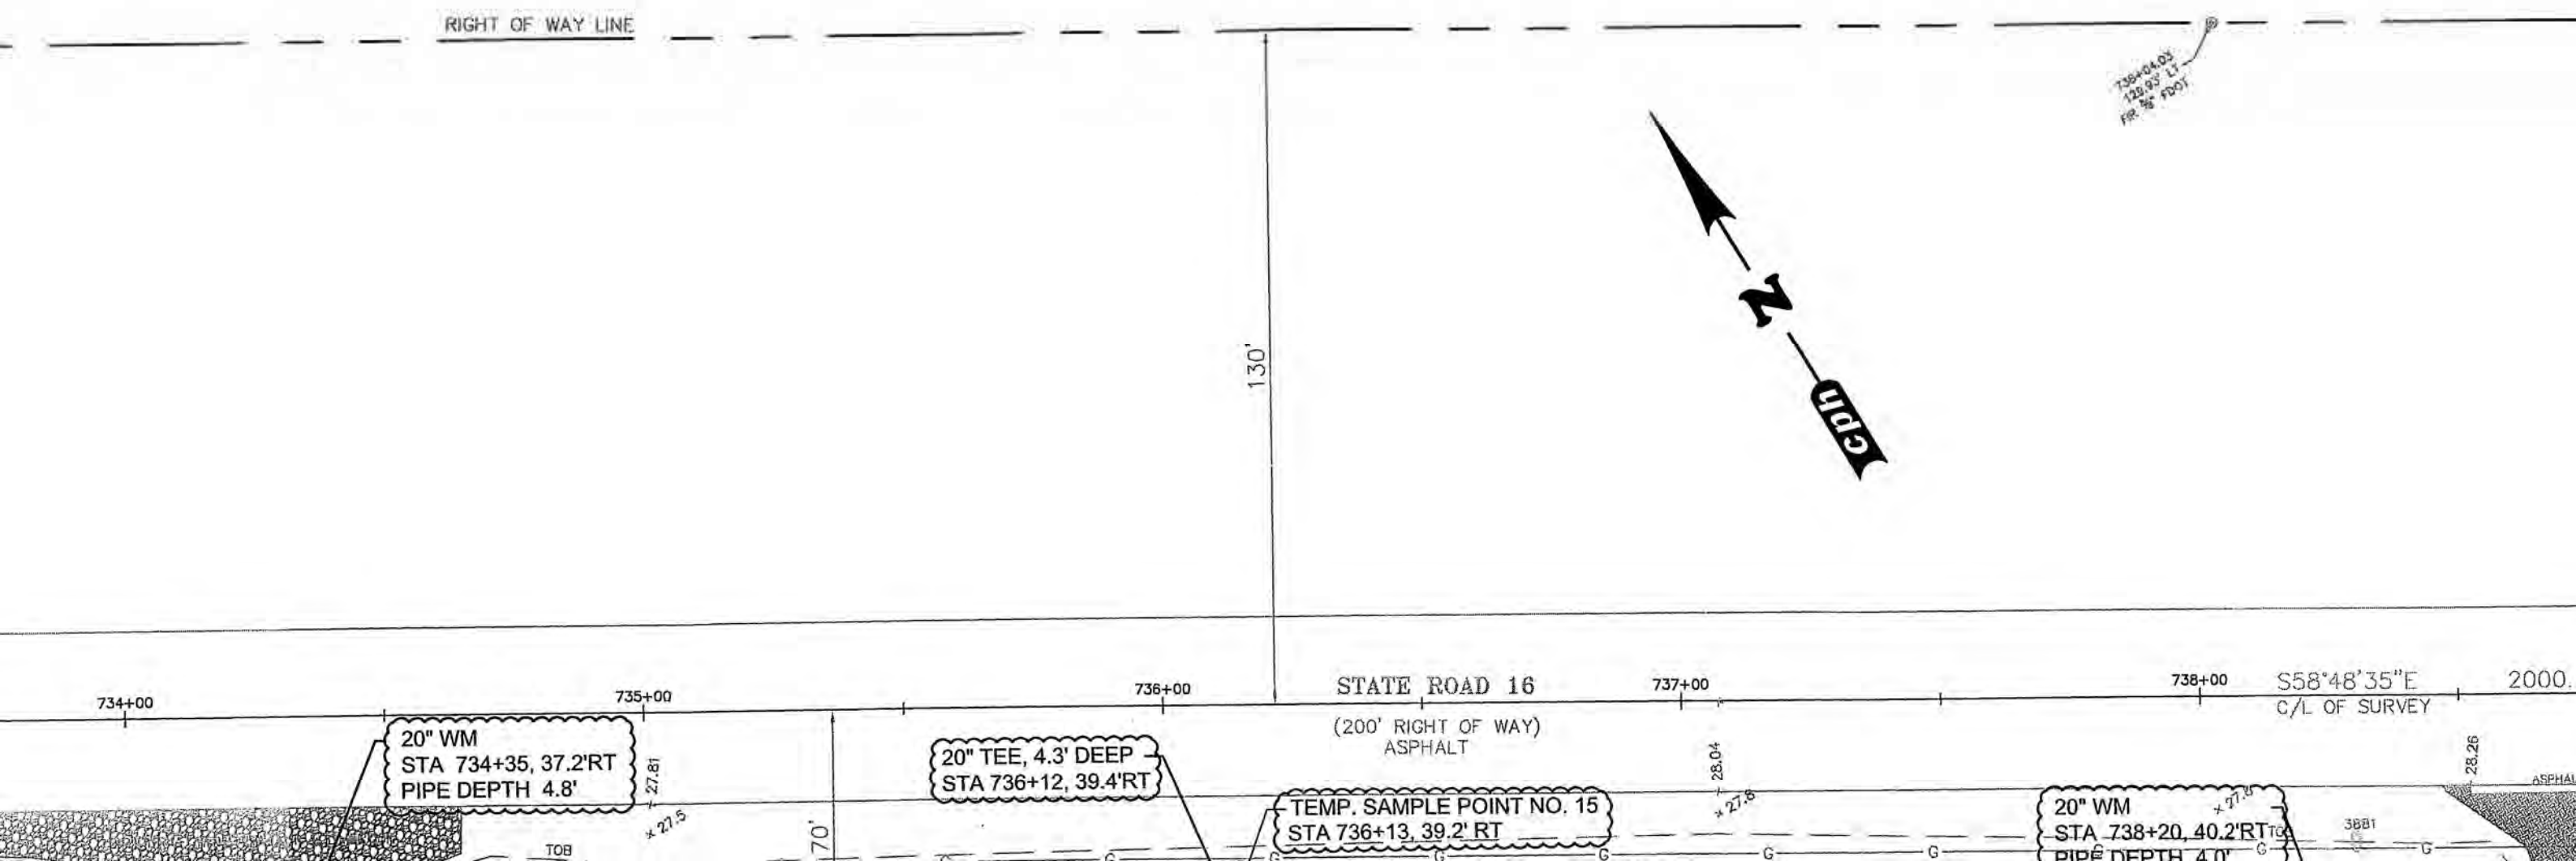


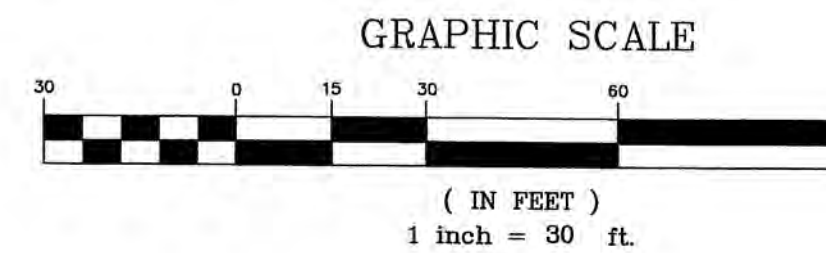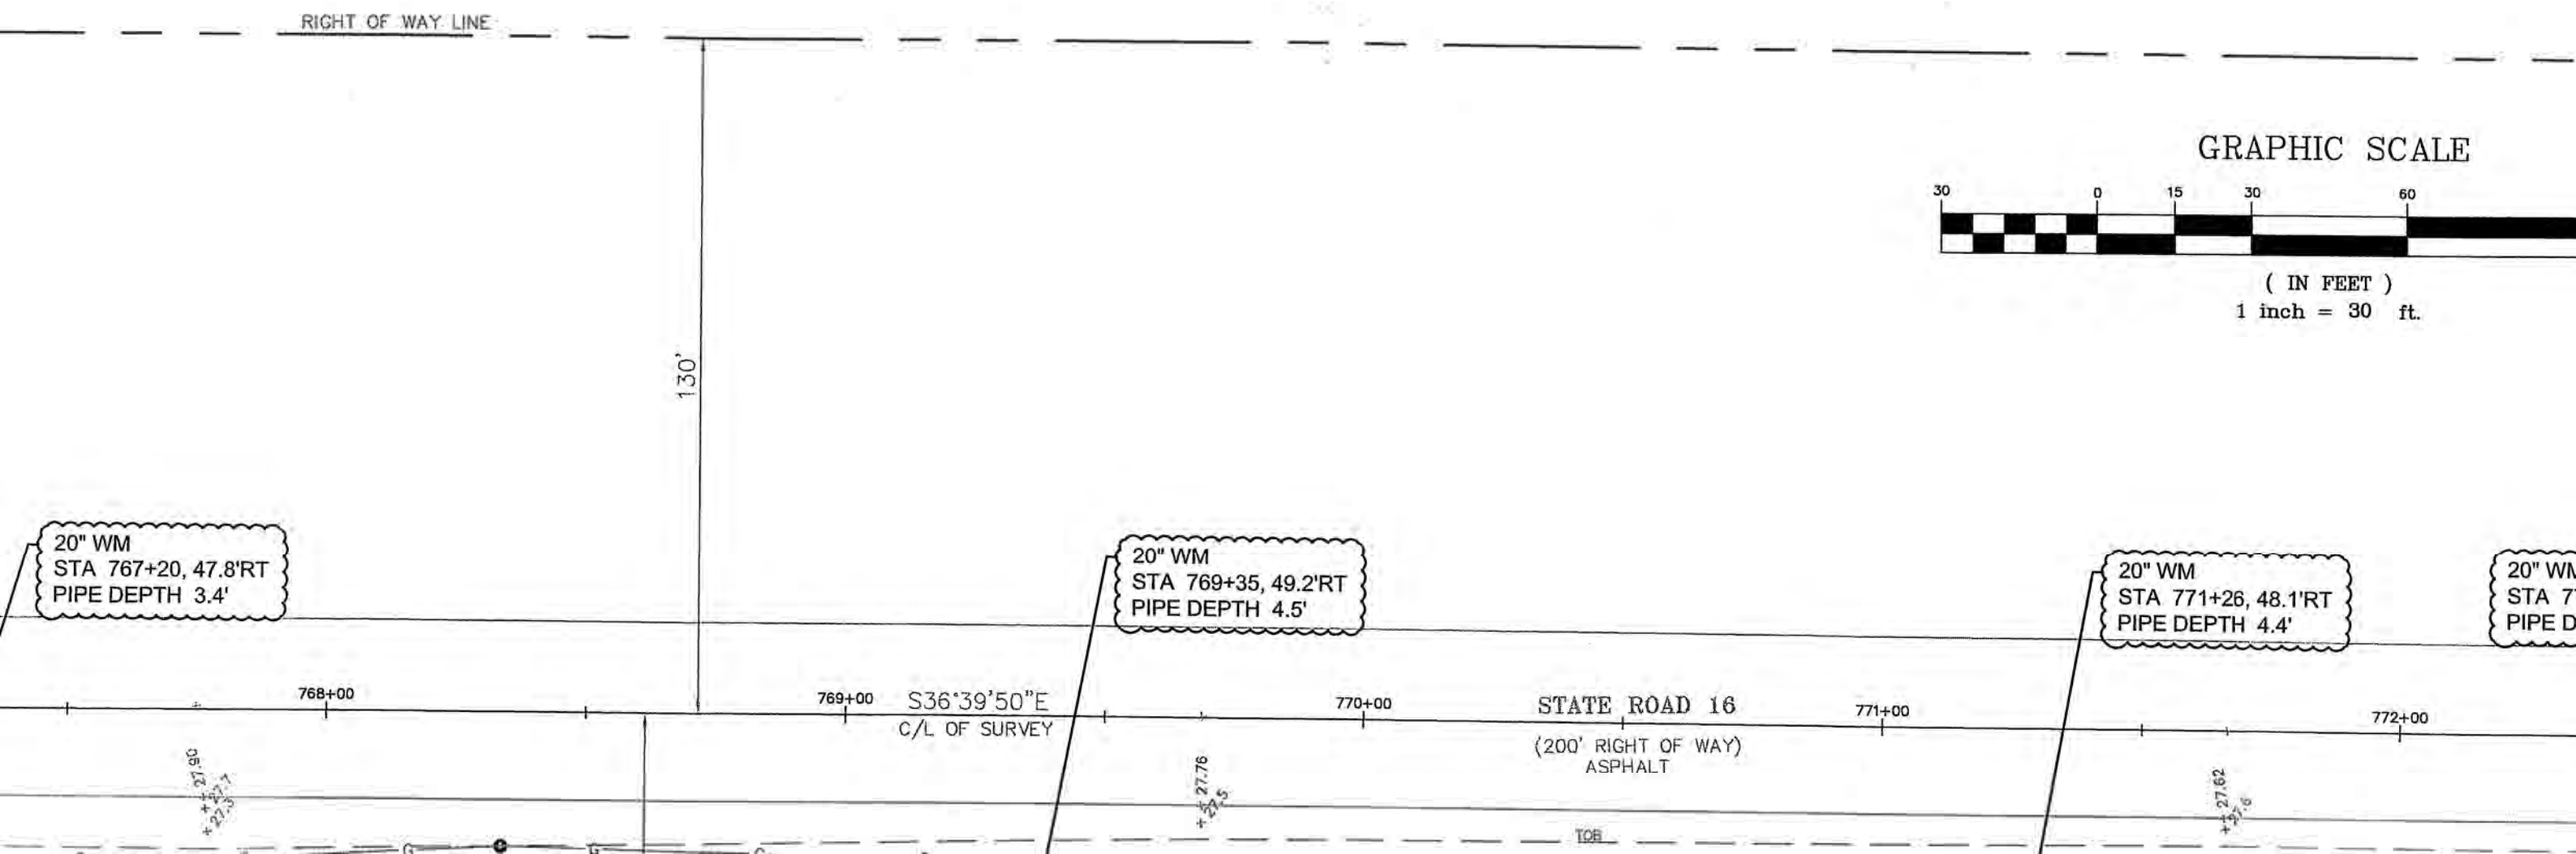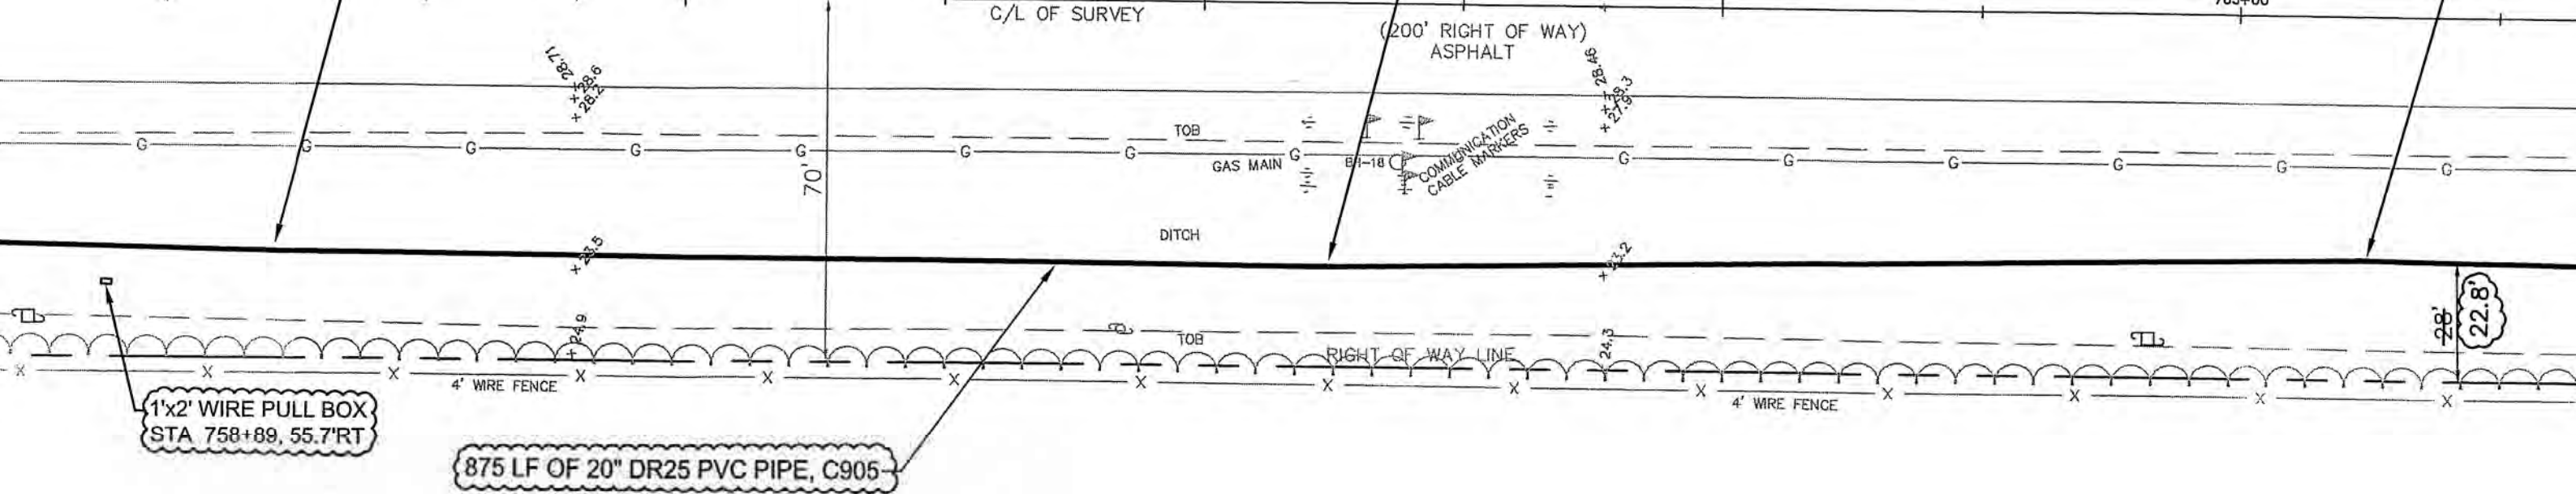


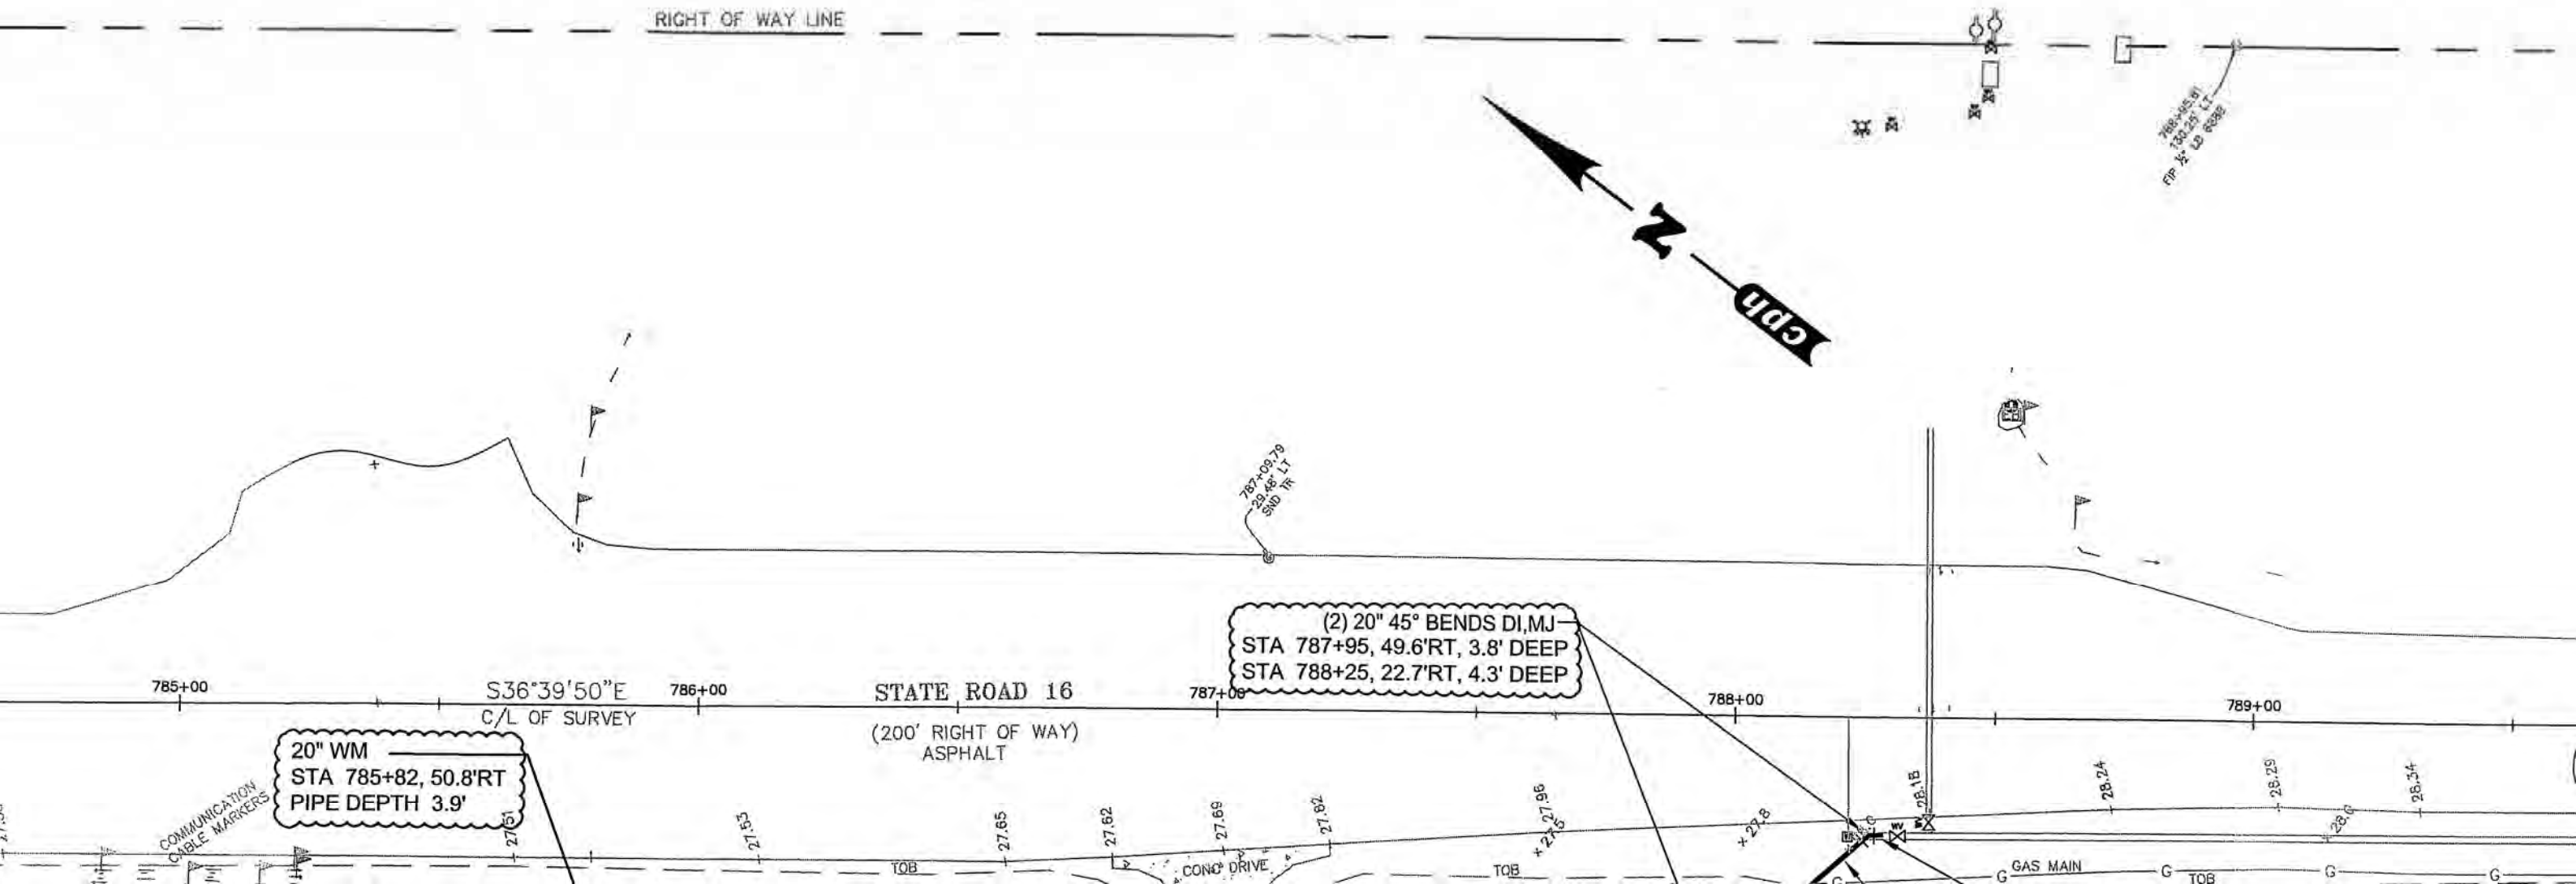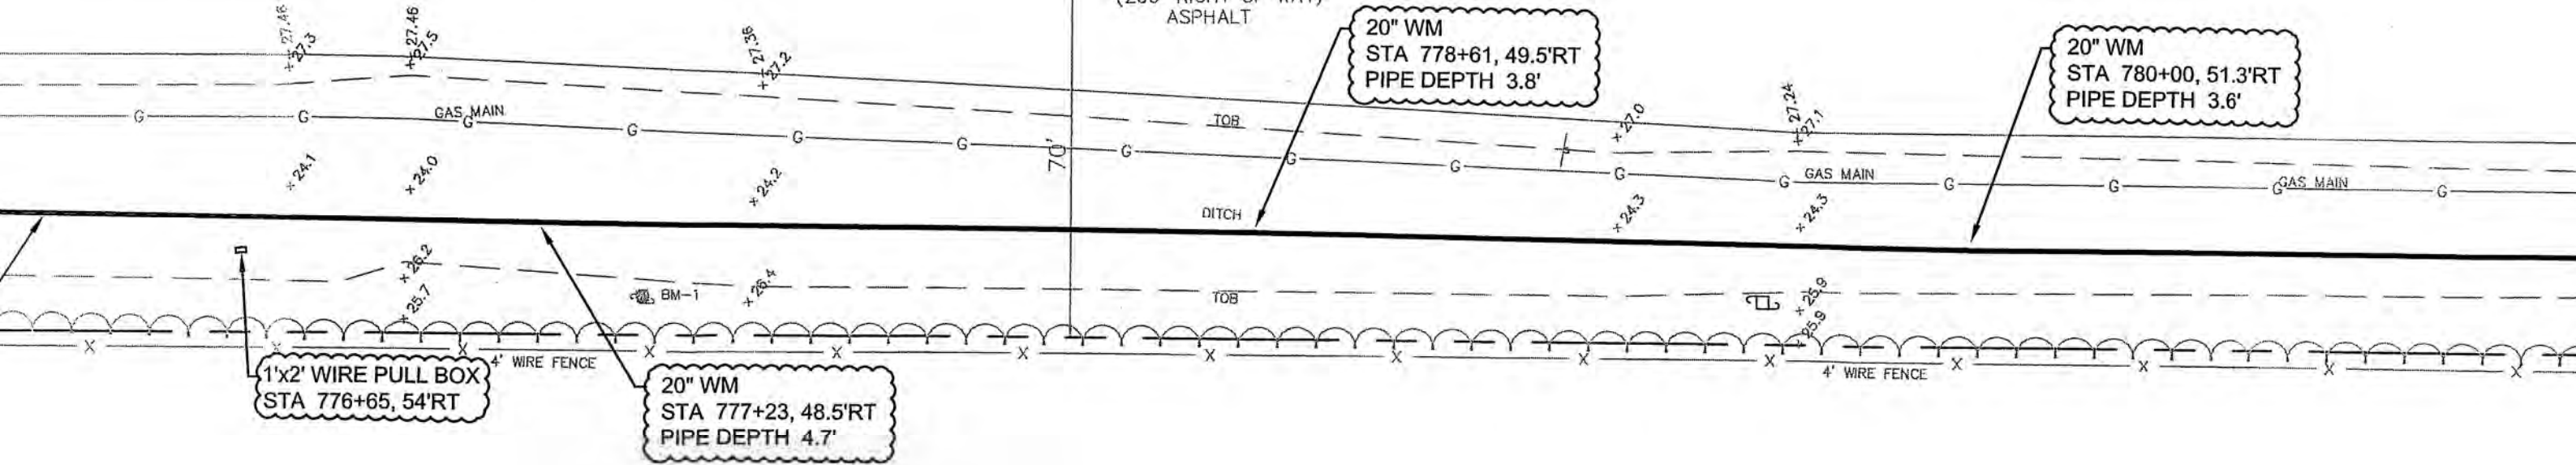

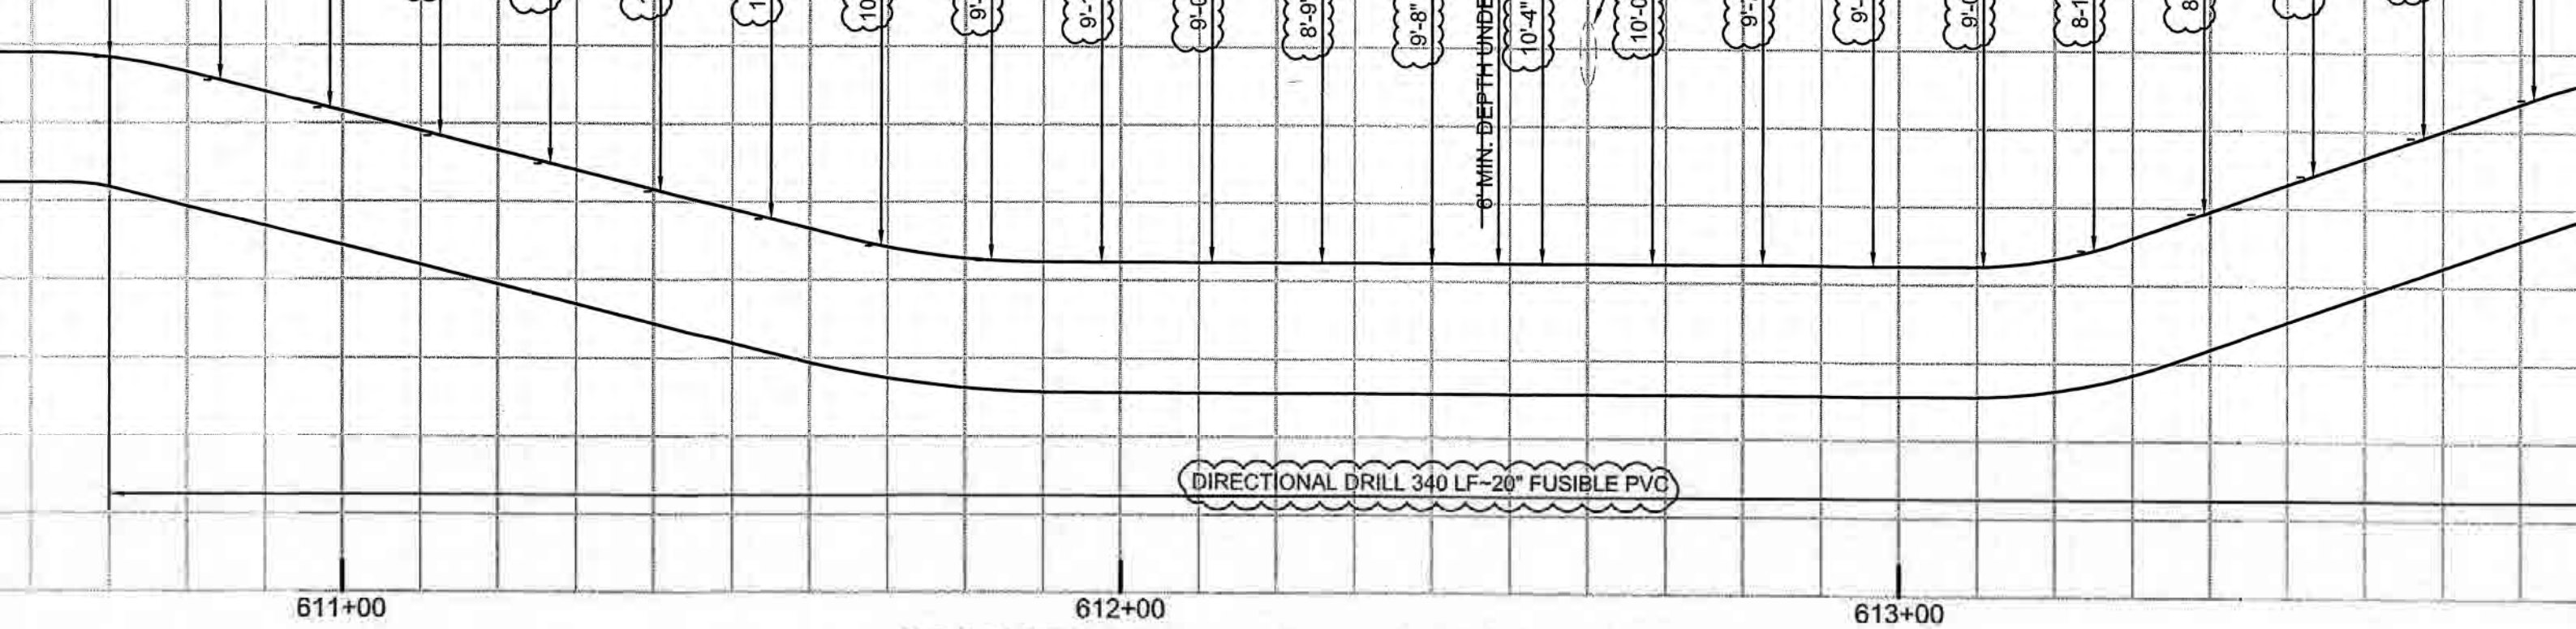

610+70 to Sta. 614+10
Section A Sta. 610+00 to Sta. 614+00
SCALE: 1" = 20' - 1" = 2'

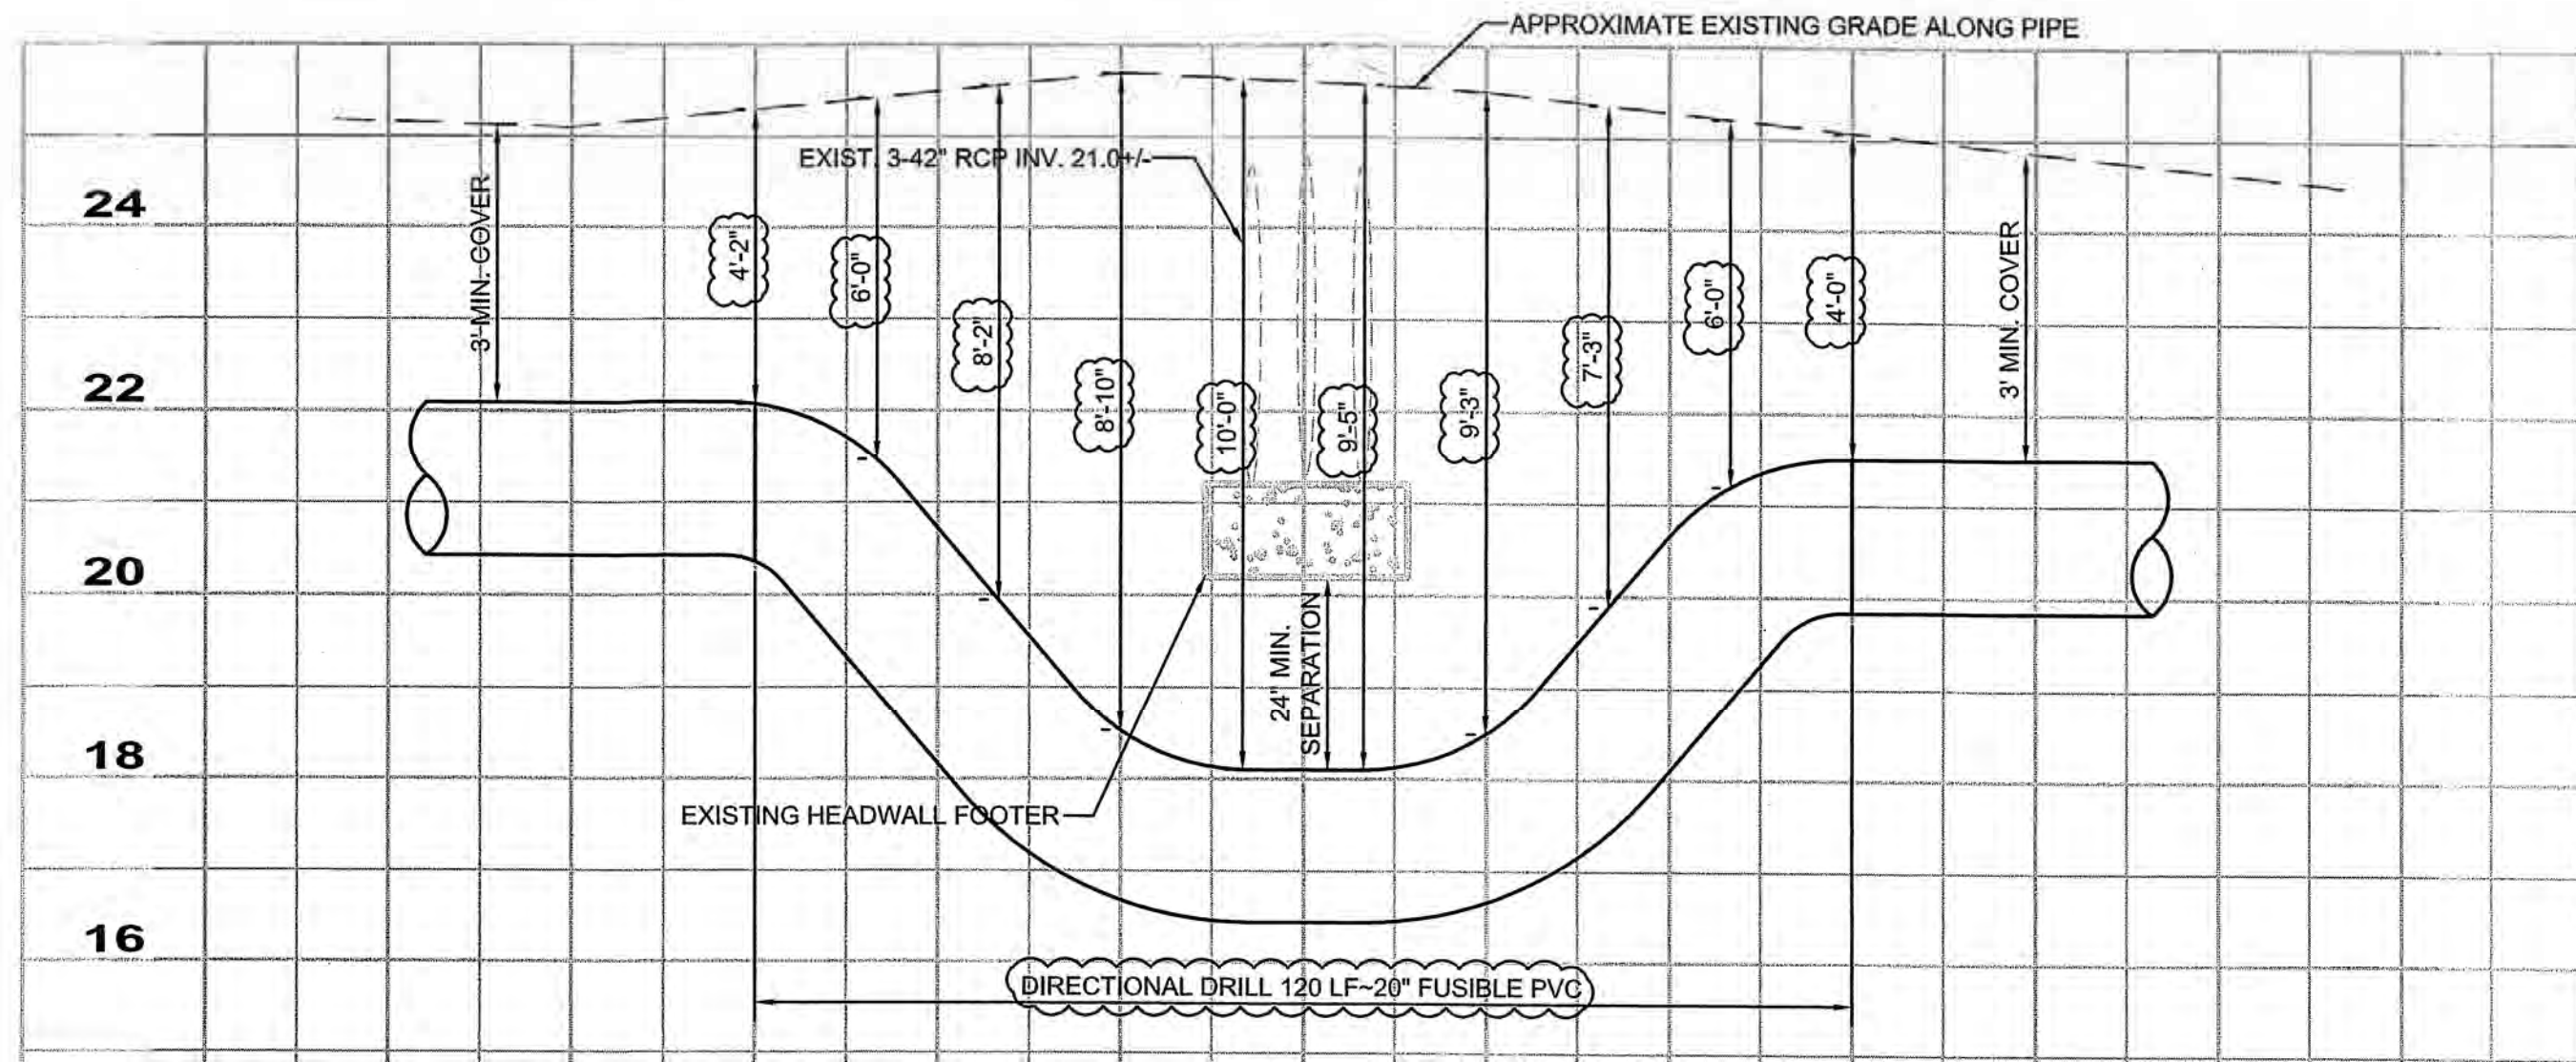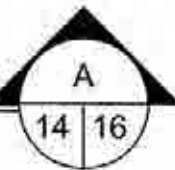

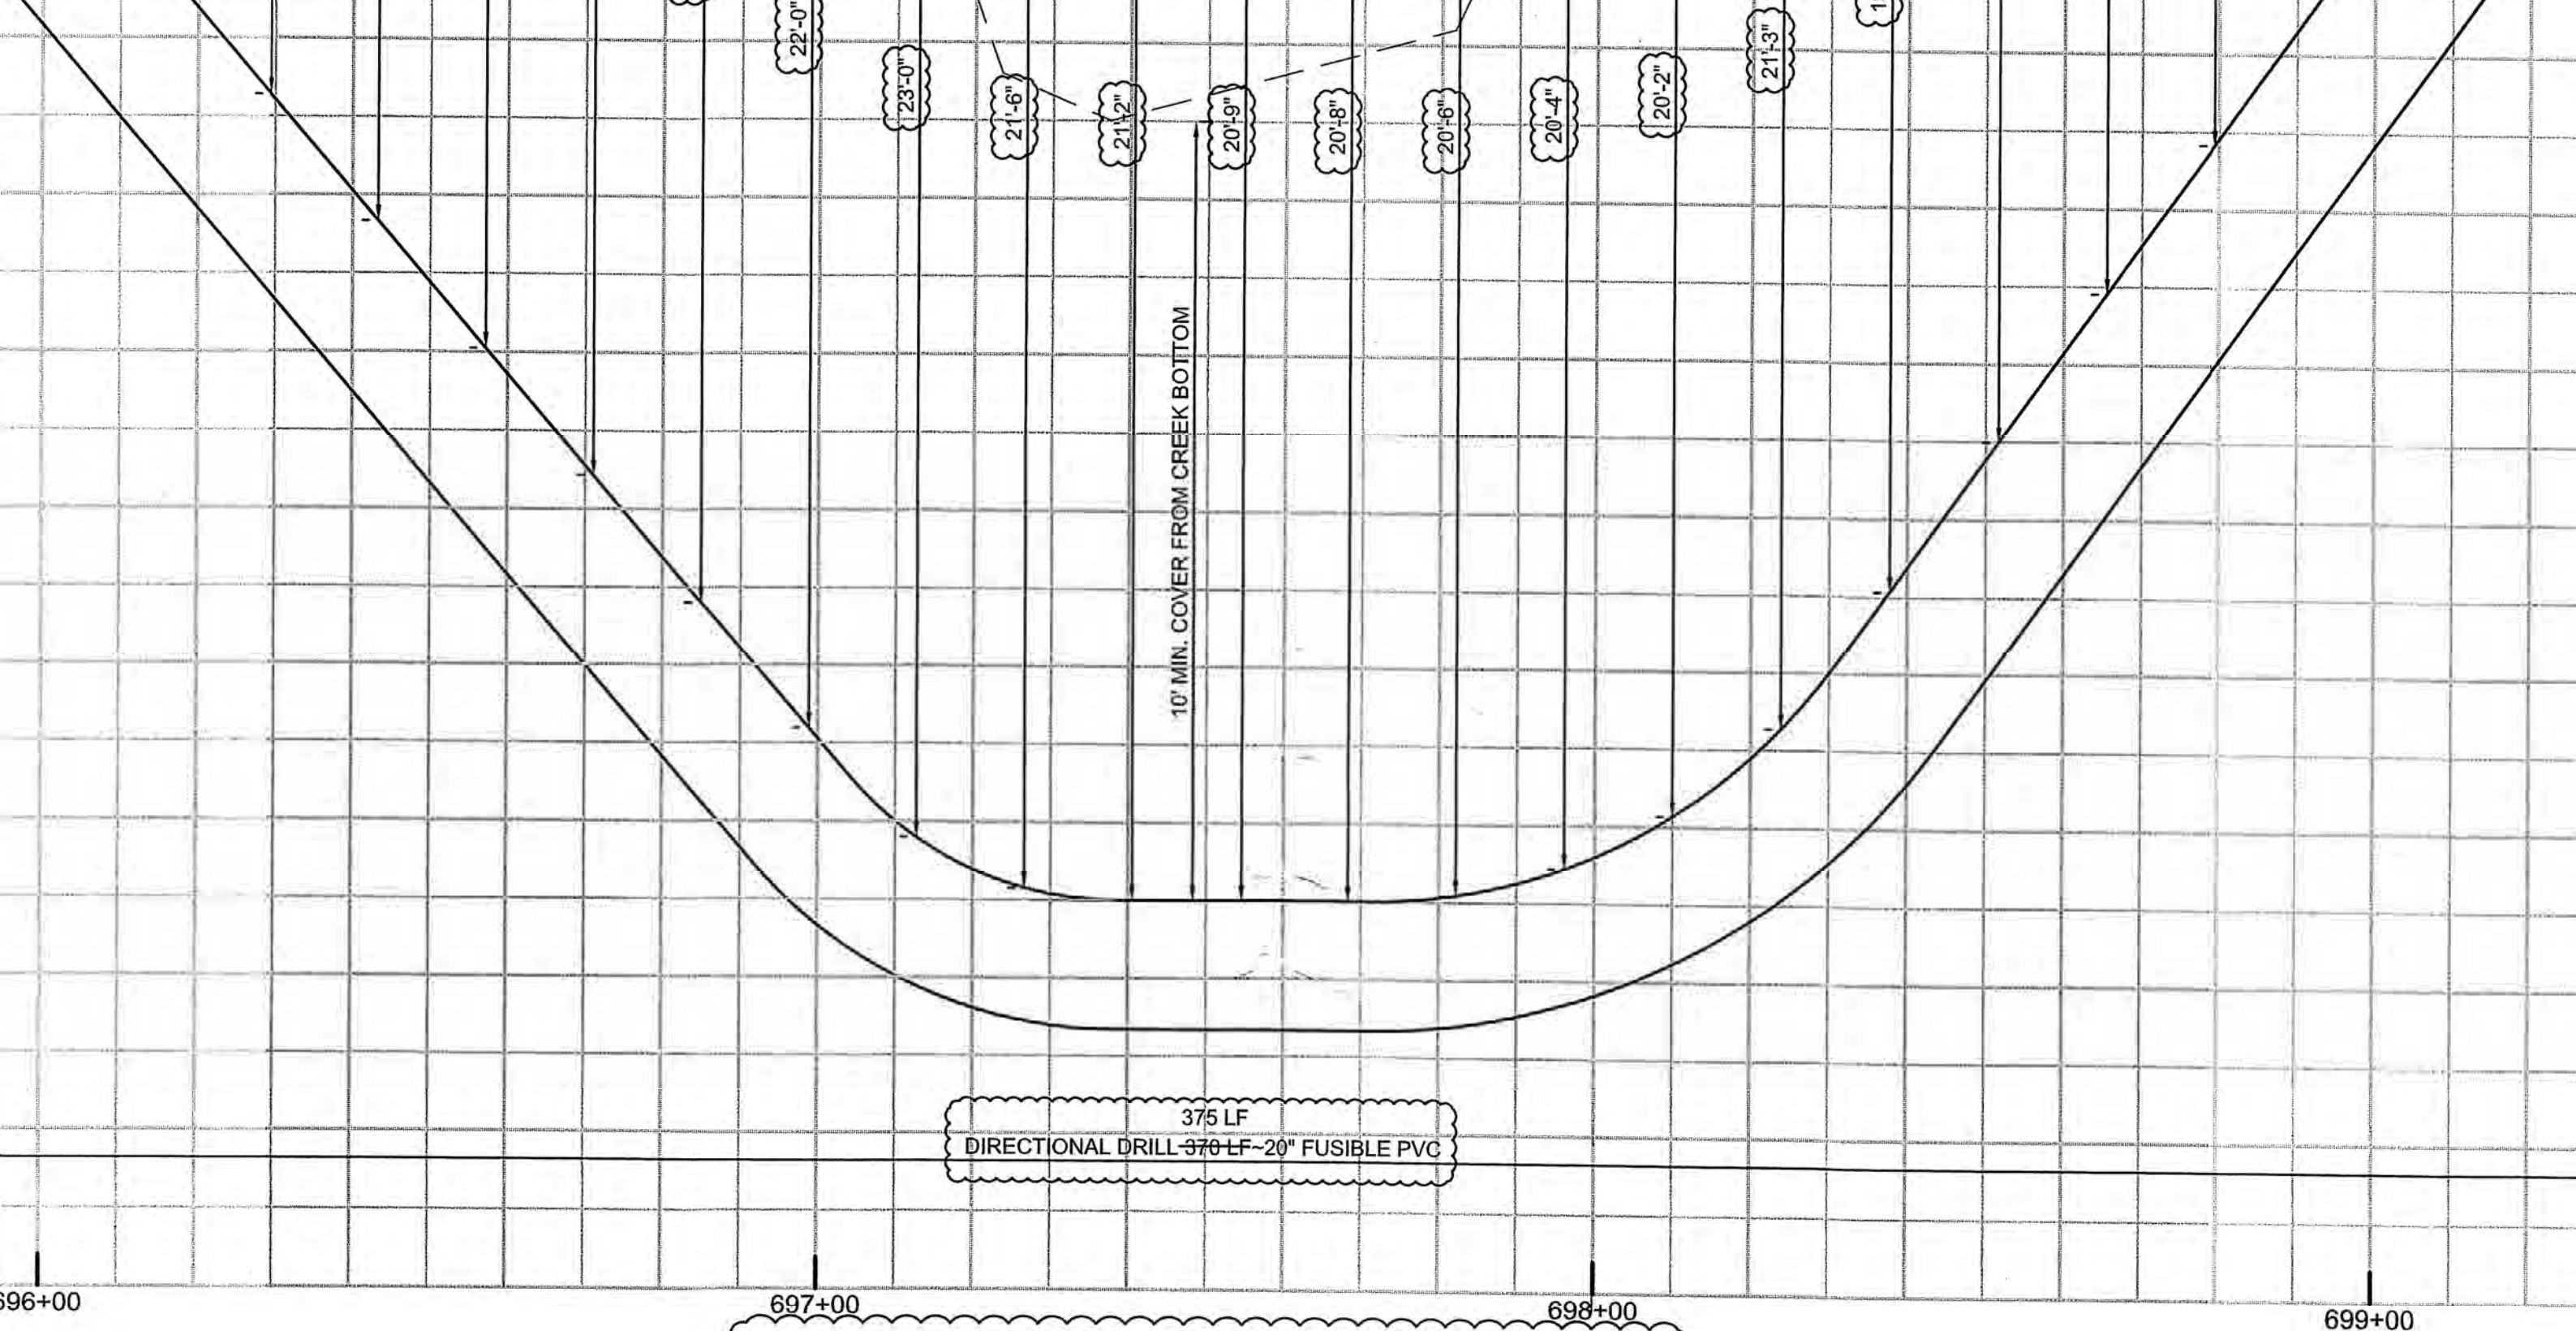

697+00 698+00 699+00

695+60 to Sta. 699+35
Section B Sta. 695+00 to Sta. 700+20


SCALE: 1" = 20' - 1" = 2'

B
14 17

2015 MSW Windward Ranch As Built Drawings



1. JOHNS COUNTY, FLORIDA

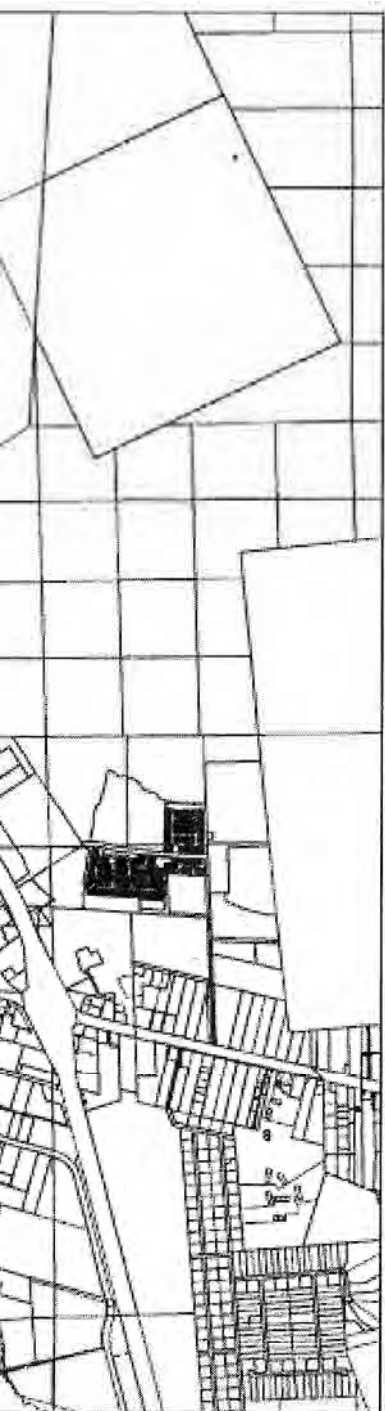

INDEX OF

1

2-4

5

6

7-9

10-12

(Attached

AS-BUILT

INFORMATION PROVIDED BY:

OUT PARCEL
OFFICIAL RECORDS
1646, PAGE 13



L.F. ~
(SDR26)
S = 0.39%

225 L.F. ~
PVC (SDR35)
S = 0.40%
0.38%

33.01

SMF-04 STORMWATER
MANAGEMENT FACILITY
EASEMENT FOR DRAINAGE
ACCESS AND MAINTENANCE

NORMAL WATER LEVEL
TOP OF BANK

204 L.F. ~
PVC (SDR26)
S = 0.40%
0.40%

MH# 78, TYPE "A", JUNCT. MH
(STA. 52+21.23, 0.54' L)
TOP EL. = 30.75
INV. IN = 21.36 SE 21.40
INV. IN = 23.21 SW 23.25
INV. OUT = 21.26 NW 21.30

142 L.F. ~
PVC (SDR35)
S = 0.40%
0.38%

276 L.F. ~
PVC (SDR35)
S = 0.40%
0.41%


20.0'
DRAINAGE
EASEMENT

200 L.F. ~
PVC (SDR35)
S = 0.40%

ALT CAY PLACE

SAINT KITTS LOOP




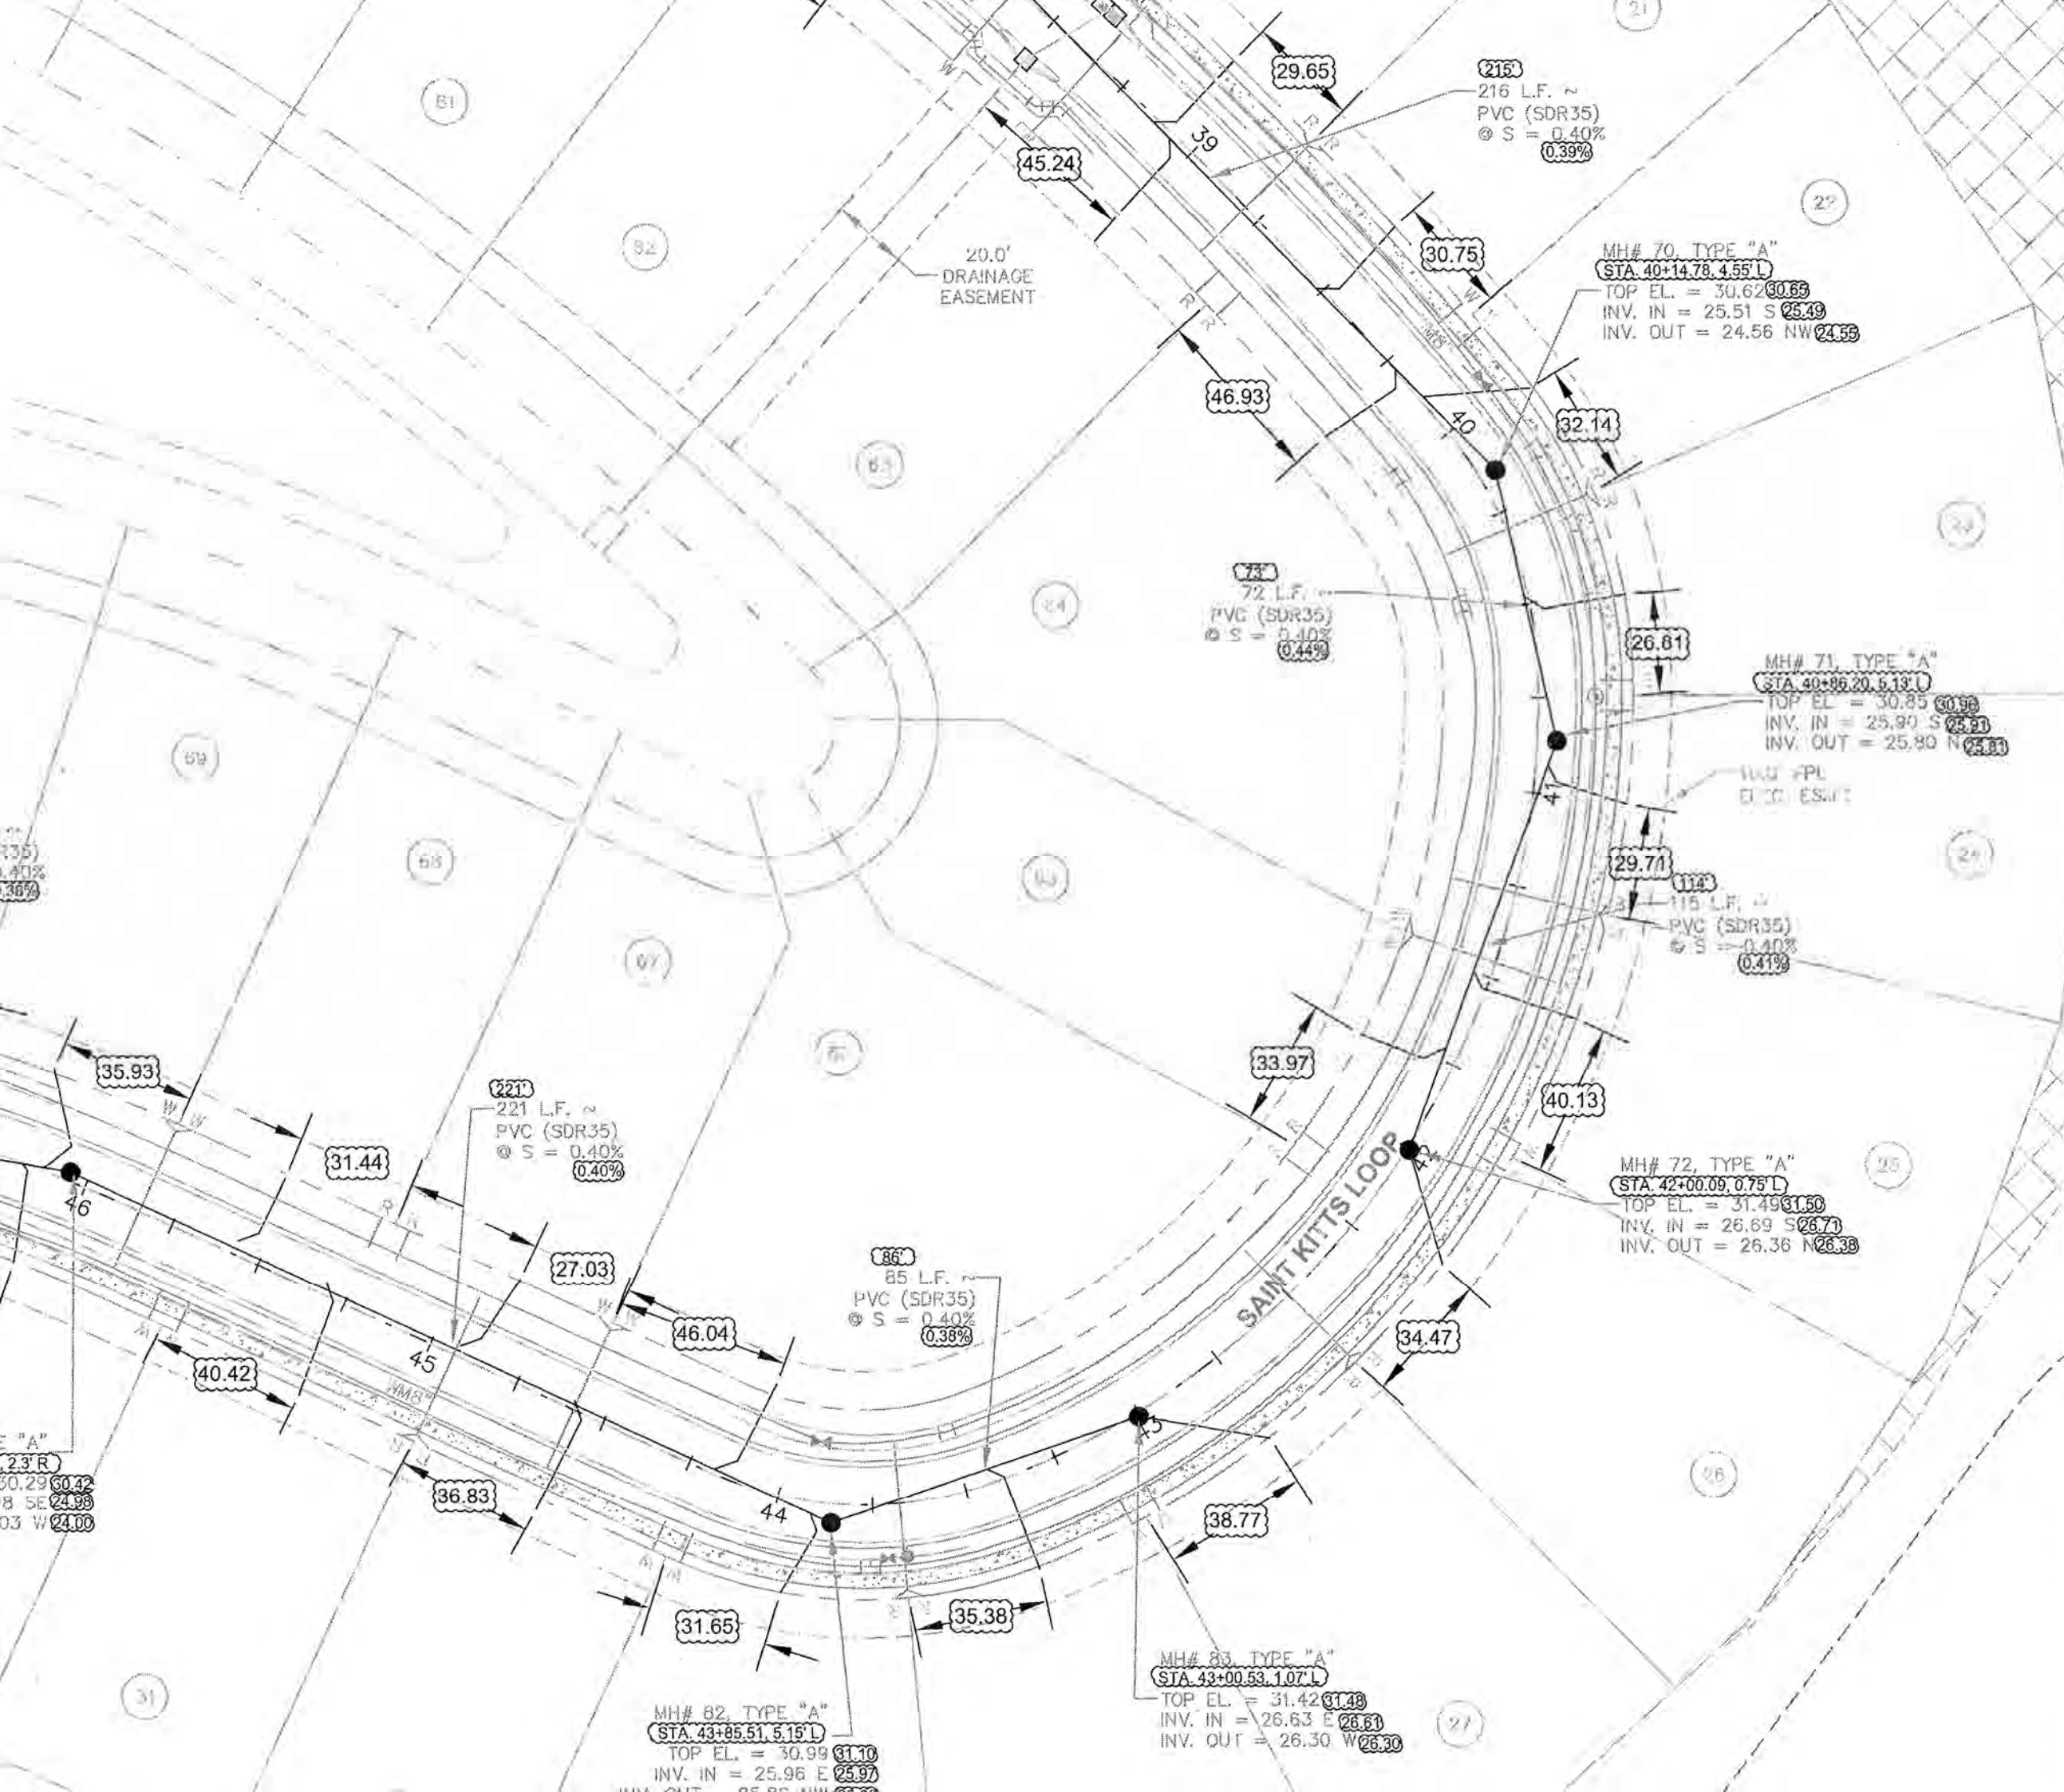

Lot	20	Sewer Service
Lot	21	Sewer Service
Lot	22	Sewer Service
Lot	76	Sewer Service



FM-2013	CL 8"X4" REDUCER	18+
FM-2014	CL 8" 45° BEND	18+
FM-2015	CL 8" 45° BEND	18+
FM-2016	CL 8"X6" REDUCER	18+
FM-2017	CL 6" X4" TEE	18+
FM-2018	CL 6"X4" REDUCER	18+
FM-2019	CL 4" GATE VALVE	18+
FM-2020	CL 4" GATE VALVE	18+
FM-2021	CL 4" 45° BEND	18-
FM-2022	CL 4" 45° BEND	18-
FM-2023	CL 4" 90° BEND	18-
FM-2024	CL 4" GATE VALVE	18-
FM-2025	CL 2" FLUSHING HYDRANT	24+
FM-2026	CL 2" FLUSHING HYDRANT	19-
FM-2027	CL 8" AIR RELEASE VALVE	12-

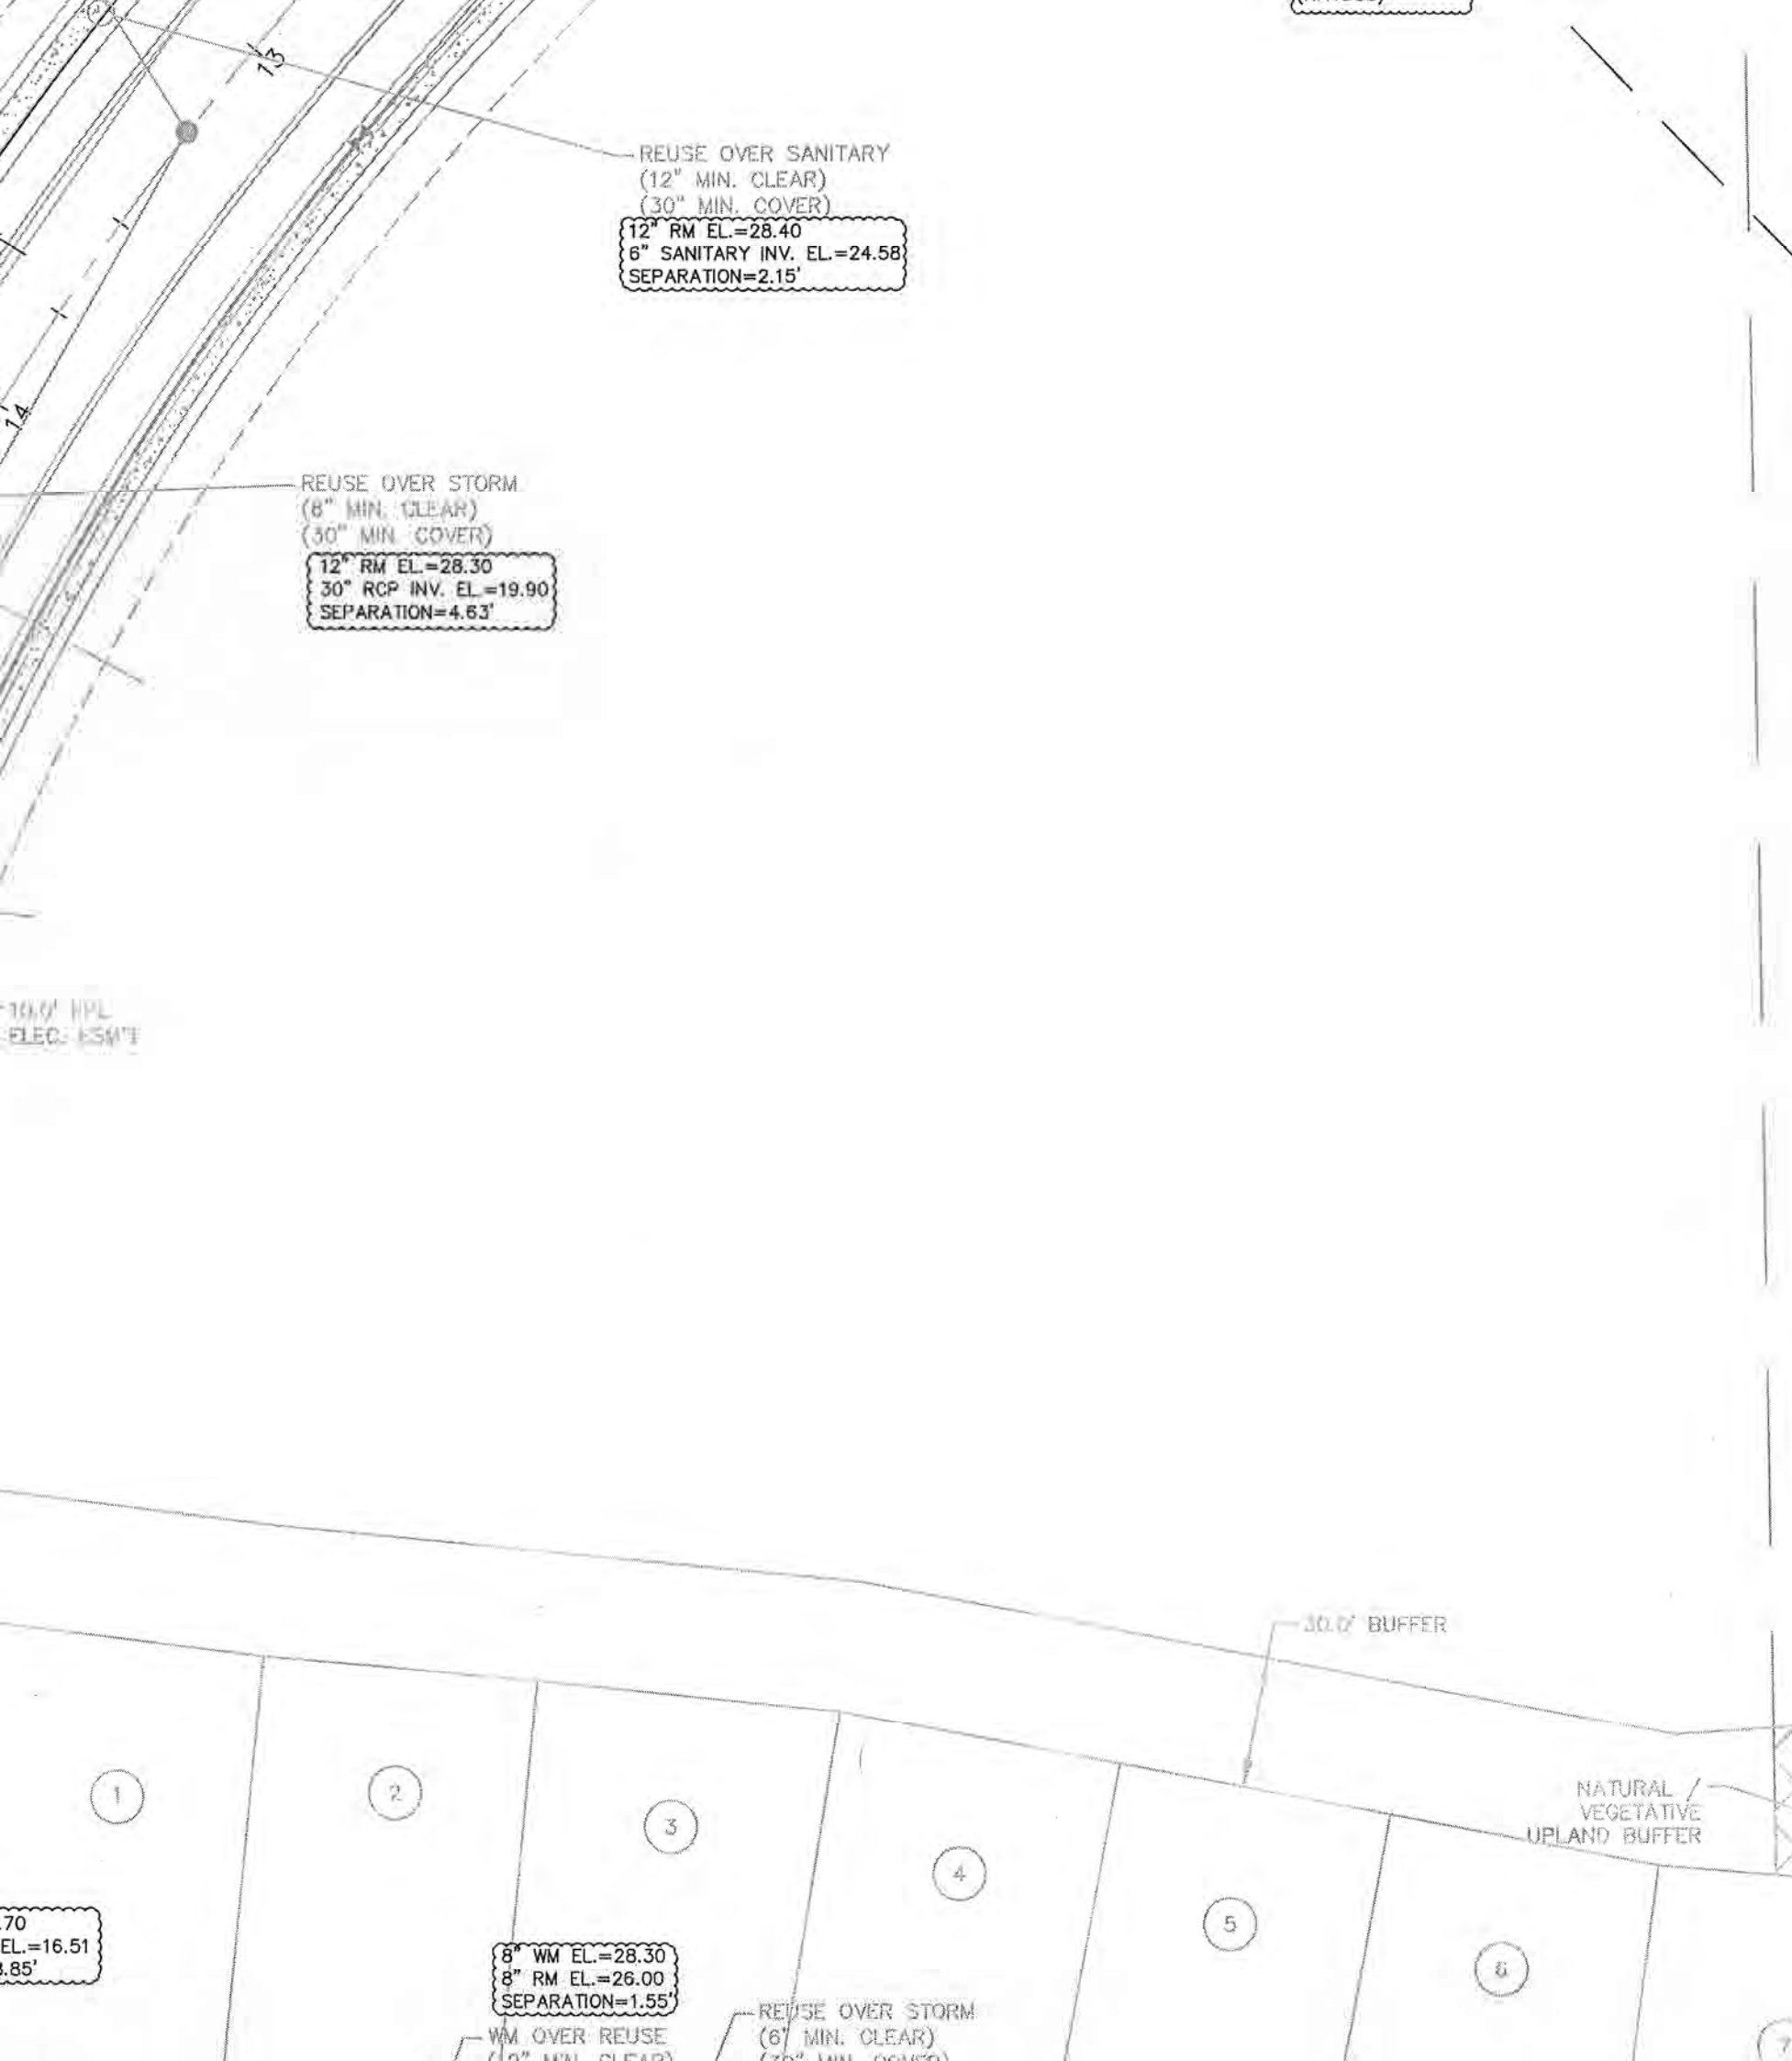


RM-4026	CL 8" 45° BEND	58+26, 19.2' R	26.80	30.70
RM-4027	CL 8" 45° BEND	28+35, 17.0' R	27.40	31.00
RM-4028	CL 8" REUSEMAIN	29+48, 18.7' R	27.80	31.30
RM-4029	CL 8" 22½° BEND	30+56, 22.3' R	27.90	31.10
RM-4030	CL 8" REUSEMAIN	31+96, 17.4' R	27.20	30.70
RM-4031	CL 8" REUSEMAIN	33+27, 17.3' R	27.60	30.70
RM-4032	CL 8" REUSEMAIN	34+25, 17.1' R	27.20	30.90
RM-4033	CL 8" REUSEMAIN	35+23, 17.4' R	27.70	31.30
RM-4034	CL 8" GATE VALVE	36+07, 17.1' R	28.60	31.10
RM-4035	CL 8" REUSEMAIN	36+97, 16.9' R	27.60	30.90
RM-4036	CL 8" REUSEMAIN	37+65, 16.9' R	27.10	30.70
RM-4037	CL 8" 45° BEND	38+36, 16.3' R	27.00	30.50
RM-4038	CL 8" 45° BEND	38+40, 19.9' R	27.10	30.50
RM-4039	CL 8" 45° BEND	38+61, 19.7' R	27.20	30.50
RM-4040	CL 8" 45° BEND	38+66, 15.2' R	27.00	30.50
RM-4041	CL 8" REUSEMAIN	39+36, 16.7' R	26.80	30.70
RM-4042	CL 8" 11¼° BEND	40+01, 17.4' R	27.00	30.90
RM-4043	CL 8" 11¼° BEND	40+46, 17.7' R	27.10	31.00
RM-4044	CL 8" REUSEMAIN	41+17, 17.7' R	27.20	31.20
RM-4045	CL 8" REUSEMAIN	41+83, 17.0' R	27.50	31.30
RM-4046	CL 8" REUSEMAIN	42+50, 17.9' R	28.20	31.40
RM-4047	CL 8" 22½° BEND	43+51, 16.9' R	27.80	31.50
RM-4048	CL 8" GATE VALVE	43+91, 15.3' R	29.50	31.50
RM-4049	CL 8" REUSEMAIN	44+68, 18.1' R	27.40	31.10
RM-4050	CL 8" REUSEMAIN	45+76, 17.8' R	27.20	30.70
RM-4051	CL 8" 22½° BEND	46+43, 19.2' R	26.70	30.50
RM-4052	CL 8" REUSEMAIN	47+01, 16.8' R	26.90	30.60
RM-4053	CL 8" 22½° BEND	48+26, 19.1' R	27.80	31.00
RM-4054	CL 8" REUSEMAIN	49+25, 17.0' R	27.90	31.40
RM-4055	CL 8" REUSEMAIN	49+91, 16.6' R	28.30	31.50
RM-4056	CL 8" REUSEMAIN	51+16, 17.3' R	28.30	31.30
RM-4057	CL 8"X4" TEE	51+92, 16.4' R	28.00	31.00
RM-4058	CL 8" GATE VALVE	51+89, 16.4' R	29.50	31.00
RM-4059	CL 4" GATE VALVE	51+92, 13.4' R	28.70	31.00
RM-4060	CL 4" 45° BEND	51+89, 20.5' L	25.80	30.90
RM-4061	CL 4" 45° BEND	51+93, 25.5' L	26.00	30.90
RM-4062	CL 4"X2" REDUCER	10+45, 28.0' L	26.20	31.10
RM-4063	CL 2" REUSEMAIN	11+19, 47.5' L	27.80	31.40
RM-4064	CL 2" REUSEMAIN	11+52, 24.5' R	28.00	31.50
RM-4065	CL 2" FLUSHING HYDRANT	52+70, 109.1' L	30.70	31.20
RM-4066	CL 8" 45° BEND	52+14, 14.6' R	27.60	30.90
RM-4067	CL 8" 45° BEND	52+21, 21.4' R	27.80	30.90
RM-4068	CL 8" 45° BEND	52+36, 20.7' R	28.00	30.90
RM-4069	CL 8" 45° BEND	52+42, 15.7' R	27.70	30.90
RM-4070	CL 8" REUSEMAIN	53+22, 15.9' R	28.00	31.20
RM-4071	CL 8" 11¼° BEND	54+28, 17.8' R	28.10	31.40
RM-4072	CL 8" 11¼° BEND	55+66, 16.6' R	29.00	32.50
RM-4073	CL 8"X4" TEE	55+82, 16.3' R	28.70	32.50
RM-4074	CL 8" GATE VALVE	55+77, 16.2' R	30.20	32.50
RM-4075	CL 4" GATE VALVE	55+82, 13.5' R	29.60	32.50
RM-4076	CL 4"X2" REDUCER	55+80, 24.9' L	28.40	32.00
RM-4077	CL 2" REUSEMAIN	55+44, 82.4' L	28.00	32.50
RM-4078	CL 2" FLUSHING HYDRANT	55+01, 54.0' L	31.80	32.30
RM-4079	CL 8" REUSEMAIN	56+76, 16.4' R	28.10	31.30
RM-4080	CL 8" REUSEMAIN	57+75, 15.1' R	27.50	30.90
RM-4081	CL 2" FLUSHING HYDRANT	24+71, 21.3' R	*	*
RM-4082	CL 2" FLUSHING HYDRANT	19+02, 31.8' R	*	*

INSTALL

AS-BUILD

INFORMATION PROVIDED BY:

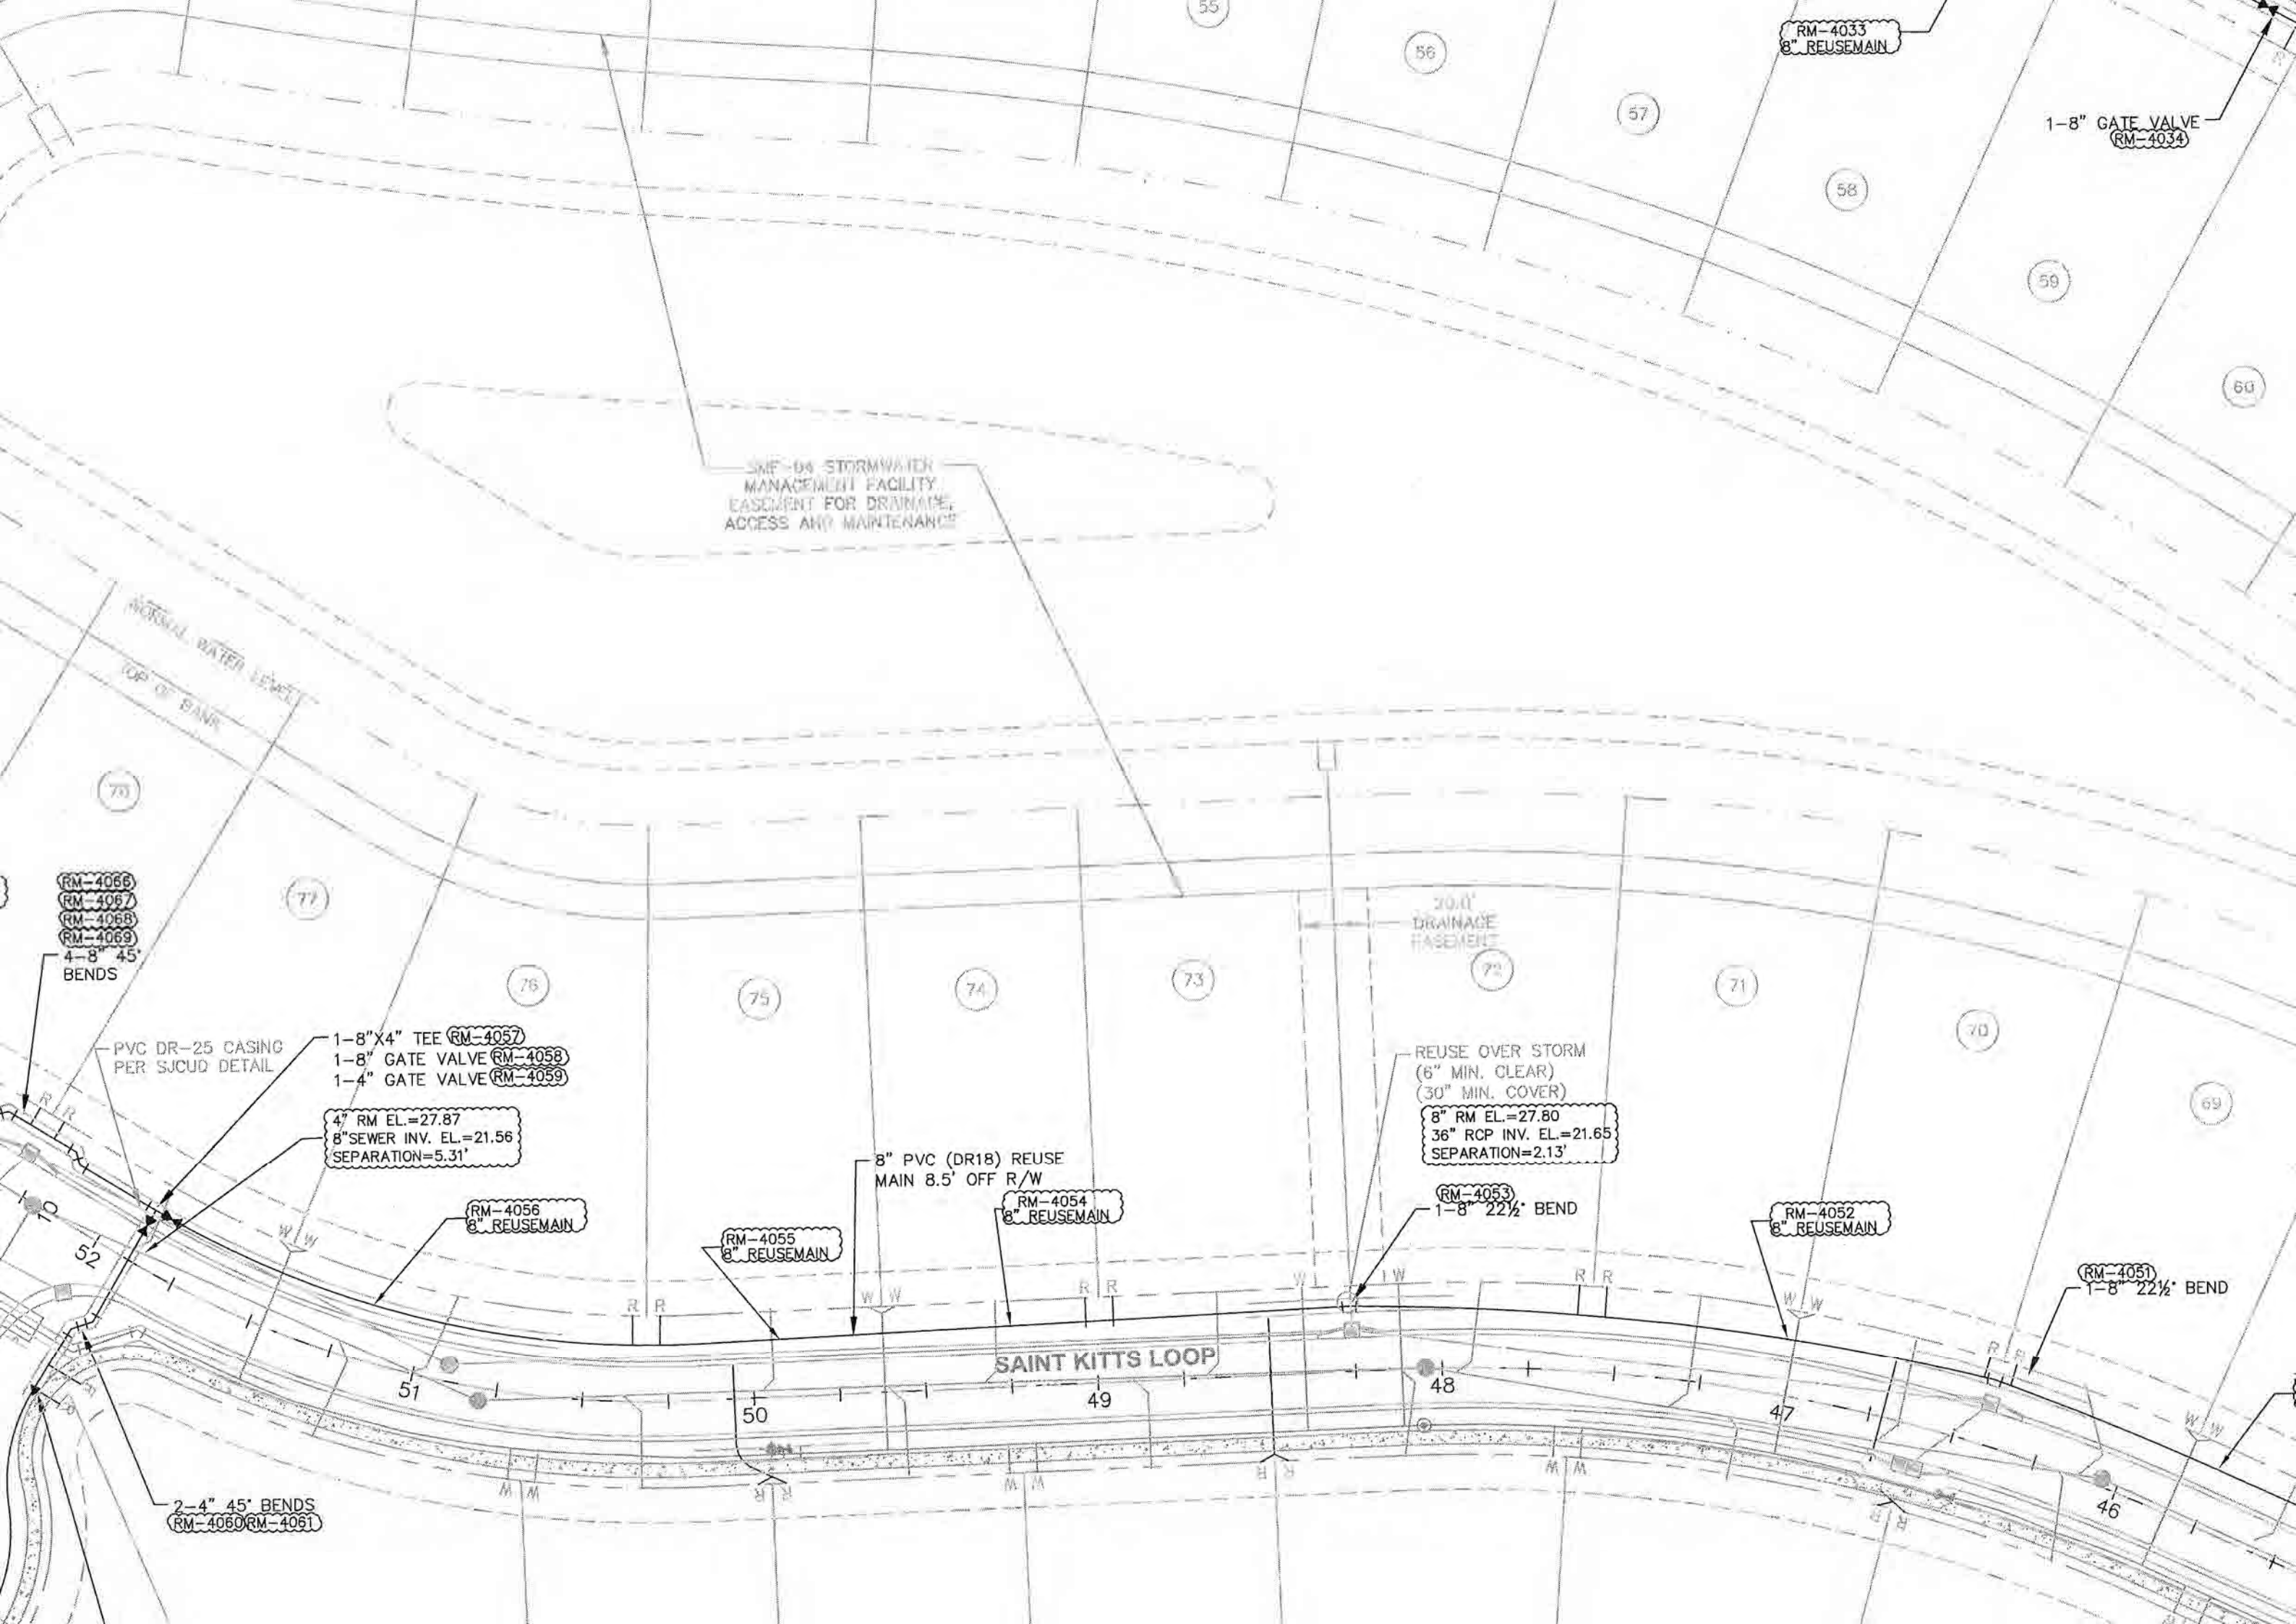

RM-4033
8" REUSEMAIN

1-8" GATE VALVE
RM-4034

SME-04 STORMWATER
MANAGEMENT FACILITY
EASEMENT FOR DRAINAGE,
ACCESS AND MAINTENANCE

NORMAL WATER LEVEL
TOP OF BANK

RM-4066
RM-4067
RM-4068
RM-4069
4-8" 45°
BENDS

PVC DR-25 CASING
PER SJCUD DETAIL

1-8" X 4" TEE RM-4057
1-8" GATE VALVE RM-4058
1-4" GATE VALVE RM-4059

4" RM EL.=27.87
8" SEWER INV. EL.=21.56
SEPARATION=5.31'

RM-4056
8" REUSEMAIN

RM-4055
8" REUSEMAIN

8" PVC (DR18) REUSE
MAIN 8.5' OFF R/W

RM-4054
8" REUSEMAIN

REUSE OVER STORM
(6" MIN. CLEAR)
(30" MIN. COVER)
8" RM EL.=27.80
36" RCP INV. EL.=21.65
SEPARATION=2.13'

RM-4053
1-8" 22½° BEND

RM-4052
8" REUSEMAIN

RM-4051
1-8" 22½° BEND

2-4" 45° BENDS
RM-4060 RM-4061

SAINT KITTS LOOP

4033
REUSEMAIN

1-8" GATE VALVE
RM-4034

RM-4035
8" REUSEMAIN

RM-4036
8" REUSEMAIN

REUSE OVER STORM
(6" MIN. CLEAR)
(30" MIN. COVER)

8" RM EL.=27.20
24" RCP INV. EL.=23.55
SEPARATION=0.71'

4-8" 45° BENDS
RM-4037 RM-4038
RM-4039 RM-4040

20.0'
DRAINAGE
EASEMENT

RM-4041
8" REUSEMAIN

2-8" 11.25° BENDS
RM-4042 RM-4043

RM-4044
8" REUSEMAIN

10.0' FPL
ELEC. ESM'T

8" PVC (DR18) REUSE
MAIN 8.5' OFF R/W

RM-4045
8" REUSEMAIN

RM-4051
1-8" 22½° BEND

RM-4050
8" REUSEMAIN


RM-4049
8" REUSEMAIN

RM-4046
8" REUSEMAIN

KITTS LOOP



WM-3022	CL 8" WATERMAIN	29+14, 16.5' L	27.50	31.20	3.7	
WM-3023	CL 8" WATERMAIN	30+32, 17.0' L	27.20	31.00	3.8	
WM-3024	CL 8"X6" TEE	31+28, 16.8' L	27.70	30.80	3.1	
WM-3025	CL 6" 90° BEND	31+28, 15.0' L	27.60	30.80	3.2	
WM-3026	CL 6" GATE VALVE	30+32, 17.0' L	28.80	30.80	2.0	M&H VA
WM-3027	CL FIRE HYDRANT	31+33, 15.3' L	*	*	*	
WM-3028	CL 8" WATERMAIN	32+49, 18.8' L	27.10	30.40	3.3	
WM-3029	CL 8" GATE VALVE	33+90, 16.2' L	28.60	30.80	2.2	M&H VA
WM-3030	CL 8" WATERMAIN	34+81, 16.7' L	27.80	31.20	3.4	
WM-3031	CL 8" WATERMAIN	36+04, 17.0' L	27.20	31.10	3.9	
WM-3032	CL 8"X6" TEE	37+34, 16.5' L	27.70	30.80	3.1	
WM-3033	CL 6" 90° BEND	37+34, 15.5' L	27.60	30.80	3.2	
WM-3034	CL 6" GATE VALVE	37+36, 15.3' L	28.90	30.80	1.9	M&H VA
WM-3035	CL FIRE HYDRANT	37+39, 15.3' L	*	*	*	
WM-3036	CL 8" WATERMAIN	38+59, 18.1' L	27.10	30.50	3.4	
WM-3037	CL 8" WATERMAIN	39+19, 17.7' L	27.50	30.60	3.1	
WM-3038	CL 8" GATE VALVE	39+95, 15.7' L	28.80	30.90	2.1	M&H VA
WM-3039	CL 8" 11¼° BEND	40+16, 15.6' L	26.80	31.00	4.2	
WM-3040	CL 8" 11¼° BEND	40+35, 16.1' L	26.60	31.00	4.4	
WM-3041	CL 8" WATERMAIN	40+52, 15.6' L	26.70	31.10	4.4	
WM-3042	CL 8" WATERMAIN	41+48, 14.7' L	28.20	31.40	3.2	
WM-3043	CL 8" WATERMAIN	42+45, 16.3' L	28.60	31.70	3.1	
WM-3044	CL 8"X6" TEE	43+76, 16.4' L	28.40	31.40	3.0	
WM-3045	CL 6" 90° BEND	43+76, 15.2' L	28.30	31.40	3.1	
WM-3046	CL 6" GATE VALVE	43+72, 14.8' L	29.40	31.40	2.0	M&H VA
WM-3047	CL FIRE HYDRANT	43+67, 14.3' L	*	*	*	
WM-3048	CL 8" WATERMAIN	44+67, 17.1' L	27.60	31.00	3.4	
WM-3049	CL 8" WATERMAIN	45+66, 16.6' L	27.10	30.70	3.6	
WM-3050	CL 8" GATE VALVE	46+47, 17.3' L	28.60	30.50	1.9	M&H VA
WM-3051	CL 8" WATERMAIN	47+70, 16.3' L	27.50	30.80	3.3	
WM-3052	CL 8" WATERMAIN	48+71, 16.6' L	27.70	31.10	3.4	
WM-3053	CL 8"X6" TEE	49+91, 16.8' L	28.10	31.60	3.5	
WM-3054	CL 6" 90° BEND	49+91, 15.4' L	28.30	31.60	3.3	
WM-3055	CL 6" GATE VALVE	49+92, 15.3' L	29.40	31.60	2.2	M&H VA
WM-3056	CL FIRE HYDRANT	49+96, 15.0' L	*	*	*	
WM-3057	CL 8" WATERMAIN	50+99, 16.7' L	27.50	31.40	3.9	
WM-3058	CL 8" 45° BEND	51+77, 16.2' L	27.60	30.90	3.3	
WM-3059	CL 8" 45° BEND	51+90, 31.1' L	27.70	30.90	3.2	
WM-3060	CL 8" GATE VALVE	52+48, 31.0' L	28.70	31.10	2.4	M&H VA
WM-3061	CL 8"X4" TEE	52+52, 31.4' L	27.70	31.10	3.4	
WM-3062	CL 4" GATE VALVE	52+52, 33.9' L	28.50	31.10	2.6	M&H VA
WM-3063	CL 4" 45° BEND	52+52, 69.1' L	27.50	31.20	3.7	
WM-3064	CL 4" 22½° BEND	52+69, 85.1' L	27.40	31.20	3.8	
WM-3065	CL 4" CAP TAPPED 2"	52+72, 98.1' L	27.60	31.20	3.6	
WM-3066	CL 2" WATERMAIN	52+46, 155.4' L	28.00	31.50	3.5	
WM-3067	CL 2" FLUSHING HYDRANT	51+82, 141.4' L	30.90	31.40	0.5	
WM-3068	CL 8" 45° BEND	52+55, 30.7' L	28.00	31.10	3.1	
WM-3069	CL 8" 45° BEND	52+67, 18.5' L	27.50	31.10	3.6	
WM-3070	CL 8" WATERMAIN	53+52, 15.9' L	27.90	31.30	3.4	
WM-3071	CL 8" WATERMAIN	54+52, 16.6' L	28.50	31.90	3.4	
WM-3072	CL 8" 45° BEND	54+74, 17.3' L	28.60	32.00	3.4	
WM-3073	CL 8" 45° BEND	54+90, 31.4' L	28.70	32.30	3.6	
WM-3074	CL 8" 22½° BEND	54+94, 49.8' L	29.10	32.30	3.2	
WM-3075	CL 8" 22½° BEND	55+02, 66.7' L	29.50	32.30	2.8	
WM-3076	CL 8" 22½° BEND	55+13, 78.3' L	29.10	32.40	3.3	
WM-3077	CL 8" 22½° BEND	55+26, 87.0' L	29.20	32.50	3.3	
WM-3078	CL 8" 22½° BEND	55+44, 88.8' L	29.30	32.50	3.2	
WM-3079	CL 8" 22½° BEND	55+57, 83.0' L	29.30	32.40	3.1	
WM-3080	CL 8" 22½° BEND	55+68, 70.7' L	29.20	32.30	3.1	
WM-3081	CL 8" 22½° BEND	55+78, 55.5' L	28.50	32.30	3.8	

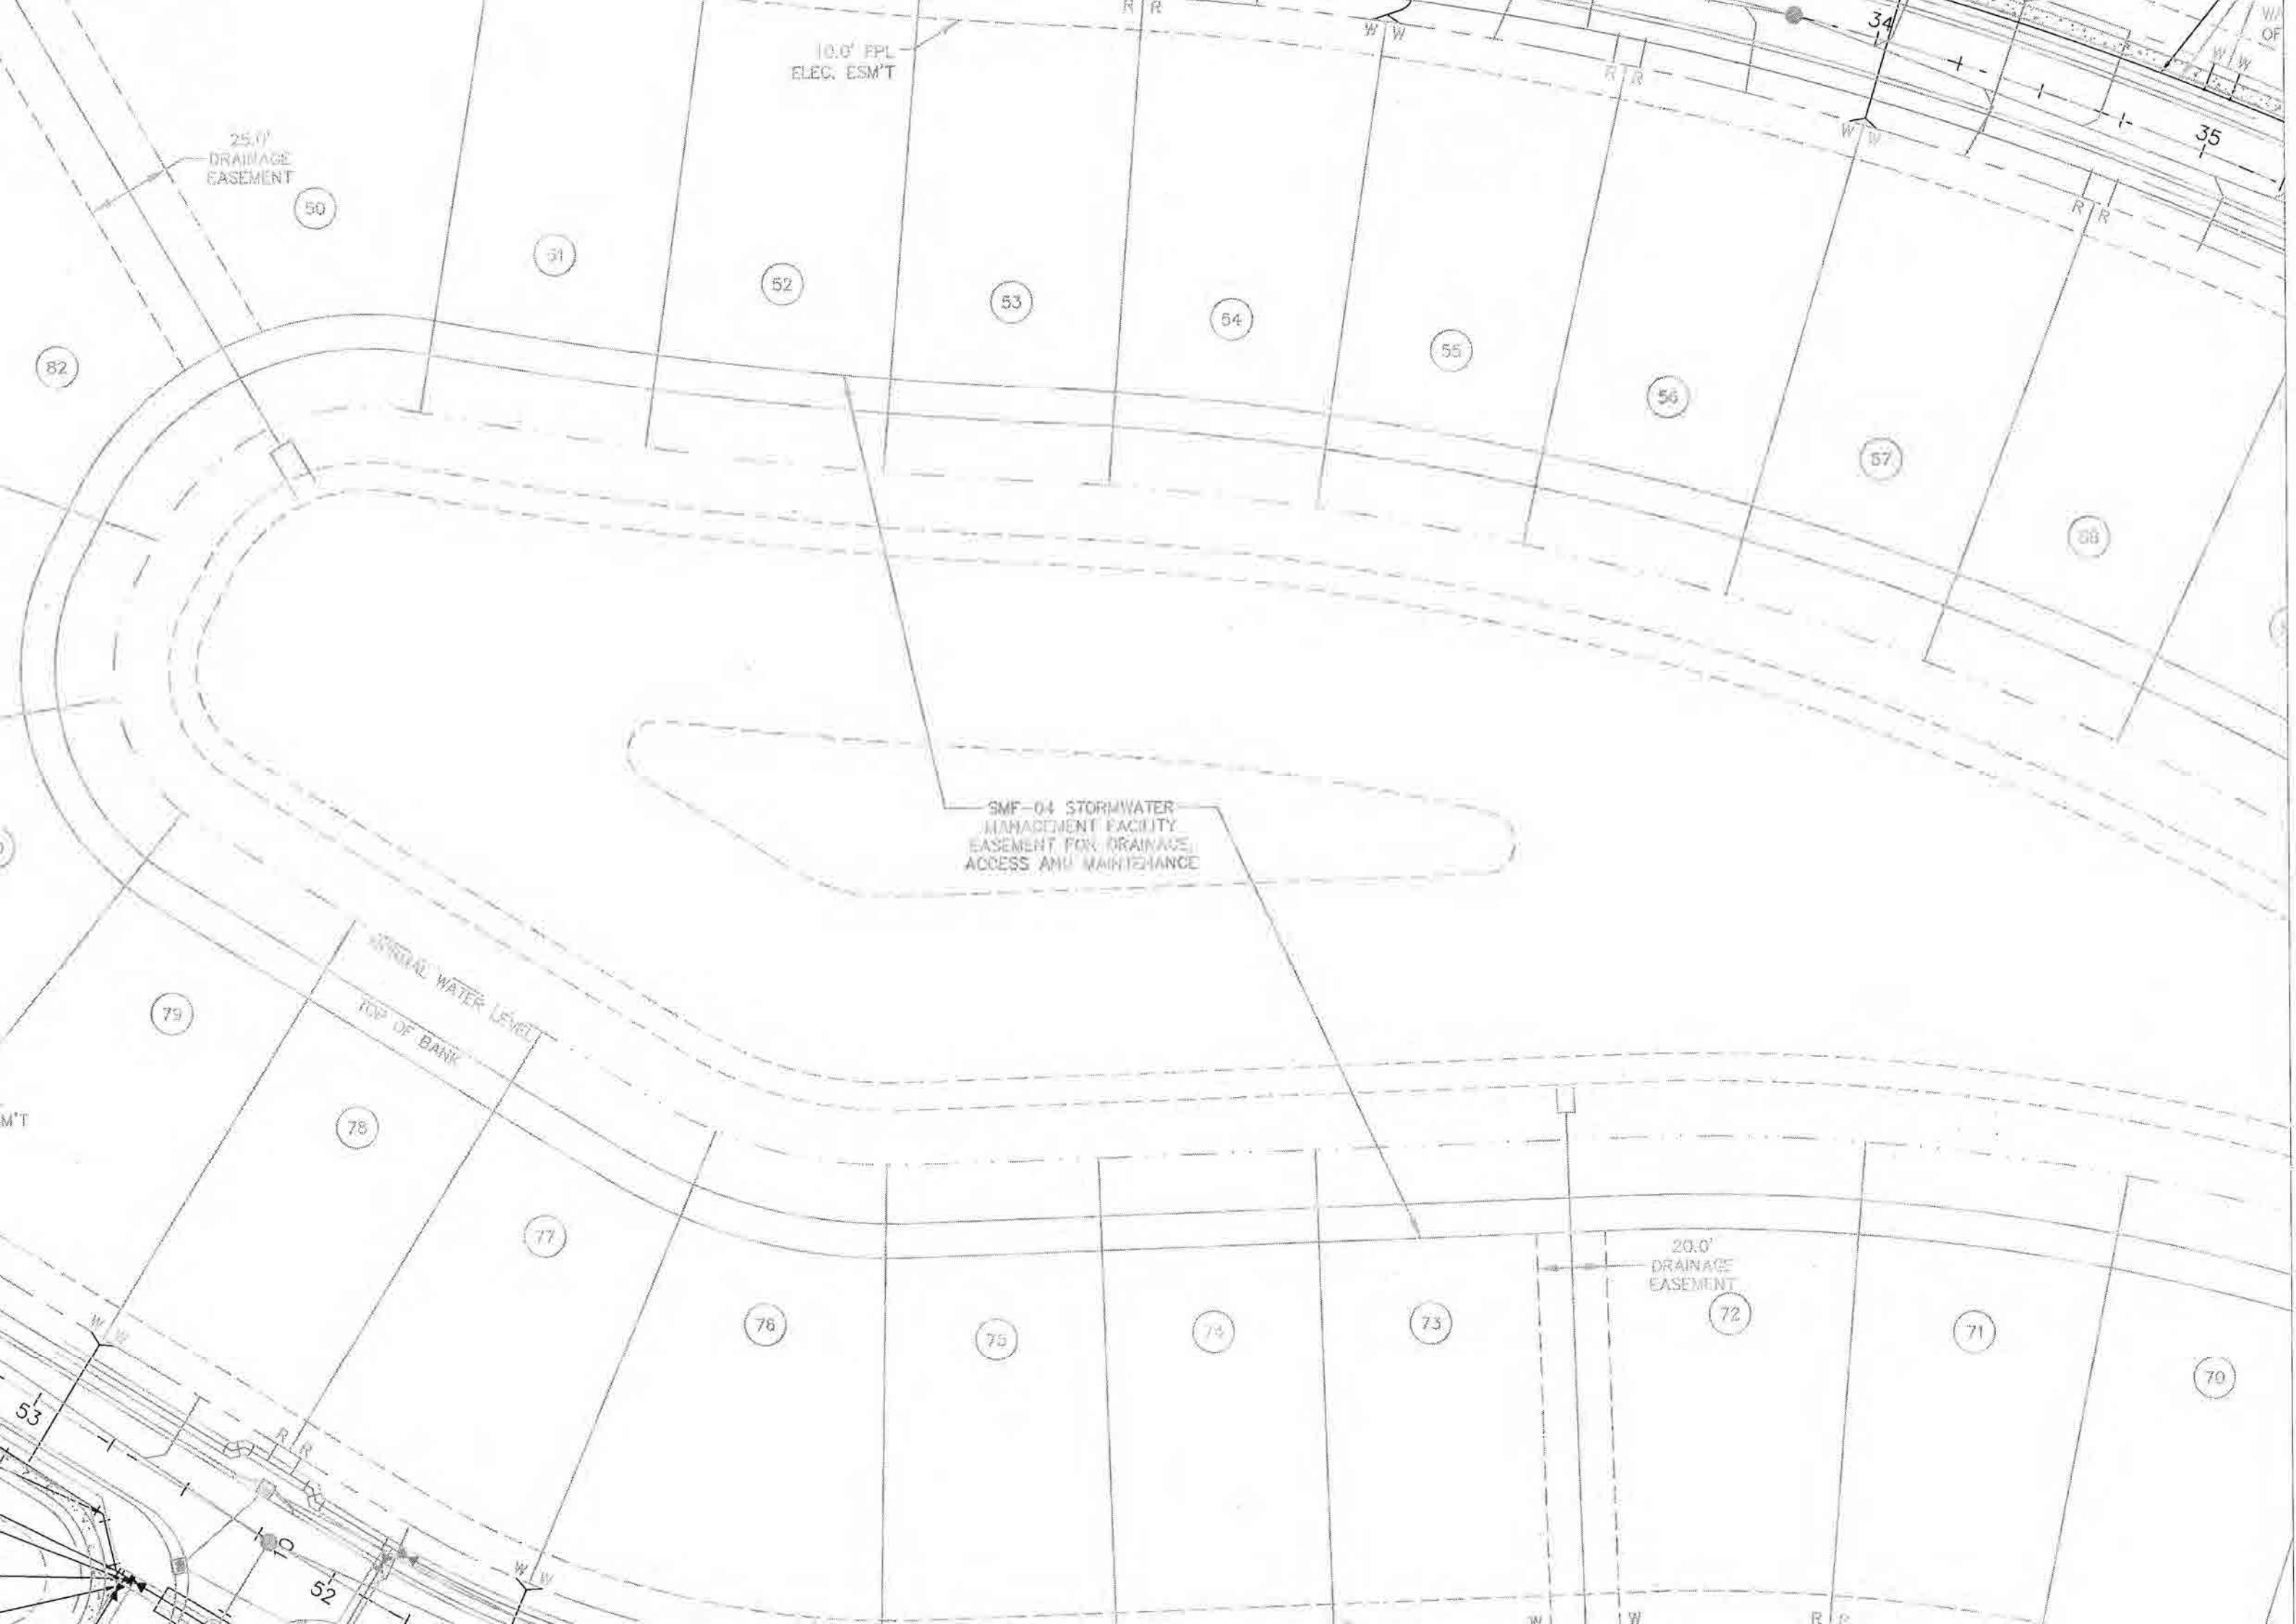


10.0' FPL
ELEC. ESM'T

25.0'
DRAINAGE
EASEMENT


SMF-04 STORMWATER
MANAGEMENT FACILITY
EASEMENT FOR DRAINAGE
ACCESS AND MAINTENANCE

20.0'
DRAINAGE
EASEMENT

MINIMAL WATER LEVEL
TOP OF BANK

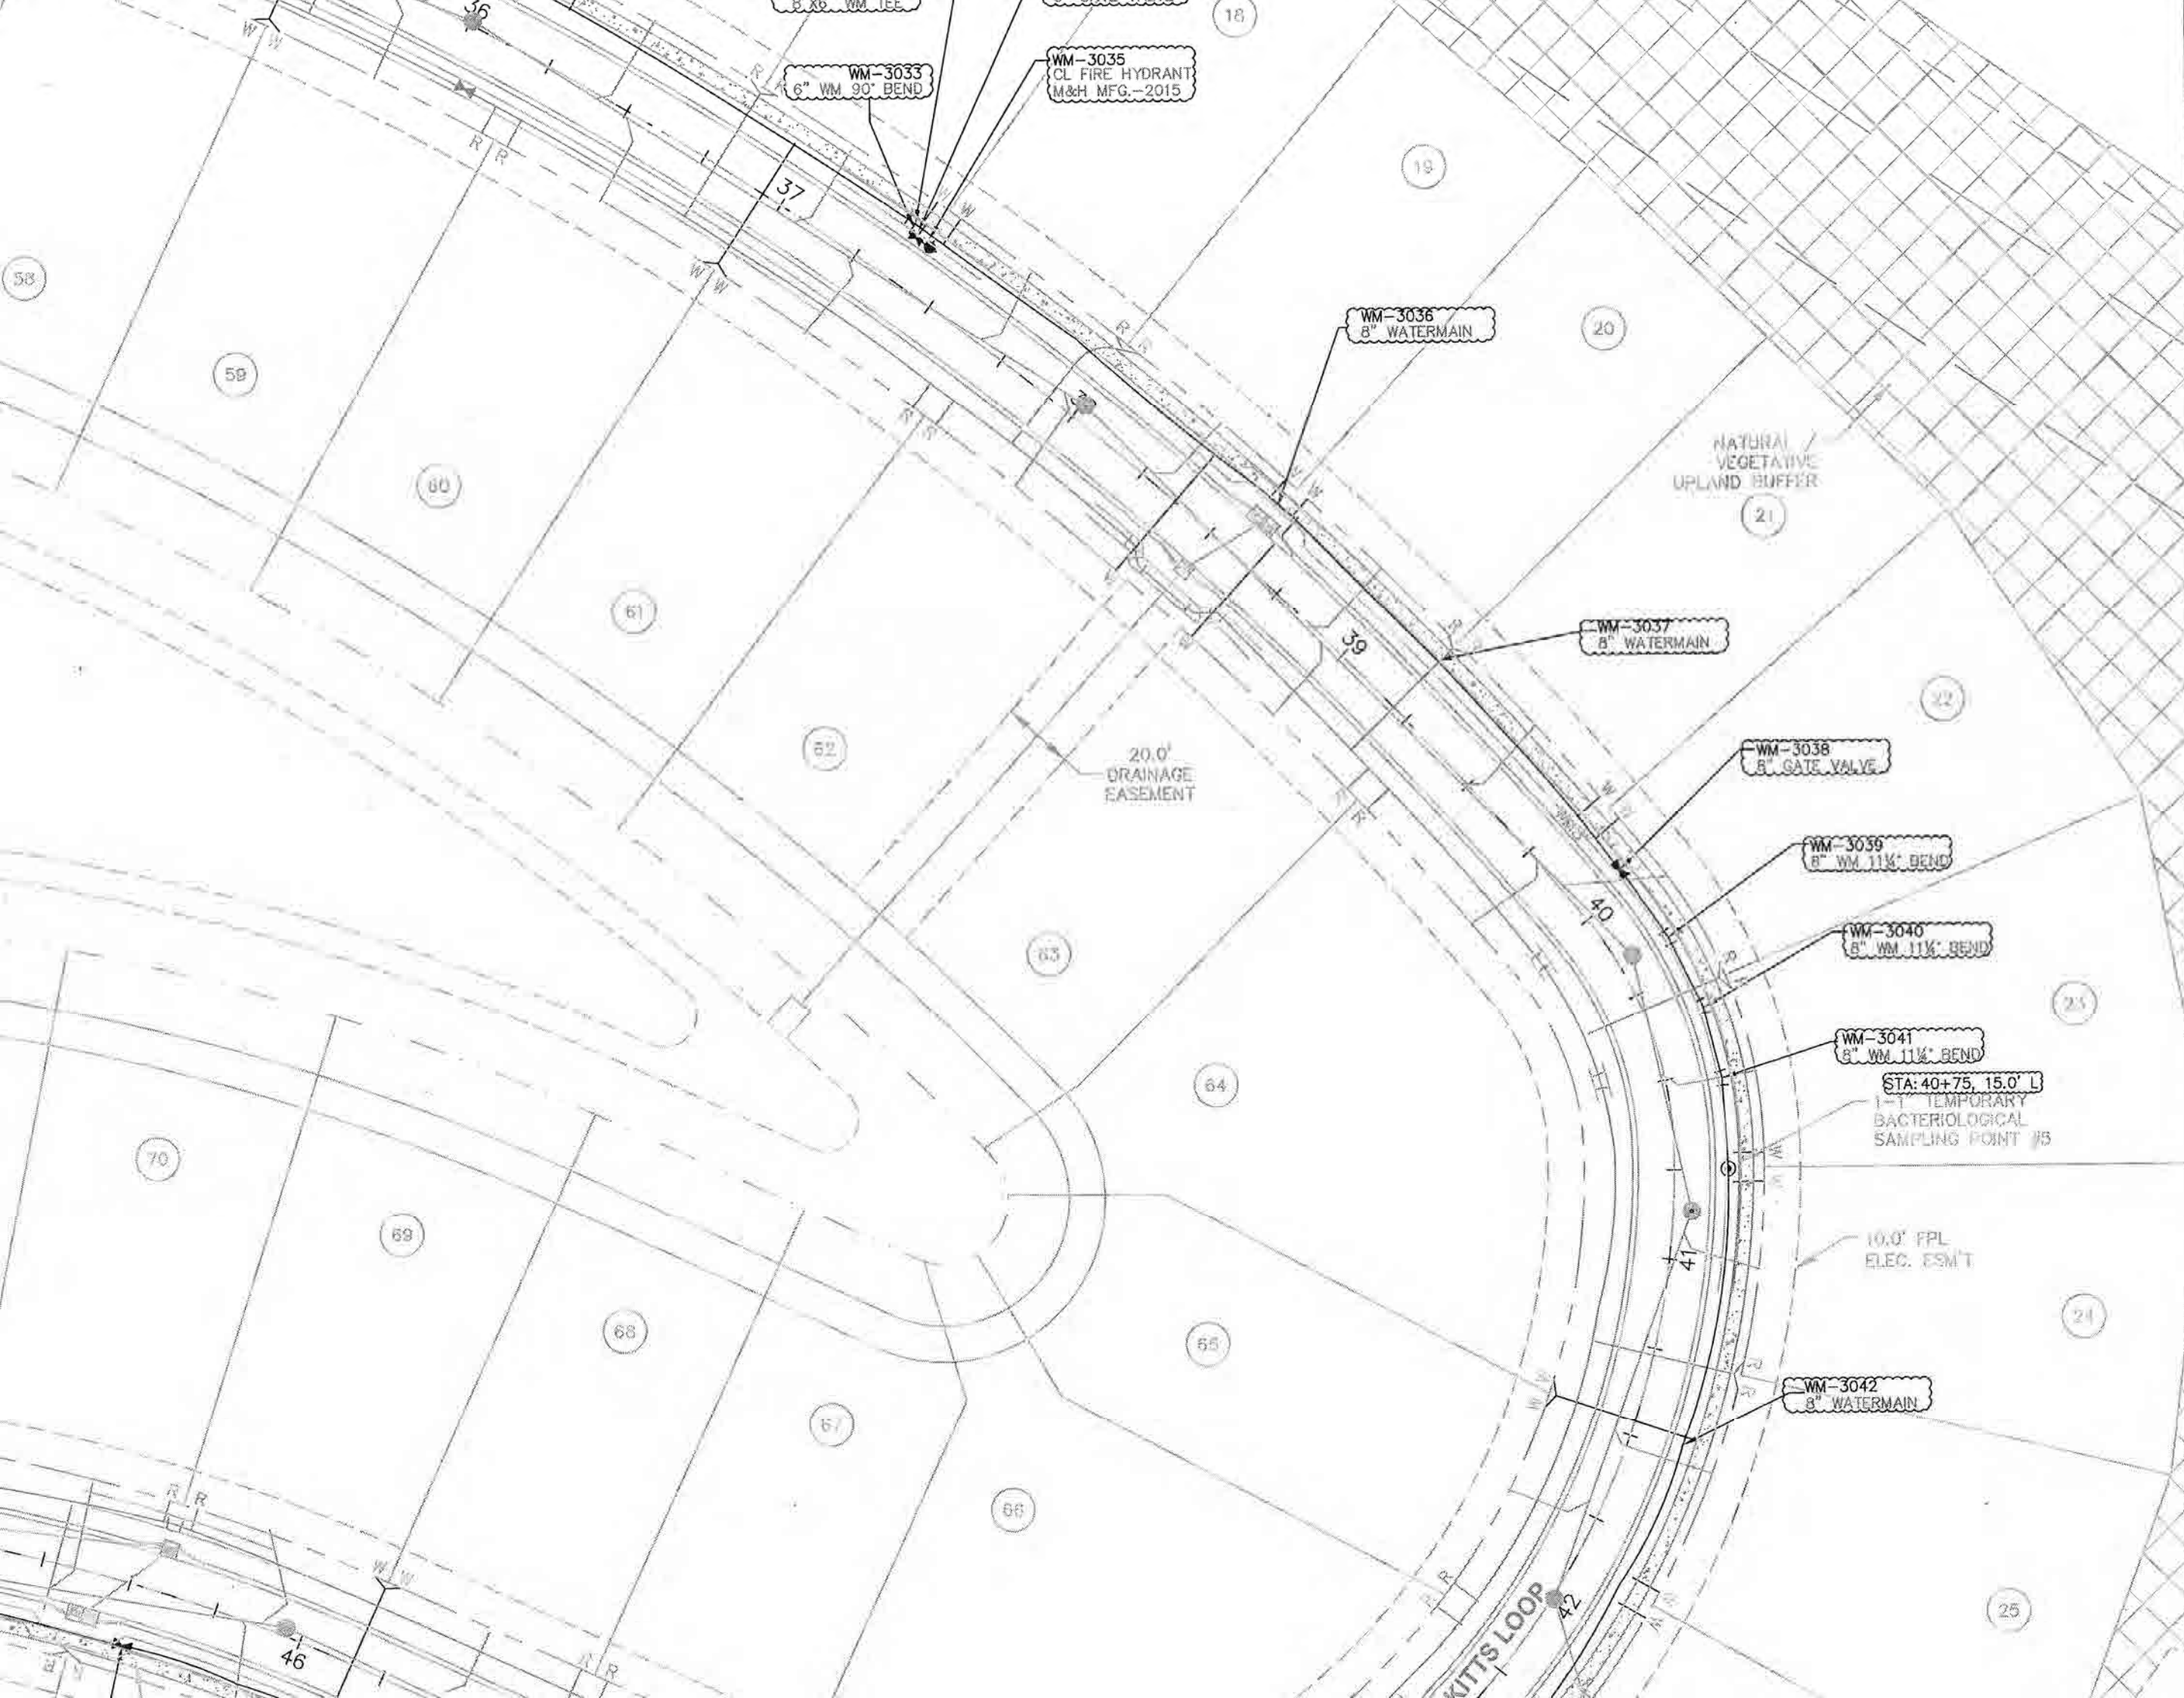



OFFSITE UTILITY AS-BUILT T. JOHNS COUNTY, FLORIDA

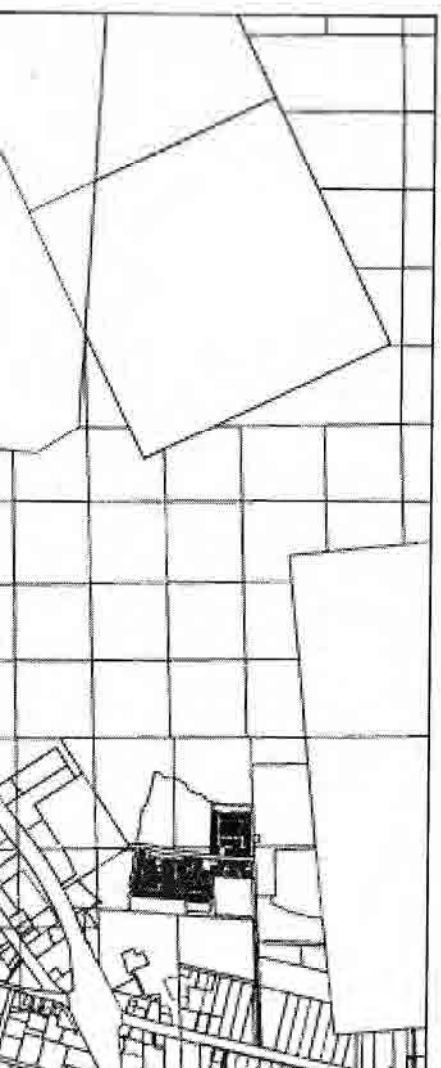



INDEX OF DR

1	Co
2-3	Fo
4-5	Re
6	W

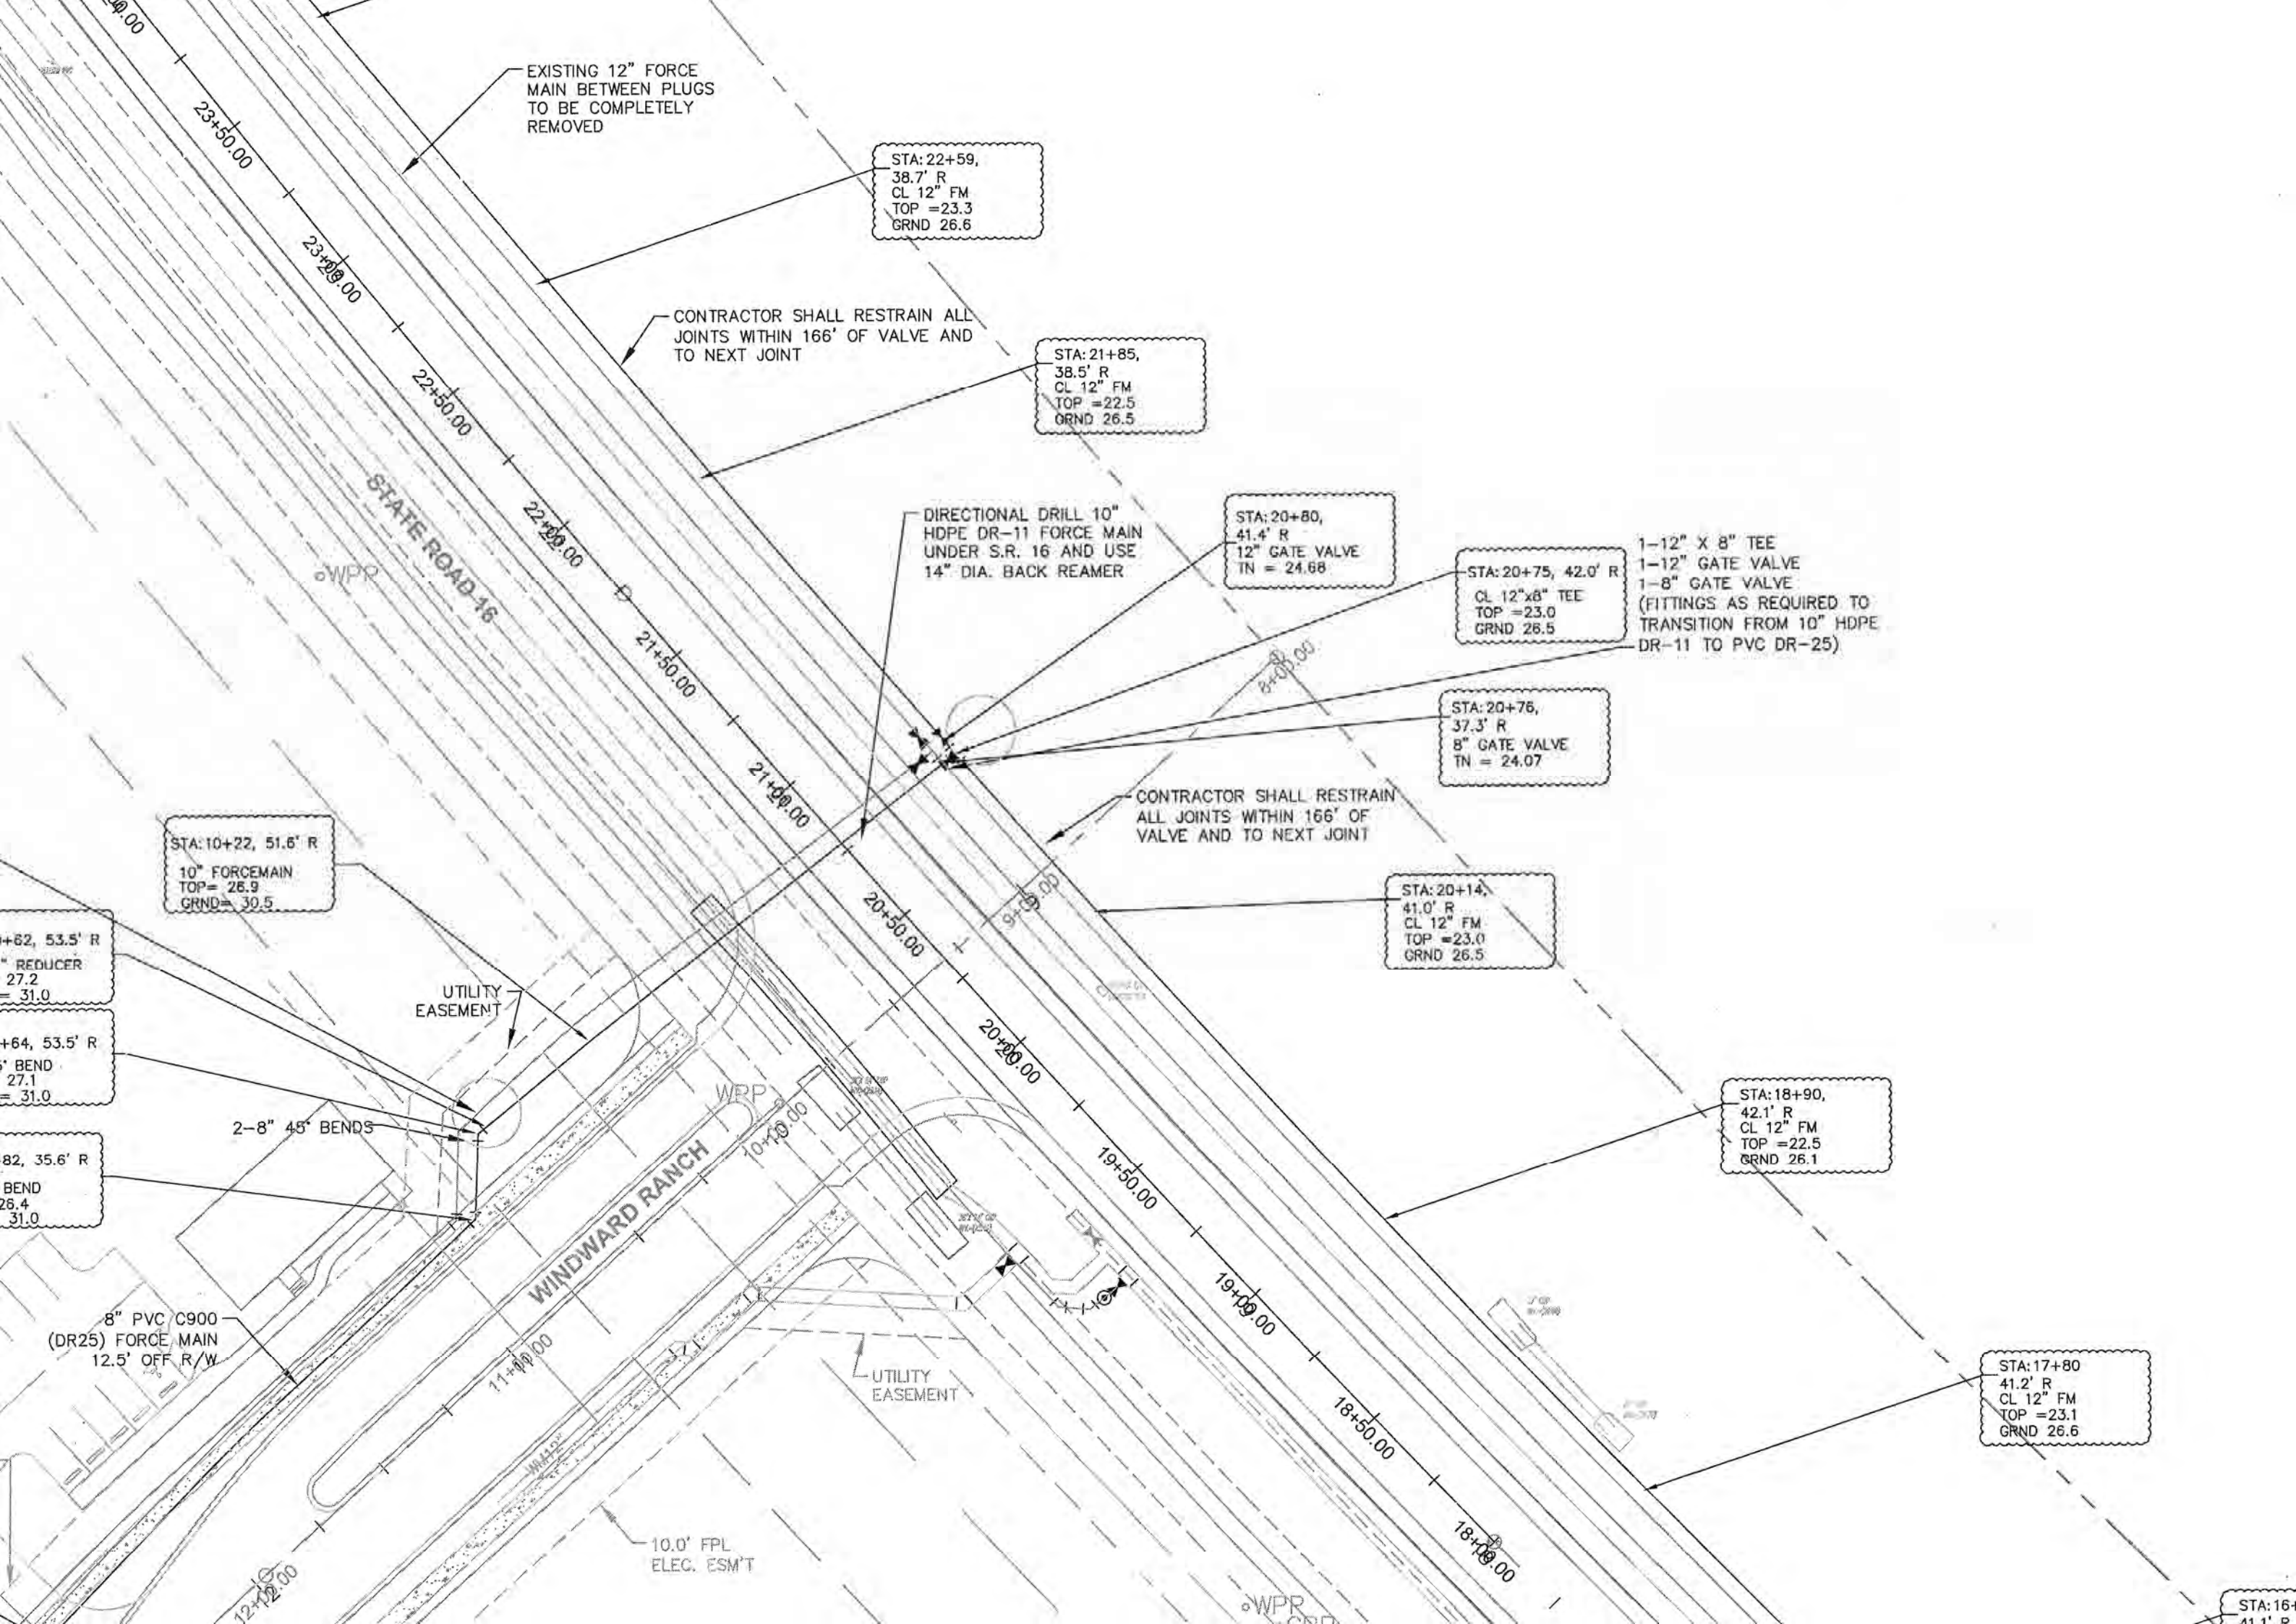

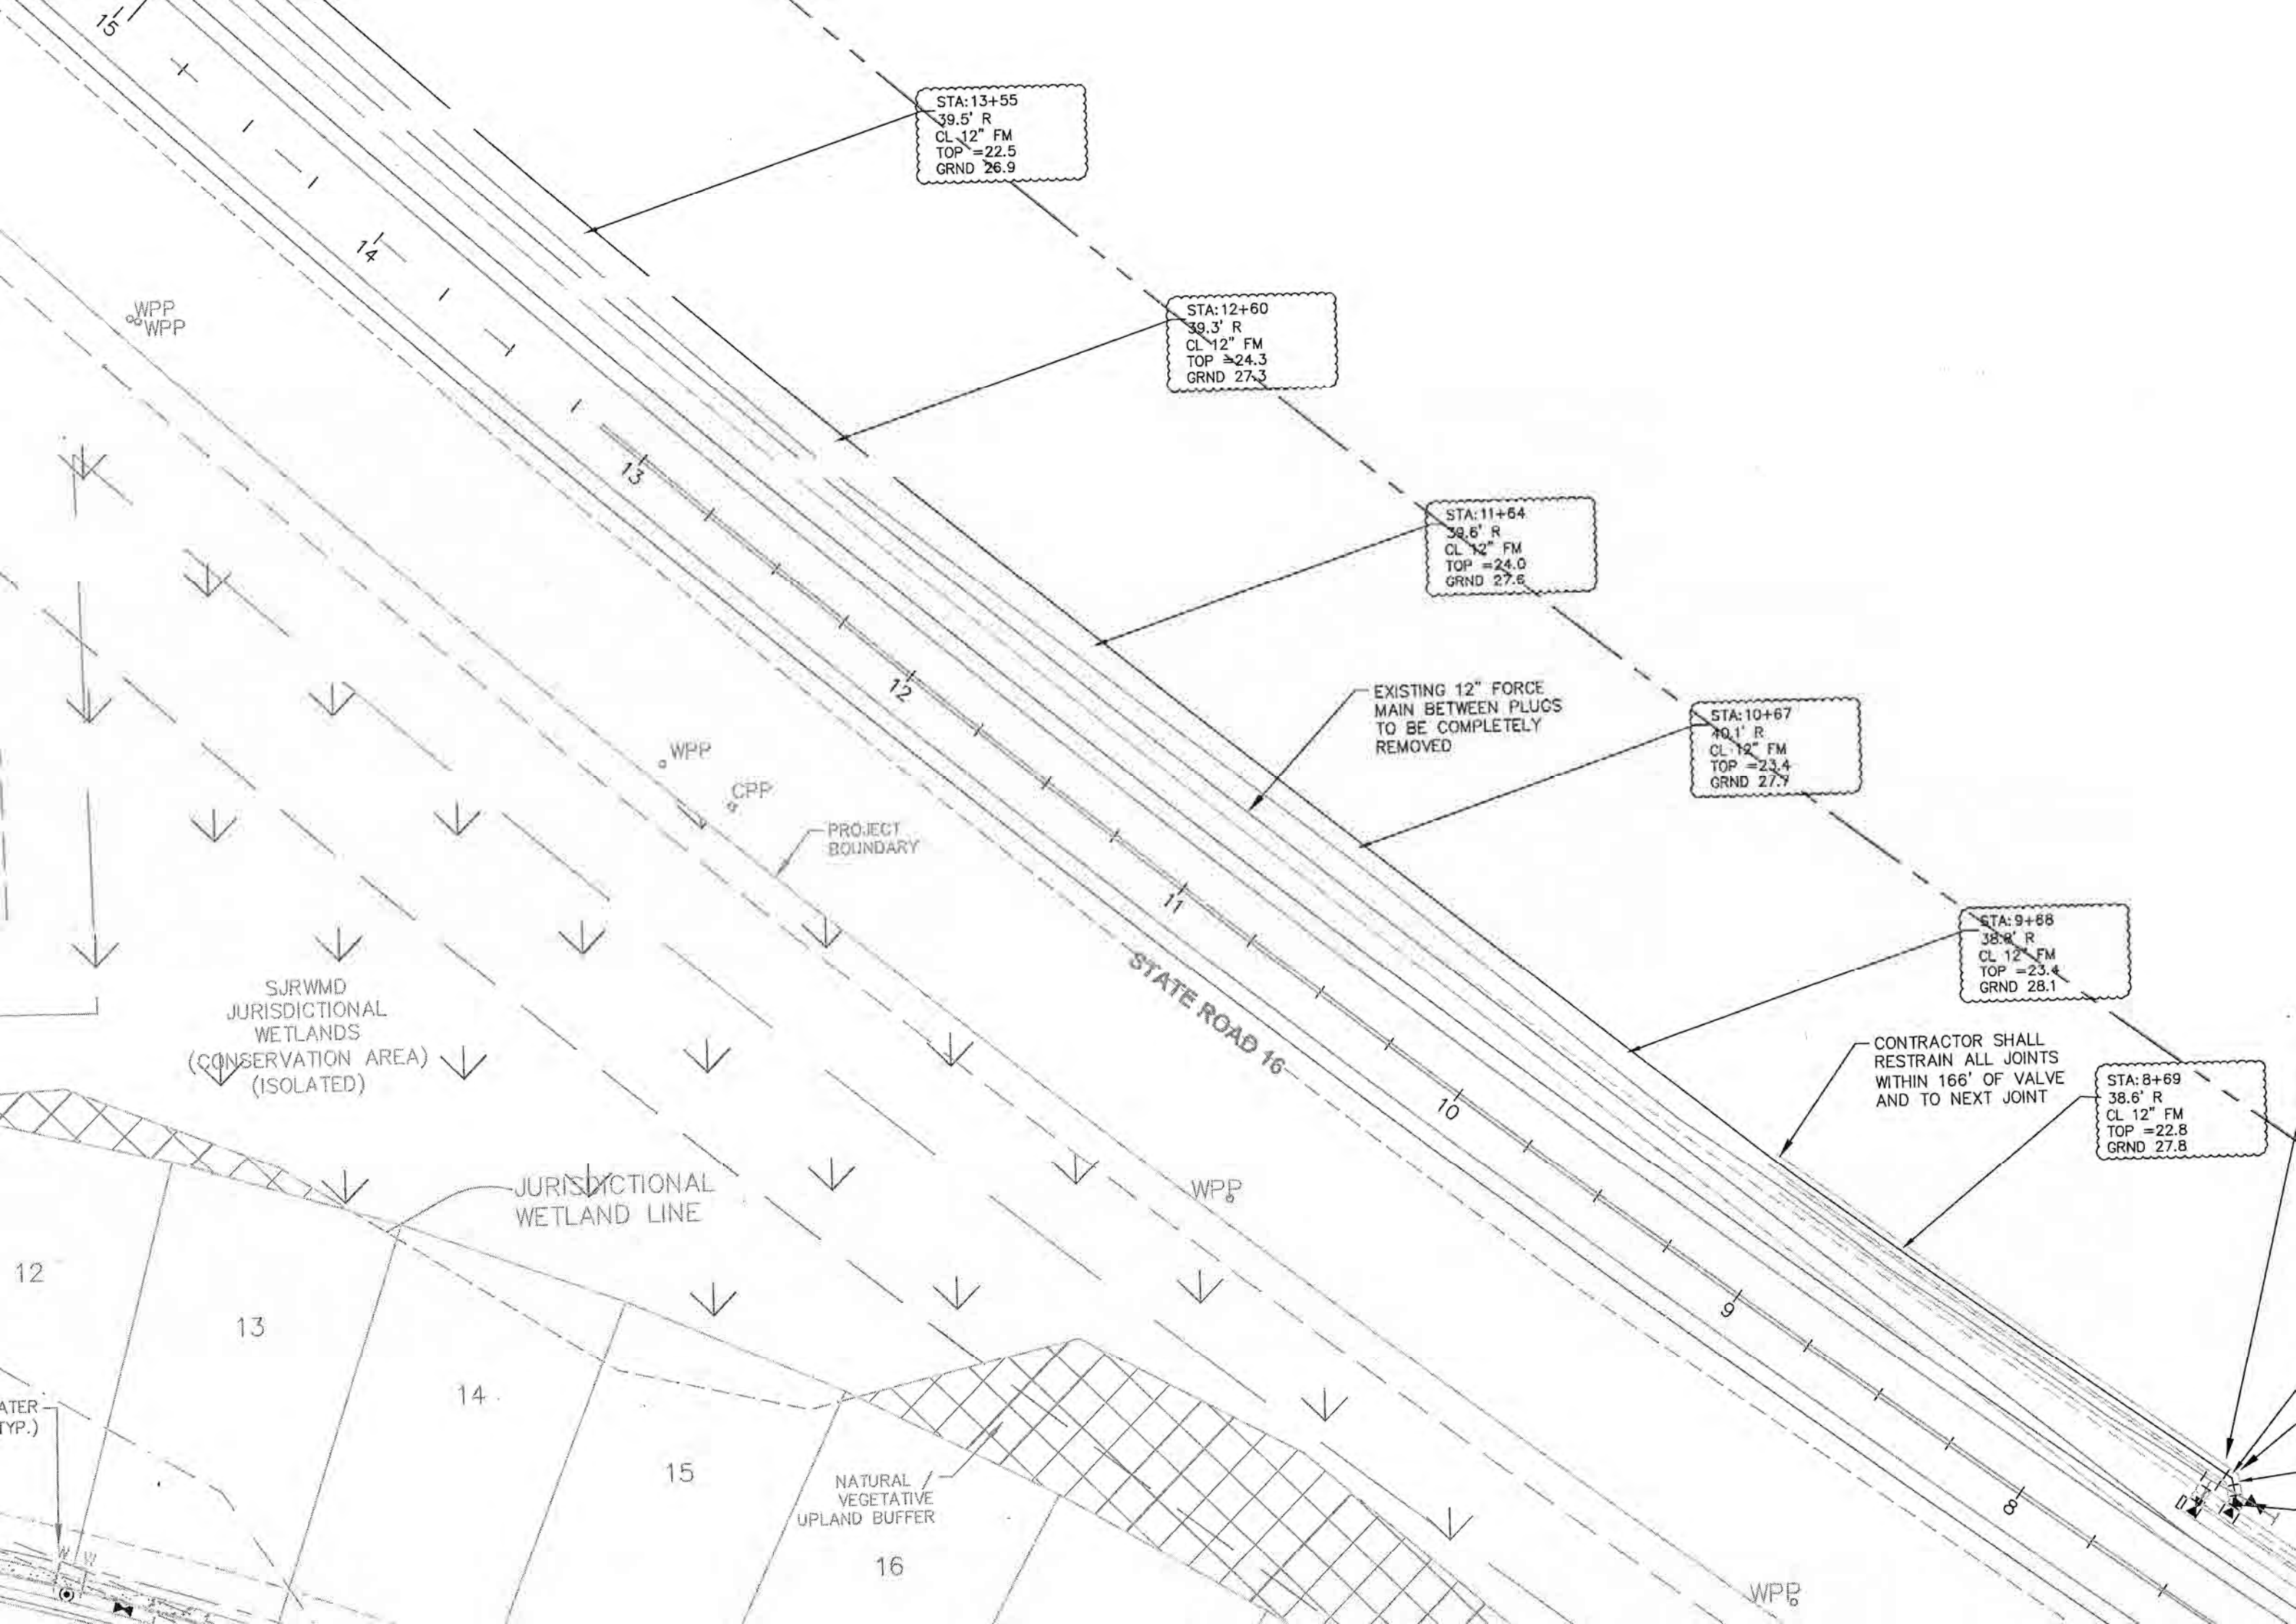

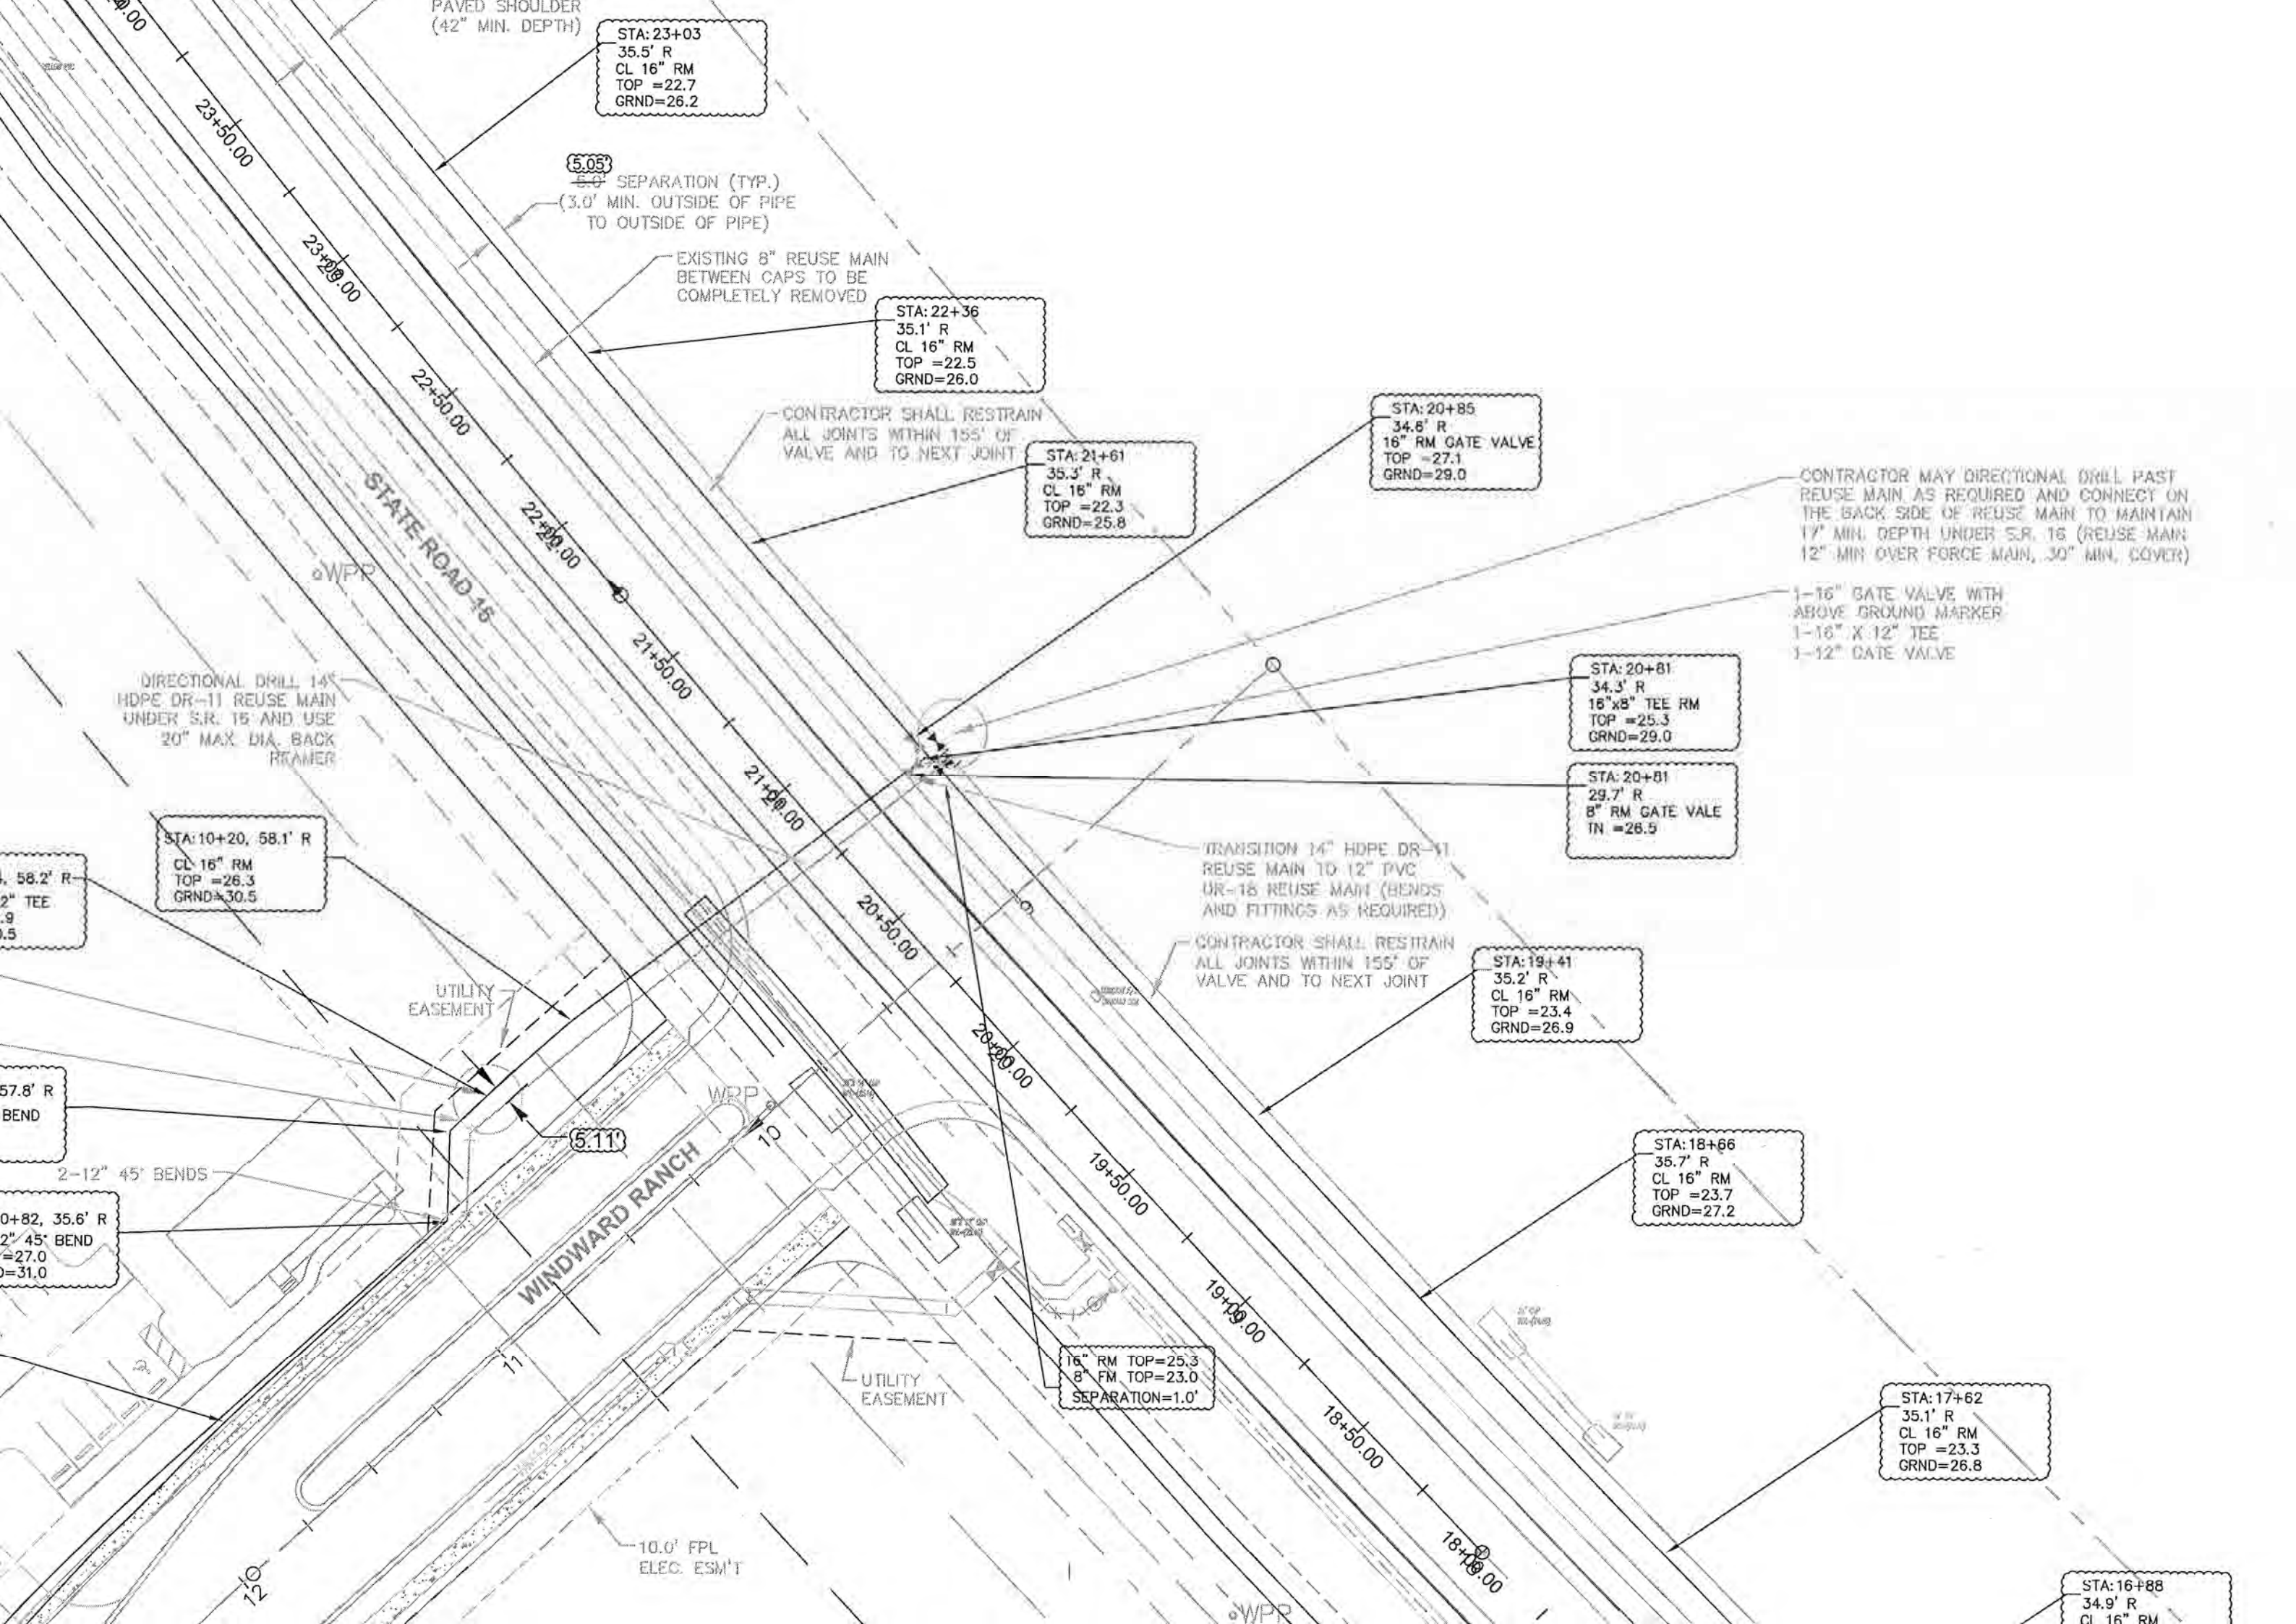

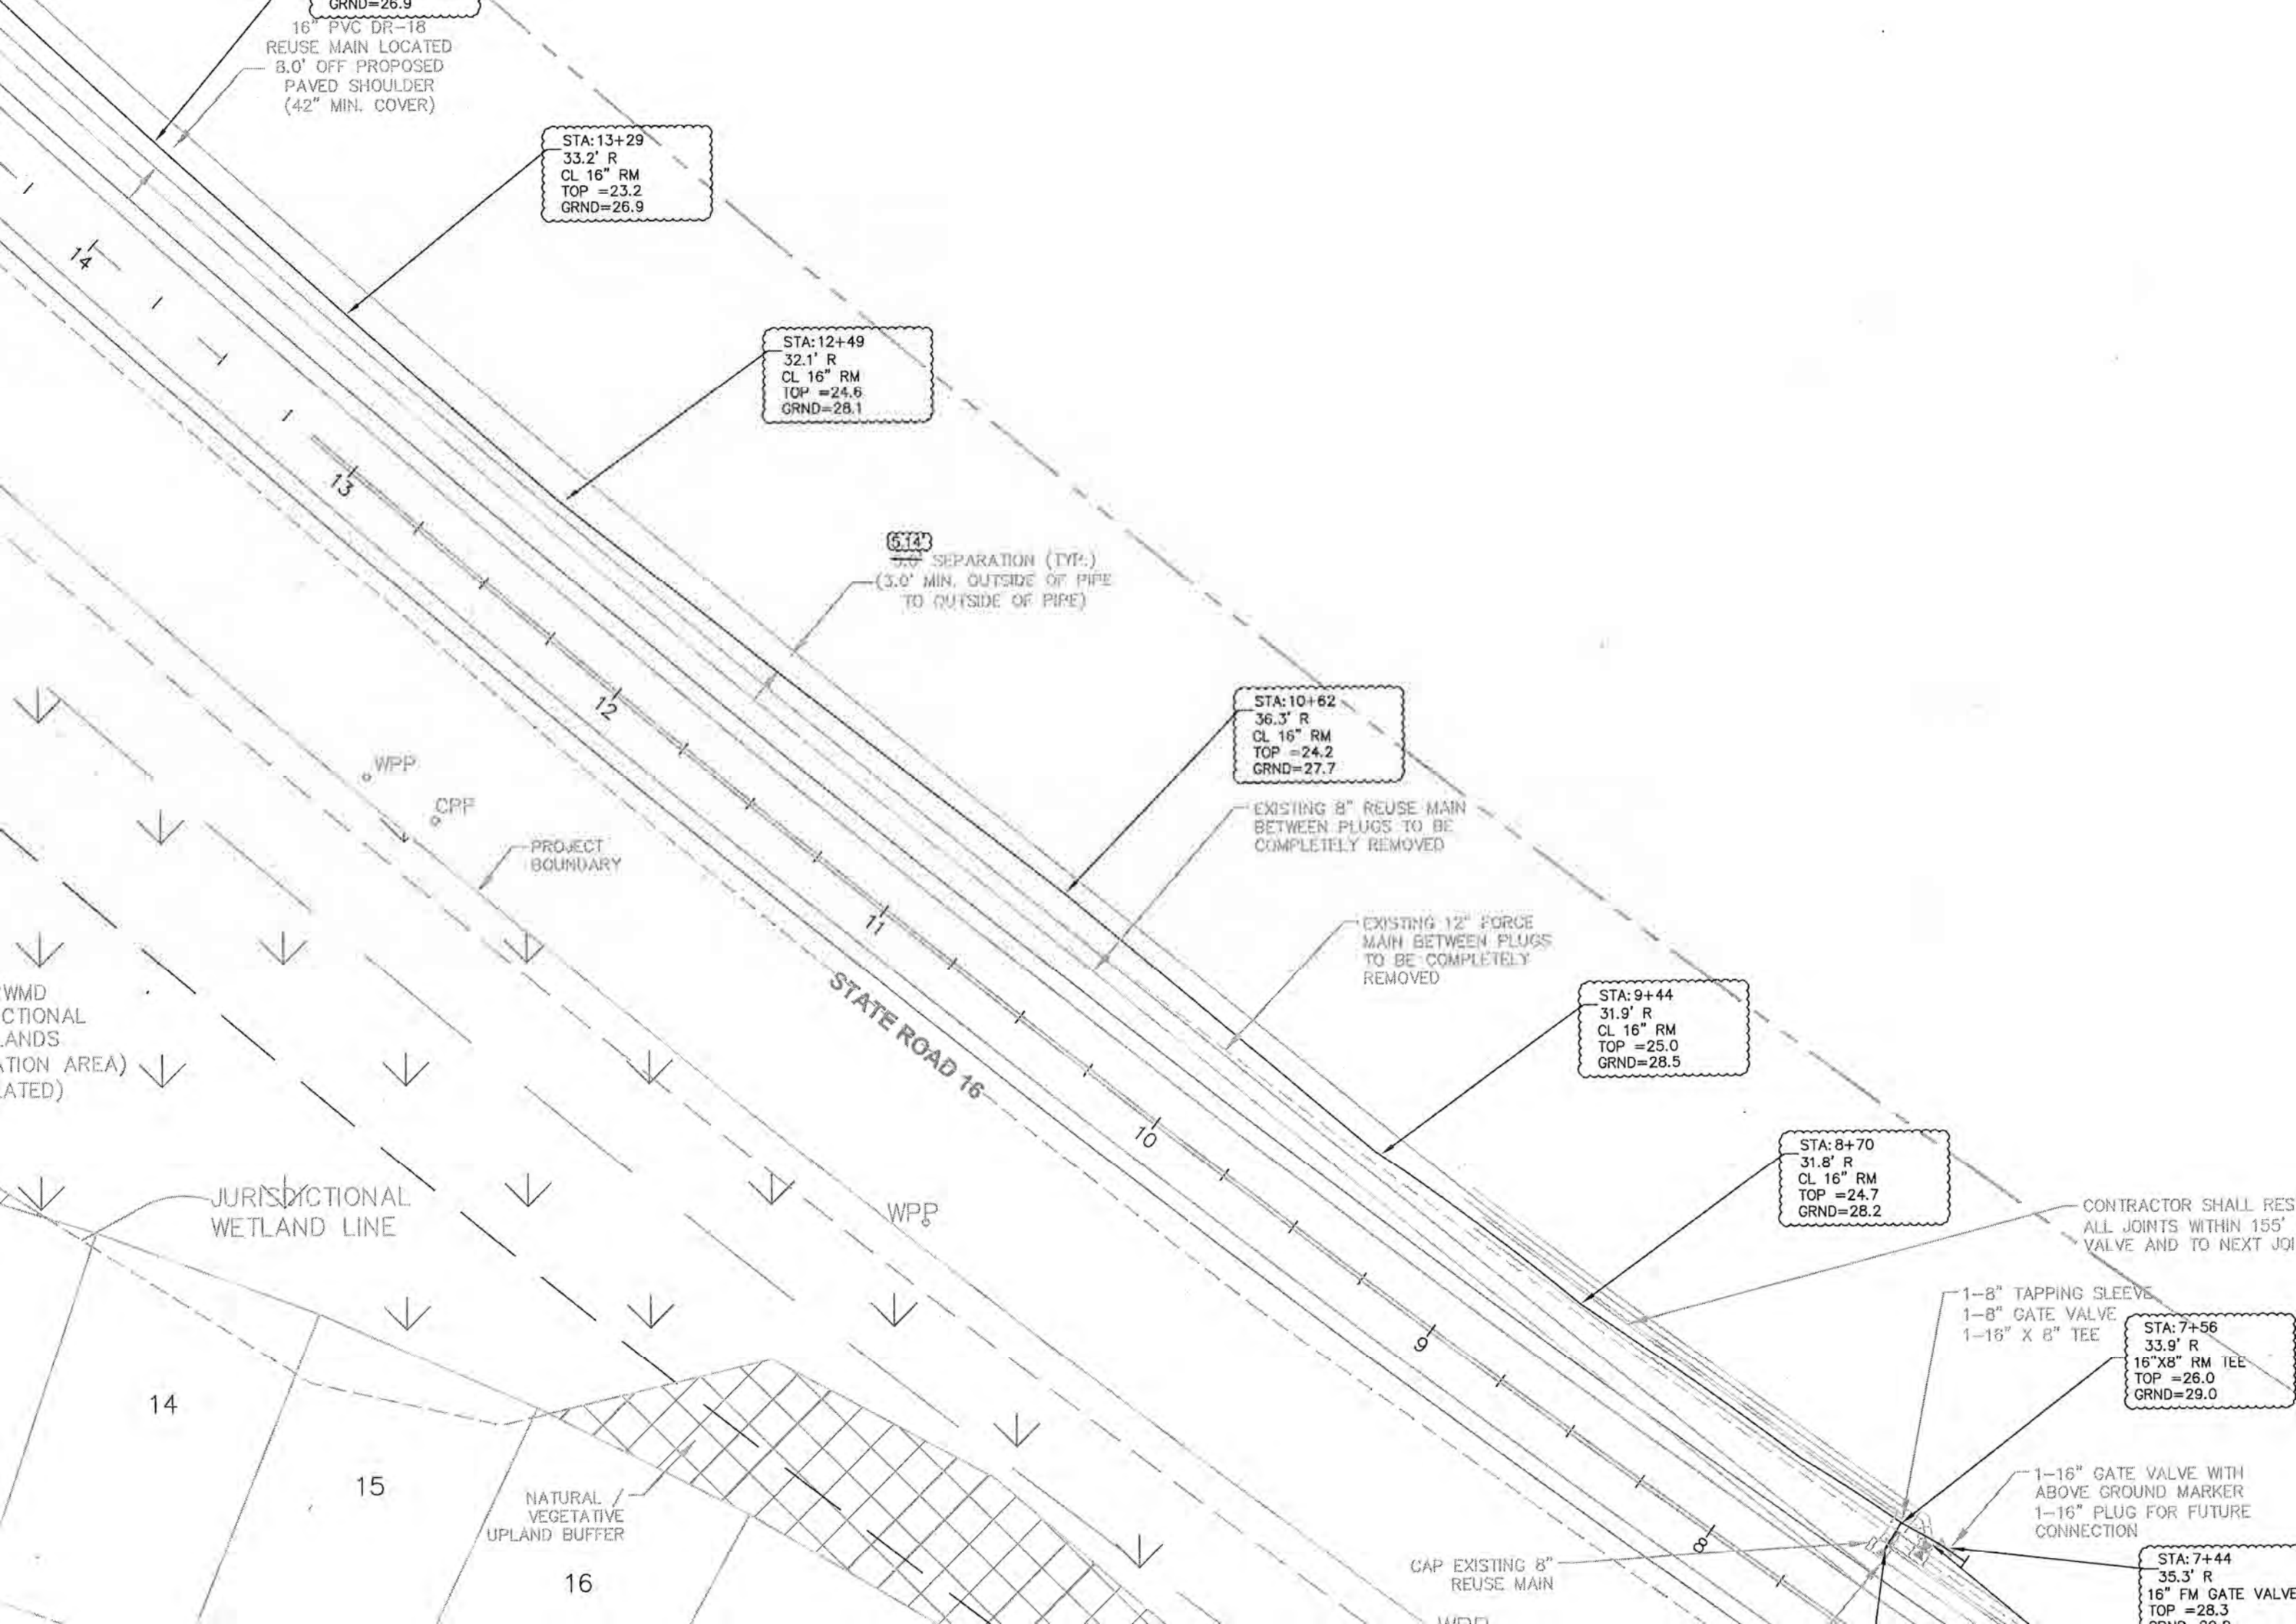

16" PVC DR-18
REUSE MAIN LOCATED
8.0' OFF PROPOSED
PAVED SHOULDER
(42" MIN. COVER)

STA:13+29
33.2' R
CL 16" RM
TOP =23.2
GRND=26.9

STA:12+49
32.1' R
CL 16" RM
TOP =24.6
GRND=28.1

514
SEPARATION (TYP.)
(3.0' MIN. OUTSIDE OF PIPE
TO OUTSIDE OF PIPE)

STA:10+62
36.3' R
CL 16" RM
TOP =24.2
GRND=27.7

EXISTING 8" REUSE MAIN
BETWEEN PLUGS TO BE
COMPLETELY REMOVED

EXISTING 12" FORCE
MAIN BETWEEN PLUGS
TO BE COMPLETELY
REMOVED

STA:9+44
31.9' R
CL 16" RM
TOP =25.0
GRND=28.5

STA:8+70
31.8' R
CL 16" RM
TOP =24.7
GRND=28.2

CONTRACTOR SHALL RES
ALL JOINTS WITHIN 155'
VALVE AND TO NEXT JOI


1-8" TAPPING SLEEVE
1-8" GATE VALVE
1-16" X 8" TEE

STA:7+56
33.9' R
16"X8" RM TEE
TOP =26.0
GRND=29.0

1-16" GATE VALVE WITH
ABOVE GROUND MARKER
1-16" PLUG FOR FUTURE
CONNECTION

STA:7+44
35.3' R
16" FM GATE VALVE
TOP =28.3
GRND=28.2

CAP EXISTING 8"
REUSE MAIN

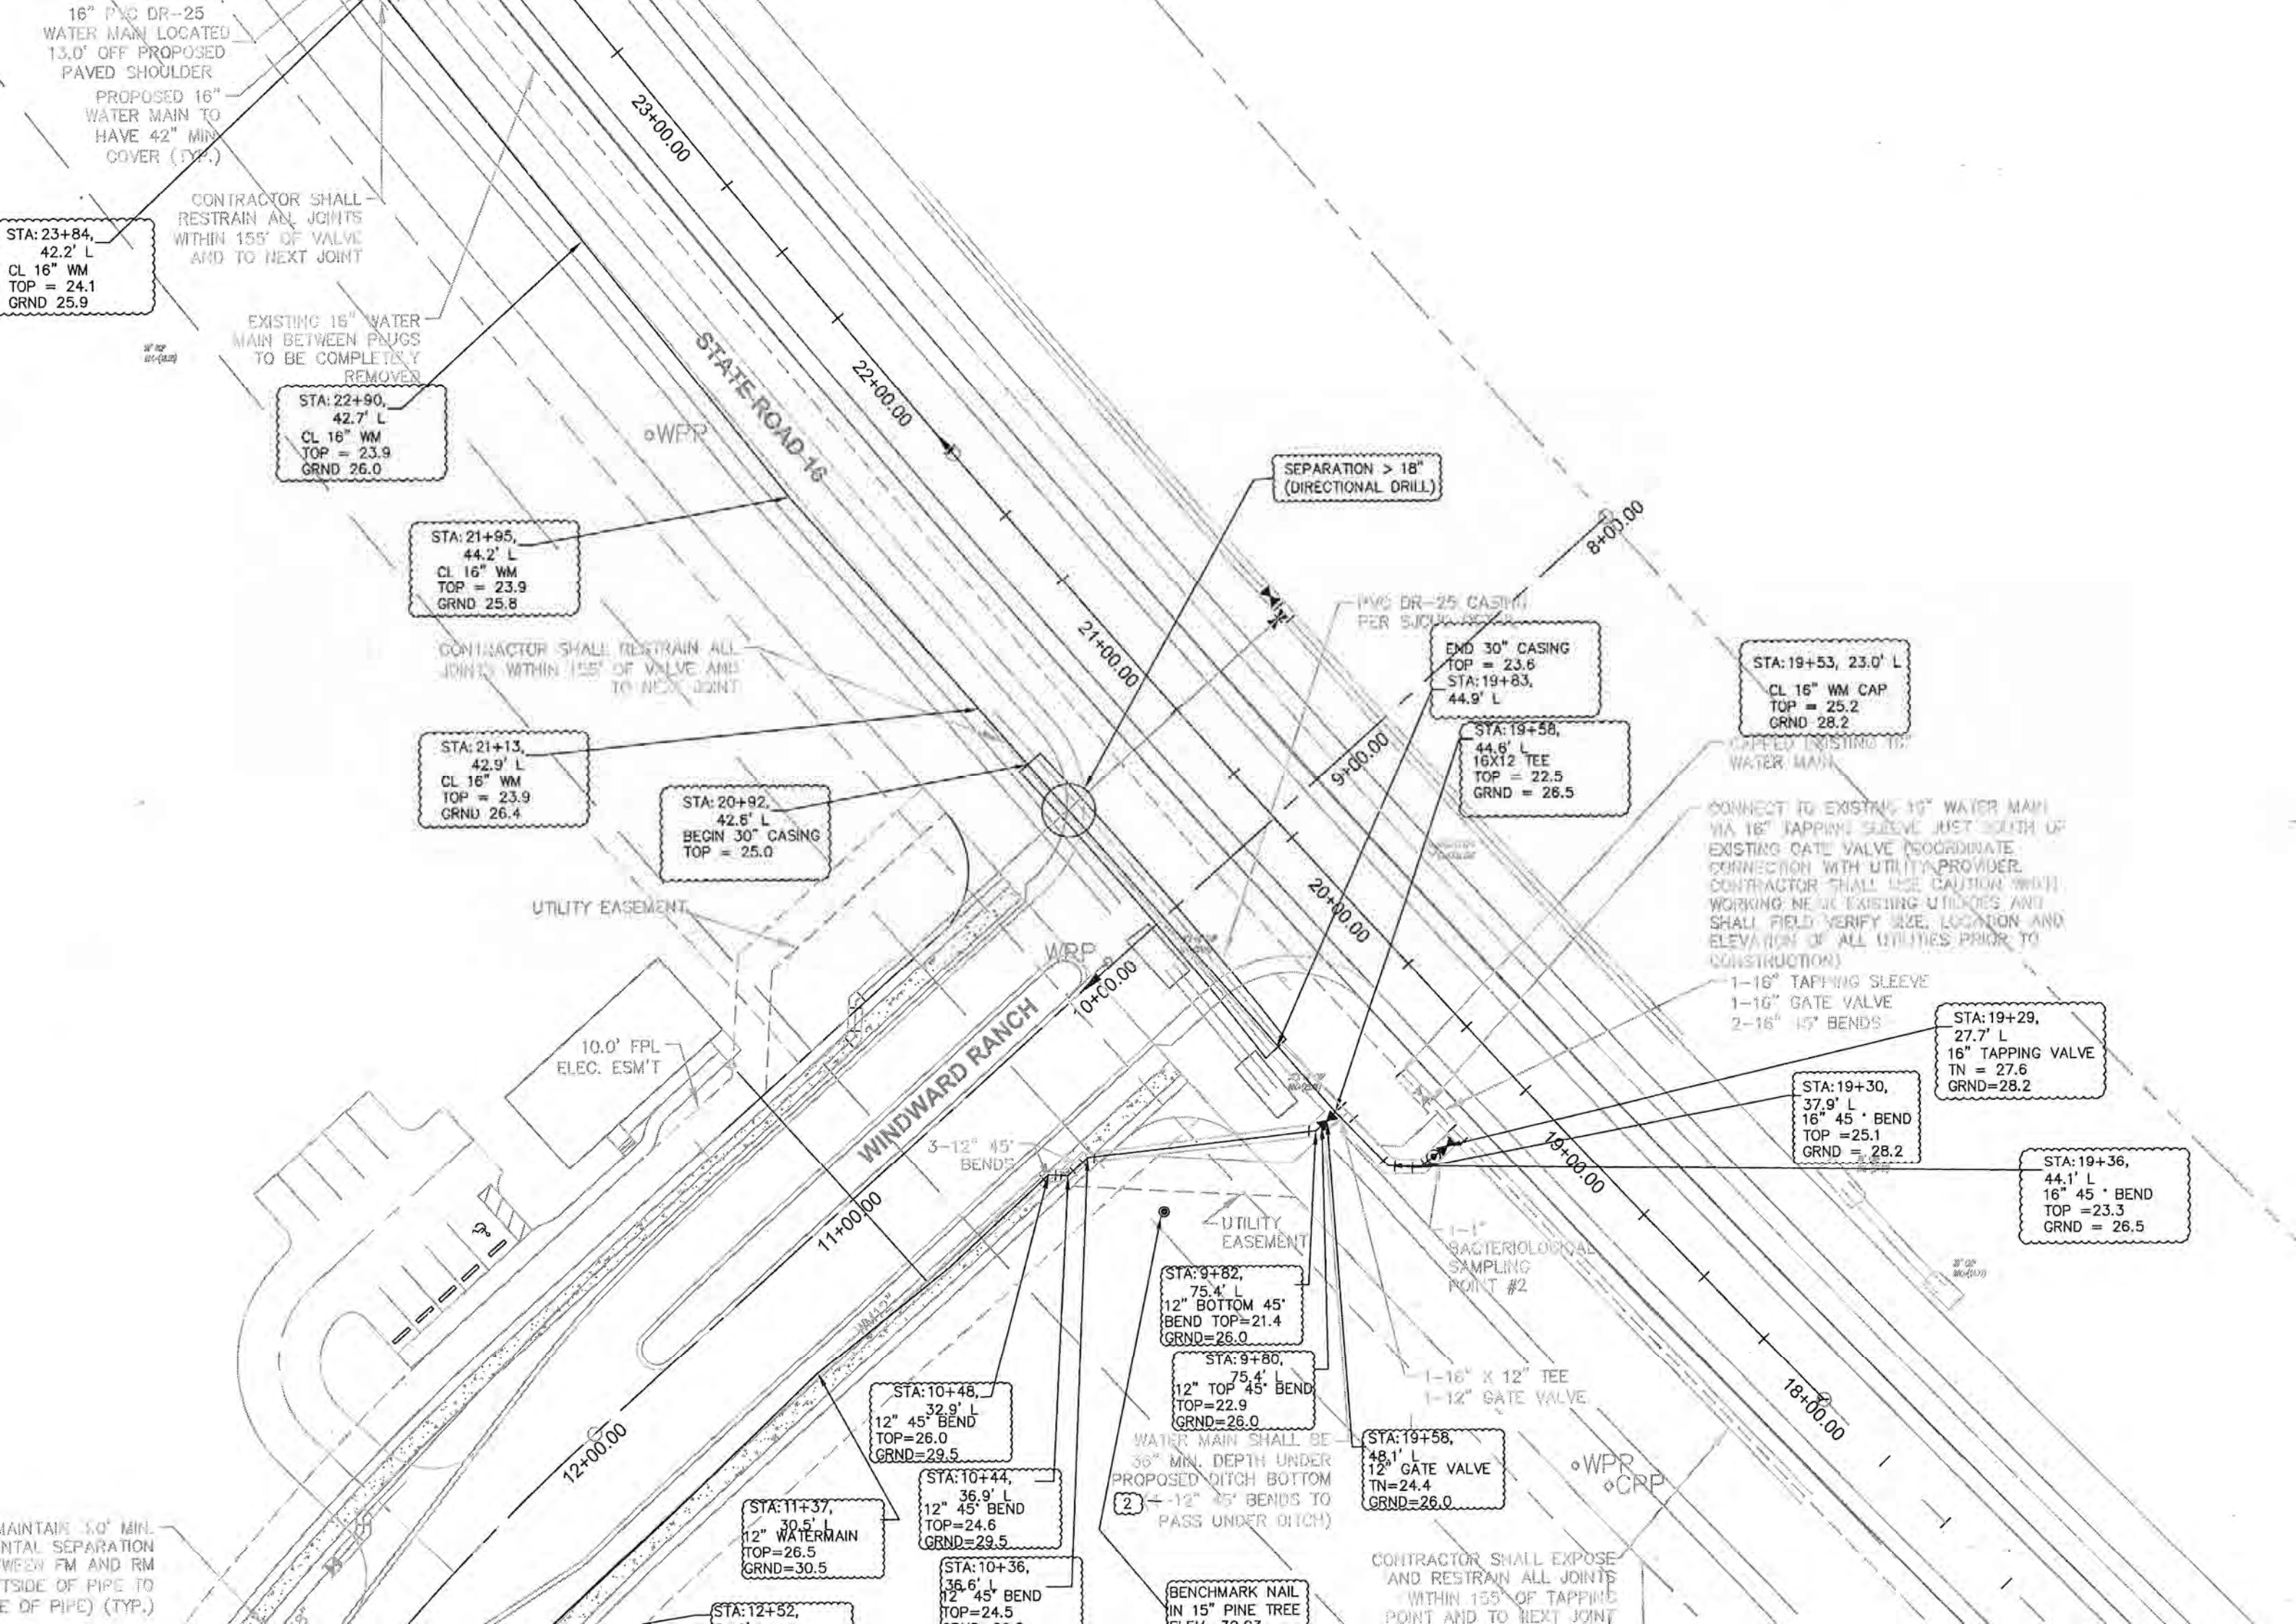

16" PVC DR-25
WATER MAIN LOCATED
13.0' OFF PROPOSED
PAVED SHOULDER

PROPOSED 16"
WATER MAIN TO
HAVE 42" MIN
COVER (TYP.)

CONTRACTOR SHALL
RESTRAIN ALL JOINTS
WITHIN 155' OF VALVE
AND TO NEXT JOINT

STA: 23+84,
42.2' L
CL 16" WM
TOP = 24.1
GRND 25.9

EXISTING 16" WATER
MAIN BETWEEN PLUGS
TO BE COMPLETELY
REMOVED

STA: 22+90,
42.7' L
CL 16" WM
TOP = 23.9
GRND 26.0

STA: 21+95,
44.2' L
CL 16" WM
TOP = 23.9
GRND 25.8

CONTRACTOR SHALL RESTRAIN ALL
JOINTS WITHIN 155' OF VALVE AND
TO NEXT JOINT

STA: 21+13,
42.9' L
CL 16" WM
TOP = 23.9
GRND 26.4

STA: 20+92,
42.5' L
BEGIN 30" CASING
TOP = 25.0

UTILITY EASEMENT

10.0' FPL
ELEC. ESM'T

WINDWARD RANCH
3-12" 45'
BENDS

STA: 10+48,
32.9' L
12" 45" BEND
TOP=26.0
GRND=29.5

STA: 10+44,
36.9' L
12" 45" BEND
TOP=24.6
GRND=29.5

STA: 11+37,
30.5' L
12" WATERMAIN
TOP=26.5
GRND=30.5

STA: 12+52,

STA: 10+36,
36.6' L
12" 45" BEND
TOP=24.5

STA: 9+82,
75.4' L
12" BOTTOM 45"
BEND TOP=21.4
GRND=26.0

STA: 9+80,
75.4' L
12" TOP 45" BEND
TOP=22.9
GRND=26.0

WATER MAIN SHALL BE
36" MIN. DEPTH UNDER
PROPOSED DITCH BOTTOM
(2) 12" 45" BENDS TO
PASS UNDER DITCH)

BENCHMARK NAIL
IN 15" PINE TREE
ELEV. 72.63

STA: 19+58,
48.1' L
12" GATE VALVE
TN=24.4
GRND=26.0

1-1" BACTERIOLOGICAL
SAMPLING
POINT #2

1-16" X 12" TEE
1-12" GATE VALVE

SEPARATION > 18"
(DIRECTIONAL DRILL)

16" DR-25 CASING
PER SJC/UT/PC

END 30" CASING
TOP = 23.6
STA: 19+83,
44.9' L

STA: 19+58,
44.6' L
16X12 TEE
TOP = 22.5
GRND = 26.5

STA: 19+53, 23.0' L
CL 16" WM CAP
TOP = 25.2
GRND 28.2

PAVED EXISTING 16"
WATER MAIN

CONNECT TO EXISTING 16" WATER MAIN
VIA 16" TAPPING SLEEVE JUST SOUTH OF
EXISTING GATE VALVE (COORDINATE
CONNECTION WITH UTILITY PROVIDER.
CONTRACTOR SHALL USE CAUTION WHEN
WORKING NEAR EXISTING UTILITIES AND
SHALL FIELD VERIFY SIZE, LOCATION AND
ELEVATION OF ALL UTILITIES PRIOR TO
CONSTRUCTION)

1-16" TAPPING SLEEVE
1-16" GATE VALVE
2-16" 45" BENDS

STA: 19+29,
27.7' L
16" TAPPING VALVE
TN = 27.6
GRND=28.2

STA: 19+30,
37.9' L
16" 45" BEND
TOP = 25.1
GRND = 28.2

STA: 19+36,
44.1' L
16" 45" BEND
TOP = 23.3
GRND = 26.5

MAINTAIN 3.0' MIN.
HORIZONTAL SEPARATION
BETWEEN FM AND RM
ON INSIDE OF PIPE TO
E OF PIPE (TYP.)

CONTRACTOR SHALL EXPOSE
AND RESTRAIN ALL JOINTS
WITHIN 155' OF TAPPING
POINT AND TO NEXT JOINT

2017 NW Park Place Water-Sewer As Built Drawings



PUD 2006-34
FOR


HRHR, L.L.C.

4314 PABLO OAKS COURT
JACKSONVILLE, FLORIDA 32256
(904) 992-9750

ST. JOHNS COUNTY, FLORIDA

WATER AND REUSE WATER
AS BUILT



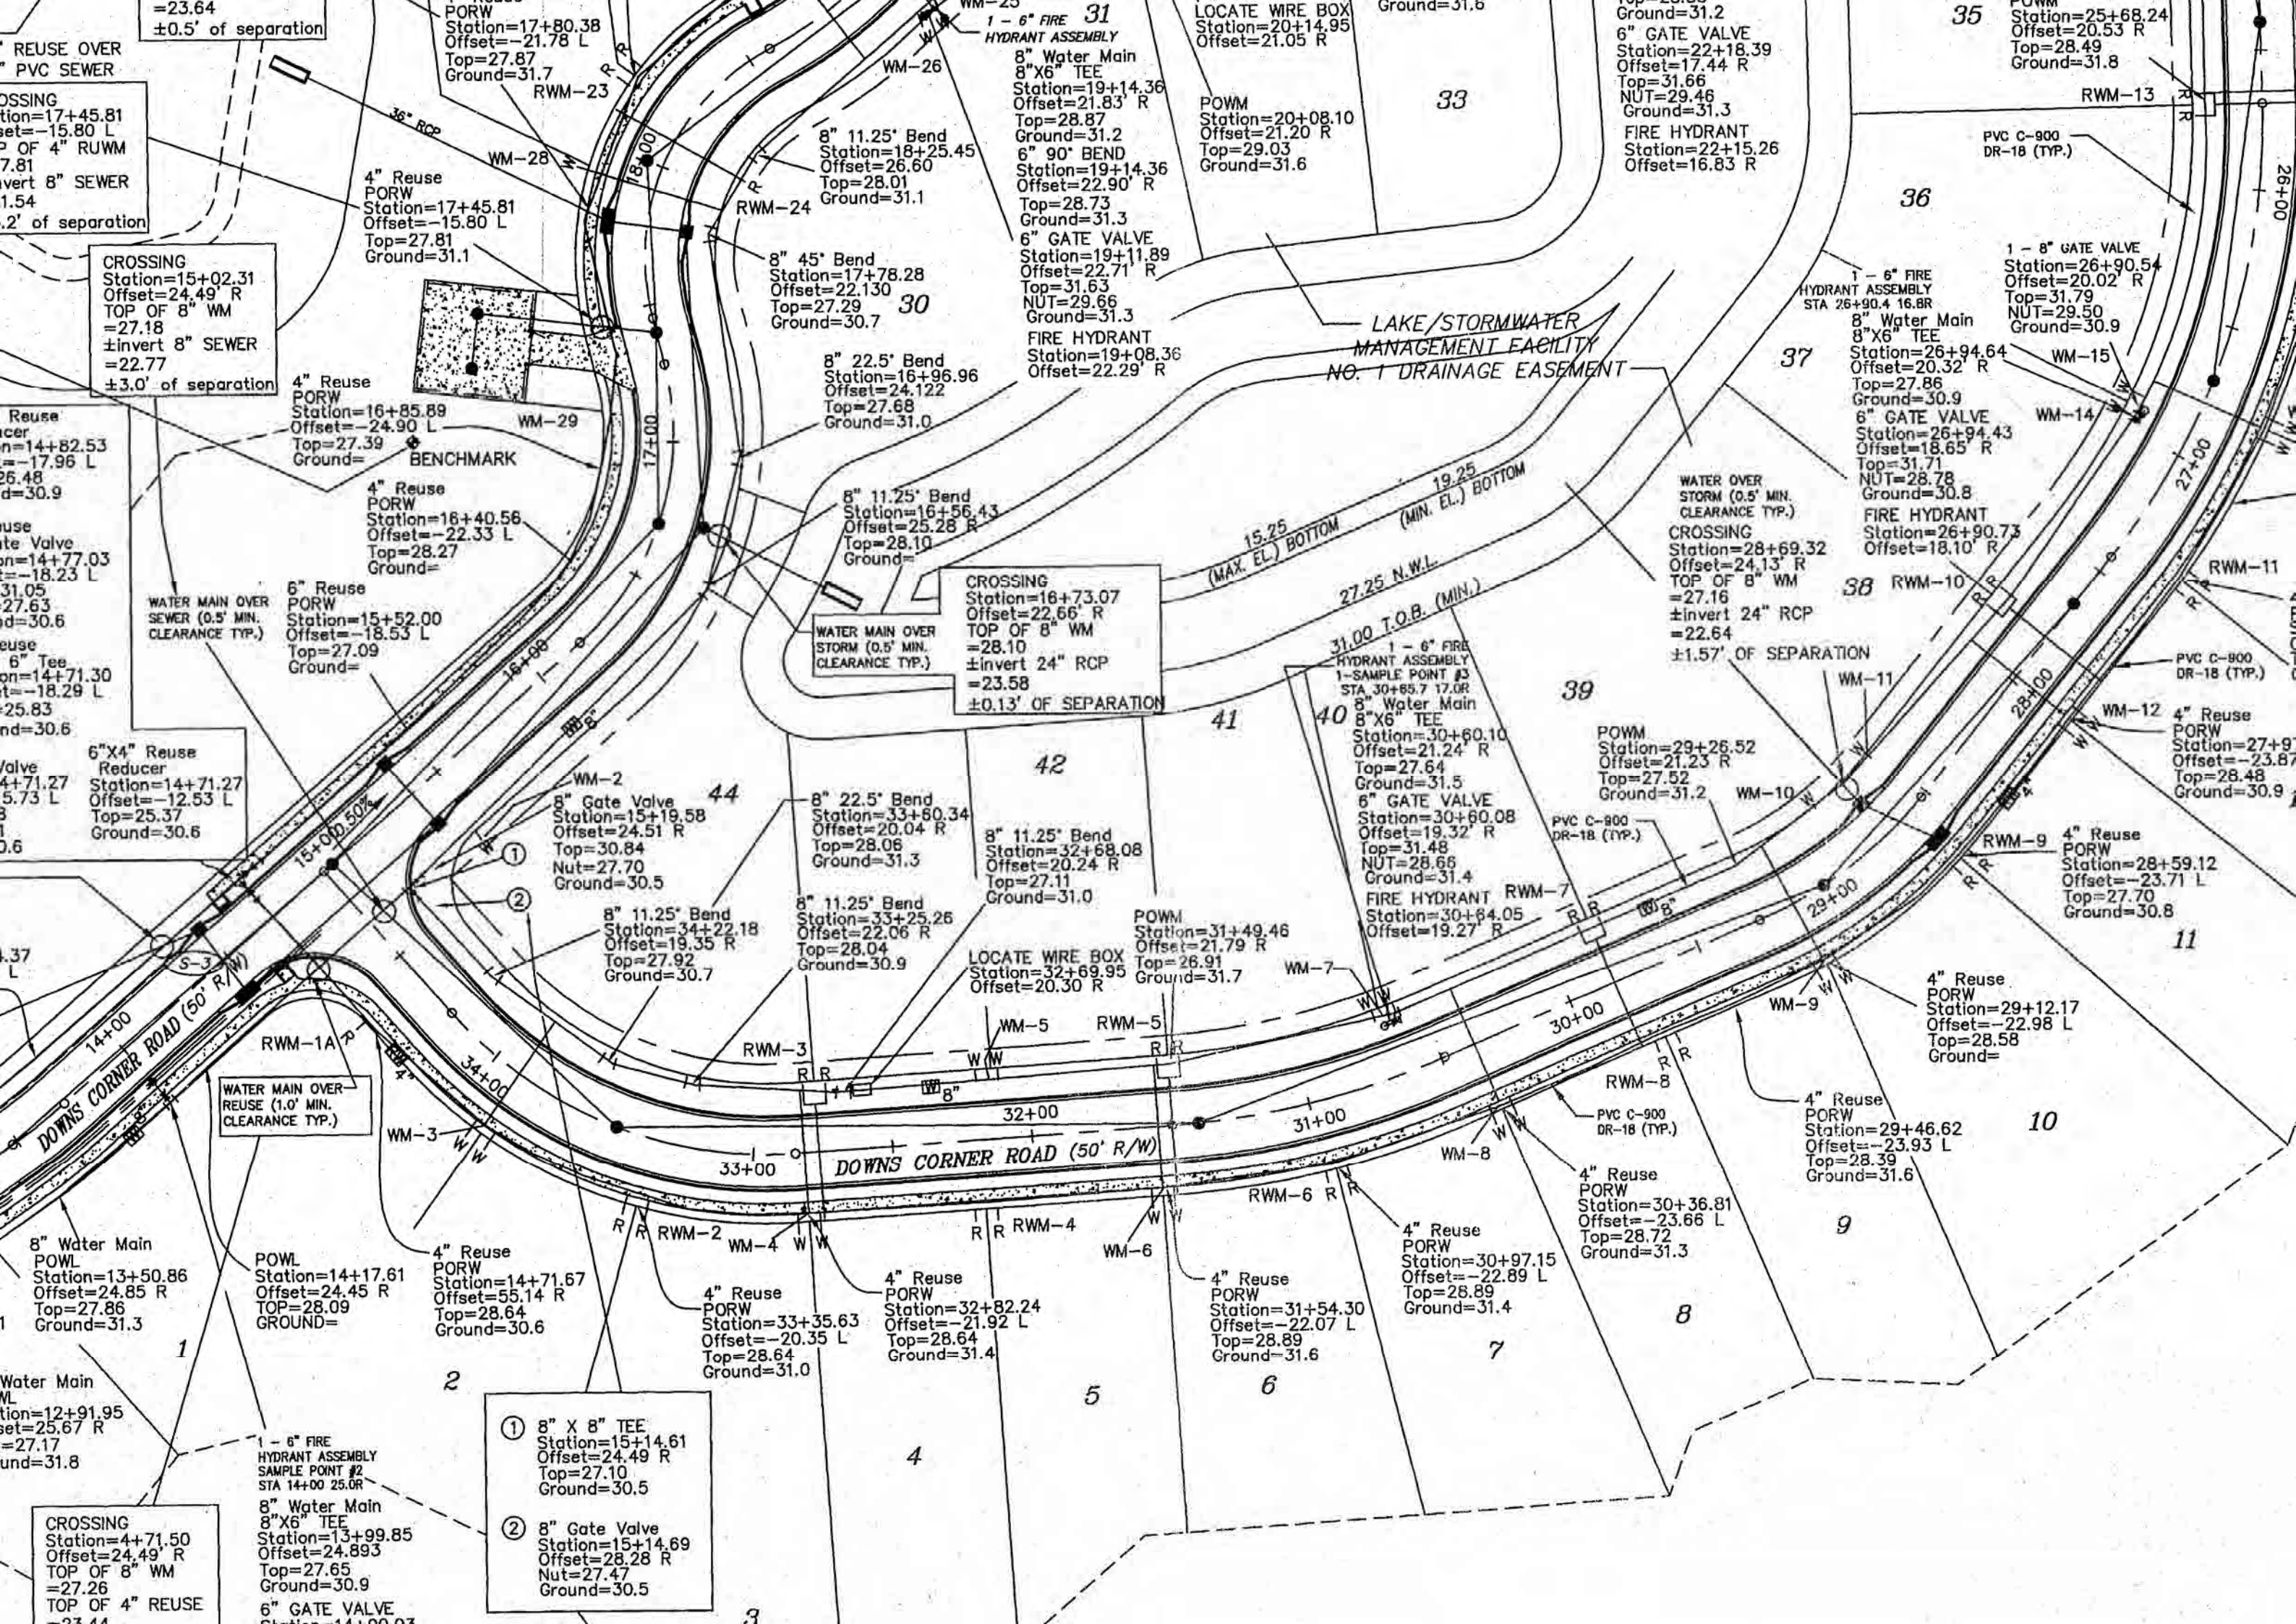

BOOK 2000 34
FOR

HRHR, L.L.C.

4314 PABLO OAKS COURT
JACKSONVILLE, FLORIDA 32256
(904) 992-9750

ST. JOHNS COUNTY, FLORIDA

GRAVITY SEWER, FORCE MAIN
AND LIFT STATION AS BUILT



PUD 2006-34
FOR

HRHR, L.L.C.


4314 PABLO OAKS COURT
JACKSONVILLE, FLORIDA 32256
(904) 992-9750


ST. JOHNS COUNTY, FLORIDA


PAVING AND DRAINAGE
AS BUILT



SEE AS BUILT SHEETS THREE
AND FOUR FOR LIFT STATION

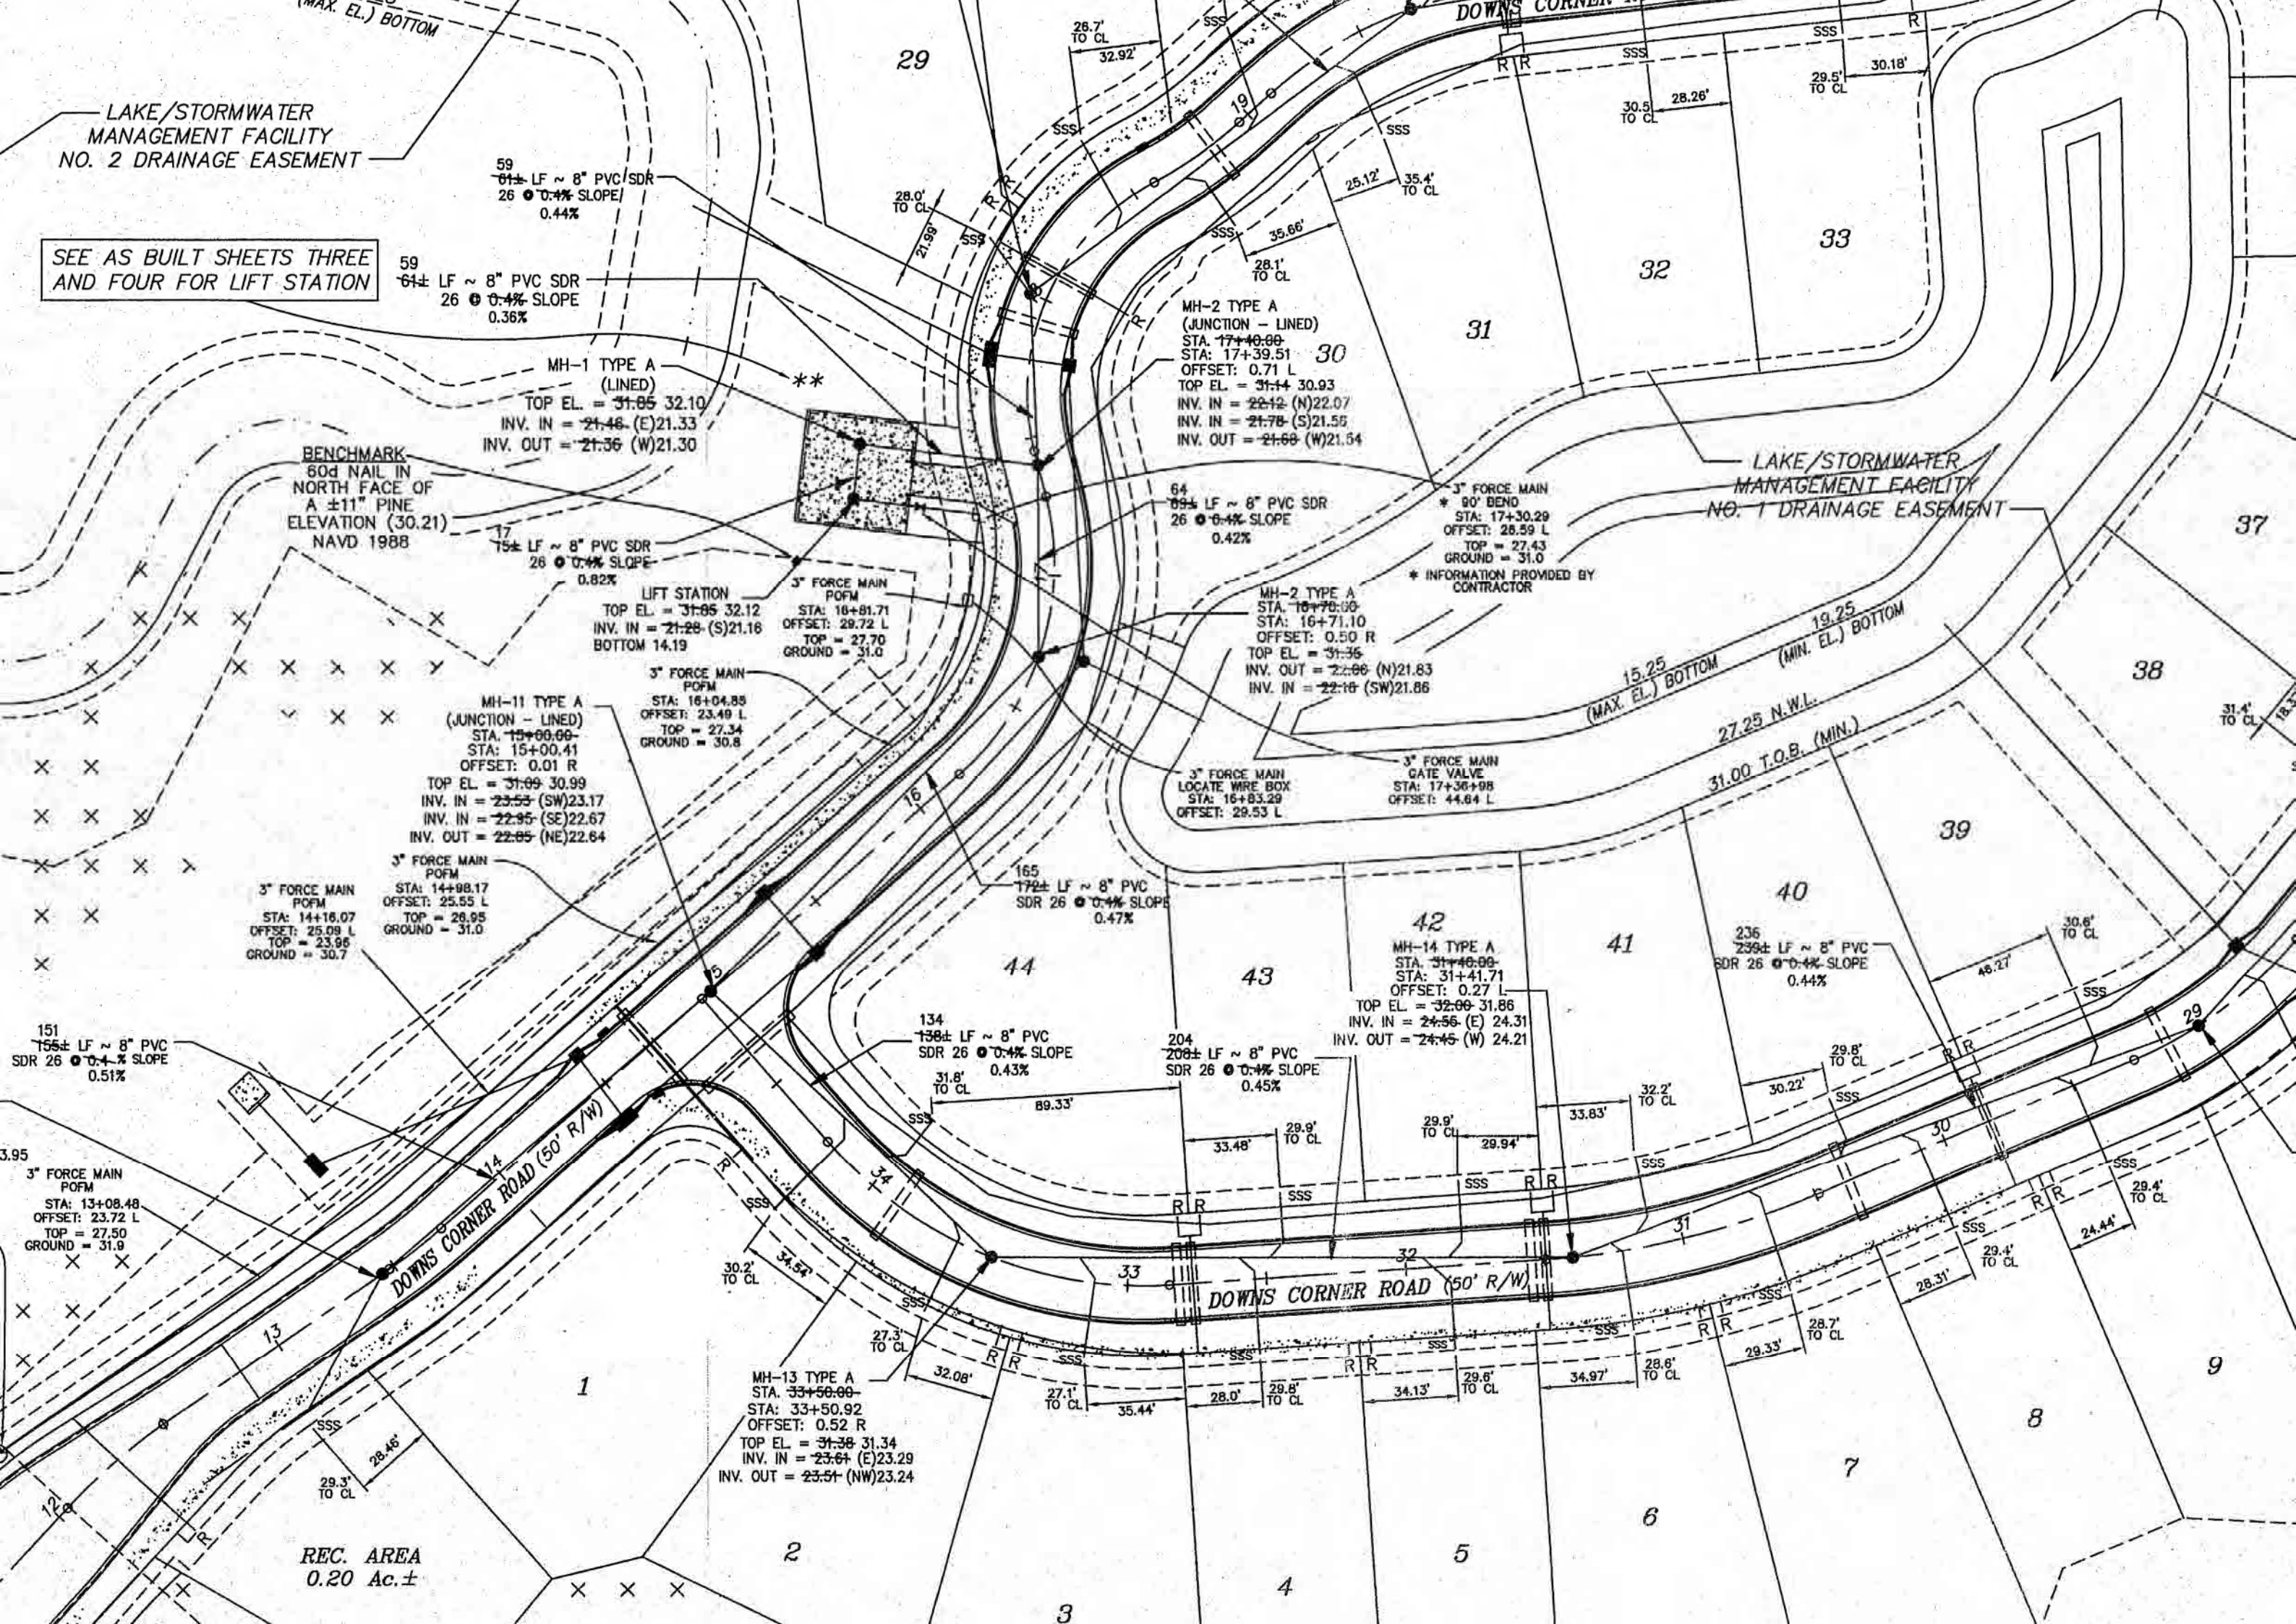

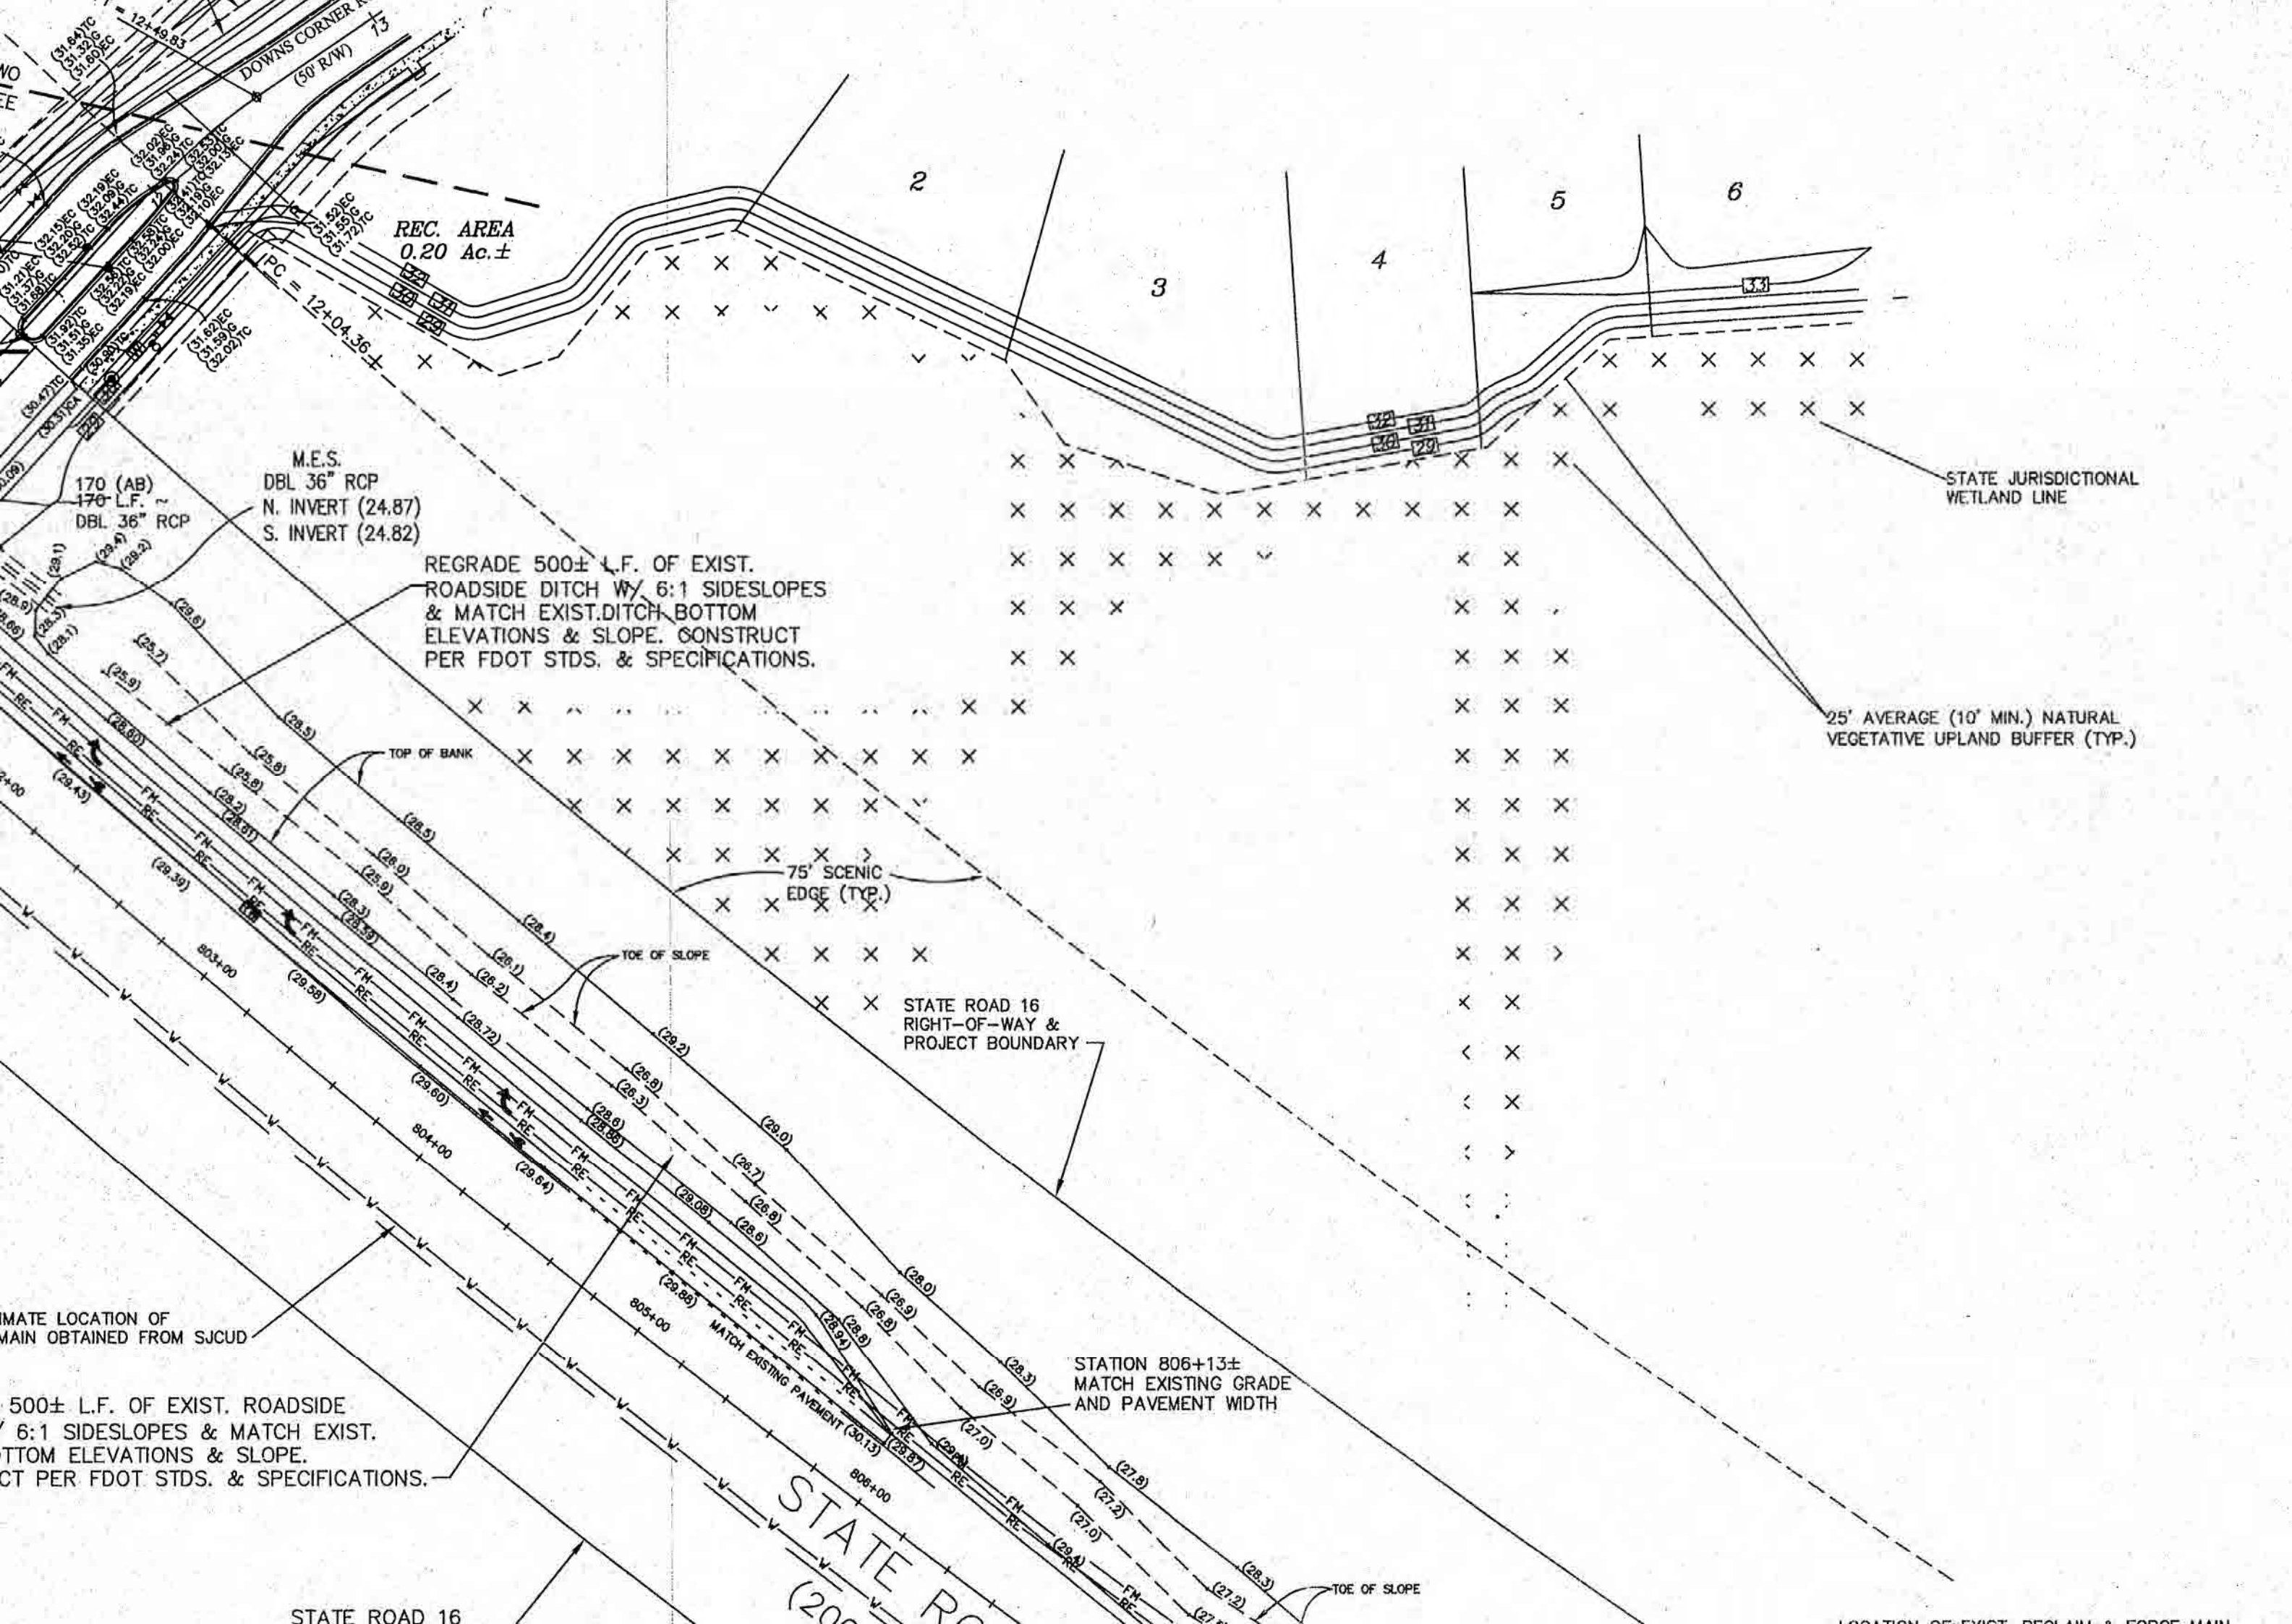

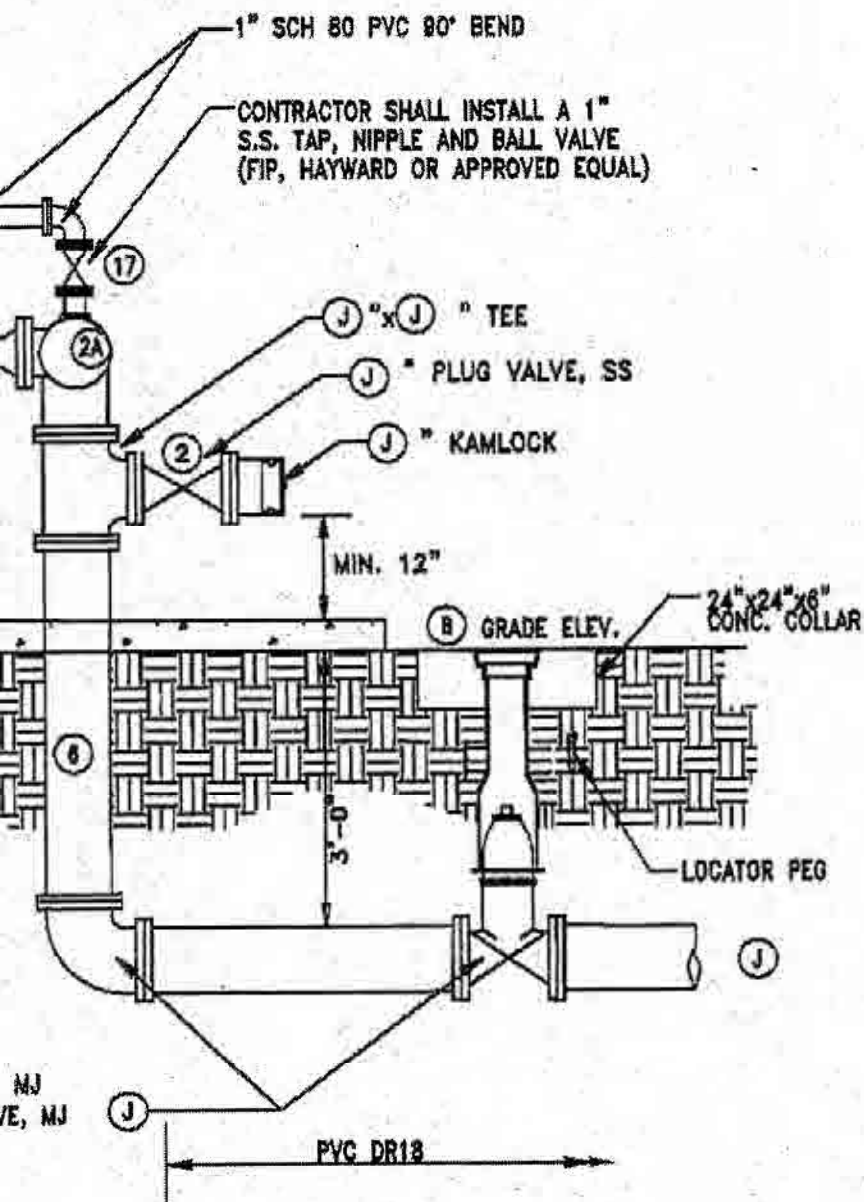

WALL THICKNESS

R' NEK

PIECE BASE

⑨ EMERGENCY SUCTION PIPING SIZE 4"

PUMP INFORMATION

NUMBER OF PUMPS 2
 PUMP MANUFACTURER FLYGT
NON-CLOG SUBMERSIBLE
 MODEL MP 3102 IMPELLER 142
 DISCHARGE 6 HP 208 MOTOR RPM 3475
3 VOLTS 60 HZ
 DESIGN POINT 36 GPM AT 104 FT.TDH
 OPERATING COND. 47 GPM AT 109 FT.TDH
 PUMP ACCESS HATCH SIZE 3' x 4'

MECHANICAL EQUIPMENT SCHEDULE

- ① CHECK VALVE, MUELLER OR M&H SWING-TYPE LEVER FACING OUTSIDE, LEVER & SPRING OPERATED, IRON BODY, BRONZE MOUNTED
- ② PLUG VALVE, DEZURIK, CAST IRON BODY, LEVER ACTUATED
- ②A CONTRACTOR TO INSTALL PRESSURE SENSOR, ONYX, PART #180-0400-22-09-03, PSW-STAINLESS STEEL, VITRON SEAL, SILICON FILL W/ 1/2" NPT CONNECTION INCLUDING A PRESSURE TRANSMITTER, ABB PART #264HSPSBA1 CALIBRATOR 0-150 PSI (OR S.J.C.U.D. APPROVED EQUAL)
- ③ STAINLESS STEEL TEE
- ④ STAINLESS STEEL SHORT RADIUS 90° BEND
- ⑤ STAINLESS STEEL 45° BEND
- ⑥ 316 STAINLESS STEEL PIPE (SCH 10)
- ⑦ DUCTILE IRON PUMP BASE
- ⑧ INFLUENT PIPE (SEE PLANS)
- ⑨ CONCRETE WETWELL
- ⑩ FLYGT PUMP (AS APPROVED BY ST. JOHNS COUNTY UTILITY DEPARTMENT) NON-CLOG SUBMERSIBLE, 3"
- ⑪ ALUMINUM WETWELL ACCESS COVER (OPENING PER PUMP MANUFACTURER)
- ⑫ STAINLESS STEEL GUIDE RAILS
- ⑬ LEVEL TRANSDUCER, HIGH AND LOW ALARM FLOATS PROVIDED BY PUMP MANUFACTURER
- ⑭ PUMP MOTOR CABLE
- ⑮ 4" TEE SCHEDULE 80 PVC AIR VENT WITH PROTECTIVE SCREENS
- ⑯ STAINLESS STEEL CABLE HOLDER
- ⑰ 1" STAINLESS BLOW OFF LINE TO WETWELL-SECURE LINE TO WETWELL SLAB W/ UNISTRUT.
- ⑱ 1/4" STAINLESS STEEL WITH 18" OF CHAIN LINKS (FLYGT GRIP EYE CONNECTOR).

RECEIVING MANHOLE

SEPARATE W/
EXPANSION JOINT

PROPERTY LINE

6" CONCRETE (TYPICAL)
OVER ENTIRE SITE

SITE LIGHT POLE PER
 (SEE ELECTRICAL PLAN)
 FROM EDGE OF WET WELL
 FIXTURE IN FRONT OF

AS-BUILT PROFESSIONAL SURVEYOR AND MAPPER C

INFORMATION PROVIDED BY: A & J LAND SURVEYORS, INC.

DATE: SEPTEMBER 8, 2016

NAME: GEORGE J. WARD

ADDRESS: 5847 LUELLA STREET

JACKSONVILLE, FLORIDA 32207

PHONE NO.: (904) 346-1733

I HEREBY CERTIFY THAT THE

PAVEMENT	CHILLED WATER
CURB & GUTTER	WATER MAIN
STORM & DRAINAGE SYSTEM	RECLAIMED WATER
LAKE OR POND	X FORCE MAIN
UNDERDRAIN CONNECTIONS	X SANITARY GRAVITY
FIRE WATER MAIN	X LIFT STATION

ARE AT THE HORIZONTAL AND VERTICAL LOCATIONS AS SHOWN
 DRAWINGS AND MEET THE MINIMAL TECHNICAL STANDARDS SET
 OF PROFESSIONAL SURVEYORS AND MAPPERS IN CHAPTER 610
 PURSUANT TO SECTION 472.027 FLORIDA STATUTES.

DATE OF FIELD SURVEY SEPTEMBER 8, 2016

SIGNATURE:

NAME:


GEORGE J. WARD

FLORIDA REGISTERED LAND SURVEYOR'S NUMBER PLS 5155

NOTES:

12. PLUG VALVE SEAT

SHEET TWO
THS, INVERTS

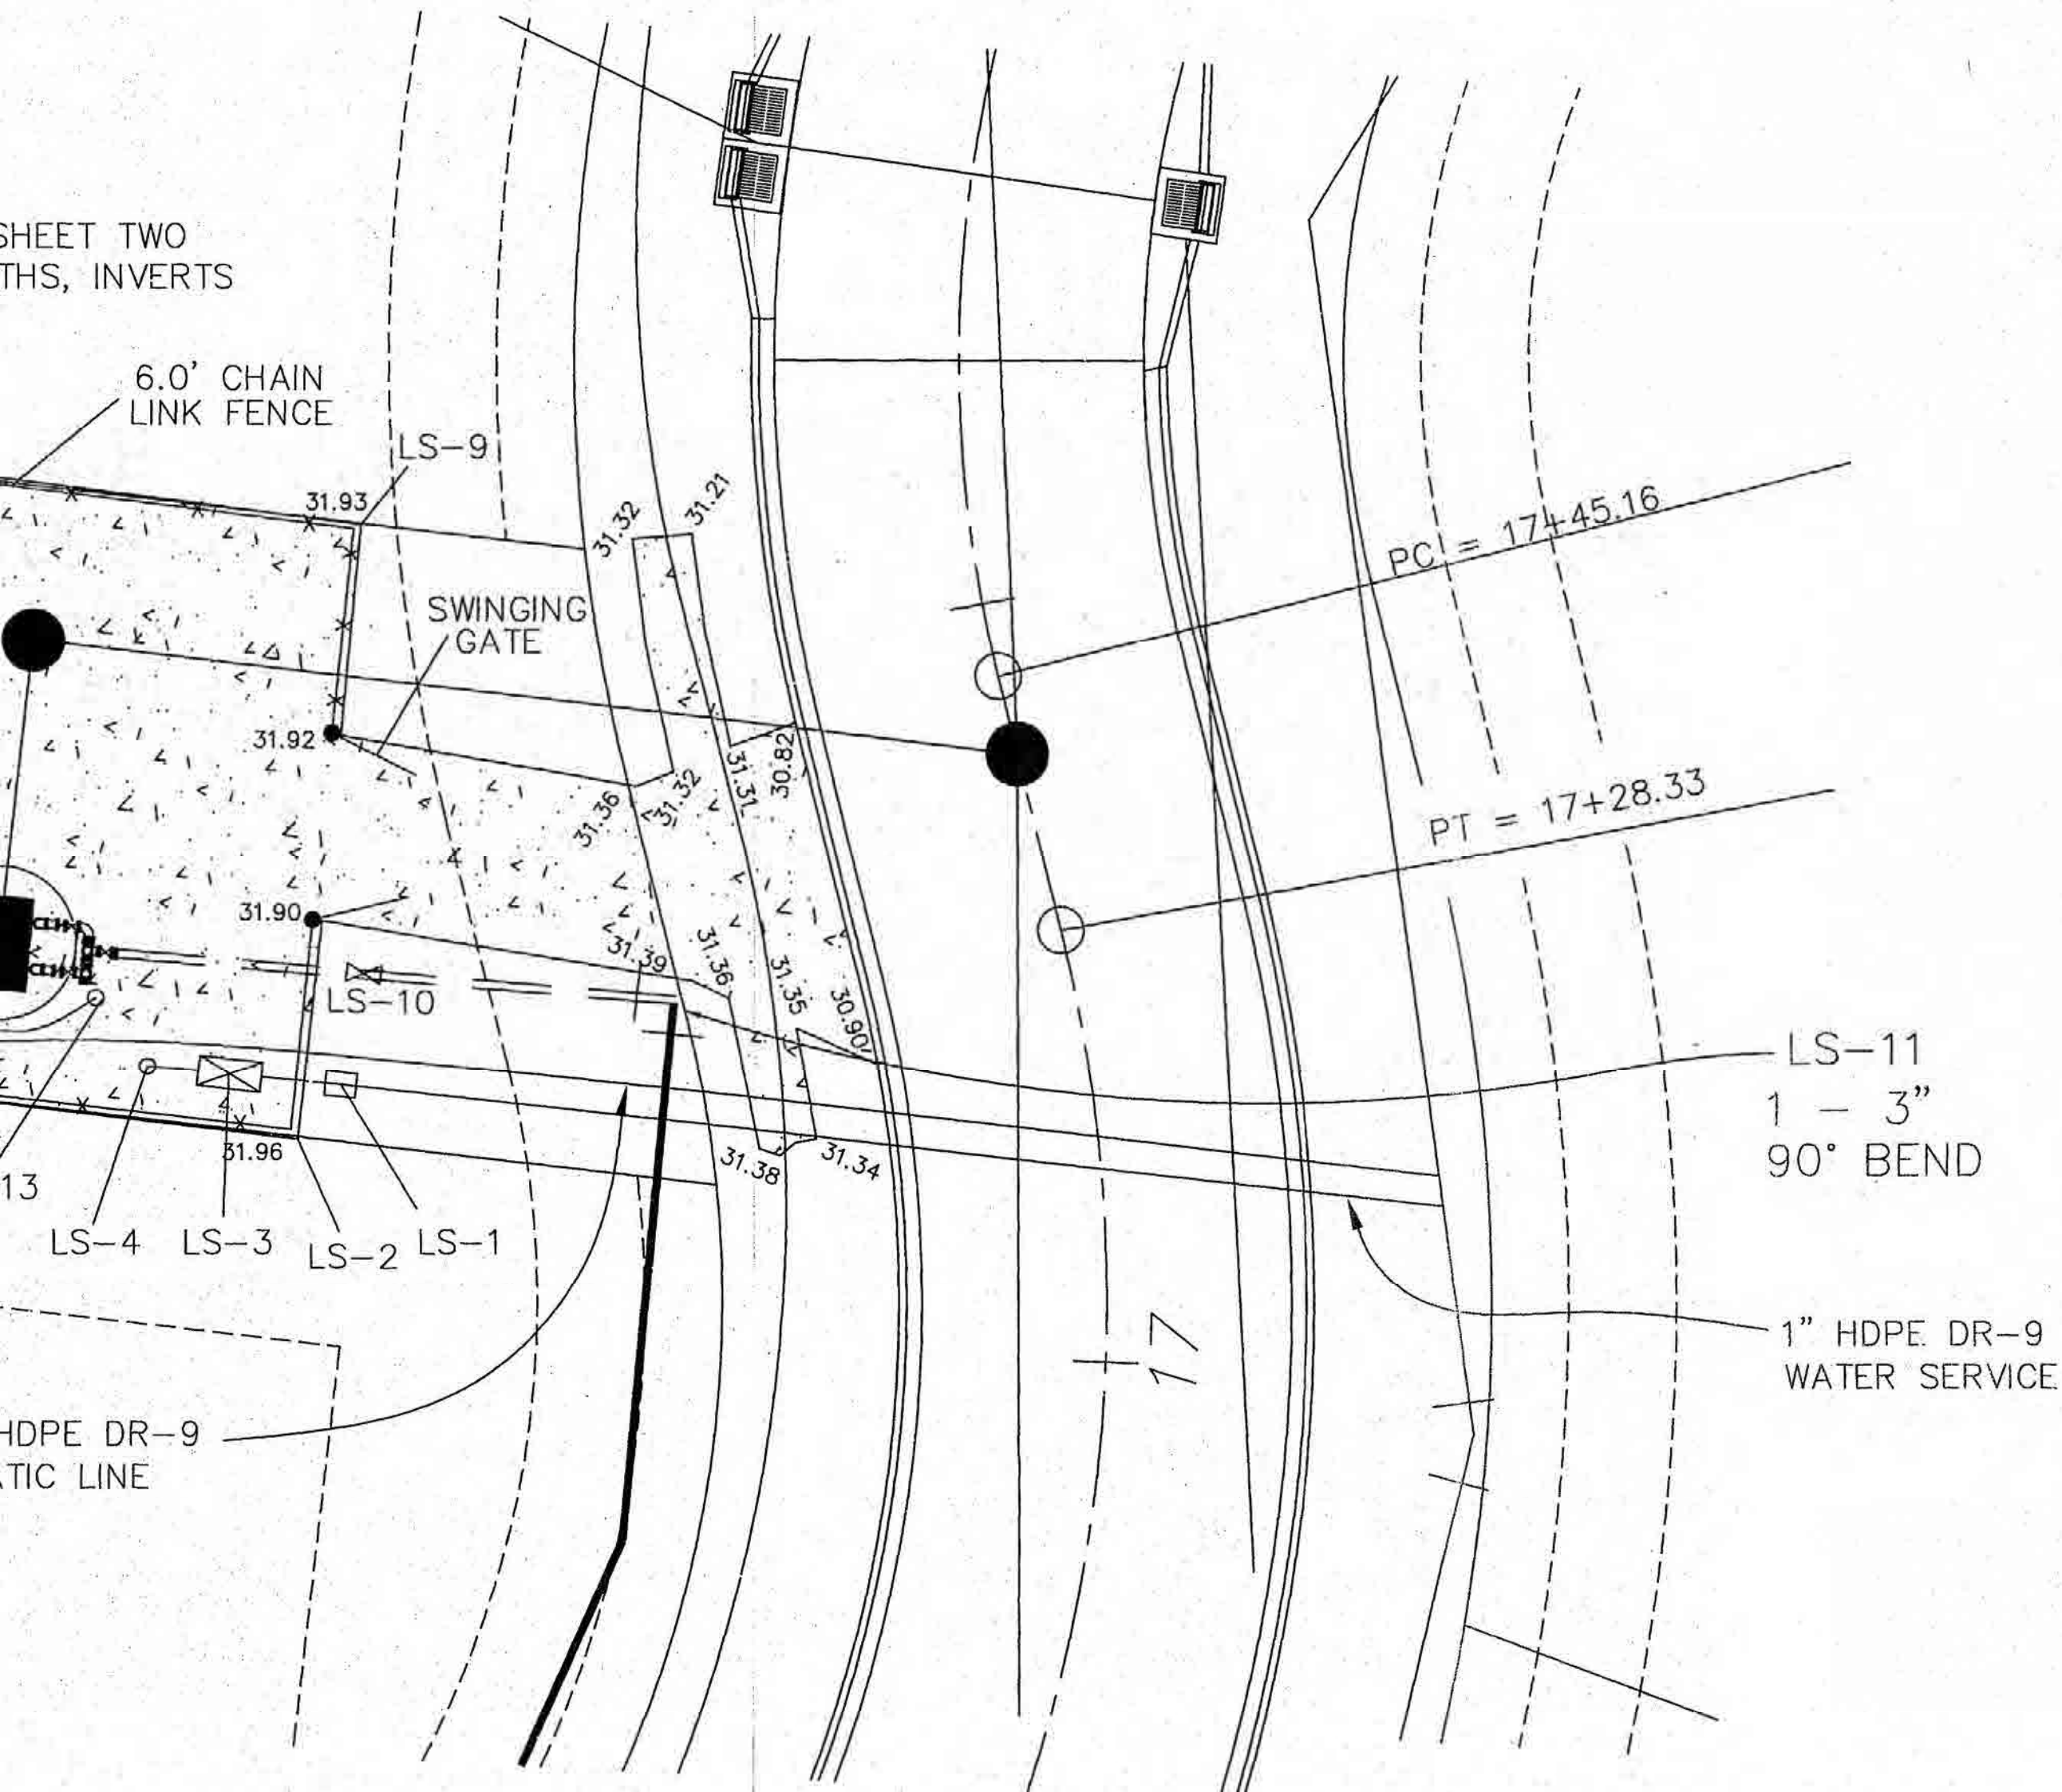


LS-4	PH
LS-5	CO C
LS-6	EL EQ R
LS-7	FIE LIG
LS-8	CO C
LS-9	CO C
LS-10	FO
LS-11	3
LS-12	STA L CON
LS-13	1" PR TRA



2017 NW Tadpole Prep As Built Drawings



KB PRO
RON
3 CHARL
ST. AUGUST
904-6

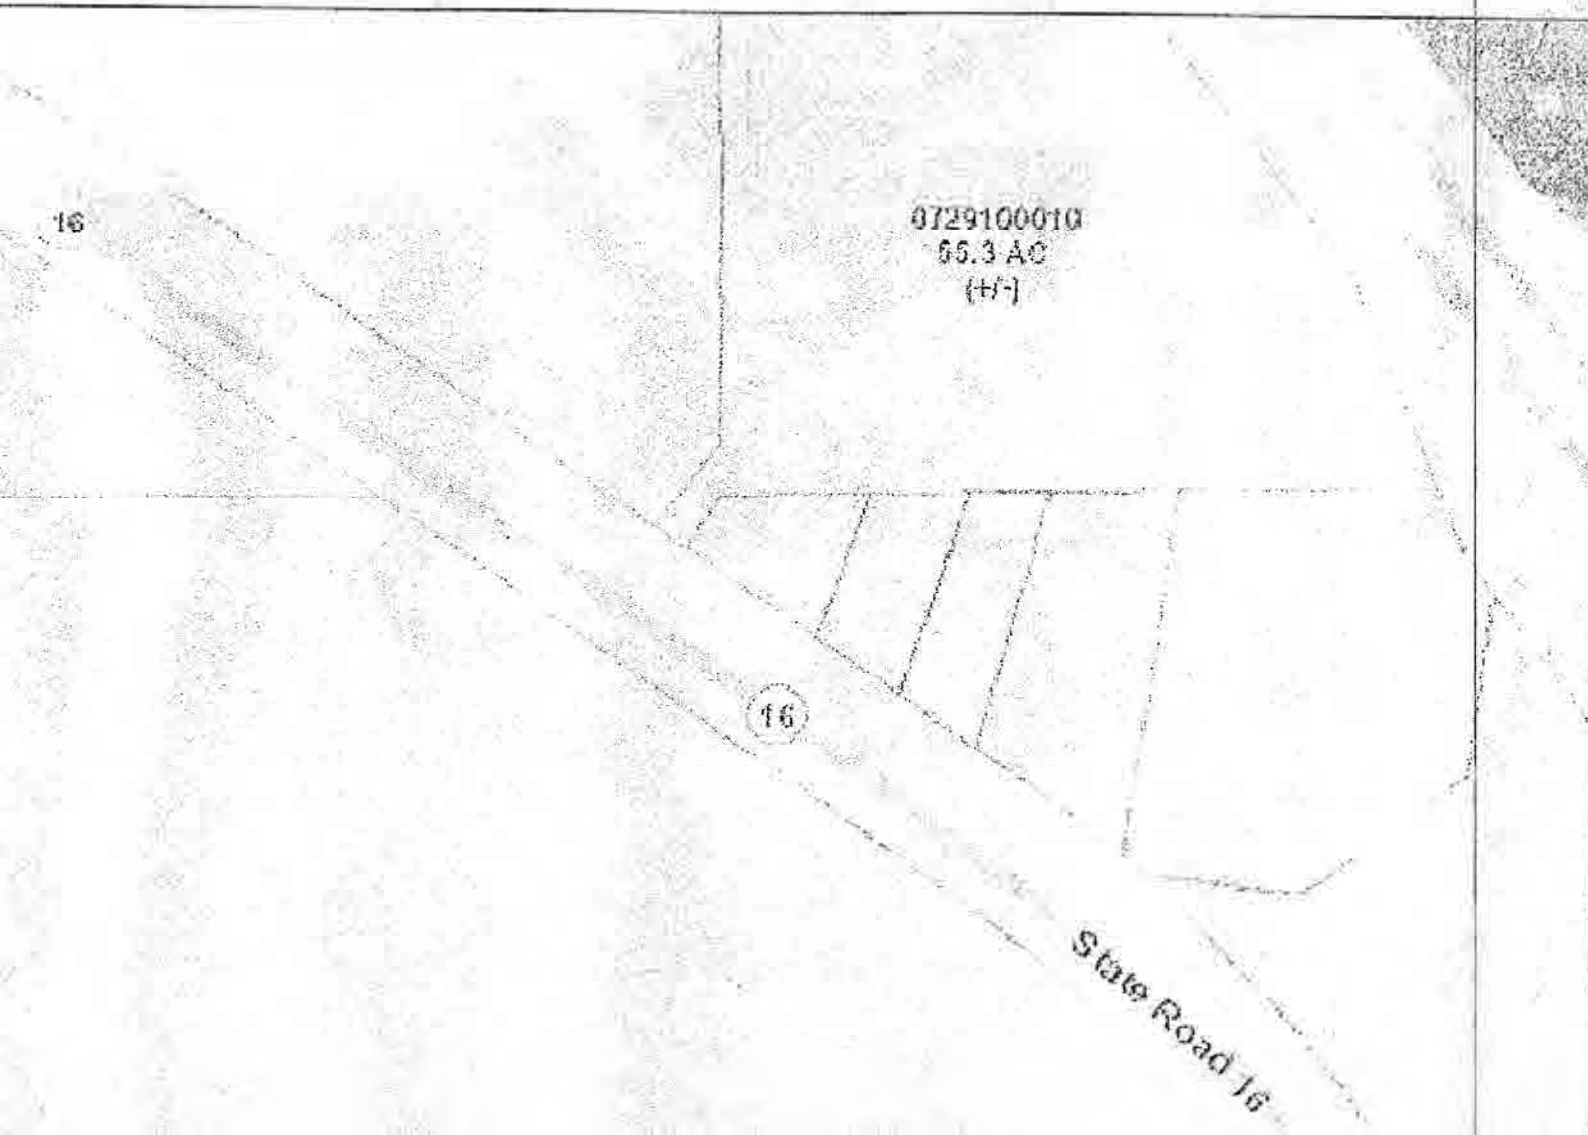

**PROJECT
LOCATION**

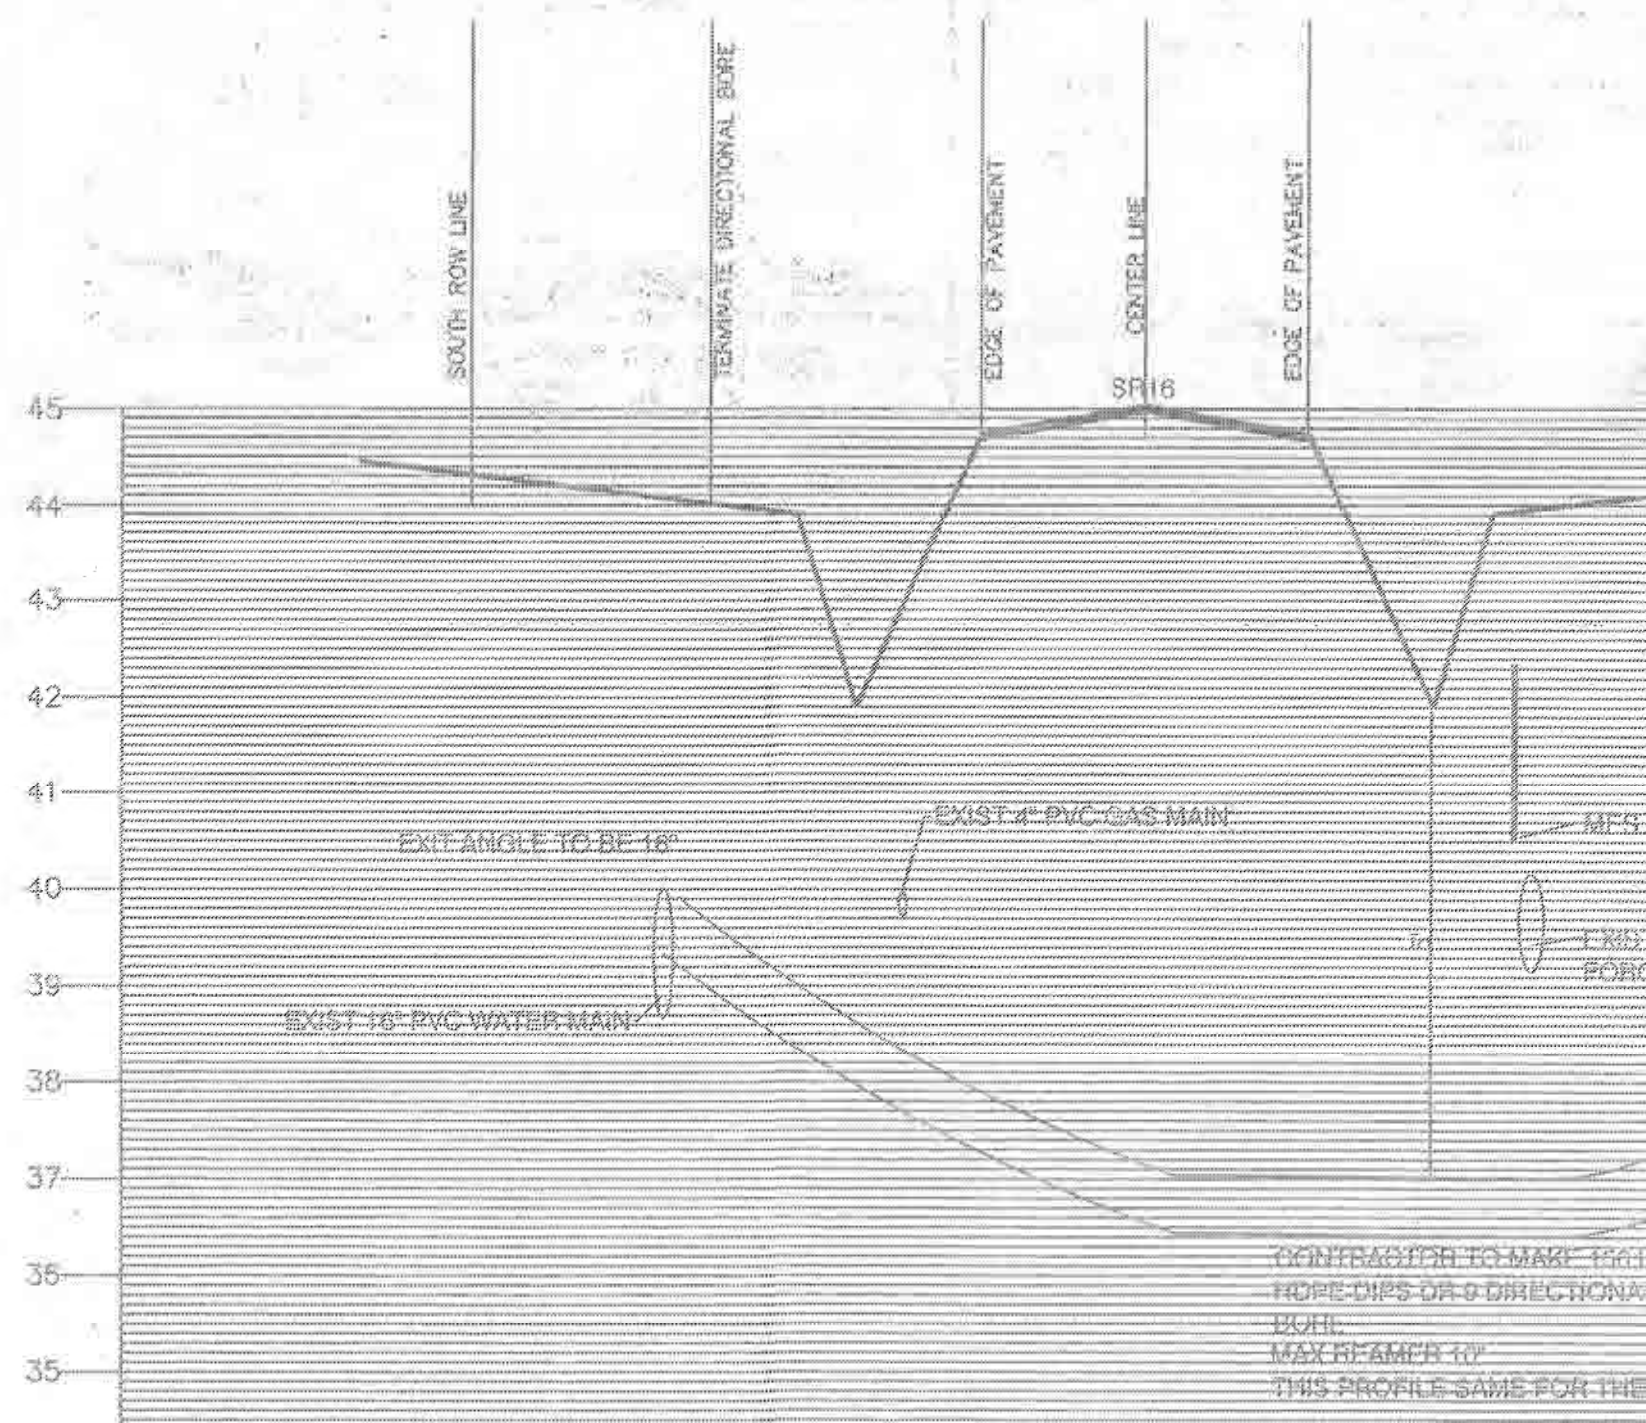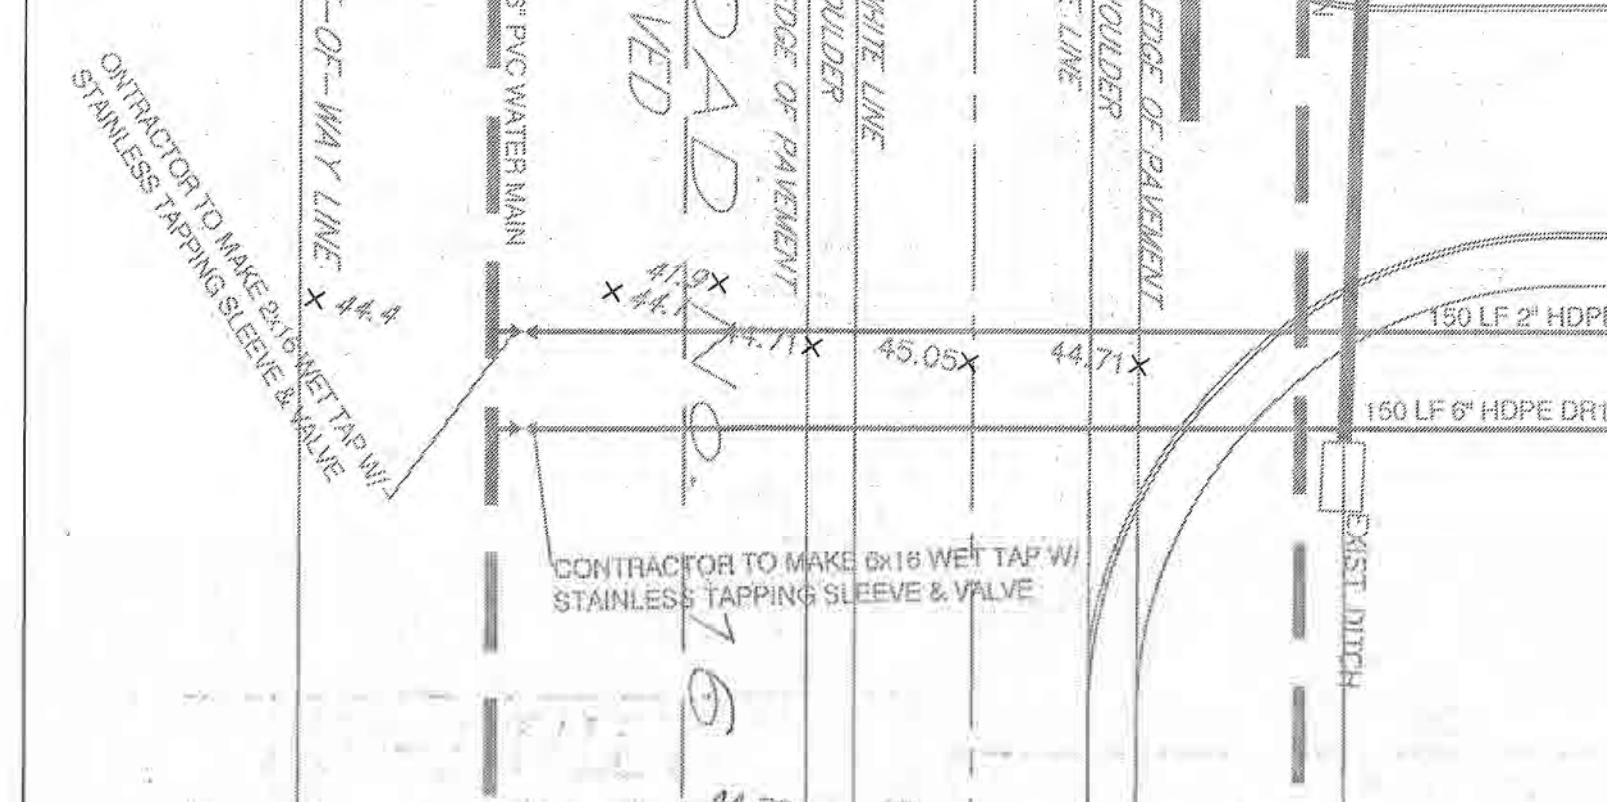

ALUMINUM GRATING, LOCATED OPPOSITE
MOTOR CONTROL CABINET. (SEE SITE PLAN).
TOP OF GRATING TO BE FLUSH WITH TOP
OF CONCRETE.

1/2"x1"x1" ALUMINUM
ANGLE FRAME
LINED CONCRETE ON TOP AND
INTO ALL OPENINGS IN TOP
FIELD LINE TOP SLAB AND
WALL SECTION JOINTS.

A
P

316 STAINLESS STEEL LIFTING CHAINS
AND APPROPRIATELY SIZED SHACKLES.
PROVIDE 5'-0" MIN. EXCESS LIFTING CHAIN.
SEE NOTE NO.1

APPROVED CORROSION PROTECTION

AS RECOMMENDED BY PUMP
MANUFACTURER

INCOMING PVC
SANITARY LINE

APPLY COATING OVER
INTERIOR GROUT AS
SPECIFIED

CONCRETE

6" MIN. LEVELING COURSE
CONCRETE
OR APPROVED EQUAL

CONCRETE AND REINFORCING
STEEL DESIGN TO BE SIGNED
BY A FLORIDA REGISTERED
SUBMIT WITH SHOP
ENGINEER DRAWINGS.

WETWE

6"
SEA
6"

2018 NW Mill Creek North As Built Drawings



ASH PROPERTIES


7880 Gate Parkway, Suite 300
Jacksonville, Florida 32256

N# 087360-0000 & 087360-00


PREPARED BY:

RAY THOMPSON SURVEYING, INC.

1825 University Boulevard West
Jacksonville, Florida 32217
(Phone) 904-448-5125

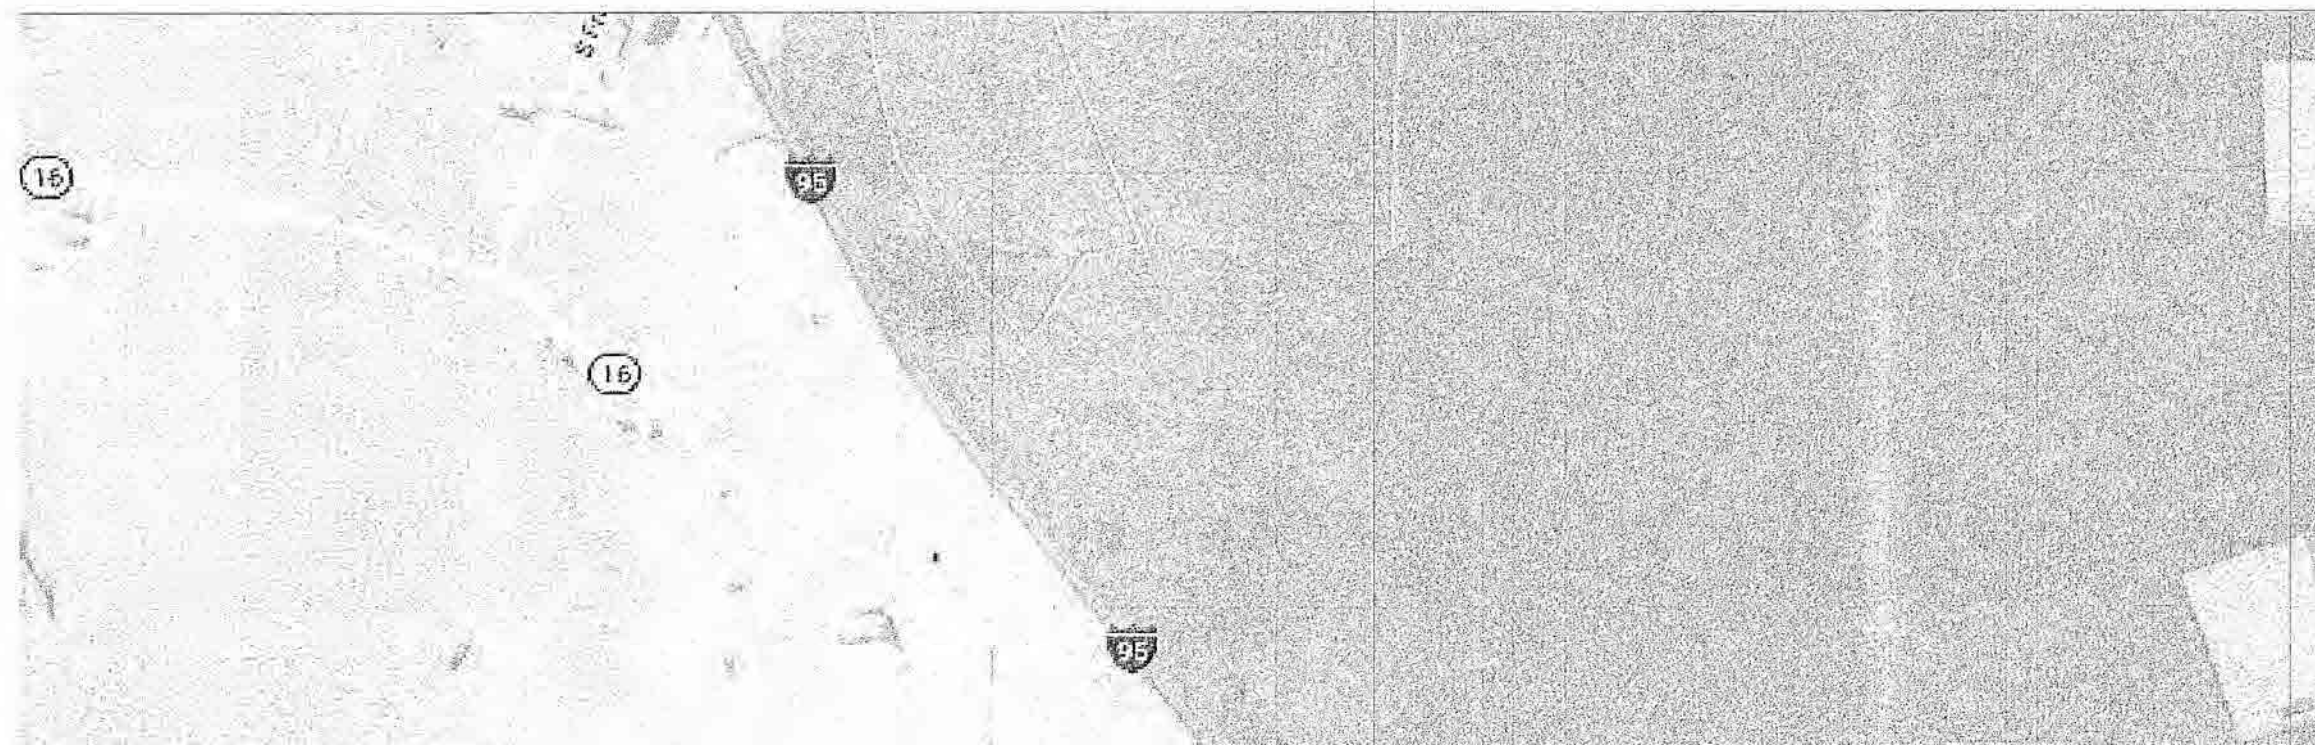

LABEL/SIZE/TYPE	MANUFACTURER	# TUN
W-2 10" GATE VALVE	MULLER	
W-9 4" GATE VALVE	MULLER	
W-11 4" GATE VALVE	MULLER	
W-13 4" DCDA RPZ-BFP	ZURN WILKINS	
W-14 8" GATE VALVE	MULLER	
W-15 8" DCDA RPZ-BFP	ZURN WILKINS	

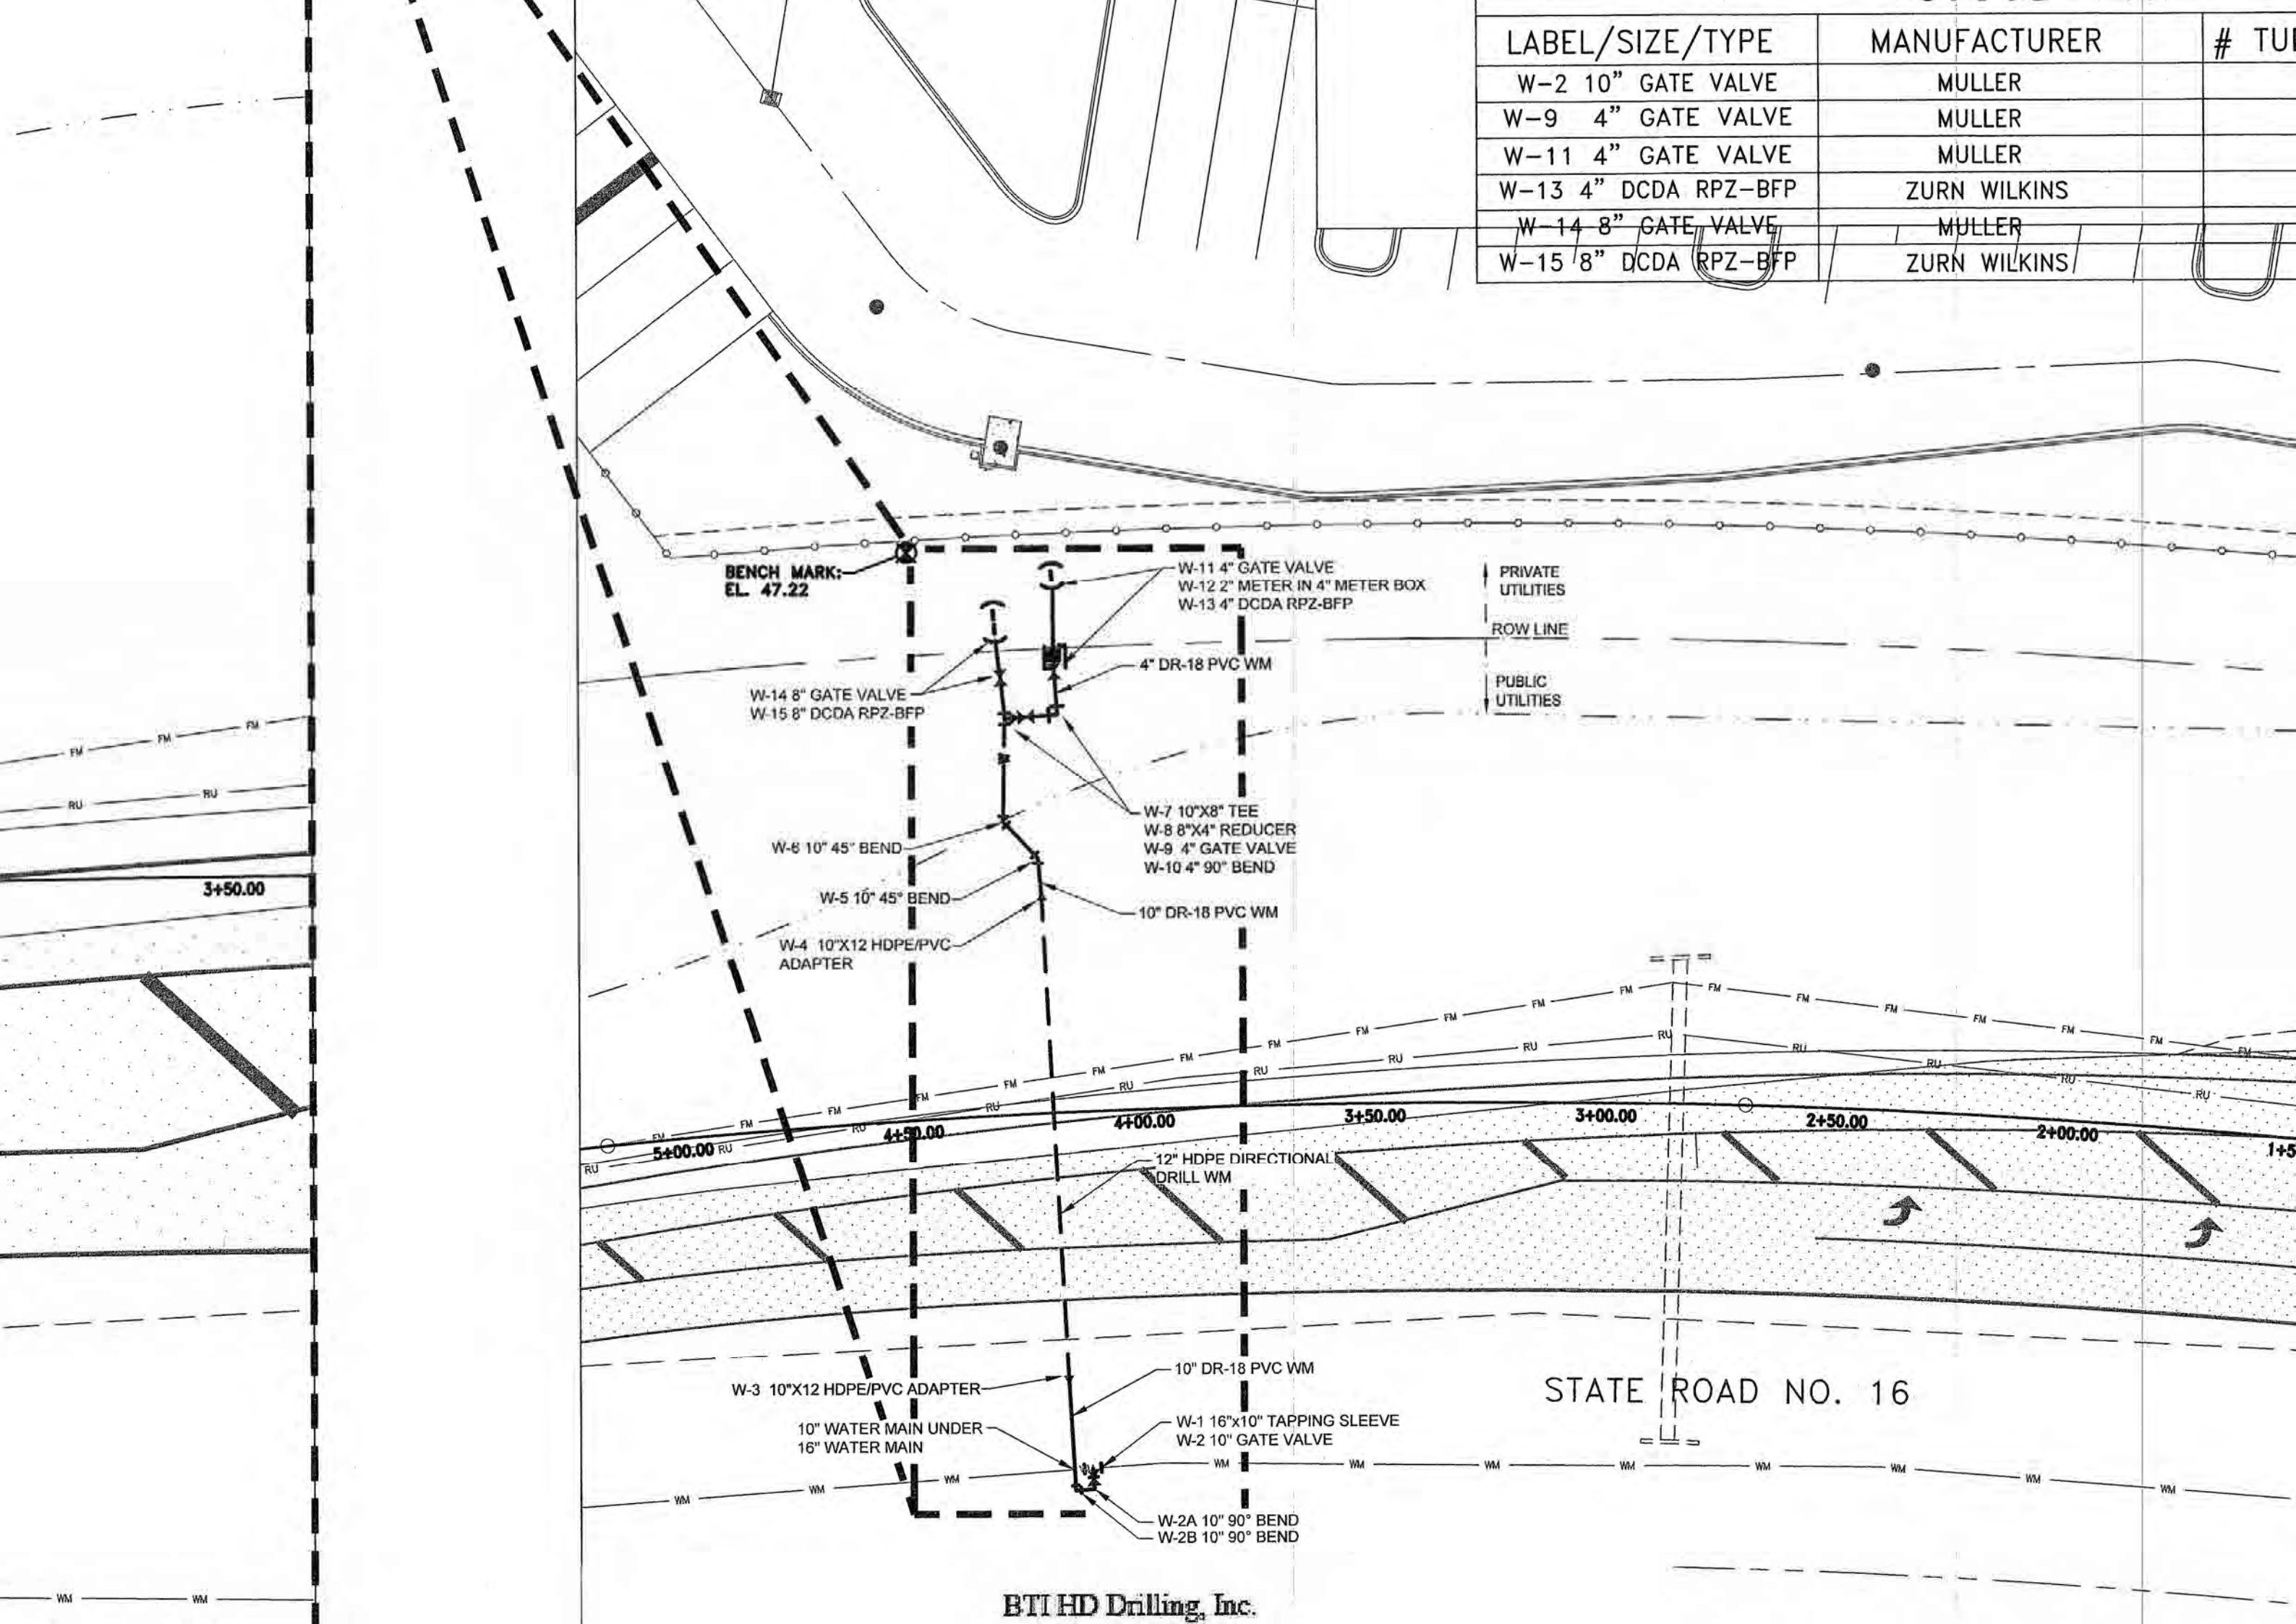

BENCH MARK:
EL. 47.22

W-14 8" GATE VALVE
W-15 8" DCDA RPZ-BFP

W-6 10" 45° BEND

W-5 10" 45° BEND

W-4 10"x12 HDPE/PVC
ADAPTER

W-11 4" GATE VALVE
W-12 2" METER IN 4" METER BOX
W-13 4" DCDA RPZ-BFP

4" DR-18 PVC WM

W-7 10"x8" TEE
W-8 8"x4" REDUCER
W-9 4" GATE VALVE
W-10 4" 90° BEND

10" DR-18 PVC WM

5+00.00

4+50.00

4+00.00

3+50.00

3+00.00

2+50.00

2+00.00

1+50.00

12" HDPE DIRECTIONAL
DRILL WM

W-3 10"x12 HDPE/PVC ADAPTER

10" WATER MAIN UNDER
16" WATER MAIN

10" DR-18 PVC WM


W-1 16"x10" TAPPING SLEEVE
W-2 10" GATE VALVE


W-2A 10" 90° BEND
W-2B 10" 90° BEND

STATE ROAD NO. 16

BTI HD Drilling, Inc.

AS-BUILT LOCATION
STA:=4+30.67
Offset=17.193R
AS-BUILT LOCATION
STA:=4+30.38
Offset=14.218R

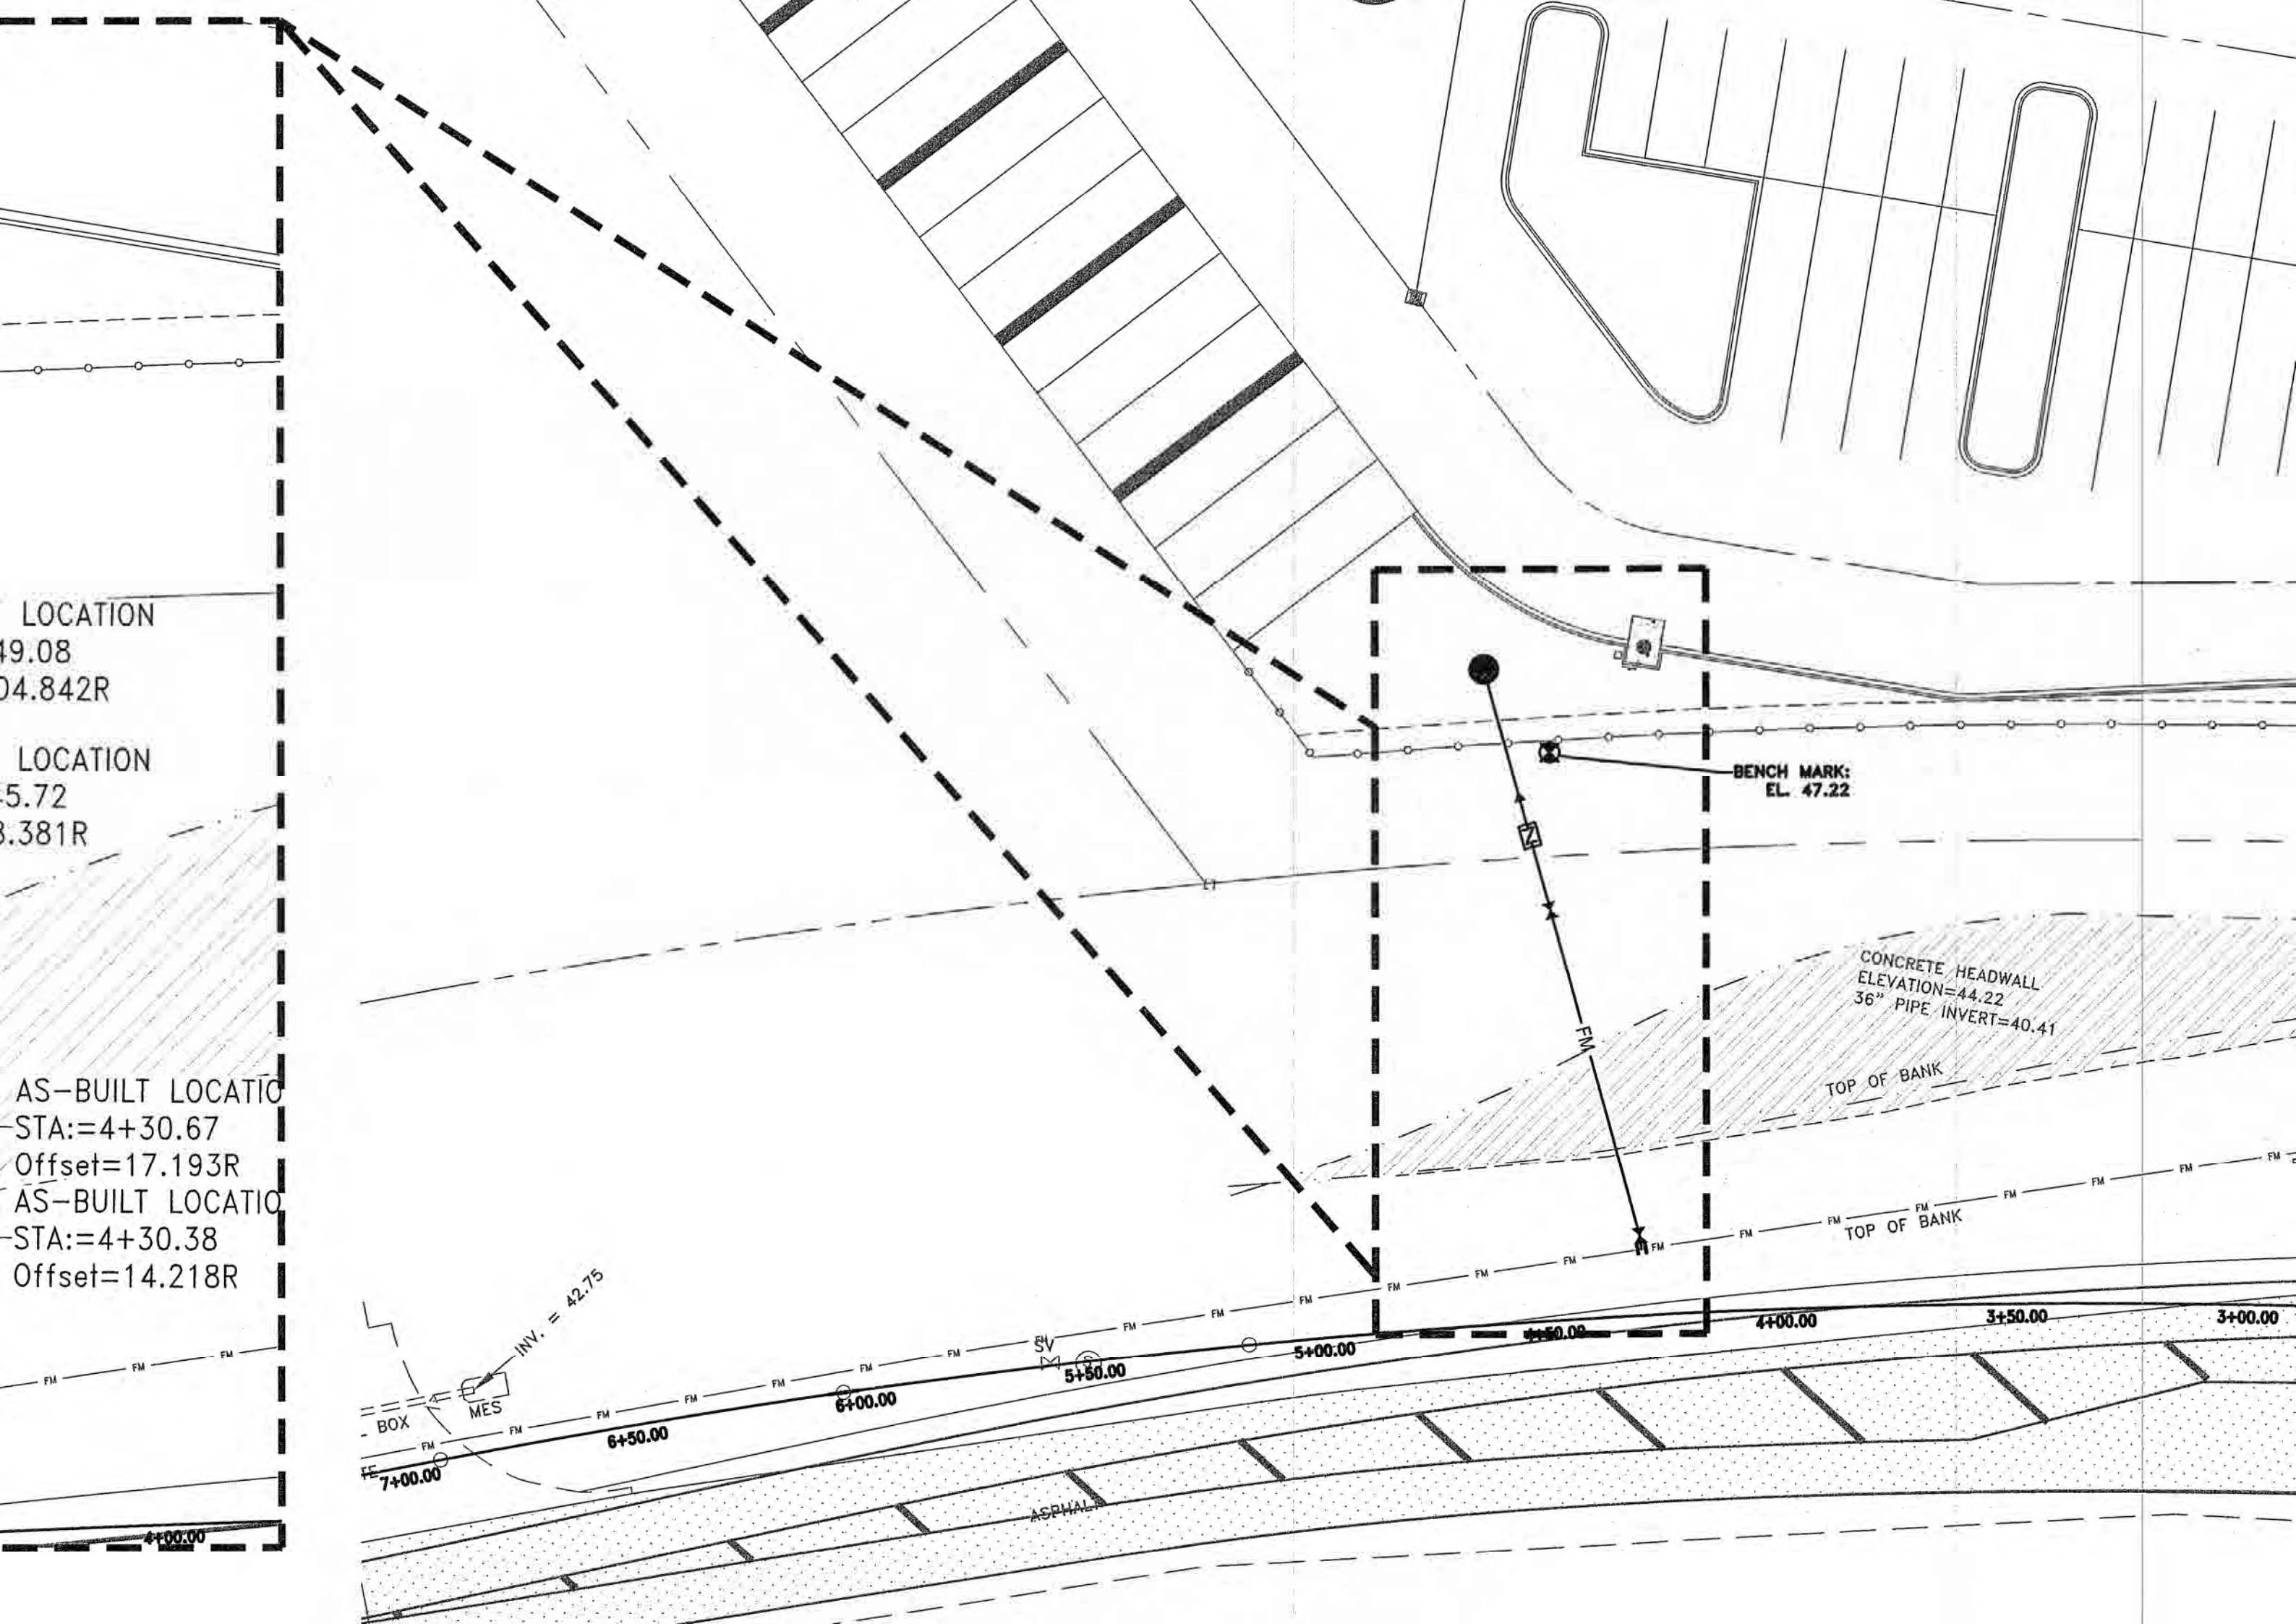

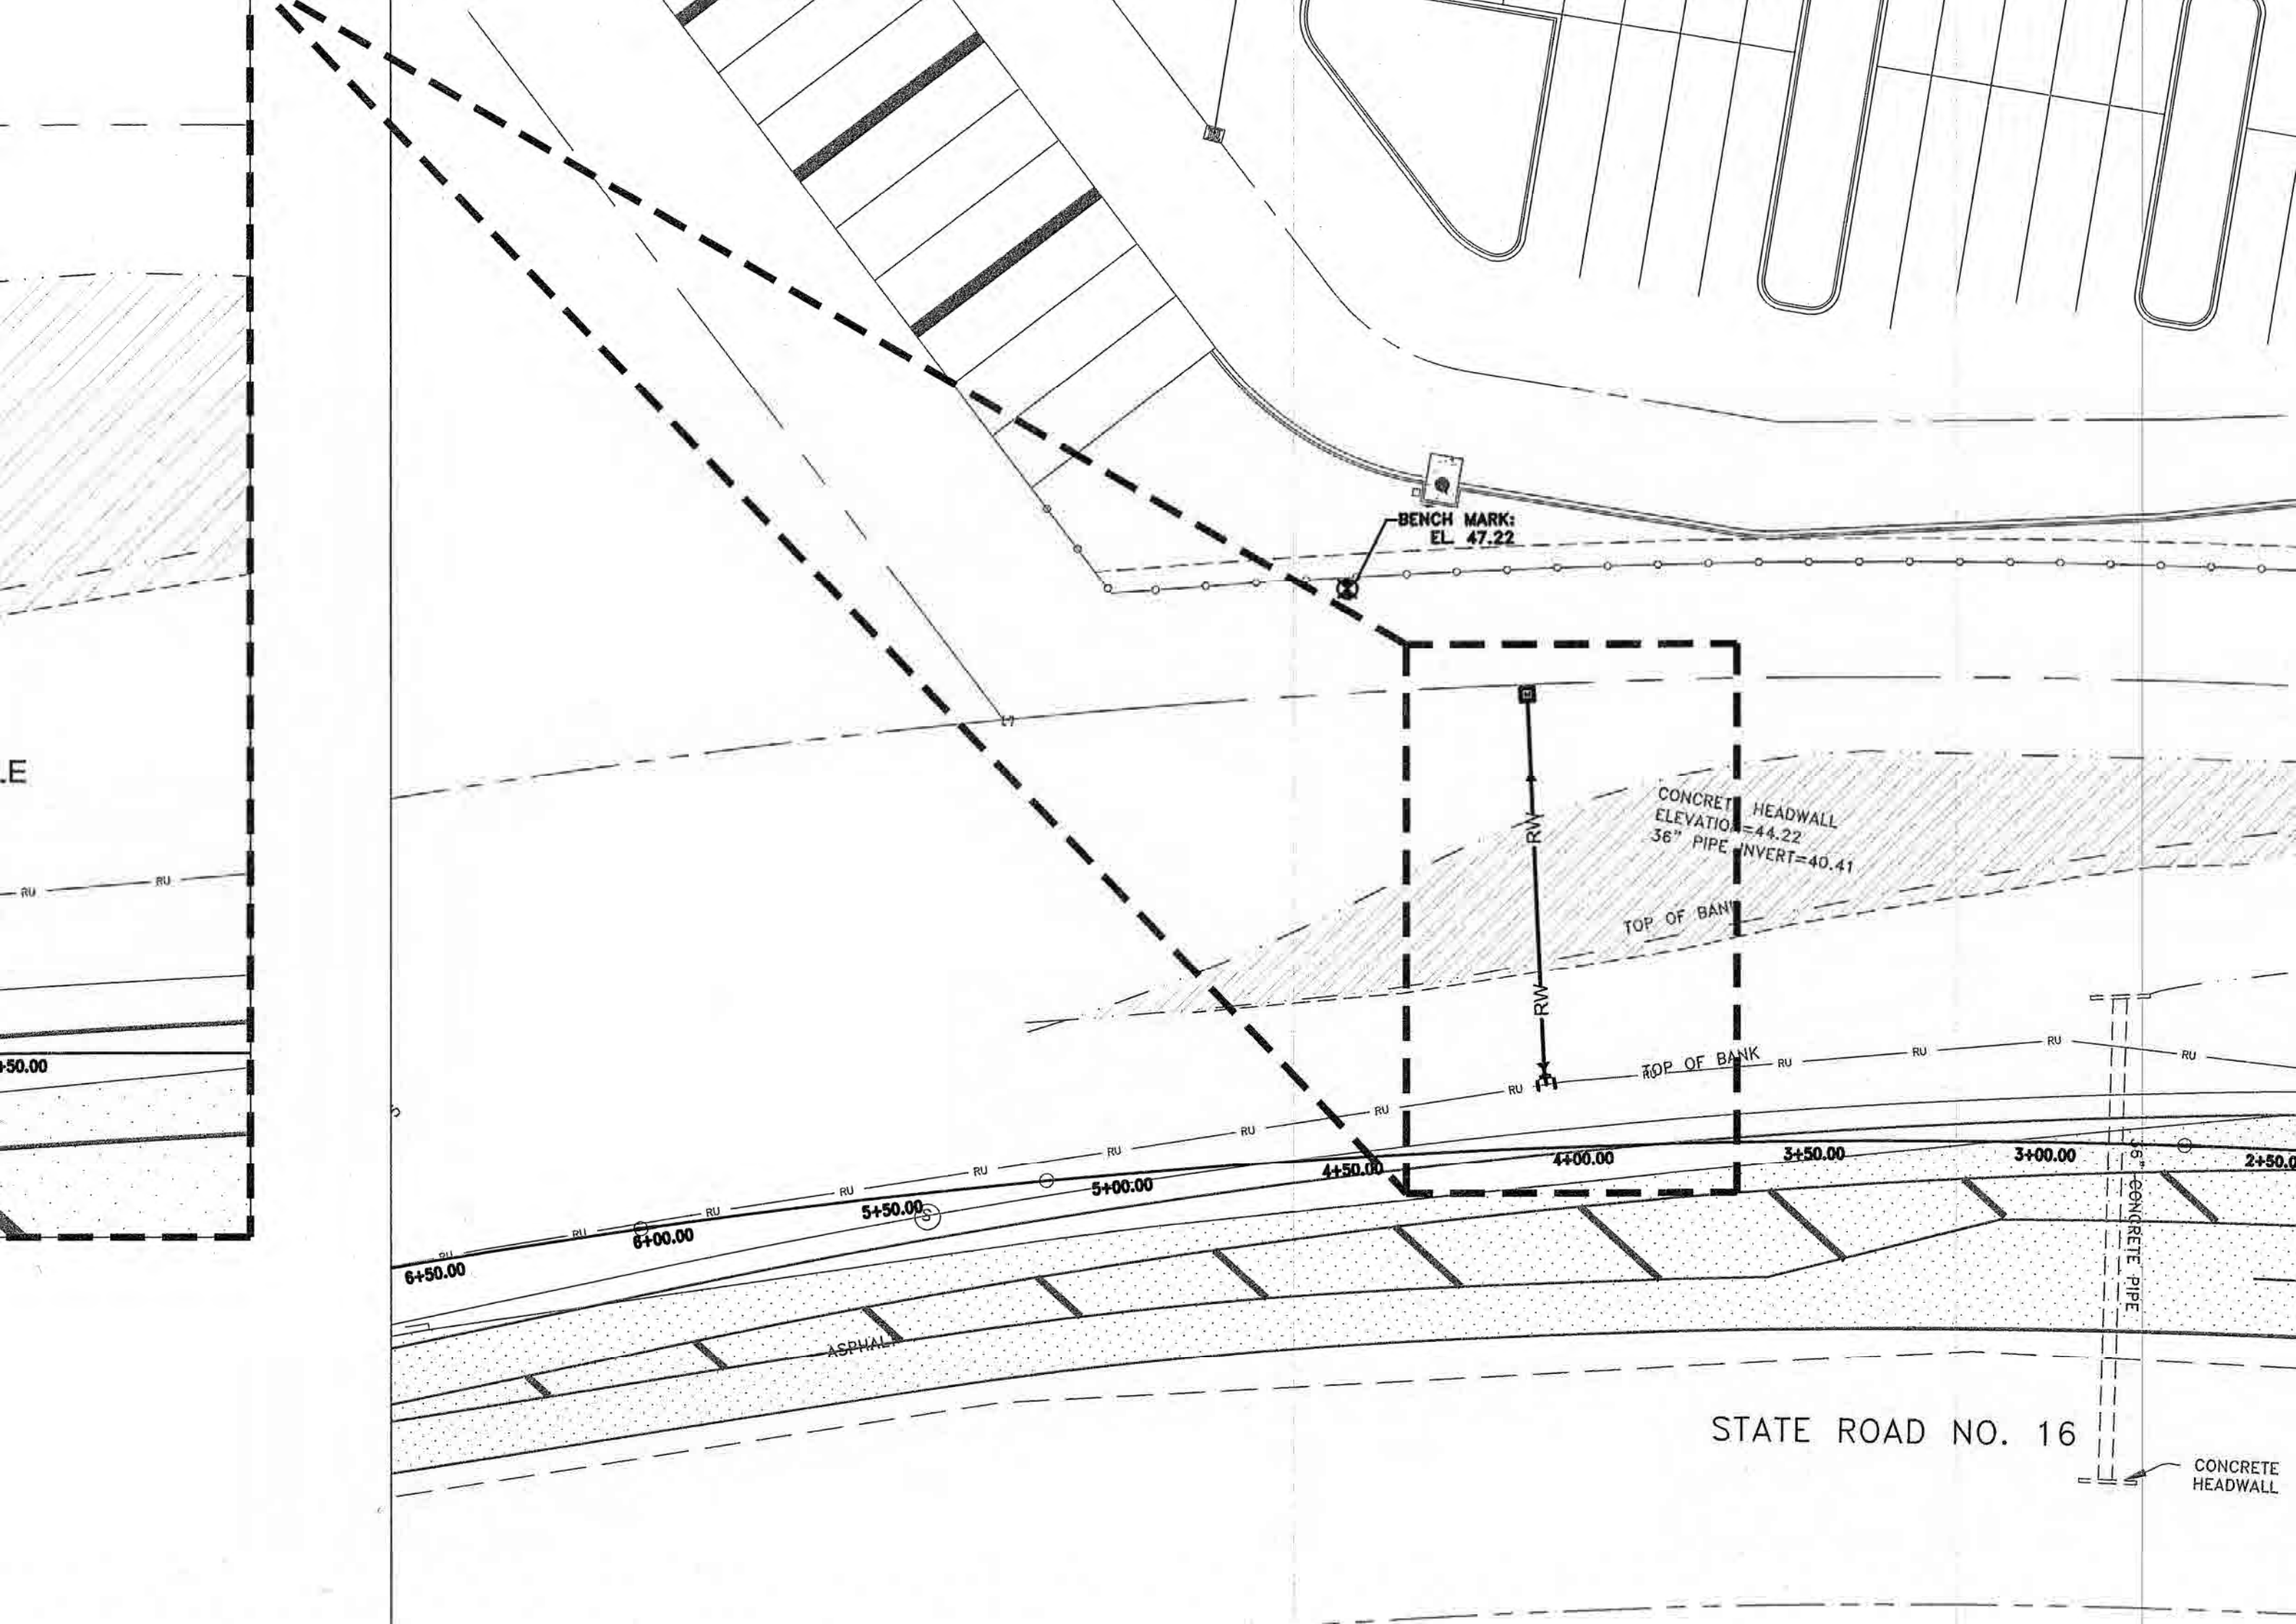

BENCH MARK:
EL. 47.22

CONCRETE HEADWALL
ELEVATION = 44.22
36" PIPE INVERT = 40.41

TOP OF BANK

TOP OF BANK

CONCRETE PIPE

CONCRETE HEADWALL

STATE ROAD NO. 16

ASPHAL

E

50.00

6+50.00

6+00.00

5+50.00

5+00.00

4+50.00

4+00.00

3+50.00

3+00.00

2+50.00

6" 90° BEND
EL. 42.66
6" GATE VALVE
EL. 42.82
PRIVATE 6" FIRE HYDRANT

6.28' AB
7.65' AB
9.28' AB

7.49' AB
9.75' AB
11.50' AB

6" 90° BEND
EL. 42.66
6" GATE VALVE
EL. 42.82
PRIVATE 6" FIRE HYDRANT

7.30' AB
13.73' AB

11.11' AB

6" DR-18 PVC FIRE MAIN
FIRE

6" 45° BEND
EL. 42.79

38.84' AB
29.86' AB
24.02' AB
20.38' AB
13.82' AB
18.69' AB
24.16' AB
32.31' AB
25.43' AB
18.46' AB

13.82' AB

6" DR-18 PVC FIRE MAIN
FIRE

8"X6" TEE
EL. 42.00
8" GATE VALVE
42.89

8" x 8" TEE
EL. 41.77
6" GATE VALVE
EL. 42.64
PRIVATE 6" FIRE HYDRANT


8" DR-18 PVC FIRE
FIRE


8" 11.25° BEND
EL. 41.67

8" 90° BEND
EL. 42.70
8"X6" REDUCER
EL. 42.88

3.55' AB
5.97' AB

14.23' AB
14.52' AB

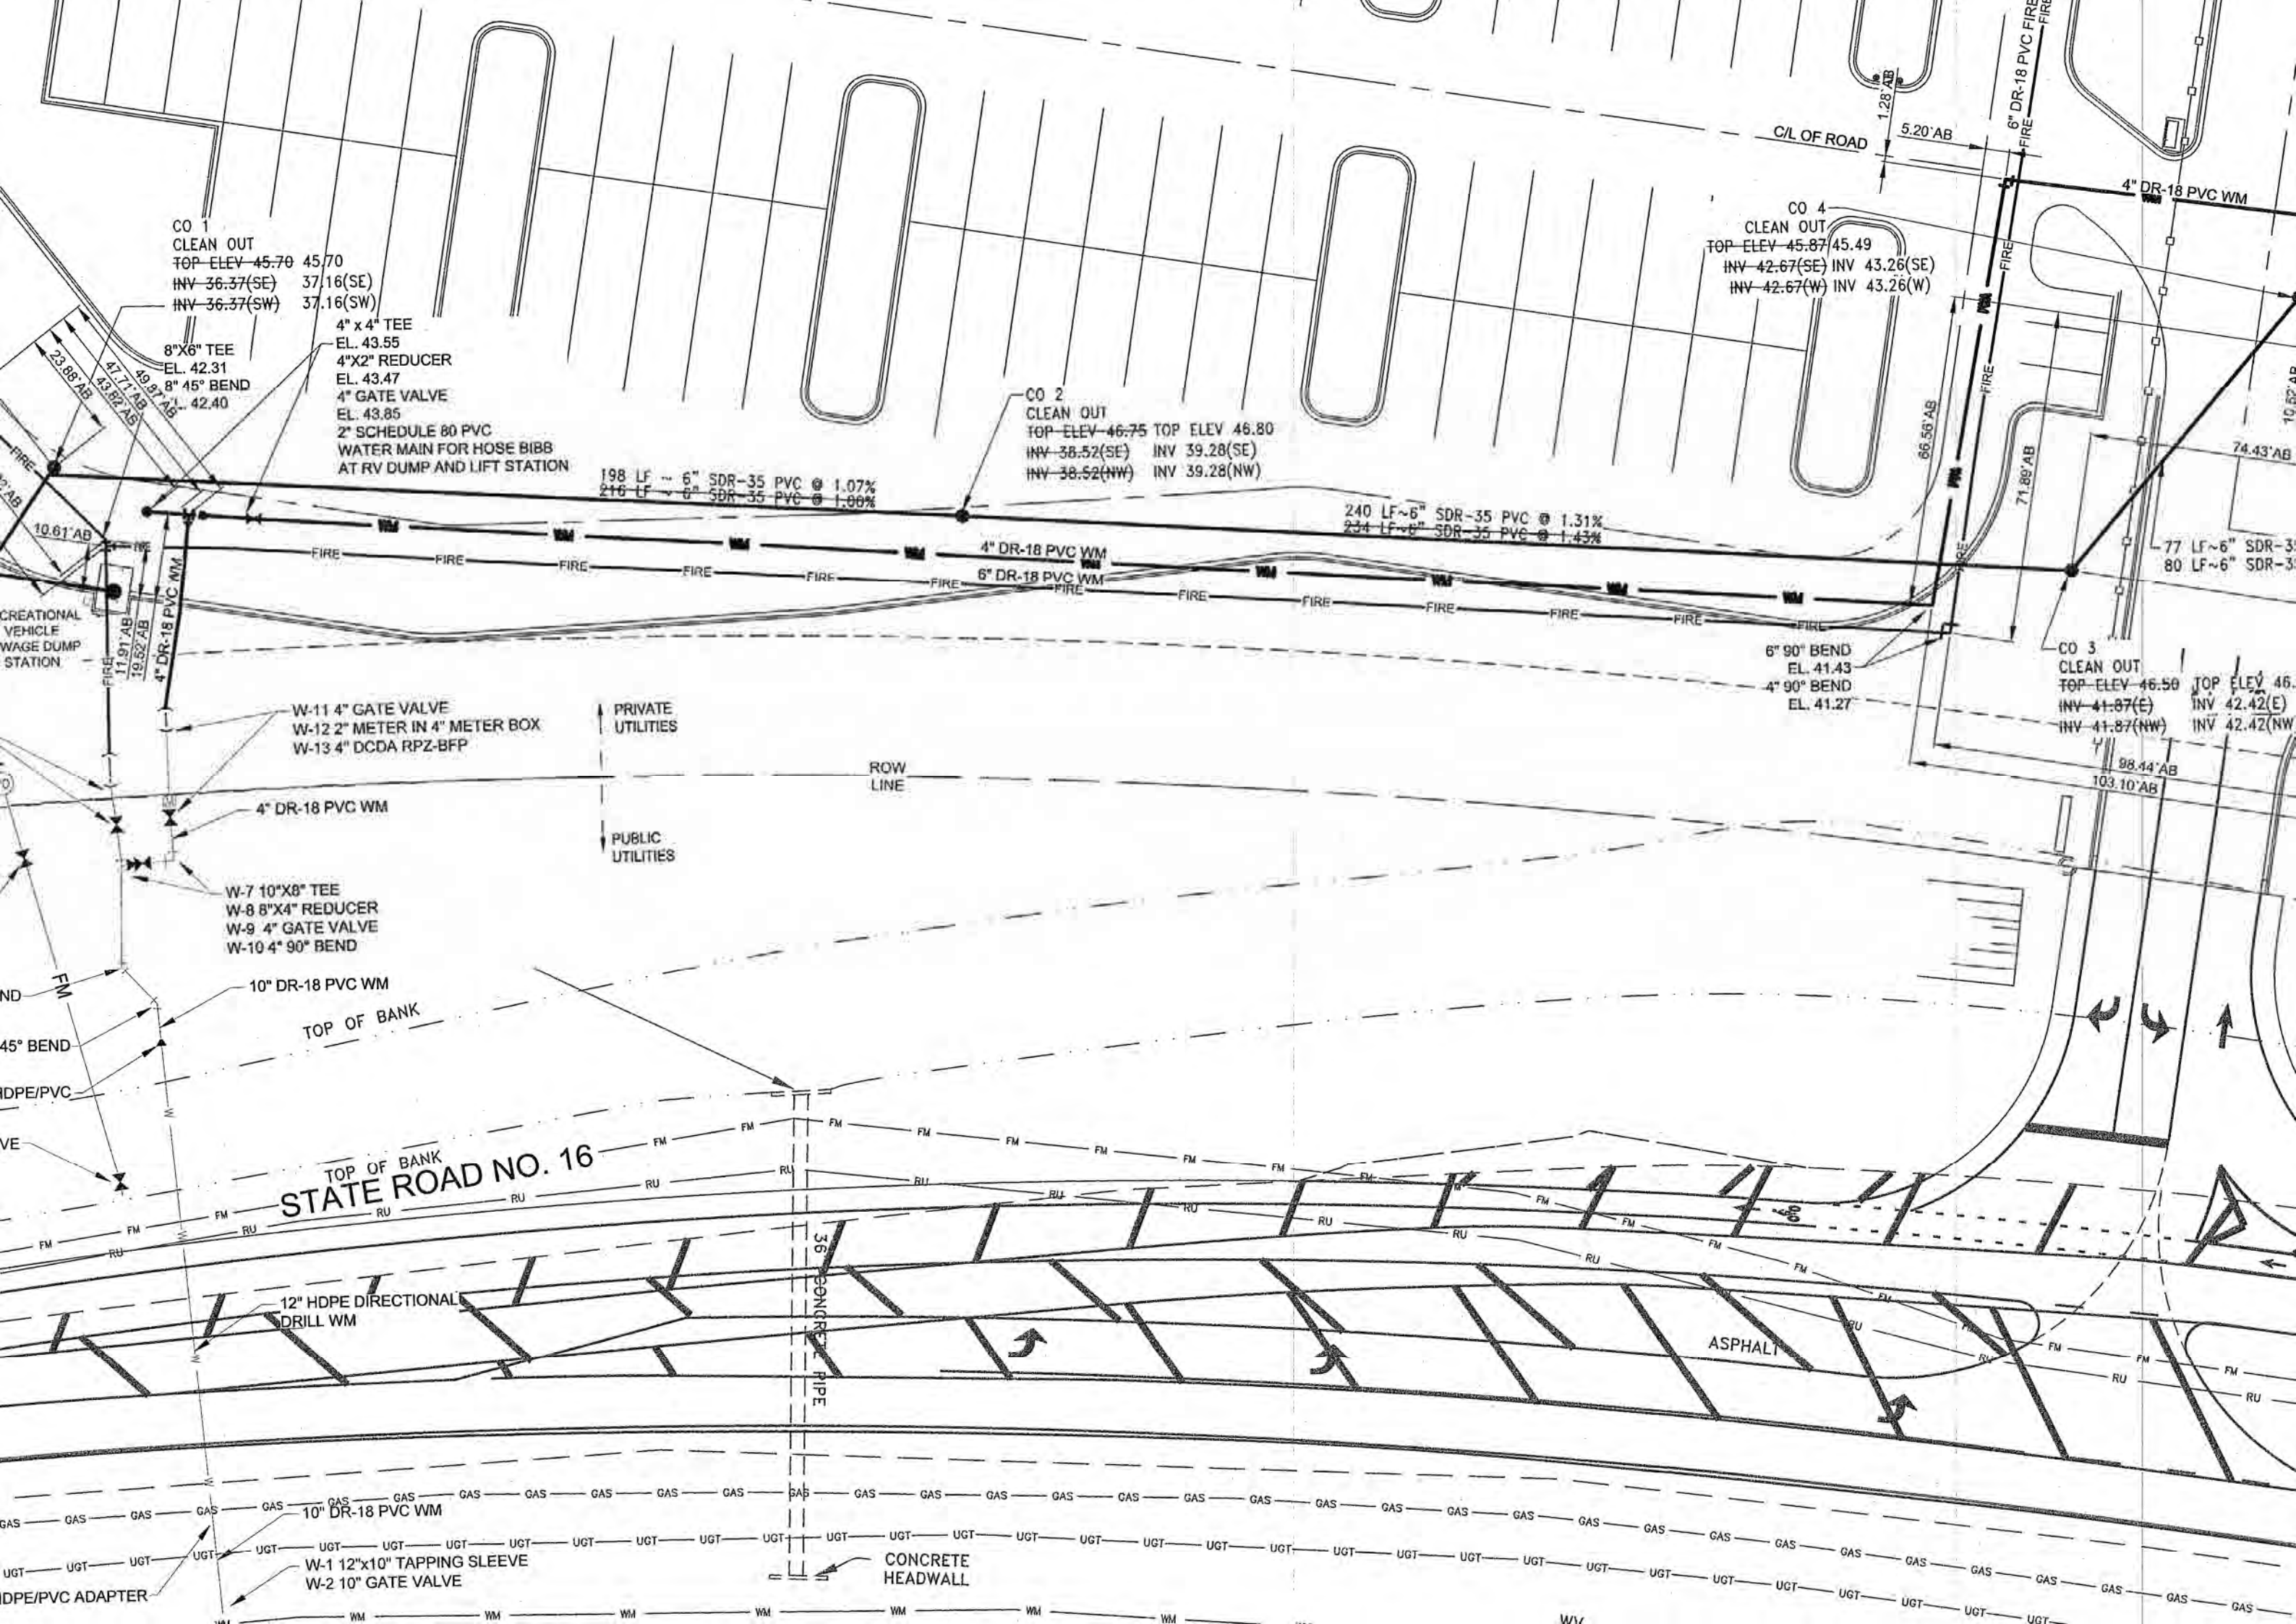


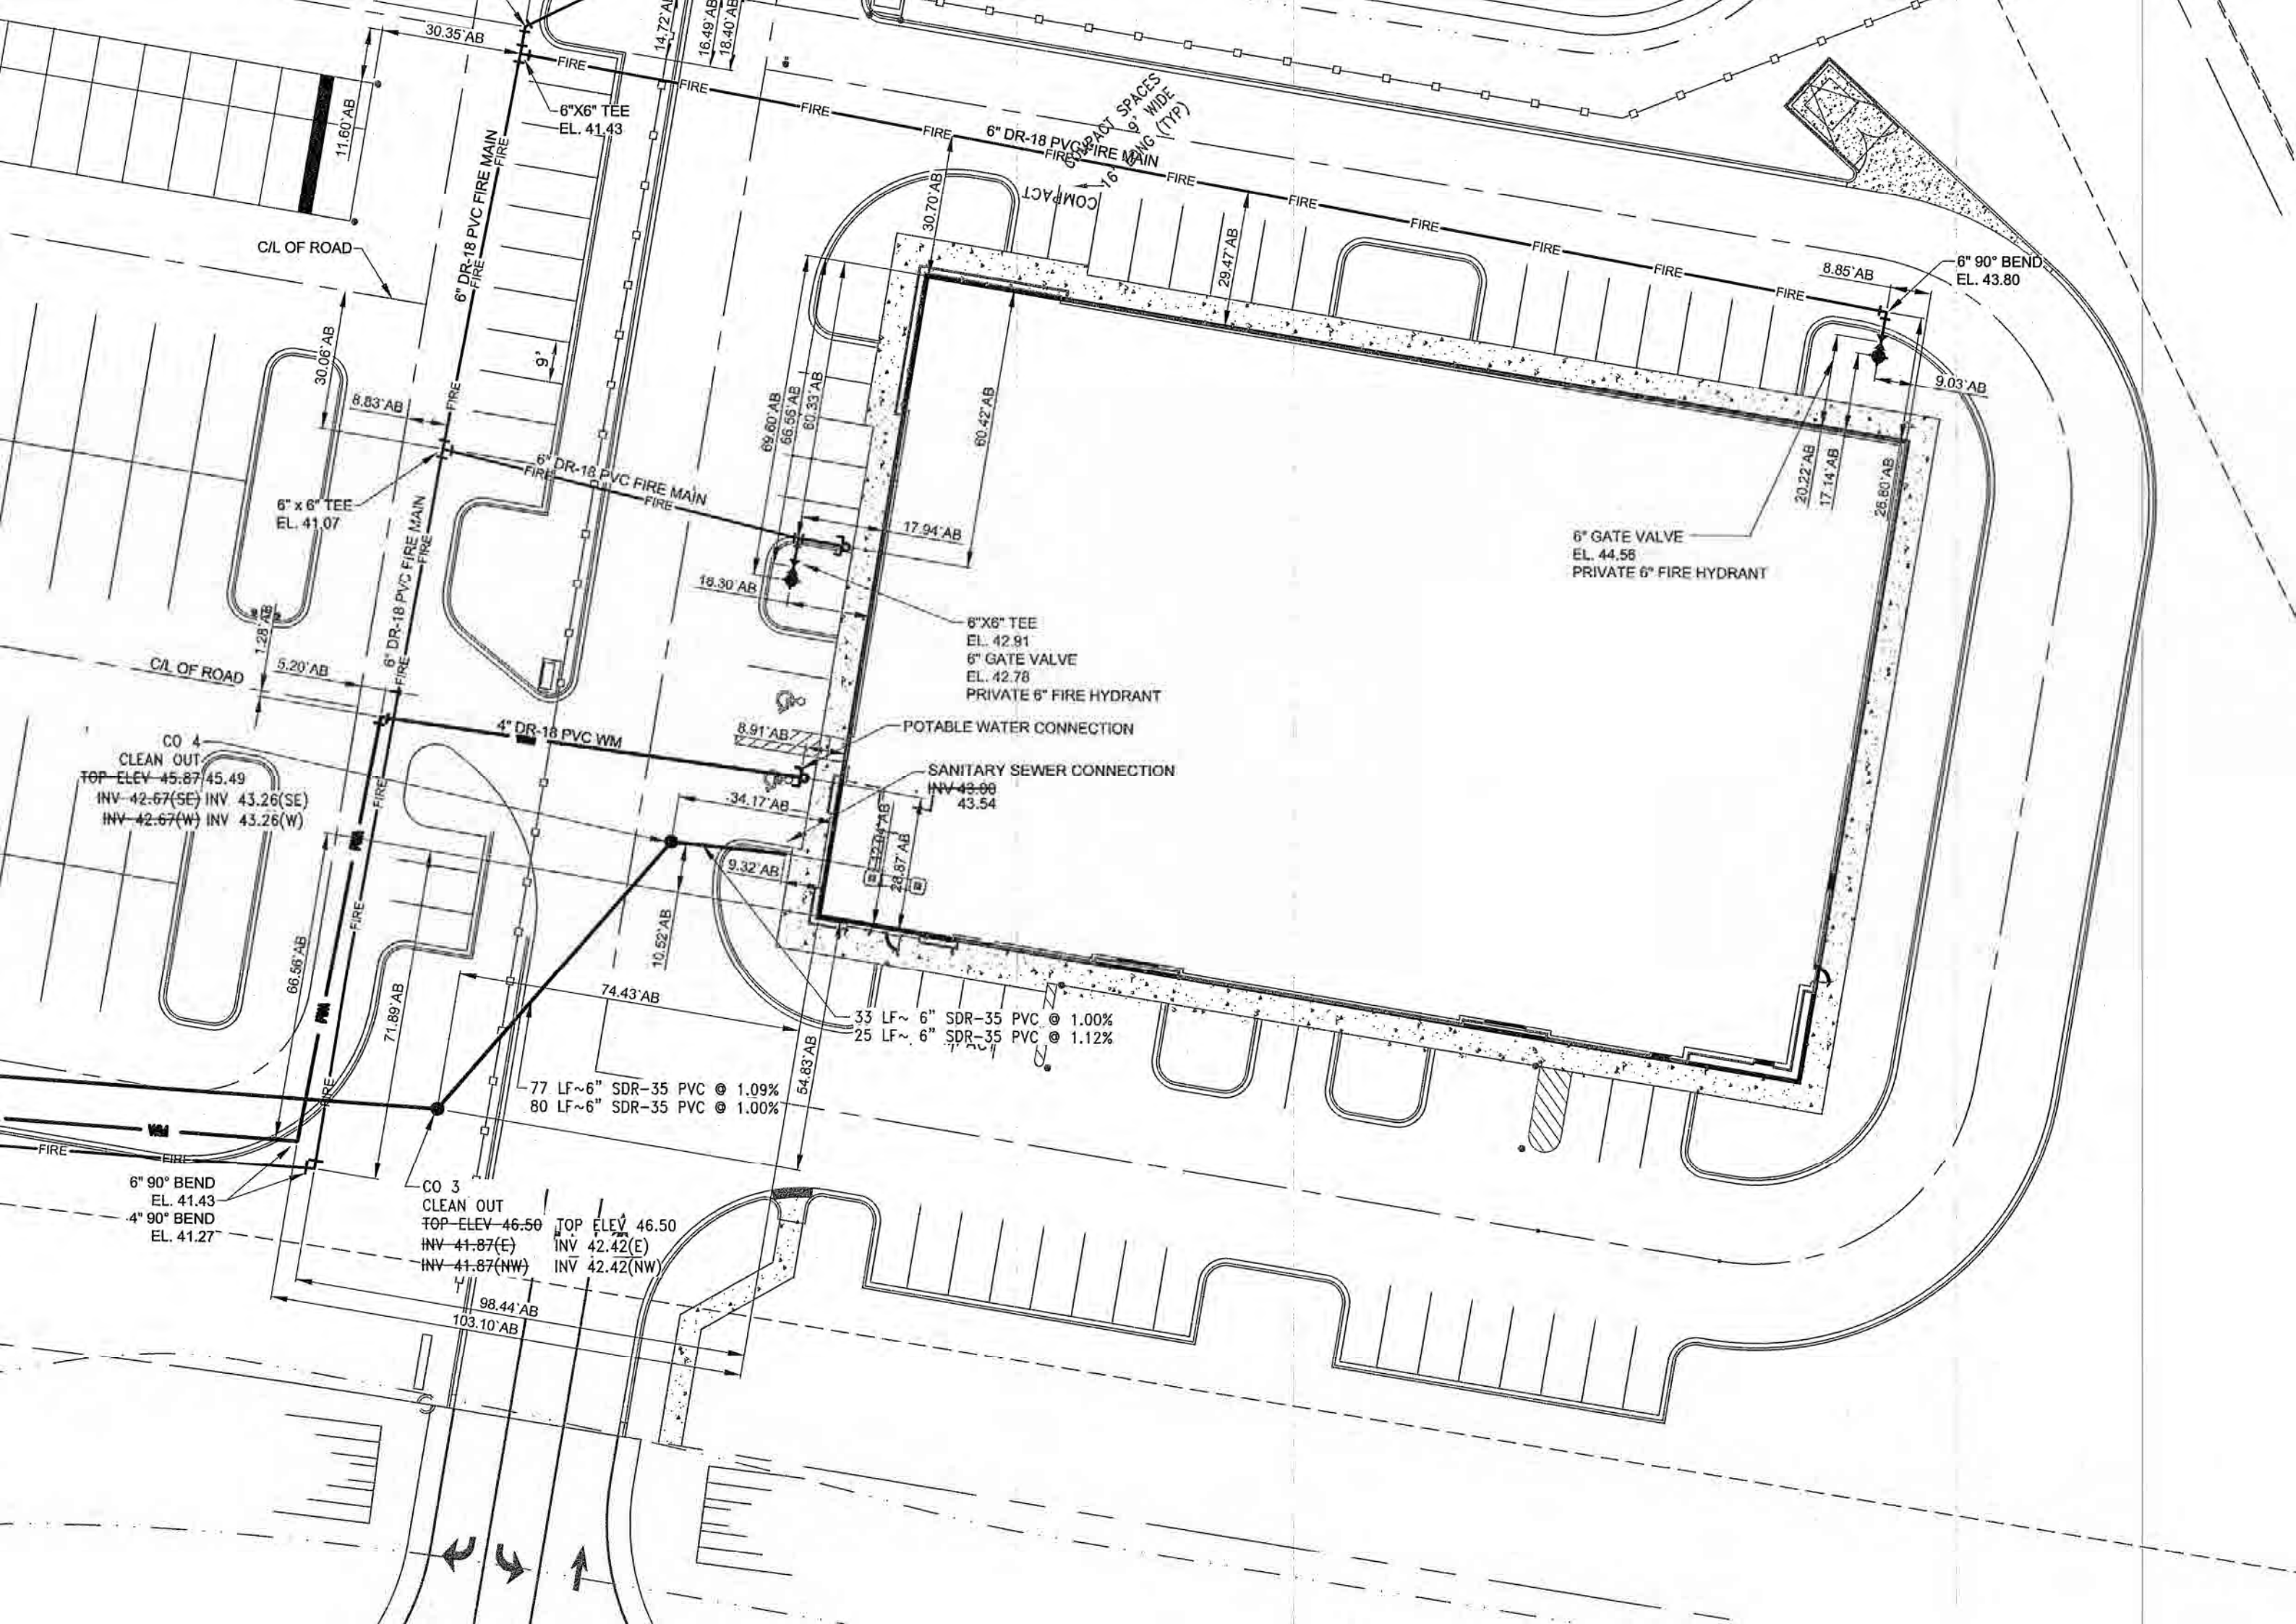

2018 NW Tomoka Pines As Built Drawings



ST. JOHNS COUNTY, FLORIDA

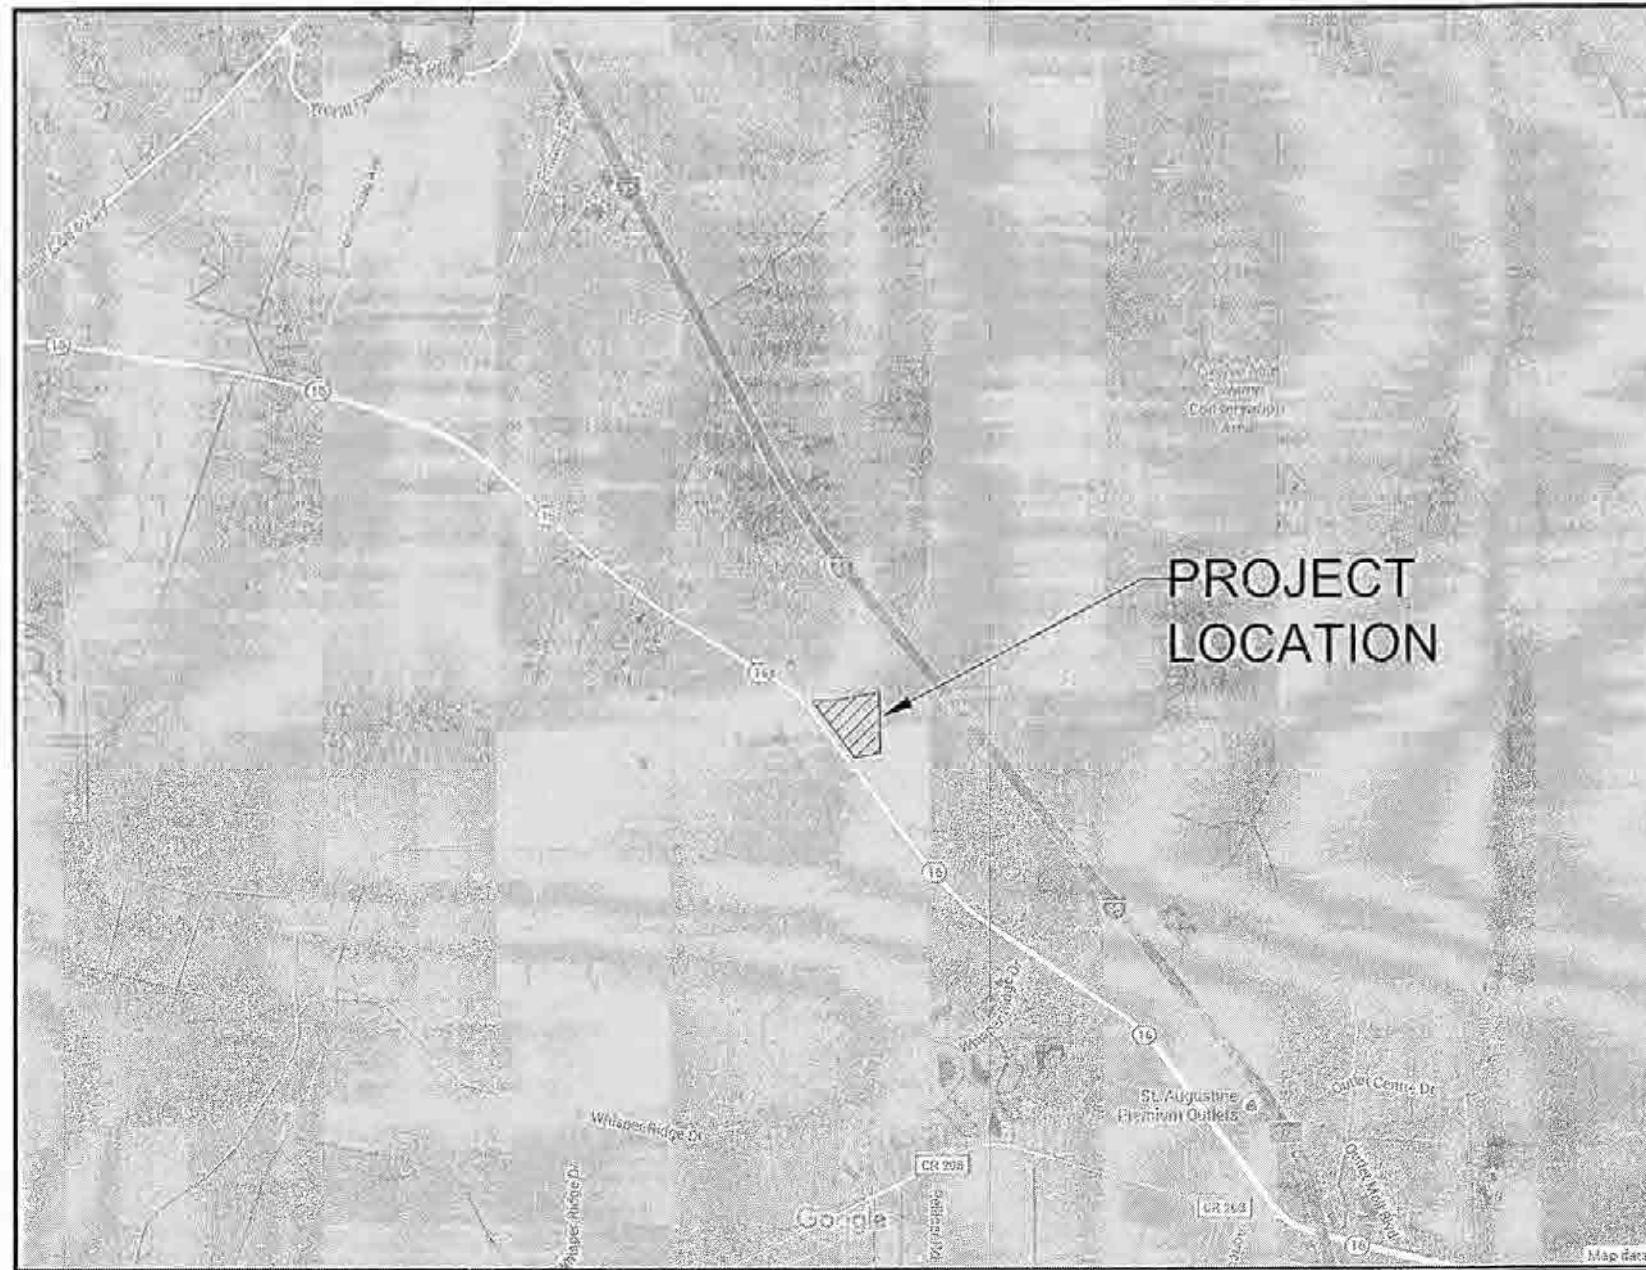

LOCATION MAP

N.T.S.

TANTS

RE BLVD.
A 32256

G GROUP, INC.
, SUITE 204
A 32216

(904) 854-4505

PING, LLC

(904) 777-8271

ITY DEPARTMENT


A 32085

12" STABILIZED SUBGRADE
LBR 40/98% MAXIMUM DENSITY
ROAD NO. 16

LBR 40/95% MAXIMUM DENSITY
98% MINIMUM DENSITY AASHTO T-180
(MODIFIED PROCTOR)

SECTION B-B TOMOKA PINES DRIVE

N.T.S

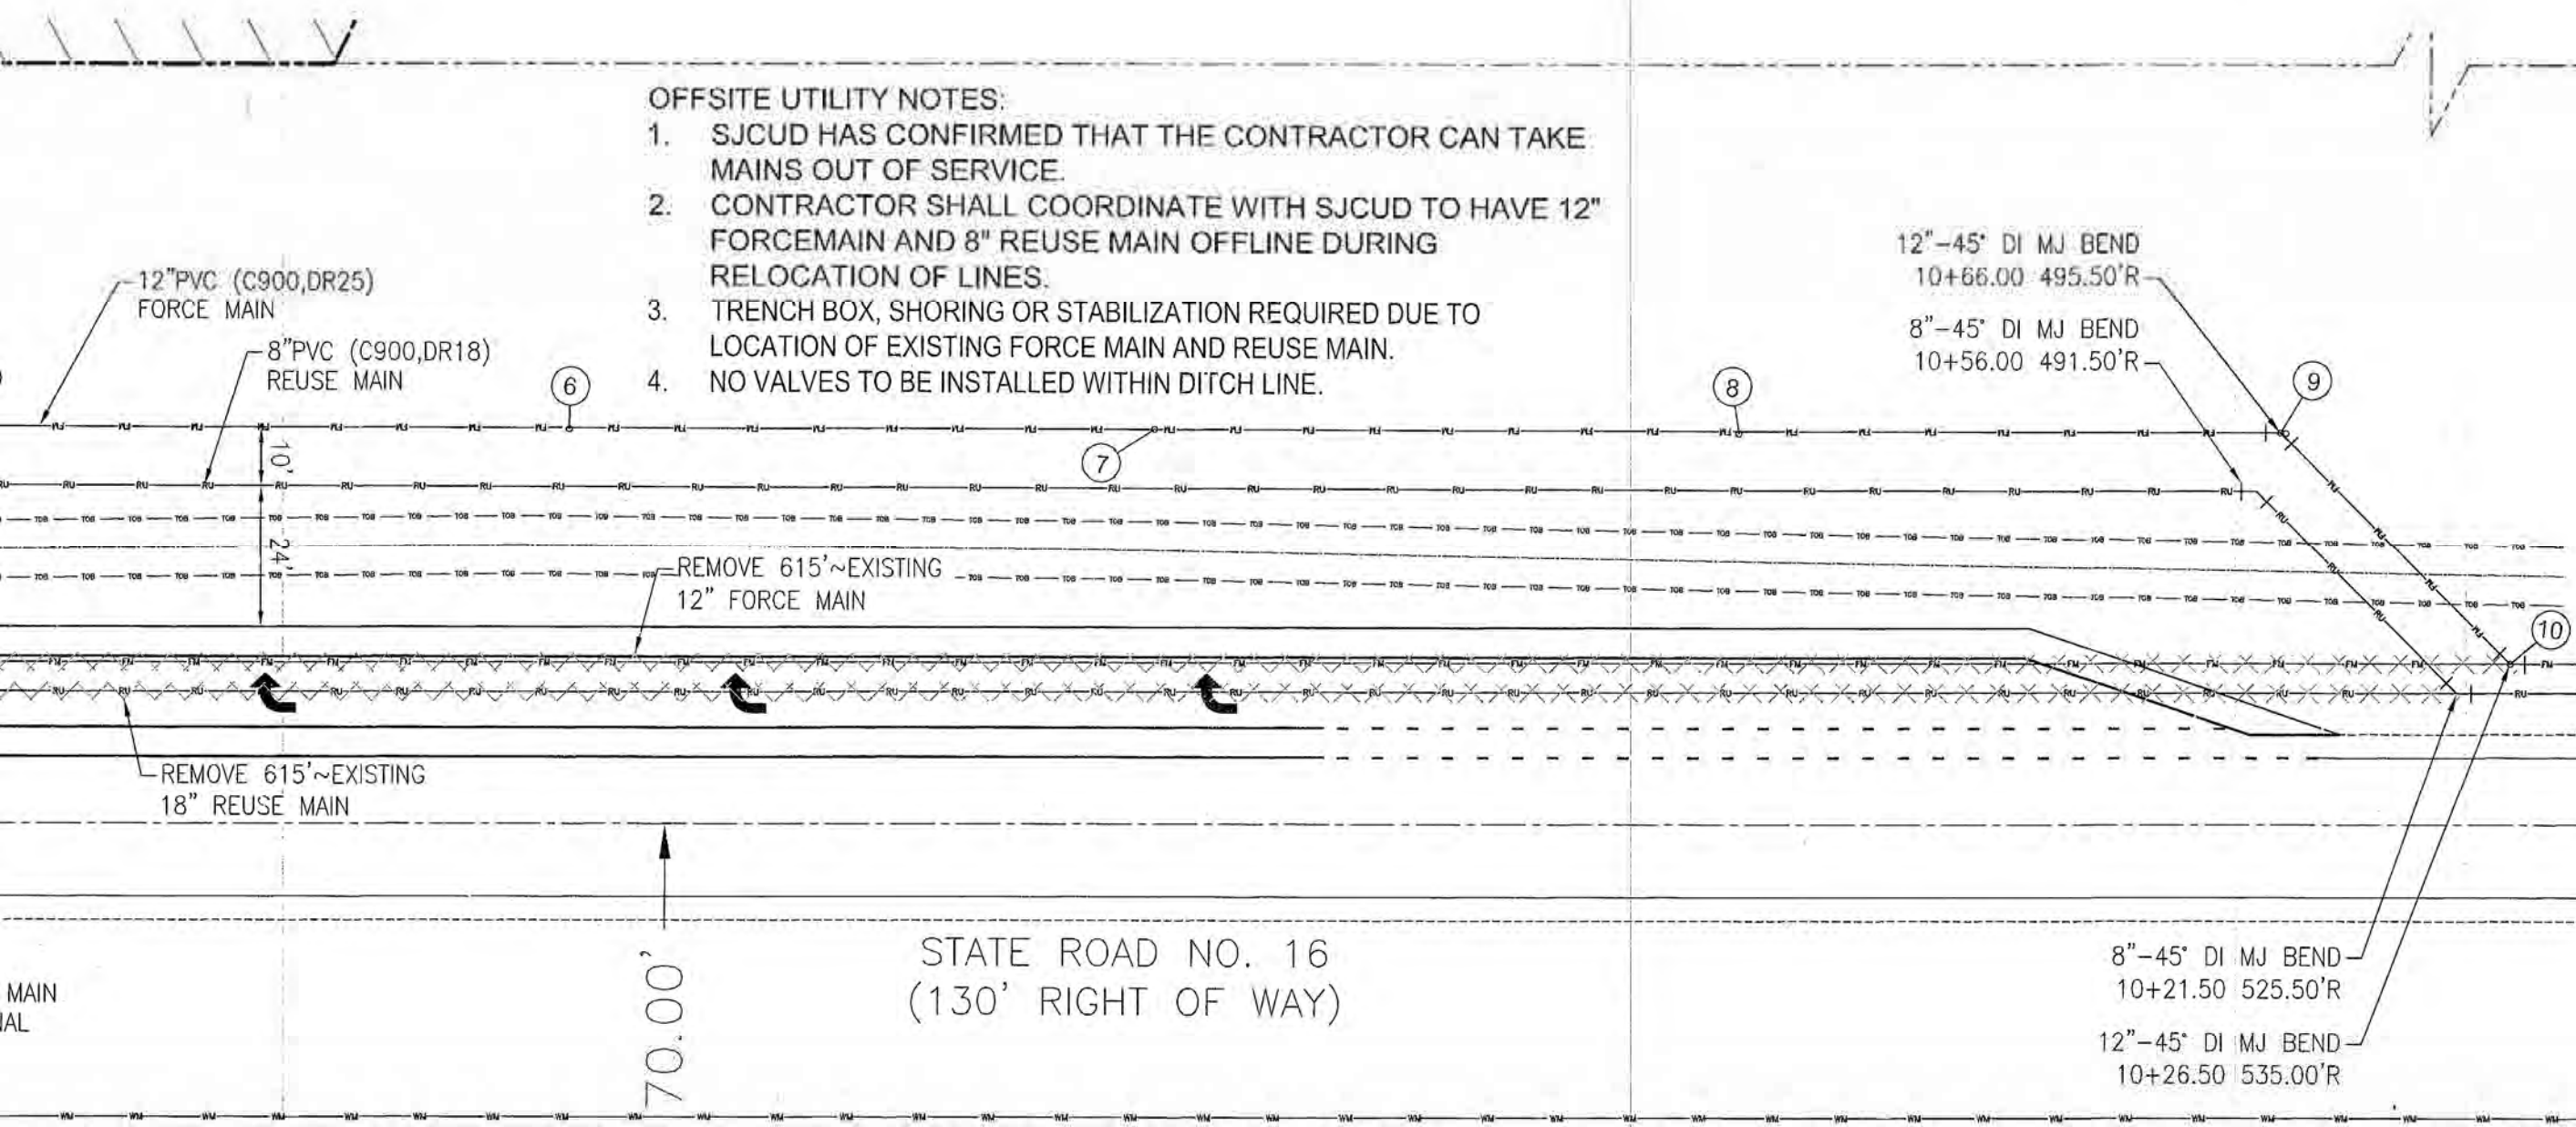

OFFSITE UTILITY NOTES:

1. SJCUD HAS CONFIRMED THAT THE CONTRACTOR CAN TAKE MAINS OUT OF SERVICE.
2. CONTRACTOR SHALL COORDINATE WITH SJCUD TO HAVE 12" FORCEMAIN AND 8" REUSE MAIN OFFLINE DURING RELOCATION OF LINES.
3. TRENCH BOX, SHORING OR STABILIZATION REQUIRED DUE TO LOCATION OF EXISTING FORCE MAIN AND REUSE MAIN.
4. NO VALVES TO BE INSTALLED WITHIN DITCH LINE.


12"-45° DI MJ BEND
10+66.00 495.50'R

8"-45° DI MJ BEND
10+56.00 491.50'R


8"-45° DI MJ BEND
10+21.50 525.50'R

12"-45° DI MJ BEND
10+26.50 535.00'R

- FDOT F
- FDOT F
- (S
- TR
- DE
- 6. ALL TR
- 7. REMOV
- PROCE
- FDOT S
- 8. ALL DI
- 9. ALIGNM
- MARKIN
- 10. ALL CU
- 11. ALL BR
- 12. ALL DIS
- CONDIT
- STRIPS
- 13. BURNIN
- 14. ALL LA
- CATAST
- 15. RPM'S
- 16. CONTRA
- 17. LANE C
- 10:00 A

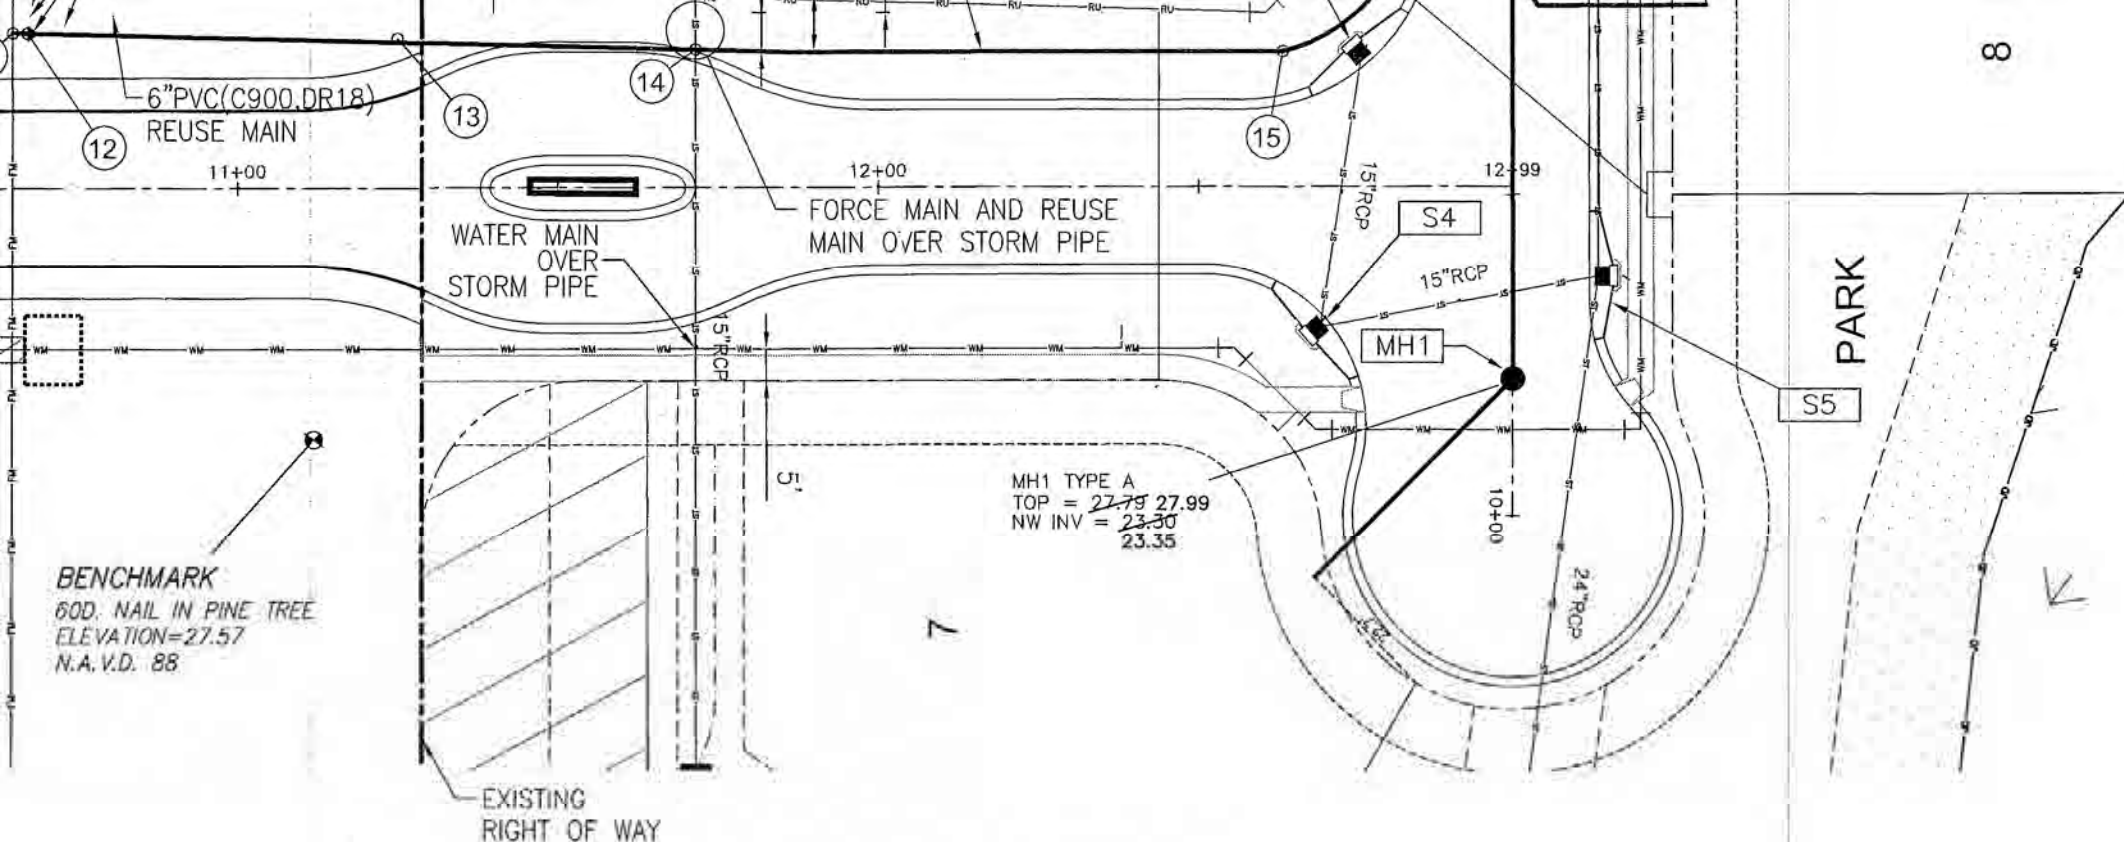

TOMOKA PINES DRIVE

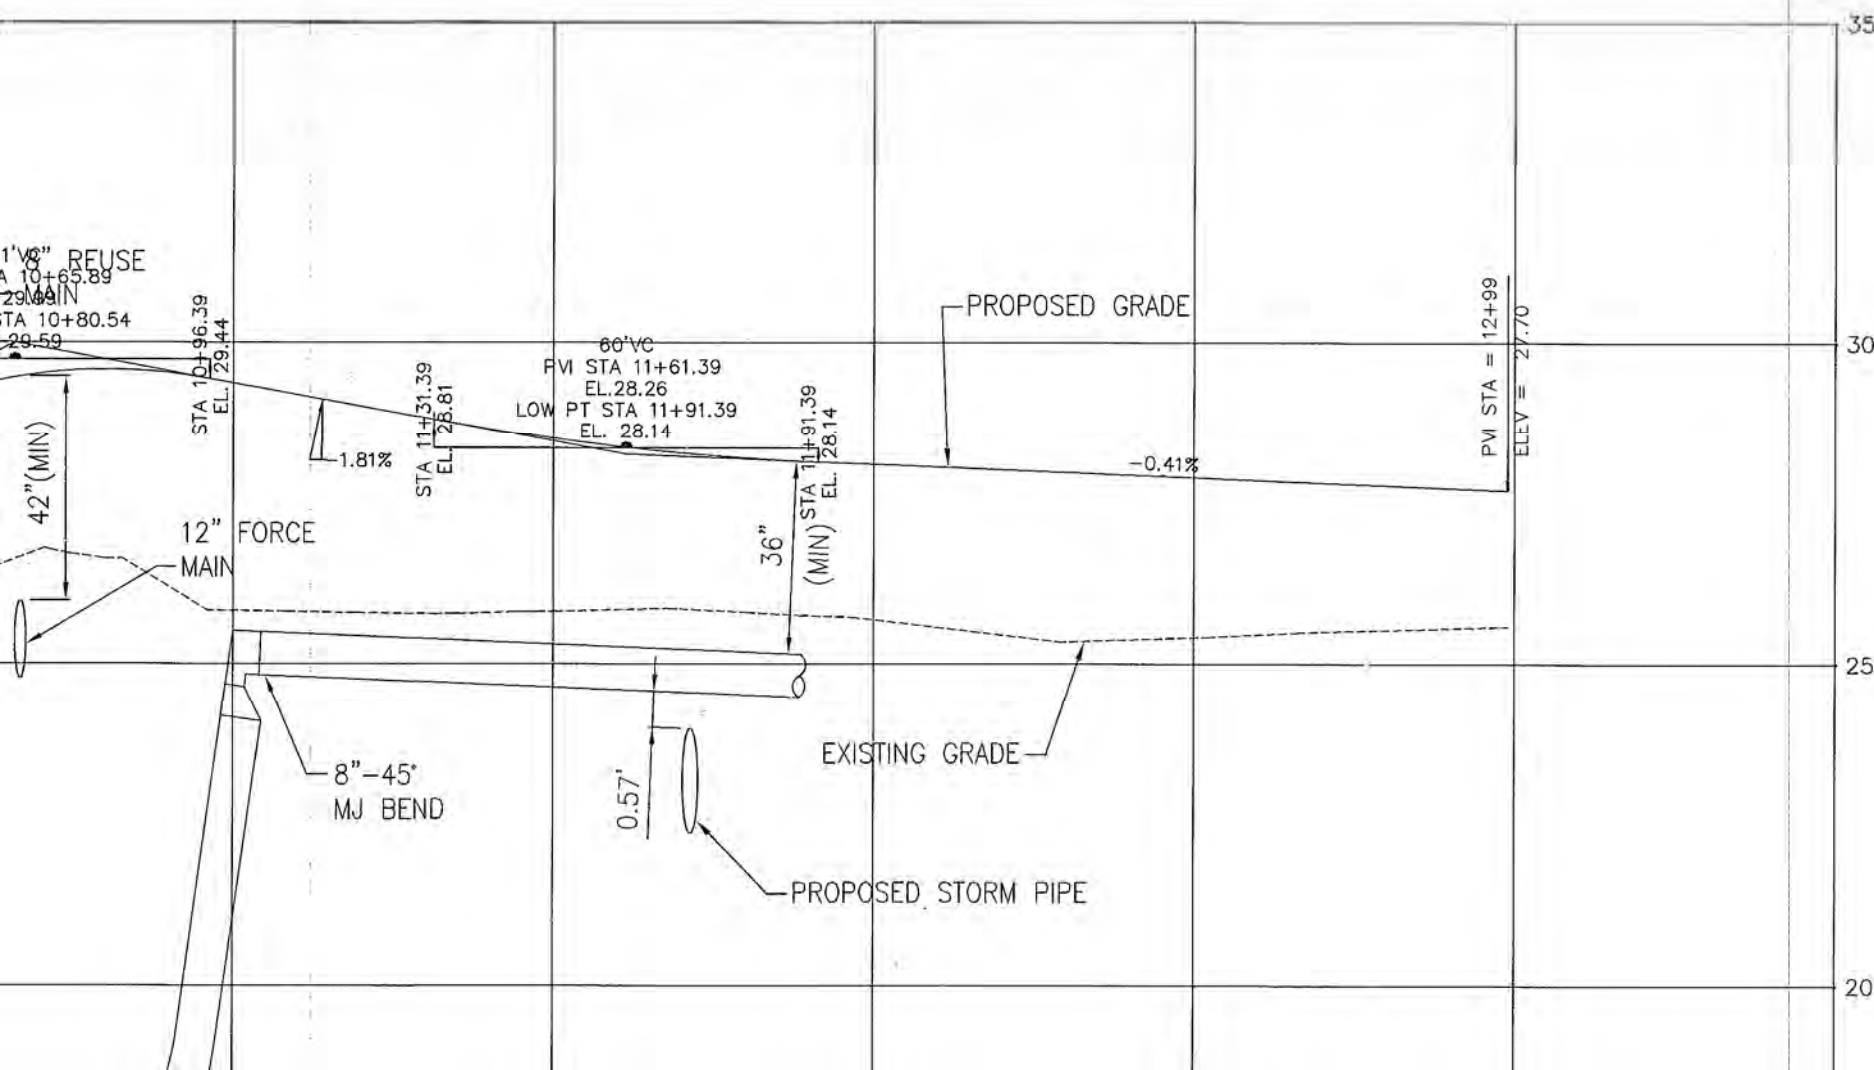

AS-BUILT


INFORMATION PROVIDED BY:

DATE: November 2017-February 2018
NAME: Burnham Construction, Inc.
ADDRESS: 11413 Enterprise East Blvd.
Macclesney, Florida 32063
PHONE NO: (904) 256-5360

I HEREBY CERTIFY THAT THE MATERIALS AND QUANTITIES USED IN THE CONSTRUCTION OF:



— Pavement	— Chilled Water
— Curb + Gutter	— Water Main
— Storm + Drainage System	— Reclaimed Water Main
— Lake or Pond	— X Force Main
— Underdrain Connections	— X Sanitary Gravity System
	— Lift Station

ARE IN ACCORDANCE WITH THE APPROVED PLANS AND JEA STANDARDS AND COUNTY SPECIFICATIONS, UNLESS OTHERWISE APPROVED BY THE REGULATORY AGENCY.

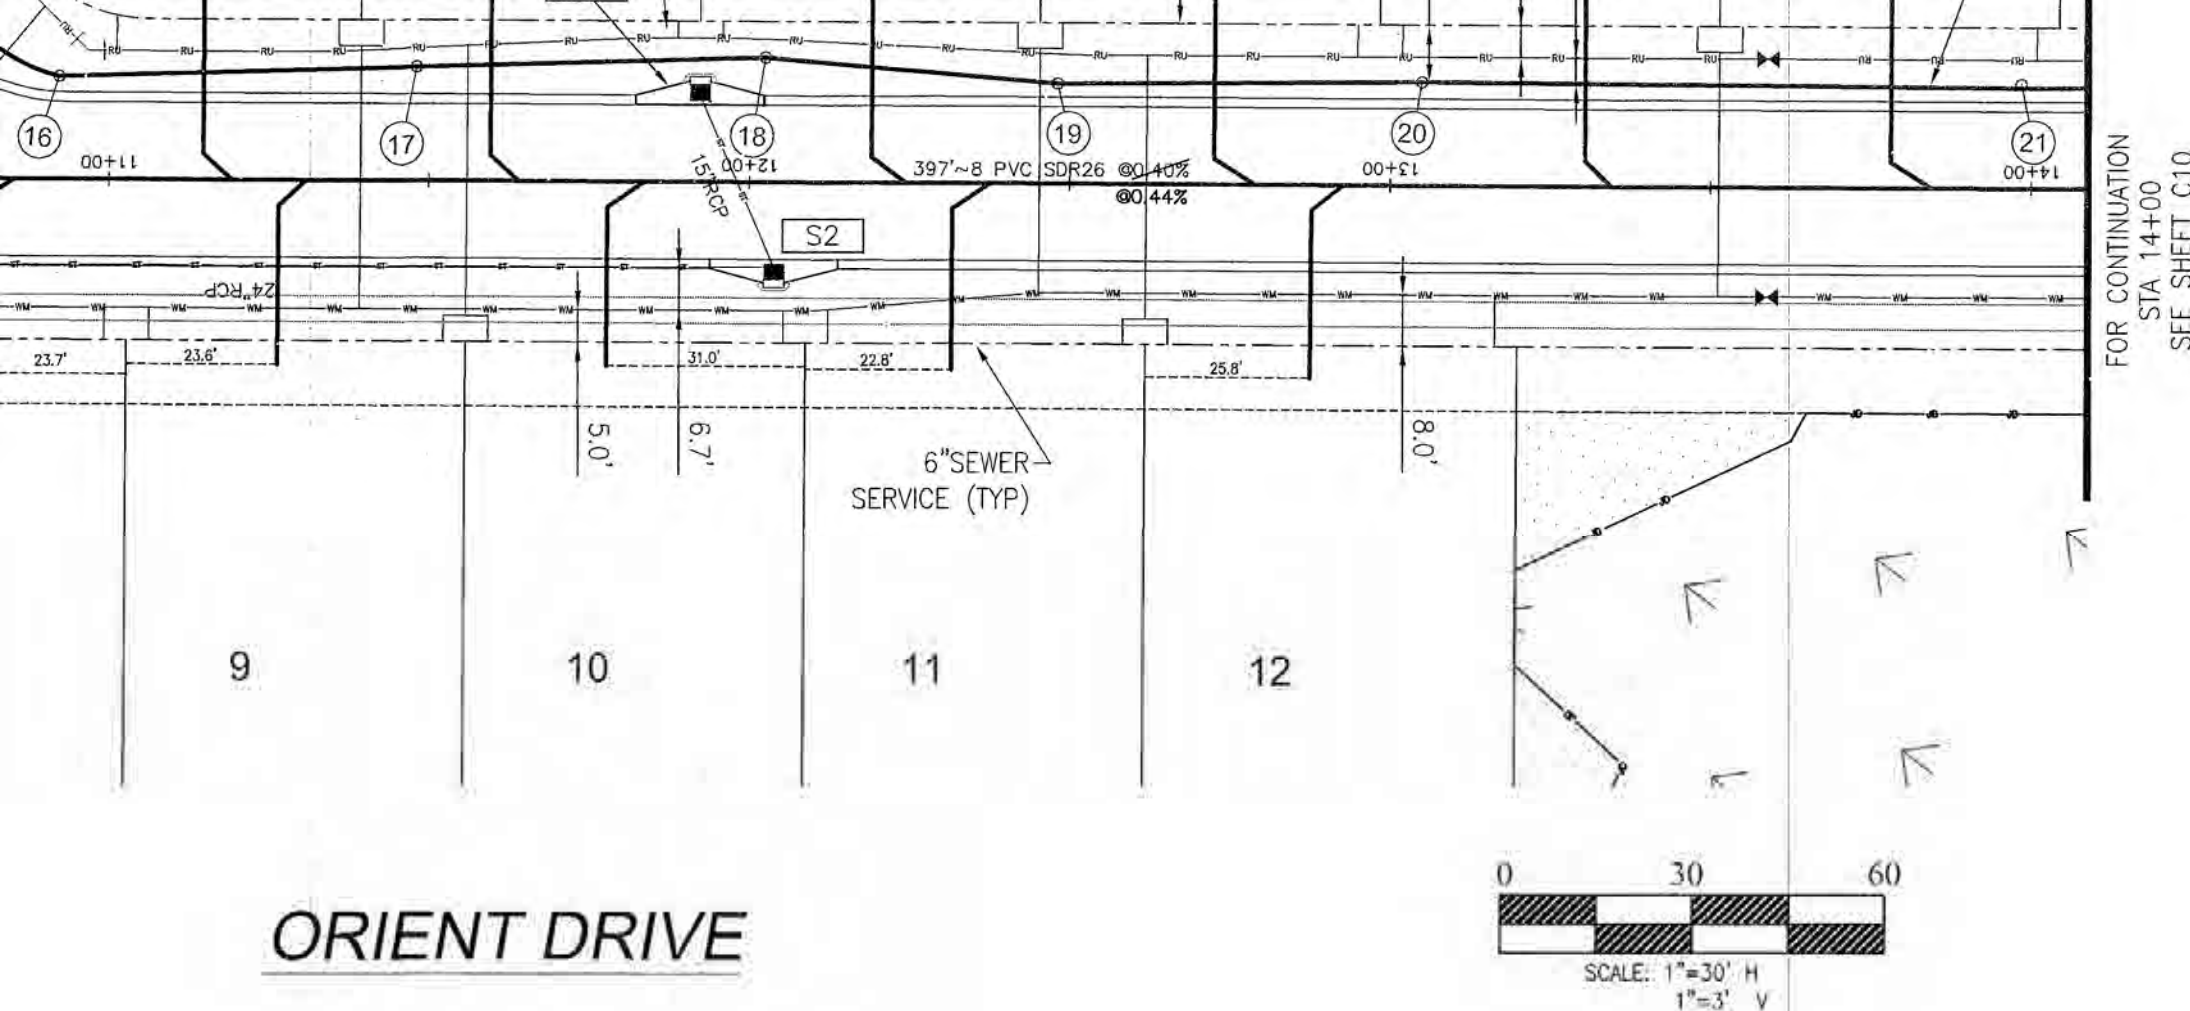

1. AREAS DISTURBED IN FDOT RIGHT OF WAY SHALL BE SODDED.
2. HOUSE WATER METER SIZES, SHALL BE 5/8" MINIMUM.
3. ALL WATER AND SEWER CONSTRUCTION SHALL COMPLY WITH THE LATEST SJCUD CONSTRUCTION STANDARDS AND SPECIFICATIONS.
4. IT IS THE REQUIREMENT OF SJCUD THAT WHEN TREES ARE TO BE PLANTED OR TO REMAIN LOCATED NEAR PUBLIC UTILITIES OWNED OR MAINTAINED PROPOSED OR EXISTING UTILITIES LINES, THAT THE TREES MUST NOT BE WITHIN 7.5 FEET (BOTH WAYS) FROM THE CENTERLINE OF THE PROPOSED EXISTING UTILITY LINE. PLEASE ENSURE THAT THE UTILITY CONSTRUCTION PLANS ARE COORDINATED WITH THE LANDSCAPE/TREE MITIGATION PLANS. (MANUAL OF WASTEWATER AND REUSE DESIGN STANDARDS AND SPECIFICATIONS, PART VI, SJCUD GENERAL NOTES).
5. CONTRACTOR TO LOCATE ALL EXISTING UTILITIES PRIOR TO CONSTRUCTION.

CONTRACTOR TO DEFLECT MAINS AROUND CURB INLET PER PIPE MANUFACTURERS SPECIFICATIONS

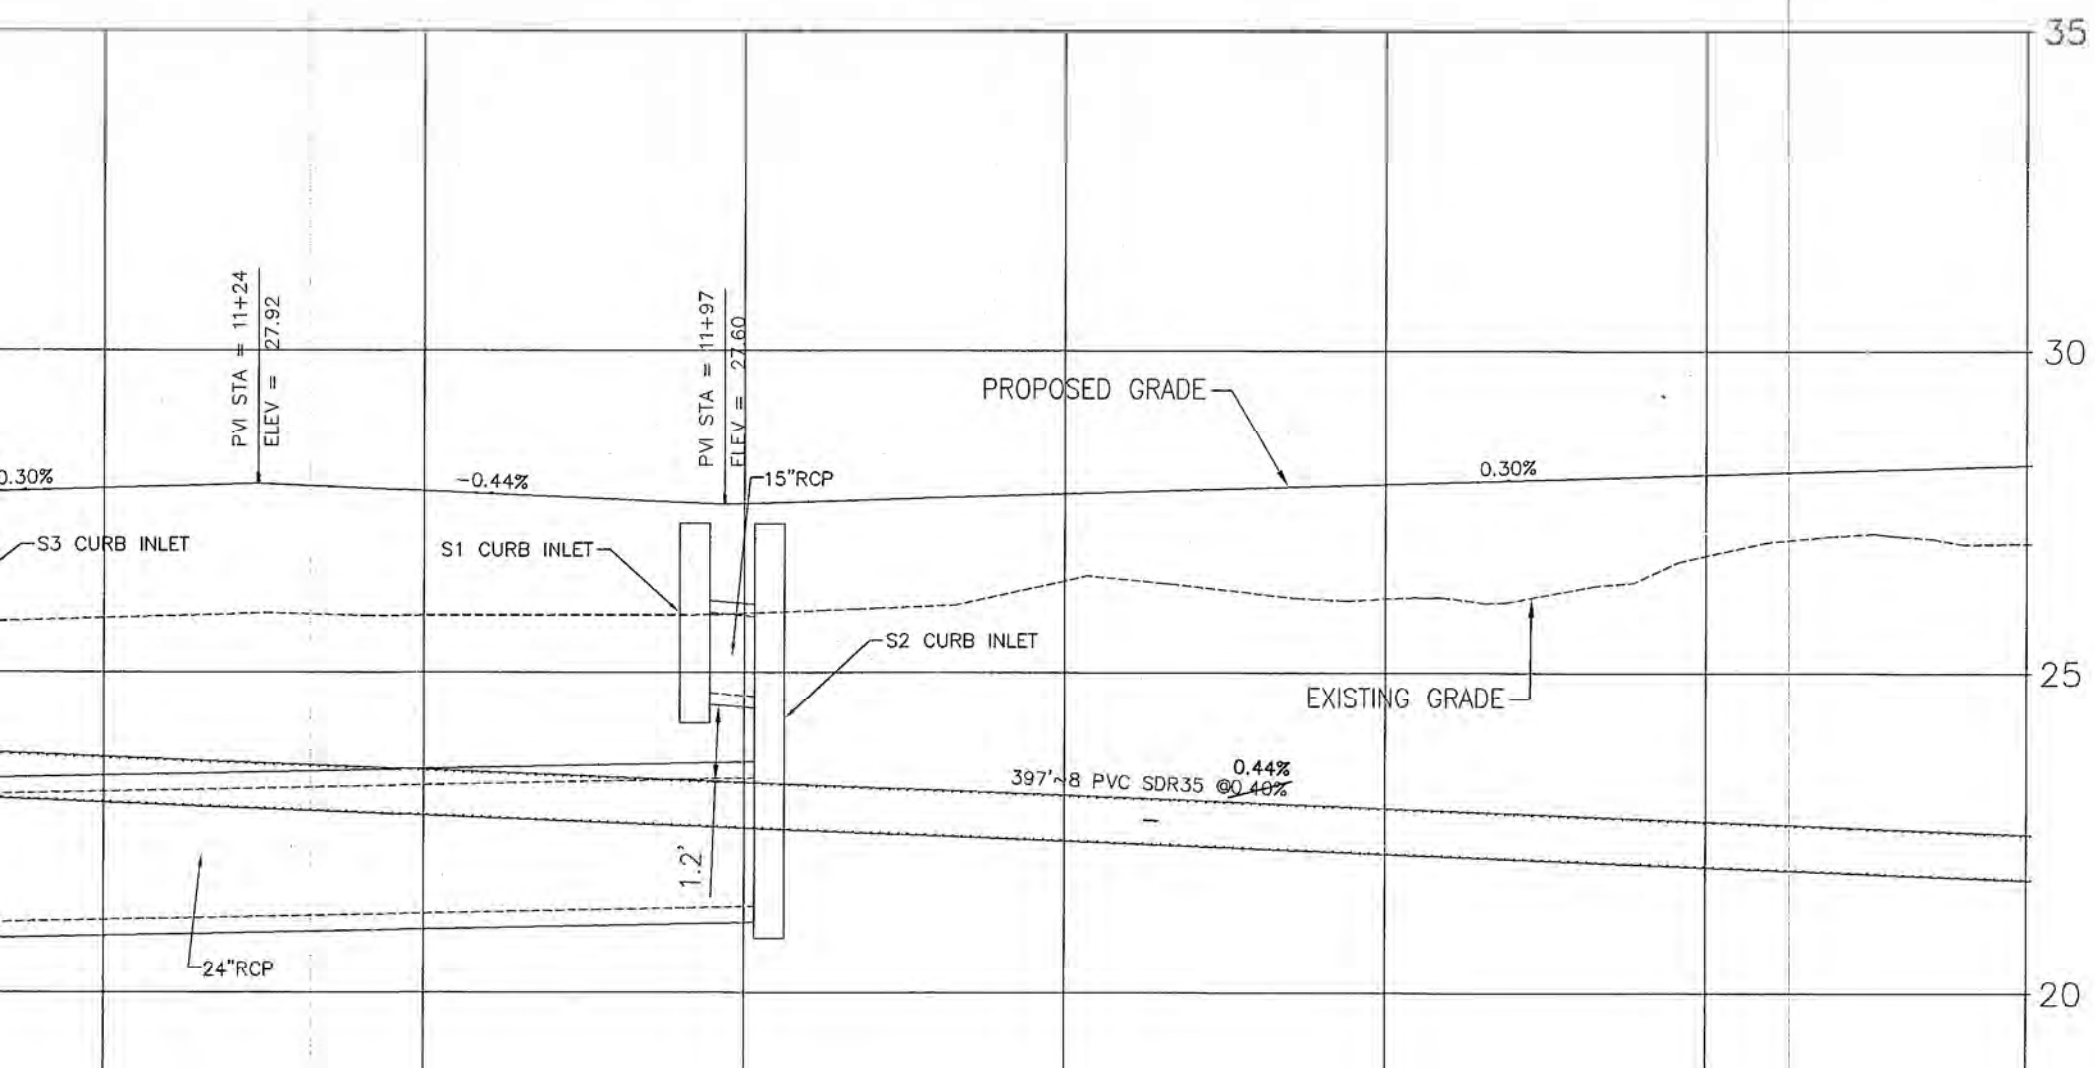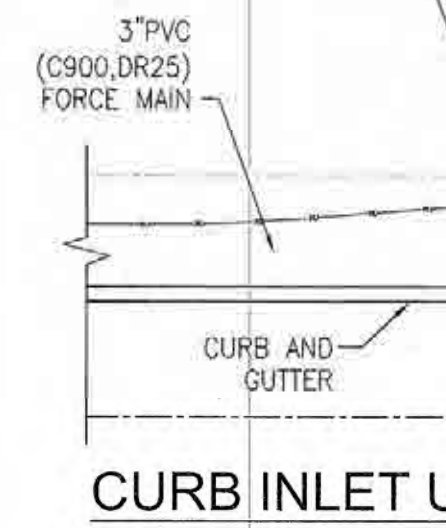

AS-BUILT

INFORMATION PROVIDED BY:

DATE: November 2017-February 2018


NAME: Burnham Construction, Inc.

ADDRESS: 11413 Enterprise East Blvd.
Macclenny, Florida 32063

PHONE NO: (904) 256-5360

I HEREBY CERTIFY THAT THE MATERIALS AND QUANTITIES USED IN CONSTRUCTION OF:

— Pavement	— Chilled Water
— Curb + Gutter	— Water Main
— Storm + Drainage System	— Reclaimed Water
— Lake or Pond	— <input checked="" type="checkbox"/> Force Main
	— <input checked="" type="checkbox"/> Sanitary Gravity

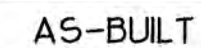

DATE: November 2017-February 2018
NAME: Burnham Construction, Inc.
ADDRESS: 11413 Enterprise East Blvd.
Macclesney, Florida 32063
PHONE NO: (904) 256-5360

<input type="checkbox"/> Pavement	<input type="checkbox"/> Unified Water
<input type="checkbox"/> Curb + Gutter	<input type="checkbox"/> Water Main
<input type="checkbox"/> Storm + Drainage System	<input checked="" type="checkbox"/> Reclaimed Water Main
<input type="checkbox"/> Lake or Pond	<input checked="" type="checkbox"/> Force Main
<input type="checkbox"/> Underdrain Connections	<input checked="" type="checkbox"/> Sanitary Gravity System
	<input type="checkbox"/> Lift Station

ARE IN ACCORDANCE WITH THE APPROVED PLANS AND JEA STANDARDS
AND COUNTY SPECIFICATIONS, UNLESS OTHERWISE APPROVED BY THE
REGULATORY AGENCY.


INFORMATION PROVIDED BY:
NAME: _____
ADDRESS: _____
PHONE: _____

I HEREBY CERTIFY



_____	Pavement
_____	Curb +
_____	Sorm +
_____	Lake or
_____	Underdr

ARE AT THE HO
"AS-BUILT" DRAW
SURVEYING AND
5J-17.051 AND 5

ELECTRONIC DRAWING
FILE DATE: FEB 20 1991

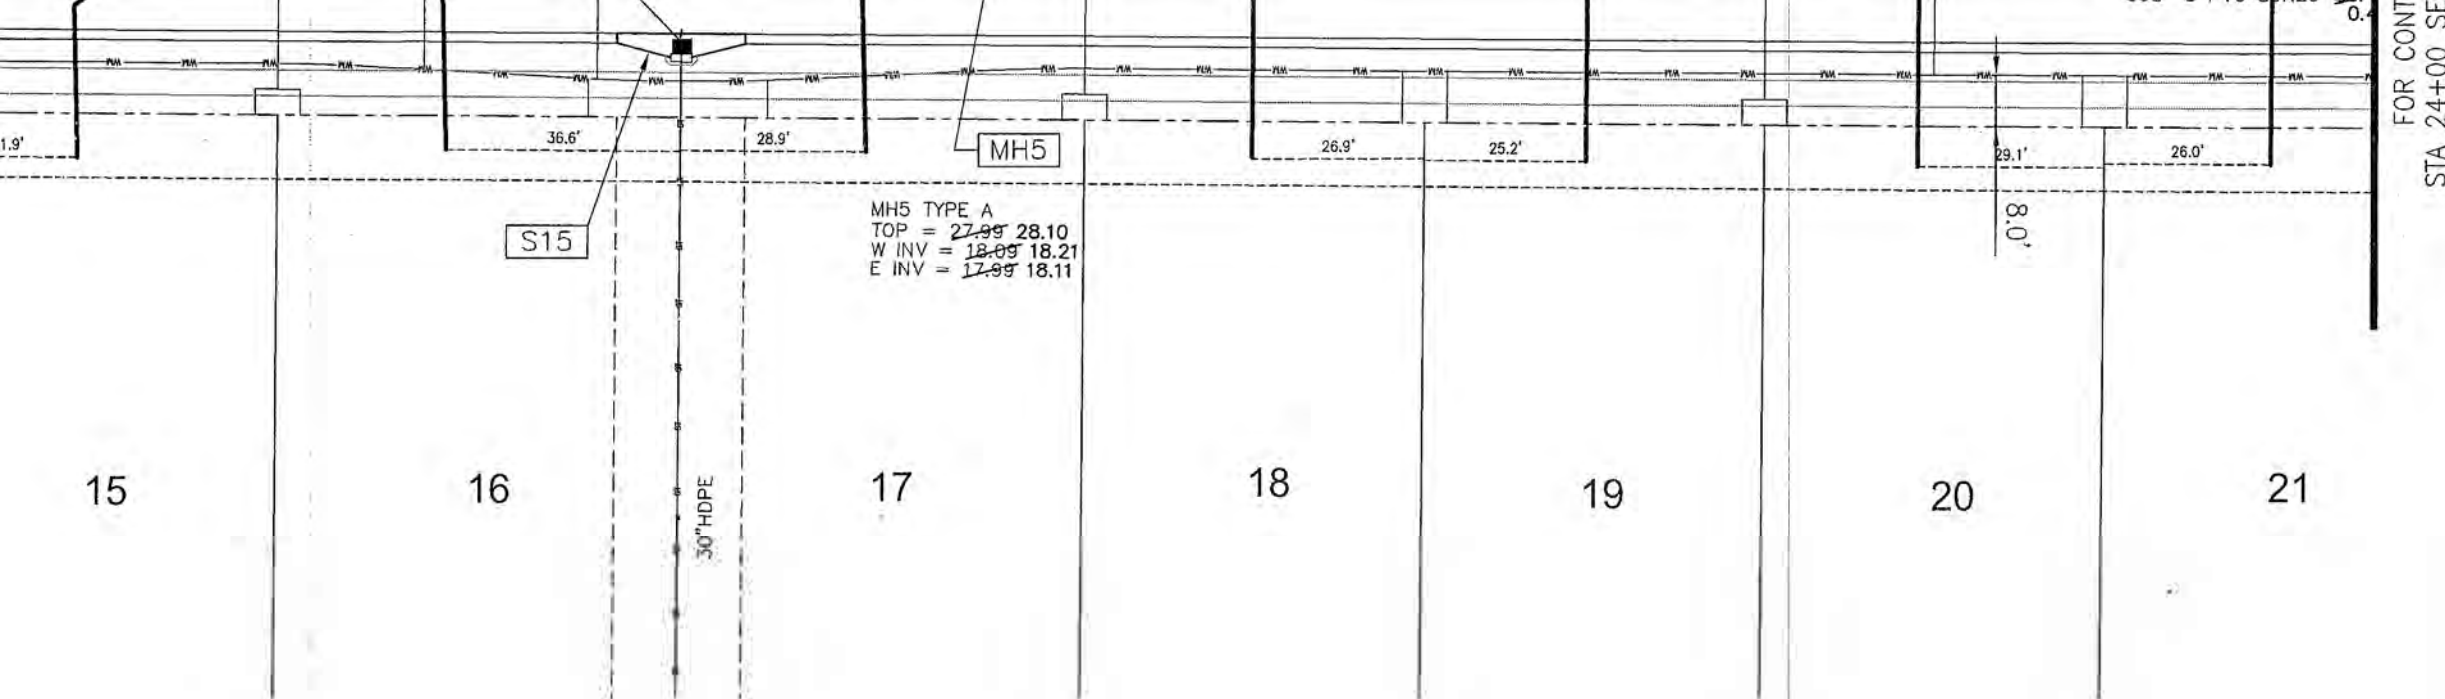

ORIENT DRIVE

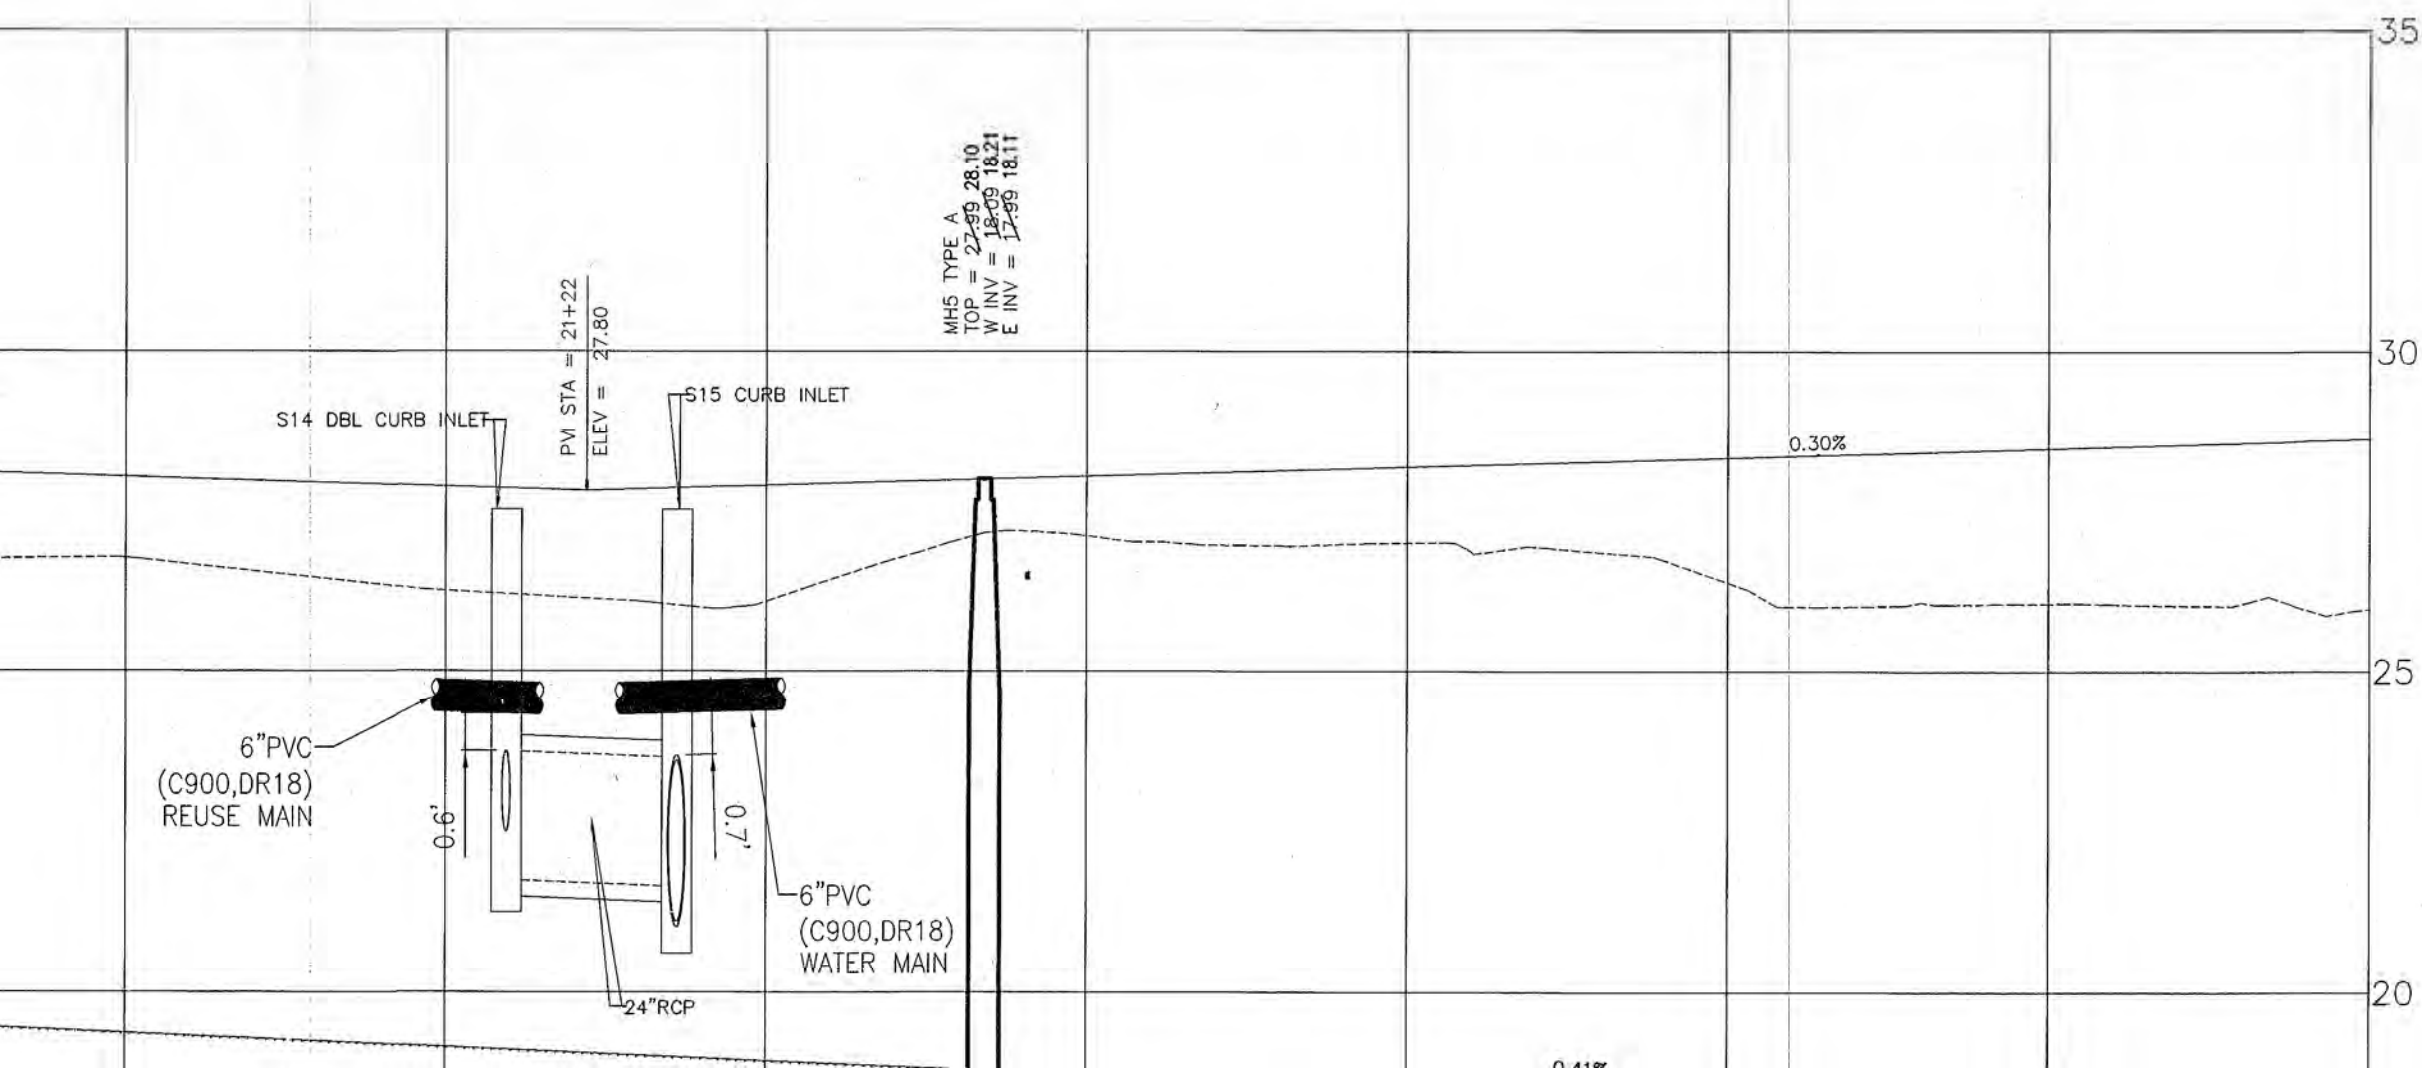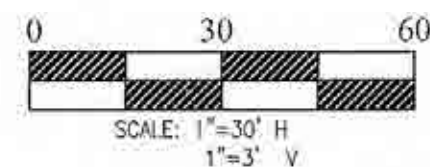

NOTES:



1. AREAS DISTURBED SODDED.
2. HOUSE WATER ME
3. ALL WATER AND S THE LATEST SJCU SPECIFICATIONS.
4. IT IS THE REQUIRE TO BE PLANTED OWNED OR MAINTA LINES, THAT THE (BOTH WAYS) FROM EXISTING UTILITY L CONSTRUCTION PL LANDSCAPE/TREE WASTEWATER AND SPECIFICATIONS, F
5. CONTRACTOR TO L CONSTRUCTION.

GATE VALVE NOTES:



AS-BUILT

INFORMATION PROVIDED BY:
DATE:
NAME:
ADDRESS:


November 2017-February
Burnham Construction, Inc.
11413 Enterprise East
Macclenny, Florida 32561

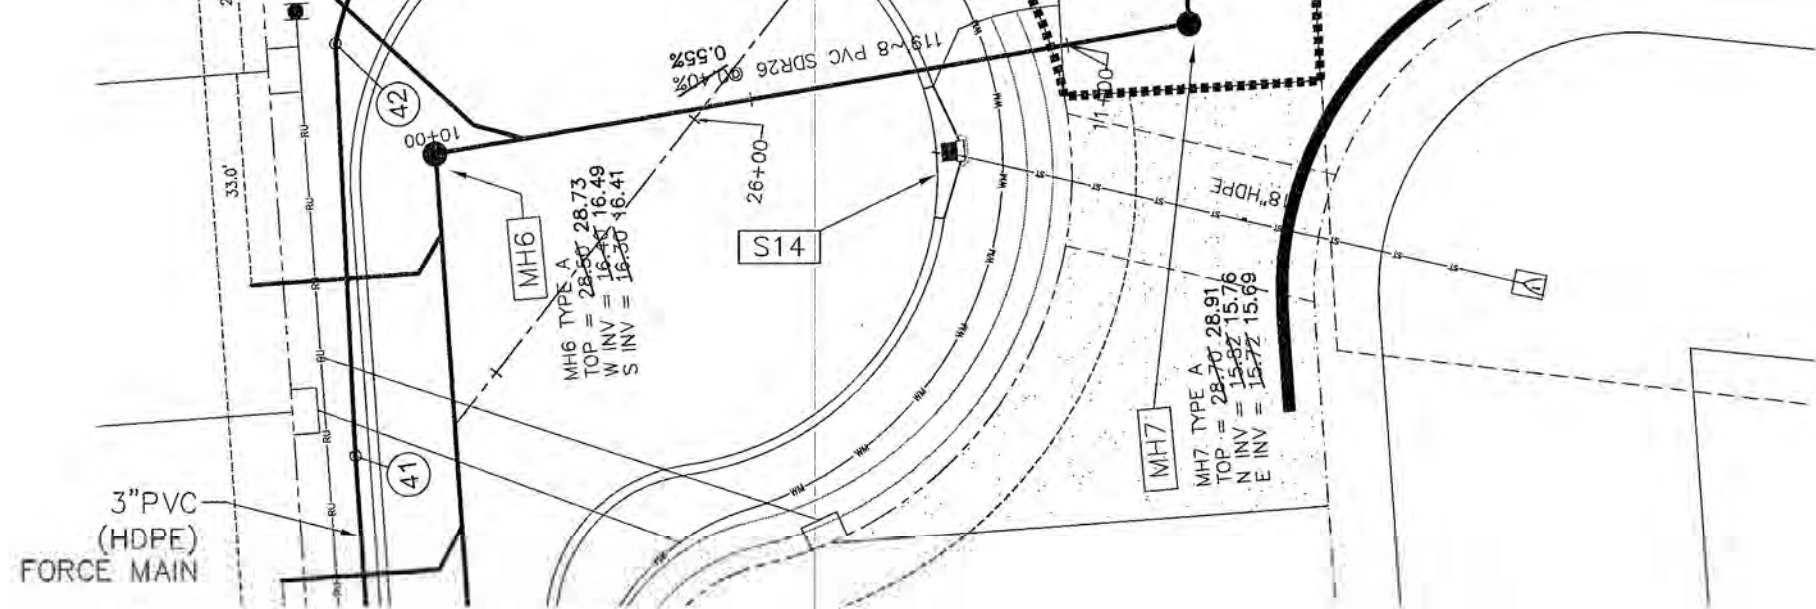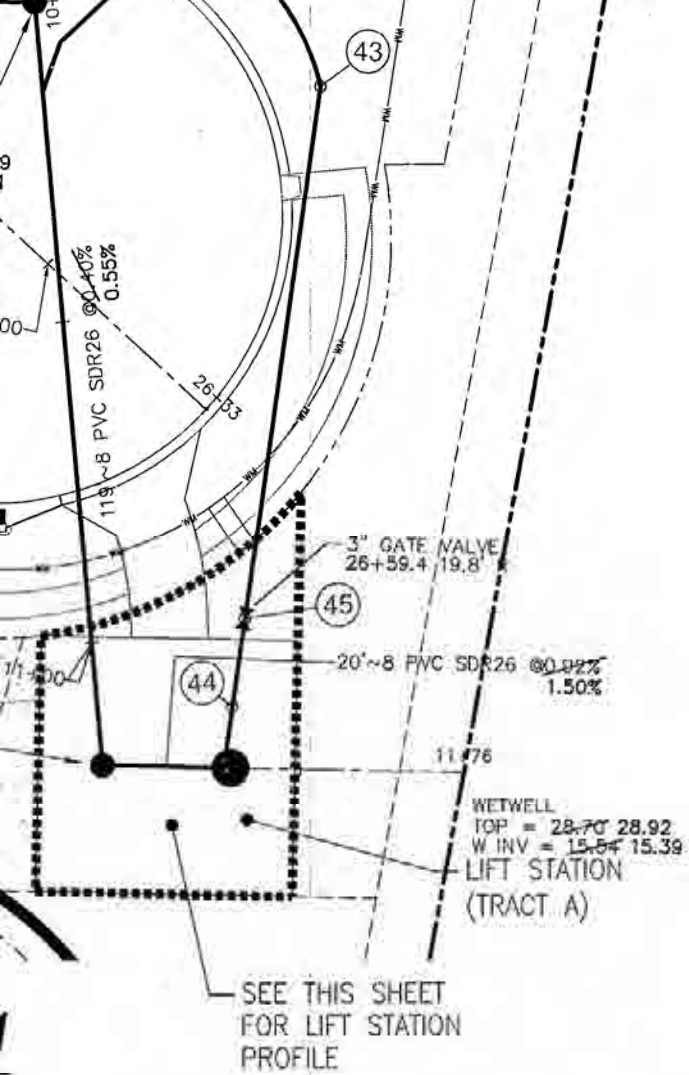

LIFT STATION-2

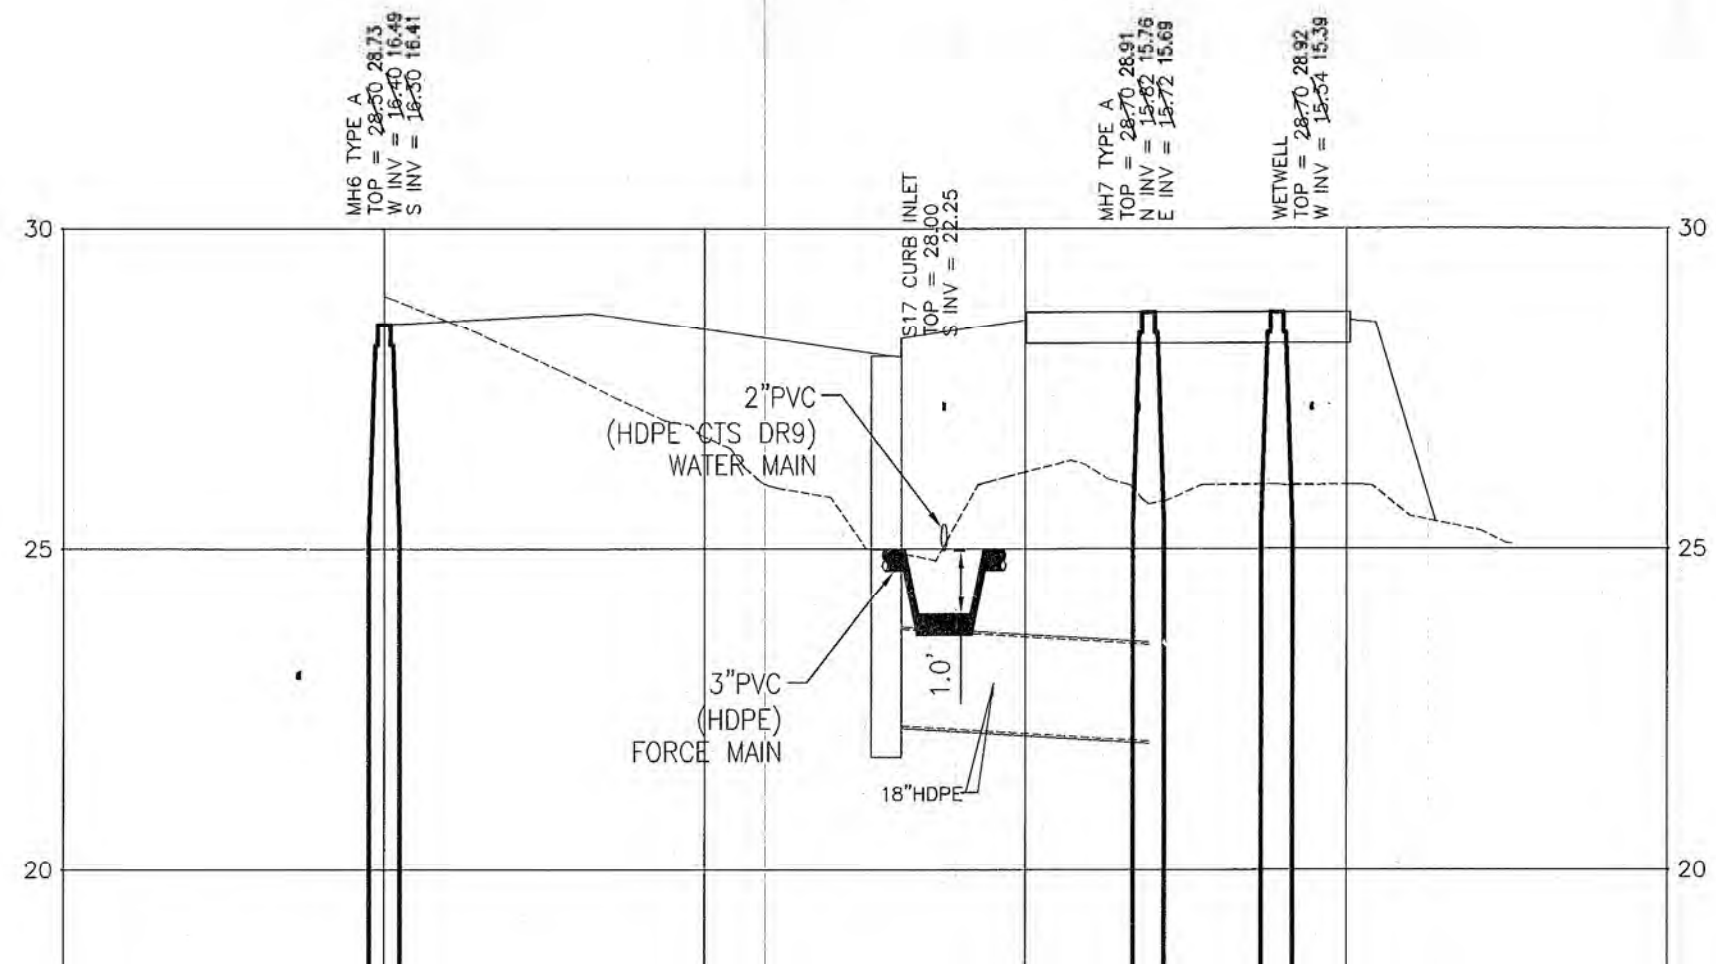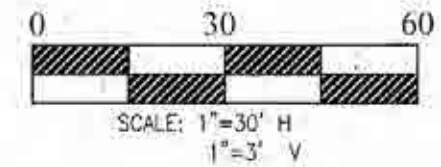


Description	Northing	Easting	Latitude	Longitude	PIPE ELEV. (feet)	FINAL GRADE (feet)	COVER (feet)	UTILITY TOP ELEVATION (feet)	UTILITY SIZE (inches)	SEPARATION	
fm.45bend.tiein	2039080.5	516817.8	N29°56'30.97"	W81°26'23.90"	23.4	26.9	3.5	.	12"	.	
fm.45bend	2039067.0	516874.0	N29°56'30.84"	W81°26'23.26"	20.3	24.9	4.6	.	12"	.	
CONFLICT	2039050.2	516885.7	N29°56'30.68"	W81°26'23.12"	20.0	24.6	4.6	21.5	6" RU	1.0'	
CONFLICT	2039005.1	516921.6	N29°56'30.23"	W81°26'22.71"	20.1	25.5	5.4	18.0	10" WL	1.1'	
fm.top.12in	2038942.8	516968.2	N29°56'29.62"	W81°26'22.18"	20.9	25.7	4.8	.	12"	.	
fm.top.12in	2038862.3	517027.3	N29°56'28.82"	W81°26'21.51"	20.6	25.1	4.5	.	12"	.	
fm.top.12in	2038781.9	517087.1	N29°56'28.03"	W81°26'20.82"	21.5	25.4	3.9	.	12"	.	
fm.top.12in	2038701.4	517146.4	N29°56'27.23"	W81°26'20.15"	21.8	25.5	3.7	.	12"	.	
fm.45bend	2038626.4	517202.3	N29°56'26.49"	W81°26'19.51"	22.9	25.9	3.0	.	12"	.	
fm.45bend.tiein	2038574.1	517193.5	N29°56'25.98"	W81°26'19.61"	21.7	24.7	3.0	.	12"	.	
fm.12x4.tee	2039042.8	516891.2	N29°56'30.60"	W81°26'23.06"	20.0	28.2	8.2	.	12"	.	
fm.4x3.reducer	2039044.3	516893.0	N29°56'30.62"	W81°26'23.04"	20.0	28.2	8.2	.	3"	.	
fm.top.3in	2039078.4	516939.5	N29°56'30.96"	W81°26'22.51"	23.2	28.7	5.5	.	3"	.	
CONFLICT	2039104.8	516977.9	N29°56'31.22"	W81°26'22.08"	25.0	27.9	2.9	24.1	15"HDPE	0.6'	
fm.top.3in	2039159.2	517051.7	N29°56'31.76"	W81°26'21.24"	25.1	27.8	2.7	.	3"	.	
fm.top.3in	2039187.1	517055.5	N29°56'32.04"	W81°26'21.20"	25.3	27.8	2.5	.	3"	.	
fm.top.3in	2039230.7	517020.8	N29°56'32.47"	W81°26'21.60"	24.9	28.0	3.1	.	3"	.	
fm.top.3in	2039273.3	516986.8	N29°56'32.89"	W81°26'21.98"	24.1	27.8	3.7	.	3"	.	
fm.top.3in	2039312.2	516962.7	N29°56'33.27"	W81°26'22.26"	24.3	28.0	3.7	.	3"	.	
fm.top.3in	2039357.4	516928.2	N29°56'33.72"	W81°26'22.65"	24.8	28.1	3.3	.	3"	.	
fm.locate.wire.box	2039432.3	516872.2	N29°56'34.46"	W81°26'23.29"	28.0	28.0	.	.	3"	.	
CONFLICT	2039499.3	516822.5	N29°56'35.12"	W81°26'23.86"	23.7	28.0	4.3	26.5	18" RCP	1.1'	
fm.top.3in	2039513.0	516812.3	N29°56'35.25"	W81°26'23.98"	23.8	28.0	4.2	.	3"	.	
fm.top.3in	2039594.8	516763.3	N29°56'36.06"	W81°26'24.54"	24.4	28.0	3.6	.	3"	.	
fm.top.3in	2039624.2	516750.2	N29°56'36.35"	W81°26'24.69"	24.7	28.0	3.3	.	3"	.	
fm.top.3in	2039673.5	516714.3	N29°56'36.84"	W81°26'25.10"	25.5	28.3	2.8	.	3"	.	
fm.top.3in	2039725.1	516677.3	N29°56'37.35"	W81°26'25.52"	25.3	28.6	3.3	.	3"	.	
fm.top.3in	2039754.6	516667.8	N29°56'37.64"	W81°26'25.63"	25.1	28.7	3.6	.	3"	.	
fm.top.3in	2039779.0	516639.9	N29°56'37.88"	W81°26'25.95"	25.2	29.0	3.8	.	3"	.	
fm.top.valve	2039779.0	516639.9	N29°56'37.88"	W81°26'25.95"	25.2	29.1	3.9	.	3"	.	
fm.top.3in	2039844.9	516651.9	N29°56'38.53"	W81°26'25.82"	25.7	29.0	3.3	.	3"	.	
fm.top.3in	2039855.1	516689.0	N29°56'38.64"	W81°26'25.40"	25.9	28.8	2.9	.	3"	.	
fm.top.3in	2039855.9	516715.7	N29°56'38.65"	W81°26'25.09"	25.8	28.7	2.9	.	3"	.	
fm.top.3in	2039875.2	516767.7	N29°56'38.84"	W81°26'24.50"	25.2	28.6	3.4	.	3"	.	
fm.top.3in	2039891.3	516844.9	N29°56'39.00"	W81°26'23.62"	25.3	28.4	3.1	.	3"	.	
CONFLICT	2039914.7	516958.2	N29°56'39.24"	W81°26'22.34"	25.2	28.0	2.8	23.2	15"HDPE	1.7'	
fm.top.3in	2039927.8	517042.8	N29°56'39.37"	W81°26'21.38"	25.3	28.2	2.9	.	3"	.	
fm.top.3in	2039943.3	517125.5	N29°56'39.53"	W81°26'20.44"	25.6	28.5	2.9	.	3"	.	
fm.top.3in	2039965.9	517244.9	N29°56'39.75"	W81°26'19.08"	25.5	28.8	3.3	.	3"	.	
fm.top.3in	2039982.0	517331.3	N29°56'39.92"	W81°26'18.10"	25.9	29.1	3.2	.	3"	.	

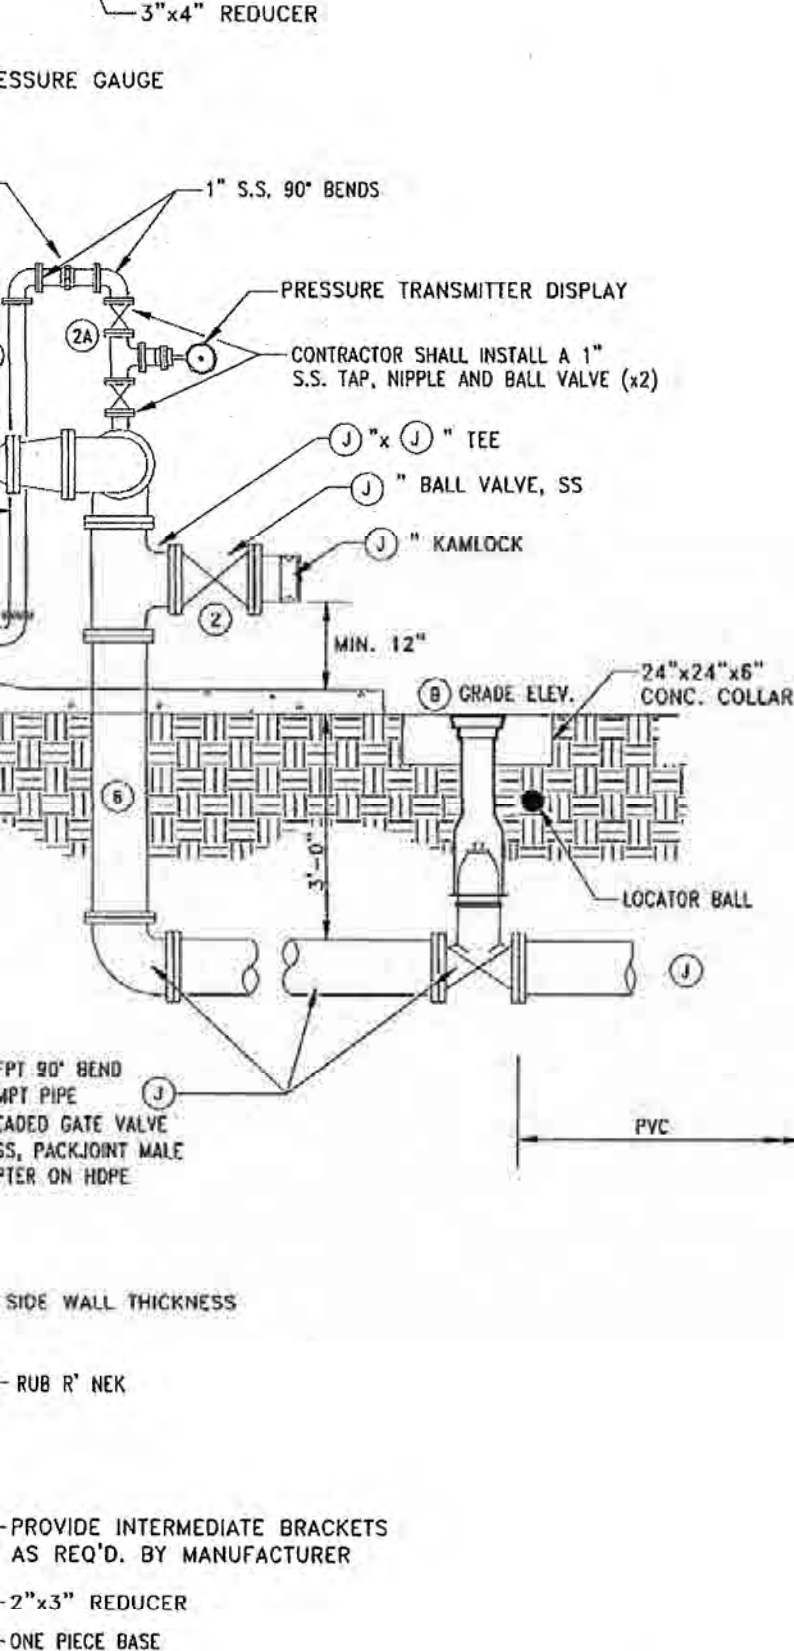

PUMP INFORMATION	
NUMBER OF PUMPS	2
PUMP MANUFACTURER	⑩ FLYGT
MP3102 HT 3-263	
PUMP MODEL	⑩ IMPELLER ID 40 MM
DISCHARGE	1 1/4" MOTOR RPM 3500
6 HP 230 VOLTS 3 PHASE 60 HZ	
MANIFOLD COND.	47 GPM AT 123 FT.TDH
RUN-OUT COND.	100 GPM AT 65 FT.TDH
PUMP ACCESS HATCH SIZE	x
ELECTRICAL SERVICE AMPS (100 or 200)	100

MECHANICAL EQUIPMENT SCHEDULE	
①	CHECK VALVE, FLAPPER TYPE, FULL PORT, THREADED BRASS; INSTALLED IN VERTICAL POSITION
②	PLUG VALVE, CAST SS, FULL PORT
②A	CONTRACTOR TO INSTALL: (2)-1" STAINLESS STEEL BALL VALVES 1"x1" STAINLESS STEEL TEE 1"x1/2" DIAPHRAGM - SEE INSTRUMENTATION 1/2"x1/2" MALE TO MALE NIPPLE
③	STAINLESS STEEL TEE
④	STAINLESS STEEL SHORT RADIUS 90° BEND
⑤	STAINLESS STEEL 45° BEND
⑥	316 STAINLESS STEEL PIPE (SCH 40)
⑦	1/4" SST BRAIDED WIRE CABLE WITH 18" OF CHAIN
⑧	INFLUENT PIPE (SEE PLANS)
⑨	CONCRETE WETWELL
⑩	PUMP (AS APPROVED BY ST. JOHNS COUNTY UTILITY DEPARTMENT) GRINDER, 2"
⑪	ALUMINUM WETWELL ACCESS COVER (OPENING PER PUMP MANUFACTURER)
⑫	STAINLESS STEEL GUIDE RAILS
⑬	LEVEL STICK, HIGH AND LOW ALARM FLOATS PROVIDED BY PUMP MANUFACTURER
⑭	PUMP MOTOR CABLE
⑮	4" TEE SCHEDULE 80 PVC AIR VENT WITH PROTECTIVE SCREENS
⑯	STAINLESS STEEL CABLE HOLDER
⑰	1" STAINLESS BLOW OFF LINE TO WETWELL-SECURE LINE TO WETWELL SLAB WITH UNISTRUT WITH UNIONS

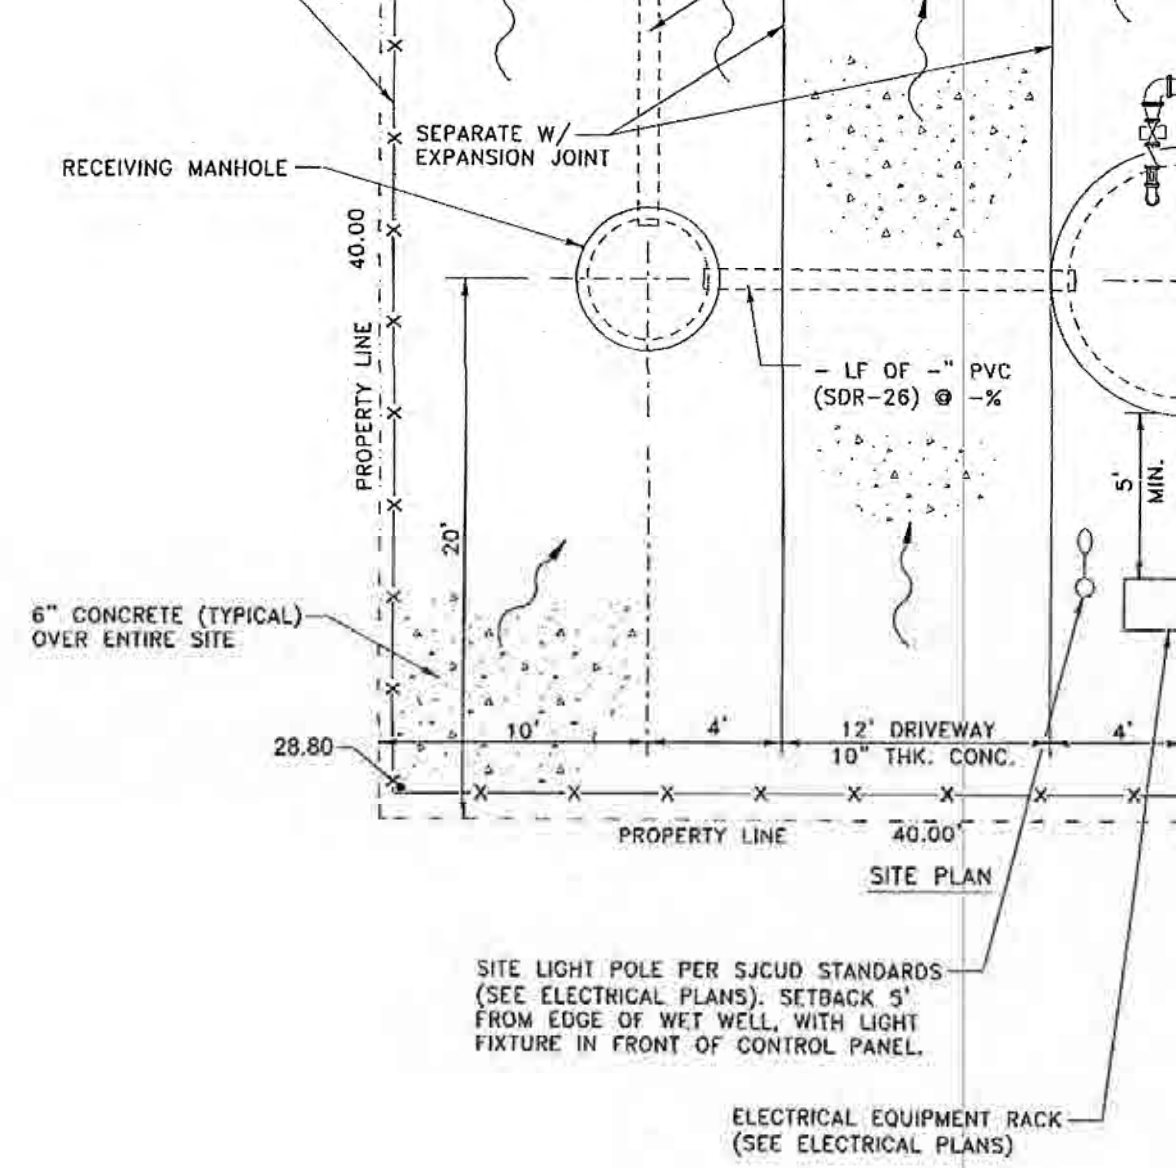


NOTES:

1. ACCESS COVER FOR THE WETWELL SHALL BE 1/4" ALUM. TREAD PLATE WITH STAINLESS STEEL HARDWARE. COVER SHALL BE PROVIDED WITH LIFTING HANDLE, LOCKING HASP AND SAFETY LATCH TO HOLD COVERS OPEN. OPENING IN WETWELL SLAB AS PER MANUFACTURERS SPECIFICATIONS.
2. ALL CONCRETE SHALL BE 6" THICK AND REINFORCED WITH 6 X 6 10/10 WWM EXCEPT THE DRIVEWAY WHICH SHALL BE 10" THICK.
3. CONTRACTOR SHALL SUBMIT SHOP DRAWINGS OF PRECAST WETWELL. SHOP DRAWINGS SHALL INCLUDE ALL NECESSARY STRUCTURAL AND FLOTATION CALCULATIONS.
4. THE CONTRACTOR SHALL BE RESPONSIBLE FOR FURNISHING ELECTRICAL POWER TO THE PUMPING STATION, THREE PHASE POWER IS REQUIRED. THIS WORK IS TO BE COORDINATED WITH FLORIDA POWER AND LIGHT.
5. THE INTERIOR OF THE WET WELL AND RECEIVING MANHOLE SHALL BE COATED WITH LINER BY APPROVED MANUFACTURER.
6. A LIGHTNING ARRESTER SHALL BE SUPPLIED AND INSTALLED BY THE "SYSTEM" SUPPLIER.
7. A SURGE SUPPRESSER SHALL BE SUPPLIED AND INSTALLED BY THE "SYSTEM" SUPPLIER.
8. AN AUDIBLE ALARM SHALL BE SUPPLIED AND INSTALLED BY THE "SYSTEM" SUPPLIER.
9. THE SURFACE OF THE WET WELL SHALL FIRST BE PREPARED BY GROUTING THE WET WELL AS REQUIRED TO OBTAIN A SMOOTH SURFACE. THE COATING SHALL BE MAINTAINED FOR A MINIMUM OF 10 YEARS FOR INTERIOR AND EXTERIOR SURFACES.

12. SITE GRADING SHALL PROVIDE FOR DRAINAGE OF WATER TO
13. SIZES SHOWN IN "STATION INFORMATION" ABOVE ARE MINI
14. ALL ABOVE GRADE FITTINGS SHALL BE PAINTED FOREST GR
15. ALL STAINLESS STEEL MUST BE SCHEDULE 40.
16. ROTATE THE PRESSURE TRANSMITTER DISPLAY TO MATCH THE MOUNTING TEE SUCH THAT THE PRESSURE TRANSMITTER DI

ST. JOHNS COUNTY, FLORIDA

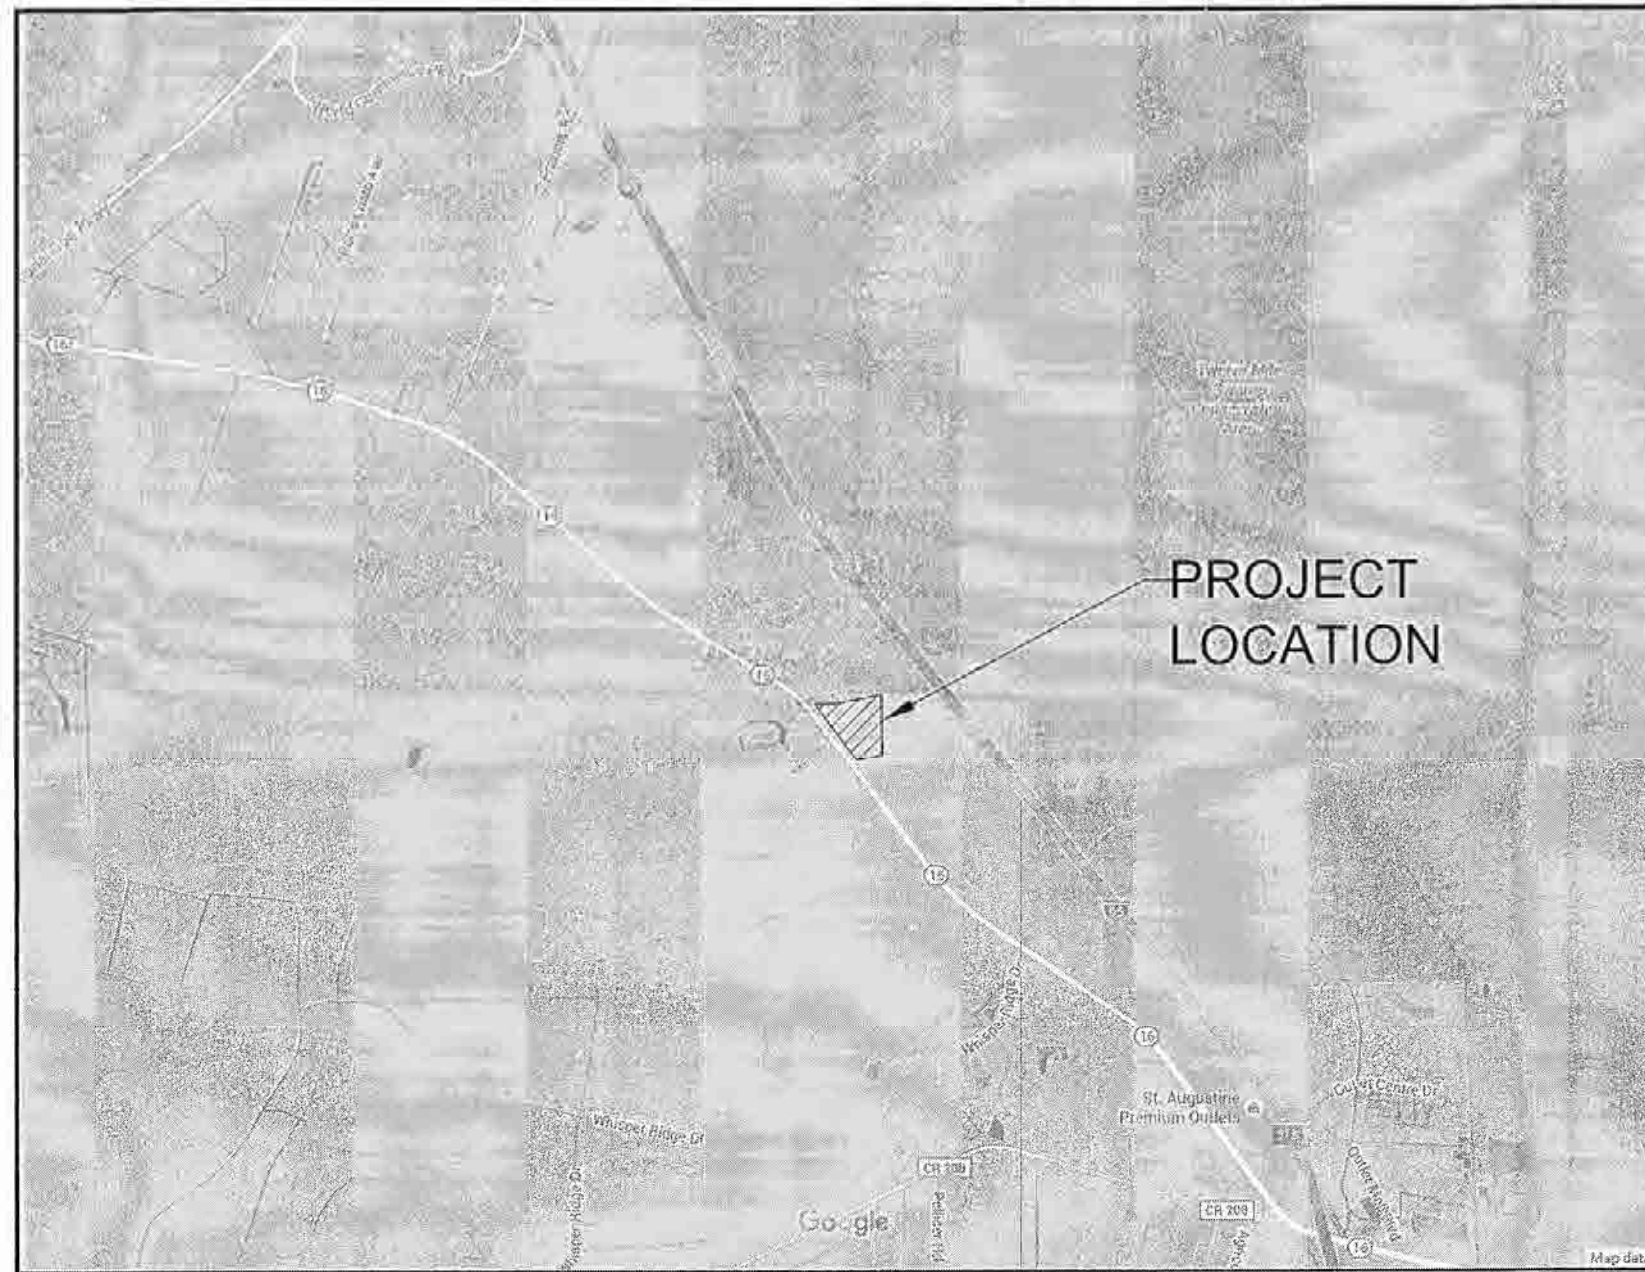

INDEX OF D

T-1
C4
C8-C12

LOCATION MAP

N.T.S.

AS	
INFORMATION PROVIDED BY:	
DATE:	Nov
NAME:	Burn
ADDRESS:	1141
PHONE NO:	Mac
I HEREBY CERTIFY THAT THE MATERIALS AND METHODS OF CONSTRUCTION OF:	
<ul style="list-style-type: none">_____ Pavement_____ Curb + Gutter_____ Storm + Drainage System_____ Lake or Pond_____ Underdrain Connections	
ARE IN ACCORDANCE WITH THE APPROPRIATE STATE AND COUNTY SPECIFICATIONS, UNLESS OTHERWISE SPECIFIED BY THE REGULATORY AGENCY.	
AUTHORIZED SIGNATURE	

NOTE: SOME INFORMATION SHOWN

Point Table


Easting	Latitude	Longitude	PIPE ELEV. (feet)	FINAL GRADE (feet)	COVER (feet)	UTILITY TOP ELEVATION (feet)	UTILITY SIZE (inches)	SEPARATION
516815.3	N29°56'30.91"	W81°26'23.93"	24.5	27.6	3.1	..	8"	.
516870.0	N29°56'30.79"	W81°26'23.30"	21.4	24.4	3.0	..	8"	.
516915.2	N29°56'30.15"	W81°26'22.79"	22.0	25.3	3.3	23.8	8" WL	1.1'
516960.0	N29°56'29.55"	W81°26'22.28"	22.4	25.4	3.0	..	8"	.
517019.5	N29°56'28.76"	W81°26'21.60"	22.2	25.1	2.9	..	8"	.
517079.1	N29°56'27.97"	W81°26'20.91"	21.8	24.7	2.9	..	8"	.
517137.8	N29°56'27.17"	W81°26'20.24"	21.6	24.5	2.9	..	8"	.
517194.4	N29°56'26.43"	W81°26'19.60"	22.9	25.9	3.0	..	8"	.
517186.7	N29°56'25.99"	W81°26'19.68"	21.7	24.7	3.0	..	8"	.
516881.8	N29°56'30.6"	W81°26'23.17"	21.5	24.6	3.1	..	8"	.



OFFSITE UTILITY NOTES:

1. SJCUD HAS CONFIRMED THAT THE CONTRACTOR CAN TAKE MAINS OUT OF SERVICE.
2. CONTRACTOR SHALL COORDINATE WITH SJCUD TO HAVE 12" FORCEMAIN AND 8" REUSE MAIN OFFLINE DURING RELOCATION OF LINES.
3. TRENCH BOX, SHORING OR STABILIZATION REQUIRED DUE TO LOCATION OF EXISTING FORCE MAIN AND REUSE MAIN.
4. NO VALVES TO BE INSTALLED WITHIN DITCH LINE.

12"-45° DI MJ BEND
10+66.00 495.50'R

8"-45° DI MJ BEND
10+56.00 491.50'R

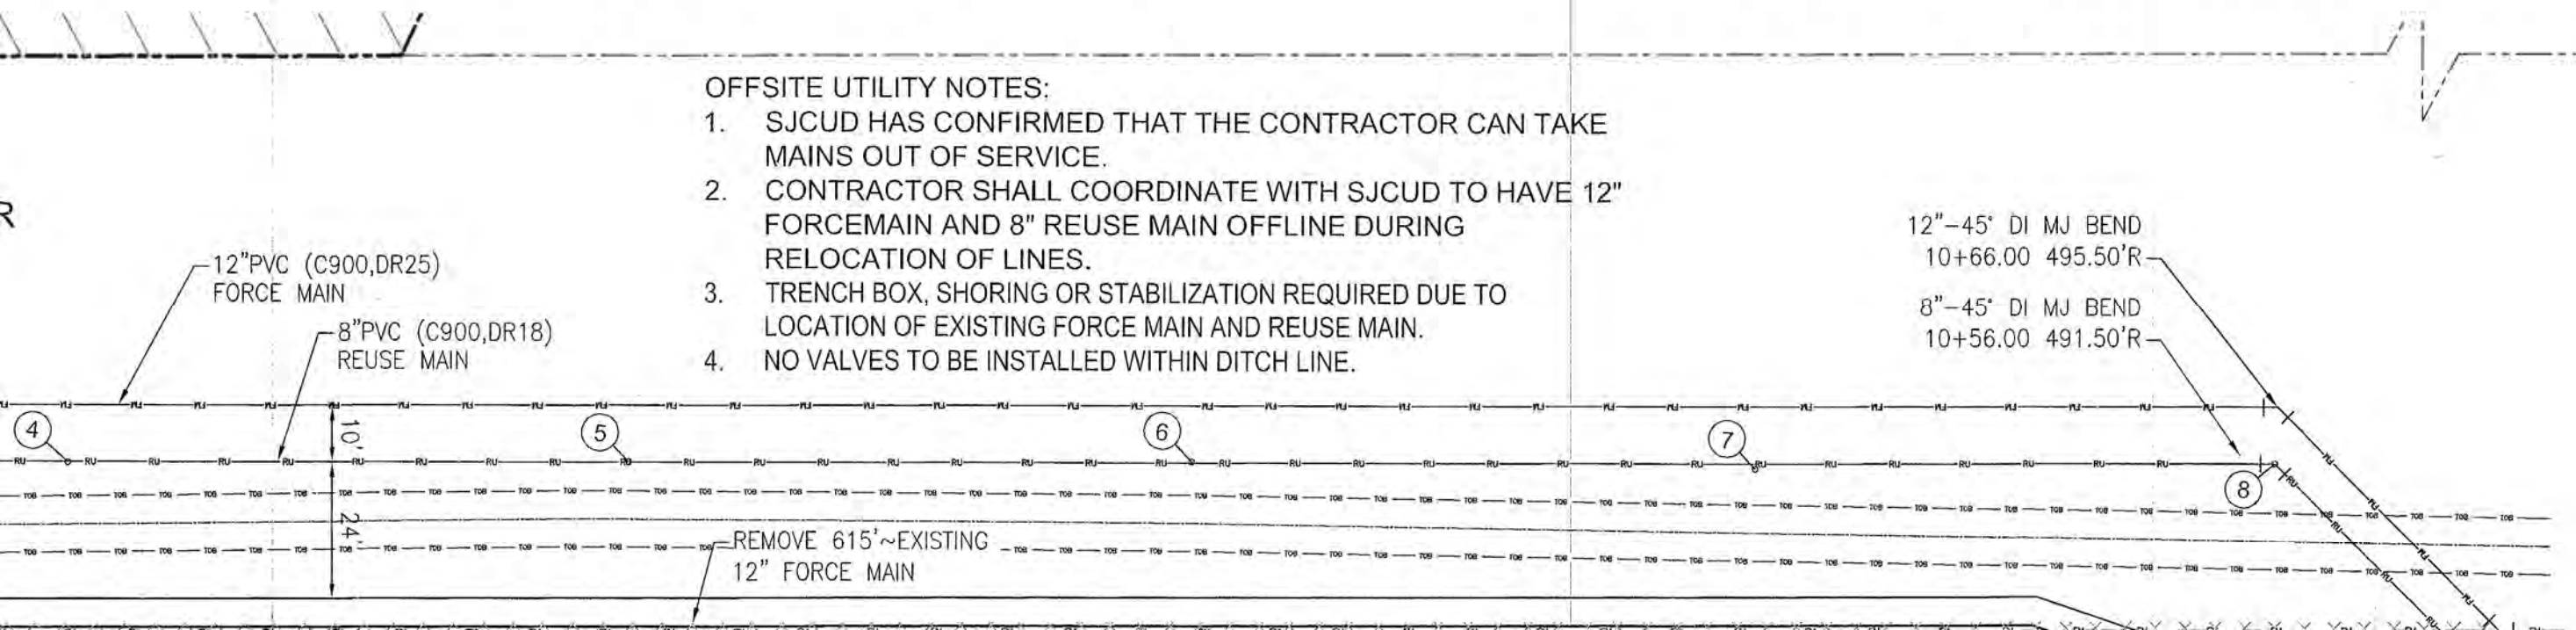

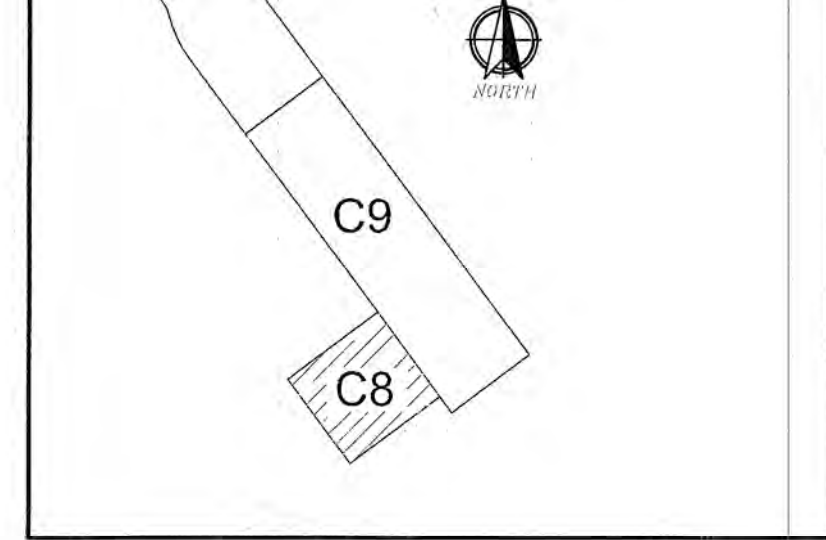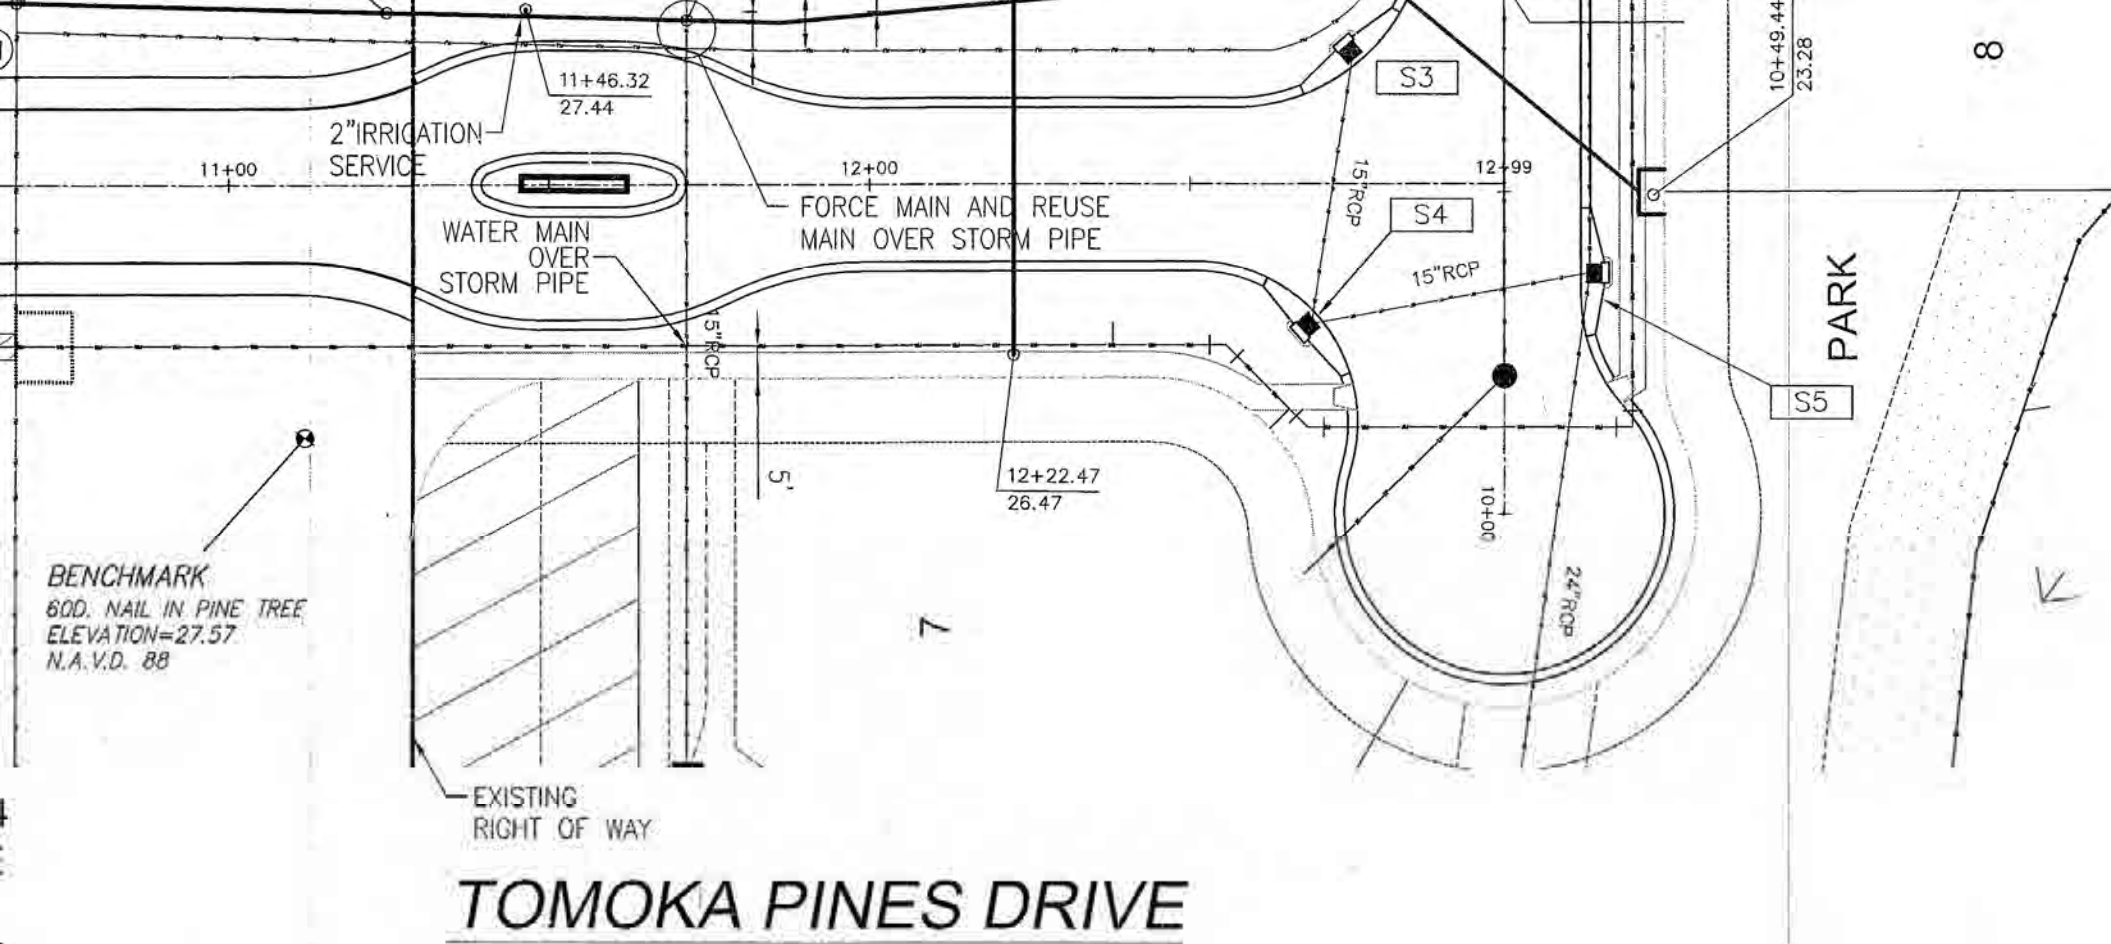

TOMOKA PINES DRIVE

Size	Type	Manufacturer	#Turns to Open	Depth of Nut	Direction to Open
6"	Gate	M+H	19.5	1.8"	Left

Point Table

Easting	Latitude	Longitude	PIPE ELEV. (feet)	FINAL GRADE (feet)	COVER (feet)	UTILITY TOP ELEVATION (feet)	UTILITY SIZE (inches)	SEPARATION
16881.8	N29°56'30.60"	W81°26'23.17"	21.5	24.6	3.1	.	8"	.
16883.5	N29°56'30.61"	W81°26'23.15"	22.8	24.6	1.8	.	6"	.
16885.7	N29°56'30.68"	W81°26'23.12"	21.5	24.6	3.1	20.0	12" FM	1.0'


AS-BUILT

INFORMATION PROVIDED BY:
 DATE: November 2017-January 2018
 NAME: Burnham Construction, Inc.
 ADDRESS: 11413 Enterprise East Blvd.
 Macclenny, Florida 32063
 PHONE NO: (904) 256-5360

I HEREBY CERTIFY THAT THE MATERIALS AND QUANTITIES USED IN THE CONSTRUCTION OF:


— Pavement	— Chilled Water
— Curb + Gutter	— Water Main
— Storm + Drainage System	— <input checked="" type="checkbox"/> Reclaimed Water Main
— Lake or Pond	— Force Main
— Underdrain Connections	— Sanitary Gravity System
	— Lift Station

ARE IN ACCORDANCE WITH THE APPROVED PLANS AND JEA STANDARDS AND COUNTY SPECIFICATIONS, UNLESS OTHERWISE APPROVED BY THE REGULATORY AGENCY.

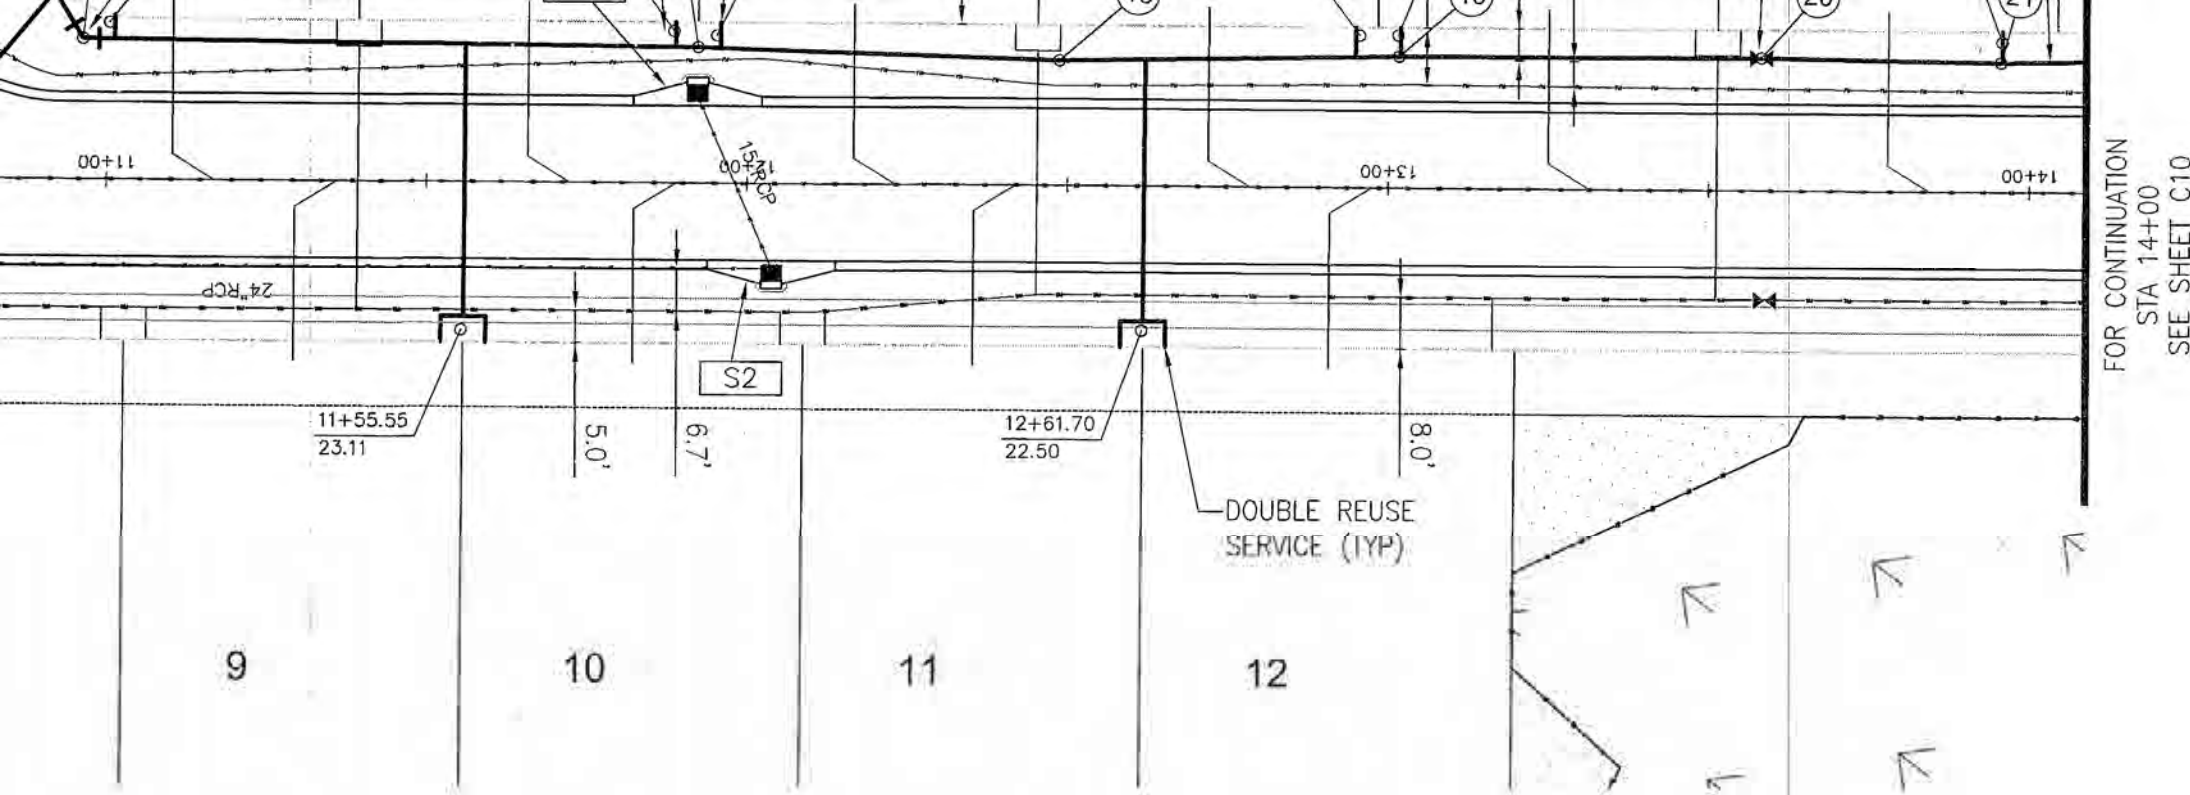

1. AREAS DISTURBED IN FDOT RIGHT OF WAY SHALL BE SODDED.
2. HOUSE WATER METER SIZES, SHALL BE 5/8" MINIMUM.
3. ALL WATER AND SEWER CONSTRUCTION SHALL COMPLY WITH THE LATEST SJCUD CONSTRUCTION STANDARDS AND SPECIFICATIONS.
4. IT IS THE REQUIREMENT OF SJCUD THAT WHEN TREES ARE TO BE PLANTED OR TO REMAIN LOCATED NEAR PUBLICLY OWNED OR MAINTAINED PROPOSED OR EXISTING UTILITY LINES, THAT THE TREES MUST NOT BE WITHIN 7.5 FEET (BOTH WAYS) FROM THE CENTERLINE OF THE PROPOSED EXISTING UTILITY LINE. PLEASE ENSURE THAT THE UTILITY CONSTRUCTION PLANS ARE COORDINATED WITH THE LANDSCAPE/TREE MITIGATION PLANS. (MANUAL OF WATER WASTEWATER AND REUSE DESIGN STANDARDS AND SPECIFICATIONS, PART VI, SJCUD GENERAL NOTES).
5. CONTRACTOR TO LOCATE ALL EXISTING UTILITIES PRIOR TO CONSTRUCTION.

ORIENT DRIVE

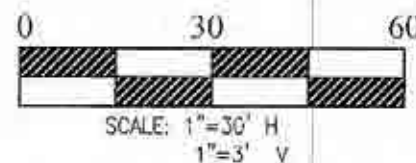

Manufacturer	#Turns to Open	Depth of Nut	Direction to Open
M+H	19.5	3.2"	Left

Point Table

Latitude	Longitude	PIPE ELEV. (feet)	FINAL GRADE (feet)	COVER (feet)	UTILITY TOP ELEVATION (feet)	UTILITY SIZE (inches)	SEPARATION
N29°56'31.80"	W81°26'21.39"	24.9	27.8	2.9	.	6"	.
N29°56'32.03"	W81°26'21.28"	25.1	27.8	2.7	.	6"	.
N29°56'32.80"	W81°26'21.93"	27.7	27.8	.	.	6"	.
N29°56'33.25"	W81°26'22.30"	24.6	28.0	3.4	.	6"	.
N29°56'33.67"	W81°26'22.67"	24.9	28.1	3.2	.	6"	.
N29°56'34.11"	W81°26'23.06"	26.0	28.3	2.3	.	6"	.

CONTRACTOR TO DEFLECT MAINS AROUND CURB INLET PER PIPE MANUFACTURERS SPECIFICATIONS

3"PVC (C900,DR25) FORCE MAIN

CURB AND GUTTER



CURB INLET U

AS-BUILT

INFORMATION PROVIDED BY:
 DATE: November 2017-January 2018
 NAME: Burnham Construction, Inc.
 ADDRESS: 11413 Enterprise East Blvd. Macclenny, Florida 32063
 PHONE NO: (904) 256-5360

I HEREBY CERTIFY THAT THE MATERIALS AND QUANTITIES USED IN CONSTRUCTION OF:

— Pavement	— Chilled Water
— Curb + Gutter	— [X] Reclaimed Water
— Storm + Drainage System	— Force Main
— Lake or Pond	— Sanitary Gravit

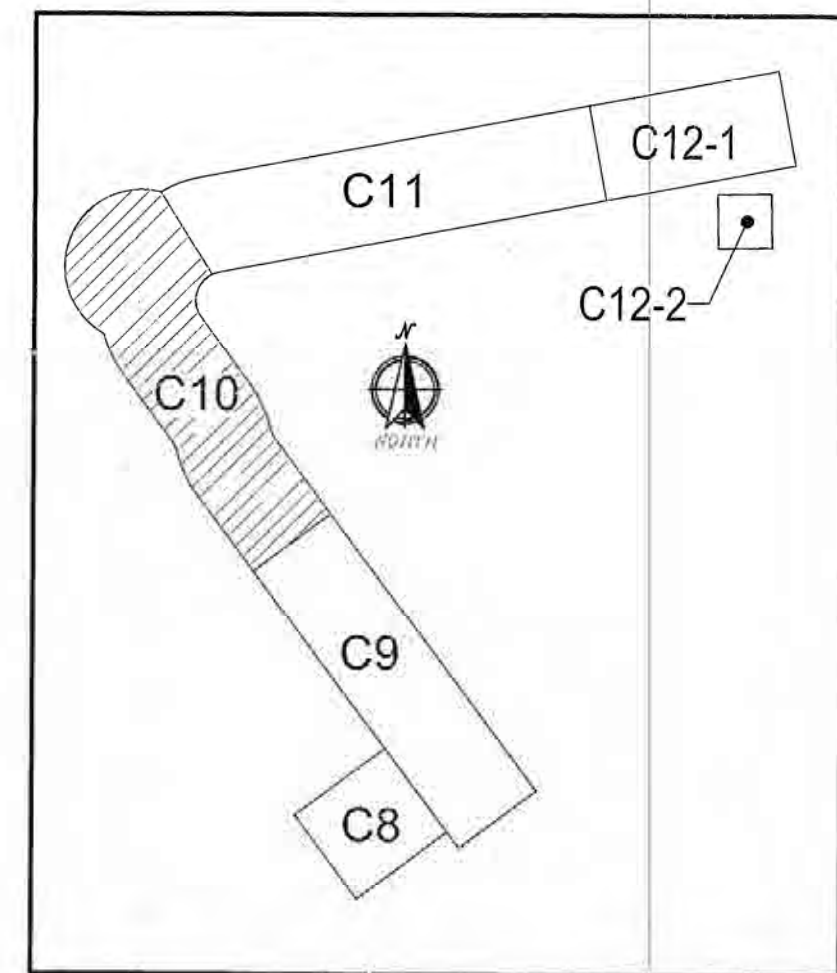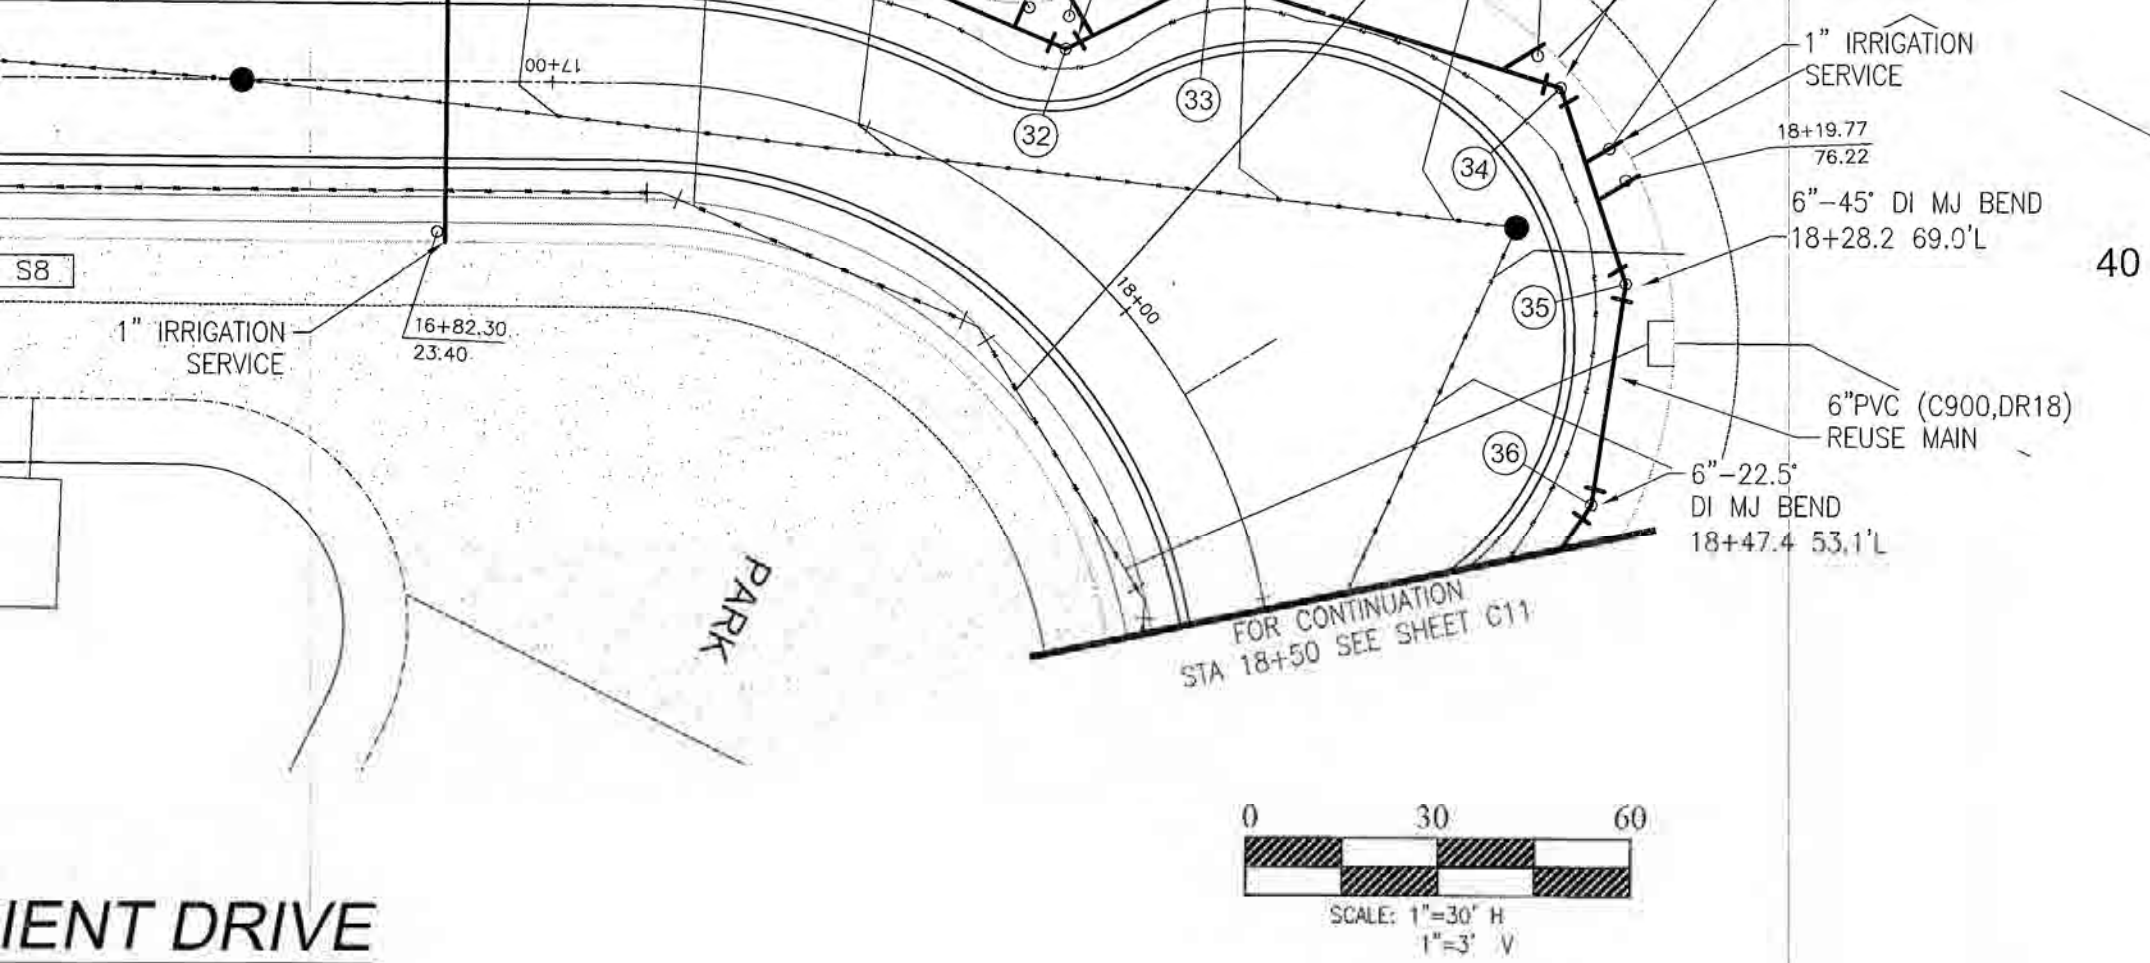

IENT DRIVE

Longitude	PIPE ELEV. (feet)	FINAL GRADE (feet)	COVER (feet)	UTILITY TOP ELEVATION (feet)	UTILITY SIZE (inches)	SEPARATION
81°26'23.83"	24.3	28.0	3.7	.	6"	.
81°26'23.85"	22.5	28.0	5.5	.	6"	.
81°26'23.93"	22.6	28.0	5.4	27.5	18" RCP	2.2'
81°26'24.01"	22.7	28.0	5.3	.	6"	.
81°26'24.01"	24.1	28.0	3.9	.	6"	.
81°26'24.29"	24.7	28.0	3.3	.	6"	.
81°26'24.58"	24.5	28.0	3.5	.	6"	.


AS-BUILT			
INFORMATION PROVIDED BY: DATE: November 2017-January 2018 NAME: Burnham Construction, Inc. ADDRESS: 11413 Enterprise East Blvd. Macedonia, Florida 32063 PHONE NO: (904) 256-5360			
I HEREBY CERTIFY THAT THE MATERIALS AND QUANTITIES USED IN THE CONSTRUCTION OF: <table border="0"> <tr> <td> <input type="checkbox"/> Pavement <input type="checkbox"/> Curb + Gutter <input type="checkbox"/> Storm + Drainage System <input type="checkbox"/> Lake or Pond <input type="checkbox"/> Underdrain Connections </td> <td> <input type="checkbox"/> Chilled Water <input checked="" type="checkbox"/> Reclaimed Water Main <input type="checkbox"/> Force Main <input type="checkbox"/> Sanitary Gravity System <input type="checkbox"/> Lift Station </td> </tr> </table>		<input type="checkbox"/> Pavement <input type="checkbox"/> Curb + Gutter <input type="checkbox"/> Storm + Drainage System <input type="checkbox"/> Lake or Pond <input type="checkbox"/> Underdrain Connections	<input type="checkbox"/> Chilled Water <input checked="" type="checkbox"/> Reclaimed Water Main <input type="checkbox"/> Force Main <input type="checkbox"/> Sanitary Gravity System <input type="checkbox"/> Lift Station
<input type="checkbox"/> Pavement <input type="checkbox"/> Curb + Gutter <input type="checkbox"/> Storm + Drainage System <input type="checkbox"/> Lake or Pond <input type="checkbox"/> Underdrain Connections	<input type="checkbox"/> Chilled Water <input checked="" type="checkbox"/> Reclaimed Water Main <input type="checkbox"/> Force Main <input type="checkbox"/> Sanitary Gravity System <input type="checkbox"/> Lift Station		
ARE IN ACCORDANCE WITH THE APPROVED PLANS AND JEA STANDARDS AND COUNTY SPECIFICATIONS, UNLESS OTHERWISE APPROVED BY THE REGULATORY AGENCY.			

INFORMATION PROVIDED BY: NAME: ADDRESS: PHONE NO:		
I HEREBY CERTIFY THAT THE MATERIALS AND QUANTITIES USED IN THE CONSTRUCTION OF: <table border="0"> <tr> <td> <input type="checkbox"/> Pavement <input type="checkbox"/> Curb + Gutter <input type="checkbox"/> Storm + Drainage System <input type="checkbox"/> Lake or Pond <input type="checkbox"/> Underdrain Connections </td> <td> <input type="checkbox"/> Chilled Water <input checked="" type="checkbox"/> Reclaimed Water Main <input type="checkbox"/> Force Main <input type="checkbox"/> Sanitary Gravity System <input type="checkbox"/> Lift Station </td> </tr> </table>	<input type="checkbox"/> Pavement <input type="checkbox"/> Curb + Gutter <input type="checkbox"/> Storm + Drainage System <input type="checkbox"/> Lake or Pond <input type="checkbox"/> Underdrain Connections	<input type="checkbox"/> Chilled Water <input checked="" type="checkbox"/> Reclaimed Water Main <input type="checkbox"/> Force Main <input type="checkbox"/> Sanitary Gravity System <input type="checkbox"/> Lift Station
<input type="checkbox"/> Pavement <input type="checkbox"/> Curb + Gutter <input type="checkbox"/> Storm + Drainage System <input type="checkbox"/> Lake or Pond <input type="checkbox"/> Underdrain Connections	<input type="checkbox"/> Chilled Water <input checked="" type="checkbox"/> Reclaimed Water Main <input type="checkbox"/> Force Main <input type="checkbox"/> Sanitary Gravity System <input type="checkbox"/> Lift Station	
ARE AT THE HORIZON "AS-BUILT" DRAWING SURVEYING AND MAPPING 5J-17.051 AND 5J-17.052		
ELECTRONIC DRAWING		



Point Table									
Stationing	Easting	Latitude	Longitude	PIPE ELEV. (feet)	FINAL GRADE (feet)	COVER (feet)	UTILITY TOP ELEVATION (feet)	UTILITY SIZE (inches)	SEPARATION
0.6	516723.1	N29°56'38.71"	W81°26'25.01"	25.9	28.7	2.8	.	6"	.
0.1	516755.9	N29°56'38.87"	W81°26'24.64"	25.6	28.7	3.1	.	6"	.
0	516723.1	N29°56'38.71"	W81°26'25.01"	25.9	28.7	2.8	.	6"	.

GATE VALVE NOTES:

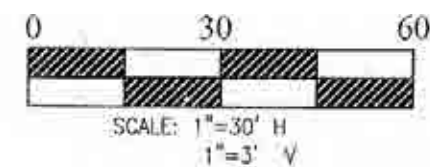


AS-BUILT

INFORMATION PROVIDED BY:
DATE:
NAME:
ADDRESS:

November 2017-January
Burnham Construction, Inc.
11413 Enterprise East
Macclenny, Florida 32058

ST. JOHNS COUNTY, FLORIDA

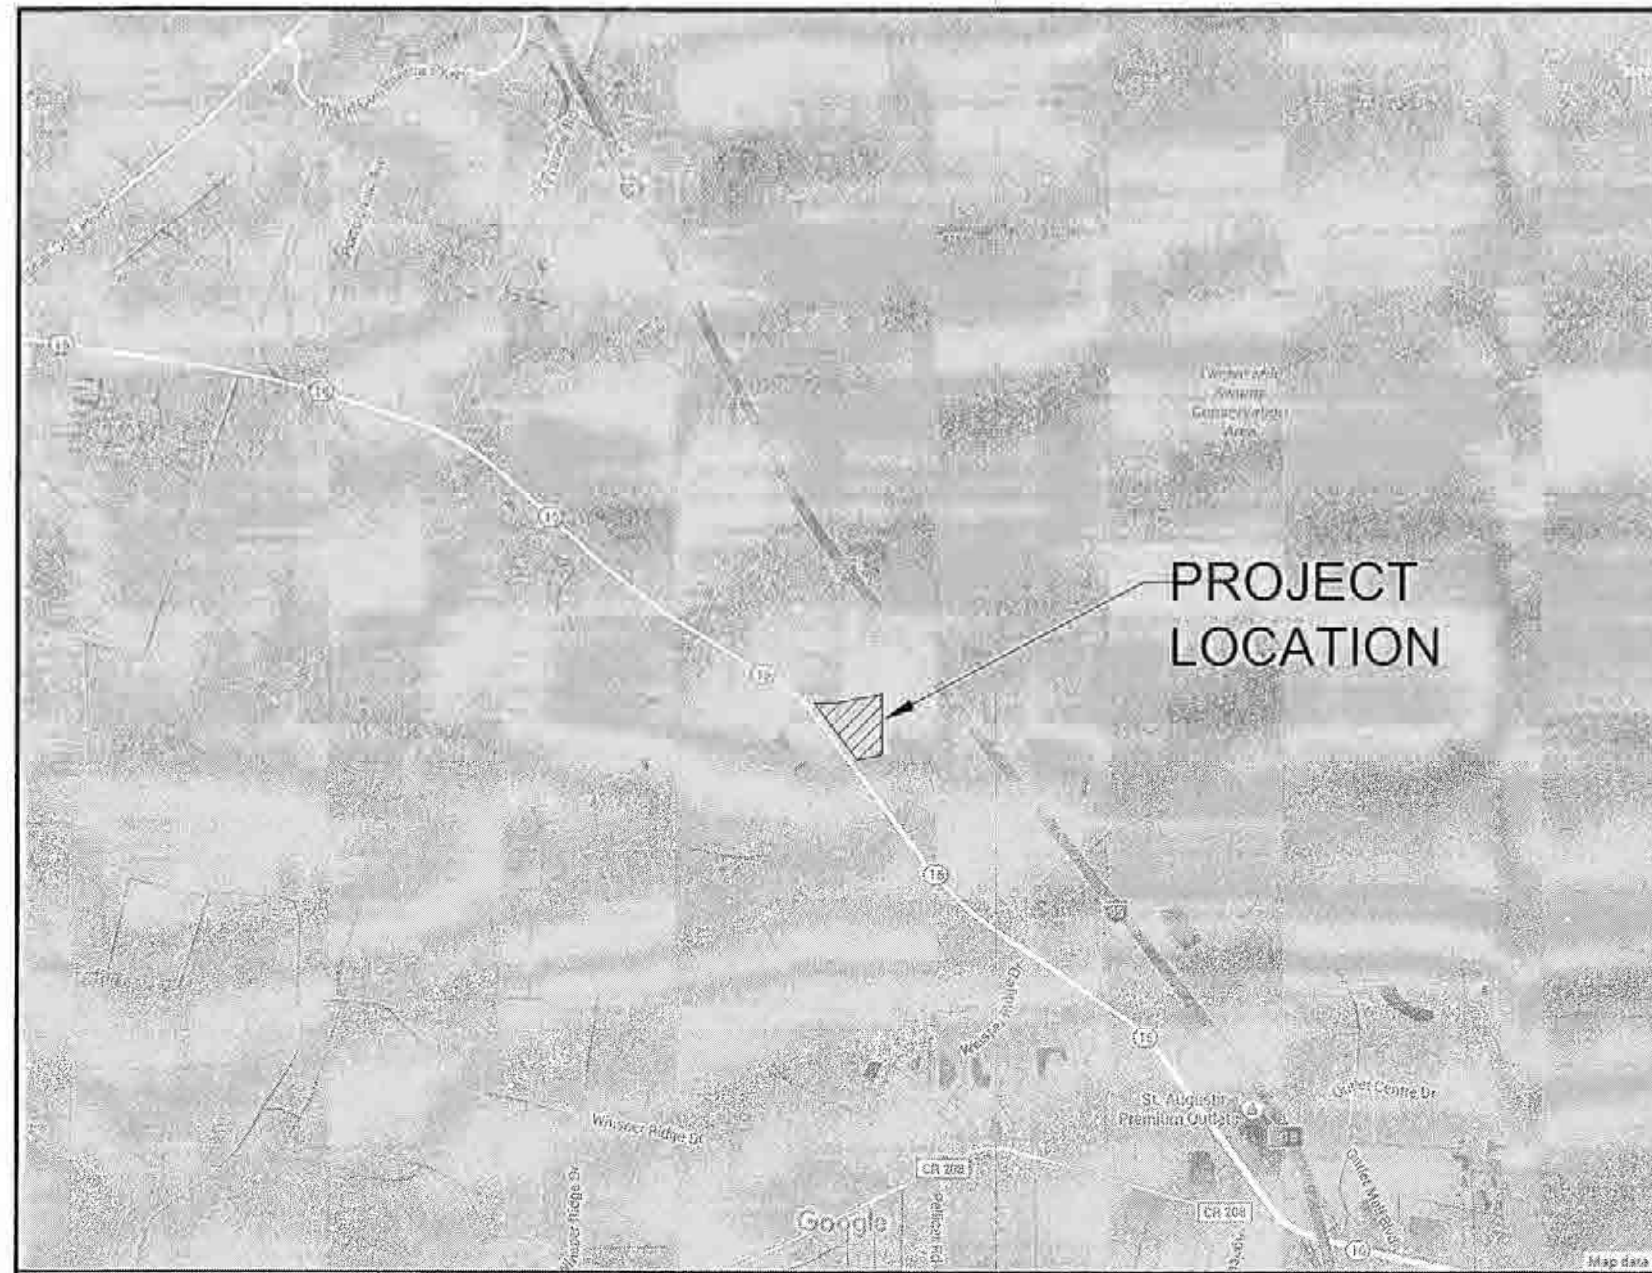

LOCATION MAP

N.T.S.

INDEX OF

T-1
C8-C12

INFORMATION PROVIDED BY:

DATE:

NAME:

ADDRESS:

PHONE NO:

I HEREBY CERTIFY THAT THE MATERIALS AND METHODS OF CONSTRUCTION OF:

— Pavement
— Curb + Cutter
— Storm + Drainage System
— Lake or Pond
— Underdrain Connections


K
PINE TREE
7.57



TOMOKA PINES DRIVE

FINAL GRADE (feet)	COVER (feet)	UTILITY TOP ELEVATION (feet)	UTILITY SIZE (Inches)	SEPARATION
28.1	2.6		8"	
27.9	2.4		8"	
27.6	3.1	23.1	24"HDPE	0.7'
27.9	3.7		8"	
27.9	3.1		8"	
28.1	3.6		8"	
28.1	3.0		6"	
28.1			6"	
27.7	2.6	23.8	15" RCP	0.6'


Point Table											
Point #	Description	Northing	Easting	Latitude	Longitude	PIPE ELEV. (feet)	FINAL GRADE (feet)	COVER (feet)	UTILITY TOP ELEVATION (feet)	UTILITY SIZE (Inches)	SEPARATION
53	top.10x8.reducer	2039017.5	516941.1	N29°56'30.35"	W81°26'22.49"	23.8	26.9	3.1		10"	
54	CONFLICT	2039005.1	516921.6	N29°56'30.23"	W81°26'22.71"	18.0	25.5	7.5	20.1	12" FM	1.1'
55	CONFLICT	2038997.1	516915.2	N29°56'30.15"	W81°26'22.79"	17.6	25.3	7.7	22.8	8" RU	4.5'
56	CONFLICT	2038990.0	516906.2	N29°56'30.08"	W81°26'22.89"	15.8	23.5	7.7	26.8	30"x60" ERCP	7.6'
57	top.10x8.reducer	2038940.3	516843.3	N29°56'29.59"	W81°26'23.60"	19.6	27.3	7.7		10"	
58	top.valve.8in	2038939.0	516841.7	N29°56'29.57"	W81°26'23.62"	21.0	23.9	2.9		8"	
59	top.wl.45bend	2038937.8	516840.2	N29°56'29.56"	W81°26'23.64"	19.5	23.9	4.4		8"	
60	top.wl.45bend	2038931.2	516831.8	N29°56'29.49"	W81°26'23.73"	17.8	23.9	6.1		8"	
61	top.tap.sleeve	2038910.2	516805.1	N29°56'29.29"	W81°26'24.03"	18.0	25.6	7.6		8"	
62	top.valve.8in	2039105.1	517055.0	N29°56'31.23"	W81°26'21.20"	25.8	28.1	2.3		8"	

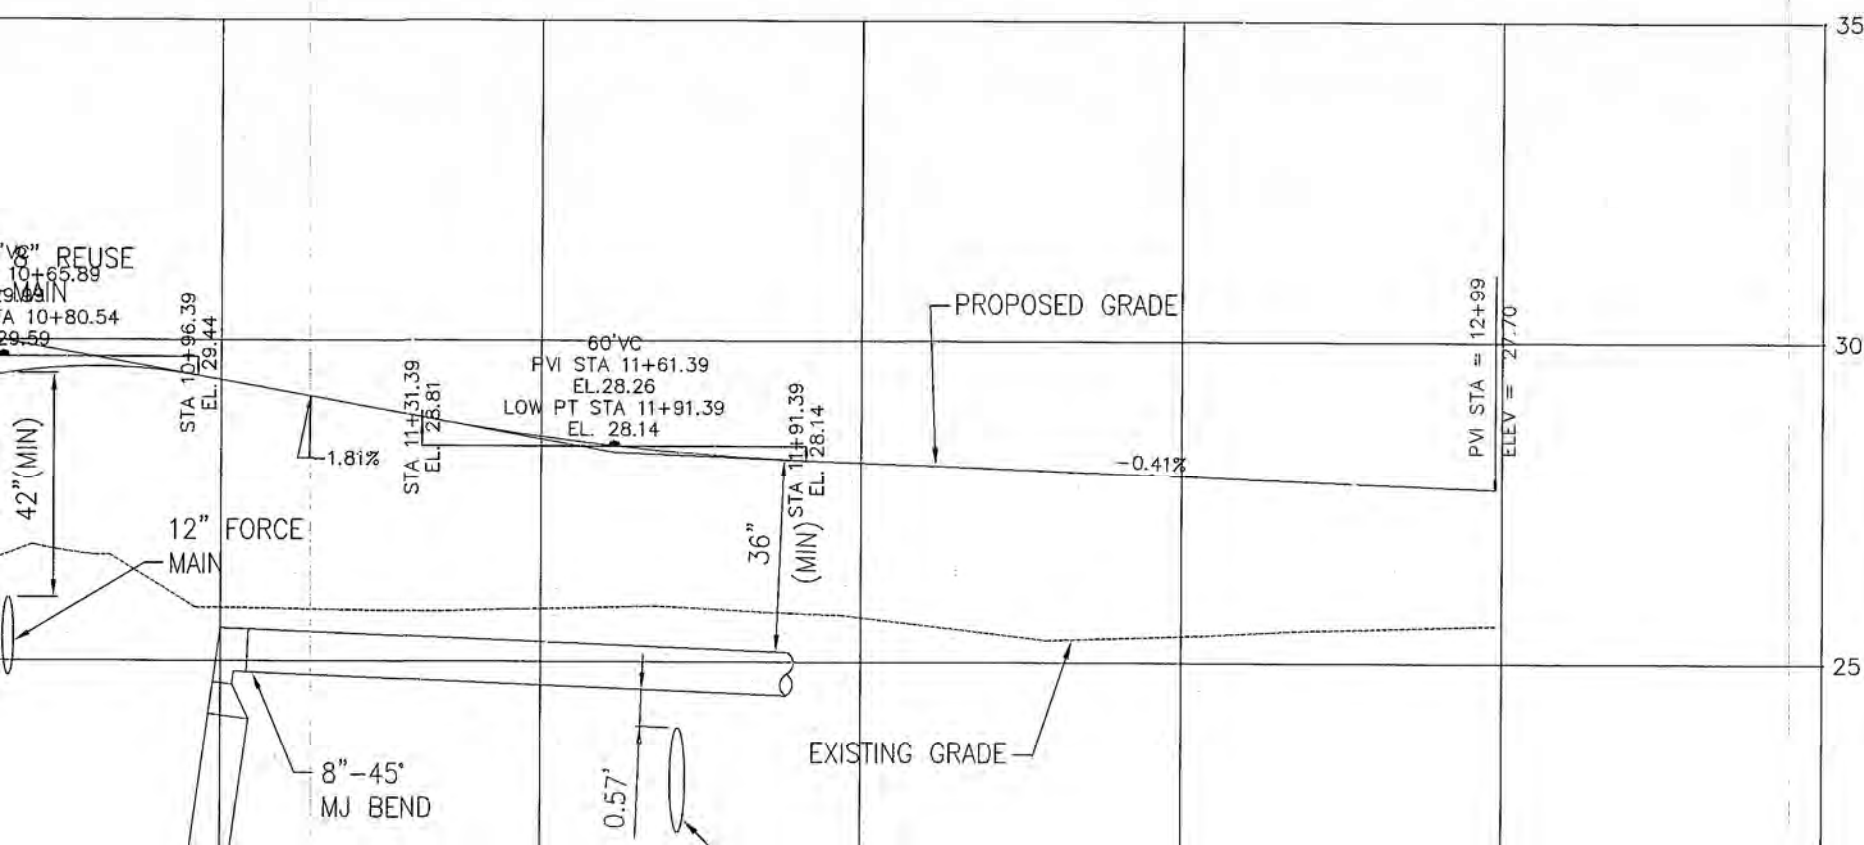

Hydrant Number	Manufa
48	M+H

Valve Number	Size	Type	Manufacturer
47	6"	Gate	M+H
58	8"	Gate	M+H
62	8"	Gate	M+H

AS-BUILT	
INFORMATION PROVIDED BY:	
DATE:	November 2017-January 2018
NAME:	Burnham Construction, Inc.
ADDRESS:	11113 E...

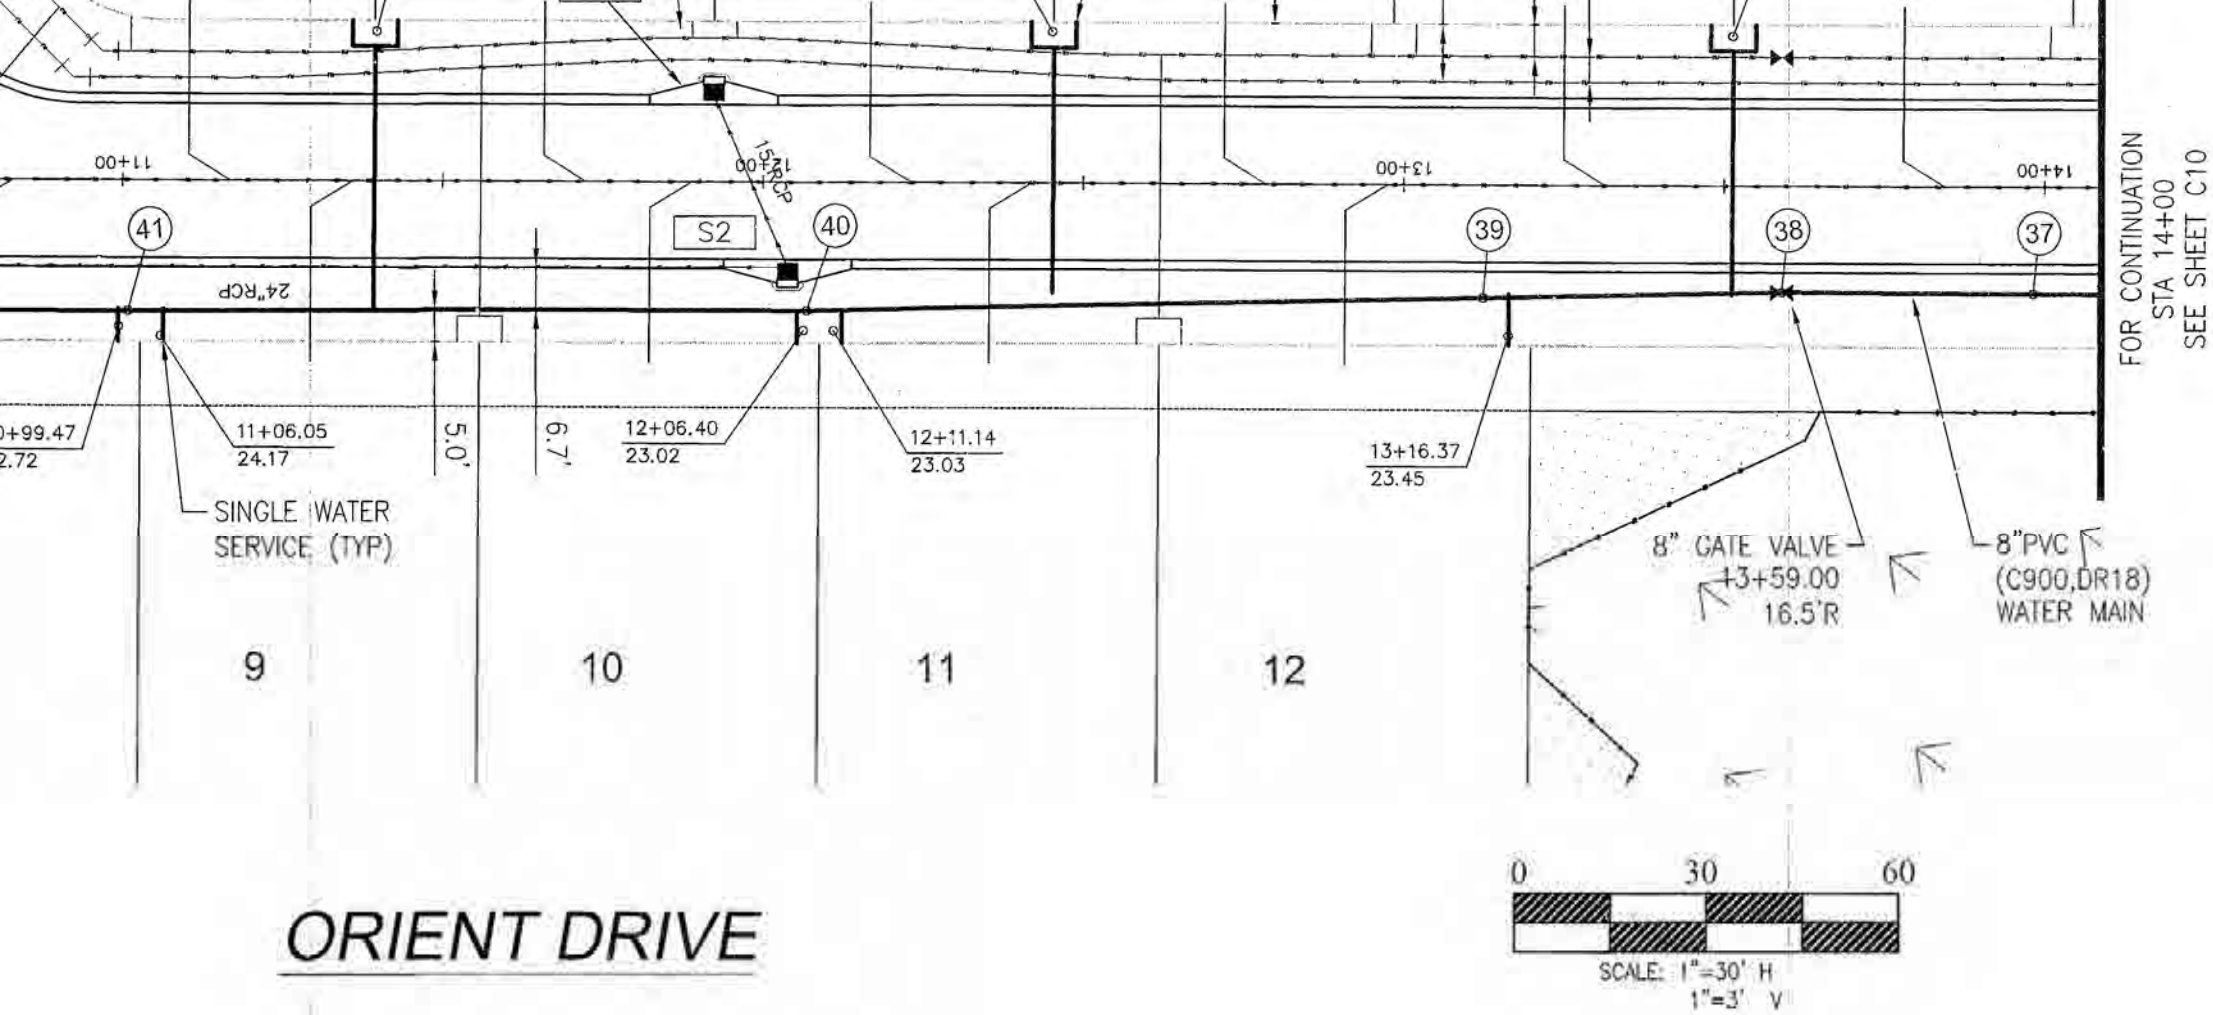

ORIENT DRIVE

1. AREAS DISTURBED IN FDOT RIGHT OF WAY SHALL BE SODDED.
2. HOUSE WATER METER SIZES, SHALL BE 5/8" MINIMUM.
3. ALL WATER AND SEWER CONSTRUCTION SHALL COMPLY WITH THE LATEST SJCUD CONSTRUCTION STANDARDS AND SPECIFICATIONS.
4. IT IS THE REQUIREMENT OF SJCUD THAT WHEN TREES ARE TO BE PLANTED OR TO REMAIN LOCATED NEAR PUBLIC ROADS, OWNED OR MAINTAINED PROPOSED OR EXISTING UTILITY LINES, THAT THE TREES MUST NOT BE WITHIN 7.5 FEET (BOTH WAYS) FROM THE CENTERLINE OF THE PROPOSED EXISTING UTILITY LINE. PLEASE ENSURE THAT THE UTILITY CONSTRUCTION PLANS ARE COORDINATED WITH THE LANDSCAPE/TREE MITIGATION PLANS. (MANUAL OF WATER WASTEWATER AND REUSE DESIGN STANDARDS AND SPECIFICATIONS, PART VI, SJCUD GENERAL NOTES).
5. CONTRACTOR TO LOCATE ALL EXISTING UTILITIES PRIOR TO CONSTRUCTION.

CONTRACTOR TO DEFLECT MAINS AROUND CURB INLET PER PIPE MANUFACTURERS SPECIFICATIONS

3" PVC (C900, DR25) FORCE MAIN

CURB AND GUTTER

CURB INLET U

Point Table



Northing	Easting	Latitude	Longitude	PIPE ELEV. (feet)	FINAL GRADE (feet)	COVER (feet)	UTILITY TOP ELEVATION (feet)	UTILITY SIZE (inches)	SEPARATION
2039451.8	516889.6	N29°56'34.65"	W81°26'23.00"	24.9	28.2	3.3	.	8"	.
2039420.3	516922.0	N29°56'34.34"	W81°26'22.73"	26.3	28.2	1.9	.	8"	.
2039383.6	516950.7	N29°56'33.98"	W81°26'22.40"	24.8	28.2	3.4	.	8"	.
2039300.5	517015.7	N29°56'33.16"	W81°26'21.66"	25.0	27.8	2.8	.	8"	.
2039215.8	517079.4	N29°56'32.32"	W81°26'20.93"	25.5	28.1	2.6	.	8"	.
2039145.7	517132.0	N29°56'31.63"	W81°26'20.33"	24.5	27.9	2.4	.	8"	.
2039139.6	517123.5	N29°56'31.57"	W81°26'20.43"	24.5	27.6	3.1	23.1	24" HDPE	0.7'

AS-BUILT

INFORMATION PROVIDED BY:
 DATE: November 2017-January 2018
 NAME: Burnham Construction, Inc.
 ADDRESS: 11413 Enterprise East Blvd. Macclenny, Florida 32063
 PHONE NO: (904) 256-5360

I HEREBY CERTIFY THAT THE MATERIALS AND QUANTITIES USED IN CONSTRUCTION OF:

— Pavement	— Chilled Water
— Curb + Gutter	— X Water Main
— Storm + Drainage System	— Reclaimed Water
— Lake or Pond	— Force Main
— Underdrain Connections	— Sanitary Gravity
	— 18" Shotcrete

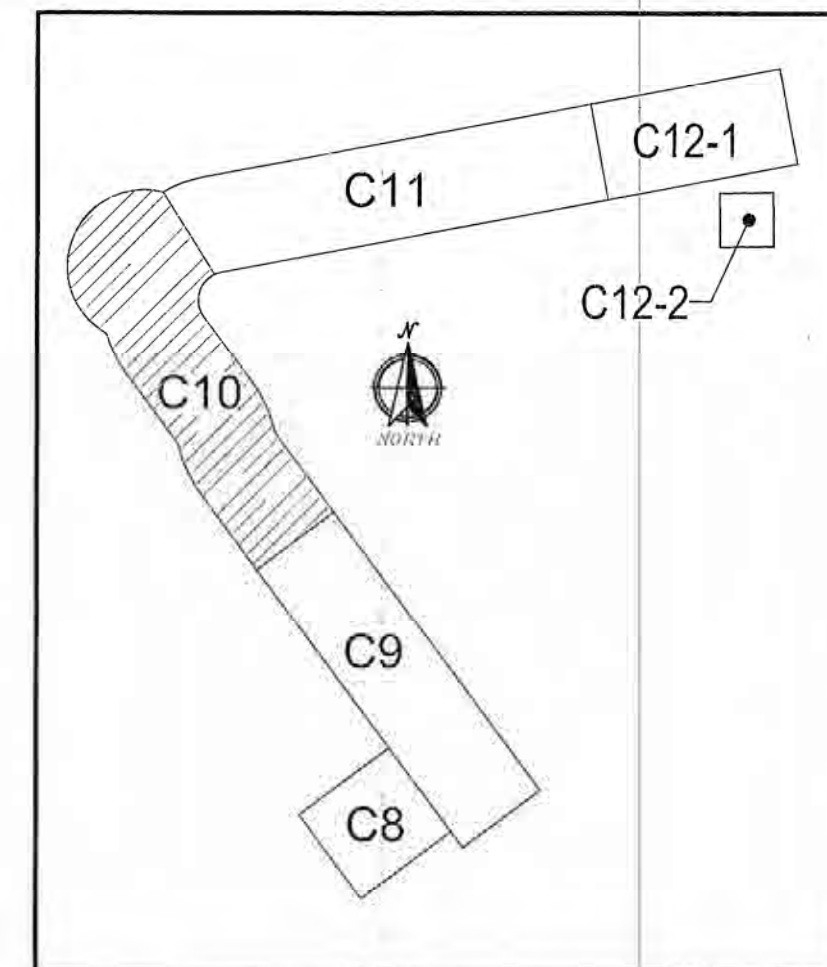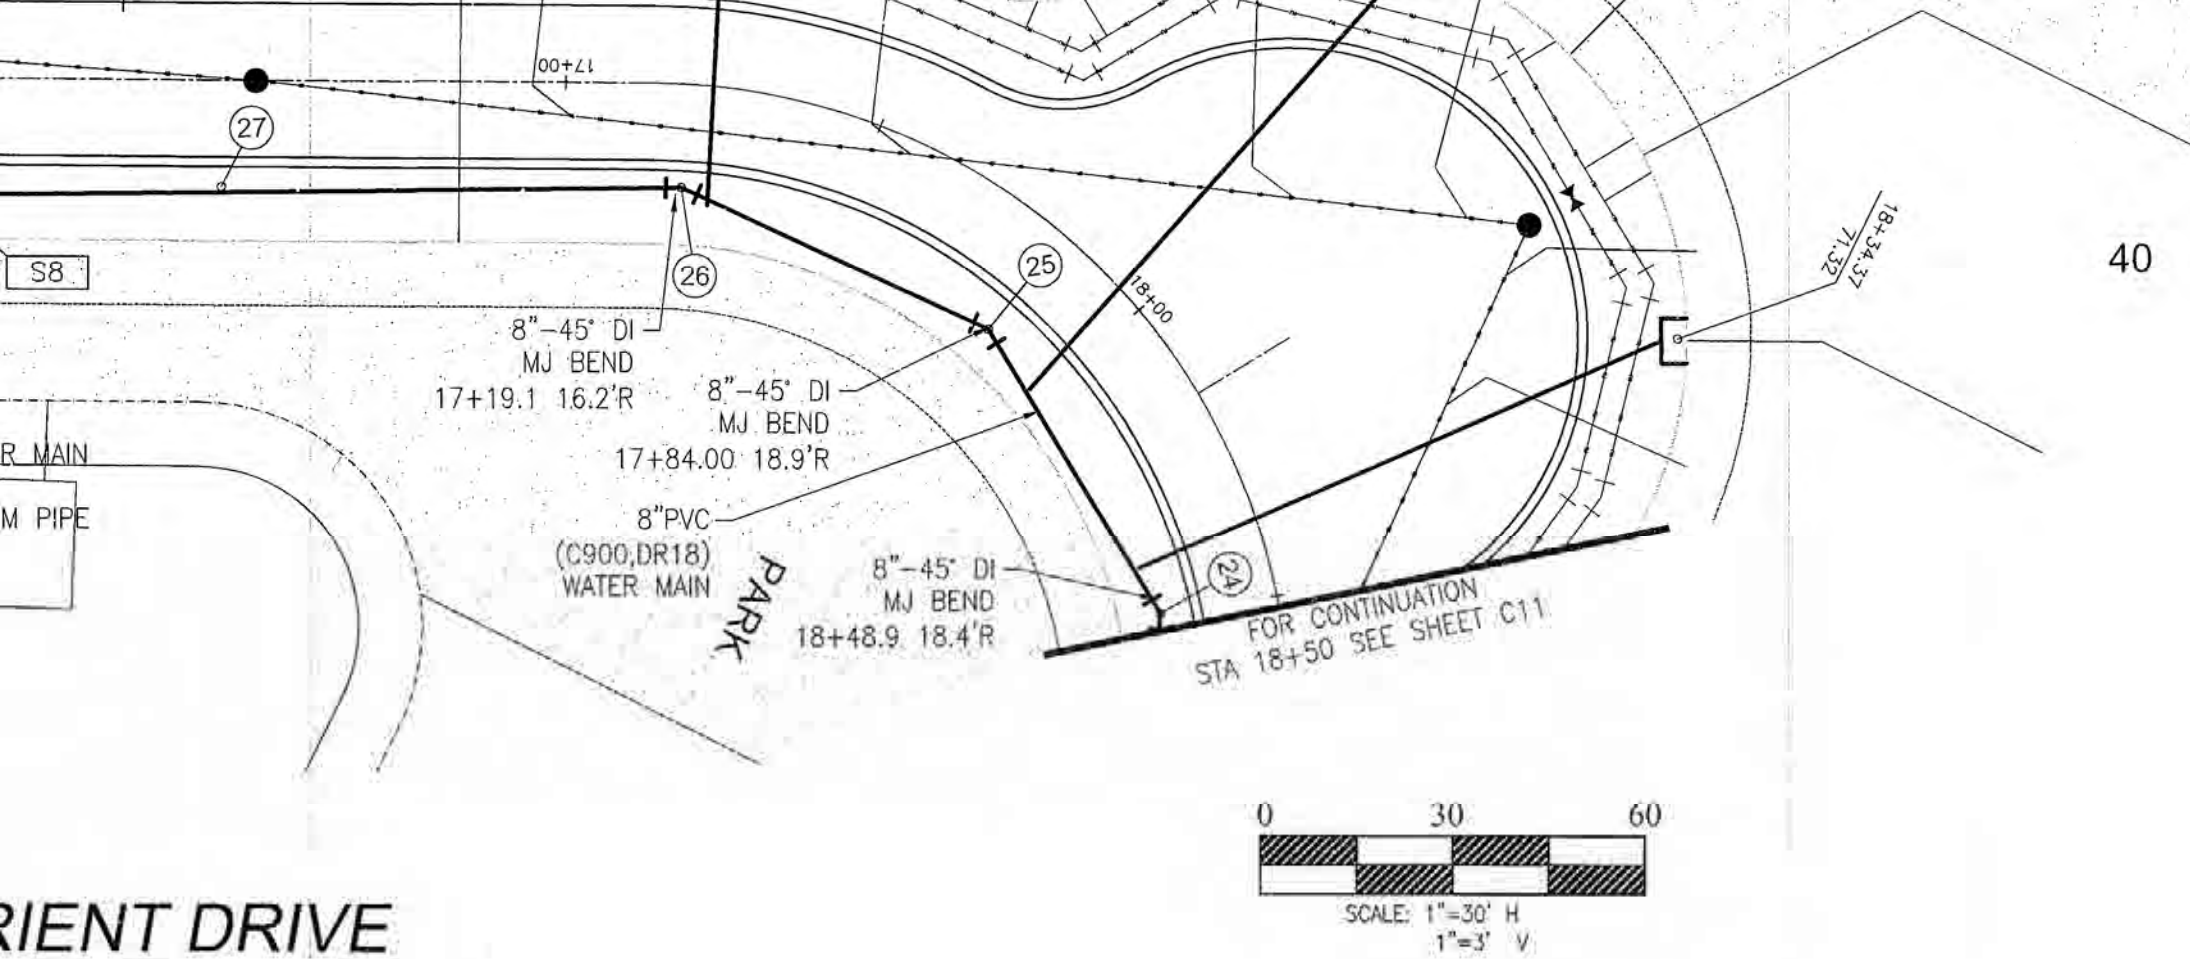


Hydrant Number	Manufacturer	Date of Manufacture and Installation
52	M+H	2017/2018

Type	Manufacturer	#Turns to Open	Depth of Nut	Direction to Open
Gate	M+H	19.5	2.0'	Left

Point Table								
Easting	Latitude	Longitude	PIPE ELEV. (feet)	FINAL GRADE (feet)	COVER (feet)	UTILITY TOP ELEVATION (feet)	UTILITY SIZE (inches)	SEPARATION
516728.5	N29°56'38.25"	W81°26'24.94"	25.6	28.8	3.2	.	8"	.
516709.4	N29°56'37.77"	W81°26'25.16"	25.6	28.7	3.1	.	8"	.
516720.7	N29°56'37.26"	W81°26'25.03"	24.7	28.5	3.8	.	8"	.

AS-BUILT			
INFORMATION PROVIDED BY:	DATE: November 2017-January 2018 NAME: Burnham Construction, Inc. ADDRESS: 11413 Enterprise East Blvd. Macedonia, Florida 32063 PHONE NO: (904) 256-5360		
I HEREBY CERTIFY THAT THE MATERIALS AND QUANTITIES USED IN THE CONSTRUCTION OF: <table border="0"> <tr> <td> <input type="checkbox"/> Pavement <input type="checkbox"/> Curb + Gutter <input type="checkbox"/> Sorm + Drainage System <input type="checkbox"/> Lake or Pond <input type="checkbox"/> Underdrain Connections </td> <td> <input checked="" type="checkbox"/> Chilled Water <input type="checkbox"/> Water Main <input type="checkbox"/> Reclaimed Water Main <input type="checkbox"/> Force Main <input type="checkbox"/> Sanitary Gravity System <input type="checkbox"/> Lift Station </td> </tr> </table>		<input type="checkbox"/> Pavement <input type="checkbox"/> Curb + Gutter <input type="checkbox"/> Sorm + Drainage System <input type="checkbox"/> Lake or Pond <input type="checkbox"/> Underdrain Connections	<input checked="" type="checkbox"/> Chilled Water <input type="checkbox"/> Water Main <input type="checkbox"/> Reclaimed Water Main <input type="checkbox"/> Force Main <input type="checkbox"/> Sanitary Gravity System <input type="checkbox"/> Lift Station
<input type="checkbox"/> Pavement <input type="checkbox"/> Curb + Gutter <input type="checkbox"/> Sorm + Drainage System <input type="checkbox"/> Lake or Pond <input type="checkbox"/> Underdrain Connections	<input checked="" type="checkbox"/> Chilled Water <input type="checkbox"/> Water Main <input type="checkbox"/> Reclaimed Water Main <input type="checkbox"/> Force Main <input type="checkbox"/> Sanitary Gravity System <input type="checkbox"/> Lift Station		
ARE IN ACCORDANCE WITH THE APPROVED PLANS AND JEA STANDARDS AND COUNTY SPECIFICATIONS, UNLESS OTHERWISE APPROVED BY THE REGULATORY AGENCY.			

INFORMATION PROVIDED BY:	NAME: ADDRESS: PHONE:		
I HEREBY CERTIFY THAT THE MATERIALS AND QUANTITIES USED IN THE CONSTRUCTION OF: <table border="0"> <tr> <td> <input type="checkbox"/> Pavement <input type="checkbox"/> Curb + Gutter <input type="checkbox"/> Sorm + Drainage System <input type="checkbox"/> Lake or Pond <input type="checkbox"/> Underdrain Connections </td> <td> <input type="checkbox"/> Chilled Water <input type="checkbox"/> Water Main <input type="checkbox"/> Reclaimed Water Main <input type="checkbox"/> Force Main <input type="checkbox"/> Sanitary Gravity System <input type="checkbox"/> Lift Station </td> </tr> </table>		<input type="checkbox"/> Pavement <input type="checkbox"/> Curb + Gutter <input type="checkbox"/> Sorm + Drainage System <input type="checkbox"/> Lake or Pond <input type="checkbox"/> Underdrain Connections	<input type="checkbox"/> Chilled Water <input type="checkbox"/> Water Main <input type="checkbox"/> Reclaimed Water Main <input type="checkbox"/> Force Main <input type="checkbox"/> Sanitary Gravity System <input type="checkbox"/> Lift Station
<input type="checkbox"/> Pavement <input type="checkbox"/> Curb + Gutter <input type="checkbox"/> Sorm + Drainage System <input type="checkbox"/> Lake or Pond <input type="checkbox"/> Underdrain Connections	<input type="checkbox"/> Chilled Water <input type="checkbox"/> Water Main <input type="checkbox"/> Reclaimed Water Main <input type="checkbox"/> Force Main <input type="checkbox"/> Sanitary Gravity System <input type="checkbox"/> Lift Station		
ARE AT THE HO... 'AS-BUILT' DRAW... SURVEYING AND... 5J-17.051 AND...			
ELECTRONIC DR... FILE DATE:			

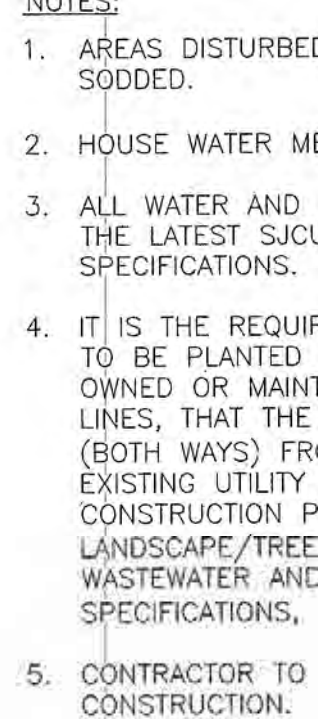


0 30 60

SCALE: 1" = 30' H
1" = 3' V

Size	Type	Manufacturer	#Turns to Open	Depth of Nut	Direction to Open
6"	Gate	M+H	29.5	2.2'	Left
8"	Gate	M+H	25.5	2.0'	Left

Point Table									
				PIPE	FINAL	COVER	UTILITY TOP	UTILITY	SEPARATION

		AS-BUILT
INFORMATION PROVIDED BY:		November 2017-January 2018
DATE:		Burnham Construction
NAME:		11413 Enterprise East
ADDRESS:		Macedonia, Florida
PHONE NO:		(904) 256-5360

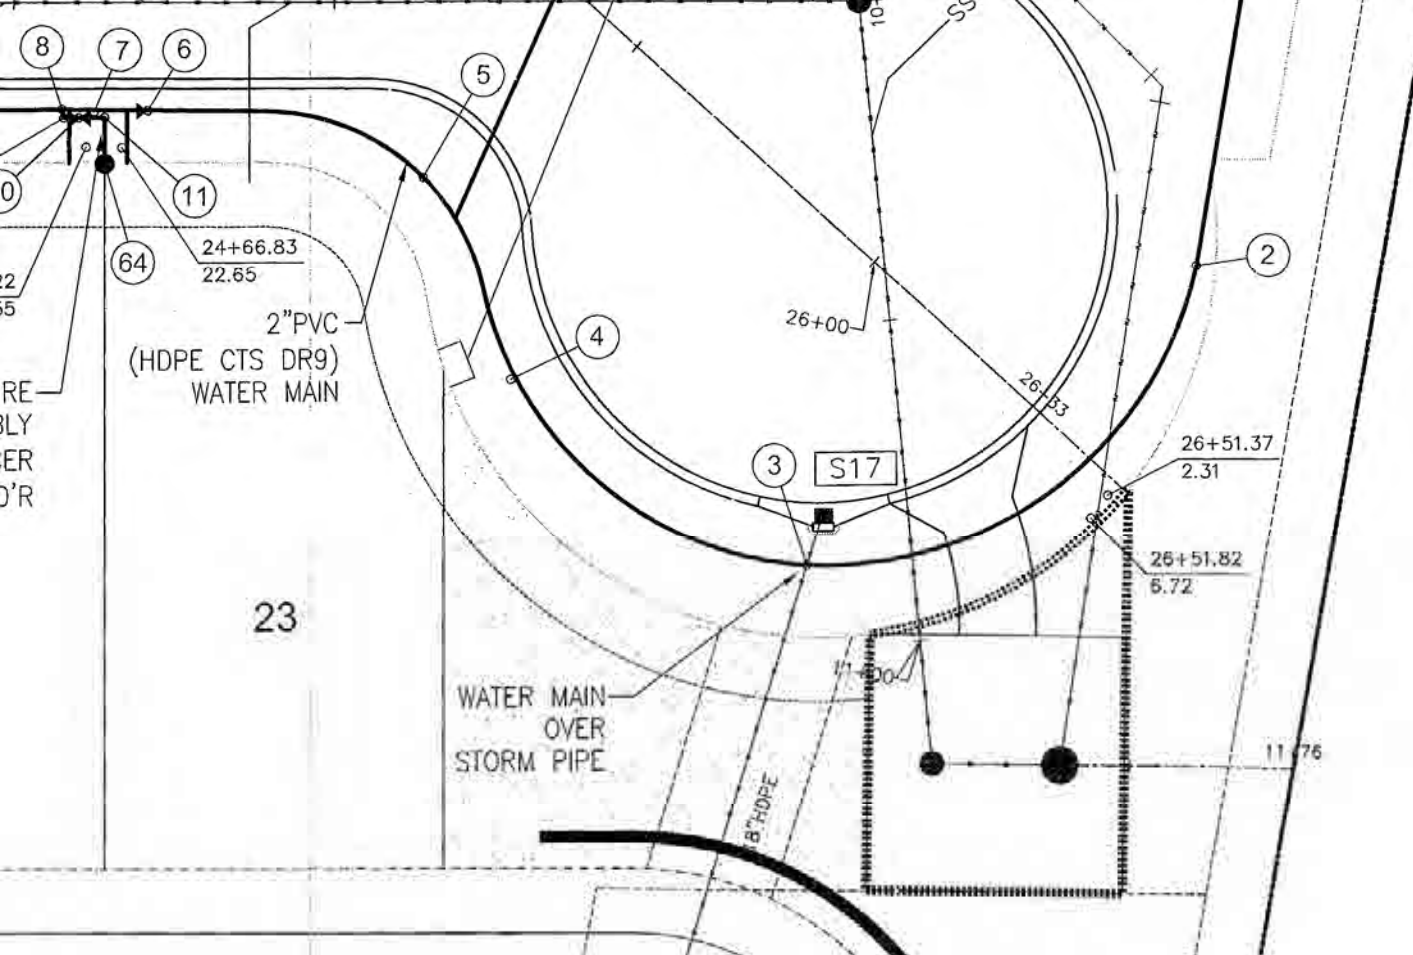

ORIENT DRIVE-1

Hydrant Number	Manufacturer	Date of Manufacture and Installation
64	M+H	2017/2018

er	Size	Type	Manufacturer	#Turns to Open	Depth of Nut	Direction to Open
	6"	Gate	M+H	19.5	1.9'	Left

Point Table


INFORMATION PROVIDED
DATE:
NAME:
ADDRESS:
PHONE NO:

2021 NW Grand Oaks Phase 1


As Built Drawings



PROJECT LOCATION

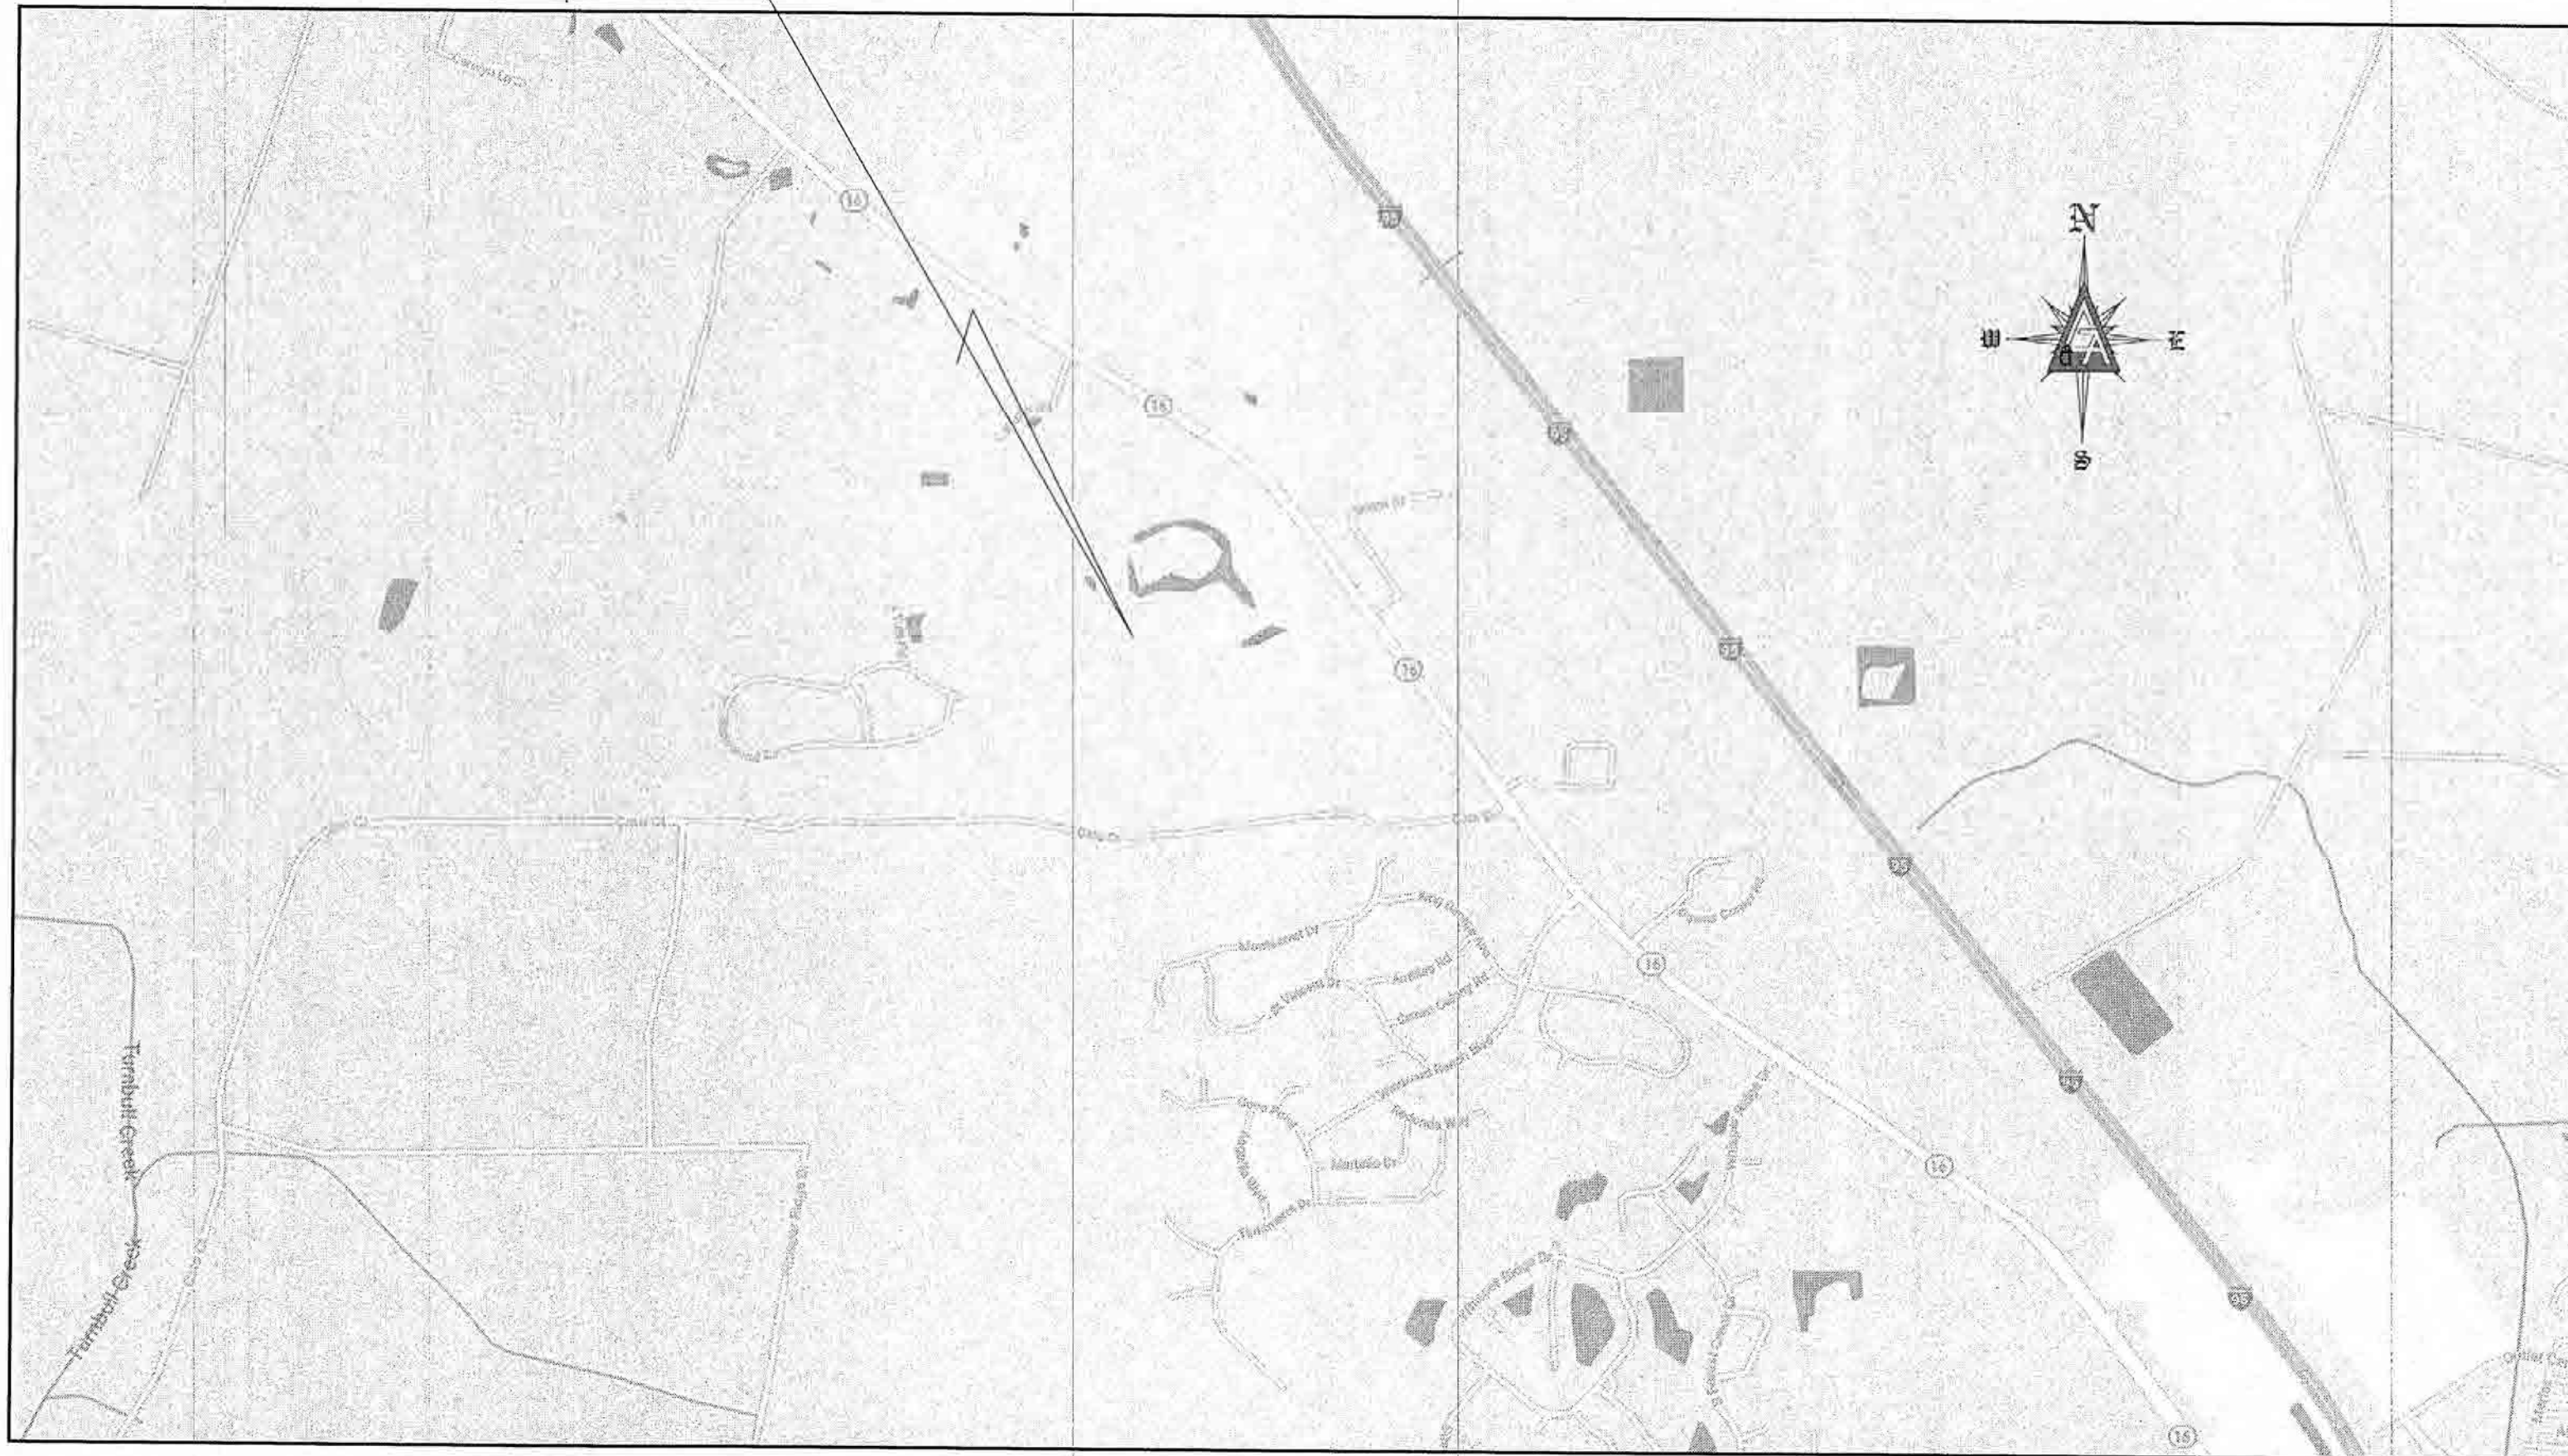

LOCATION MAP
(NOT TO SCALE)

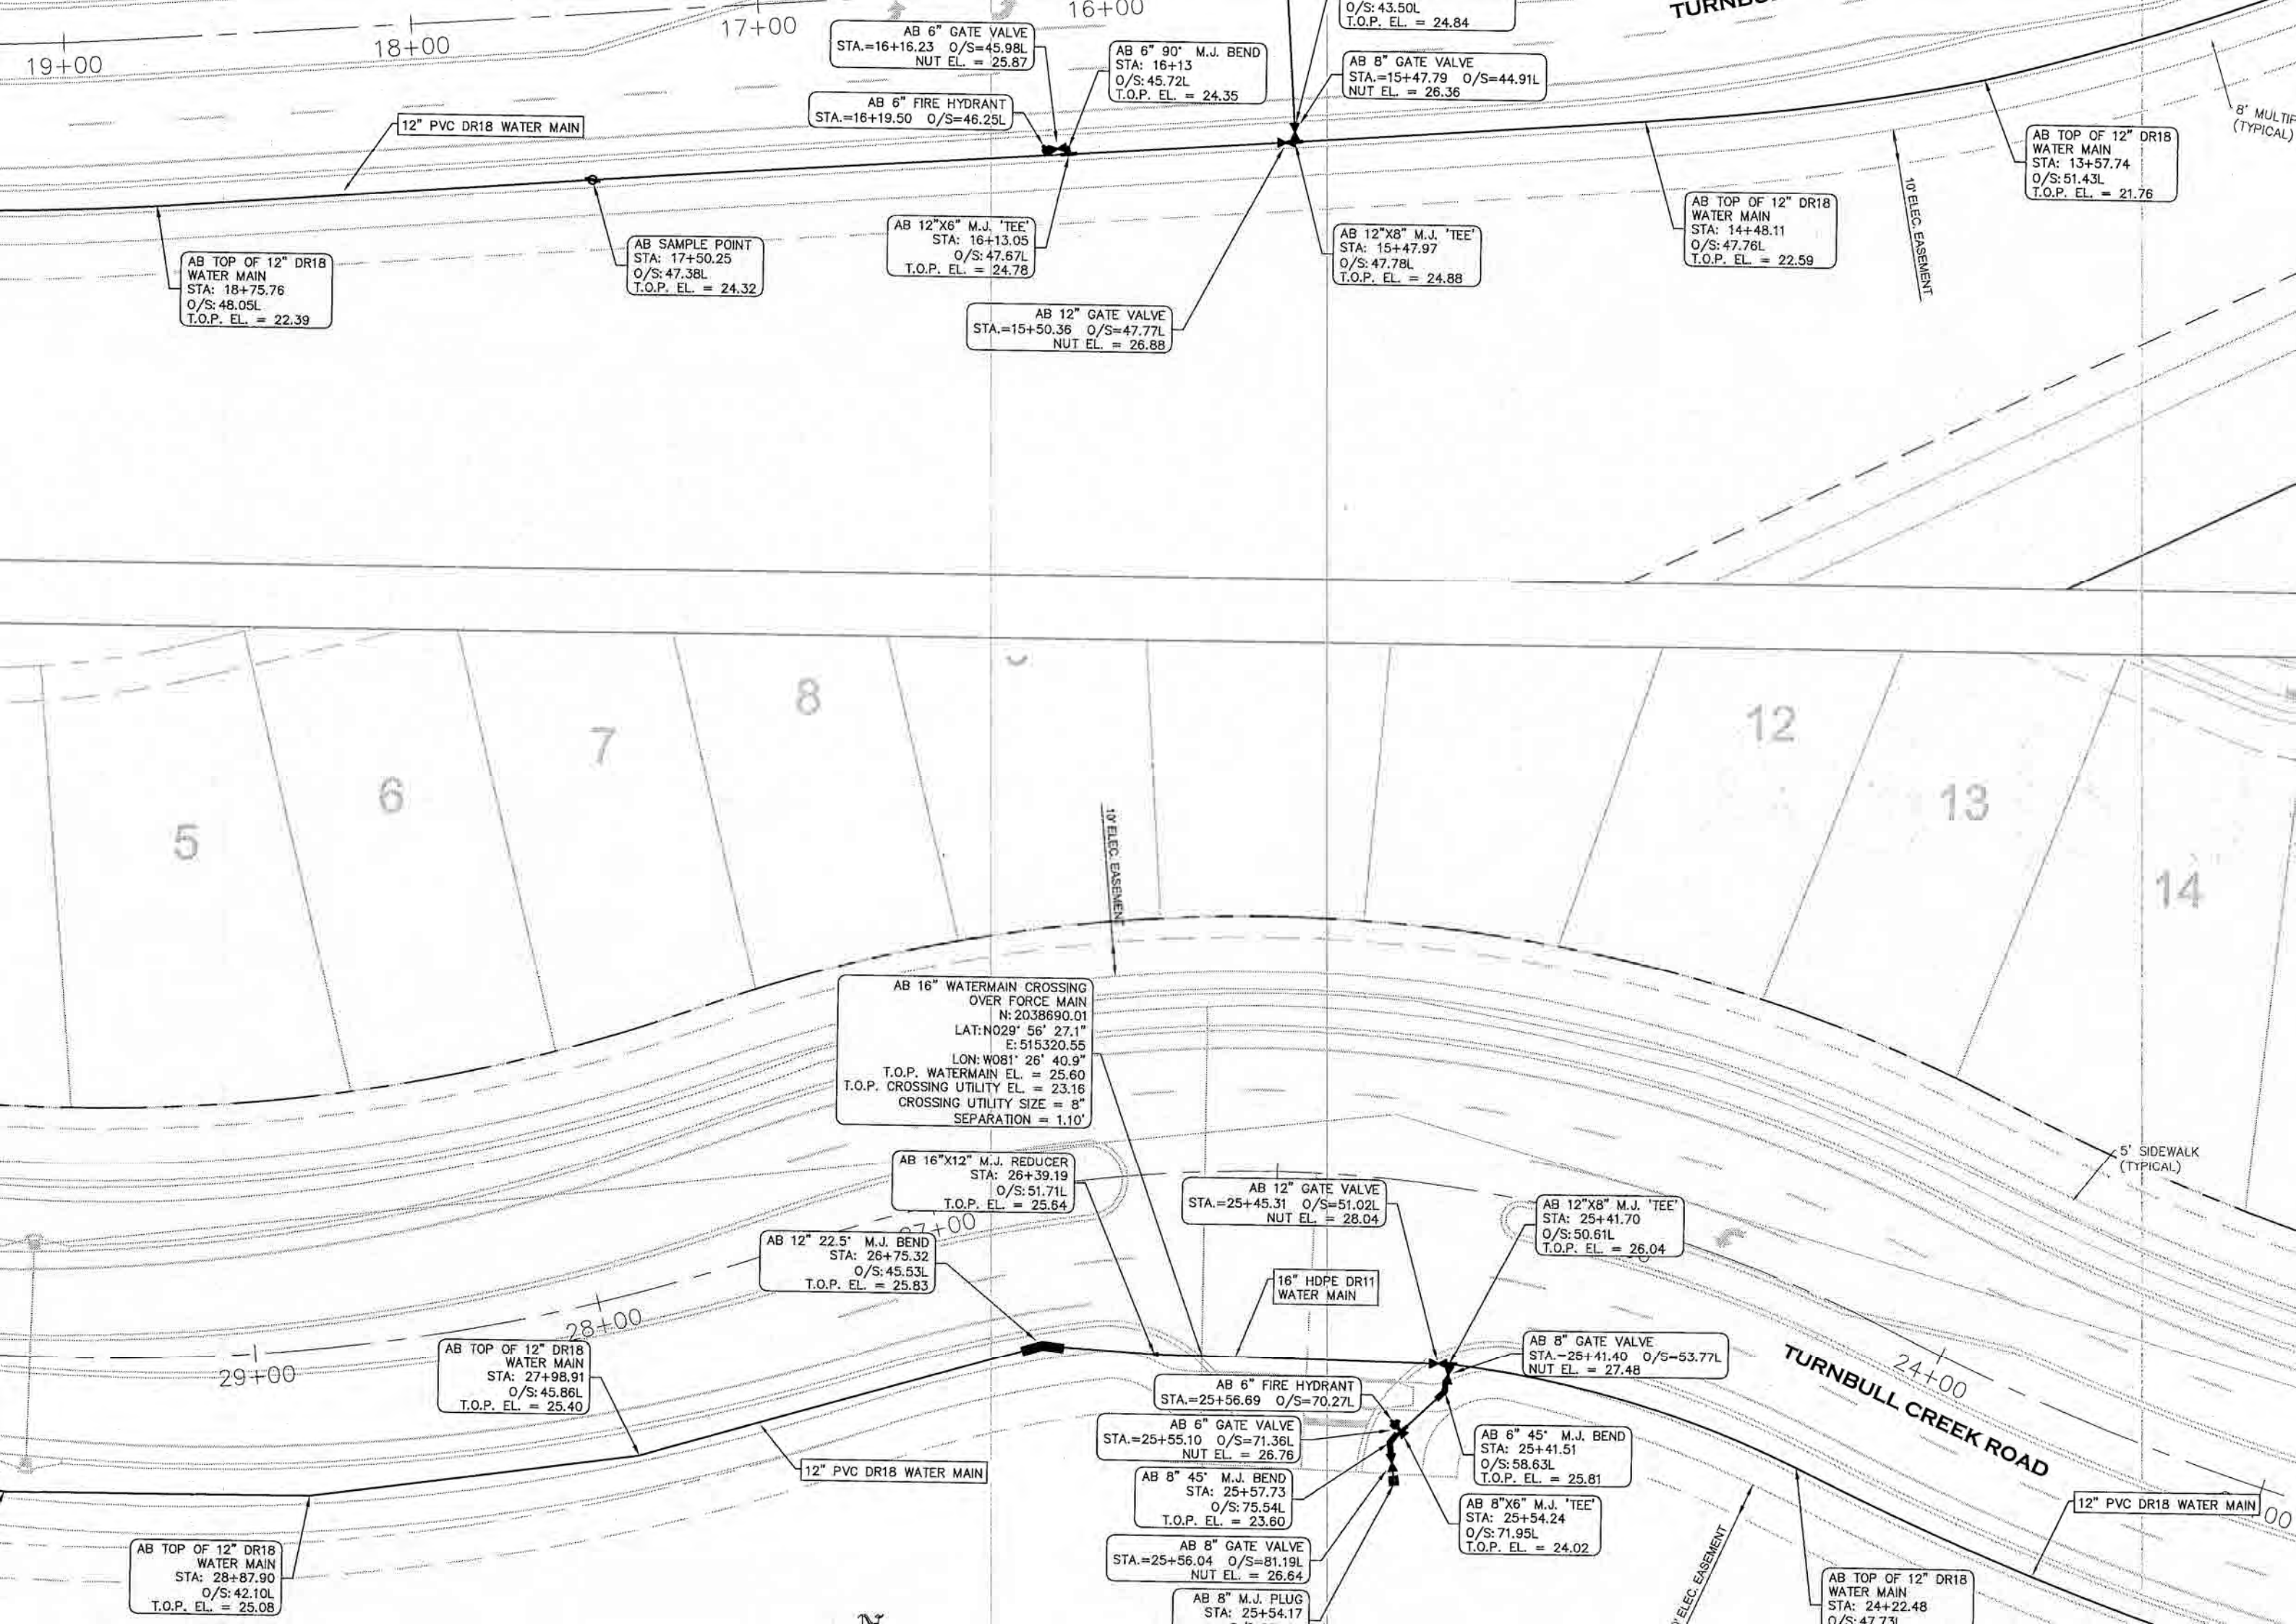

IPURPOSE PATH
(TYPICAL)

AB TOP OF 12" DR18
WATER MAIN
STA: 41+16.97
O/S: 25.46L
T.O.P. EL. = 22.95

STA.=40+07.52 O/S=21.14L

AB 6" GATE VALVE
STA.=40+07.39 O/S=22.40L
NUT EL. = 24.32

AB 16"x12" M.J. ADAPTER
HDPE TO PVC
STA: 38+56.29
O/S: 23.82L
T.O.P. EL. = 24.22

16" HDPE DR11
WATER MAIN

AB 8" GATE VALVE
STA.=38+02.32 O/S=27.32L
NUT EL. = 24.96

8" PVC DR18 WATER MAIN

AB 8"x6" M.J. 'TEE'
STA: 38+00.84
O/S: 63.95L
T.O.P. EL. = 22.77

AB 8" M.J. PLUG
STA: 38+01.53
O/S: 81.38L
T.O.P. EL. = 25.15

AB 6" FIRE HYDRANT
STA.=38+12.98 O/S=64.73L

AB 6" GATE VALVE
STA.=38+03.41 O/S=64.12L
NUT EL. = 25.25

AB 12"x6" M.J. 'TEE'
STA: 40+07.12
O/S: 25.11L
T.O.P. EL. = 23.30

AB TOP OF 12" DR18
WATER MAIN
STA: 39+67.09
O/S: 25.00L
T.O.P. EL. = 23.41

AB 12" WATERMAIN CROSSING
OVER REUSE
N: 2038904.70
LAT: N029° 56' 29.1"
E: 514136.84
LON: W081° 26' 54.4"
T.O.P. WATERMAIN EL. = 24.22
T.O.P. CROSSING UTILITY EL. = 19.77
CROSSING UTILITY SIZE = 4"
SEPARATION = 3.45'

AB 12" WATERMAIN CROSSING
OVER STORM
N: 2038858.98
LAT: N029° 56' 28.7"
E: 514482.84
LON: W081° 26' 50.4"
T.O.P. WATERMAIN EL. = 22.20
INV. CROSSING UTILITY EL. = 12.72
CROSSING UTILITY SIZE = 36"
SEPARATION = 5.14'

NBULL CREEK ROAD

12" PVC DR18
WATER MAIN

AB TOP OF 12" DR18
WATER MAIN
STA: 46+92.69
O/S: 24.76L
T.O.P. EL. = 22.62


10' ELEC. EASEMENT

AB TOP OF 12" DR18
WATER MAIN
STA: 45+83.66
O/S: 24.13L
T.O.P. EL. = 24.17

AB TOP OF 12" DR18
WATER MAIN
STA: 44+35.64
O/S: 25.34L
T.O.P. EL. = 22.74

MATCH LINE "B"

N

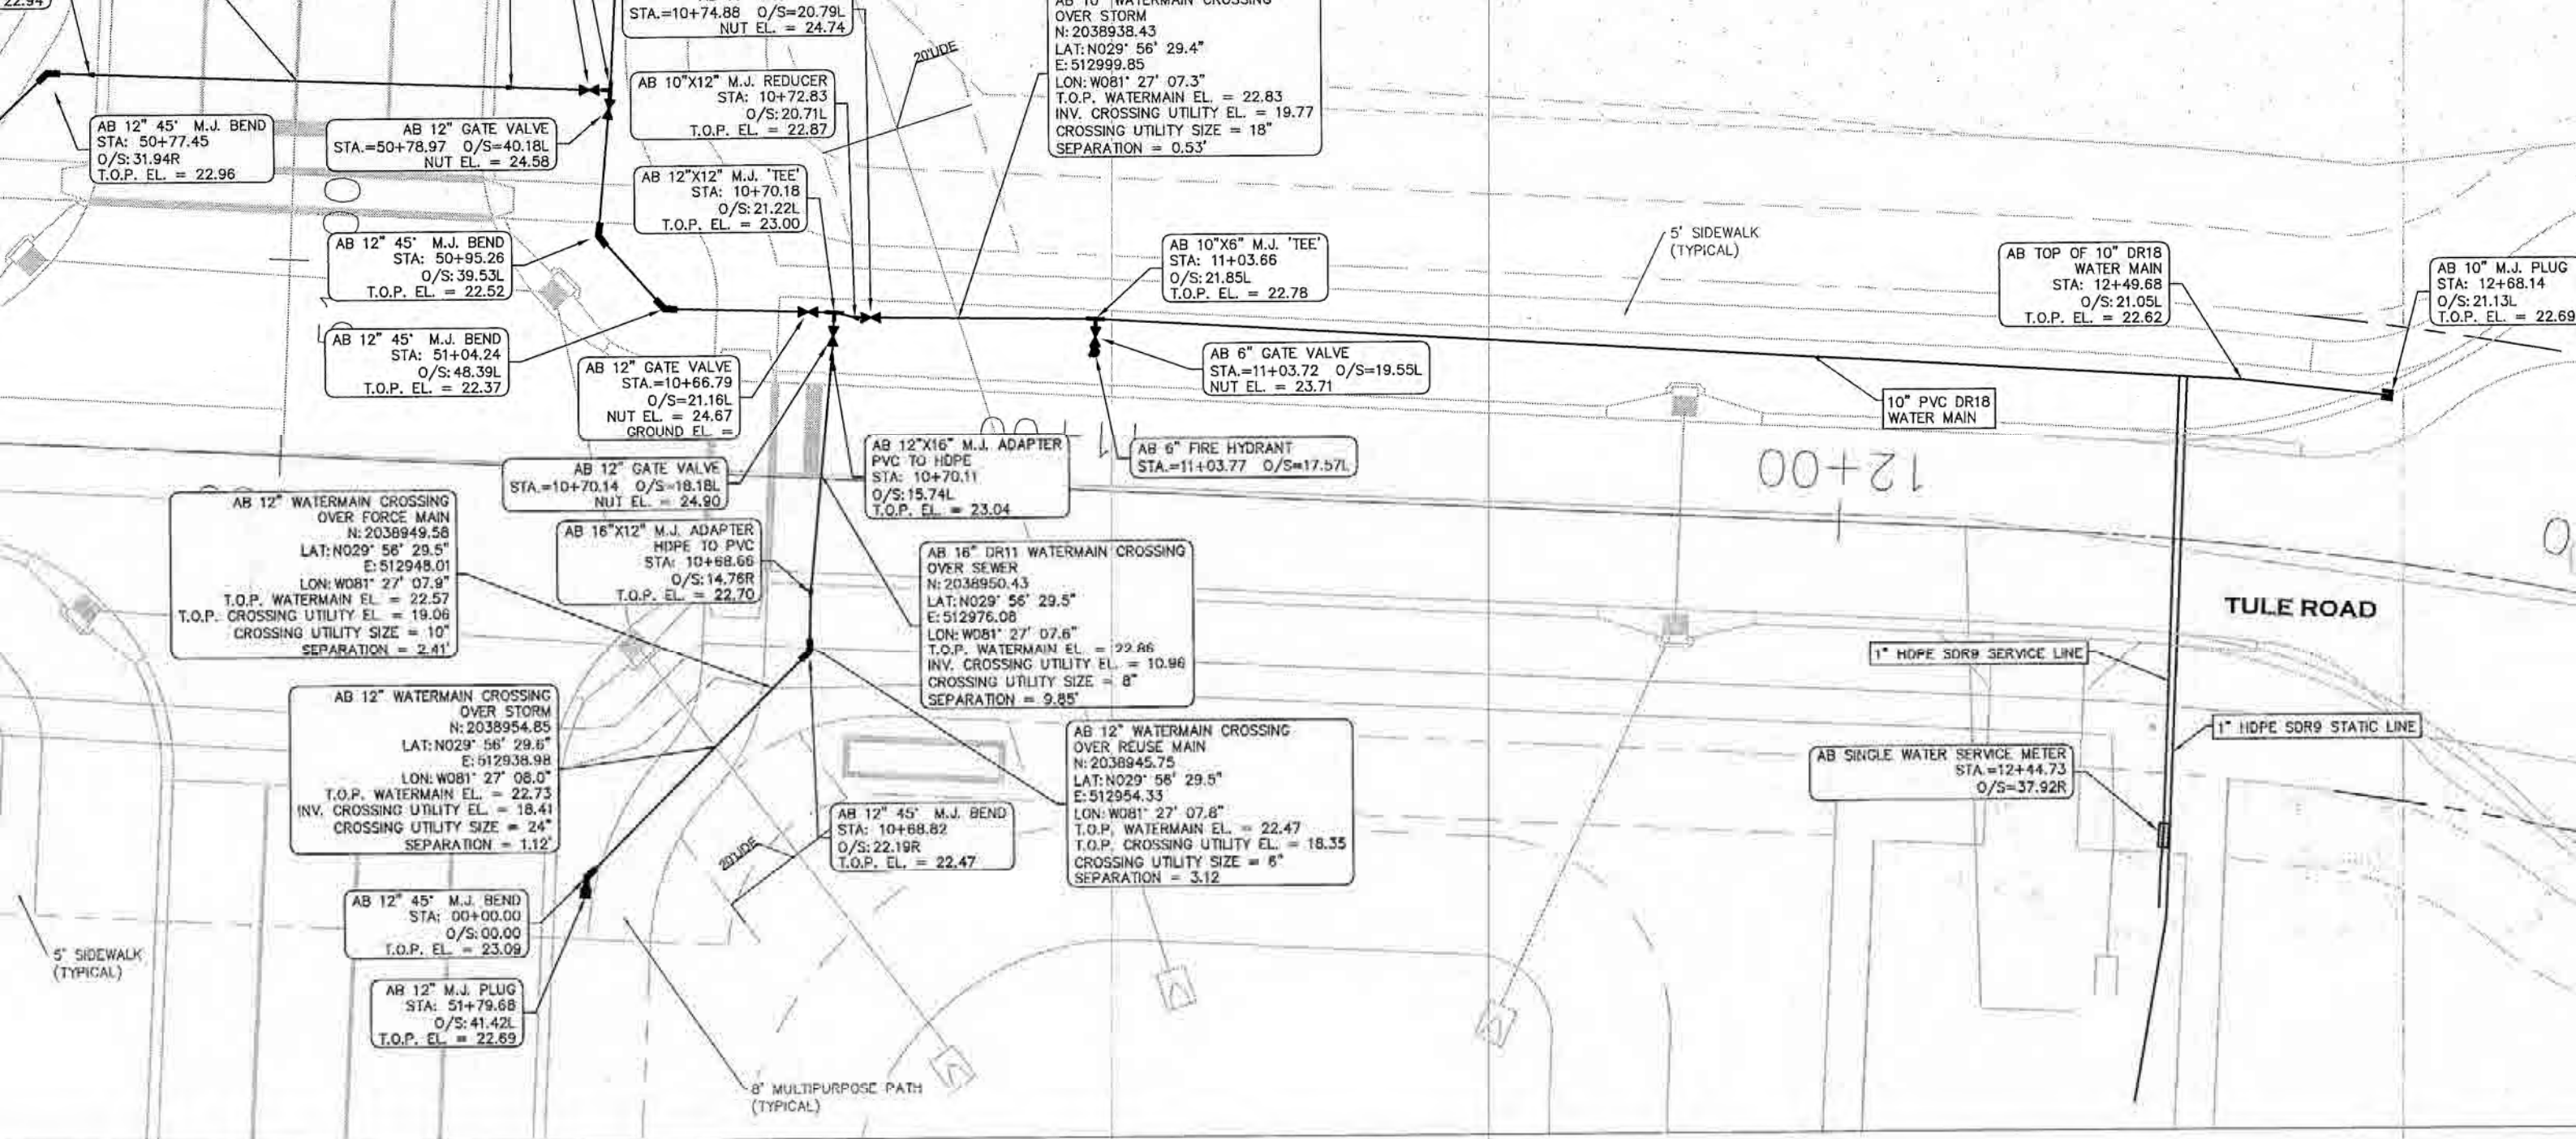



19+00

18+00

17+00

16+00

10

11

12

13

14

5

6

7

8

9

AB TOP OF 6" DR18 REUSE MAIN
STA: 25+65.76
O/S: 51.62R
T.O.P. EL. = 23.90

AB TOP OF 6" DR18 REUSE MAIN
STA: 25+19.85
O/S: 50.29R
T.O.P. EL. = 24.21

AB TOP OF 6" DR18 REUSE MAIN
STA: 24+90.23
O/S: 51.45R
T.O.P. EL. = 24.90

AB TOP OF 6" DR18 REUSE MAIN
STA: 24+21.21
O/S: 50.95R
T.O.P. EL. = 23.74

AB TOP OF 6" DR18 REUSE MAIN
STA: 23+...
O/S: 51.4...
T.O.P. EL. = ...

AB TOP OF 6" DR18 REUSE MAIN
STA: ...
O/S: ...
T.O.P. EL. = ...

AB 6" GATE VALVE
STA: 27+20.19 O/S: 51.66R
NUT EL. = 26.22

AB TOP OF 6" DR18 REUSE MAIN
STA: 28+52.29
O/S: 50.01R
T.O.P. EL. = 23.45

AB TOP OF 6" DR18 REUSE MAIN
STA: 29+65.95
O/S: 48.96R
T.O.P. EL. = 22.93

6" PVC DR18 REUSE MAIN

TURNBULL CREEK ROAD

29+00

28+00



27+00


26+00


25+00

24+00

23+00

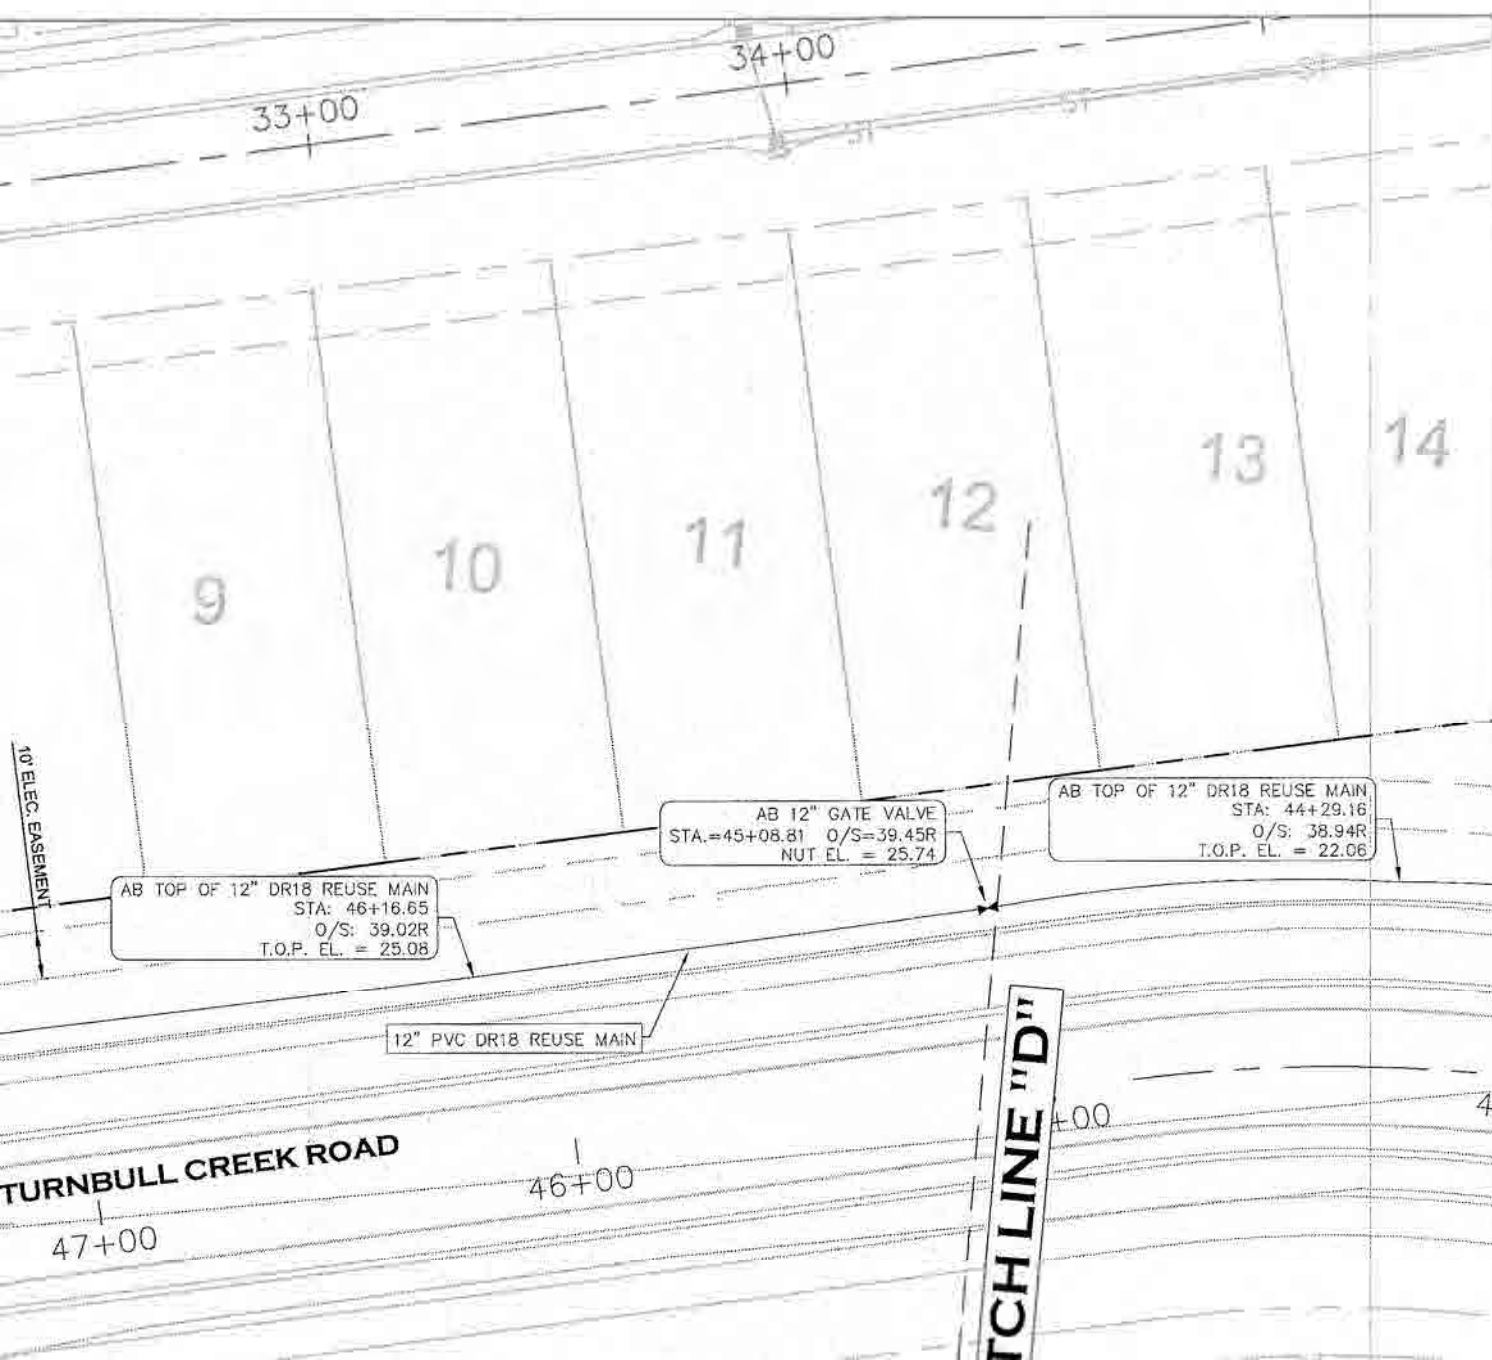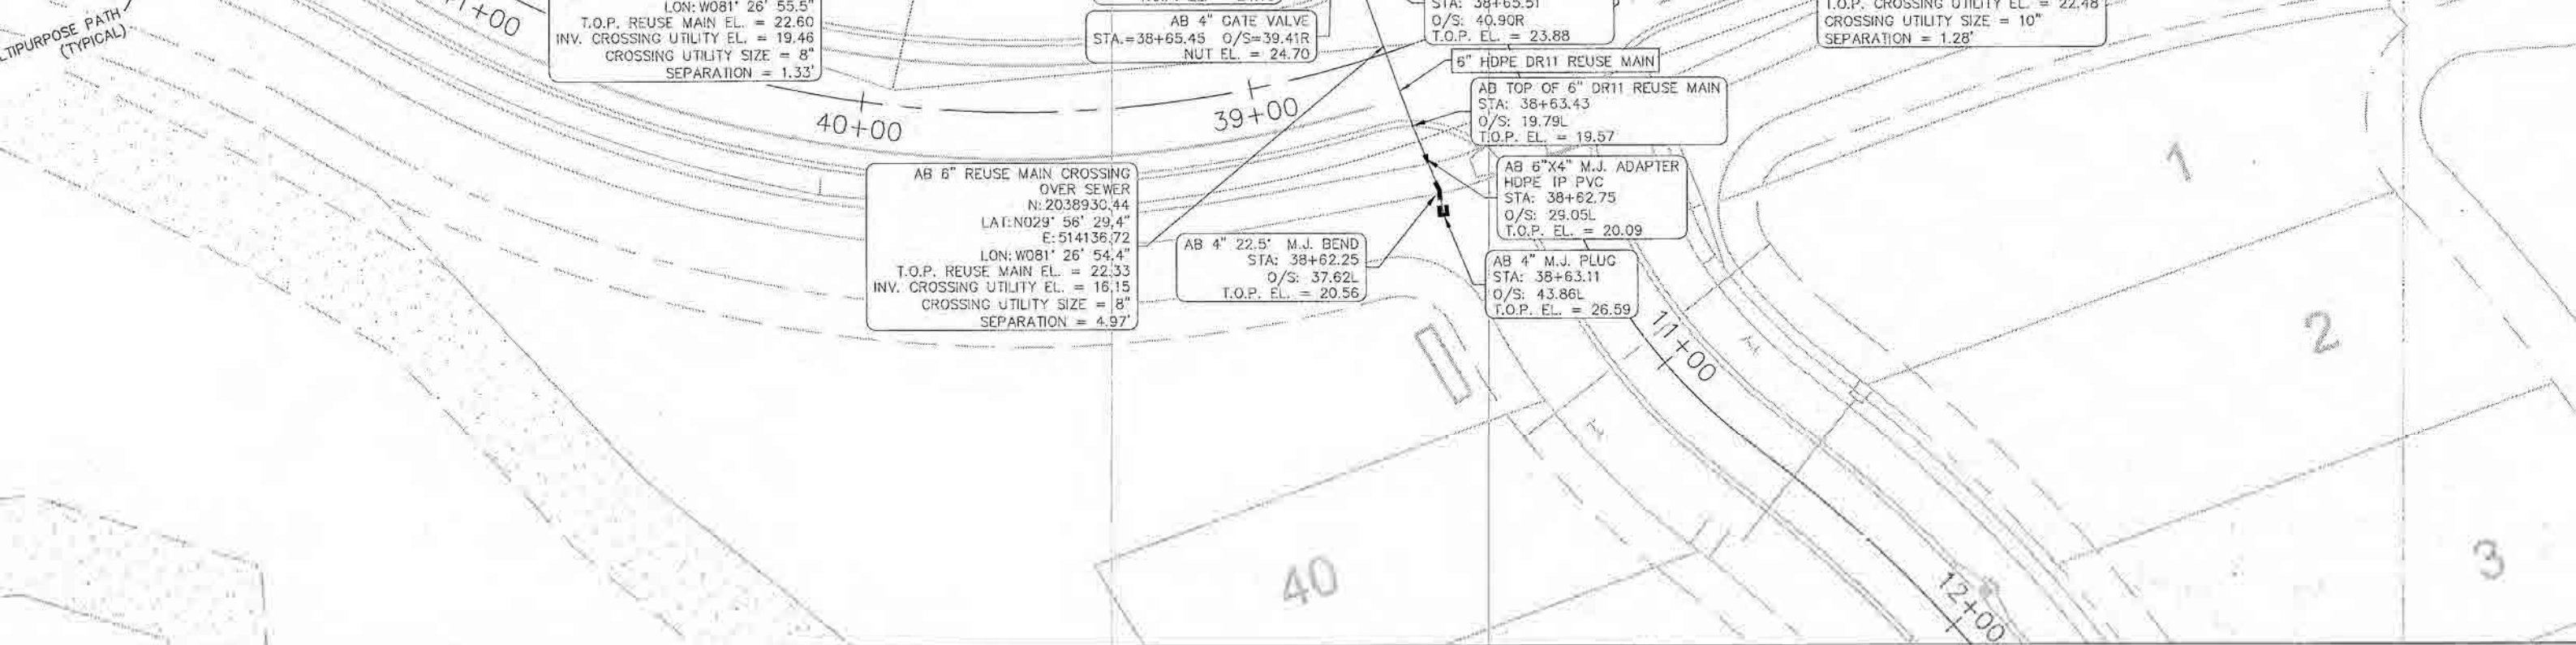

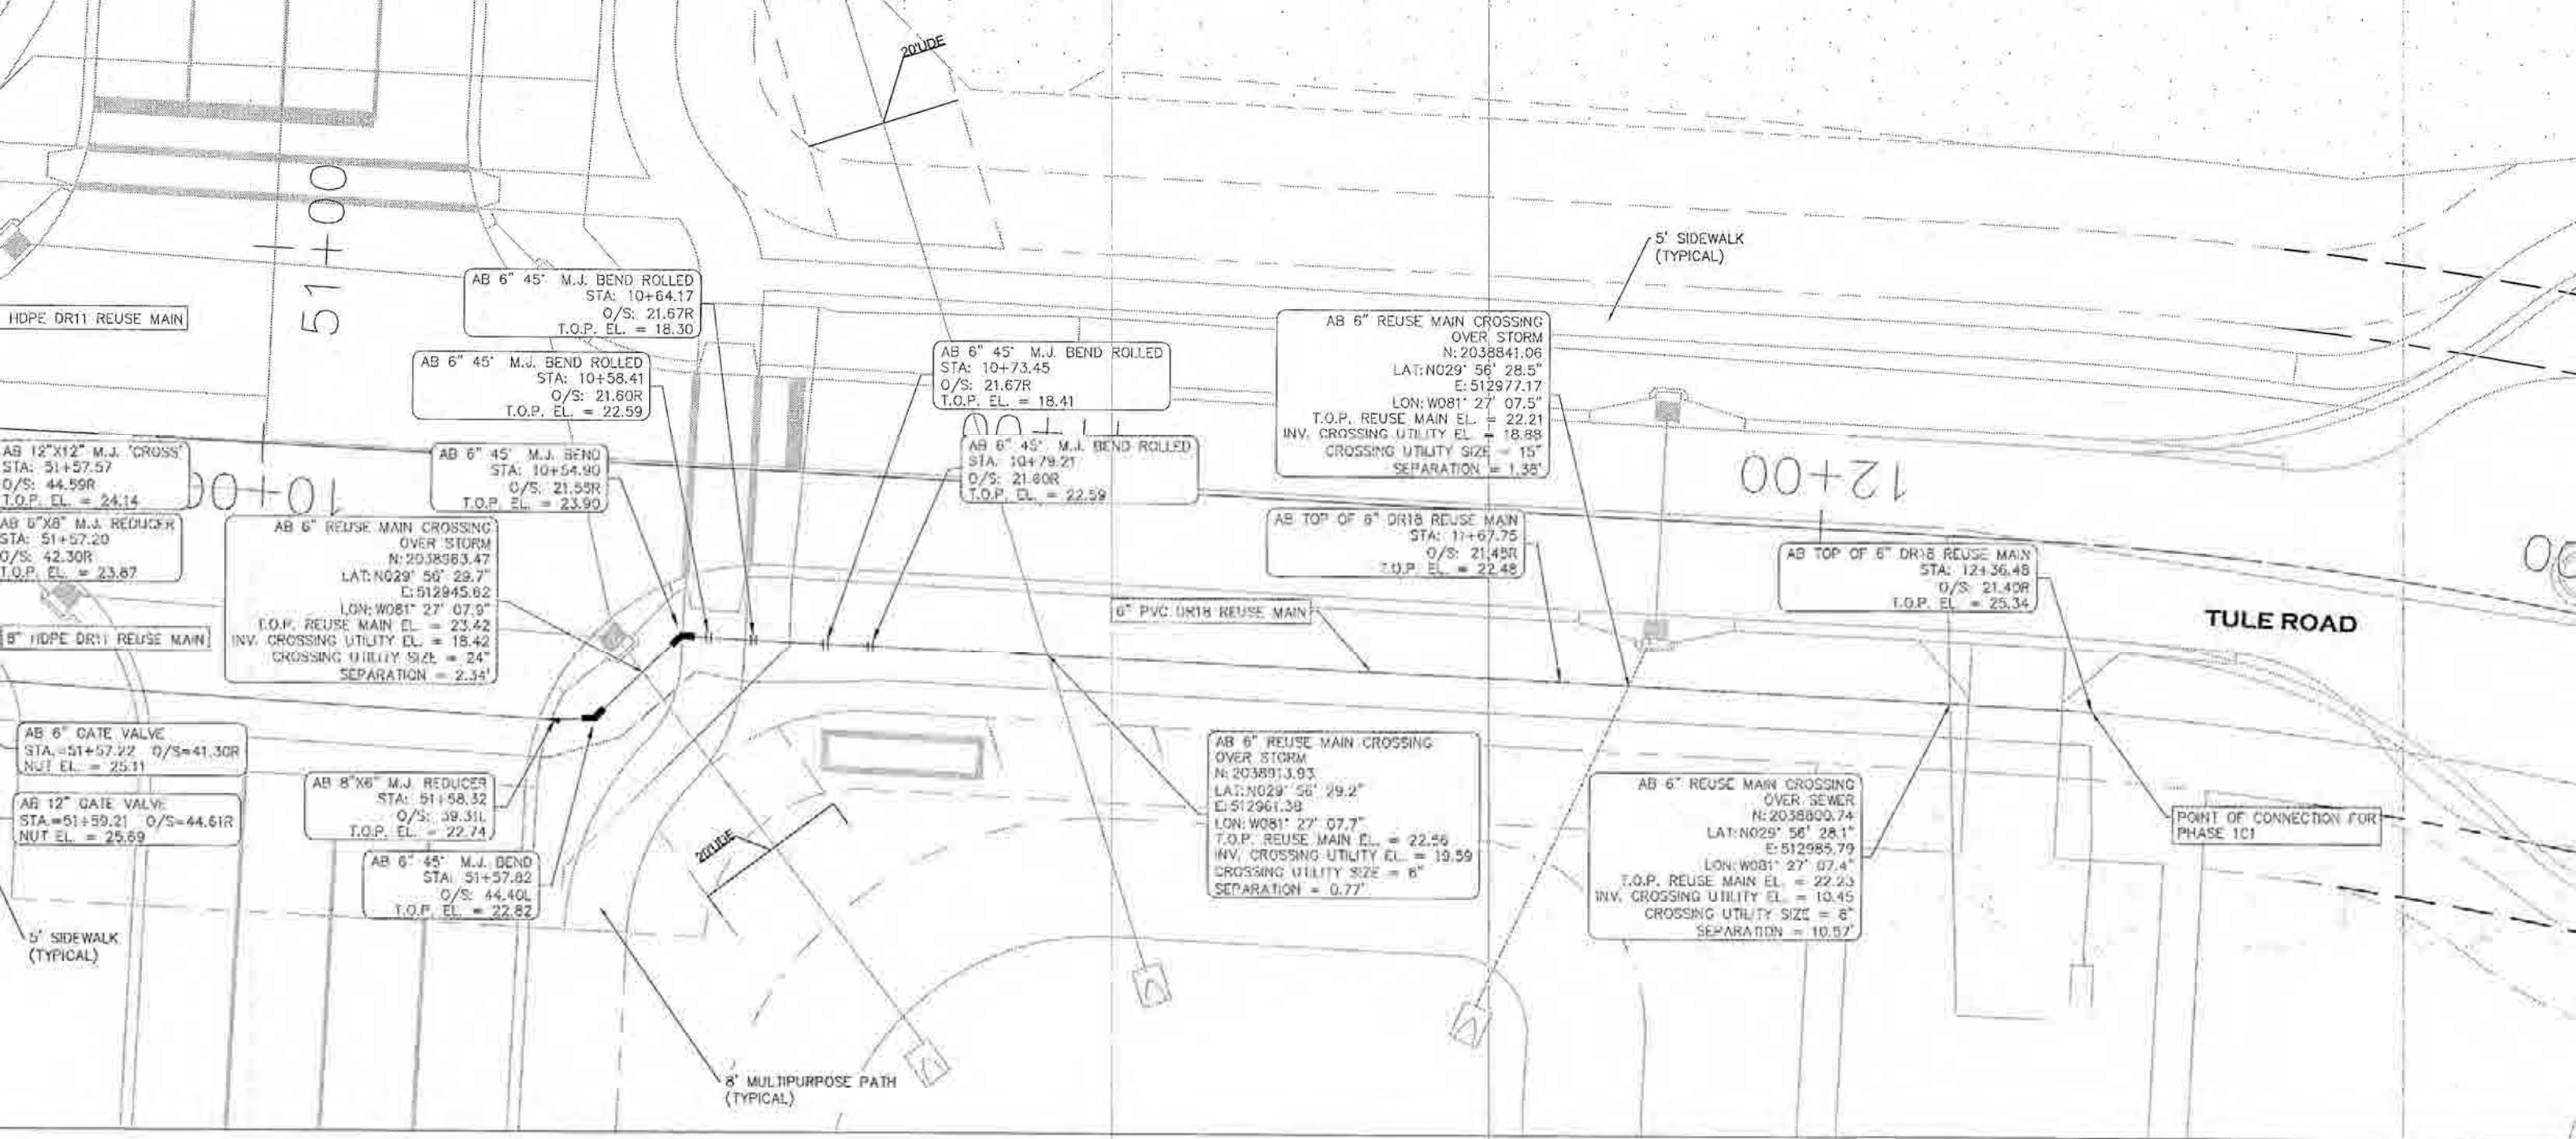

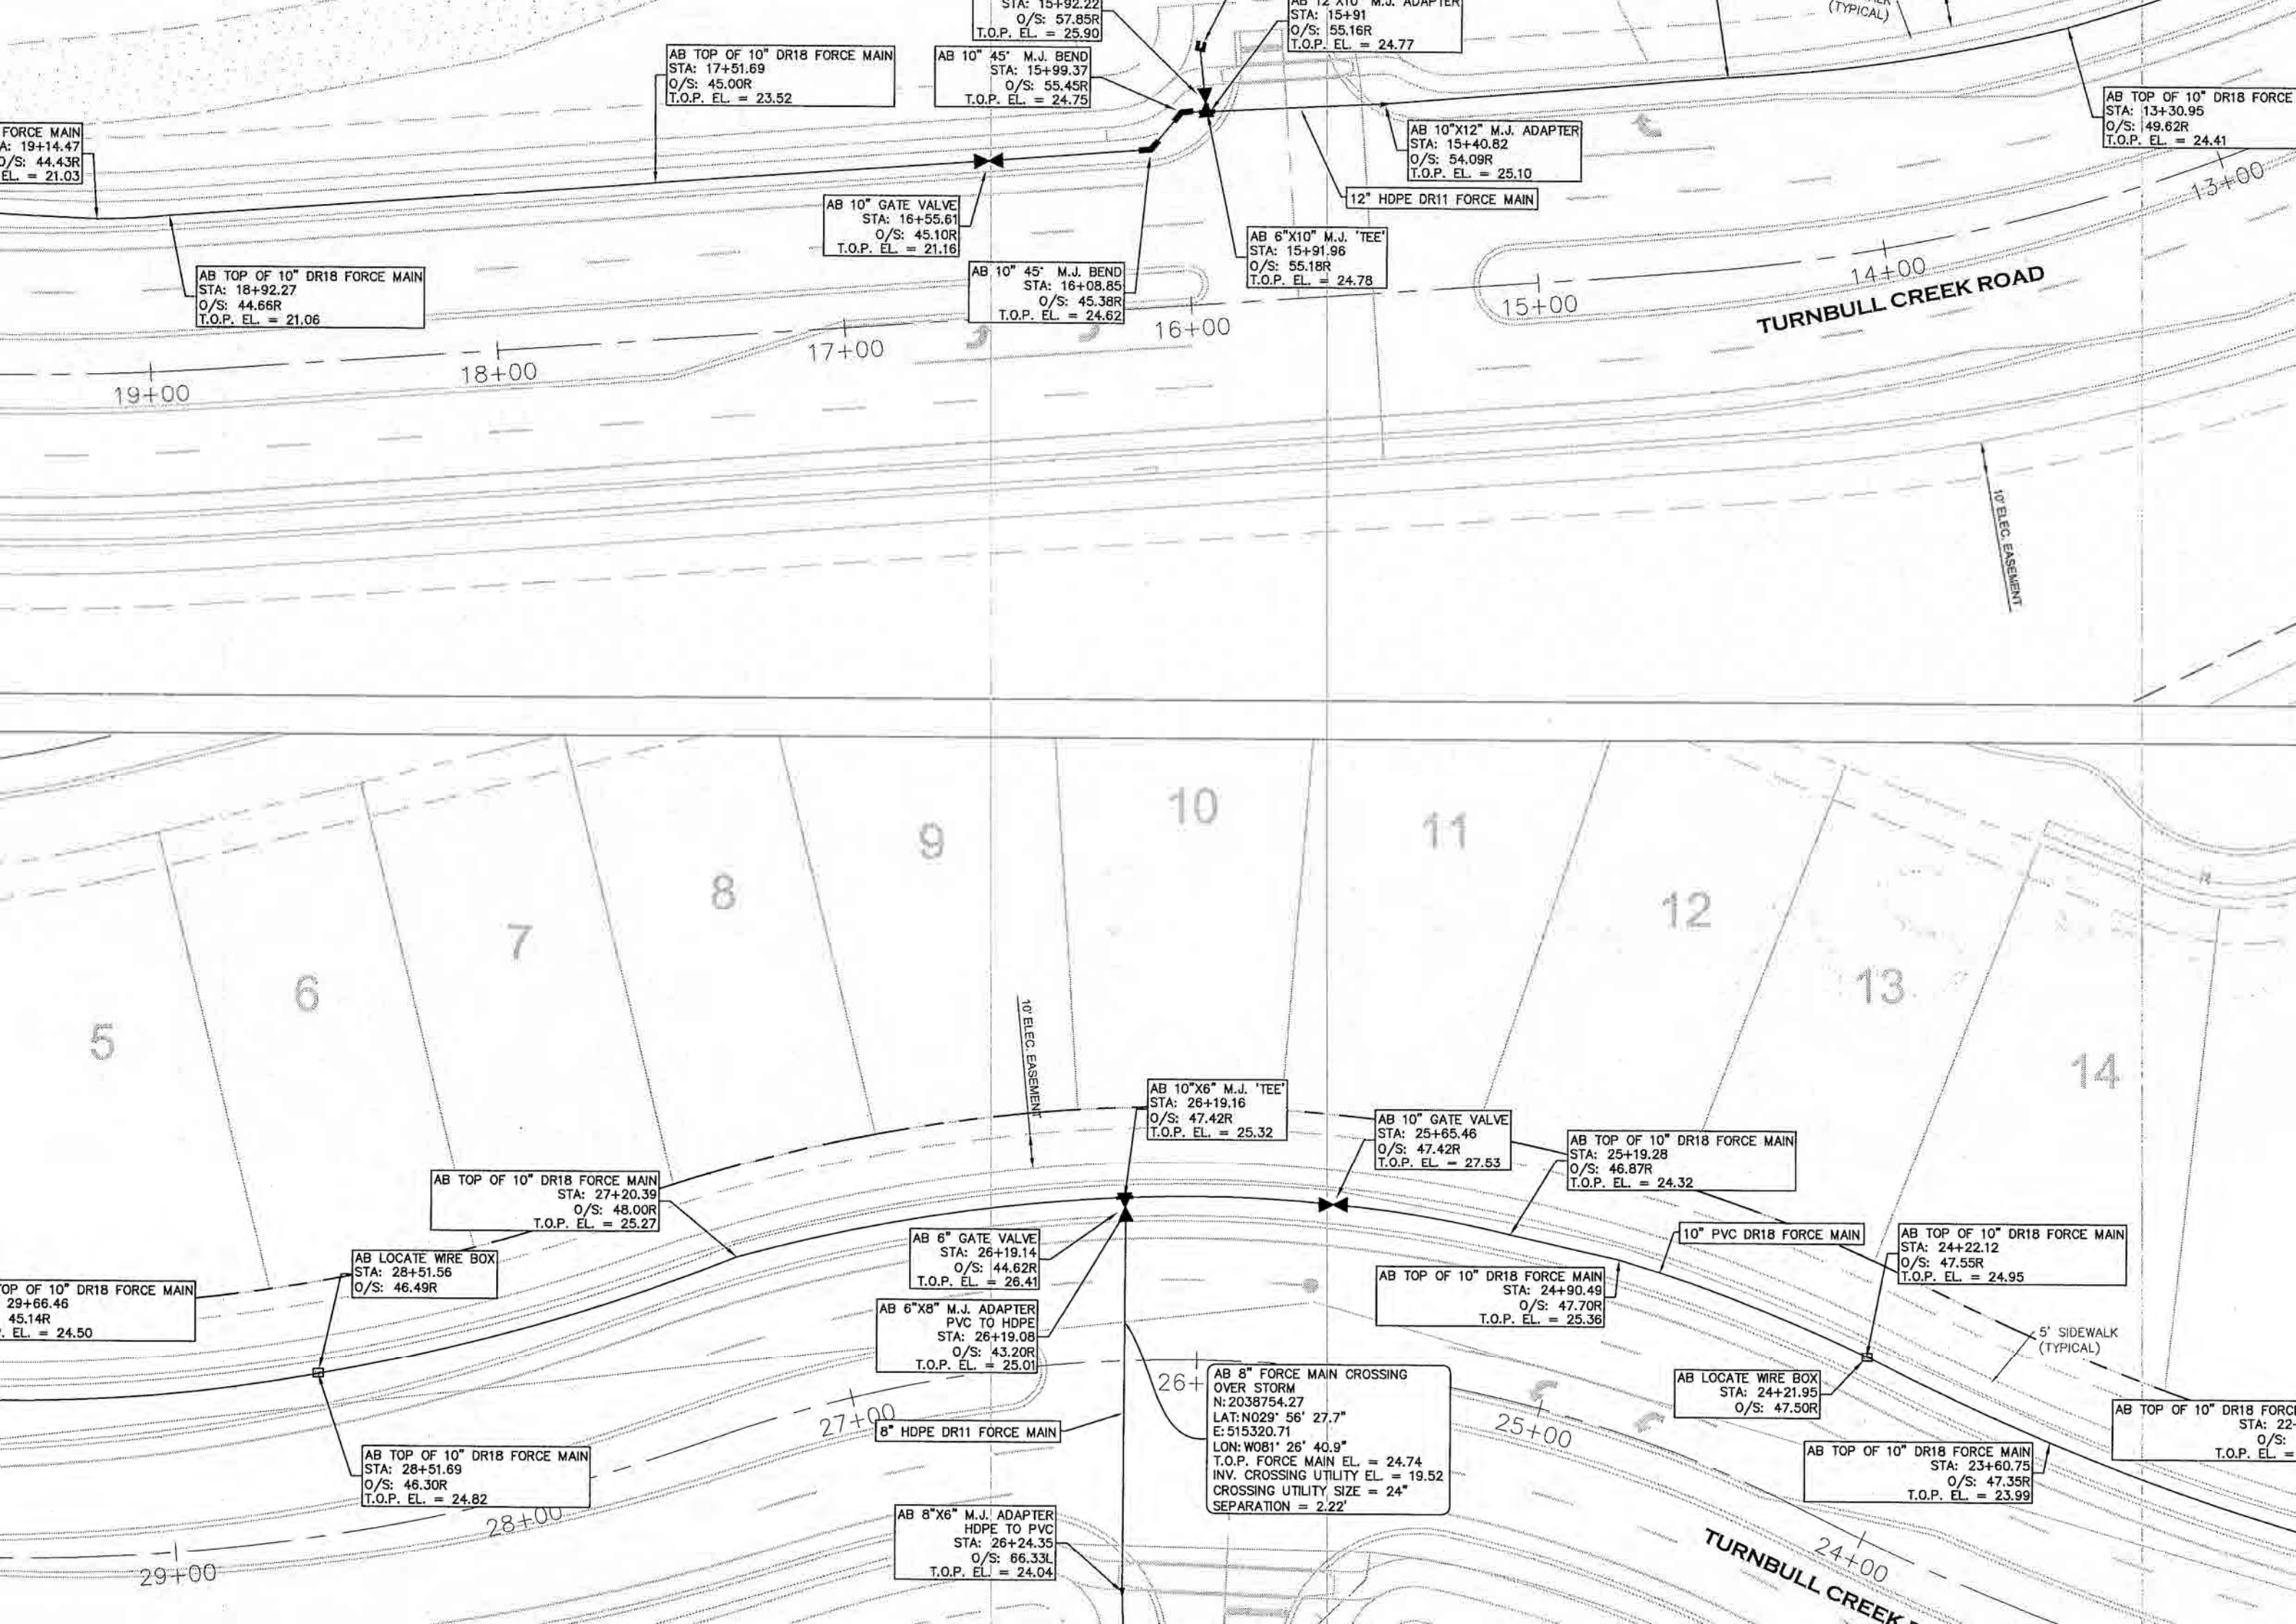

FORCE MAIN
A: 19+14.47
O/S: 44.43R
EL. = 21.03

AB TOP OF 10" DR18 FORCE MAIN
STA: 18+92.27
O/S: 44.66R
T.O.P. EL. = 21.06

AB TOP OF 10" DR18 FORCE MAIN
STA: 17+51.69
O/S: 45.00R
T.O.P. EL. = 23.52

AB 10" 45' M.J. BEND
STA: 15+99.37
O/S: 55.45R
T.O.P. EL. = 24.75

STA: 15+92.22
O/S: 57.85R
T.O.P. EL. = 25.90

AB 12" X10" M.J. ADAPTER
STA: 15+91
O/S: 55.16R
T.O.P. EL. = 24.77

AB 10"X12" M.J. ADAPTER
STA: 15+40.82
O/S: 54.09R
T.O.P. EL. = 25.10

AB TOP OF 10" DR18 FORCE
STA: 13+30.95
O/S: 49.62R
T.O.P. EL. = 24.41

AB 10" GATE VALVE
STA: 16+55.61
O/S: 45.10R
T.O.P. EL. = 21.16

AB 10" 45' M.J. BEND
STA: 16+08.85
O/S: 45.38R
T.O.P. EL. = 24.62

AB 6"X10" M.J. 'TEE'
STA: 15+91.96
O/S: 55.18R
T.O.P. EL. = 24.78

12" HDPE DR11 FORCE MAIN

TURNBULL CREEK ROAD

10' ELEC. EASEMENT

TOP OF 10" DR18 FORCE MAIN
STA: 29+66.46
O/S: 45.14R
EL. = 24.50

AB LOCATE WIRE BOX
STA: 28+51.56
O/S: 46.49R

AB TOP OF 10" DR18 FORCE MAIN
STA: 27+20.39
O/S: 48.00R
T.O.P. EL. = 25.27

AB 6" GATE VALVE
STA: 26+19.14
O/S: 44.62R
T.O.P. EL. = 26.41

AB 6"X8" M.J. ADAPTER
PVC TO HDPE
STA: 26+19.08
O/S: 43.20R
T.O.P. EL. = 25.01

8" HDPE DR11 FORCE MAIN

AB 8"X6" M.J. ADAPTER
HDPE TO PVC
STA: 26+24.35
O/S: 66.33L
T.O.P. EL. = 24.04

AB 10"X6" M.J. 'TEE'
STA: 26+19.16
O/S: 47.42R
T.O.P. EL. = 25.32

AB 10" GATE VALVE
STA: 25+65.46
O/S: 47.42R
T.O.P. EL. = 27.53

AB TOP OF 10" DR18 FORCE MAIN
STA: 25+19.28
O/S: 46.87R
T.O.P. EL. = 24.32

AB TOP OF 10" DR18 FORCE MAIN
STA: 24+90.49
O/S: 47.70R
T.O.P. EL. = 25.36

AB LOCATE WIRE BOX
STA: 24+21.95
O/S: 47.50R

AB TOP OF 10" DR18 FORCE MAIN
STA: 23+60.75
O/S: 47.35R
T.O.P. EL. = 23.99



AB TOP OF 10" DR18 FORCE MAIN
STA: 24+22.12
O/S: 47.55R
T.O.P. EL. = 24.95

AB TOP OF 10" DR18 FORCE
STA: 22+
O/S:
T.O.P. EL. =

AB 8" FORCE MAIN CROSSING
OVER STORM
N: 2038754.27
LAT: N029° 56' 27.7"
E: 515320.71
LON: W081° 26' 40.9"
T.O.P. FORCE MAIN EL. = 24.74
INV. CROSSING UTILITY EL. = 19.52
CROSSING UTILITY SIZE = 24"
SEPARATION = 2.22'

TURNBULL CREEK

5' SIDEWALK
(TYPICAL)

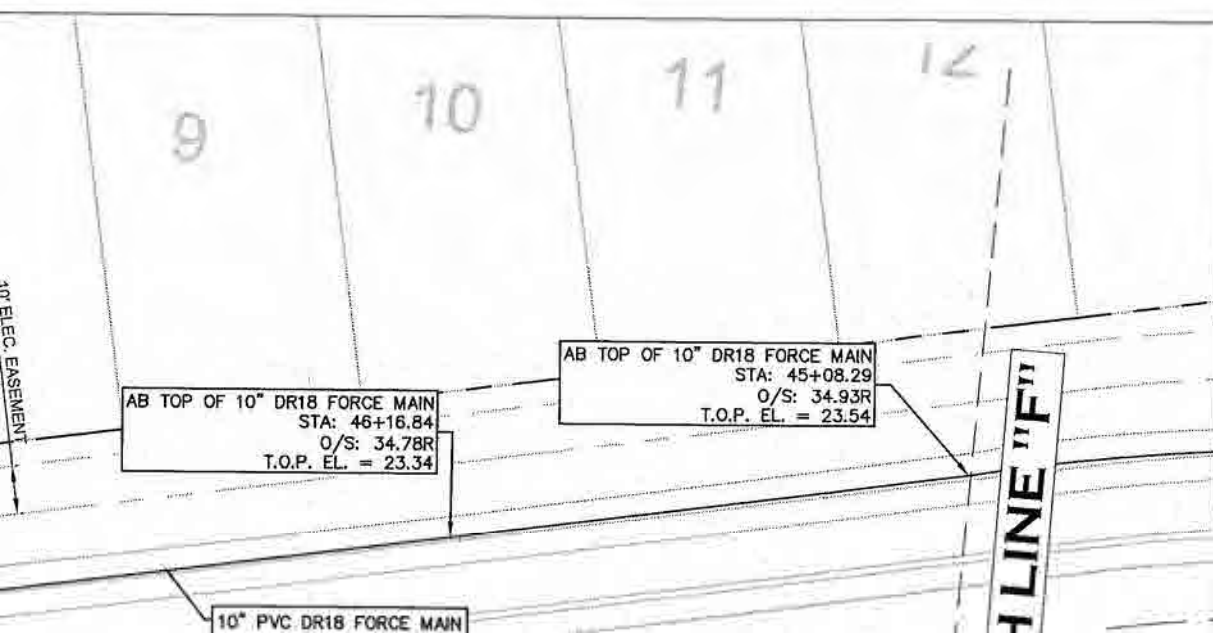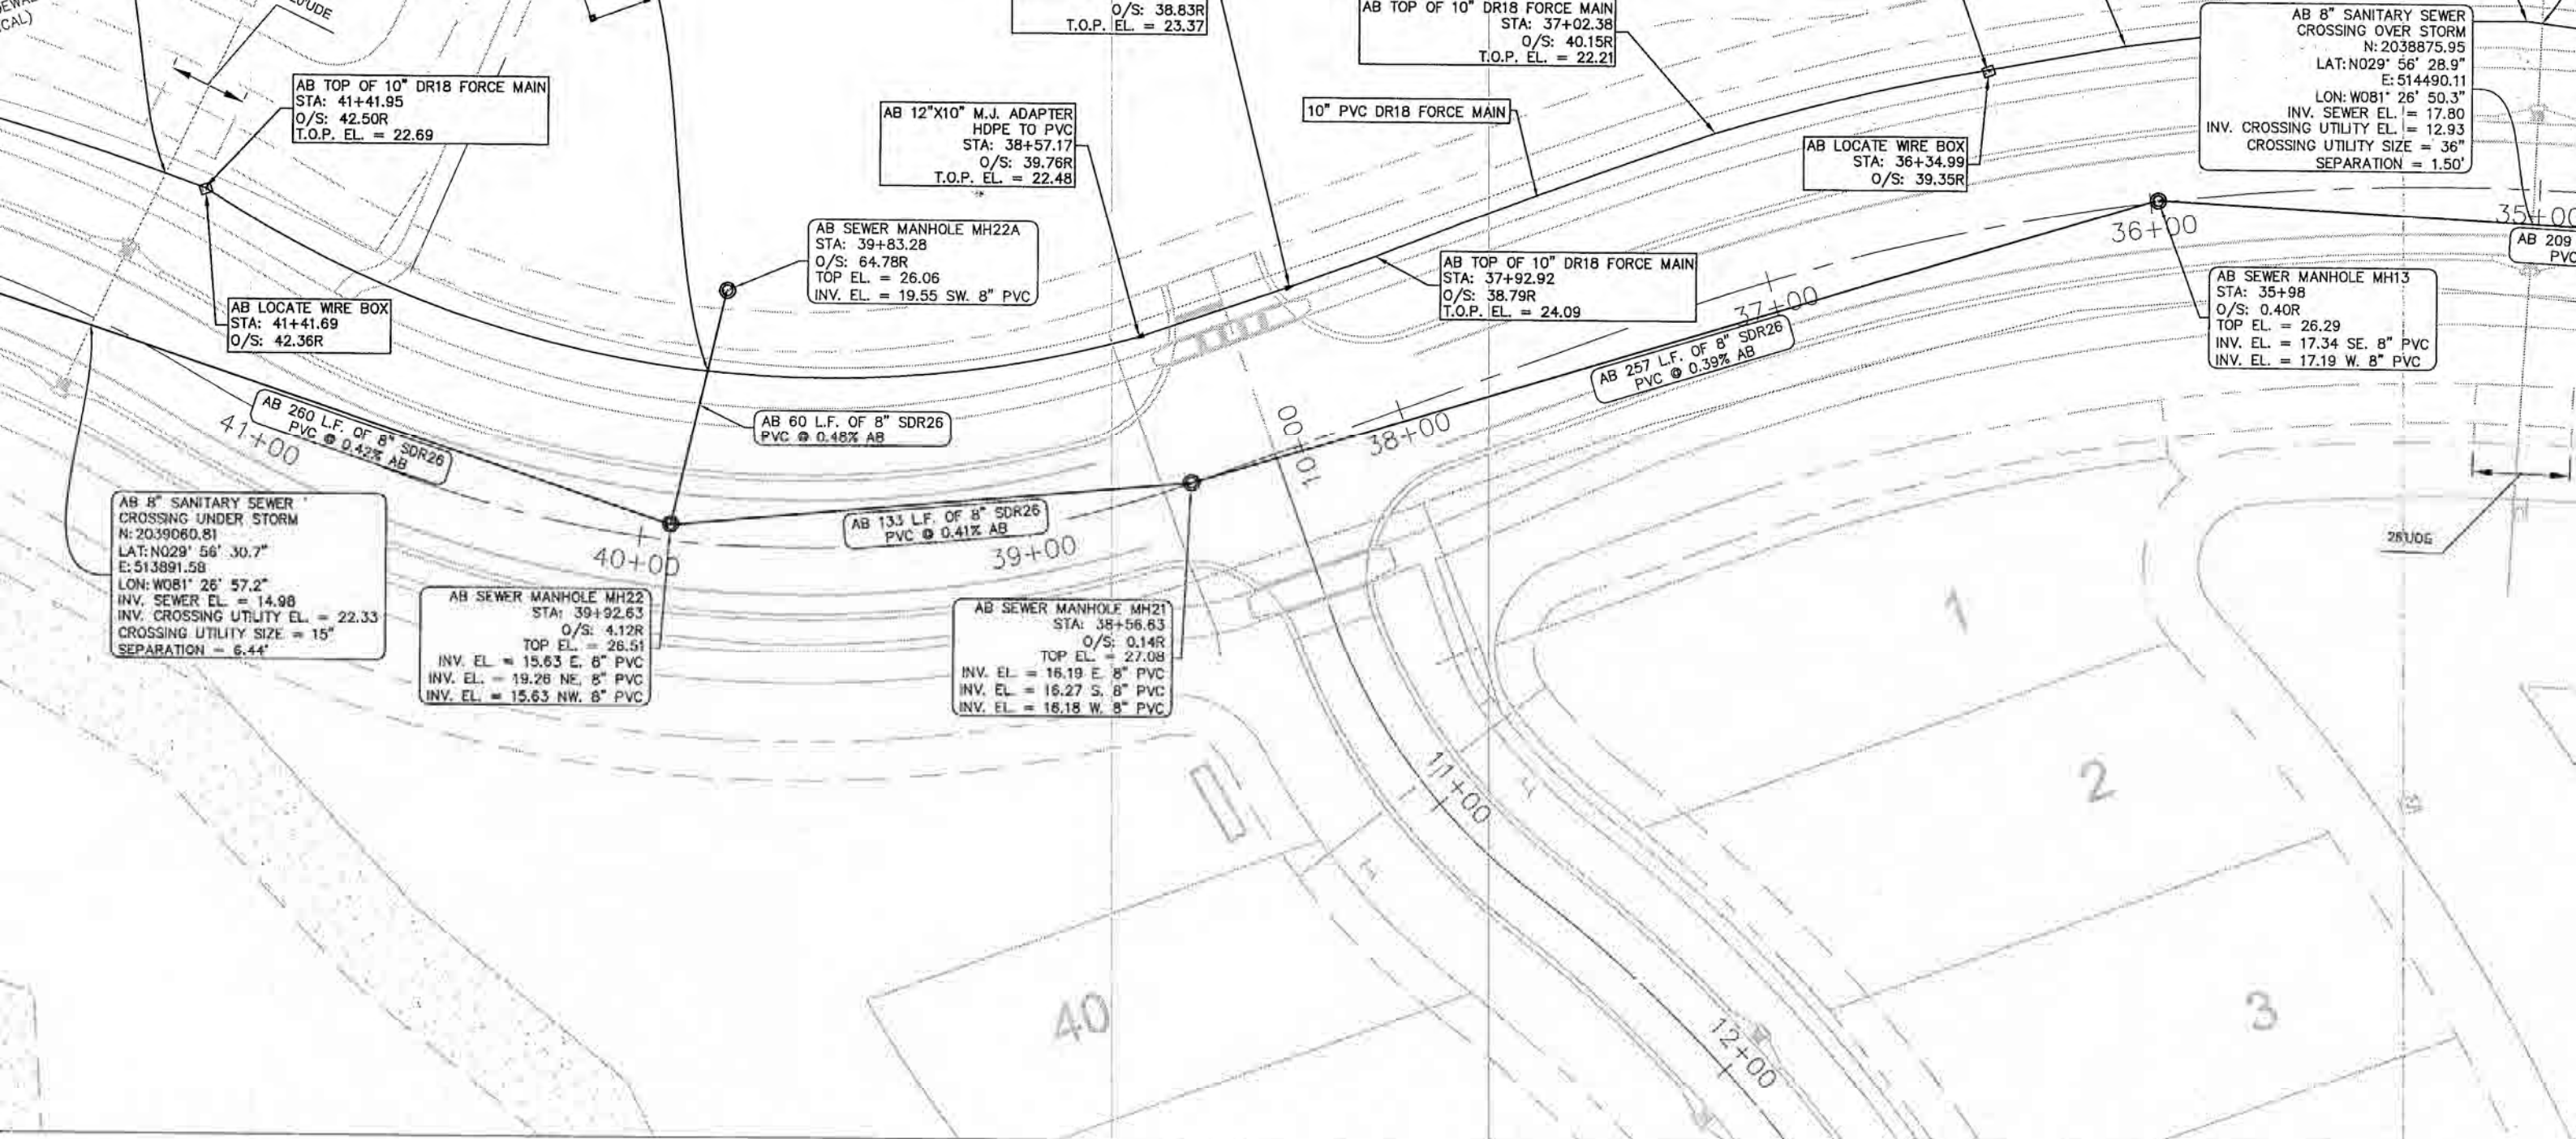

SEWER



T.O.P. EL. = 20.76
STA: 00+00.00
O/S: 00.00
T.O.P. EL. = 21.19

AB SEWER MANHOLE MH47
STA: 51+24.77
O/S: 0.31L
TOP EL. = 26.13
INV. EL. = 11.29 E. 8" PVC
INV. EL. = 11.38 N. 8" PVC
INV. EL. = 11.29 S. 8" PVC

AB 8" SANITARY SEWER
CROSSING UNDER STORM
N: 2038978.99
LAT: N029° 56' 29.8"
E: 512969.84
LON: W081° 27' 07.6"
INV. SEWER EL. = 11.06
INV. CROSSING UTILITY EL. = 21.80
CROSSING UTILITY SIZE = 18"
SEPARATION = 9.83'

AB 8" SANITARY SEWER
CROSSING UNDER STORM
N: 2038926.62
LAT: N029° 56' 29.3"
E: 512981.29
LON: W081° 27' 07.5"
INV. SEWER EL. = 10.89
INV. CROSSING UTILITY EL. = 19.68
CROSSING UTILITY SIZE = 18"
SEPARATION = 7.88'

AB 8" SANITARY SEWER
CROSSING UNDER STORM
N: 2038842.77
LAT: N029° 56' 28.5"
E: 512999.62
LON: W081° 27' 07.3"
INV. SEWER EL. = 10.63
INV. CROSSING UTILITY EL. = 21.74
CROSSING UTILITY SIZE = 15"
SEPARATION = 10.20'

12" HOPE DR11 FORCE MAIN

AB 214 L.F. OF 8" SDR26
PVC @ 0.35% AB

12+00

M.J. ADAPTER
HDPE TO PVC
STA: 51+48.30
O/S: 39.48R
P. EL. = 23.85
J. BEND ROLLED
STA: 51+50.56
O/S: 39.43R
P. EL. = 23.88

AB 6" 45° M.J. BEND
STA: 10+57.01
O/S: 26.07R
T.O.P. EL. = 21.60

AB 8"x6" M.J. REDUCER
STA: 51+63.20
O/S: 38.74L
T.O.P. EL. = 21.09

AB TOP OF 6" DR18 FORCE MAIN
STA: 11+68.04
O/S: 25.89R
T.O.P. EL. = 21.12

AB SEWER MANHOLE MH-76
STA: 12+16.20
O/S: 0.94L
TOP EL. = 25.69
INV. EL. = 10.54 N. 8" PVC
INV. EL. = 10.88 S. 8" PVC
INV. EL. = 10.54 W. 8" PVC

BEND ROLLED
A: 51+53.74
O/S: 39.48R
EL. = 21.42

M.J. TEE
51+62.25
S: 39.38R
= 21.99

AB 6" GATE VALVE
STA: 51+62.27
O/S: 37.37R
T.O.P. EL. = 22.99

8" HOPE DR11 FORCE MAIN

AB 6" 45° M.J. BEND ROLLED
STA: 10+79.92
O/S: 25.99R
T.O.P. EL. = 22.55

AB 6" 45° M.J. BEND ROLLED
STA: 10+76.36
O/S: 26.42R
T.O.P. EL. = 19.35

AB 6" 45° M.J. BEND ROLLED
STA: 10+64.21
O/S: 27.14R
T.O.P. EL. = 19.08

AB 6" 45° M.J. BEND ROLLED
STA: 10+59.52
O/S: 26.48R
T.O.P. EL. = 22.65

AB 6" FORCE MAIN CROSSING
OVER STORM
N: 2038911.40
LAT: N029° 56' 29.2"
E: 512957.42
LON: W081° 27' 07.8"
T.O.P. FORCE MAIN EL. = 22.16
INV. CROSSING UTILITY EL. = 19.26
CROSSING UTILITY SIZE = 18"
SEPARATION = 0.70'

AB 6" FORCE MAIN CROSSING
OVER STORM
N: 2038841.91
LAT: N029° 56' 28.5"
E: 512972.46
LON: W081° 27' 07.6"
T.O.P. FORCE MAIN EL. = 21.39
INV. CROSSING UTILITY EL. = 18.88
CROSSING UTILITY SIZE = 15"
SEPARATION = 0.70'

AB 6" 45° M.J. BEND
STA: 51+60.10
O/S: 47.80L
T.O.P. EL. = 22.57

AB 10" M.J. 'PLUG'
STA: 51+77.32
O/S: 39.00R
T.O.P. EL. = 22.22

5' SIDEWALK
(TYPICAL)

AB 6" FORCE MAIN CROSSING
OVER STORM
N: 2038959.98
LAT: N029° 56' 29.6"
E: 512942.93
LON: W081° 27' 07.9"
T.O.P. FORCE MAIN EL. = 22.02
INV. CROSSING UTILITY EL. = 18.42
CROSSING UTILITY SIZE = 24"
SEPARATION = 0.57'


8' MULTIPURPOSE PATH
(TYPICAL)


AB SEWER MANHOLE MH77
STA: 12+20.68
O/S: 61.26R
TOP EL. = 26.60
INV. EL. = 10.32 E. 8" PVC
INV. EL. = 10.31 S. 8" PVC




(SHOWN IN THIS LOCATION FOR CLARITY)
TO BE LOCATED AS SHOWN ON PLAN VIEW

EMERGENCY SUCTION
PIPE W/ " KAMLOCK FITTING (SEE NOTE 18)
(SHOWN IN THIS LOCATION FOR CLARITY)
TO BE LOCATED AS SHOWN ON PLAN VIEW


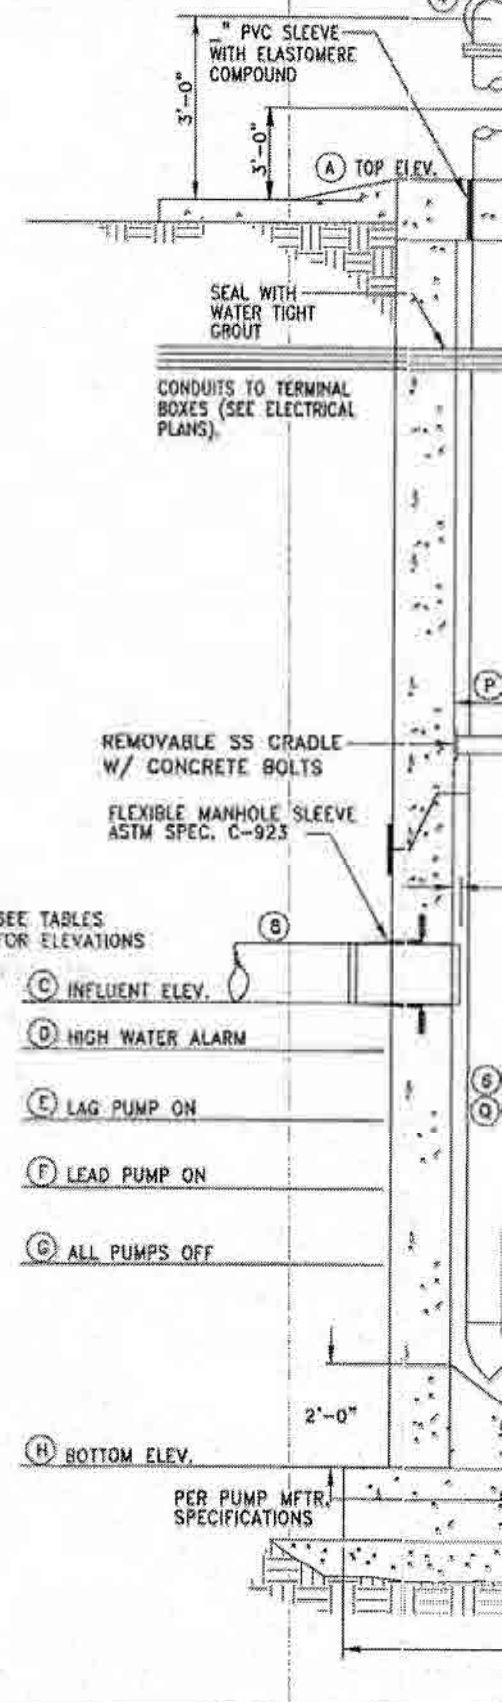


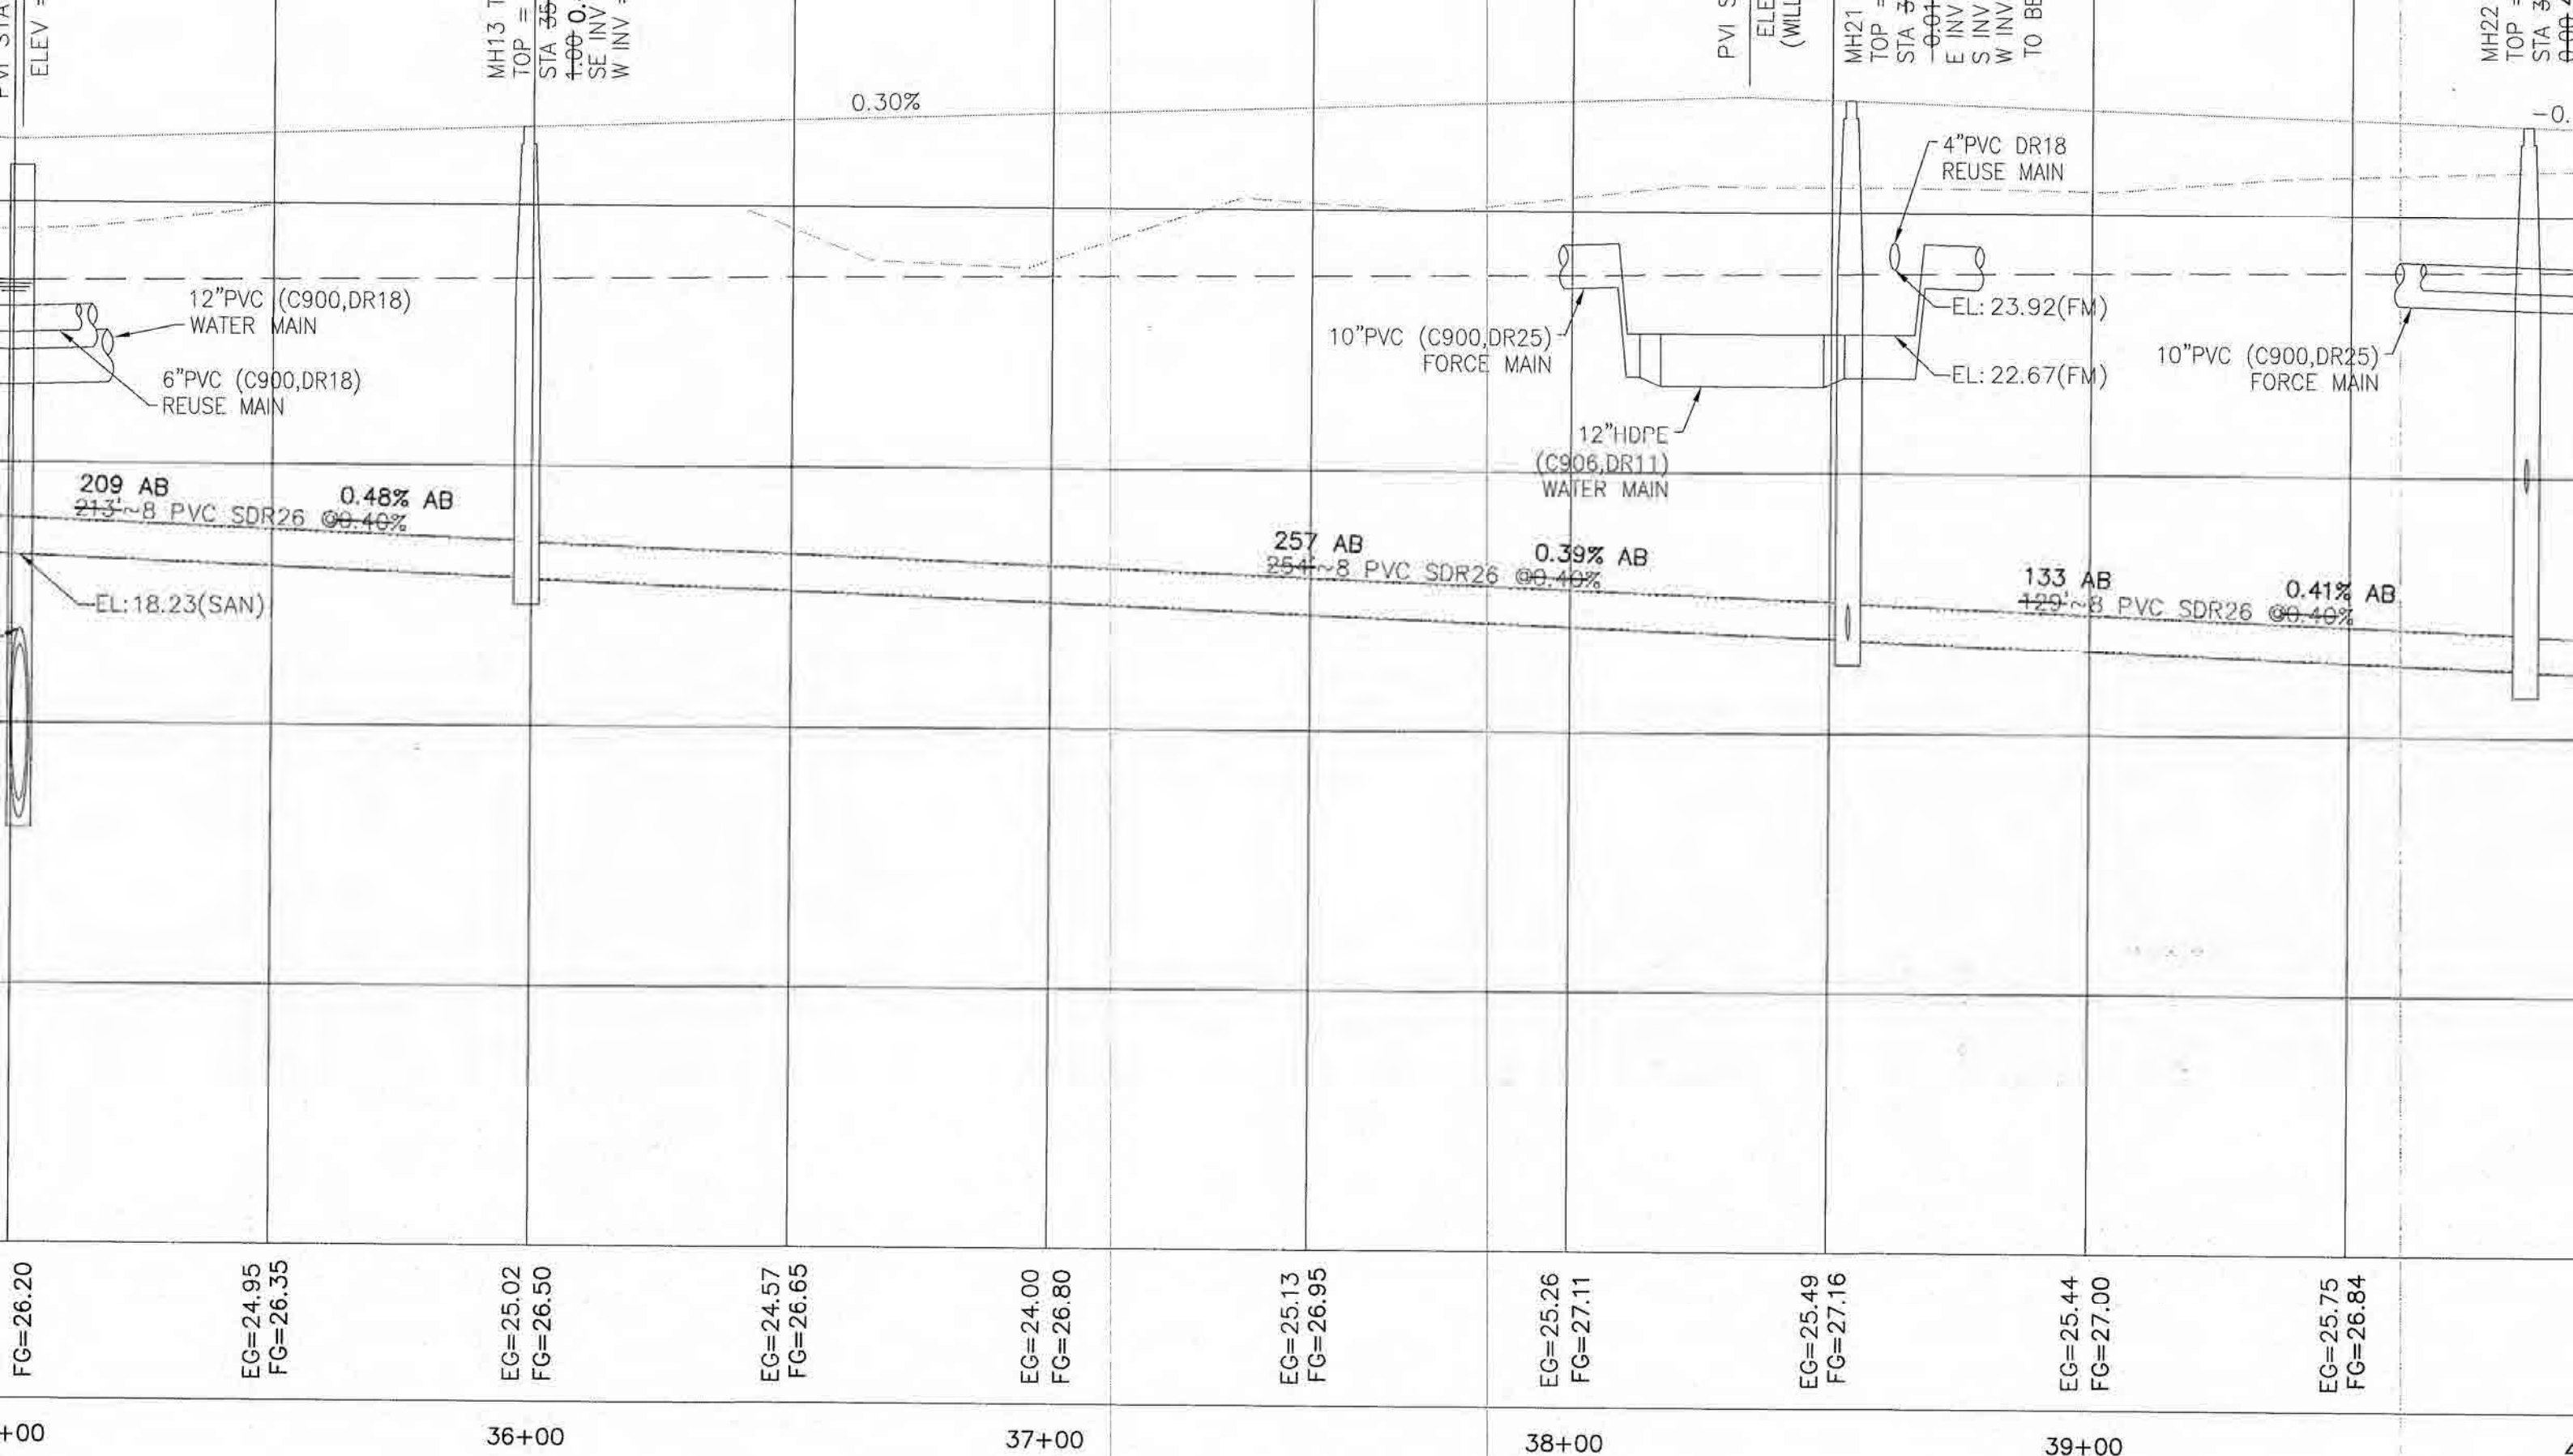


TURNBULL CREEK RD PROFILE

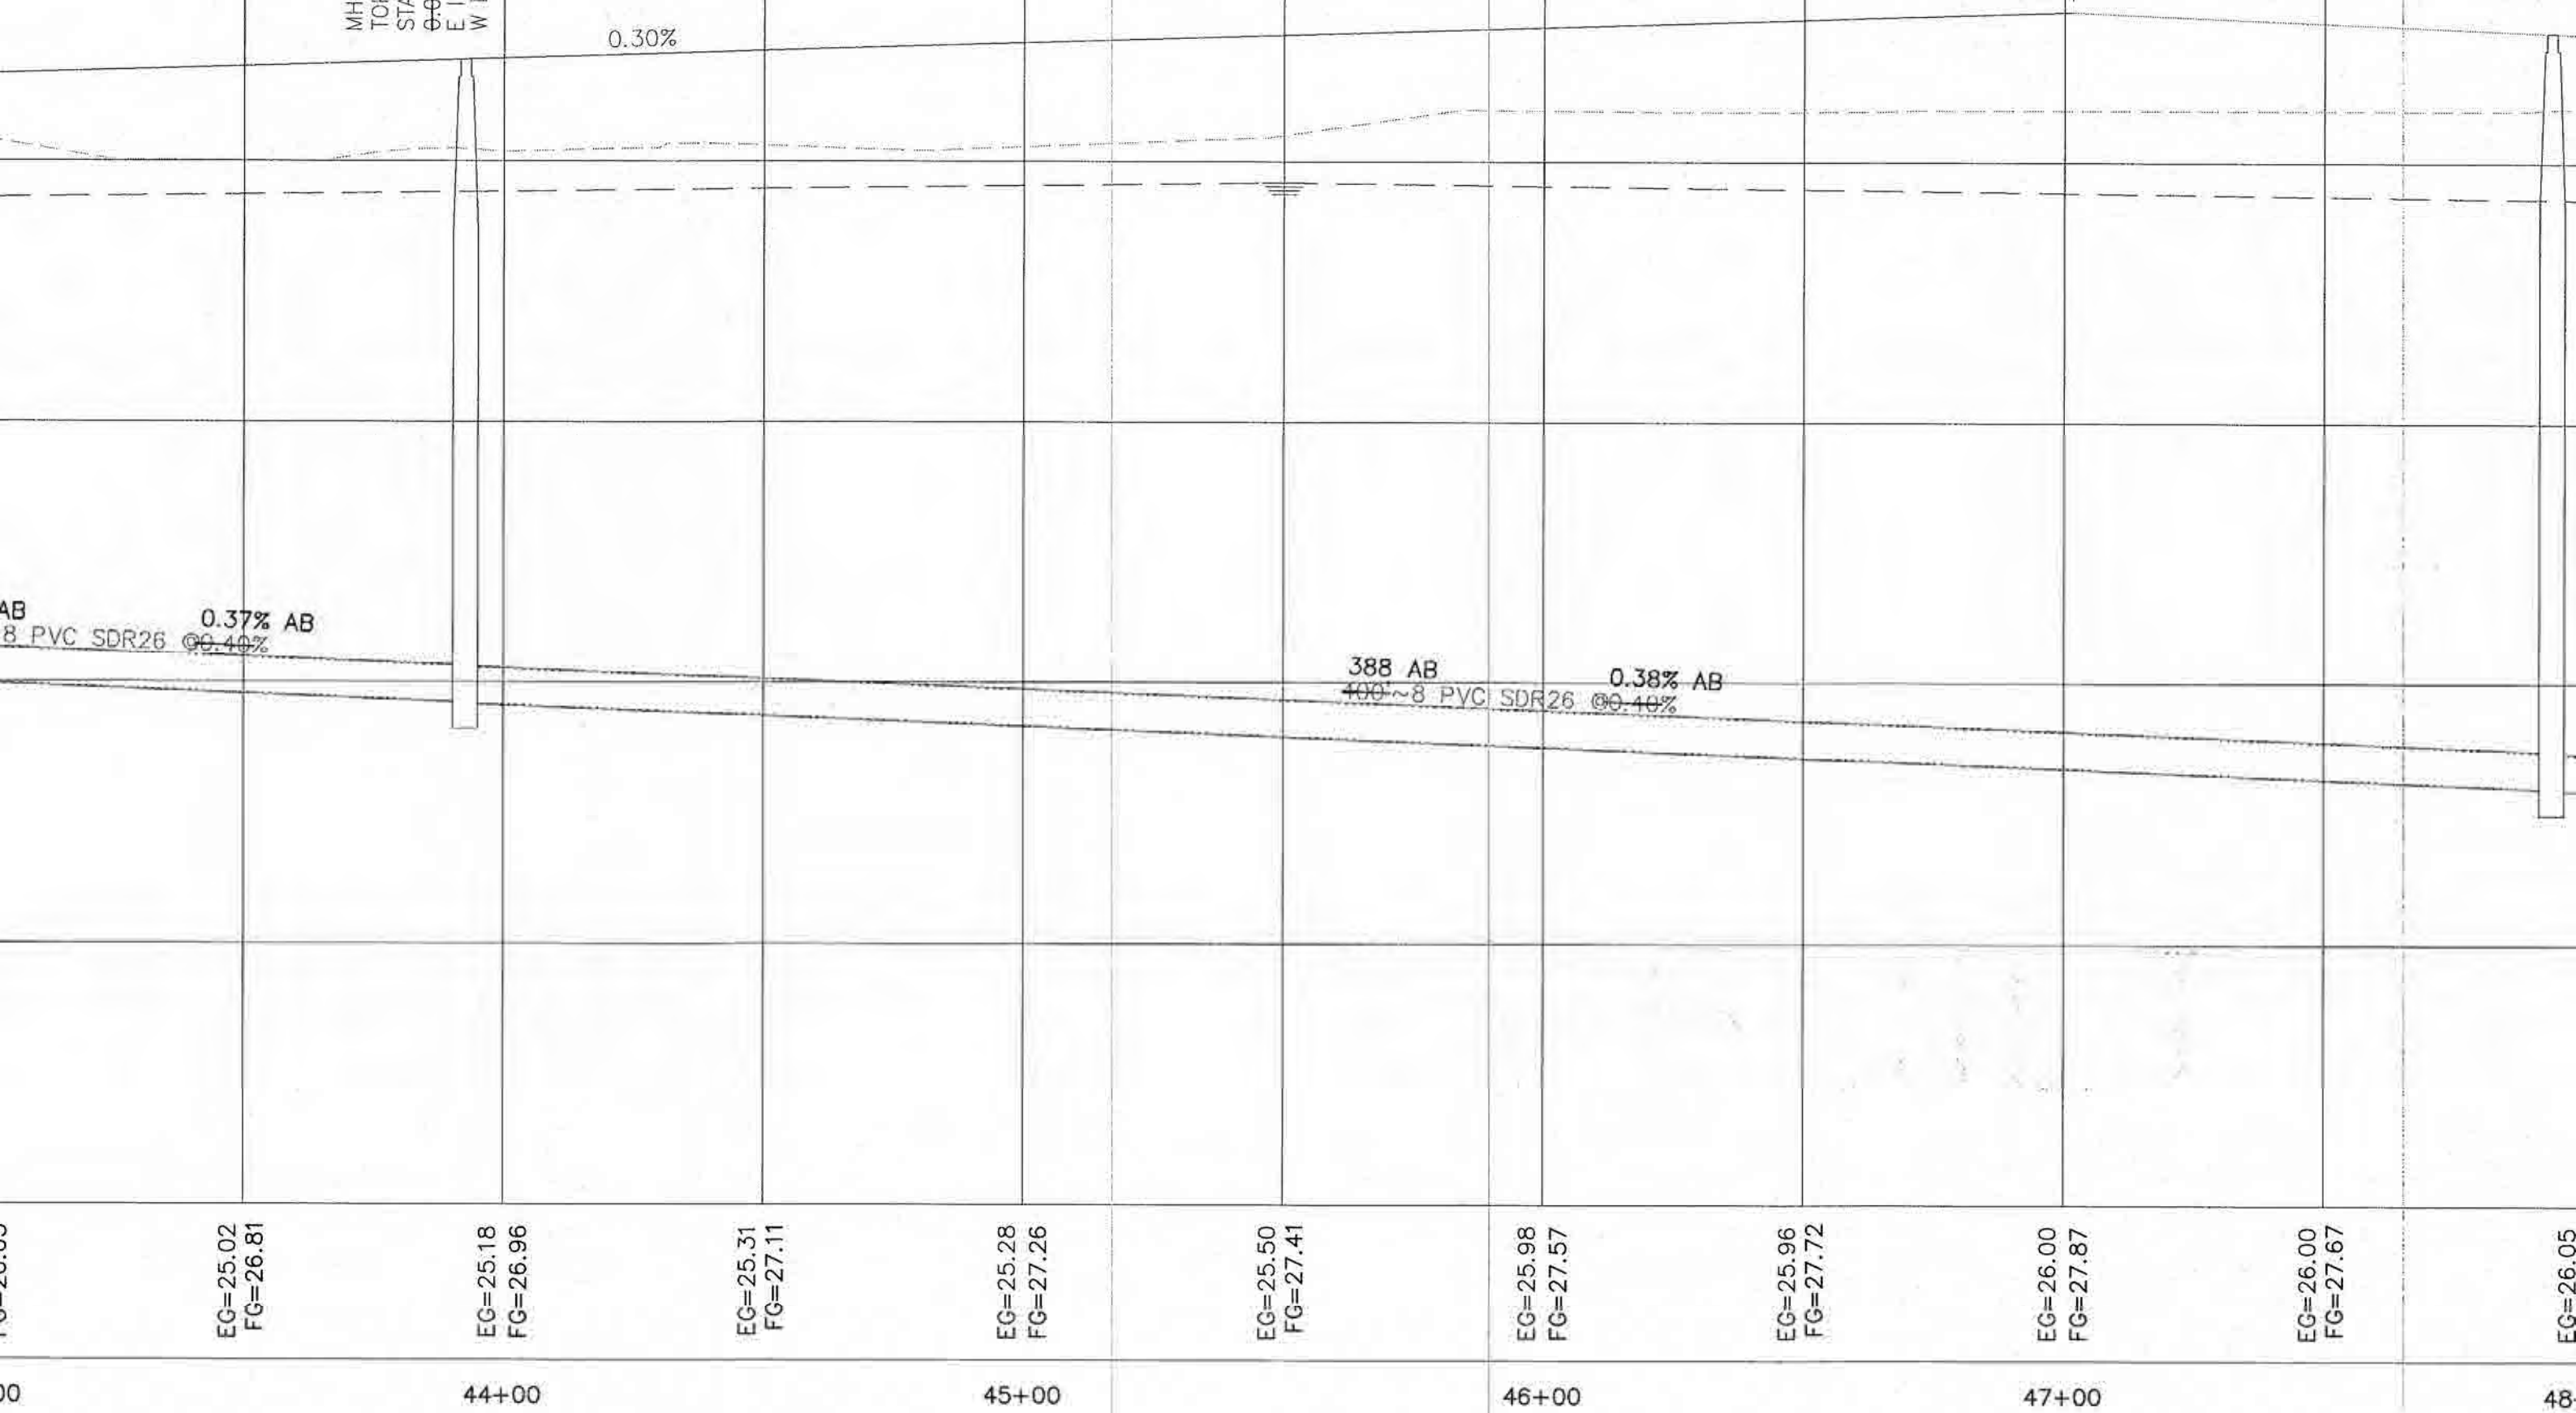


TURNBULL CREEK RD PROFILE

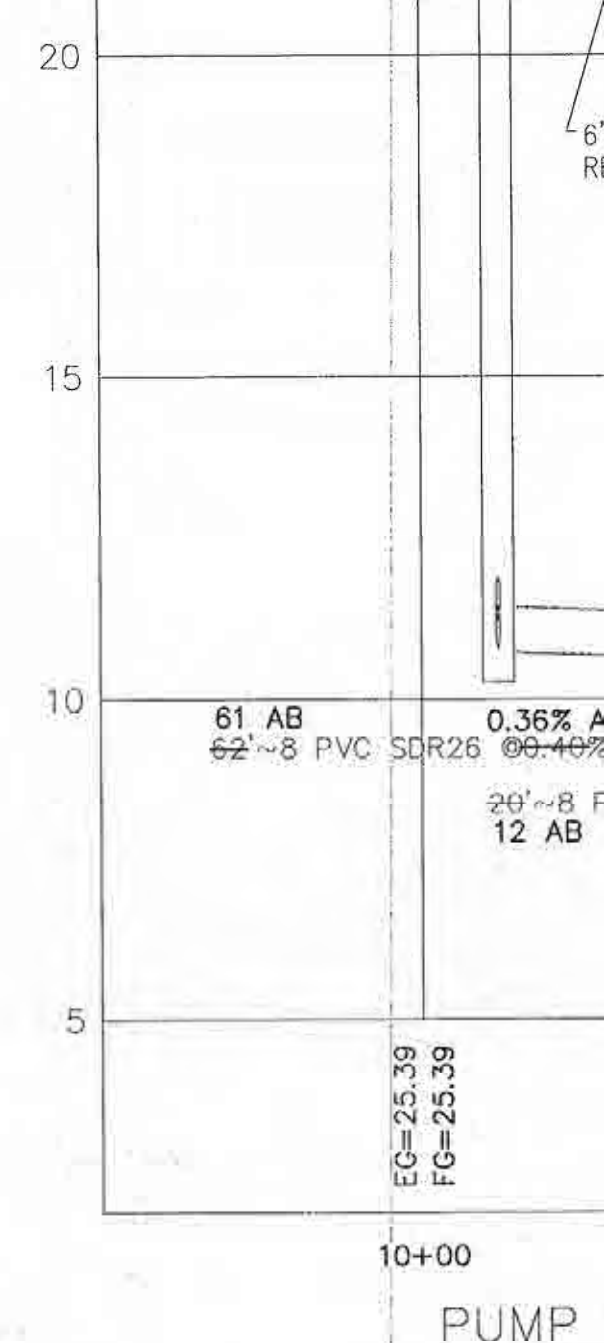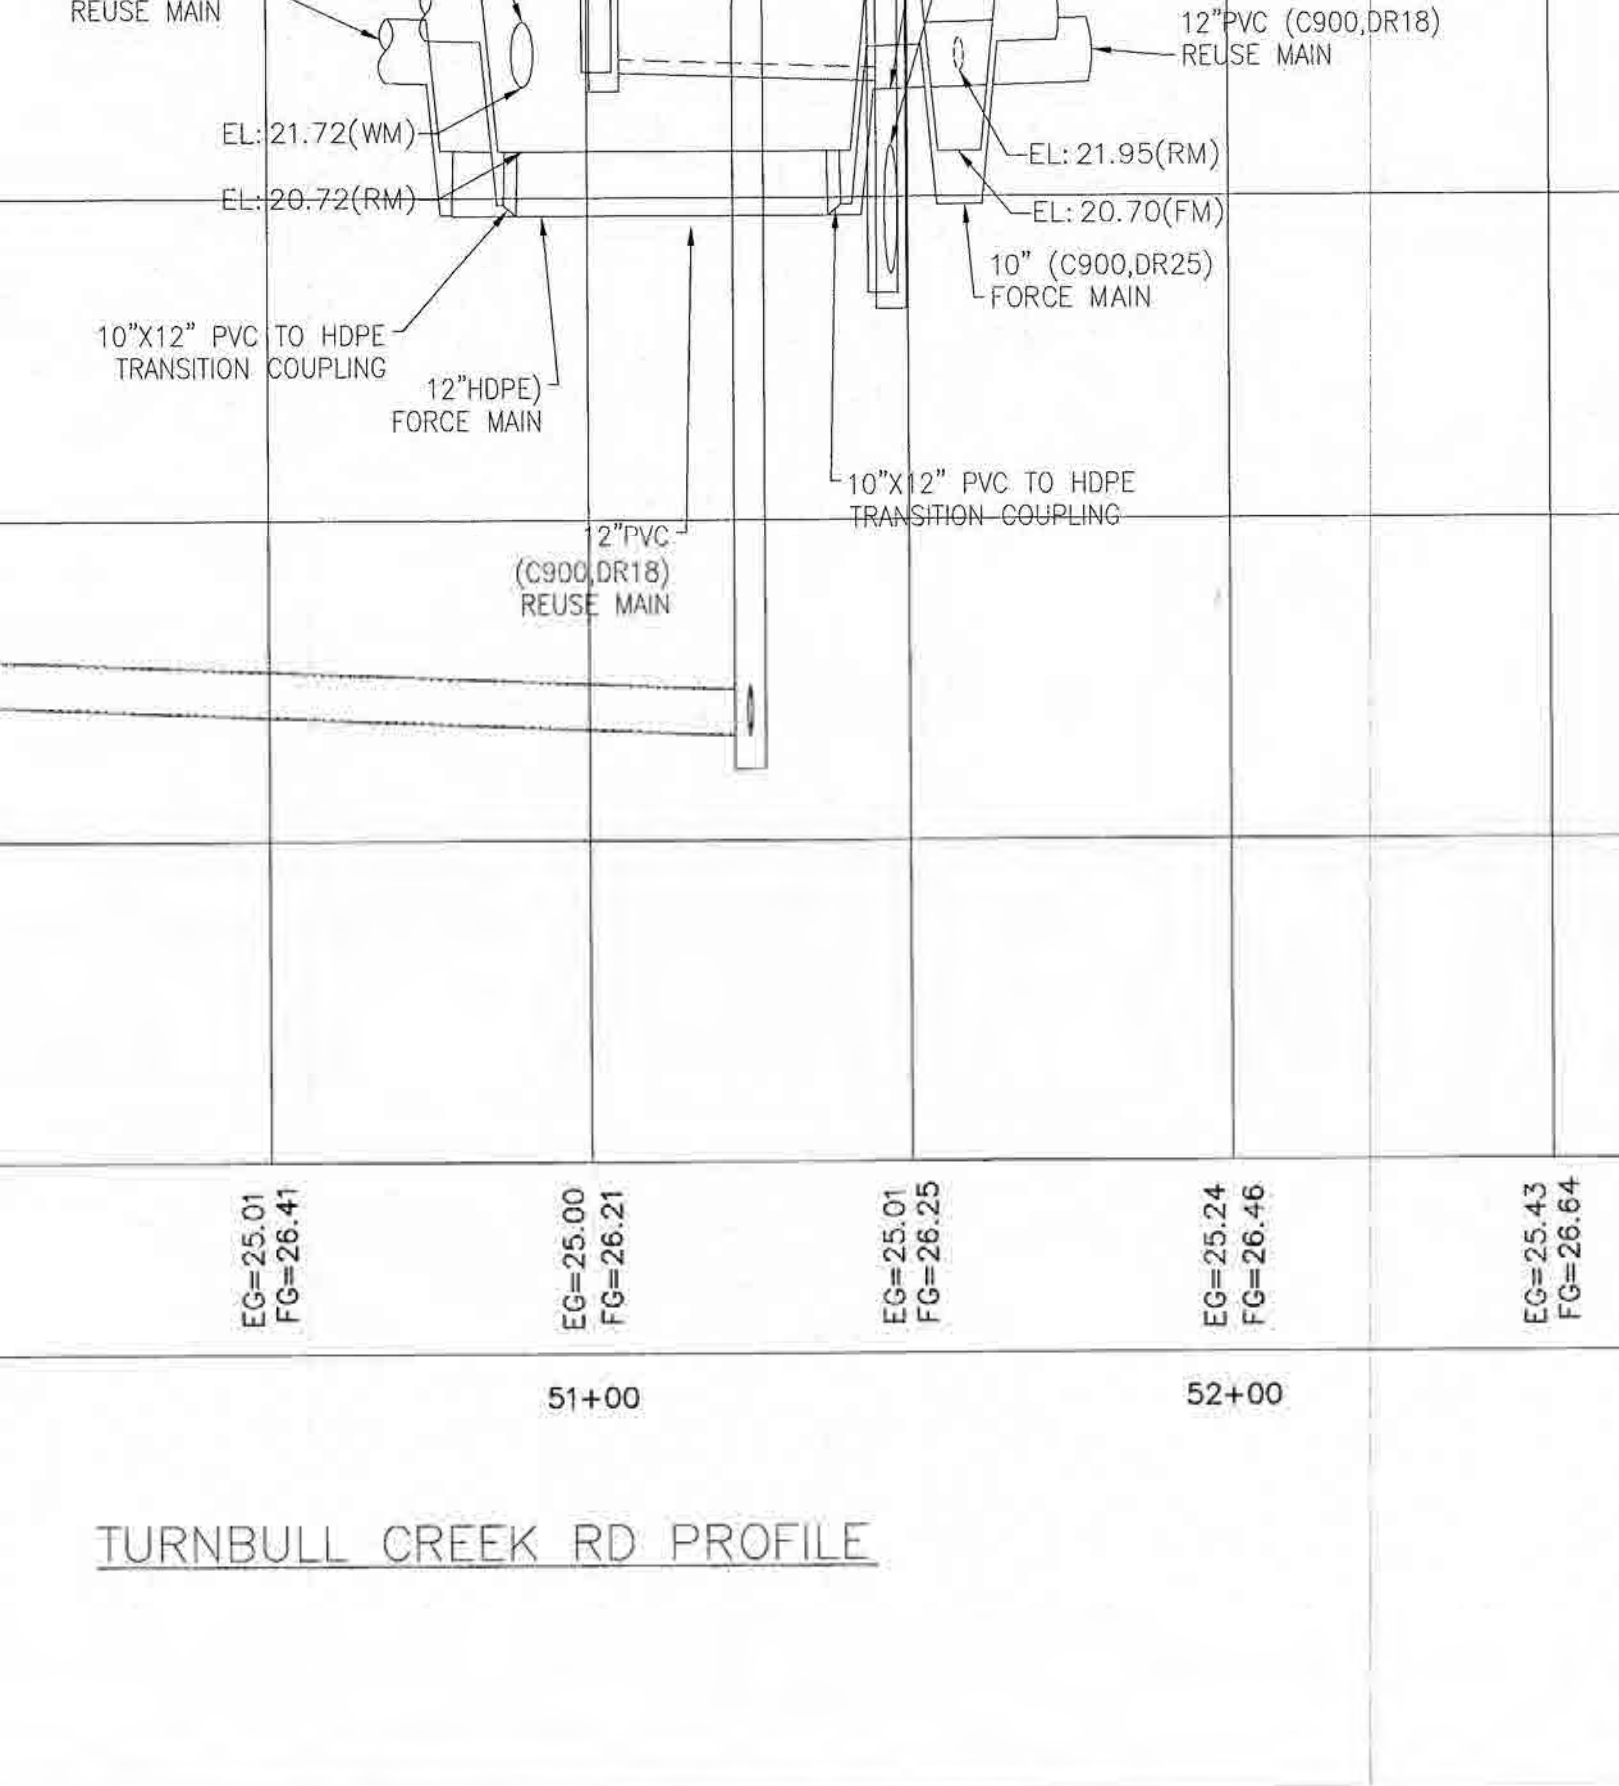



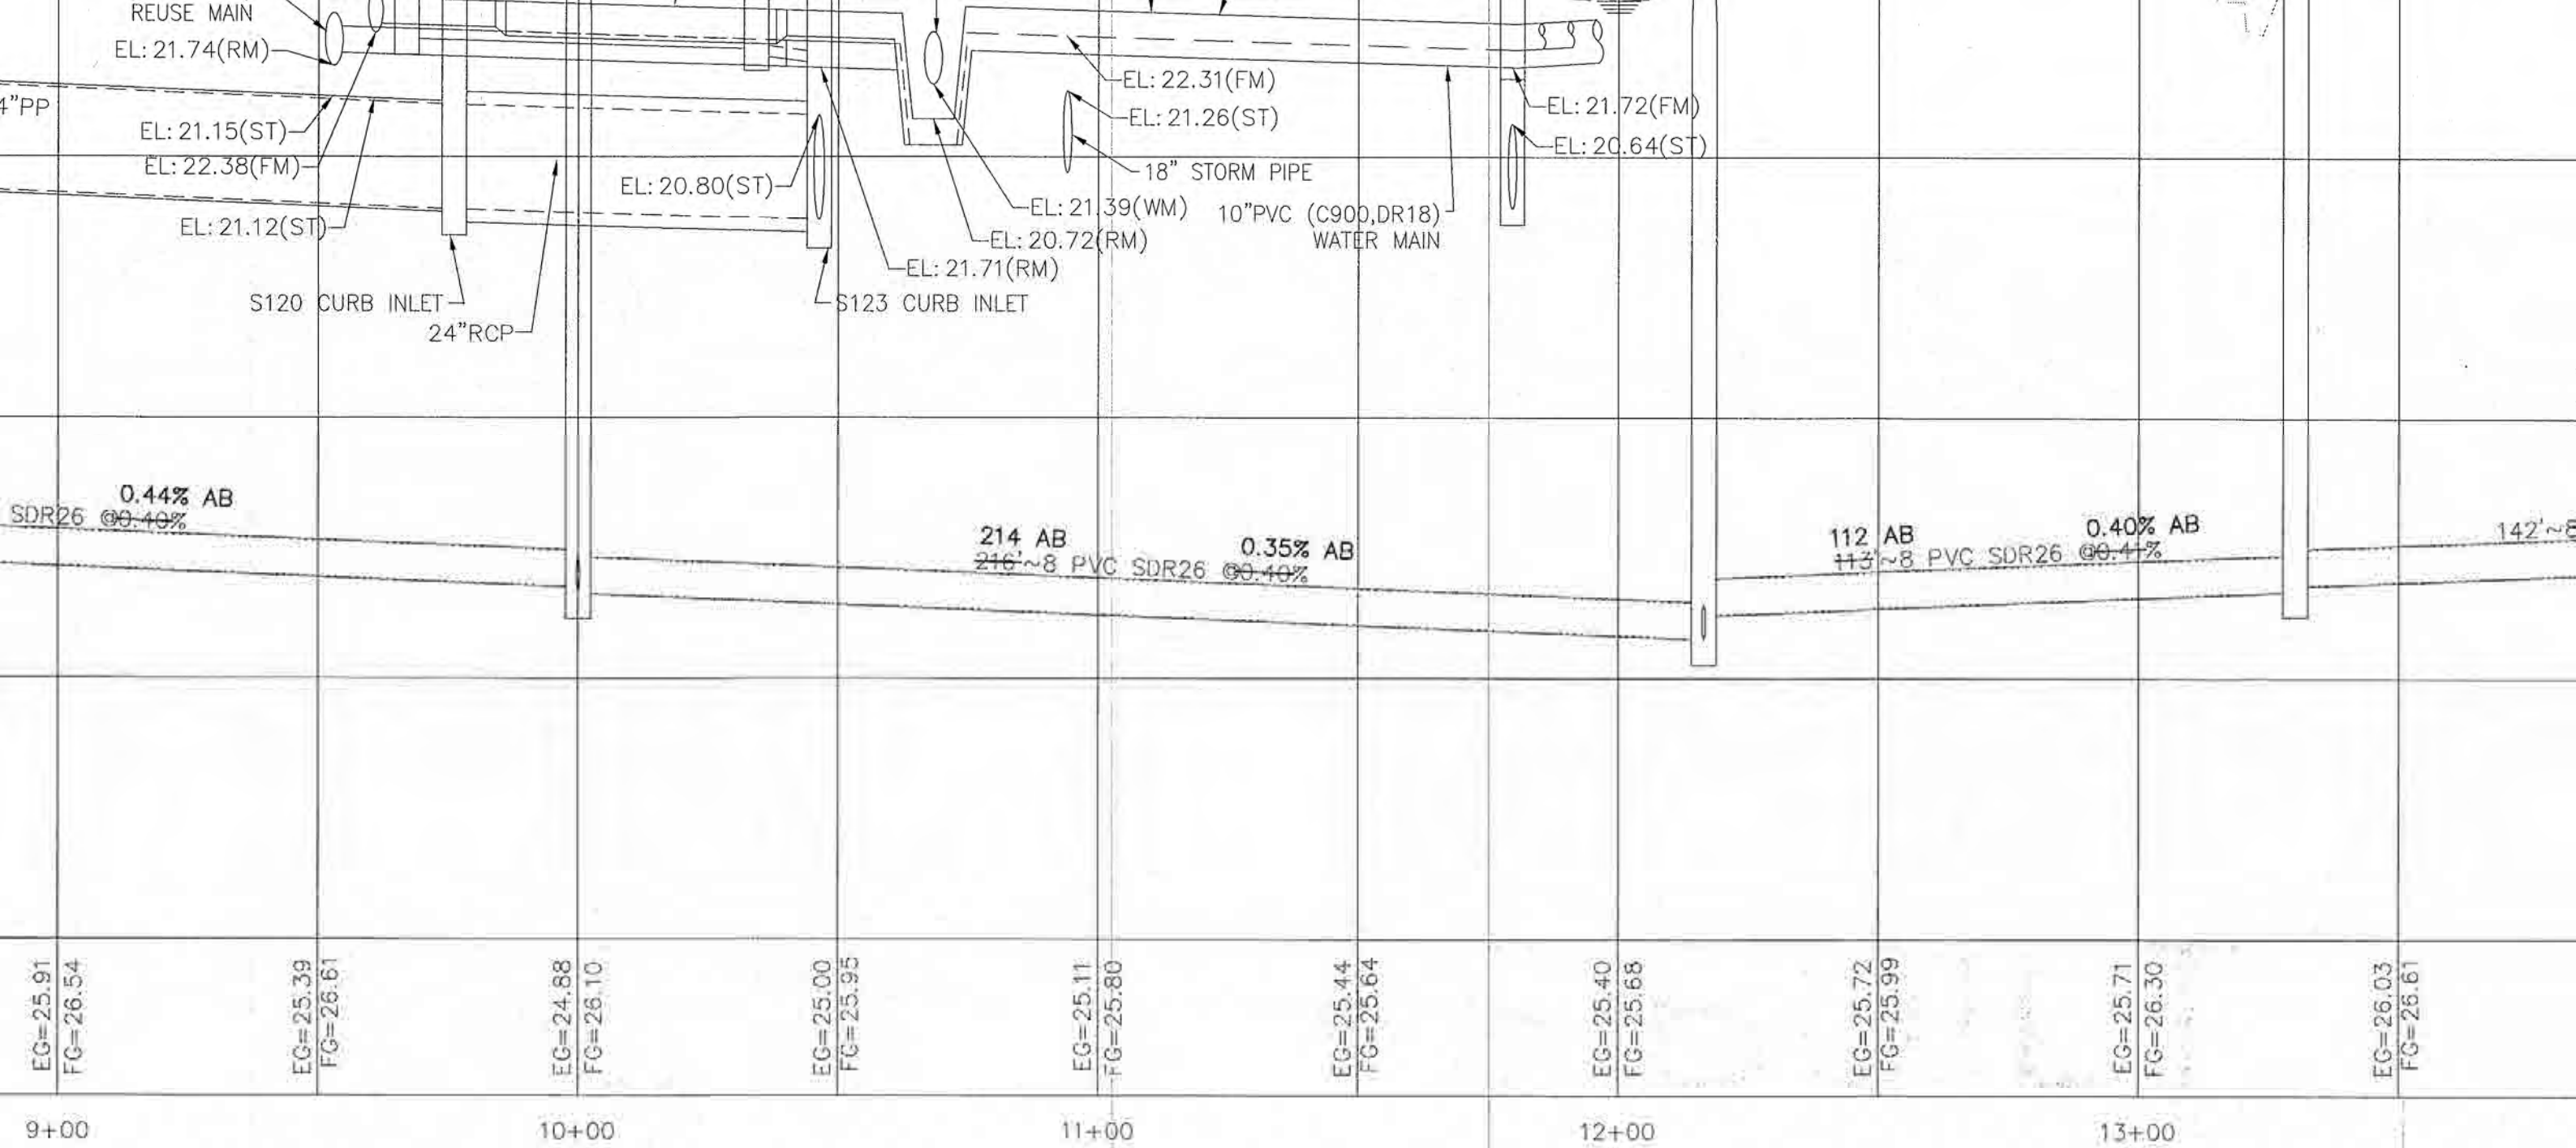



TULE RD PROFILE

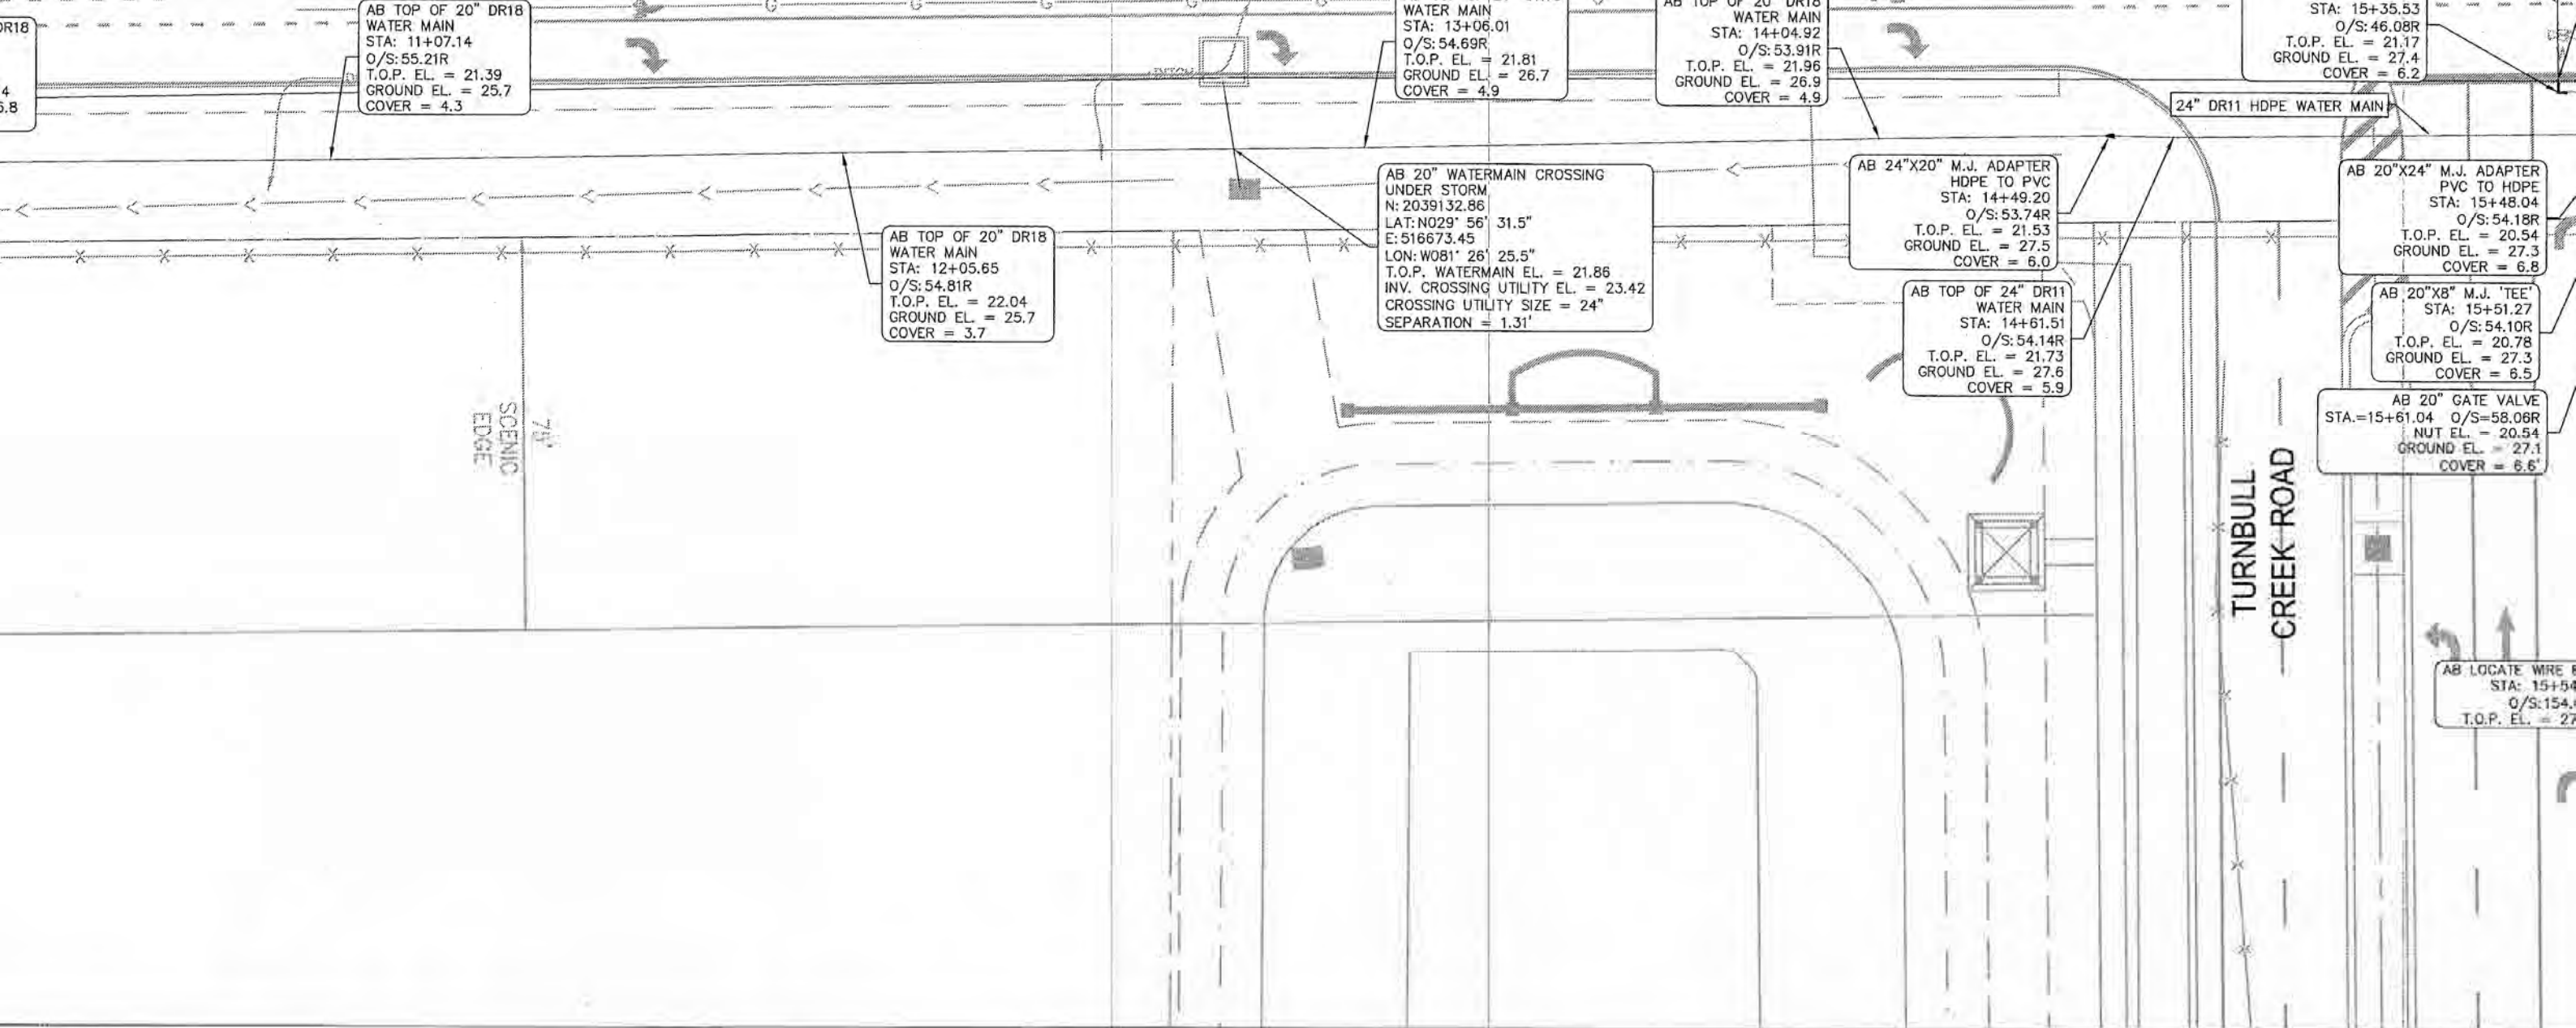


DETAIL #2
SCALE 1" = 10'

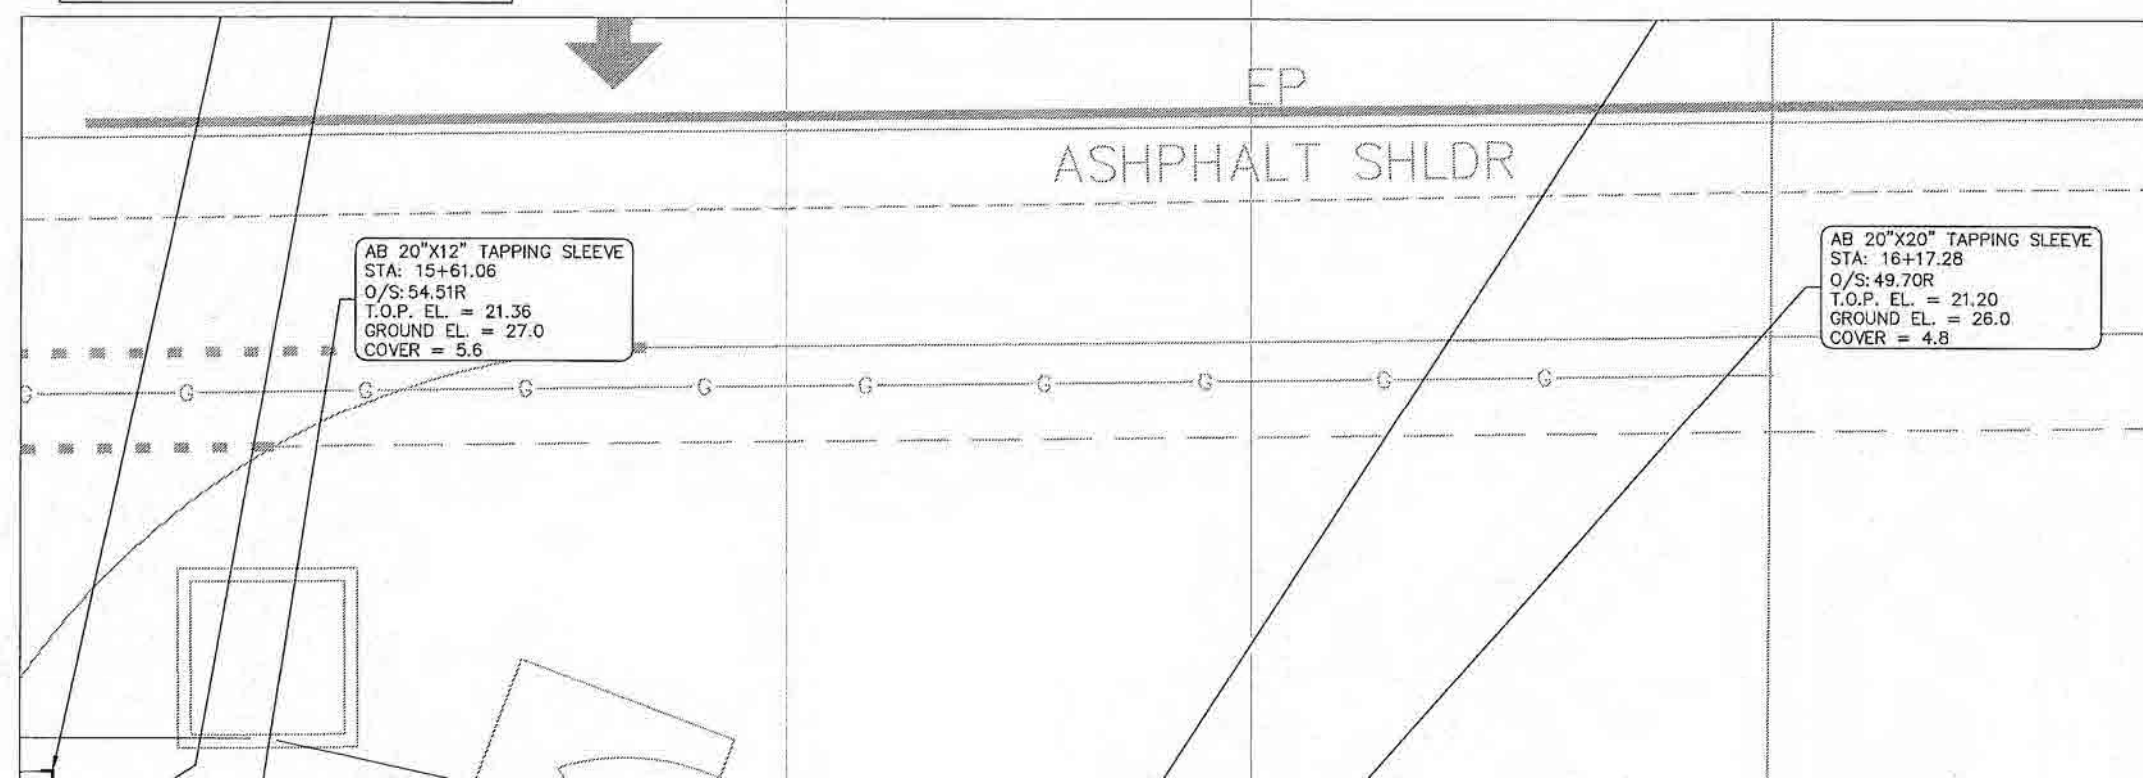

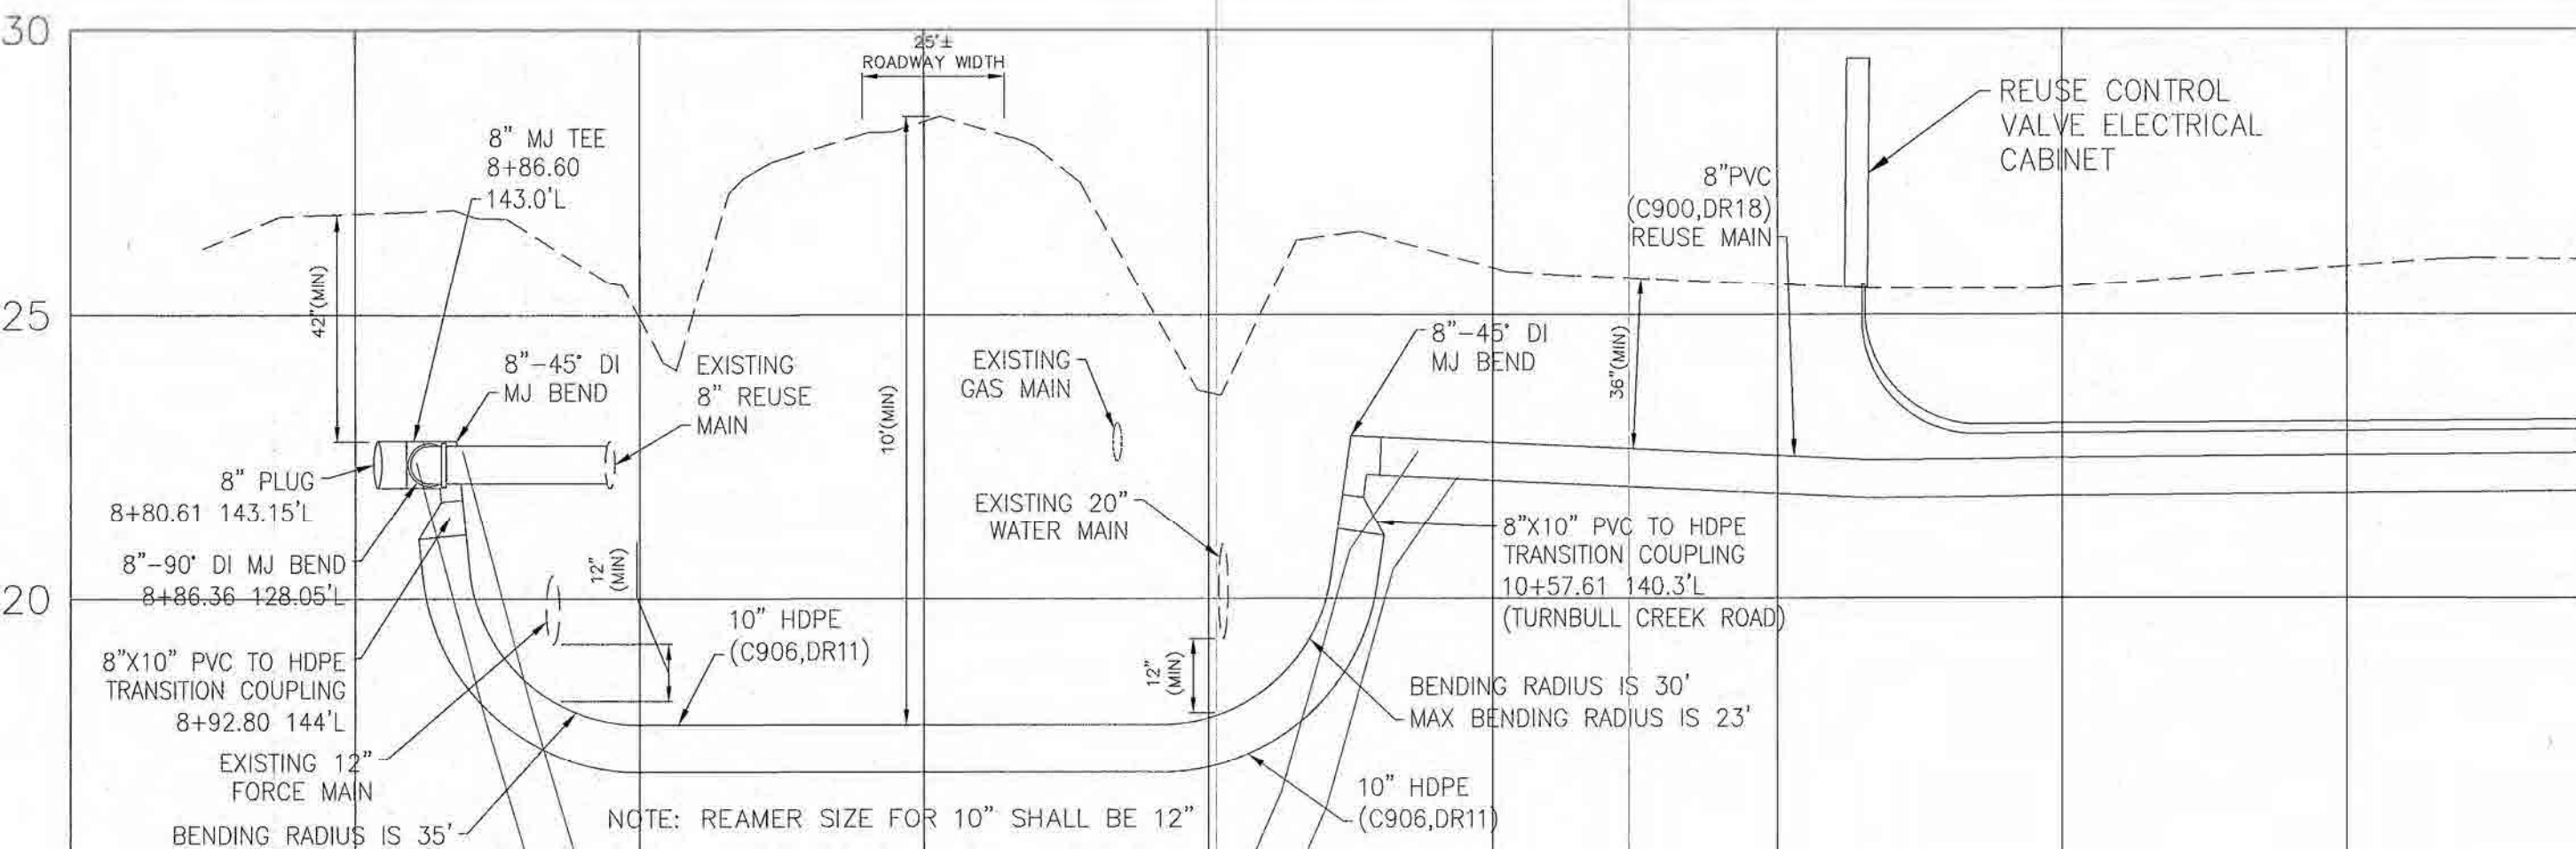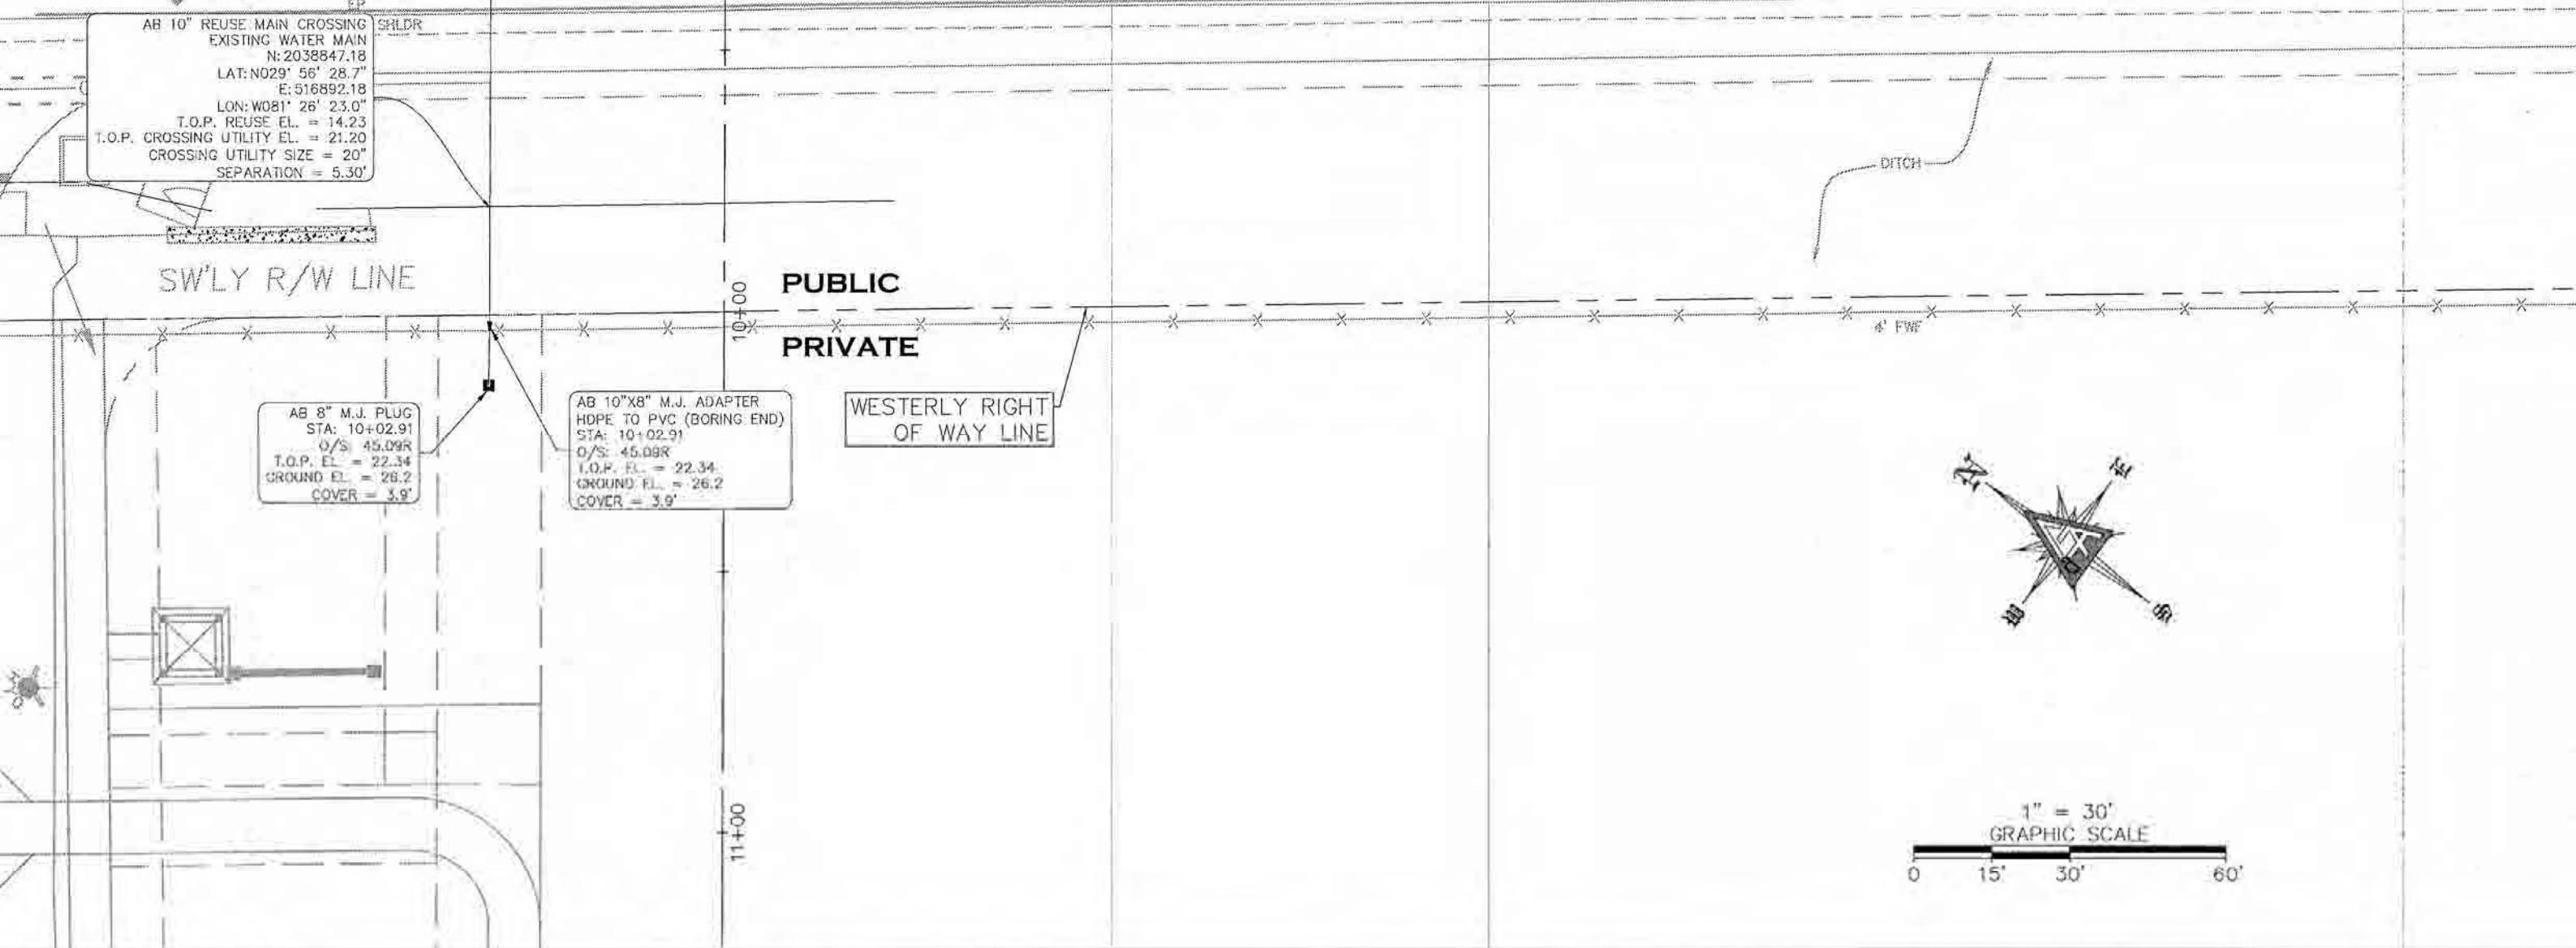

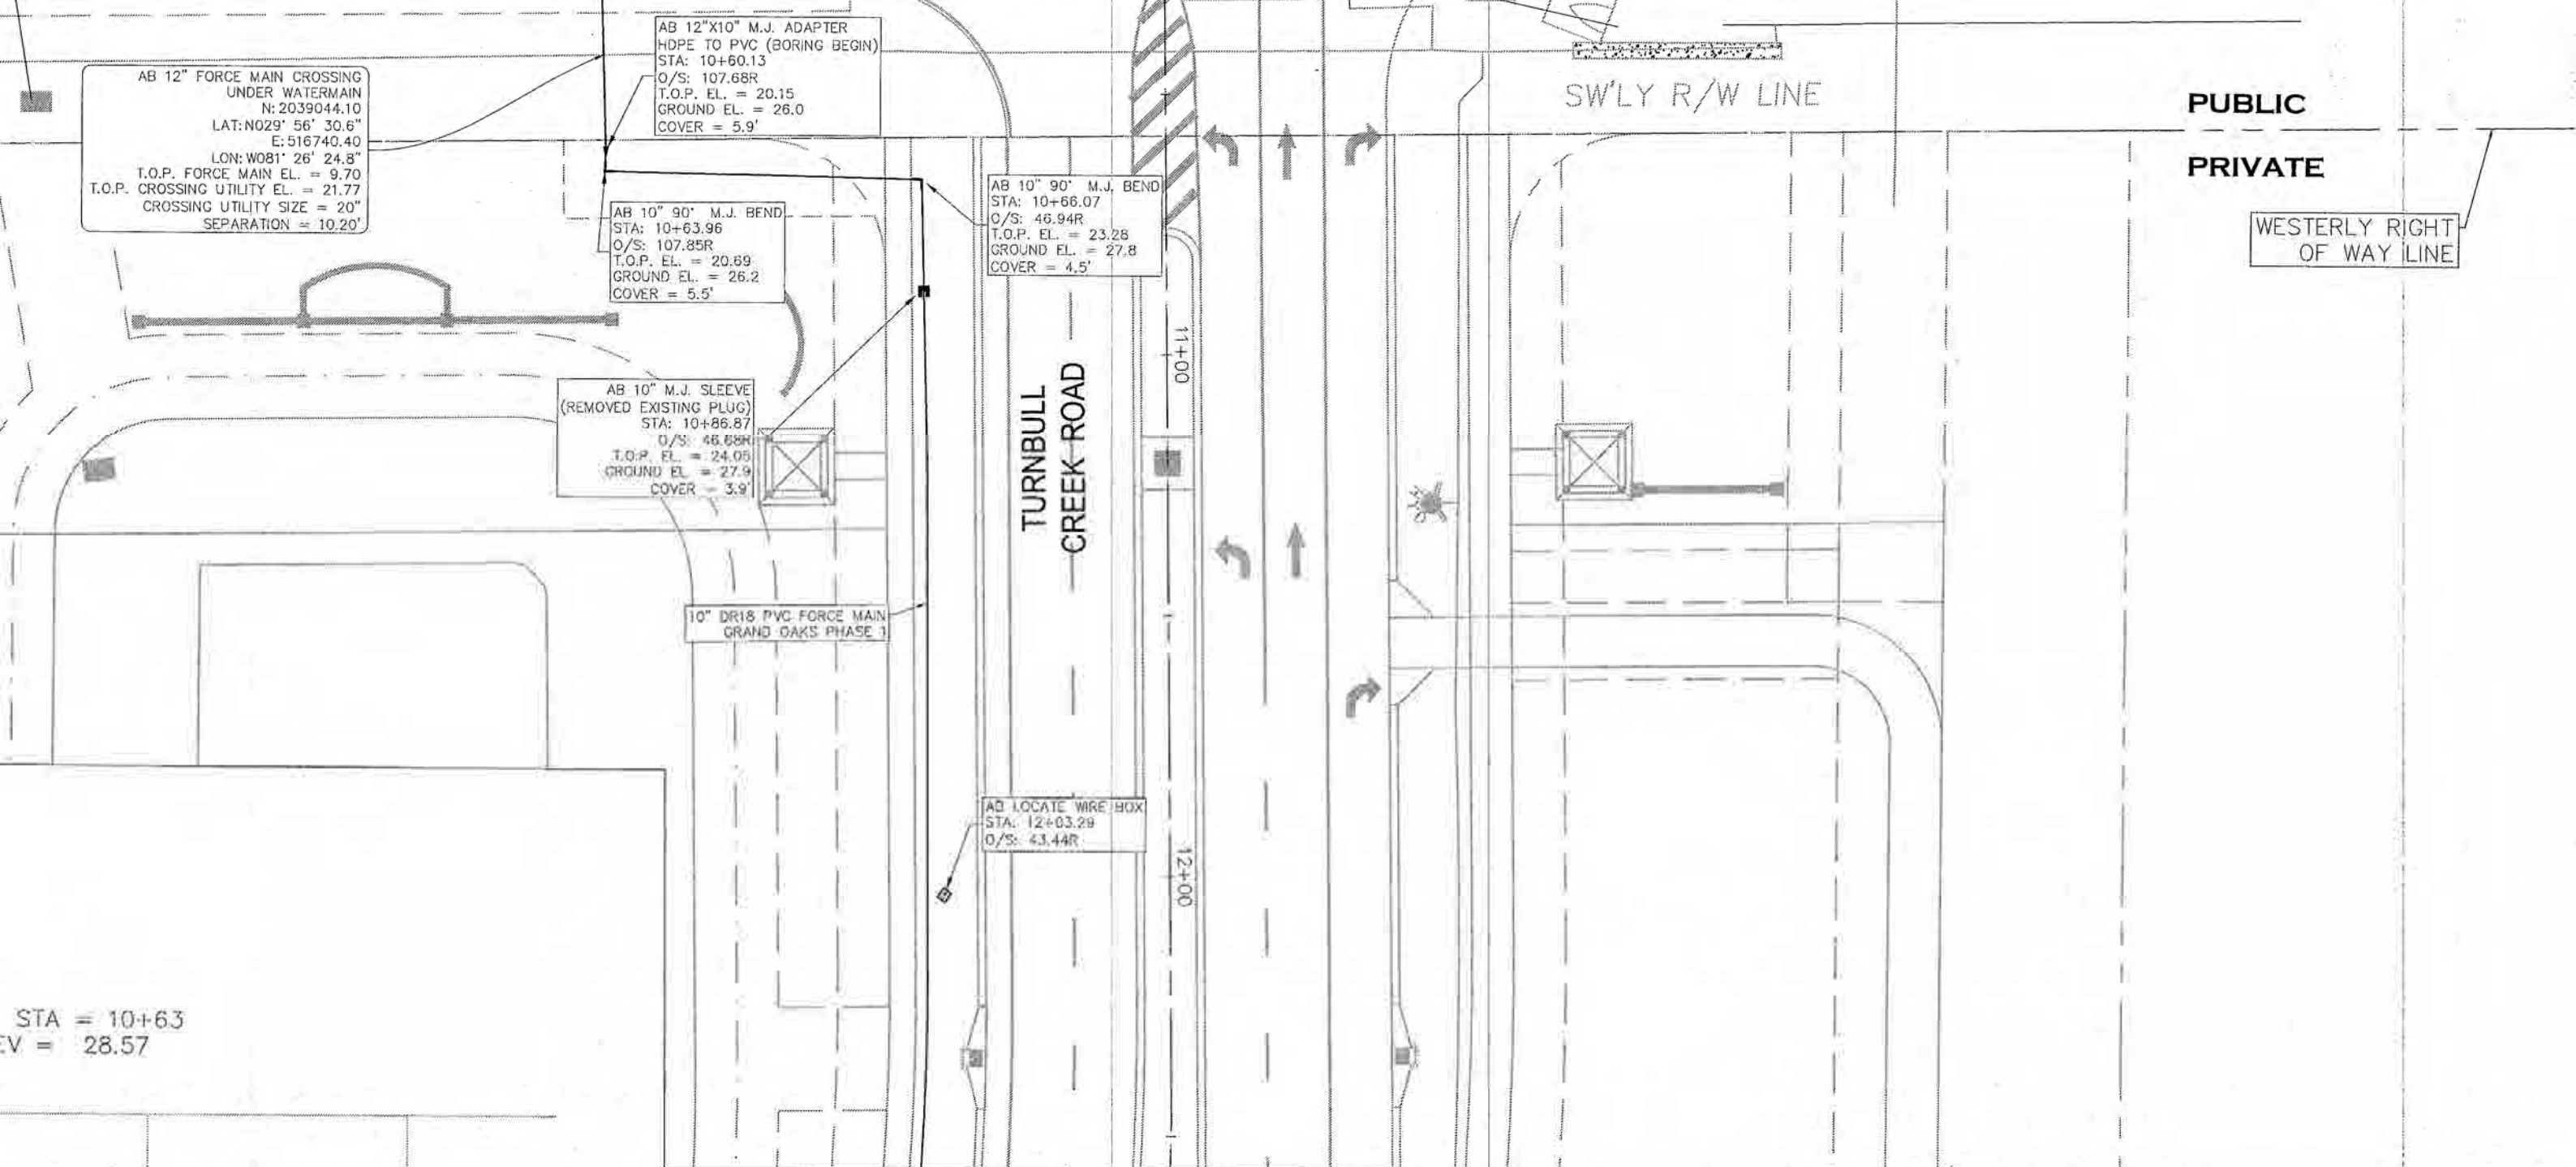

STA = 10+63
E.V. = 28.57

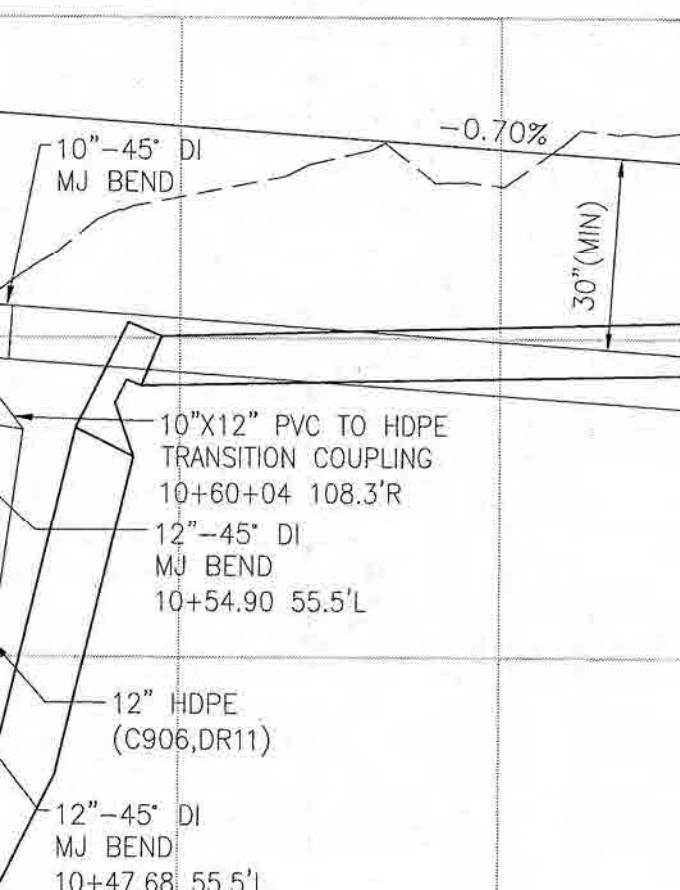

T B LANDMARK CONSTRUCTION, INC. BORE PROFILE LOG

OWNER/GC: W. Gardner LLC

DATE: 11/3/2020

SITE: Started dilling east under SR 16

STATION START: 89' west of c/l to SR 16, 110' north of c/l to turn bull creek rd

STATION END: 33' east of c/l to state road 16, 115' noth of c/l to tomoka pines

JOB NUMBER: 8384

BORE #: 2

JOB NAME: Grand Oaks Phase 1

SIZE: 12"

DRILLER: Carlos Rivera / Lee Ashbaugh

PIPE TYPE: HDPE

ROD	DEPTH	STATION #
15	3'6"	Power 4'
30	8'5"	
45	11'10"	Water main 6' top
60	15'9"	
75	18'11"	Gas 4'
90	18'11"	
105	17'1"	

ROD	DEPTH	STATION #
540		
555		
570		
585		
600		
615		
630		

FO

2022 MWS Grand Oaks Offsite Watermain As Built Drawings









- LEGEND**
- ± - DENOTES PLUS OR MINUS
 - AB - DENOTES AS-BUILT
 - AL - DENOTES ARC LENGTH
 - ALUM - DENOTES ALUMINUM
 - BM - DENOTES BENCHMARK
 - BOC - DENOTES BACK OF CURB
 - ℄ - DENOTES CENTERLINE
 - C# - DENOTES CURVE NUMBER
 - C/L - DENOTES CENTERLINE
 - CB - DENOTES CHORD BEARING



AS-BUILT) AS

VICINITY MAP

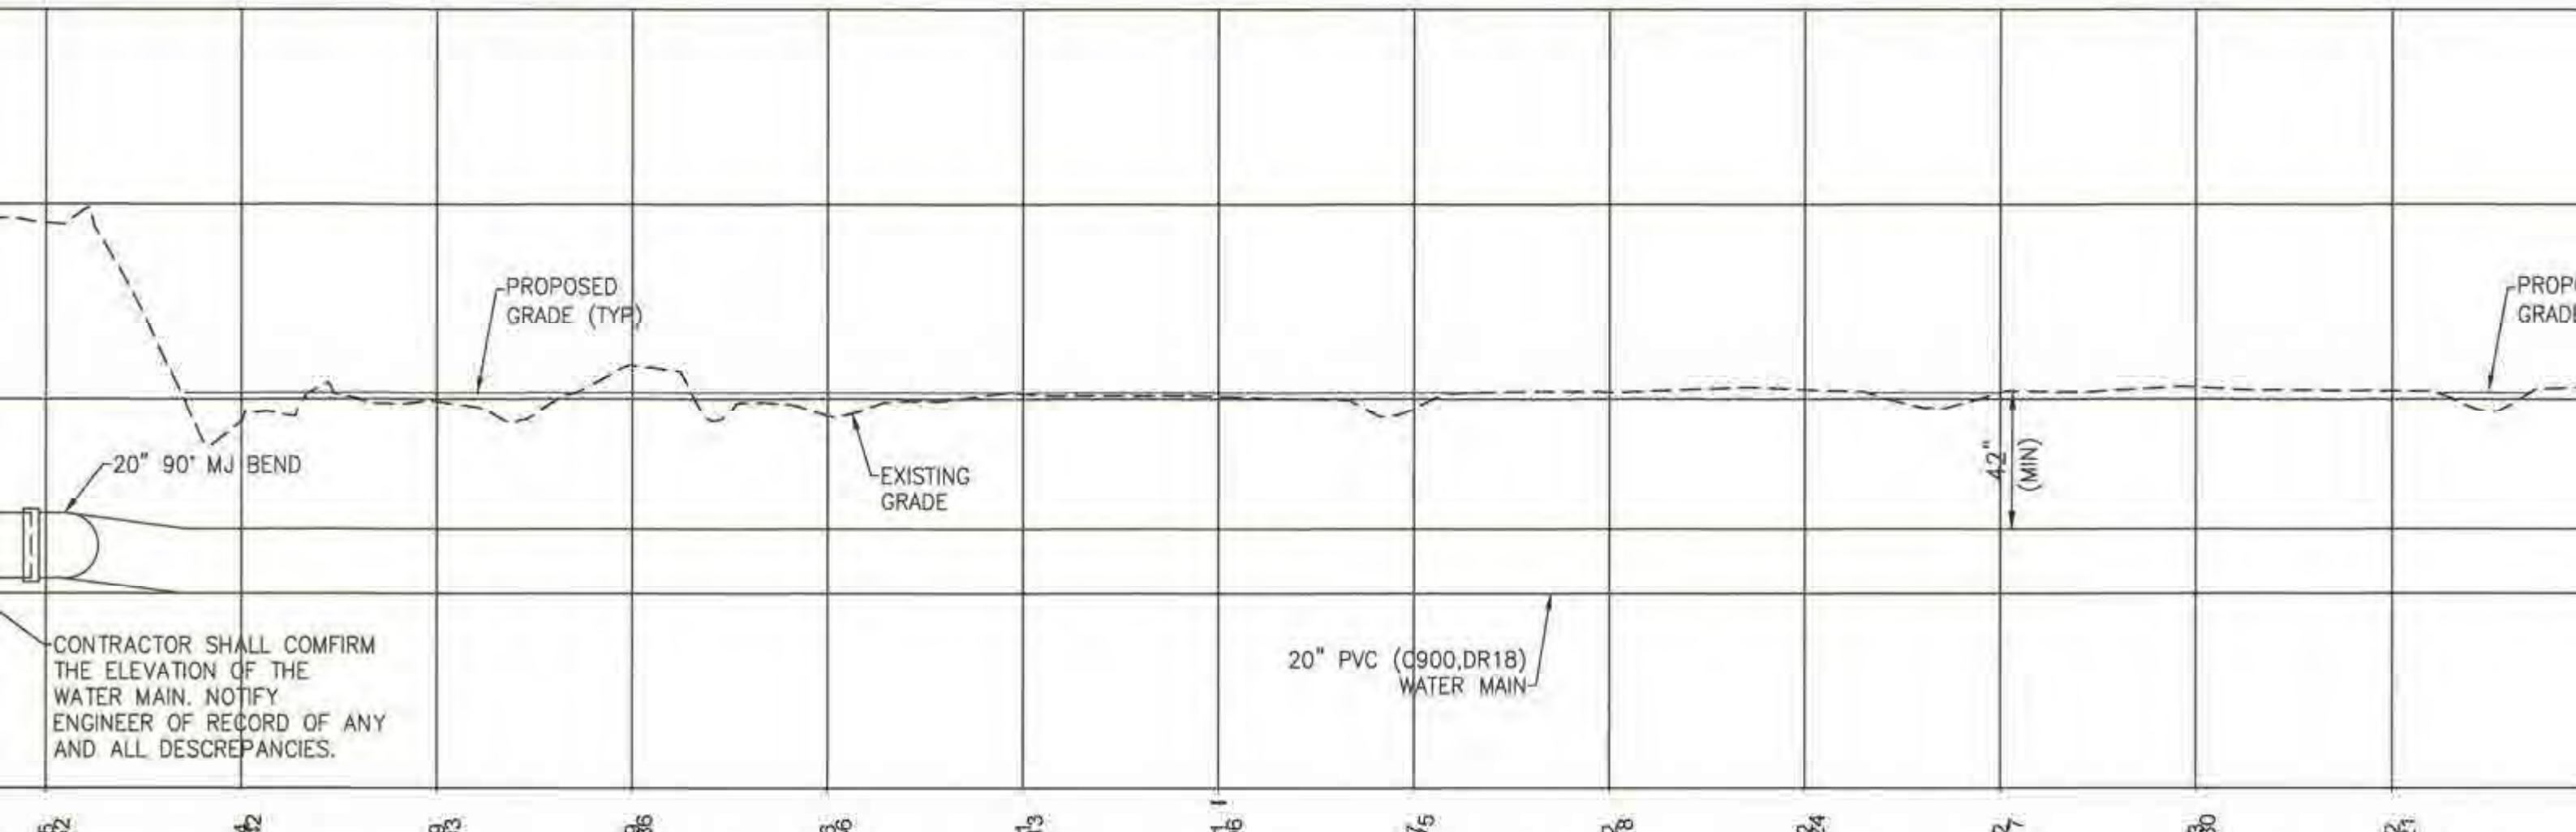

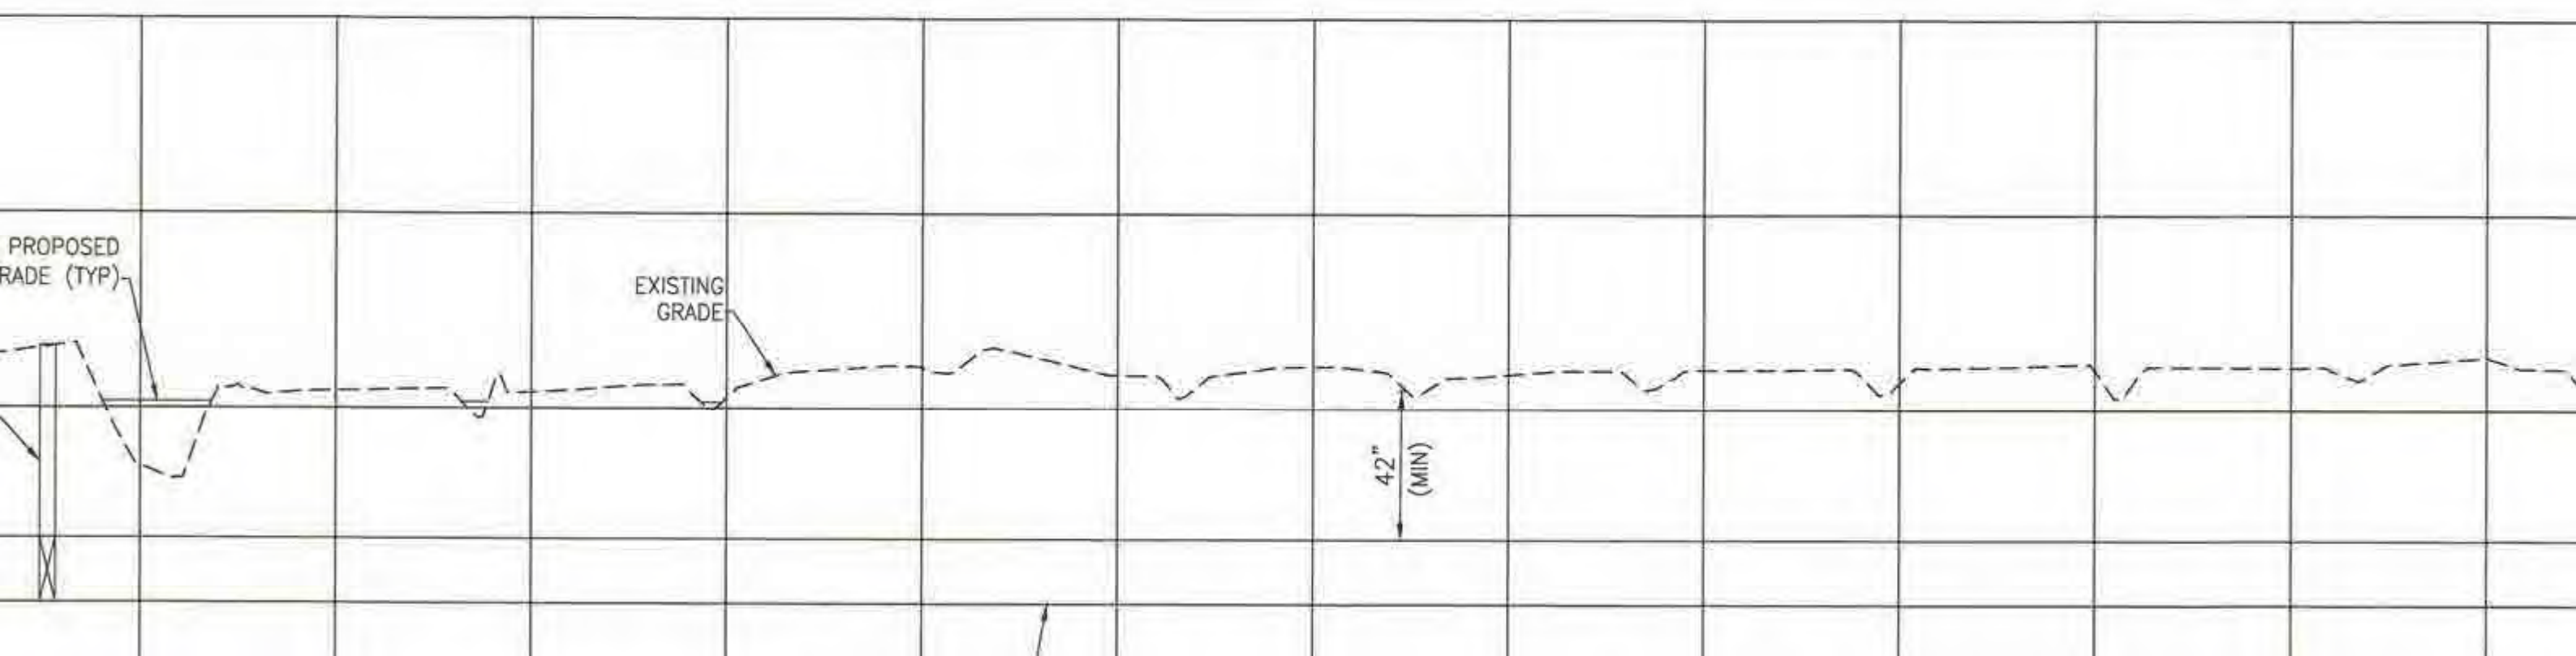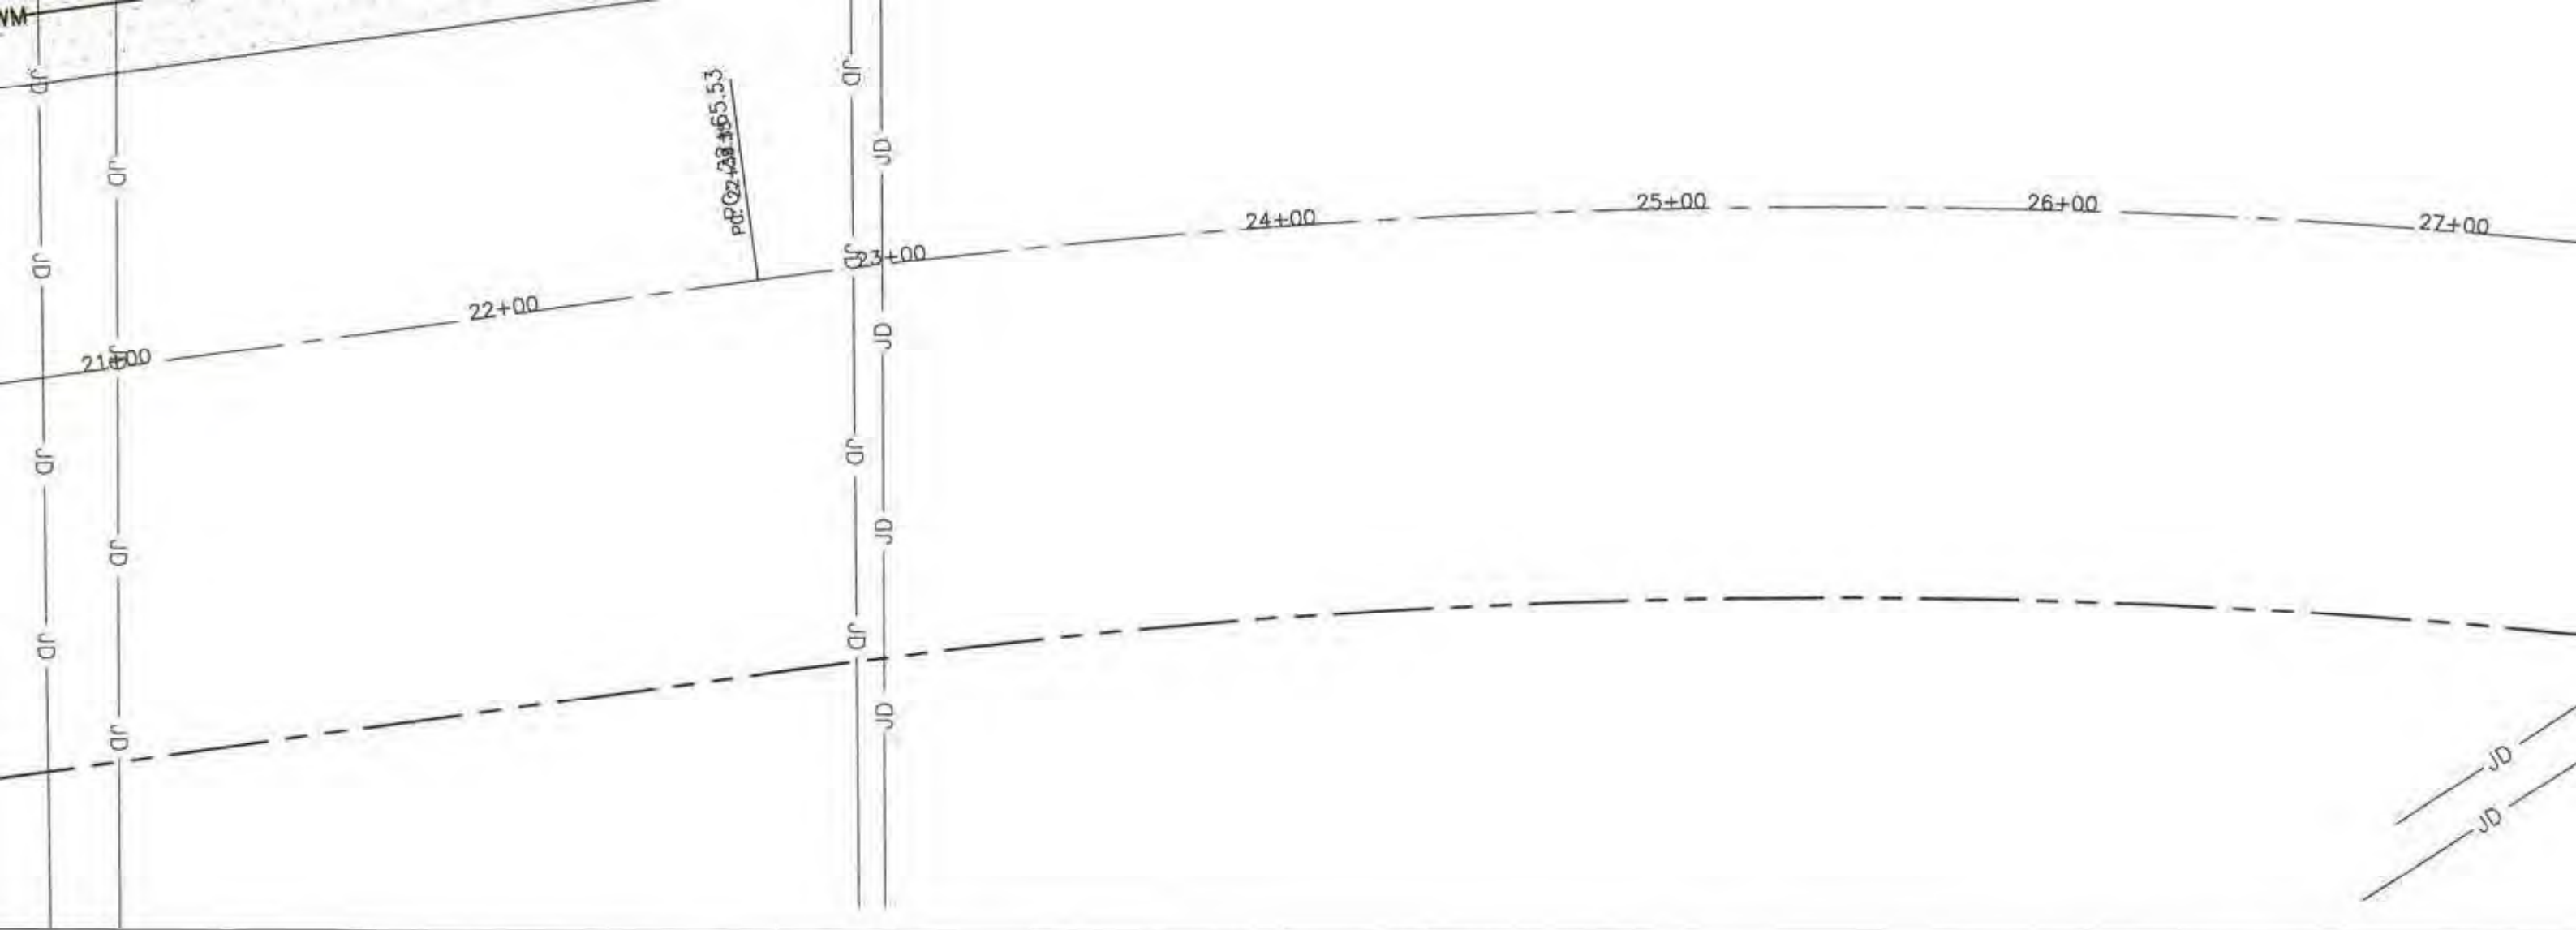

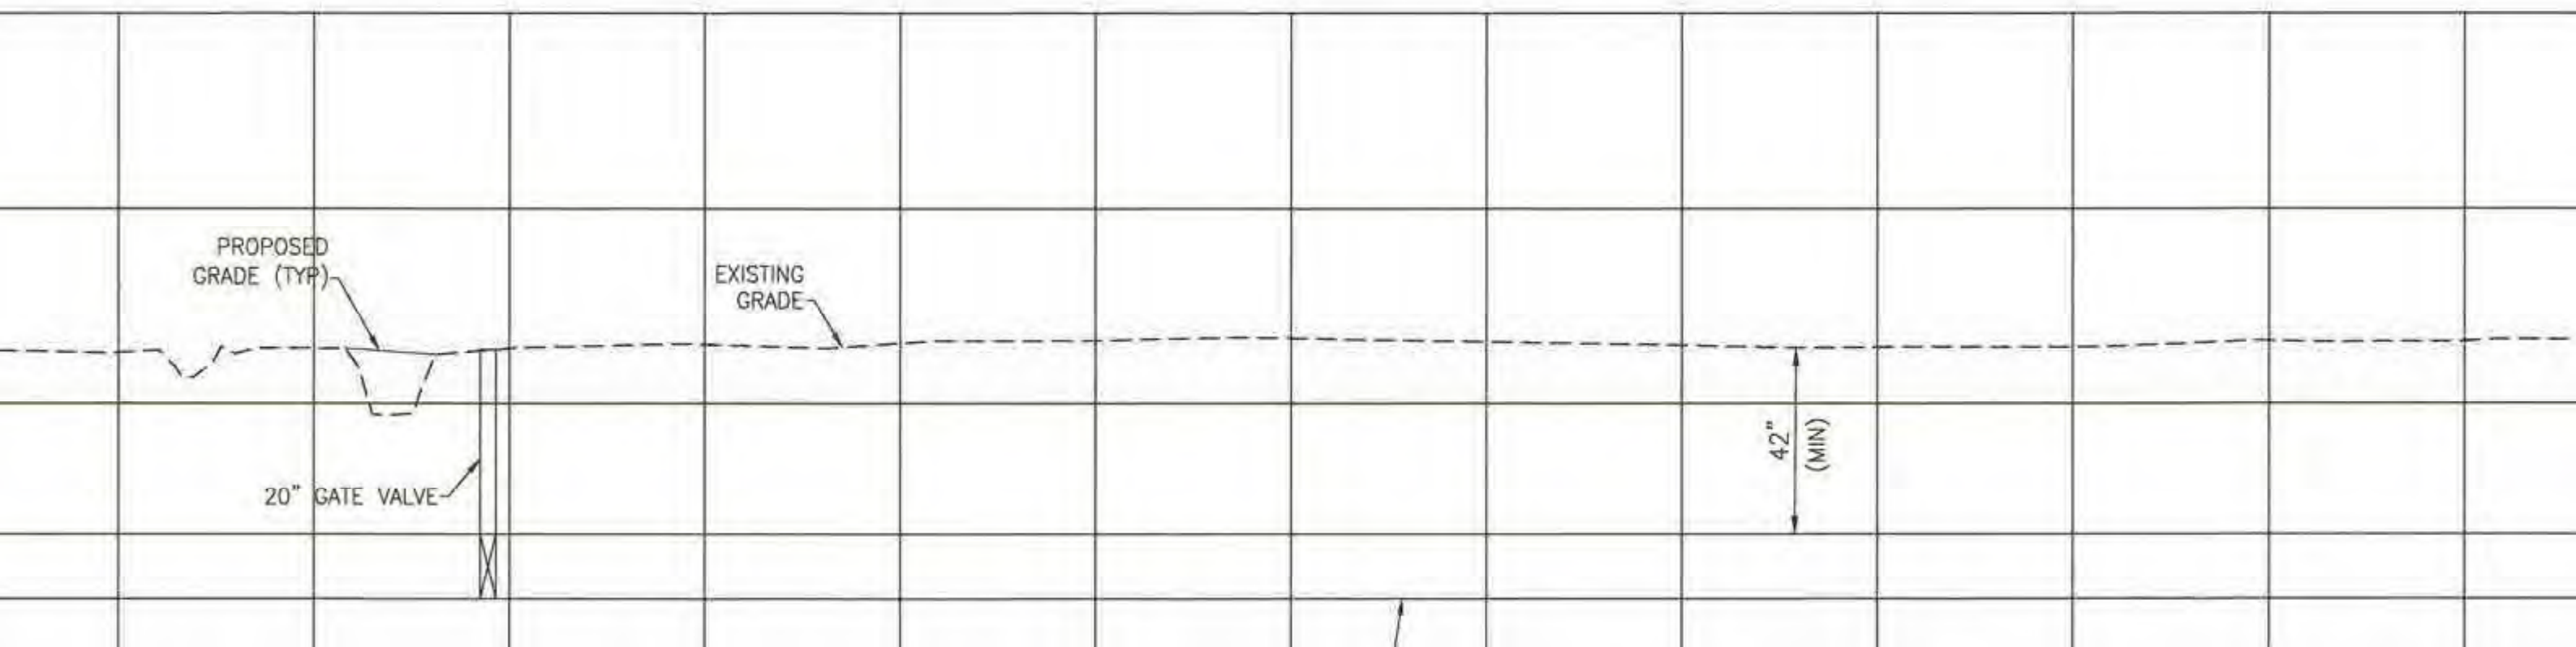

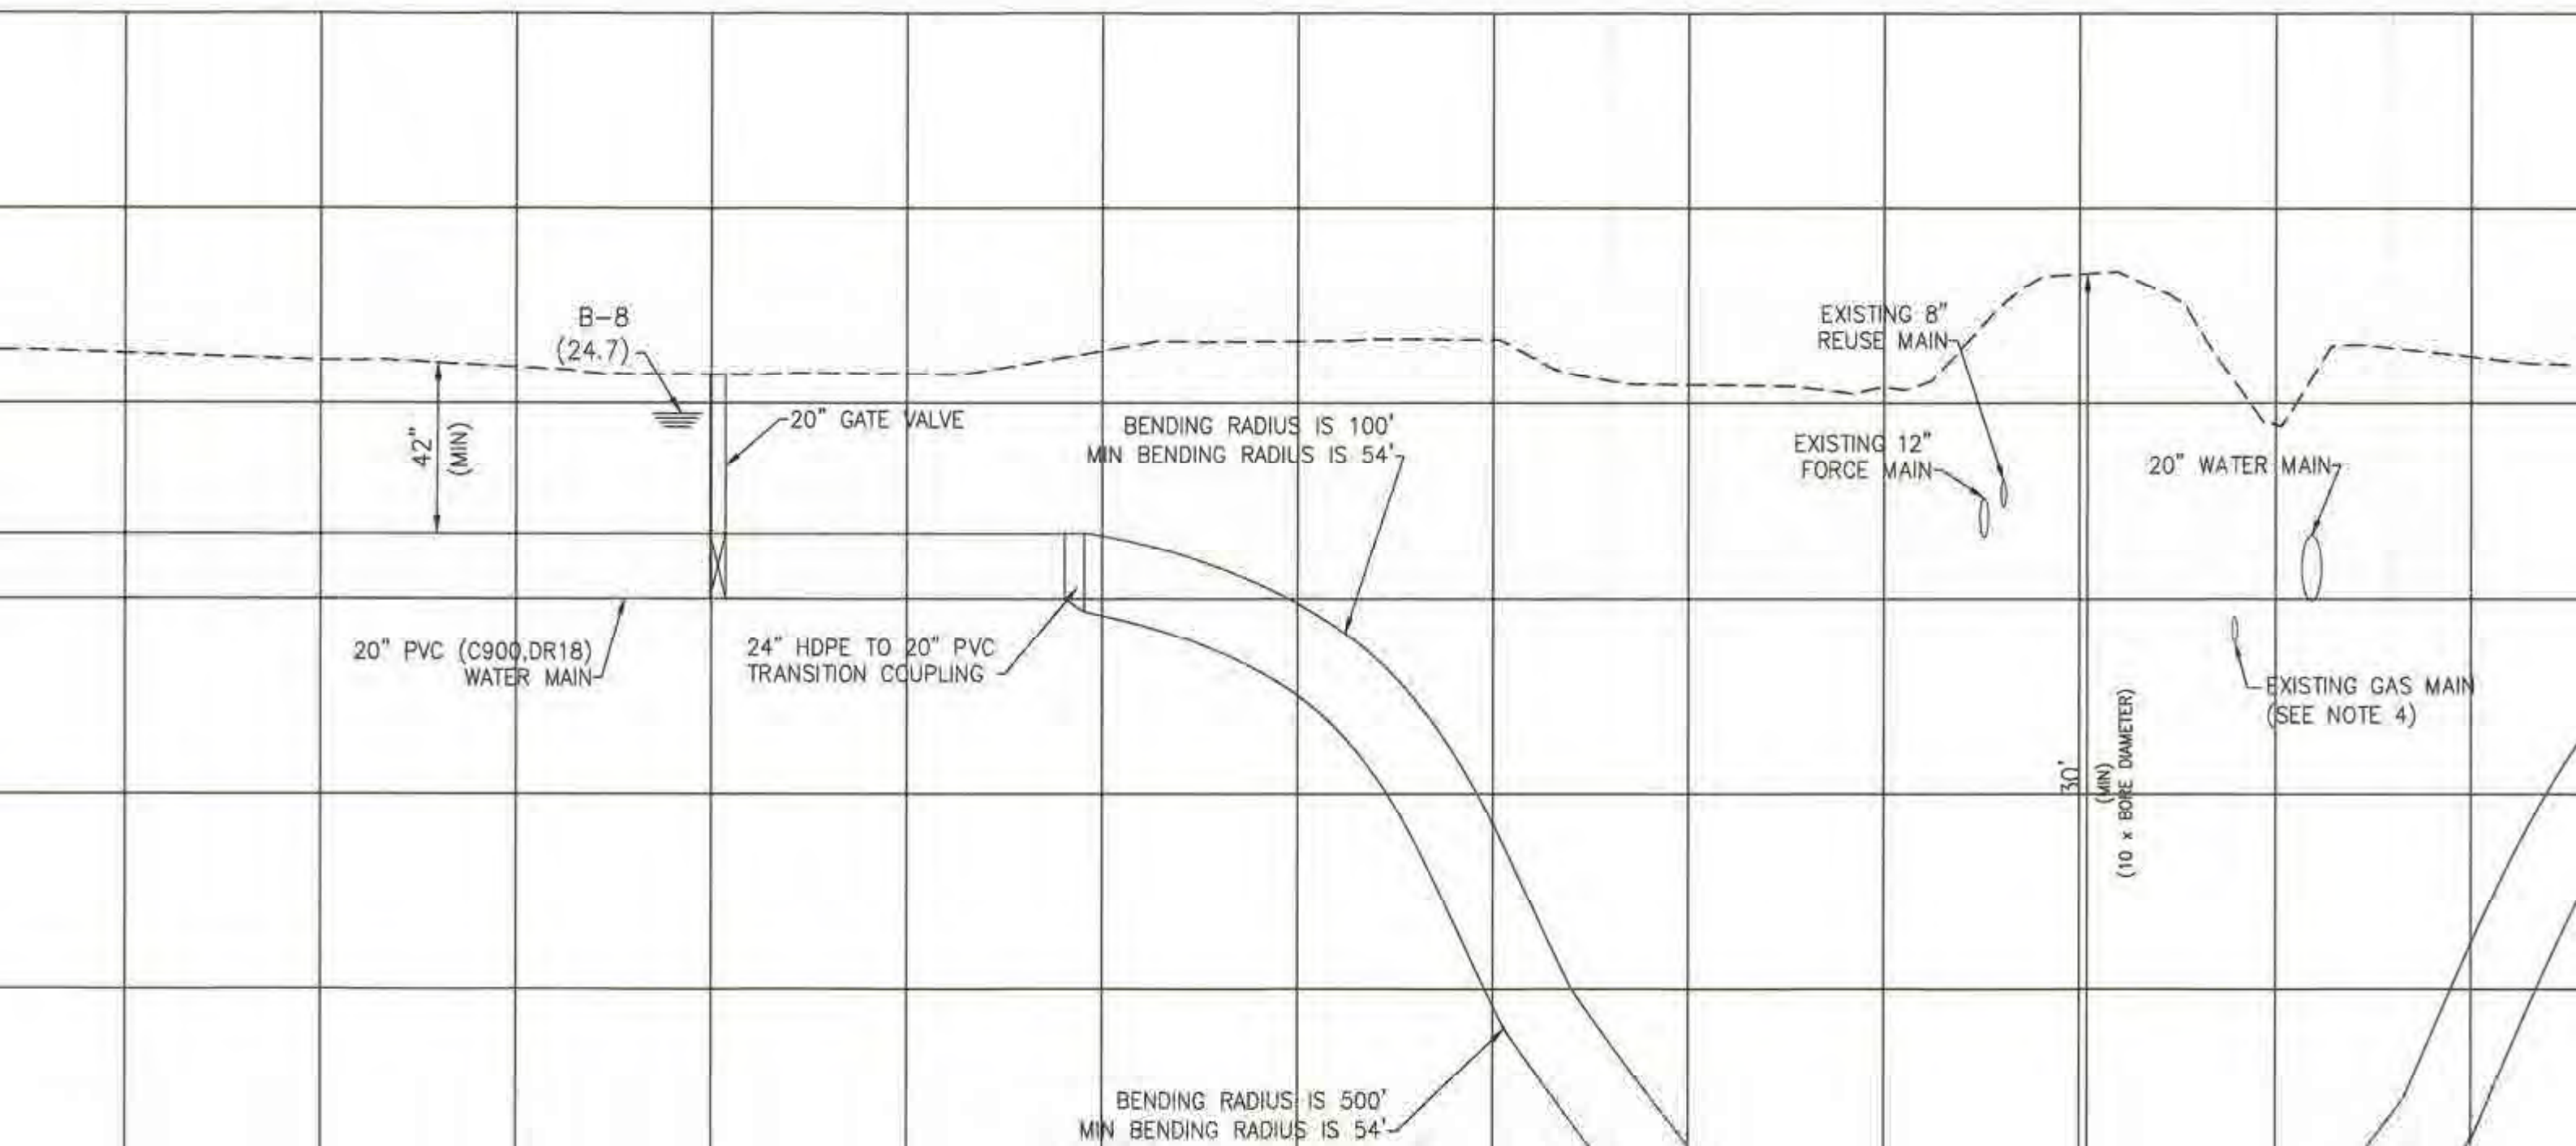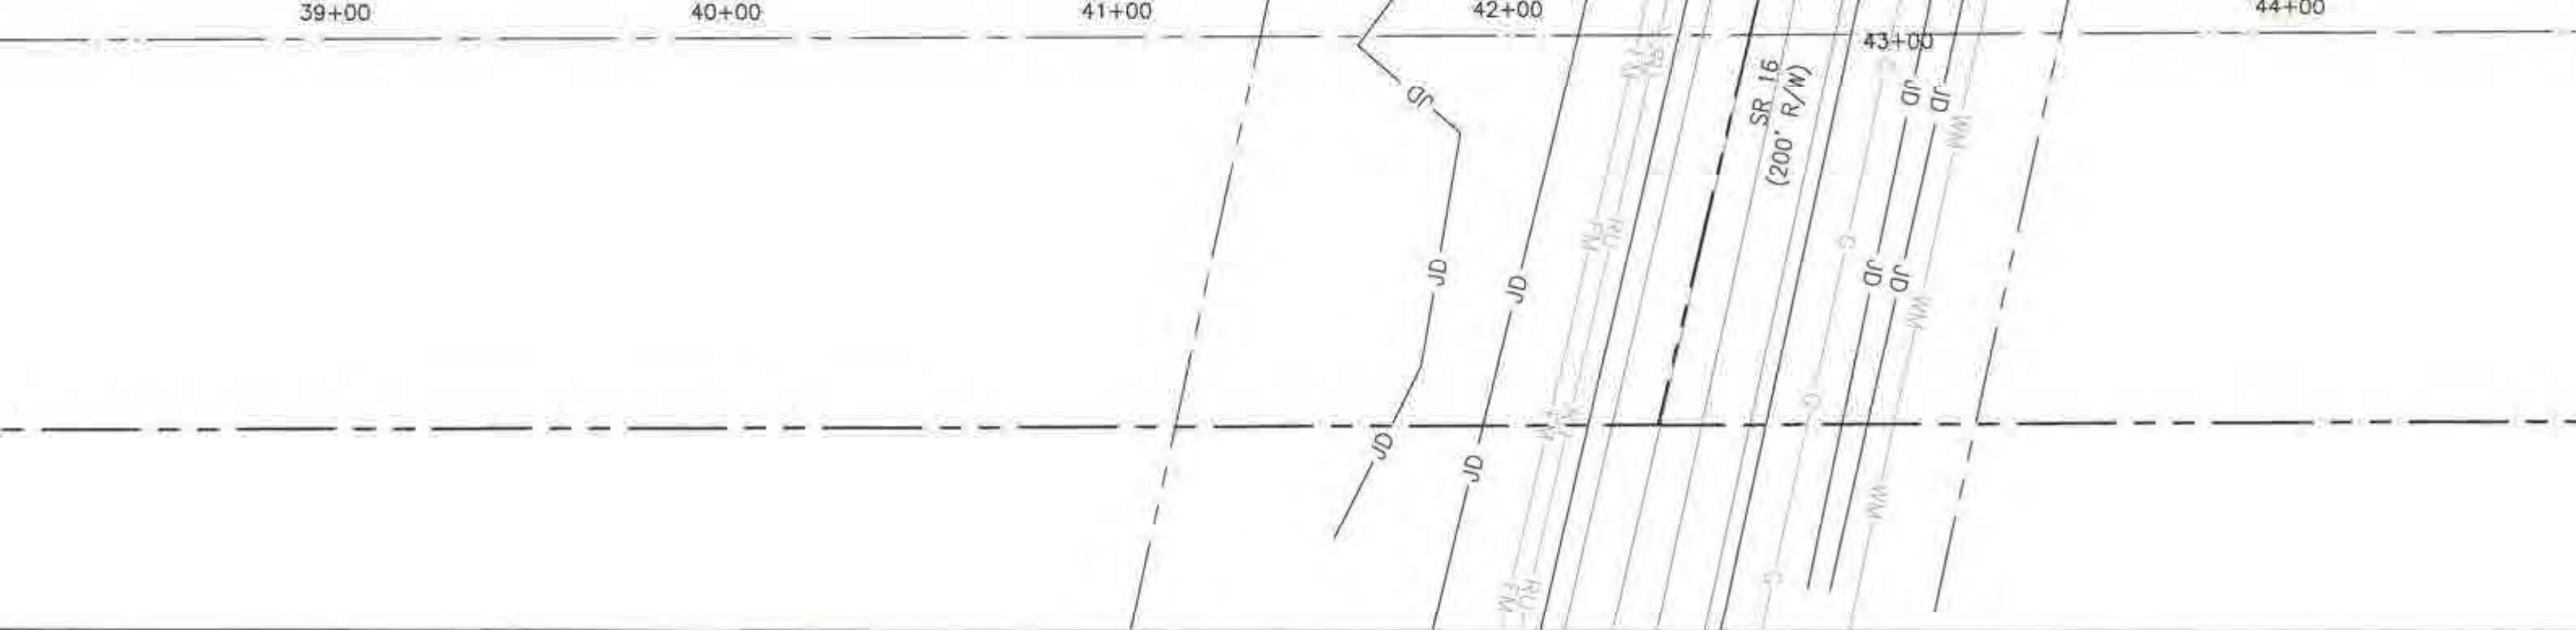

TOP PIPE ELEVATION
NATURAL GROUND=26.00

48+00 49+00 50+00 51+00 52+00 53+00 54+00

JD Gr JD Gr JD

EXISTING
GRADE

PROPOSED
GRADE (TYP)


20" GATE VALVE



42"
(MIN)

00

[illegible]

MWS-4357

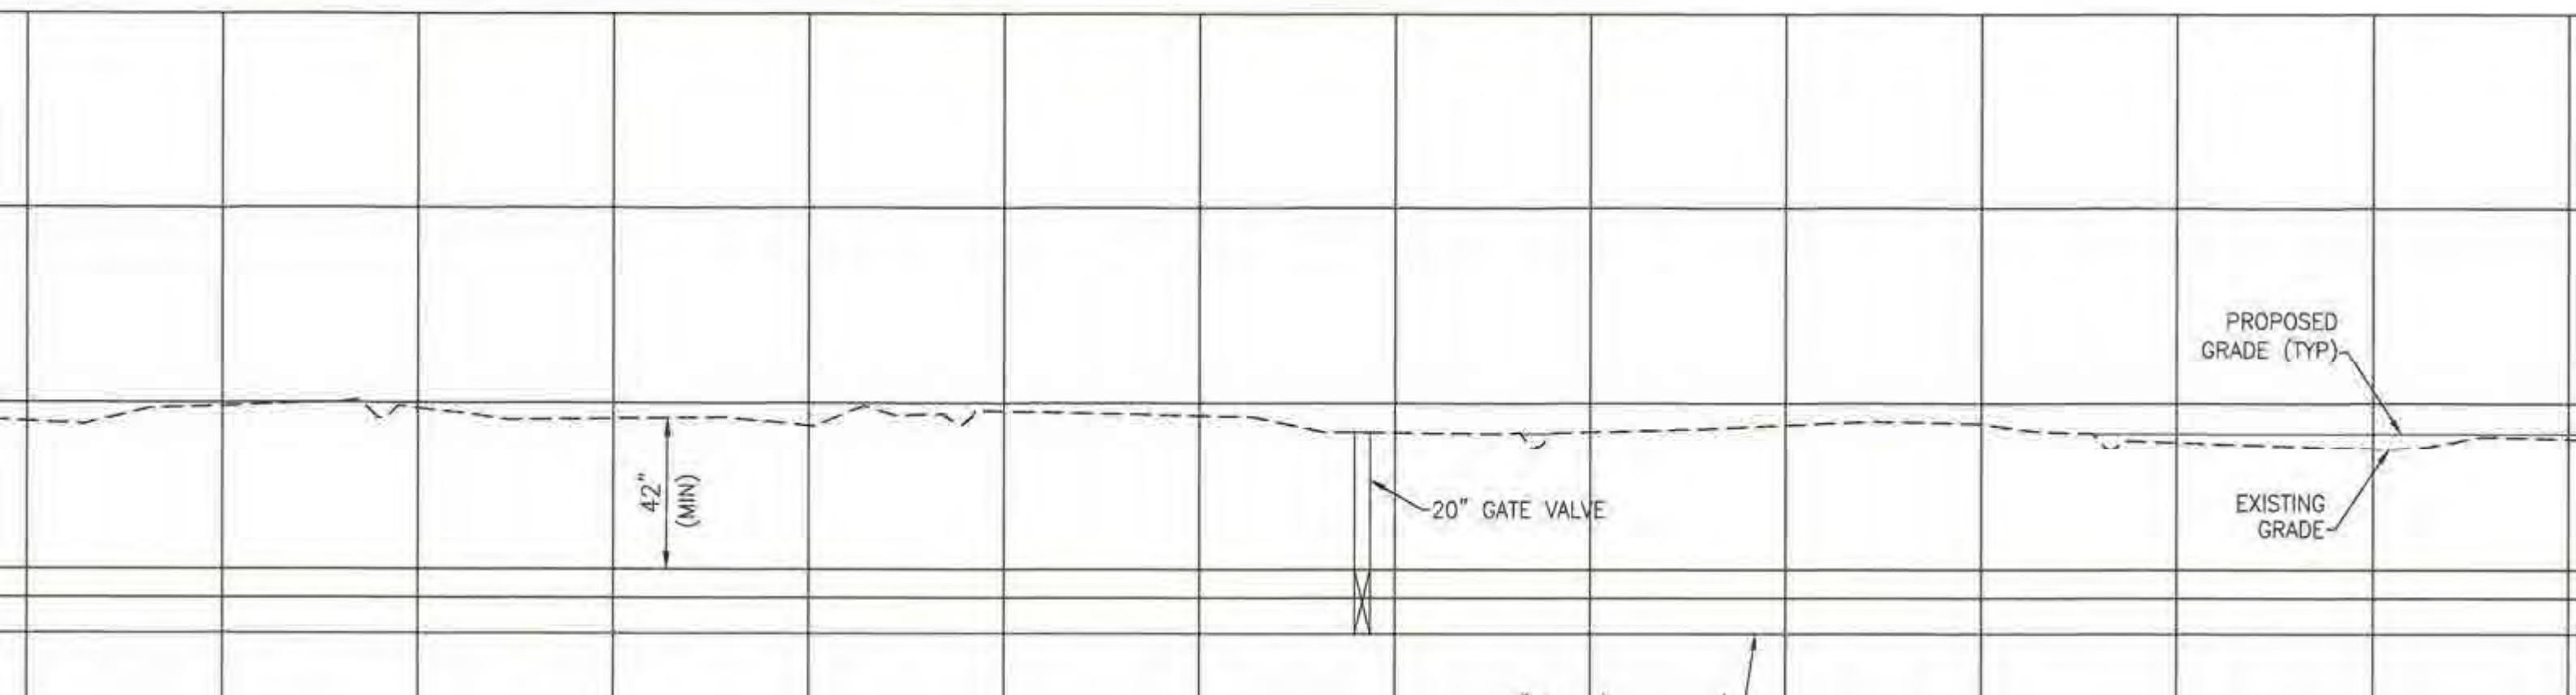

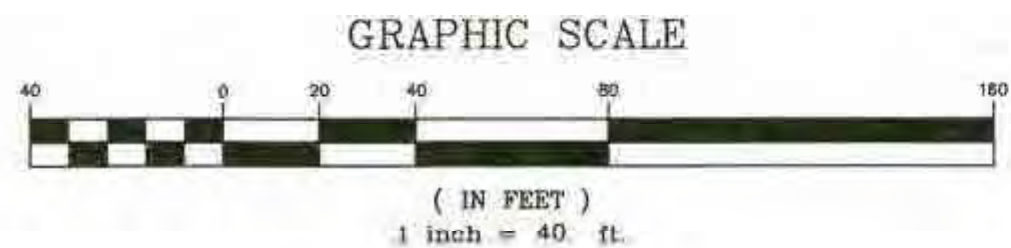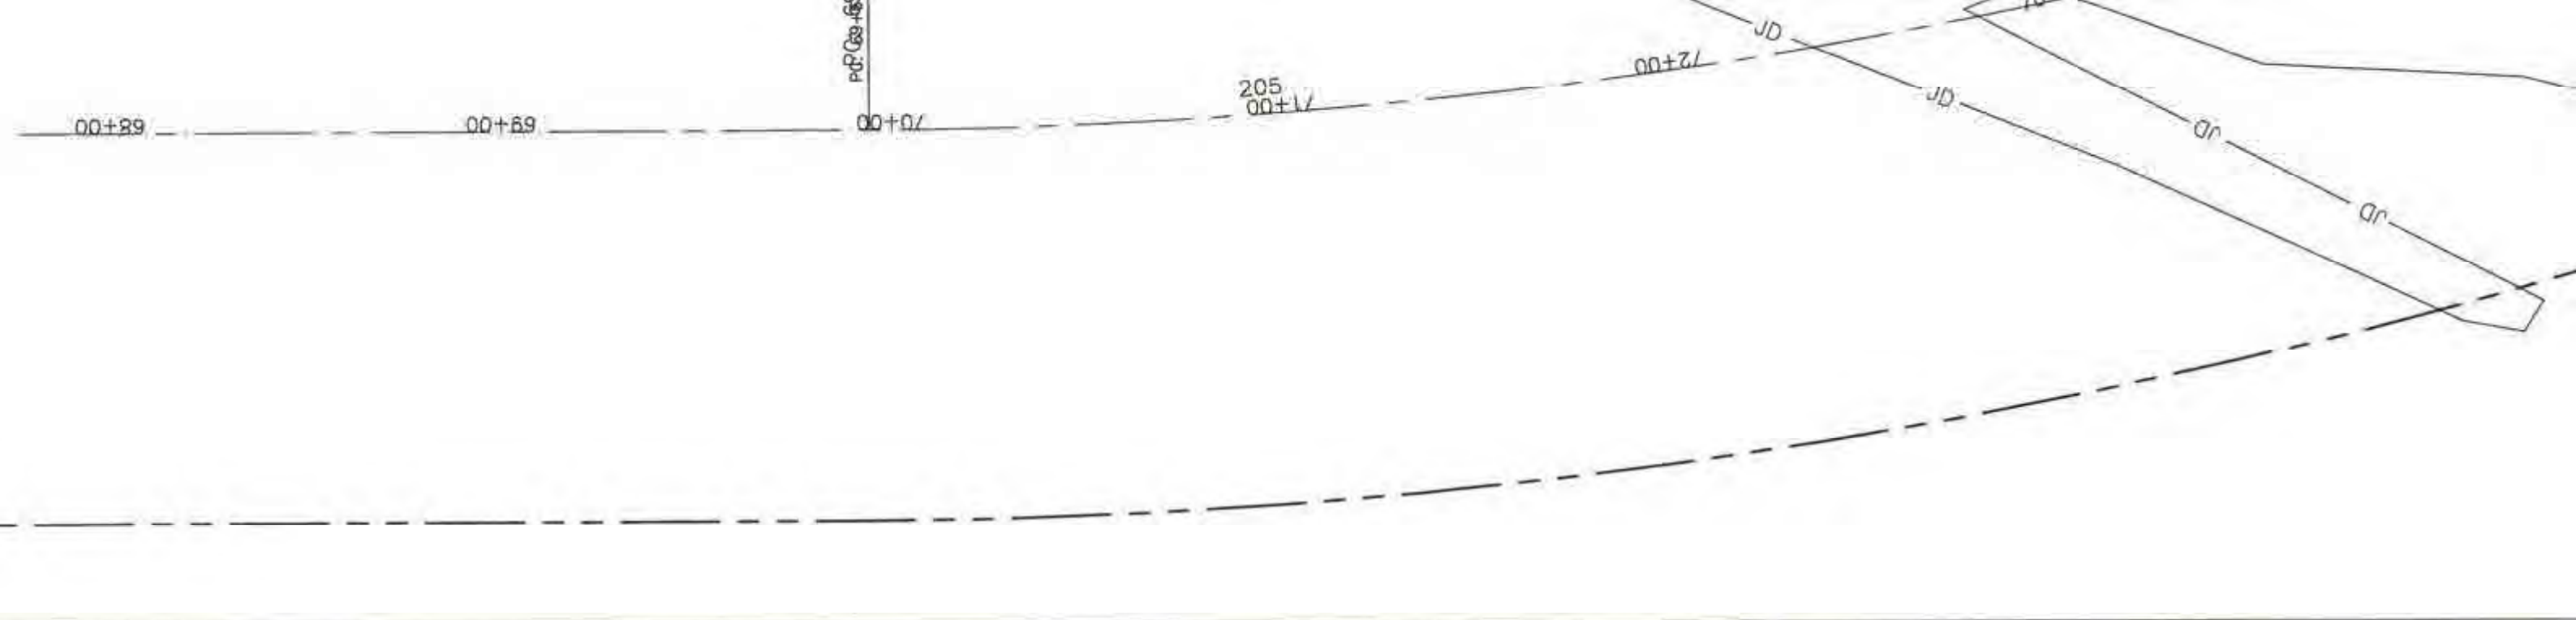



RECEIVED

MAY 30 2023

GIS DEPARTMENT

MWS-4358

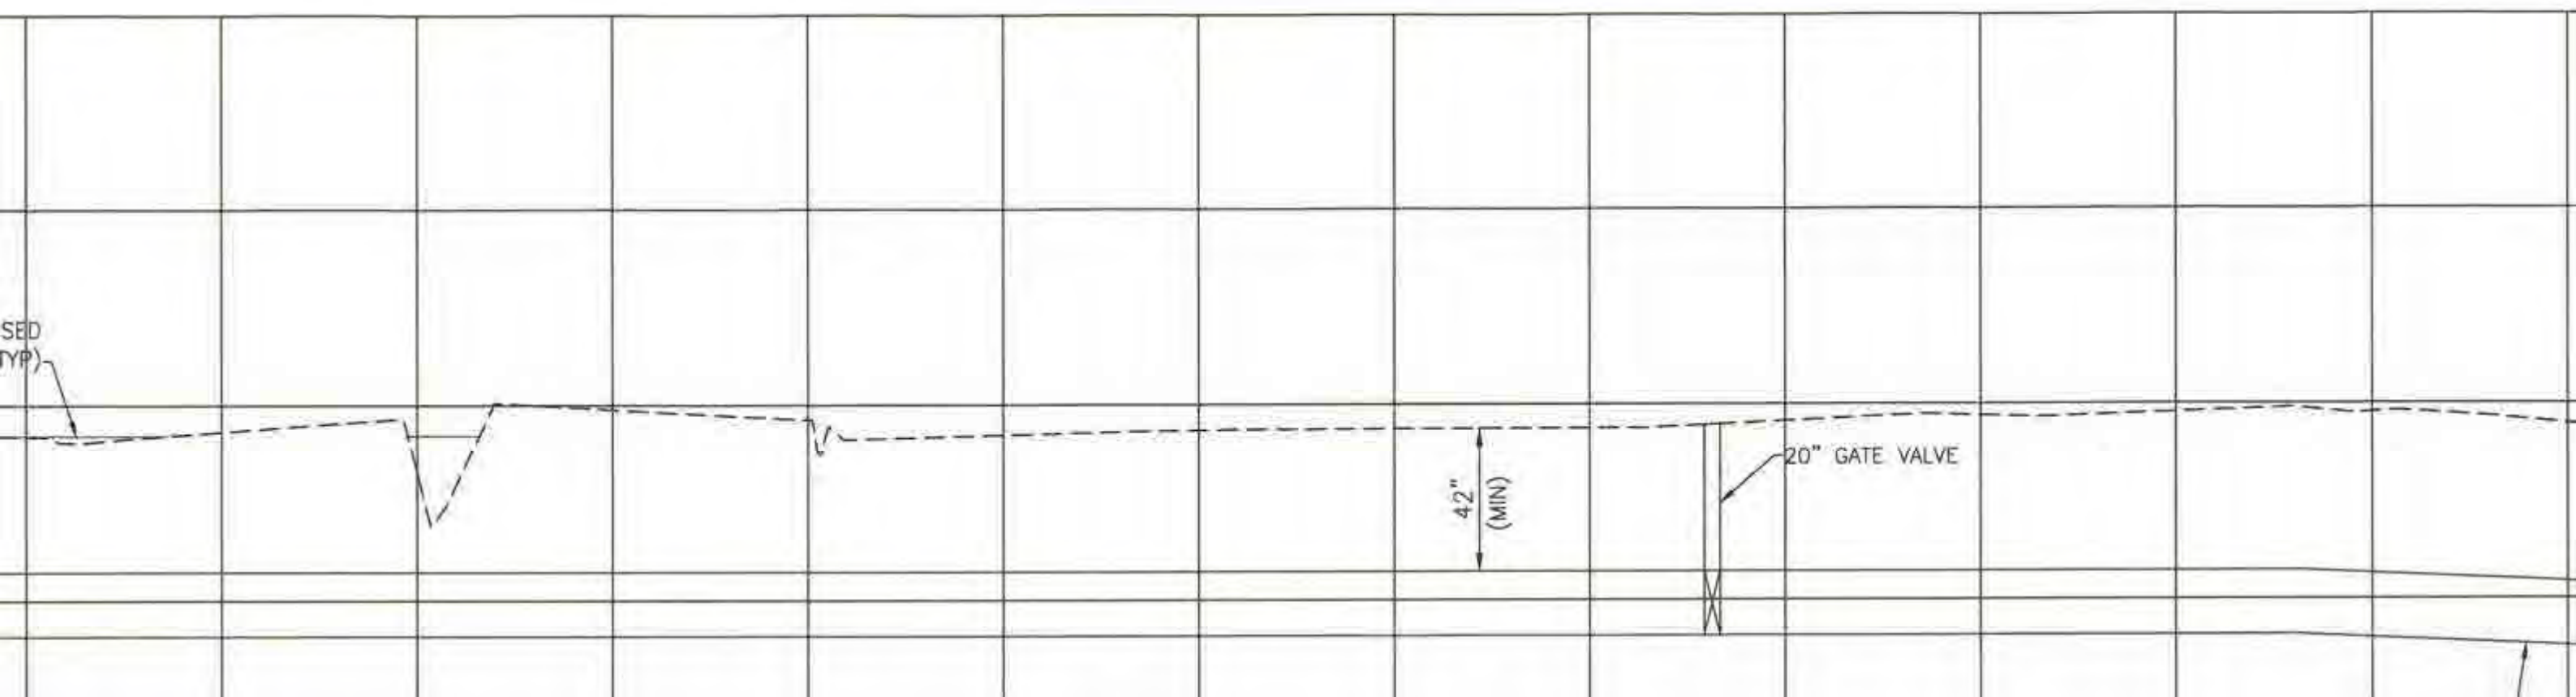

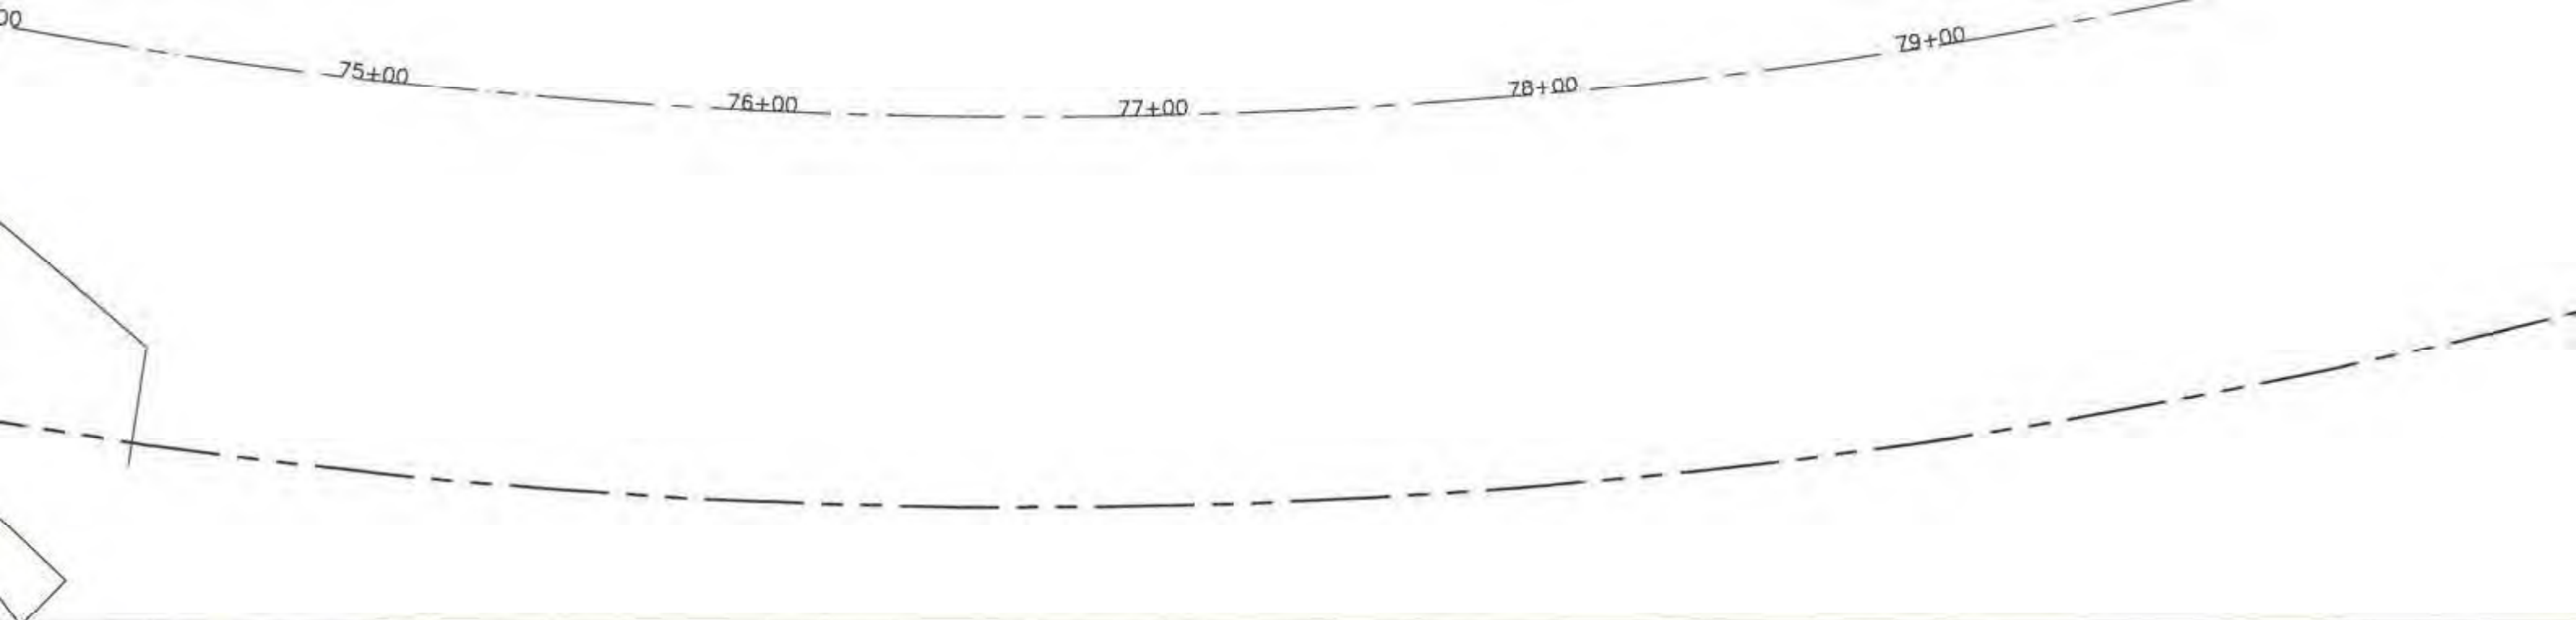


RECEIVED

MAY 3 0 2022

GIS DEPARTMENT

MWS-435a

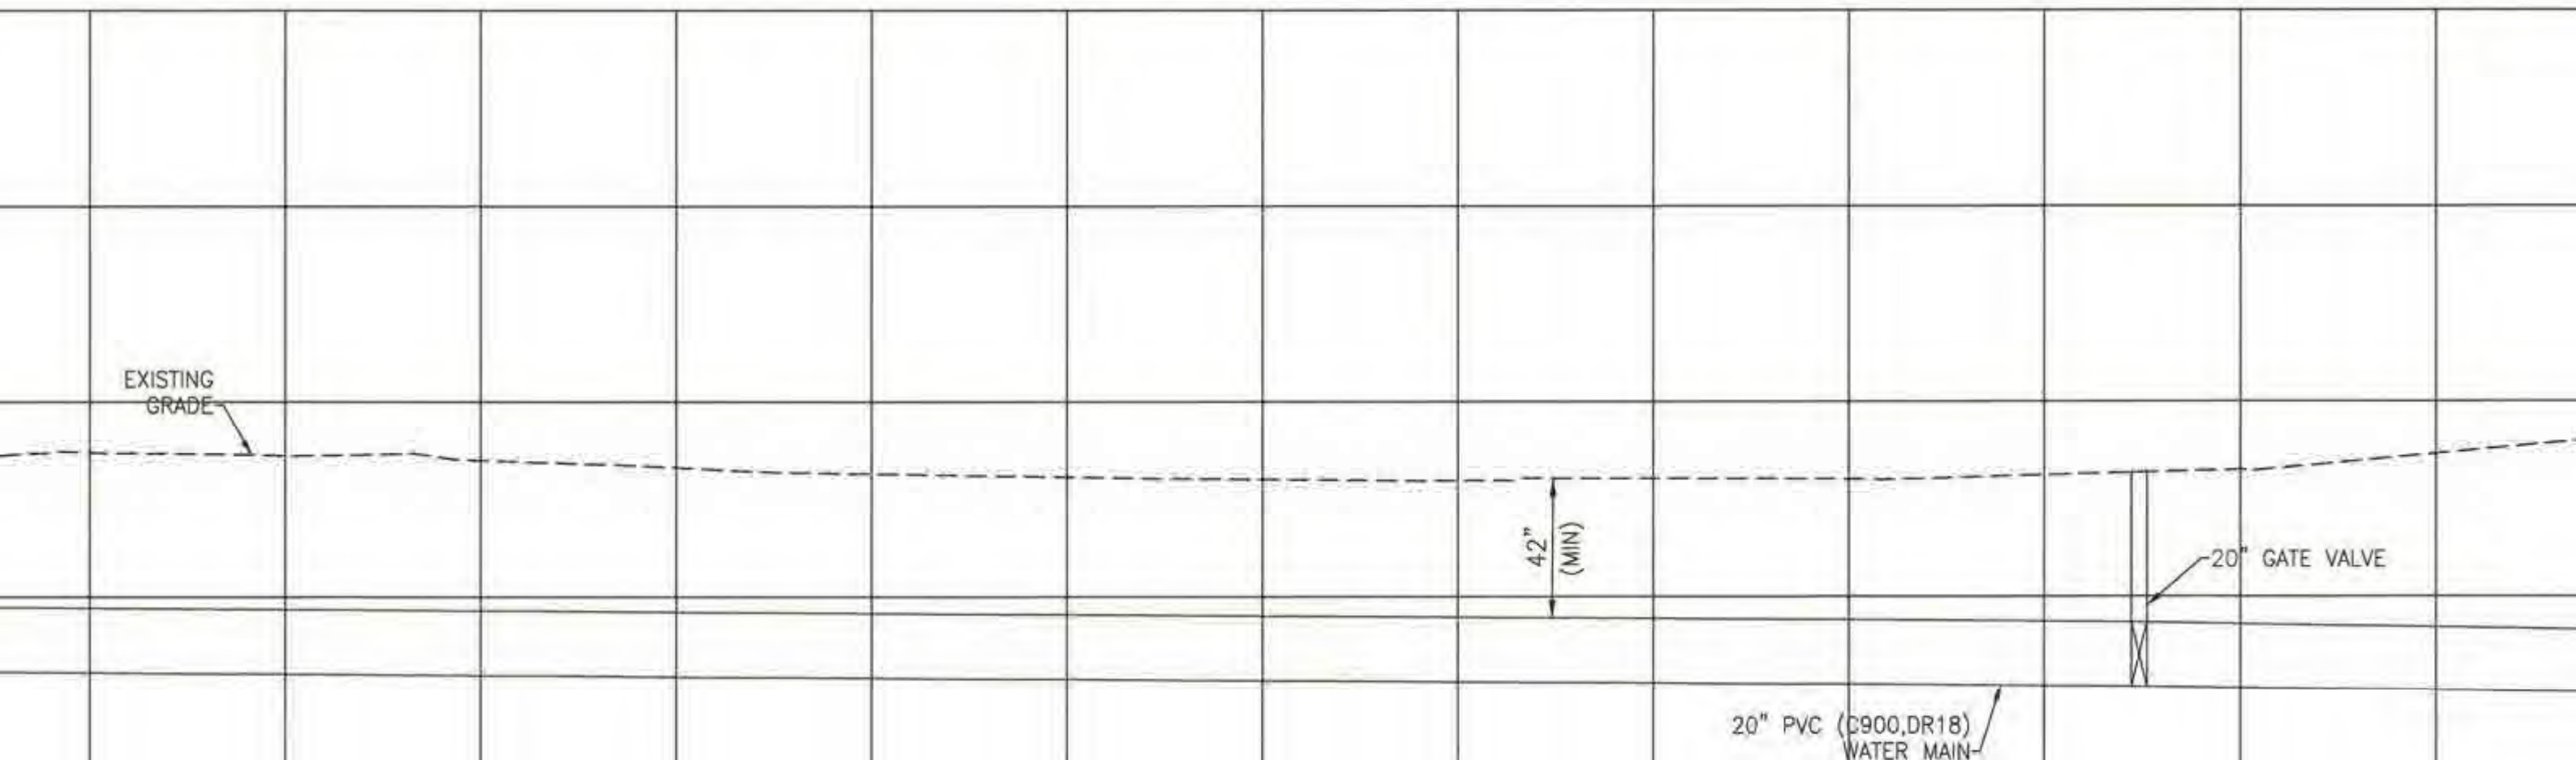

100% (100%)
400 (100%)
100% (100%)

85+00

86+00

87+00

88+00




89+00


EXISTING
GRADE


42"
(MIN)


20" PVC (C900, DR18)
WATER MAIN



20" GATE VALVE

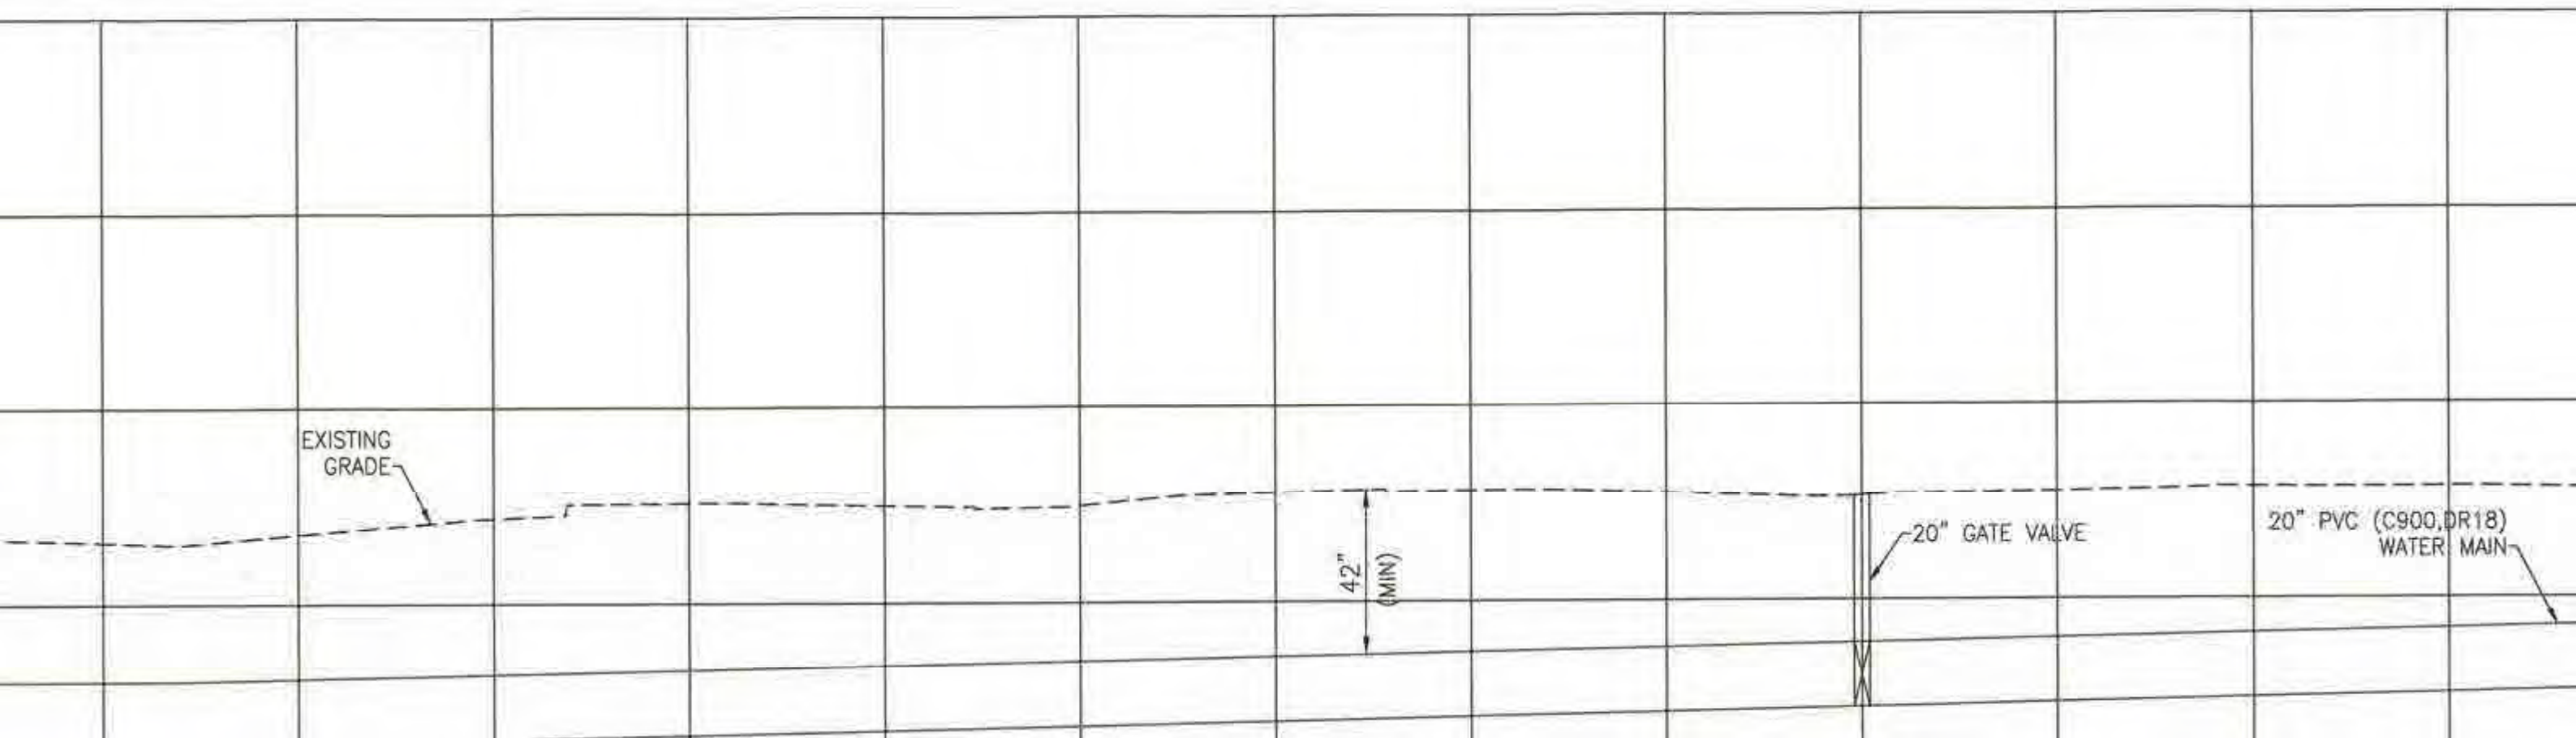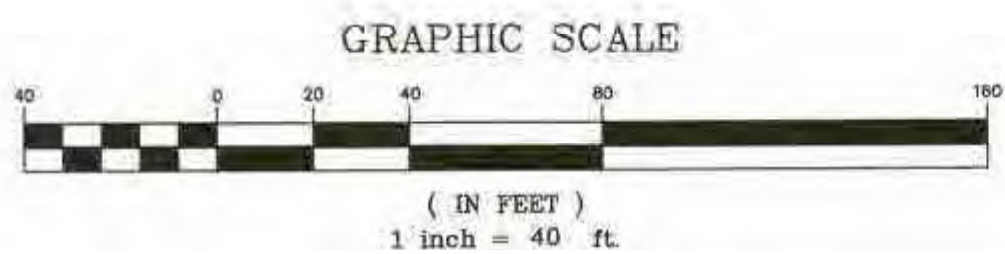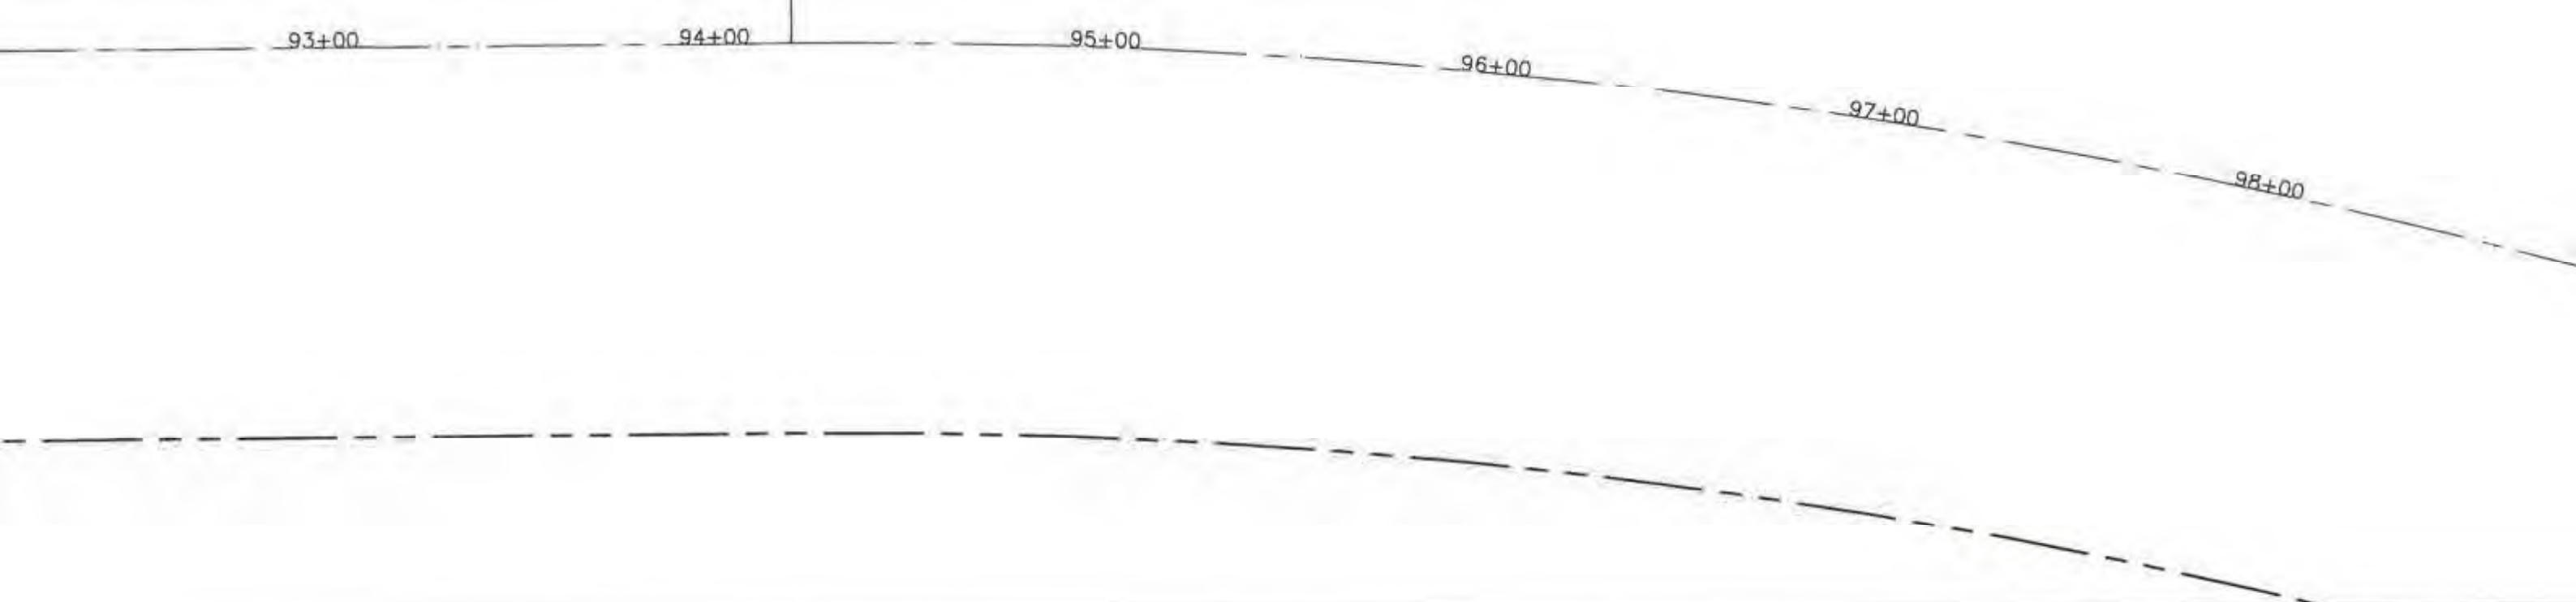

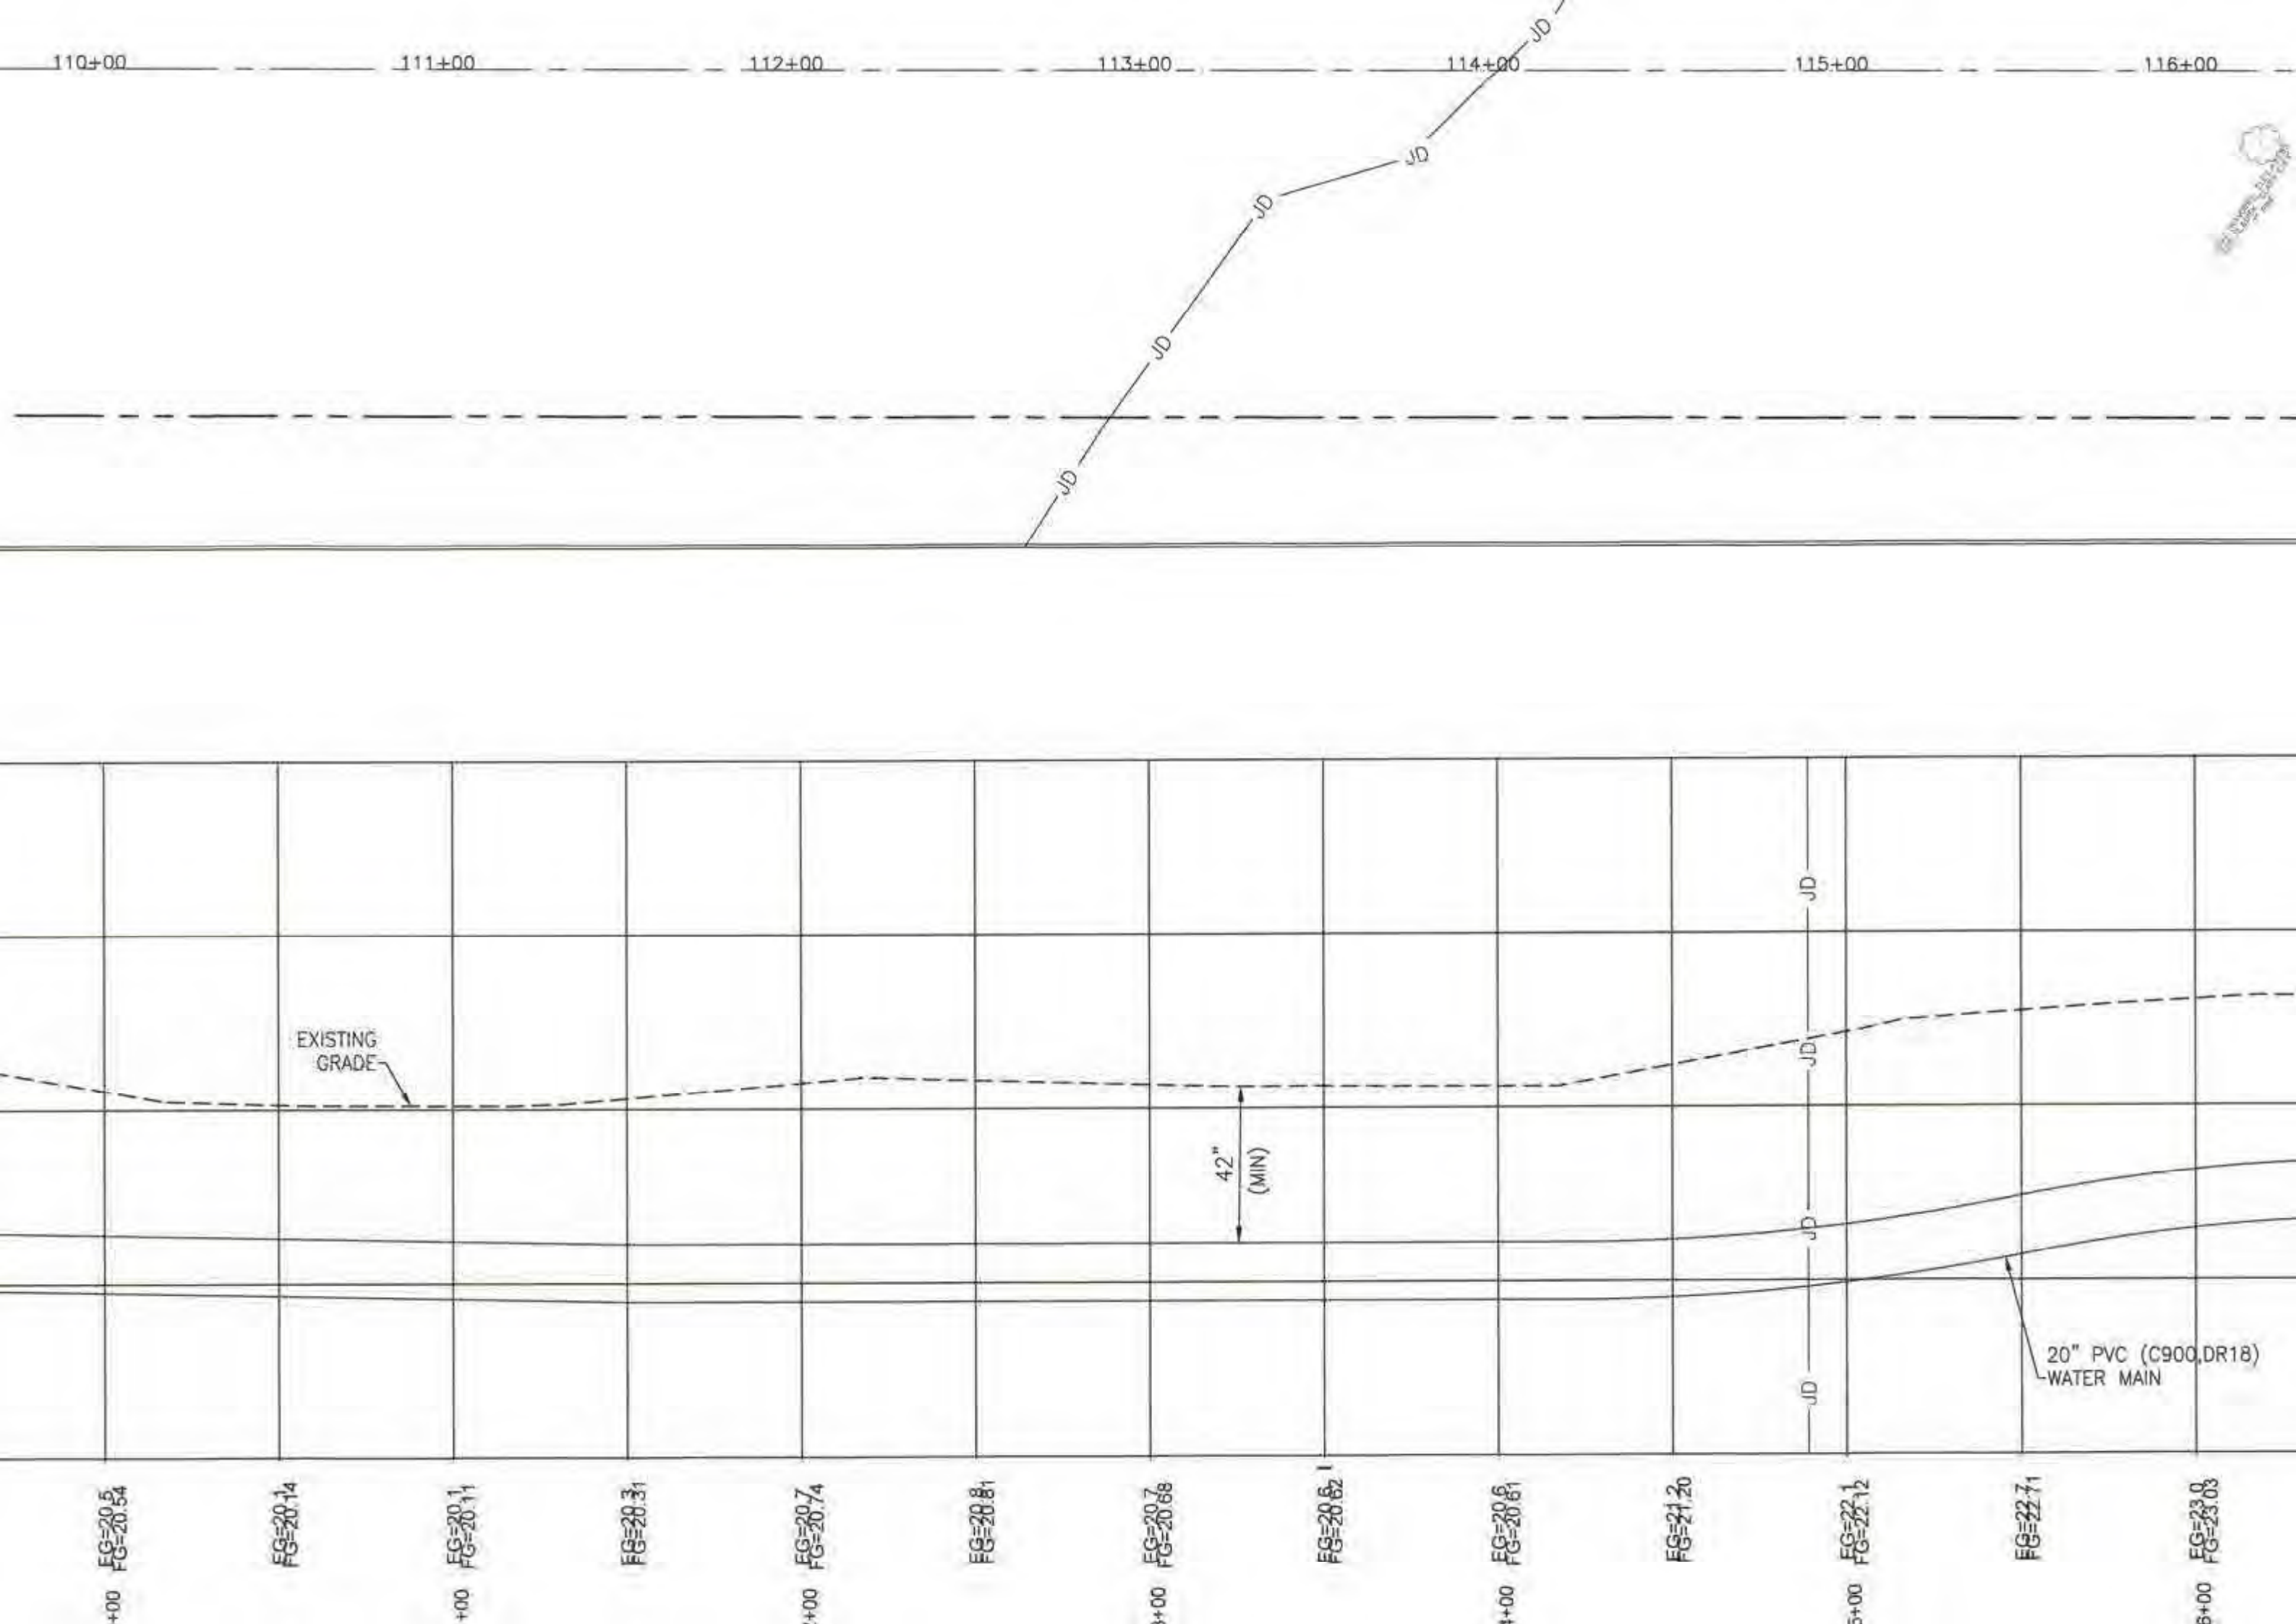

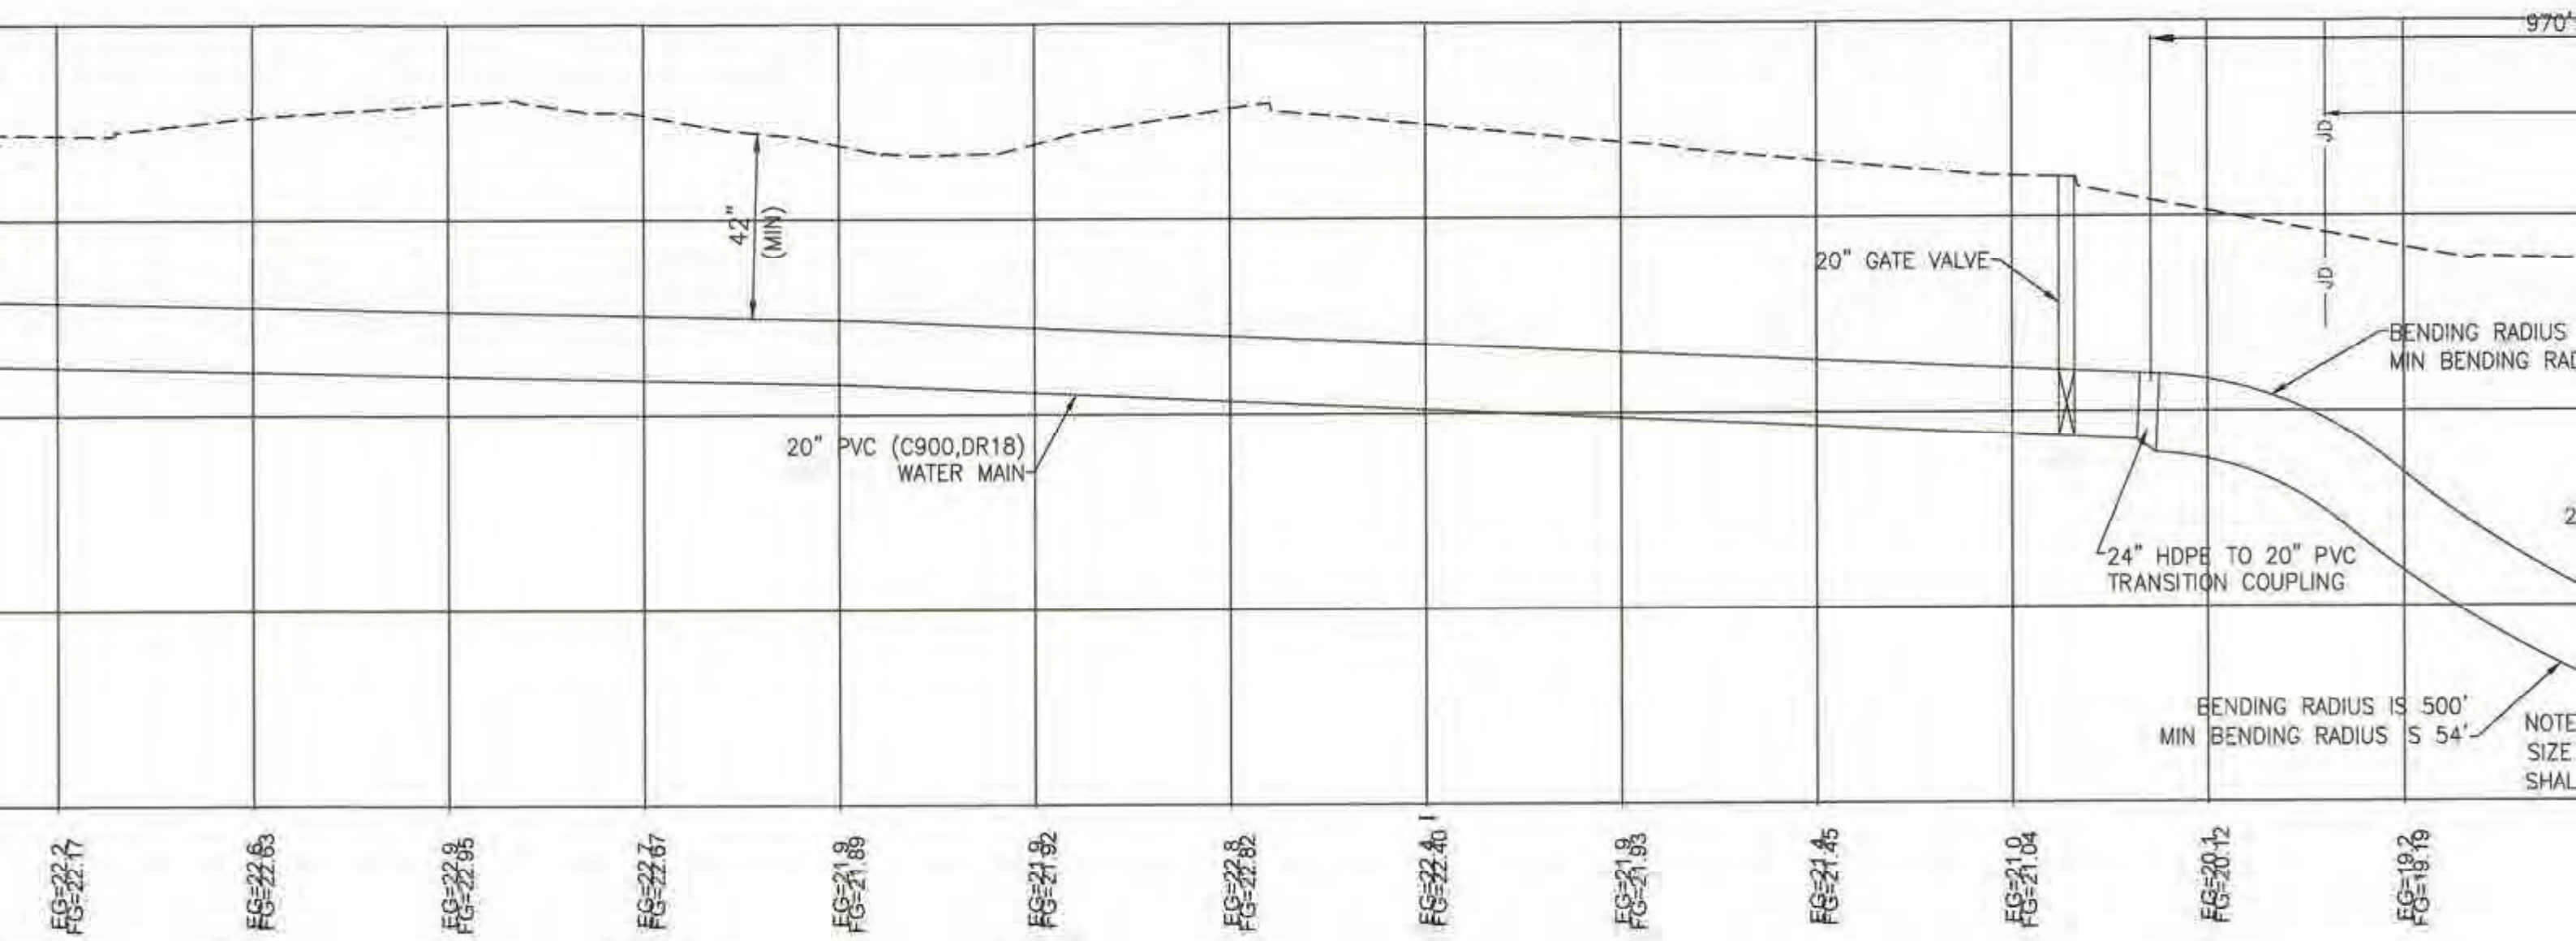

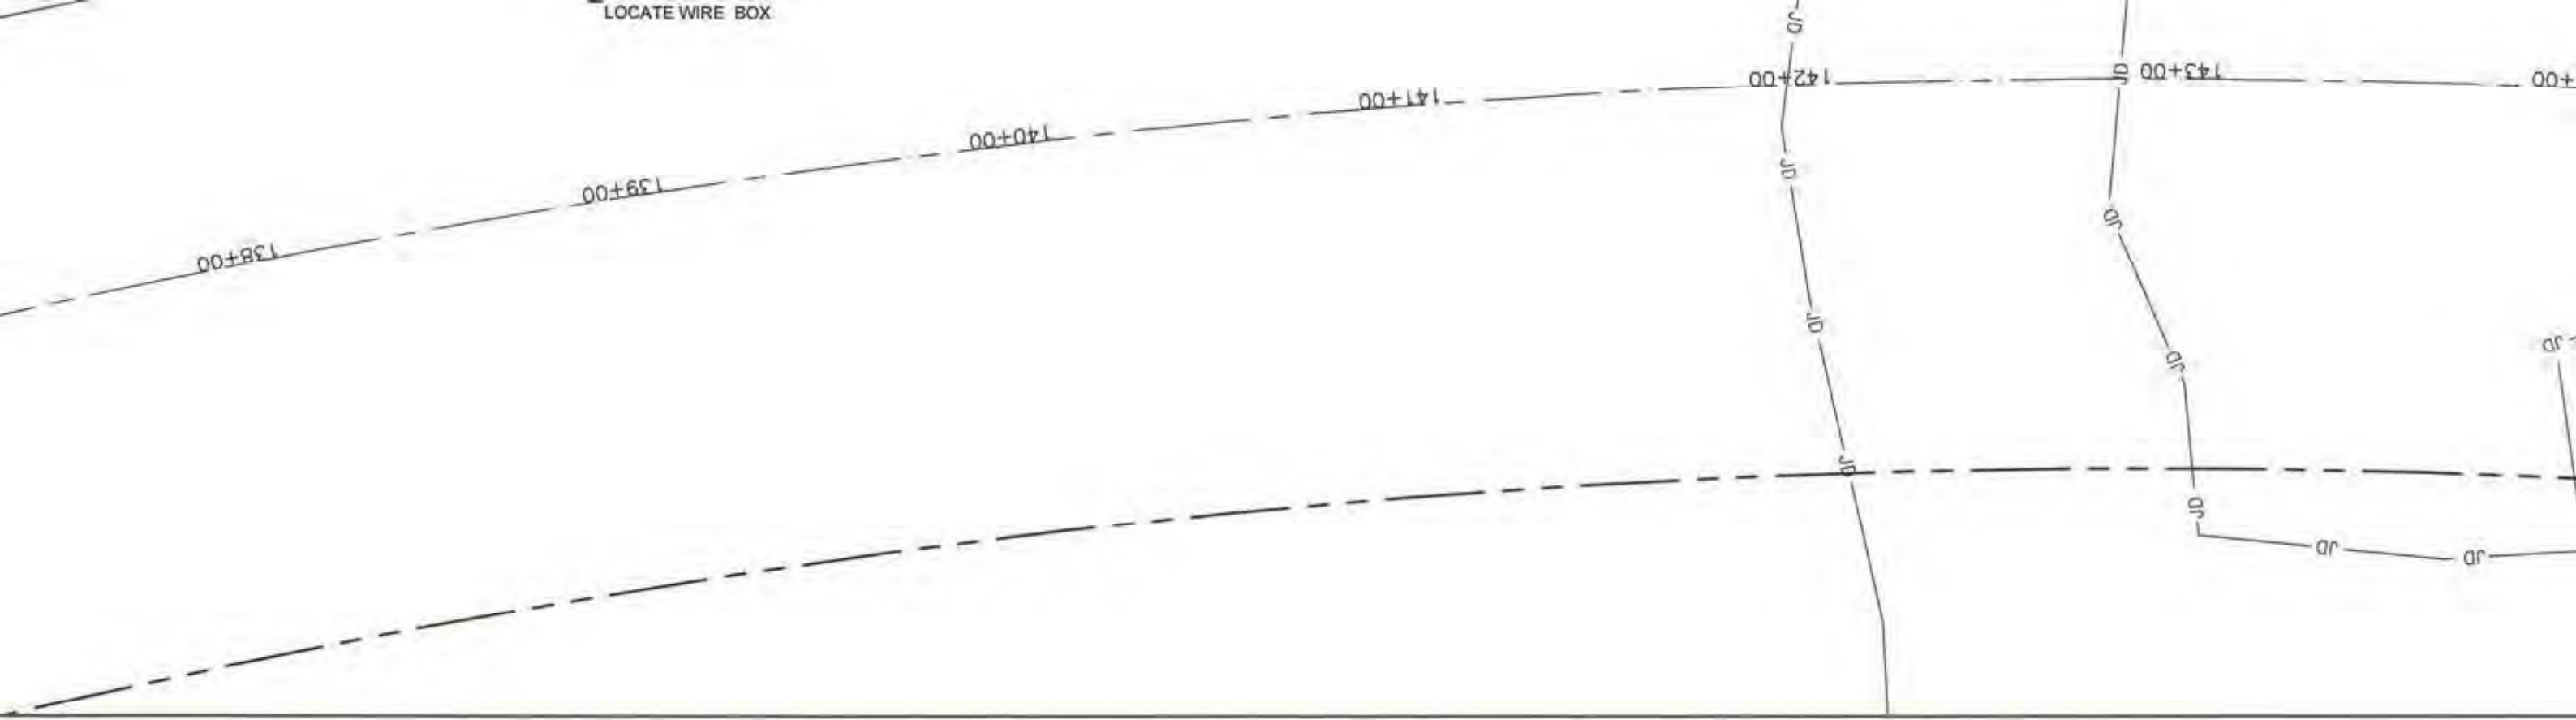

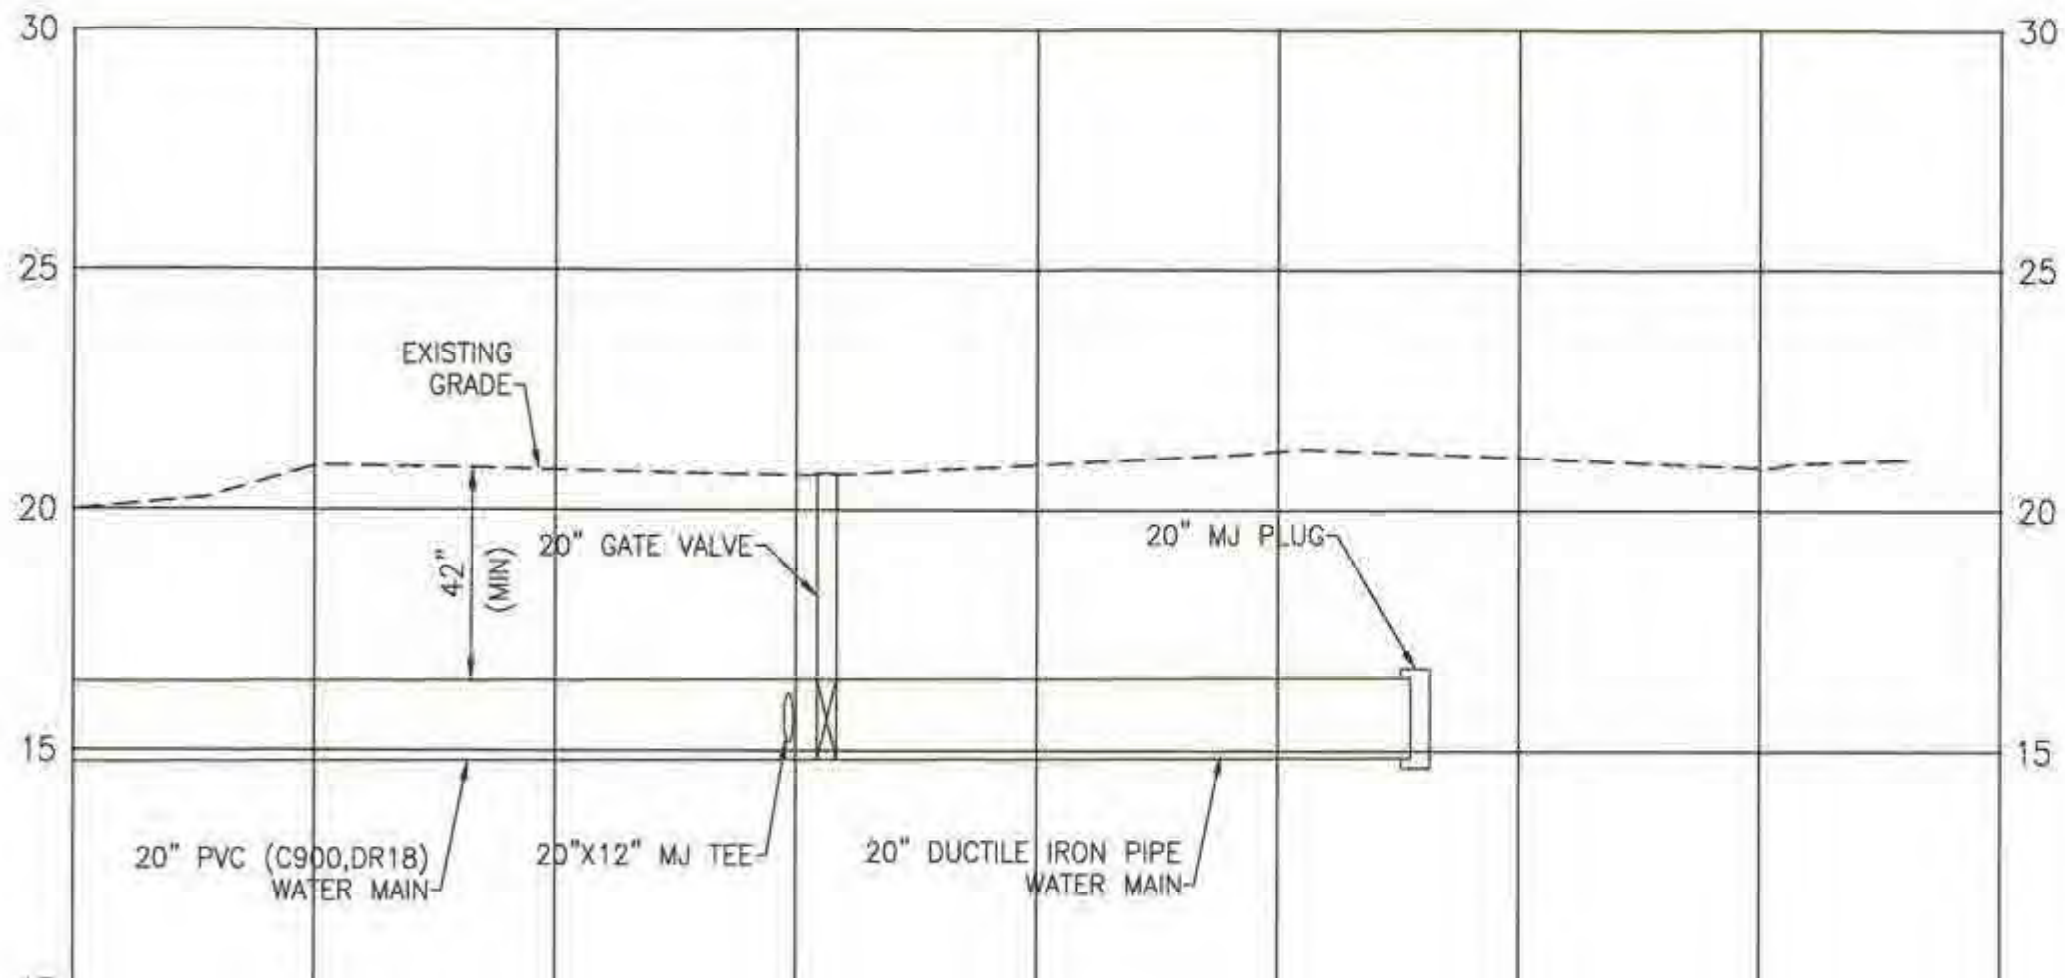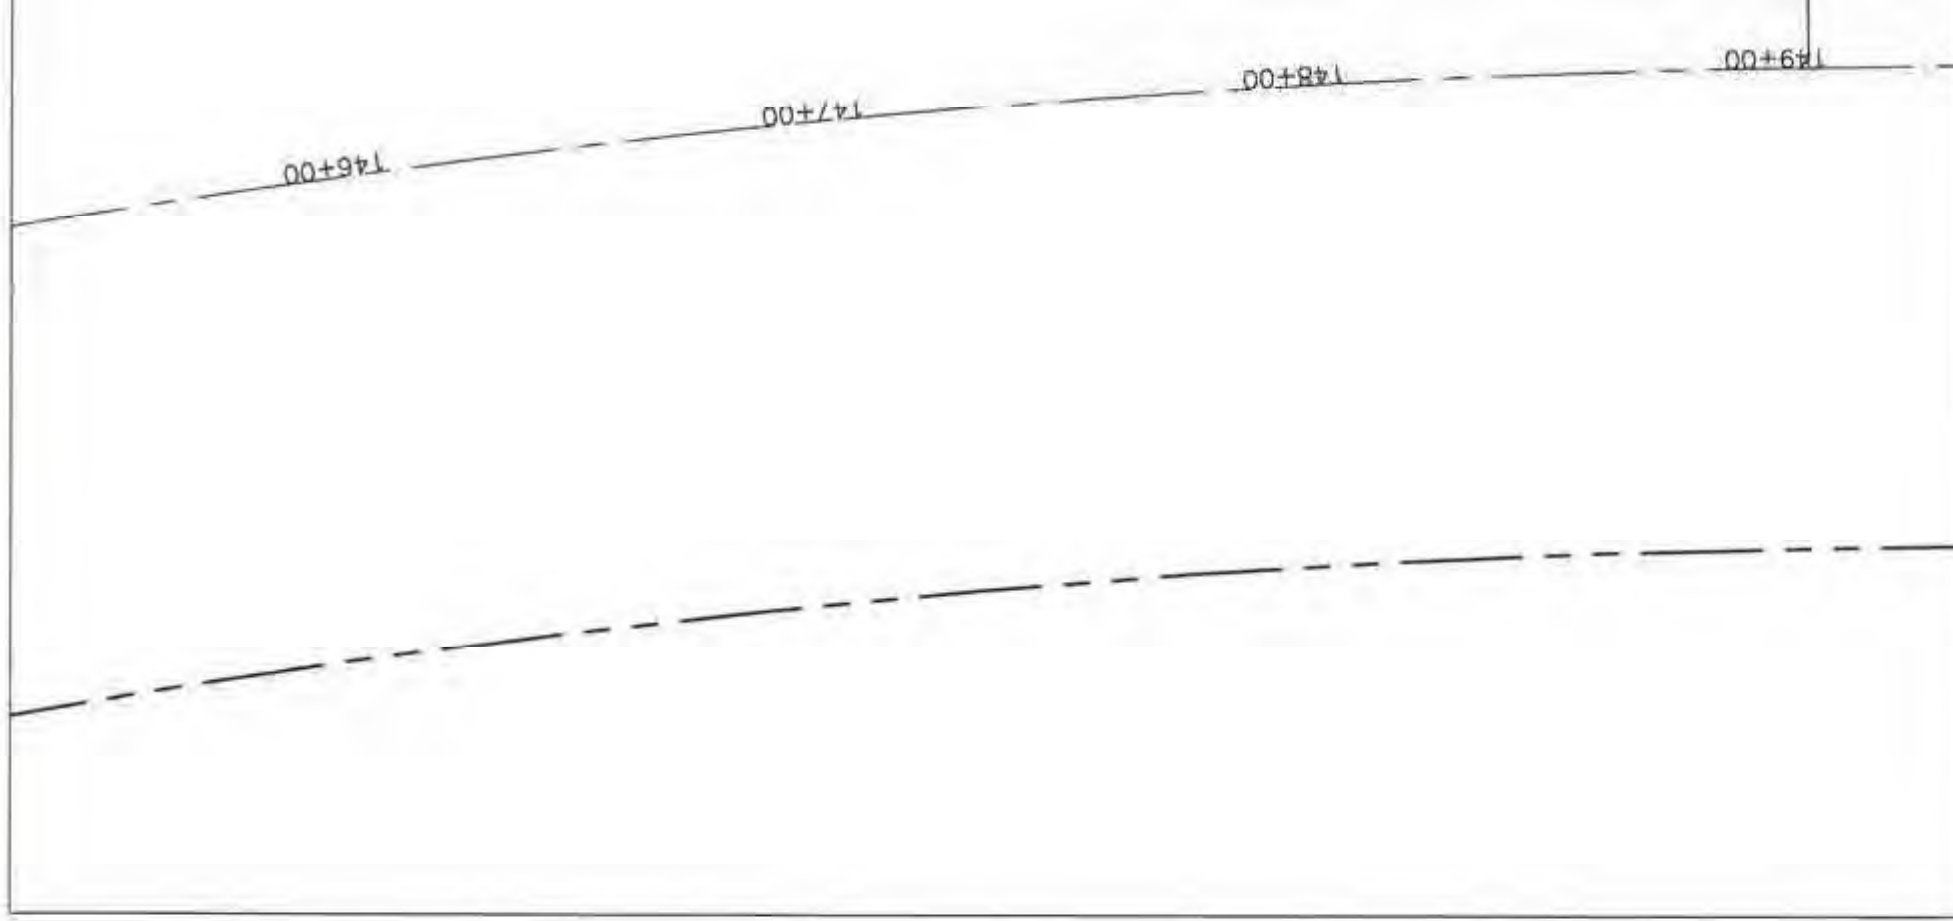

AMERICAN PIPE COMPANY	DI	EPOXY	19.26	22.60	3.34	508148.22	2039685.03	029.94350511	-081.46735135
AMERICAN PIPE COMPANY	DI	EPOXY	18.06	20.20	4.14	508673.55	2037819.65	029.93838175	-081.46566885
AMERICAN PIPE COMPANY	DI	EPOXY	22.87	26.40	3.53	502824.75	2048835.84	029.96860632	-081.46428107
AMERICAN PIPE COMPANY	DI	EPOXY	21.21	25.90	4.69	504552.53	2046028.60	029.96090722	-081.47878759
AMERICAN PIPE COMPANY	DI	EPOXY	21.31	26.40	5.09	504519.38	2046494.99	029.96218926	-081.47889840
AMERICAN PIPE COMPANY	DI	EPOXY	19.49	22.60	3.11	508163.78	2039670.14	029.94346433	-081.46730205
AMERICAN PIPE COMPANY	DI	EPOXY	16.79	21.20	4.41	508599.26	2038783.00	029.94102984	-081.46591572
AMERICAN PIPE COMPANY	DI	EPOXY	22.80	26.40	3.60	502997.14	2048978.98	029.96900189	-081.48373855
AMERICAN PIPE COMPANY	DI	EPOXY	22.10	26.60	4.50	502834.51	2048841.00	029.96862061	-081.48425031
AMERICAN PIPE COMPANY	DI	EPOXY	20.59	24.20	3.61	505083.13	2042772.35	029.95195963	-081.47706926
AMERICAN PIPE COMPANY	DI	EPOXY	19.22	24.00	4.78	506568.73	2041881.51	029.94952699	-081.47236683
AMERICAN PIPE COMPANY	DI	EPOXY	20.69	24.30	3.61	507195.86	2041121.89	029.94744535	-081.47037682
AMERICAN PIPE COMPANY	DI	EPOXY	19.69	23.60	3.91	507747.57	2040296.43	029.94518179	-081.46862422
AMERICAN PIPE COMPANY	DI	EPOXY	17.67	21.20	3.53	508613.51	2038729.95	029.94088413	-081.46587005
AMERICAN PIPE COMPANY	DI	EPOXY	23.38	26.80	3.42	503687.41	2048341.46	029.96725691	-081.48155014
AMERICAN PIPE COMPANY	DI	EPOXY	21.40	26.50	5.10	504554.70	2046007.53	029.96084932	-081.47578046
AMERICAN PIPE COMPANY	DI	EPOXY	21.89	20.00	4.11	504584.10	2045610.88	029.95975896	-081.47868237
AMERICAN PIPE COMPANY	DI	EPOXY	21.01	24.70	3.69	504657.00	2044623.91	029.95704597	-081.47843918
AMERICAN PIPE COMPANY	DI	EPOXY	21.50	23.30	1.80	505809.00	2042296.51	029.95065950	-081.47477109
AMERICAN PIPE COMPANY	DI	EPOXY	20.90	24.30	3.40	504732.66	2043631.24	029.95431731	-081.47818720
AMERICAN PIPE COMPANY	DI	EPOXY	21.19	22.19	1.00	504510.84	2046602.50	029.96248479	-081.47892680
AMERICAN PIPE COMPANY	DI	EPOXY	23.12	26.80	3.68	504312.60	2047553.49	029.96509745	-081.47956538
AMERICAN PIPE COMPANY	DI	EPOXY	19.04	22.60	3.56	508154.20	2039686.00	029.94350785	-081.46733249
AMERICAN PIPE COMPANY	DI	EPOXY	15.89	20.20	4.31	508675.99	2037619.58	029.93838158	-081.46566115
AMERICAN PIPE COMPANY	DI	EPOXY	15.92	20.90	4.98	508625.06	2037505.62	029.93751770	-081.46581791

LOCATE WIRE		
NO.	LOCATE BOX SUBTYPE	NORTHING
W LOC BX 1	MECHANICAL FITTING	2040156.46
W LOC BX 2	MECHANICAL FITTING	2043852.84
W LOC BX 3	MECHANICAL FITTING	2043442.52
W LOC BX 4	MECHANICAL FITTING	2048691.73
W LOC BX 5	MECHANICAL FITTING	2048402.15
W LOC BX 6	MECHANICAL FITTING	2047366.82
W LOC BX 7	MECHANICAL FITTING	2046913.21
W LOC BX 8	MECHANICAL FITTING	2046036.45
W LOC BX 9	MECHANICAL FITTING	2045583.20
W LOC BX 10	MECHANICAL FITTING	2045118.26
W LOC BX 11	MECHANICAL FITTING	2042504.58
W LOC BX 12	MECHANICAL FITTING	2042423.26
W LOC BX 13	MECHANICAL FITTING	2042105.97
W LOC BX 14	MECHANICAL FITTING	2041591.07
W LOC BX 15	MECHANICAL FITTING	2040520.44
W LOC BX 16	MECHANICAL FITTING	2039742.26
W LOC BX 17	MECHANICAL FITTING	2040880.12
W LOC BX 18	MECHANICAL FITTING	2040863.98
W LOC BX 19	MECHANICAL FITTING	2038756.00
W LOC BX 20	MECHANICAL FITTING	2038278.71
W LOC BX 21	MECHANICAL FITTING	2037463.43

DETAIL TABLE					
DEPTH INCH	MANUFACTURER	NORTHING LATITUDE	EASTING LONGITUDE	LATITUDE (DECIMAL DEGREES)	LONGITUDE (DECIMAL DEGREES)
67	AMERICAN FLOW CONTROL	2042767.9630	505083.04	029.95194766	-081.47706951
77	AMERICAN FLOW CONTROL	2042766.7080	505087.97	029.95194417	-081.47705390
10	AMERICAN FLOW CONTROL	2042291.4620	505809.44	029.95064561	-081.47476961
96	AMERICAN FLOW CONTROL	2042293.6770	505815.35	029.95065177	-081.47475100
60	AMERICAN FLOW CONTROL	2041878.2710	506570.77	029.94951810	-081.47236033
59	AMERICAN FLOW CONTROL	2041876.0417	506576.06	029.94951203	-081.47234362
70	AMERICAN FLOW CONTROL	2041115.4960	507200.50	029.94742781	-081.47036211
82	AMERICAN FLOW CONTROL	2041117.0260	507194.39	029.94743195	-081.47038141
43	AMERICAN FLOW CONTROL	2040296.9830	507742.71	029.94518325	-081.46883957
86	AMERICAN FLOW CONTROL	2040288.8240	507752.56	029.94516092	-081.46860836
40	AMERICAN FLOW CONTROL	2038731.3210	508608.29	029.94088784	-081.46588656
01	AMERICAN FLOW CONTROL	2048338.1350	503686.21	029.96724775	-081.48155391
90	AMERICAN FLOW CONTROL	2048333.7540	503695.49	029.96723581	-081.48152454
04	AMERICAN FLOW CONTROL	2046016.3770	504553.94	029.96087363	-081.47878298
99	AMERICAN FLOW CONTROL	2046015.9190	504543.77	029.96087226	-081.47881508
84	AMERICAN FLOW CONTROL	2045607.8730	504581.65	029.95975069	-081.47869009

RECEIVED

MAY 30 2023

GIS DEPARTMENT

MWS-4368

OFFSITE

MAIN

DATE: 11/10/2021

BORE #:

SIZE: 24"

PIPE TYPE:

ROD	DEPTH	STATION #
800	22'3"	
820	20'4"	
840	19'4"	
860	20'	
880	19'	
900	16'3"	
920	13'2"	
940	9'9"	
960	7'	
980	5'	
1000	pit	
1020		
1040		
SITE: SR-16

STATION START:

STATION END:

JOB NUMBER: 8726

BORE #:

JOB NAME: Grand Oaks Offsite Water Main

SIZE:

DRILLER: Danny Bryan


PIPE TYPE:

ROD	DEPTH	STATION #
20	2'2"	
40	7'4"	
60	11'0"	
80	14'0"	
100	17'8"	
120	20'2"	
140	21'0"	
160	22'6"	
180	23'1"	
200	24'6"	
220	24'7"	
240	24'2"	
260	25'4"	
280	27'1"	
300	26'7"	
320	24'5"	
340	19'11"	
360	17'0"	
380	13'2"	
400	10'11"	
420	9'9"	
440	6'4"	
460	4'4"	
480	2'3"	
500	1'10"	
520		
540		
560		
580		
600		
620		
640		
660		
680		
700		
720		

ROD	DEPTH
800	
820	
840	
2023 NW Senior Living Green As Built Drawings



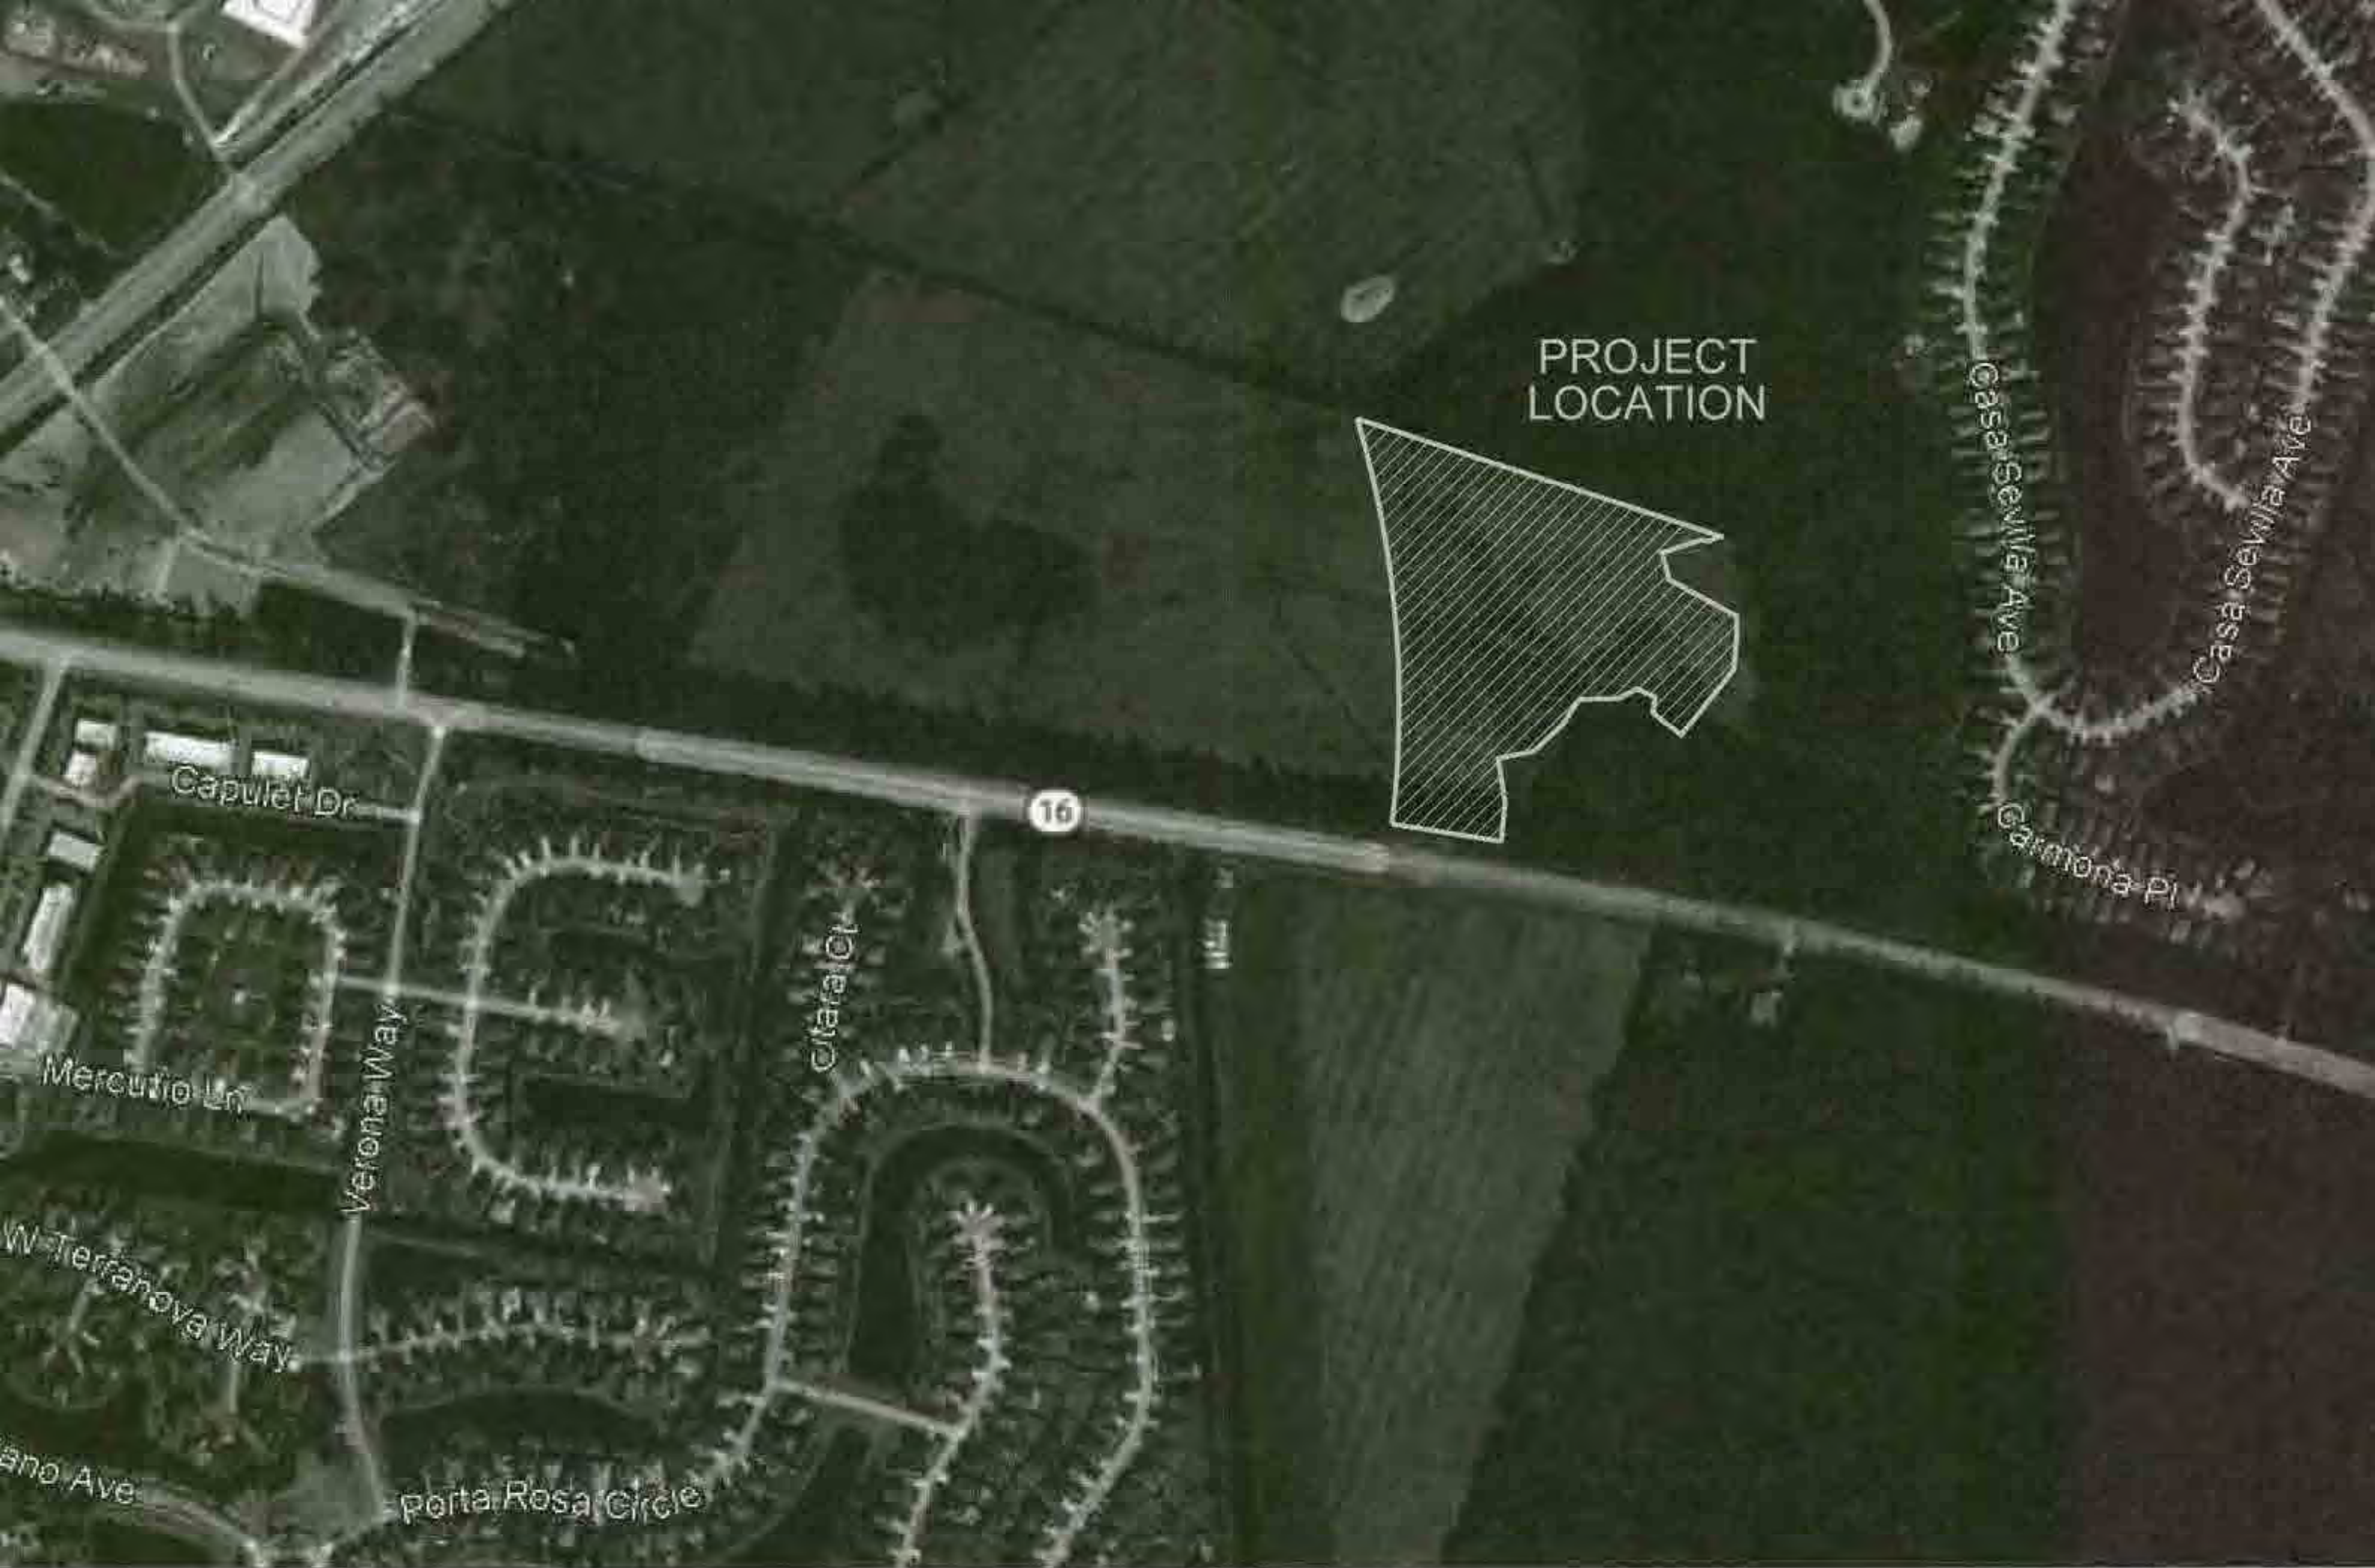

PROJECT
LOCATION

VICINITY MAP
NOT TO SCALE

FM-3	GATE VALVE	2046359.4780	504920.9900	29°57'42.5565"	-081°28'39.4622"	23.69	26.26	2.57'	24.85	4"	SJCUD	MUELLER COMPANY	DUCT
FM-4	REDUCER	2046362.4090	504921.5360	29°57'42.5856"	-081°28'39.4561"	23.10	25.7	2.6'	-	6"X4"	SJCUD	STAR PIPE PRODUCTS	DUCT
FM-5	CROSS	2046364.5560	504921.8950	29°57'42.8068"	-081°28'39.4522"	23.10	25.8	2.7'	-	12"X6"	SJCUD	STAR PIPE PRODUCTS	DUCT
FM-6	REDUCER	2046369.3840	504921.5770	29°57'42.6546"	-081°28'39.4560"	23.33	26.6	3.3'	-	6"X4"	SJCUD	STAR PIPE PRODUCTS	DUCT
FM-7	GATE VALVE	2046371.6140	504922.5600	29°57'42.6767"	-081°28'39.4449"	23.41	26.90	3.49'	24.57	4"	SJCUD	MUELLER COMPANY	DUCT
FM-8	GATE VALVE	2046364.9630	504925.7230	29°57'42.6110"	-081°28'39.4087"	22.72	27.36	4.64'	26.40	12"	SJCUD	MUELLER COMPANY	DUCT
FM-9	GATE VALVE	2046366.0590	504917.8750	29°57'42.6216"	-081°28'39.4979"	22.28	26.2	3.9'	25.96	12"	SJCUD	MUELLER COMPANY	DUCT
FM-18	4" X 3" REDUCER	2046375.9590	504923.2890	29°57'42.7198"	-081°28'39.4369"	23.44	26.2	2.8'	-	4" X 3"	SJCUD	STAR PIPE PRODUCTS	DUCT
FM-19	12" CAP	2046368.1320	504889.3400	29°57'42.6409"	-081°28'39.8224"	22.95	26.2	3.3'	-	12"	SJCUD	STAR PIPE PRODUCTS	F
FM-20	12" CAP	2046348.5020	505046.0480	29°57'42.4530"	-081°28'38.0400"	22.14	25.8	3.7'	-	12"	SJCUD	STAR PIPE PRODUCTS	F


RE-USE WATER FITTINGS TABLE

LABEL	TYPE	NORTHING	EASTING	LATITUDE	LONGITUDE	PIPE ELEVATION	FINAL GRADE	COVER	TOP OF NUT	UTILITY SIZE	FACILITY OWNER	MANUFACTURER	FITTING
RW-1	TAPPING SLEEVE	2046271.6690	504897.9640	29°57'41.6864"	-081°28'39.7198"	21.75	27.0	5.25'	-	8" X 4"	SJCUD	PERFORMANCE PIPE	STAINL
RW-2	GATE VALVE	2046271.7372	504897.8876	29°57'41.6863"	-081°28'39.7192"	21.75	27.0	5.25'	22.90	4"	SJCUD	MUELLER COMPANY	DUCT
RW-2A	45°	2046289.5934	504901.9930	29°57'41.8639"	-081°28'39.6748"	22.04	25.7	3.7'	-	4"	SJCUD	STAR PIPE PRODUCTS	DUCT
RW-2B	45°	2046296.1410	504903.4647	29°57'41.9288"	-081°28'39.6584"	20.03	24.0	4.0'	-	4"	SJCUD	STAR PIPE PRODUCTS	DUCT
RW-3	GATE VALVE	2046351.3280	504915.2040	29°57'42.4756"	-081°28'39.5276"	19.92	25.0	5.1'	21.88	4"	SJCUD	MUELLER COMPANY	DUCT
RW-4	REDUCER	2046353.4320	504917.5900	29°57'42.4966"	-081°28'39.5006"	19.27	25.0	5.7'	-	12" X 4"	SJCUD	STAR PIPE PRODUCTS	DUCT
RW-5	CROSS	2046355.4794	504916.0346	29°57'42.5168"	-081°28'39.5184"	20.23	25.0	4.8'	-	16" X 12"	SJCUD	STAR PIPE PRODUCTS	DUCT
RW-6	GATE VALVE	2046355.9370	504912.1580	29°57'42.5211"	-081°28'39.5624"	19.08	25.2	6.1'	22.76	16"	SJCUD	MUELLER COMPANY	DUCT
RW-7	REDUCER	2046356.4060	504916.8960	29°57'42.5260"	-081°28'39.5624"	21.27	25.4	4.1'	-	12" X 4"	SJCUD	STAR PIPE PRODUCTS	DUCT
RW-8	GATE VALVE	2046362.5320	504917.0320	29°57'42.5866"	-081°28'39.5074"	19.58	25.7	6.1'	20.74	4"	SJCUD	MUELLER COMPANY	DUCT
RW-9	GATE VALVE	2046355.2600	504918.9620	29°57'41.6864"	-081°28'39.4851"	19.12	25.2	6.1'	22.80	16"	SJCUD	MUELLER COMPANY	DUCT
RW-10	45°	2046354.5150	504924.5986	29°57'42.5076"	-081°28'39.4210"	19.81	25.5	5.7'	-	16"	SJCUD	STAR PIPE PRODUCTS	DUCT
RW-11	45°	2046354.0630	504927.0960	29°57'42.5032"	-081°28'39.3925"	21.92	25.5	3.6'	-	16"	SJCUD	STAR PIPE PRODUCTS	DUCT
RW-12	CAP	2046359.6980	504888.8490	29°57'42.5574"	-081°28'39.8276"	23.45	25.9	2.5'	-	16"	SJCUD	STAR PIPE PRODUCTS	F
RW-13	CAP	2046337.5120	505045.8300	29°57'42.3442"	-081°28'38.0419"	22.71	25.8	3.1'	-	16"	SJCUD	STAR PIPE PRODUCTS	F
RW-14	REDUCER	2046375.9333	504913.9695	29°57'42.7191"	-081°28'39.5428"	24.43	27.5	3.1'	-	4" X 2"	SJCUD	STAR PIPE PRODUCTS	DUCT
RW-15	METER BOX	2046386.3980	504919.7670	29°57'42.8229"	-081°28'39.4773"	-	27.35	-	-	1.1' X 1.7'	SJCUD	GLASMASTERS	POL

9-
PREVENTER

PRIVATE
UTILITY
PUBLIC
UTILITY

ROAD NO. 16
RIGHT-OF-WAY

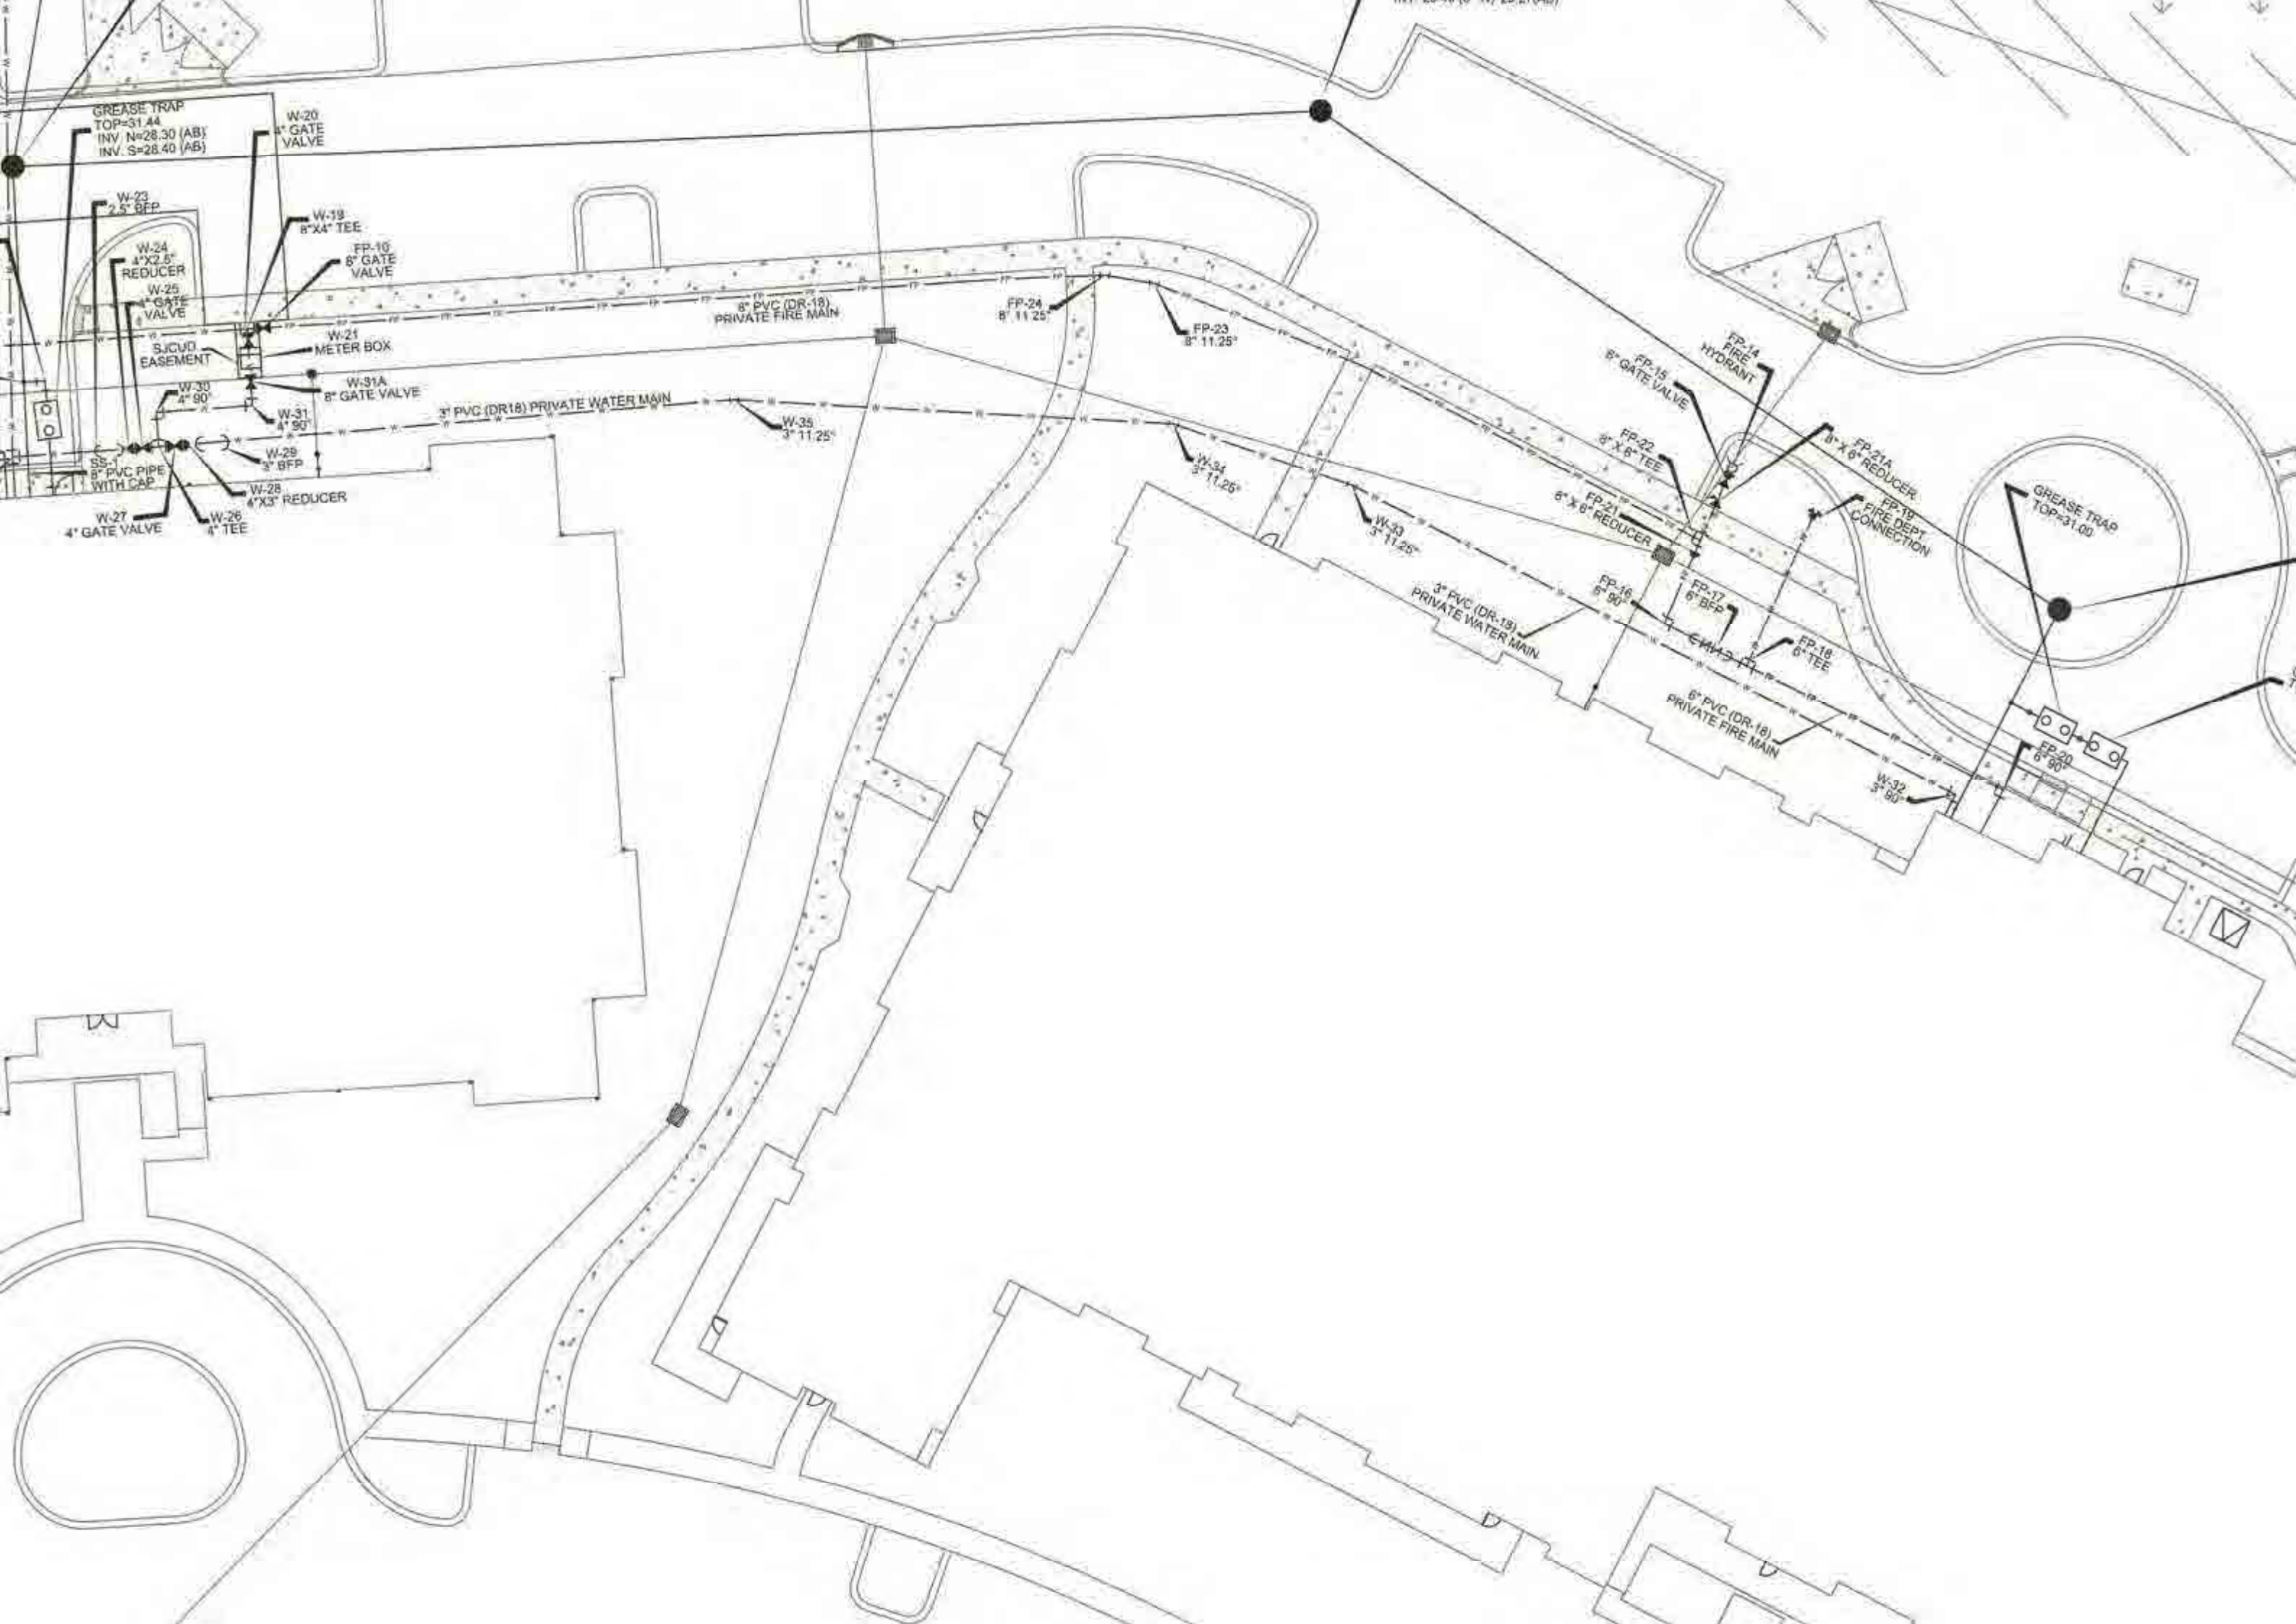

	2047114.2965	505019.6980	29°57'50.0325"	-081°28'38.3758"	26.49	29.5	3.6'	-	8"X8"	SJCUD	STAR PIPE PRODUCTS	DUCTILE IRON	ASPHALT SEAL COAT
TEE	2047121.9437	505129.7077	29°57'50.1127"	-081°28'37.1255"	27.10	31.1	4.0'	-	8"X4"	SJCUD	STAR PIPE PRODUCTS	DUCTILE IRON	ASPHALT SEAL COAT
E VALVE	2047120.5730	505130.1900	29°57'50.0991"	-081°28'37.1199"	26.66	30.96	4.30'	28.26	4"	SJCUD	MUELLER COMPANY	DUCTILE IRON	FUSION BONDED EPOXY
ER BOX	2047115.7530	505130.5285	29°57'50.0514"	-081°28'37.1156"	-	30.96	-	-	4.5'X4.5'	SJCUD	GLASMASTERS	FIBERGLASS	FIBERGLASS
SE BIB	2047197.4140	505076.7890	29°57'50.8575"	-081°28'37.7306"	-	30.57	-	-	1.5"	SJCUD	NORTH AMERICAN PIPE CORPORATION	PVC	PVC
TEE	2047094.3667	505079.1504	29°57'49.8376"	-081°28'37.6989"	27.53	31.0	3.5'	-	2.5'X2.5'X1.5"	SJCUD	STAR PIPE PRODUCTS	DUCTILE IRON	ASPHALT SEAL COAT
BFP	2047095.2720	505100.0860	29°57'49.8475"	-081°28'37.4610"	-	32.2	-	-	2.5"	SJCUD	ZURN WILKINS	CAST IRON	FUSION BONDED EPOXY
REDUCER	2047096.1309	505104.2176	29°57'49.8561"	-081°28'37.4140"	28.17	32.2	4.0'	-	4" X 2.5"	SJCUD	STAR PIPE PRODUCTS	DUCTILE IRON	ASPHALT SEAL COAT
E VALVE	2047097.2100	505107.9300	29°57'49.8670"	-081°28'37.3719"	28.14	32.2	4.1'	29.30	4"	SJCUD	MUELLER COMPANY	DUCTILE IRON	FUSION BONDED EPOXY
TEE	2047097.1500	505109.9620	29°57'49.8665"	-081°28'37.3488"	28.14	31.7	3.6'	-	4"	SJCUD	STAR PIPE PRODUCTS	DUCTILE IRON	ASPHALT SEAL COAT
TE VALVE	2047096.2300	505113.7800	29°57'49.8575"	-081°28'37.3053"	28.43	31.7	3.3'	29.59	4"	SJCUD	MUELLER COMPANY	DUCTILE IRON	FUSION BONDED EPOXY
REDUCER	2047097.0100	505117.1751	29°57'49.8654"	-081°28'37.2668"	28.16	31.7	3.5'	-	4" X 3"	SJCUD	STAR PIPE PRODUCTS	DUCTILE IRON	ASPHALT SEAL COAT
REDUCER	2047096.8960	505120.3680	29°57'49.8644"	-081°28'37.2305"	-	31.3	-	-	2.5"	SJCUD	ZURN WILKINS	CAST IRON	FUSION BONDED EPOXY
90°	2047104.8980	505110.8330	29°57'49.9432"	-081°28'37.3392"	28.16	31.0	2.8'	-	4"	SJCUD	STAR PIPE PRODUCTS	DUCTILE IRON	ASPHALT SEAL COAT
90°	2047104.5490	505129.5850	29°57'49.9405"	-081°28'37.1260"	28.23	31.2	3.0'	-	4"	SJCUD	STAR PIPE PRODUCTS	DUCTILE IRON	ASPHALT SEAL COAT
TE VALVE	2047110.6996	505130.5655	29°57'49.9321"	-081°28'37.1175"	28.17	31.2	3.0'	29.67	8"	SJCUD	MUELLER COMPANY	DUCTILE IRON	FUSION BONDED EPOXY
90°	2047022.1161	505498.4199	29°57'49.1397"	-081°28'32.9290"	29.11	32.2	3.1'	-	3"	SJCUD	STAR PIPE PRODUCTS	DUCTILE IRON	ASPHALT SEAL COAT
11.25°	2047088.7730	505368.0090	29°57'49.7941"	-081°28'34.4148"	28.34	31.3	3.0'	-	3"	SJCUD	STAR PIPE PRODUCTS	DUCTILE IRON	ASPHALT SEAL COAT
11.25°	2047101.9950	505329.5620	29°57'49.9234"	-081°28'34.8525"	27.74	31.1	3.4'	-	3"	SJCUD	STAR PIPE PRODUCTS	DUCTILE IRON	ASPHALT SEAL COAT
11.25°	2047107.0750	505234.7820	29°57'49.9698"	-081°28'35.9302"	26.67	30.5	3.8'	-	3"	SJCUD	STAR PIPE PRODUCTS	DUCTILE IRON	ASPHALT SEAL COAT


FIRE PROTECTION FITTINGS TABLE

TYPE	NORTHING	EASTING	LATITUDE	LONGITUDE	PIPE ELEVATION	FINAL GRADE	COVER	TOP OF NUT	UTILITY SIZE	FACILITY OWNER	MANUFACTURER	FITTING MATERIAL	LINING MATERIAL
E VALVE	2046809.7590	504979.0280	29°57'47.0162"	-081°28'38.8237"	26.21	30.65	4.44'	27.71	6"	SJCUD	MUELLER COMPANY	DUCTILE IRON	FUSION BONDED EPOXY
22.5'	2046771.6480	505347.5370	29°57'46.6541"	-081°28'34.6325"	27.93	29.6	1.7'	-	6"	SJCUD	STAR PIPE PRODUCTS	DUCTILE IRON	ASPHALT SEAL COAT
E VALVE	2046760.8450	505480.0540	29°57'46.5518"	-081°28'33.3529"	24.94	29.8	4.9'	26.44	6"	SJCUD	MUELLER COMPANY	DUCTILE IRON	FUSION BONDED EPOXY
HYDRANT	2046760.9420	505463.5940	29°57'46.5529"	-081°28'33.3126"	-	32.9	-	-	6"	SJCUD	WATTS	DUCTILE IRON	SILICONE
E VALVE	2047126.9630	504971.5520	29°57'50.1559"	-081°28'38.9237"	27.59	31.04	3.45	28.75	6"	SJCUD	MUELLER COMPANY	DUCTILE IRON	FUSION BONDED EPOXY
HYDRANT	2047129.5290	504971.4530	29°57'50.1812"	-081°28'38.9250"	-	33.4	-	-	6"	SJCUD	WATTS	DUCTILE IRON	SILICONE
E VALVE	2047108.5920	505019.1980	29°57'49.9760"	-081°28'38.3812"	26.49	29.5	3.0'	28.24	8"	SJCUD	MUELLER COMPANY	DUCTILE IRON	FUSION BONDED EPOXY
OW PREVENTER	2047103.3130	505020.9830	29°57'49.9238"	-081°28'38.3606"	-	34.1	-	-	8"	SJCUD	MUELLER COMPANY	CAST IRON	FUSION BONDED EPOXY
EPT. CONNECT	2047133.2590	505047.7980	29°57'50.2213"	-081°28'38.0572"	-	30.5	-	-	6"	SJCUD	WATTS	DUCTILE IRON	SILICONE
E VALVE	2047122.6280	505132.4900	29°57'50.1186"	-081°28'37.0939"	27.74	31.11	3.37'	29.24	8"	SJCUD	MUELLER COMPANY	DUCTILE IRON	FUSION BONDED EPOXY
90°	2047091.7030	2220.26.6010	29°57'49.8089"	-081°28'38.3574"	26.60	31.5	4.9'	-	6"	SJCUD	STAR PIPE PRODUCTS	DUCTILE IRON	ASPHALT SEAL COAT
TEE	2047092.3250	505049.6370	29°57'49.8162"	-081°28'38.0344"	26.23	31.5	5.3	-	6"	SJCUD	STAR PIPE PRODUCTS	DUCTILE IRON	ASPHALT SEAL COAT
90°	2047094.1260	505076.4600	29°57'49.8351"	-081°28'37.7295"	27.82	30.0	2.4	-	6"	SJCUD	STAR PIPE PRODUCTS	DUCTILE IRON	ASPHALT SEAL COAT
RE DEPT. CONNECTION	2047092.6010	505450.1000	29°57'49.8354"	-081°28'33.4817"	-	29.0	-	-	6"	SJCUD	STAR PIPE PRODUCTS	DUCTILE IRON	ASPHALT SEAL COAT
TE VALVE	2047089.9930	505448.8910	29°57'49.8095"	-081°28'33.4953"	27.74	29.1	1.4'	28.90	6"	SJCUD	STAR PIPE PRODUCTS	DUCTILE IRON	ASPHALT SEAL COAT
90°	2047060.2810	505434.2850	29°57'49.5148"	-081°28'33.6510"	29.13	31.6	2.5'	-	6"	SJCUD	STAR PIPE PRODUCTS	DUCTILE IRON	ASPHALT SEAL COAT
BFP	2047057.2210	505438.6190	29°57'49.4847"	-081°28'33.6105"	-	31.7	-	-	6"	SJCUD	ZURN WILKINS	CAST IRON	FUSION BONDED EPOXY
TEE	2047050.0180	505453.1570	29°57'49.4140"	-081°28'33.4449"	28.81	31.2	2.4'	-	6"	SJCUD	STAR PIPE PRODUCTS	DUCTILE IRON	ASPHALT SEAL COAT
RE DEPT. CONNECTION	2047082.2340	505467.6420	29°57'49.7335"	-081°28'33.2818"	-	30.2	-	-	6"	SJCUD	STAR PIPE PRODUCTS	DUCTILE IRON	ASPHALT SEAL COAT
90°	2047023.0640	505508.4980	29°57'49.1495"	-081°28'32.8145"	29.11	32.2	3.1'	-	6"	SJCUD	STAR PIPE PRODUCTS	DUCTILE IRON	ASPHALT SEAL COAT
REDUCER	2047076.2010	505442.0210	29°57'49.6727"	-081°28'33.5728"	28.44	30.3	1.9'	-	8"X6"	SJCUD	STAR PIPE PRODUCTS	DUCTILE IRON	ASPHALT SEAL COAT
REDUCER	2047085.2892	505446.8561	29°57'49.7628"	-081°28'33.5182"	28.34	30.3	2.0'	-	8"X6"	SJCUD	STAR PIPE PRODUCTS	DUCTILE IRON	ASPHALT SEAL COAT
TEE	2047078.5380	505442.3010	29°57'49.6959"	-081°28'33.5697"	28.34	30.3	2.0'	-	8"	SJCUD	STAR PIPE PRODUCTS	DUCTILE IRON	ASPHALT SEAL COAT
11.25°	2047132.3910	505325.3820	29°57'50.2241"	-081°28'34.9014"	27.07	30.7	3.6'	-	8"	SJCUD	STAR PIPE PRODUCTS	DUCTILE IRON	ASPHALT SEAL COAT
11.25°	2047133.0970	505314.6800	29°57'50.2307"	-081°28'35.0231"	27.29	30.5	3.2'	-	8"	SJCUD	STAR PIPE PRODUCTS	PVC	PVC
OF 6" PVC	2046828.3230	505102.2793	29°57'47.2051"	-081°28'37.4234"	27.93	31.3	3.4'	-	8"	SJCUD	STAR PIPE PRODUCTS	PVC	PVC
OF 6" PVC	2046796.7160	505294.2001	29°57'46.9001"	-081°28'35.2401"	28.27	29.6	1.3'	-	8"	SJCUD	STAR PIPE PRODUCTS	PVC	PVC

FORCE MAIN FITTINGS TABLE

TYPE	NORTHING	EASTING	LATITUDE	LONGITUDE	PIPE ELEVATION	FINAL GRADE	COVER	TOP OF NUT	UTILITY SIZE	FACILITY OWNER	MANUFACTURER	FITTING MATERIAL	LINING MATERIAL
45°	2047146.4130	504912.6080	29°57'50.3460"	-081°28'39.5946"	24.65	28.7	4.1'	-	3"	SJCUD	STAR PIPE PRODUCTS	DUCTILE IRON	ASPHALT SEAL COAT
45°	2047204.1760	504972.1780	29°57'50.9202"	-081°28'38.9203"	25.06	27.7	2.6'	-	3"	SJCUD	STAR PIPE PRODUCTS	DUCTILE IRON	ASPHALT SEAL COAT
P 3" PVC	2047044.7980	504913.8970	29°57'49.3401"	-081°28'39.5753"	24.79	30.2	5.4'	-	3"	SJCUD	STAR PIPE PRODUCTS	PVC	PVC

Plot

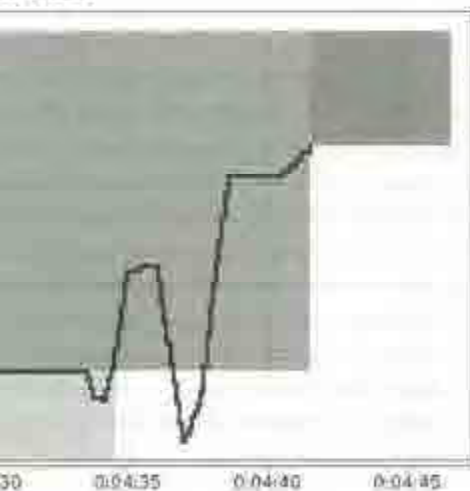

ot



Pressures

Drag Pressure	65 psi	
Bead Up	60 psi	228 psi
Heat Soak	0 psi	65 psi
Fuse	60 psi	228 psi
Cool	0 psi	0 psi

Fusion Specification

Fusion Type	Butt Fusion
Fusion Specification	ASTM F2620
Bead Time	0 seconds
Bead Size	1/4"
Heat/Soak Time	272 seconds
Fuse Time	665 seconds
Open/Close Time	15 seconds
Cool Time	0 seconds

	Minimum	Maximum
Bead Up	227 psi	309 psi
Heat Soak	0 psi	65 psi
Fuse	227 psi	309 psi
Cool	0 psi	0 psi

External Heater Temperatures

	Side A	Side B
One	425 °F	425 °F
Two	425 °F	425 °F
Three	425 °F	425 °F
Four	425 °F	425 °F

GPS Location

	Latitude	Longitude
2021-09-09 18:16:07 UTC	29°57'47.6"N	81°28'38.9"W

Logged Data Summary

Number of Data Points	82
Total Fusion Time	1095 seconds
Maximum Recorded Pressure	228 psi


Device Information

DataLogger Serial Number	MDL5-0751
Calibration Date	2020-11-19
Firmware Version	v5.1
Software Version	v1.1.2
Software Product Name	DLSm


Data Source

File Name	DLS 2010-10-26 12-54-06 Joint 2 Job 8946 by bj,DLS
Upload Time	2021-09-10 11:13:07 GMT

Heater Removal Plot

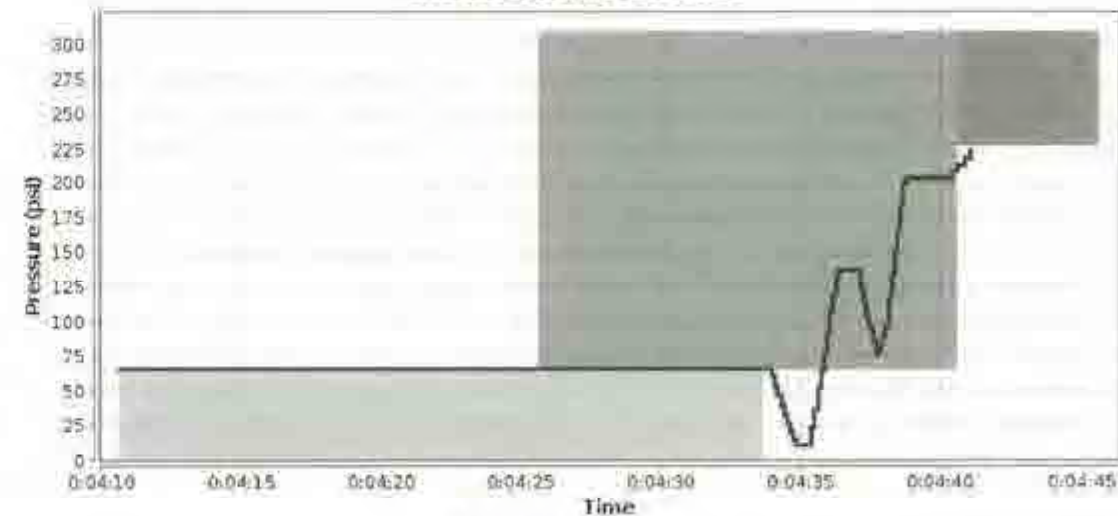


Summary Plot

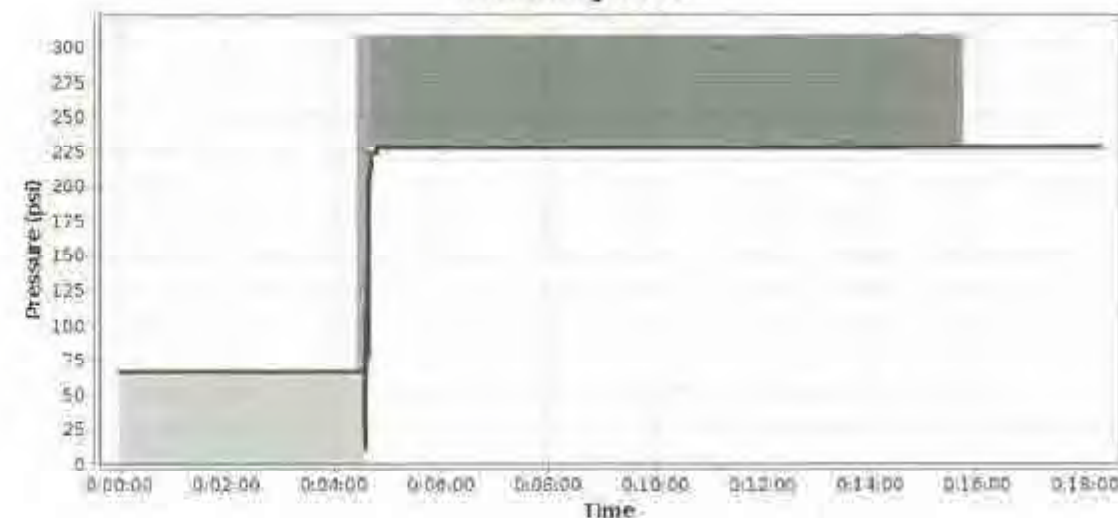

Notes

pull head

al Plot

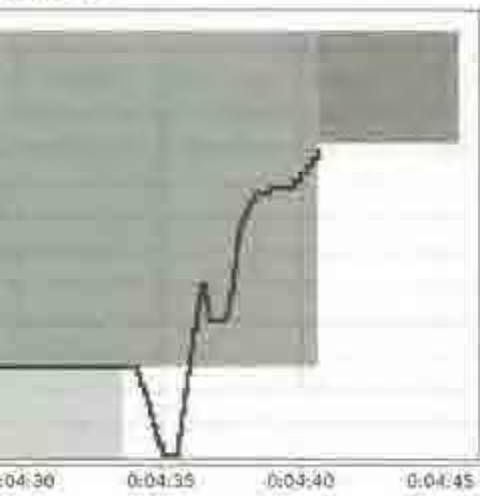

lot



Pressures

Drag Pressure	67 psi		
Bead Up	60 psi	Interfacial	Gauge
Heat Soak	0 psi		230 psi
Fuse	60 psi		67 psi
Cool	0 psi		230 psi
			0 psi

Fusion Specification

Fusion Type	Butt Fusion
Fusion Specification	ASTM F2620
Bead Time	0 seconds
Bead Size	1/4"
Heat/Soak Time	272 seconds
Fuse Time	665 seconds
Open/Close Time	15 seconds
Cool Time	0 seconds

	Minimum	Maximum
Bead Up	229 psi	311 psi
Heat Soak	0 psi	67 psi
Fuse	229 psi	311 psi
Cool	0 psi	0 psi

External Heater Temperatures

	Side A	Side B
One	429 °F	429 °F
Two	427 °F	429 °F
Three	429 °F	427 °F
Four	427 °F	429 °F

GPS Location

	Latitude	Longitude
2021-09-09 20:03:50		
UTC	29°57'47.5"N	81°28'38.9"W

Logged Data Summary

Number of Data Points	126
Total Fusion Time	1083 seconds
Maximum Recorded Pressure	227 psi


Device Information

DataLogger Serial Number	MDLS-0751
Calibration Date	2020-11-19
Firmware Version	v5.1
Software Version	v1.1.2
Software Product Name	DL5m


Data Source

File Name	DL5 2010-10-26 14-41-48 Joint 6 Job 8946 by bj.DL5
Upload Time	2021-09-10 11:13:10 GMT

Heater Removal Plot

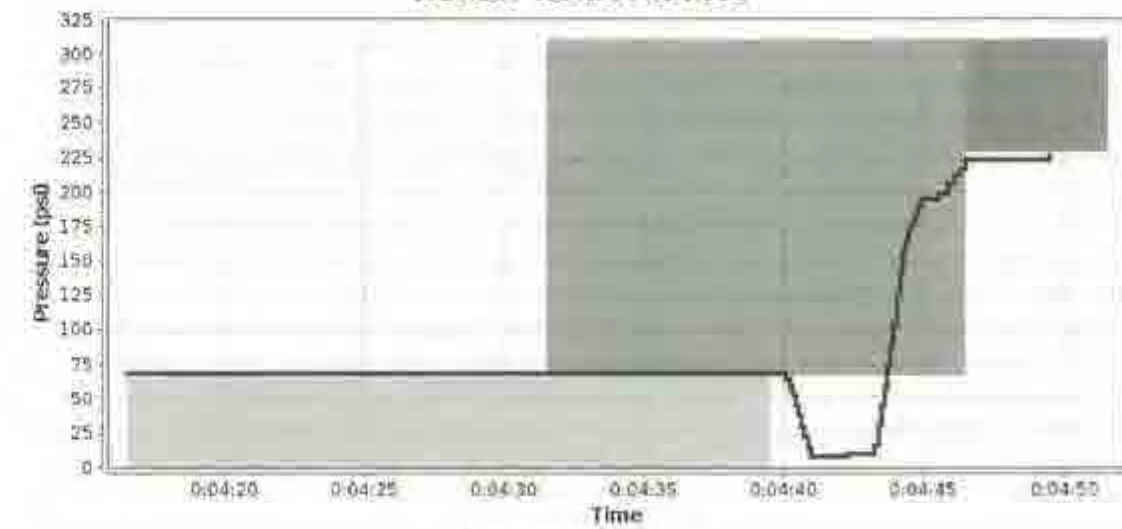

Summary Plot

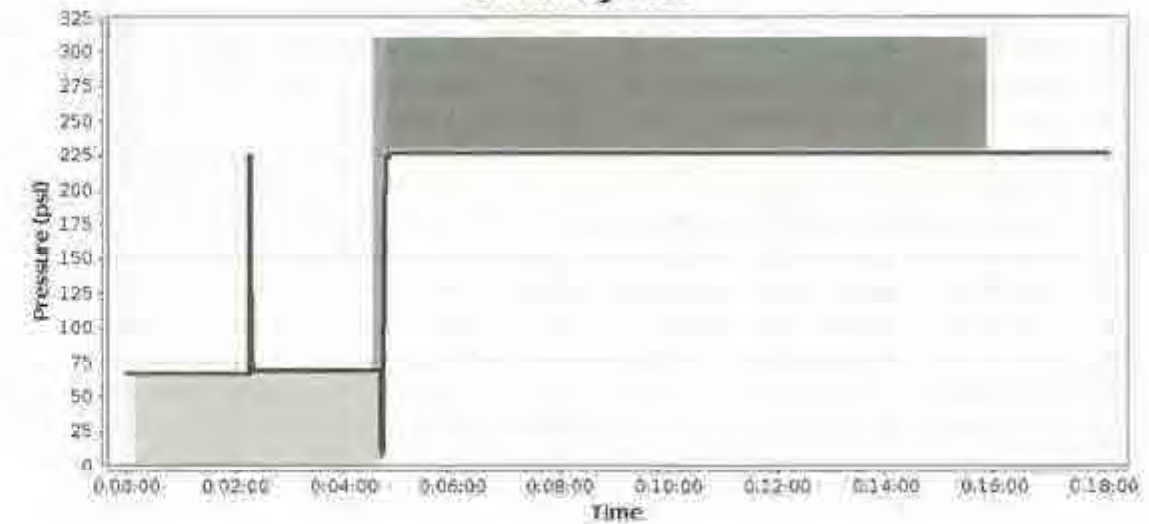

Notes

pull head

Pressures

Drag Pressure	67 psi		
		Interfacial	Gauge
Bead Up		60 psi	230 psi
Heat Soak		0 psi	67 psi
Fuse		60 psi	230 psi
Cool		0 psi	0 psi

Fusion Specification

Fusion Type	Butt Fusion
Fusion Specification	ASTM F2620
Bead Time	0 seconds
Bead Size	1/4"
Heat/Soak Time	272 seconds
Fuse Time	665 seconds
Open/Close Time	15 seconds
Cool Time	0 seconds

	Minimum	Maximum
Bead Up	229 psi	311 psi
Heat Soak	0 psi	67 psi
Fuse	229 psi	311 psi
Cool	0 psi	0 psi

External Heater Temperatures

	Side A	Side B
One	433 °F	431 °F
Two	433 °F	431 °F
Three	431 °F	425 °F
Four	429 °F	429 °F

GPS Location

	Latitude	Longitude
2021-09-09 20:32:45		
UTC	29°57'47.5"N	81°28'38.9"W

Logged Data Summary


Number of Data	
Points	68
Total Fusion Time	1081 seconds
Maximum Recorded	
Pressure	225 psi

Device Information

DataLogger Serial	
Number	MDL5-0751
Calibration Date	2020-11-19
Firmware Version	v5.1
Software Version	v1.1.2
Software Product	
Name	DL5m

Data Source

File Name	DL5 2010-10-26 15-10-43 Joint 7 Job 8946 by bf.DL5
Upload Time	2021-09-10 11:13:10 GMT

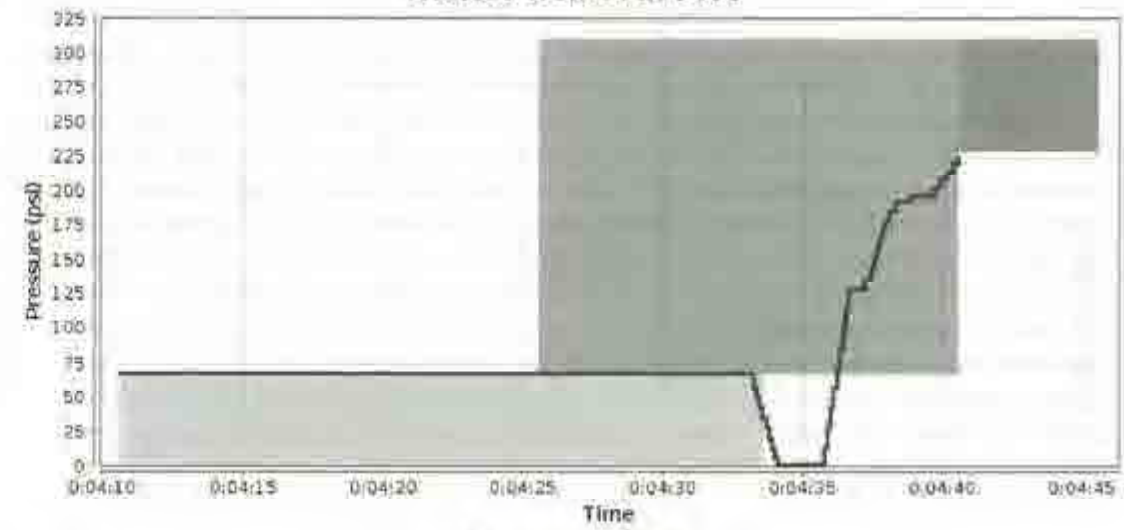Heater Removal Plot**Summary Plot****Notes**

pull head

**NW CR 2209 RM FM International Grand
Parkway State Road 16
As Built Drawings**






VICINITY MAP

N.T.S.

LEGEND

- ± — DENOTES PLUS OR MINUS
- AB — DENOTES AS-BUILT
- AL — DENOTES ARC LENGTH
- ALUM — DENOTES ALUMINUM
- BM — DENOTES BENCHMARK
- BOC — DENOTES BACK OF CURB
- ℄ — DENOTES CENTERLINE
- C# — DENOTES CURVE NUMBER

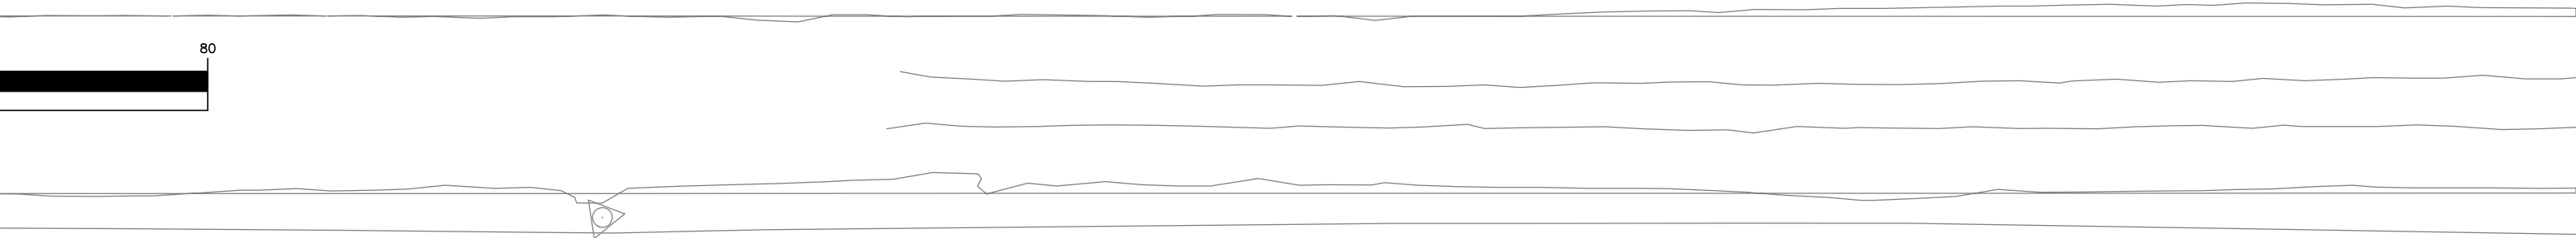


PAGE NOTES

- 1. SEE COVER SHEET FOR NOTES AND LEGEND
- 2. THIS PAGE NOT VALID WITHOUT COVER SHEET

FORCE MA AS-BUILT


TRAINED.


TRANSITION FROM 20" HDPE
BOLTED TO TEE

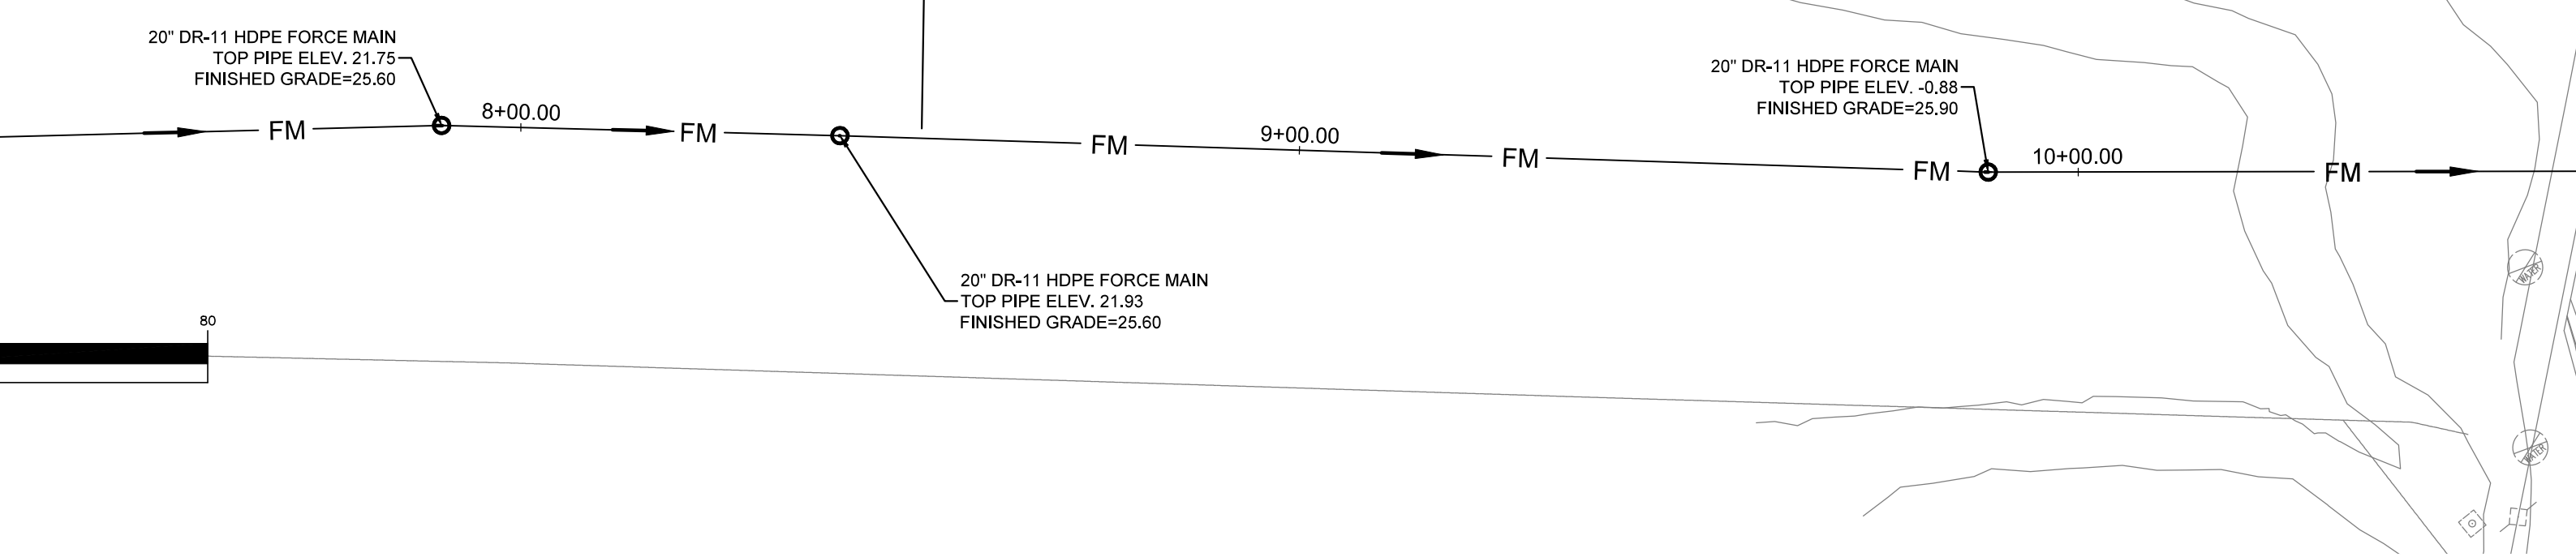

PAGE NOTES


1. SEE COVER SHEET FOR NOTES AND LEGEND
2. THIS PAGE NOT VALID WITHOUT COVER SHEET

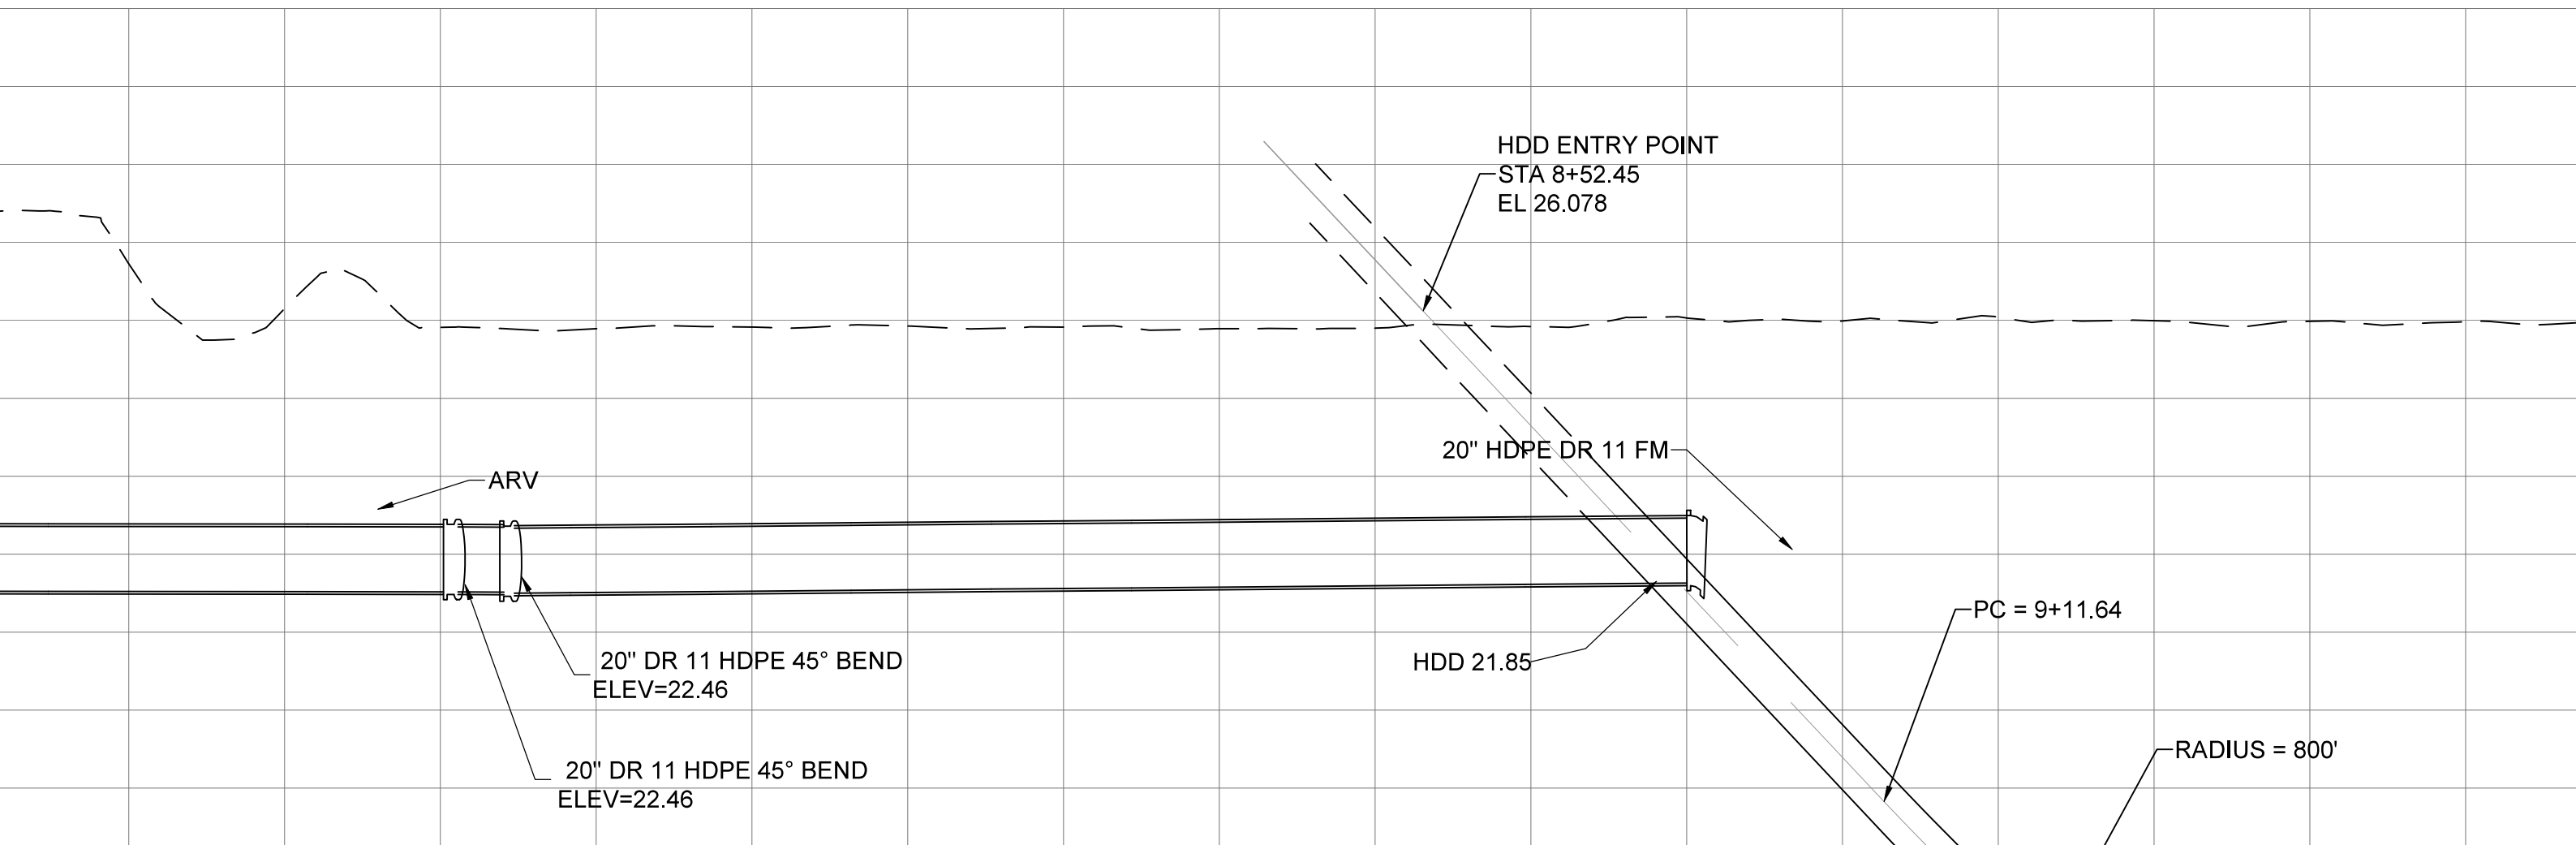


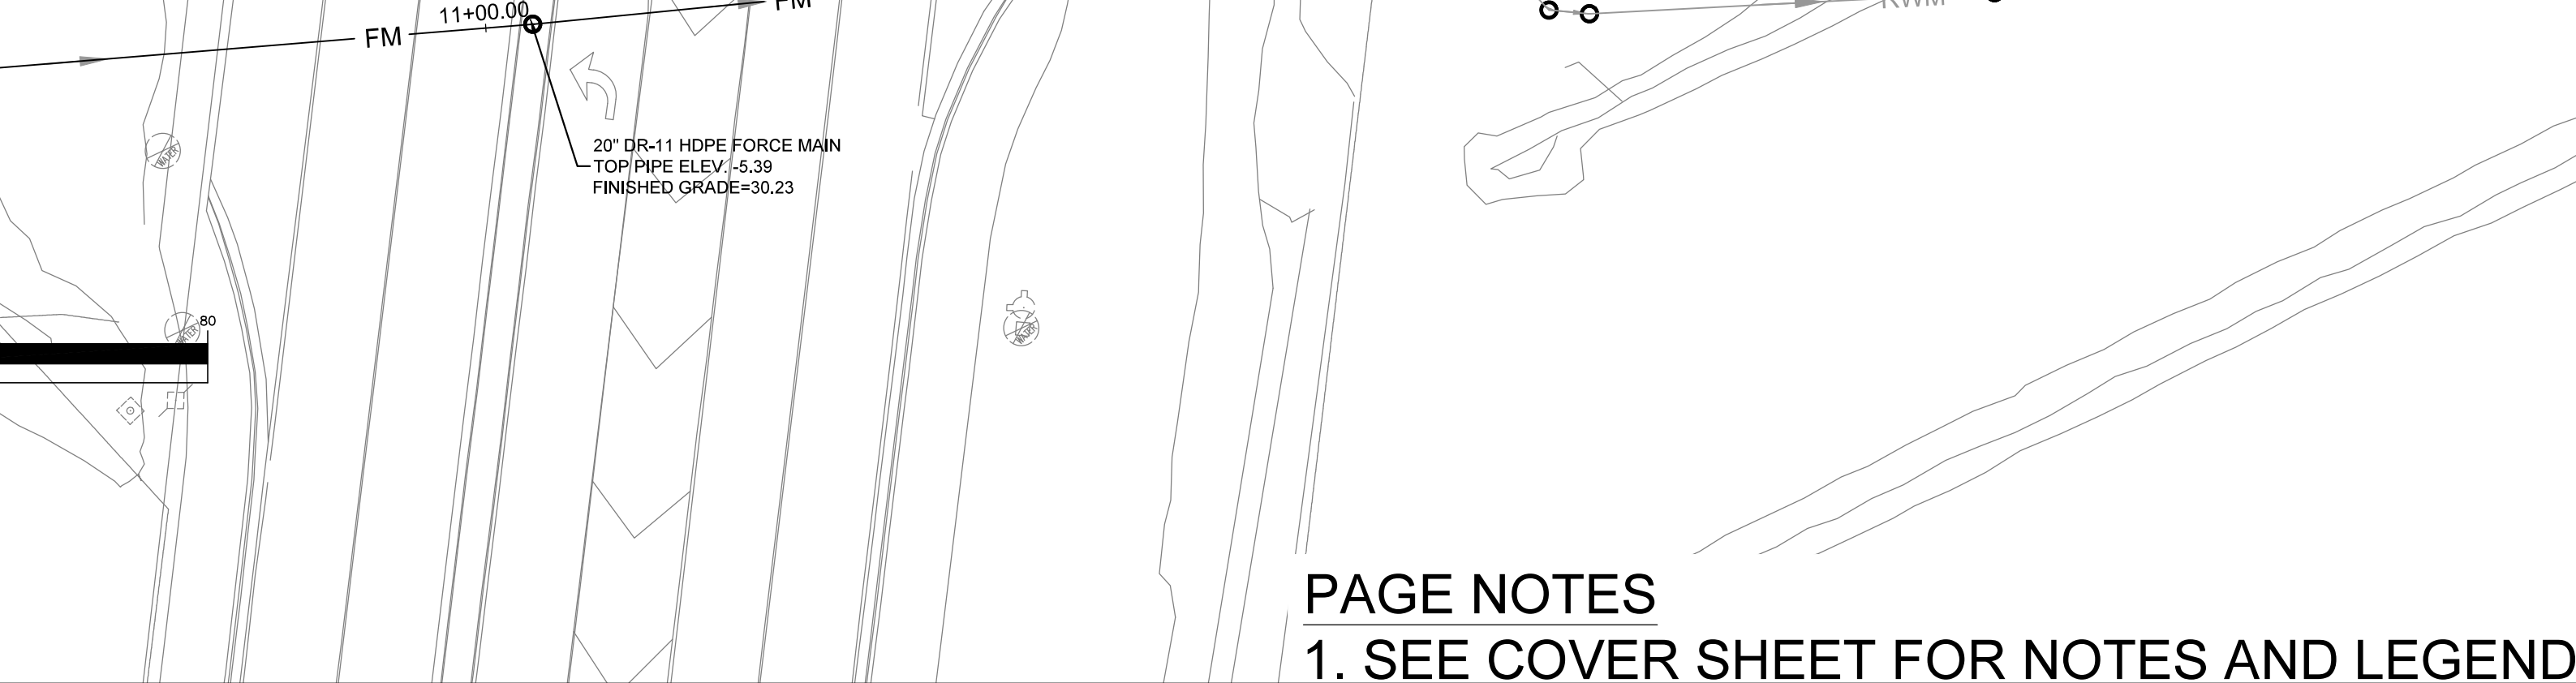

PAGE NOTES


1. SEE COVER SHEET FOR NOTES AND LEGEND
2. THIS PAGE NOT VALID WITHOUT COVER SHEET

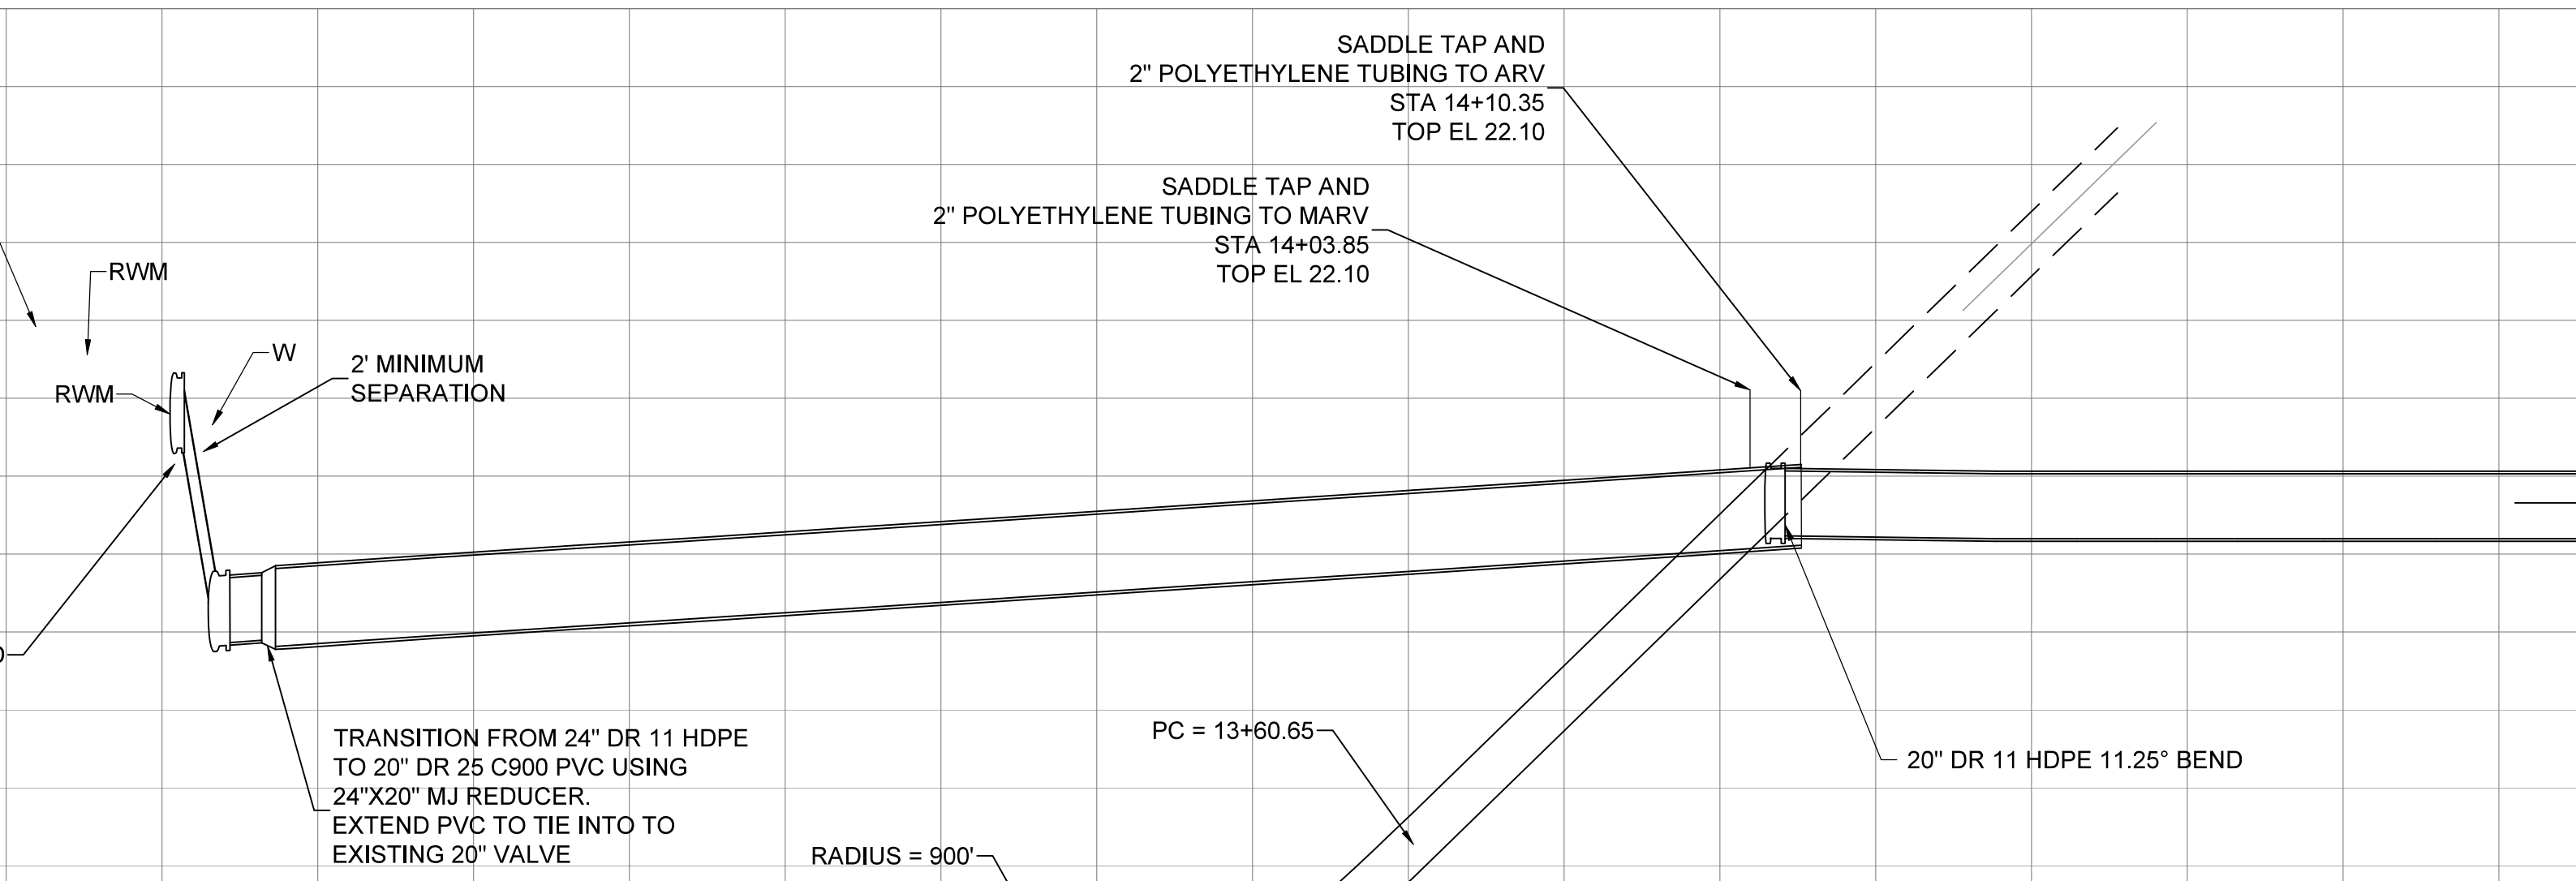

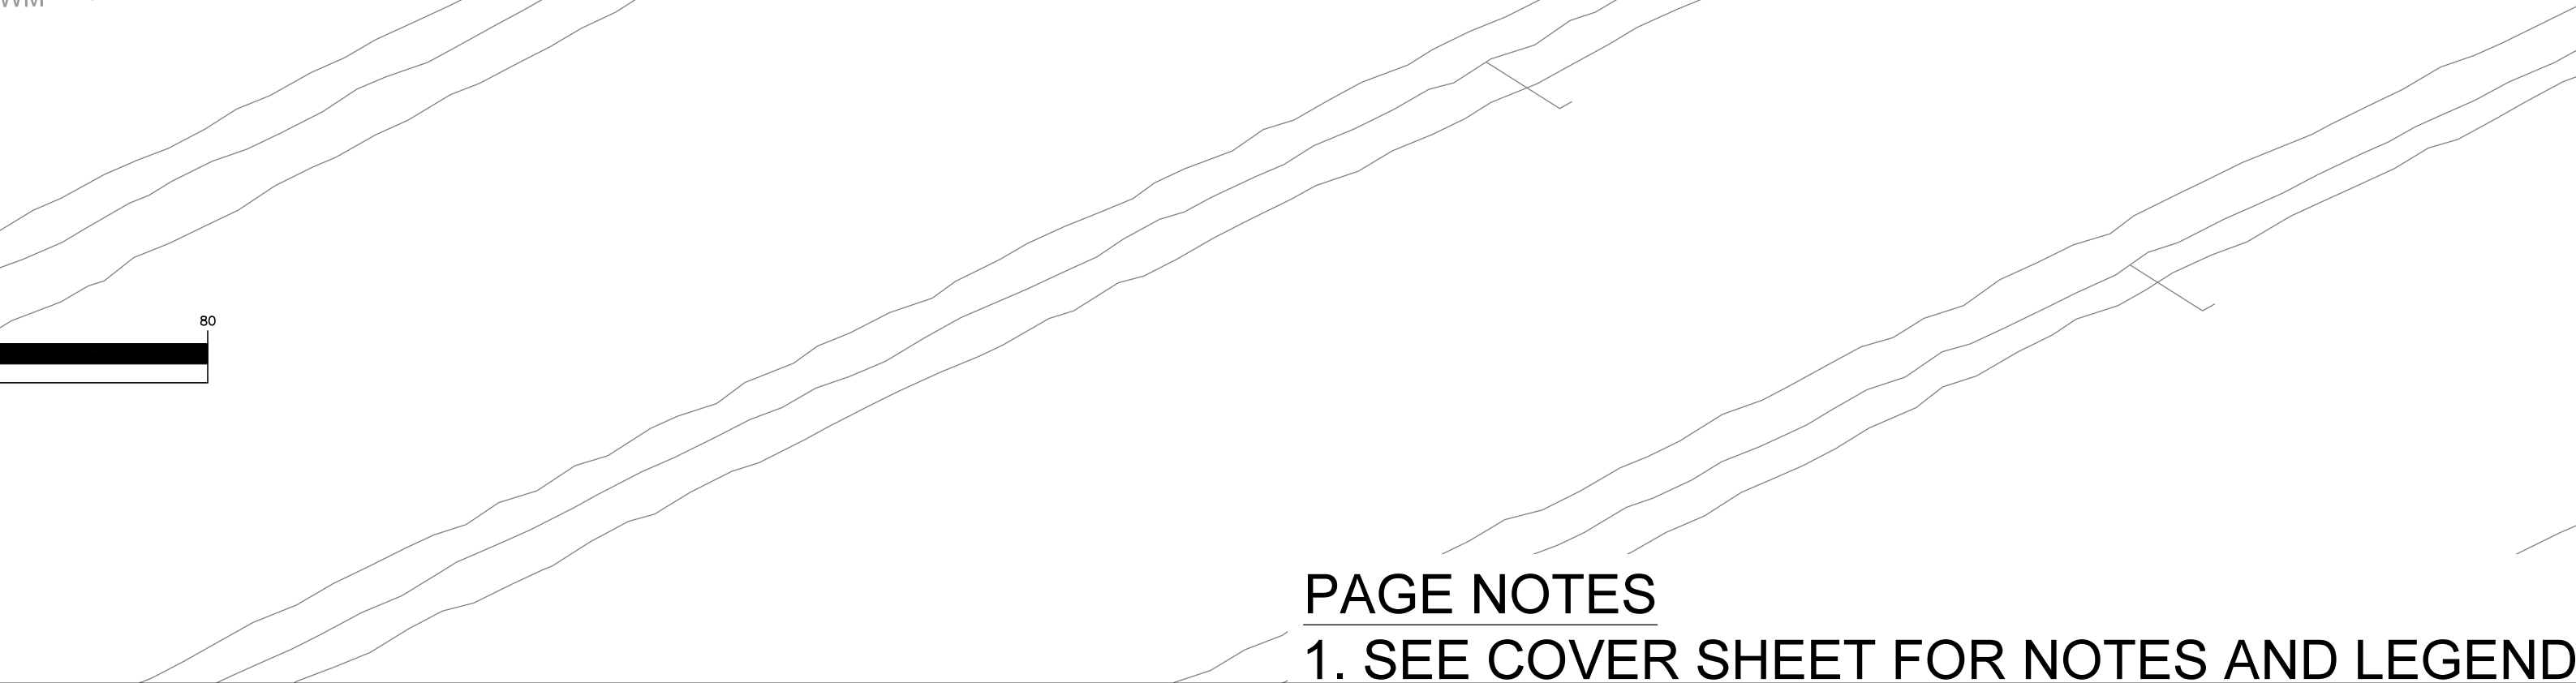

PAGE NOTES

- 1. SEE COVER SHEET FOR NOTES AND LEGEND
- 2. THIS PAGE NOT VALID WITHOUT COVER SHEET

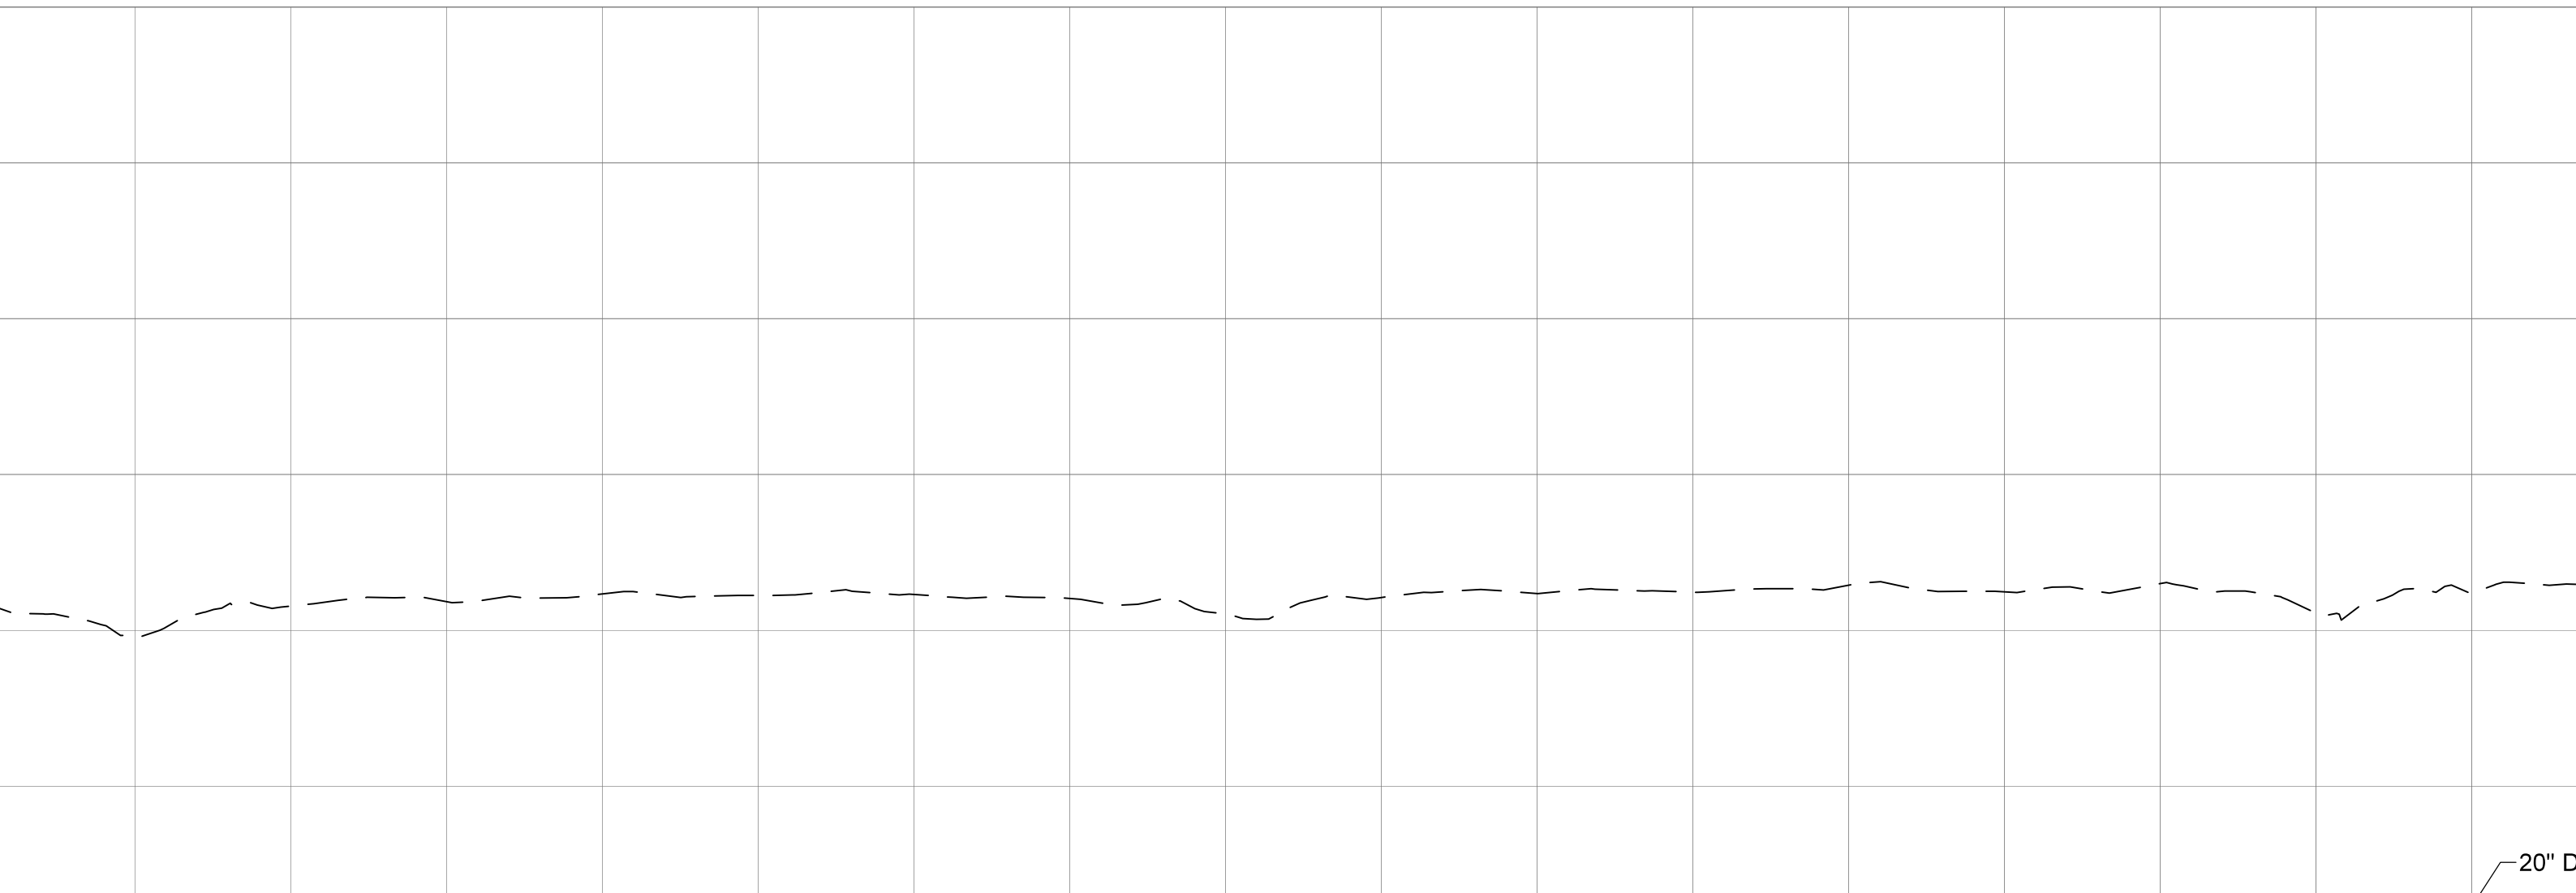




FORCE AS-BU


PAGE NOTES

1. SEE COVER SHEET FOR NOTES AND LEGEND
2. THIS PAGE NOT VALID WITHOUT COVER SHEET

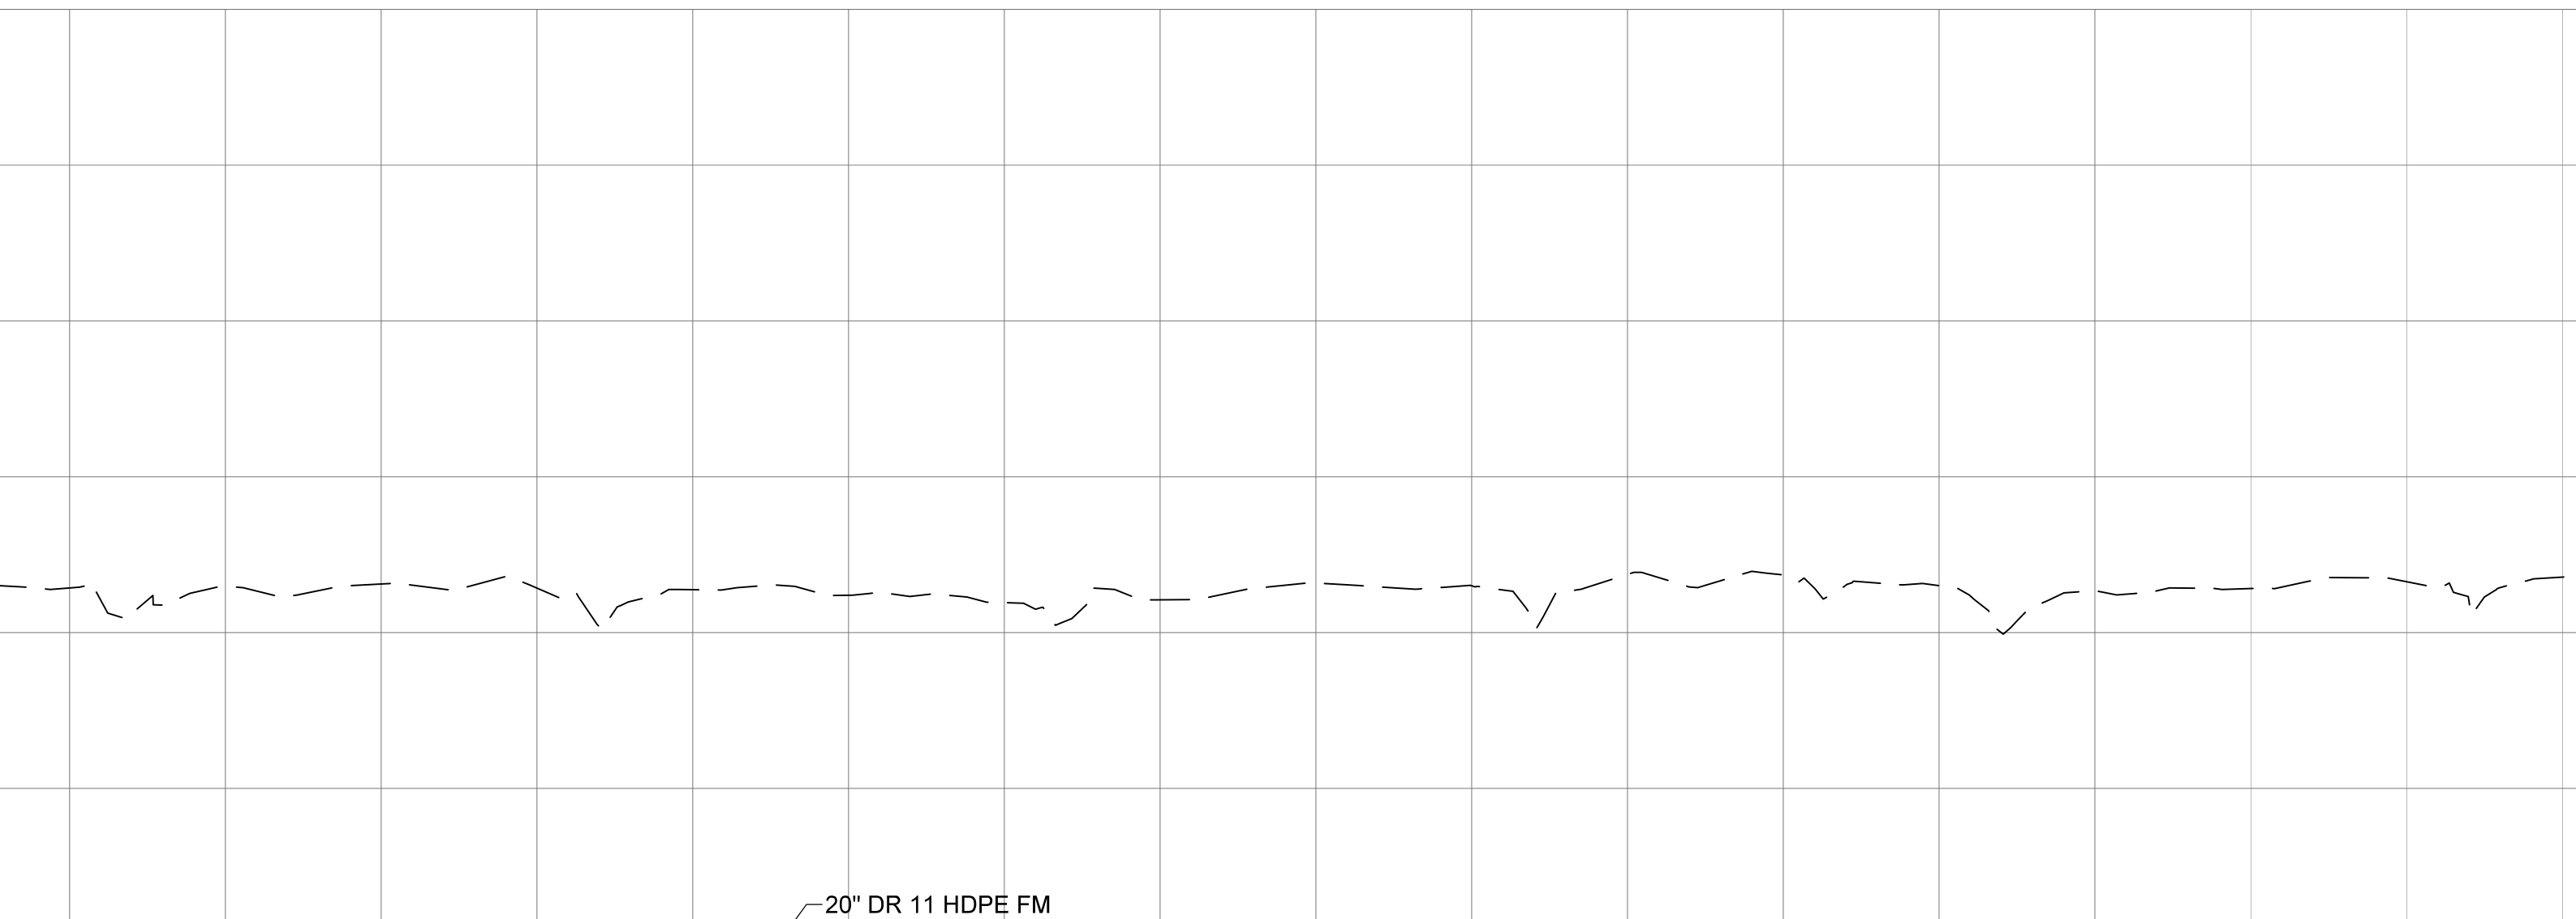


MAIN

LT

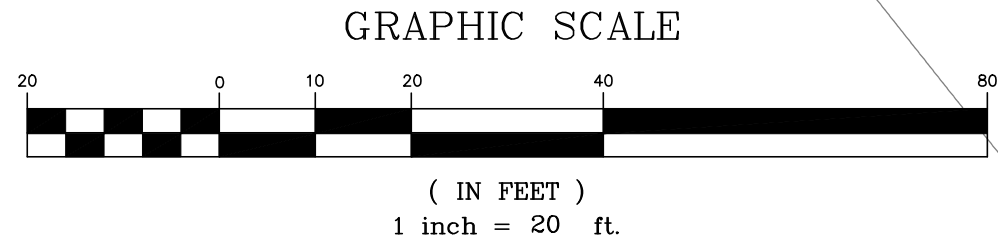


PAGE NOTES

1. SEE COVER SHEET FOR NOTES AND LEGEND
2. THIS PAGE NOT VALID WITHOUT COVER SHEET

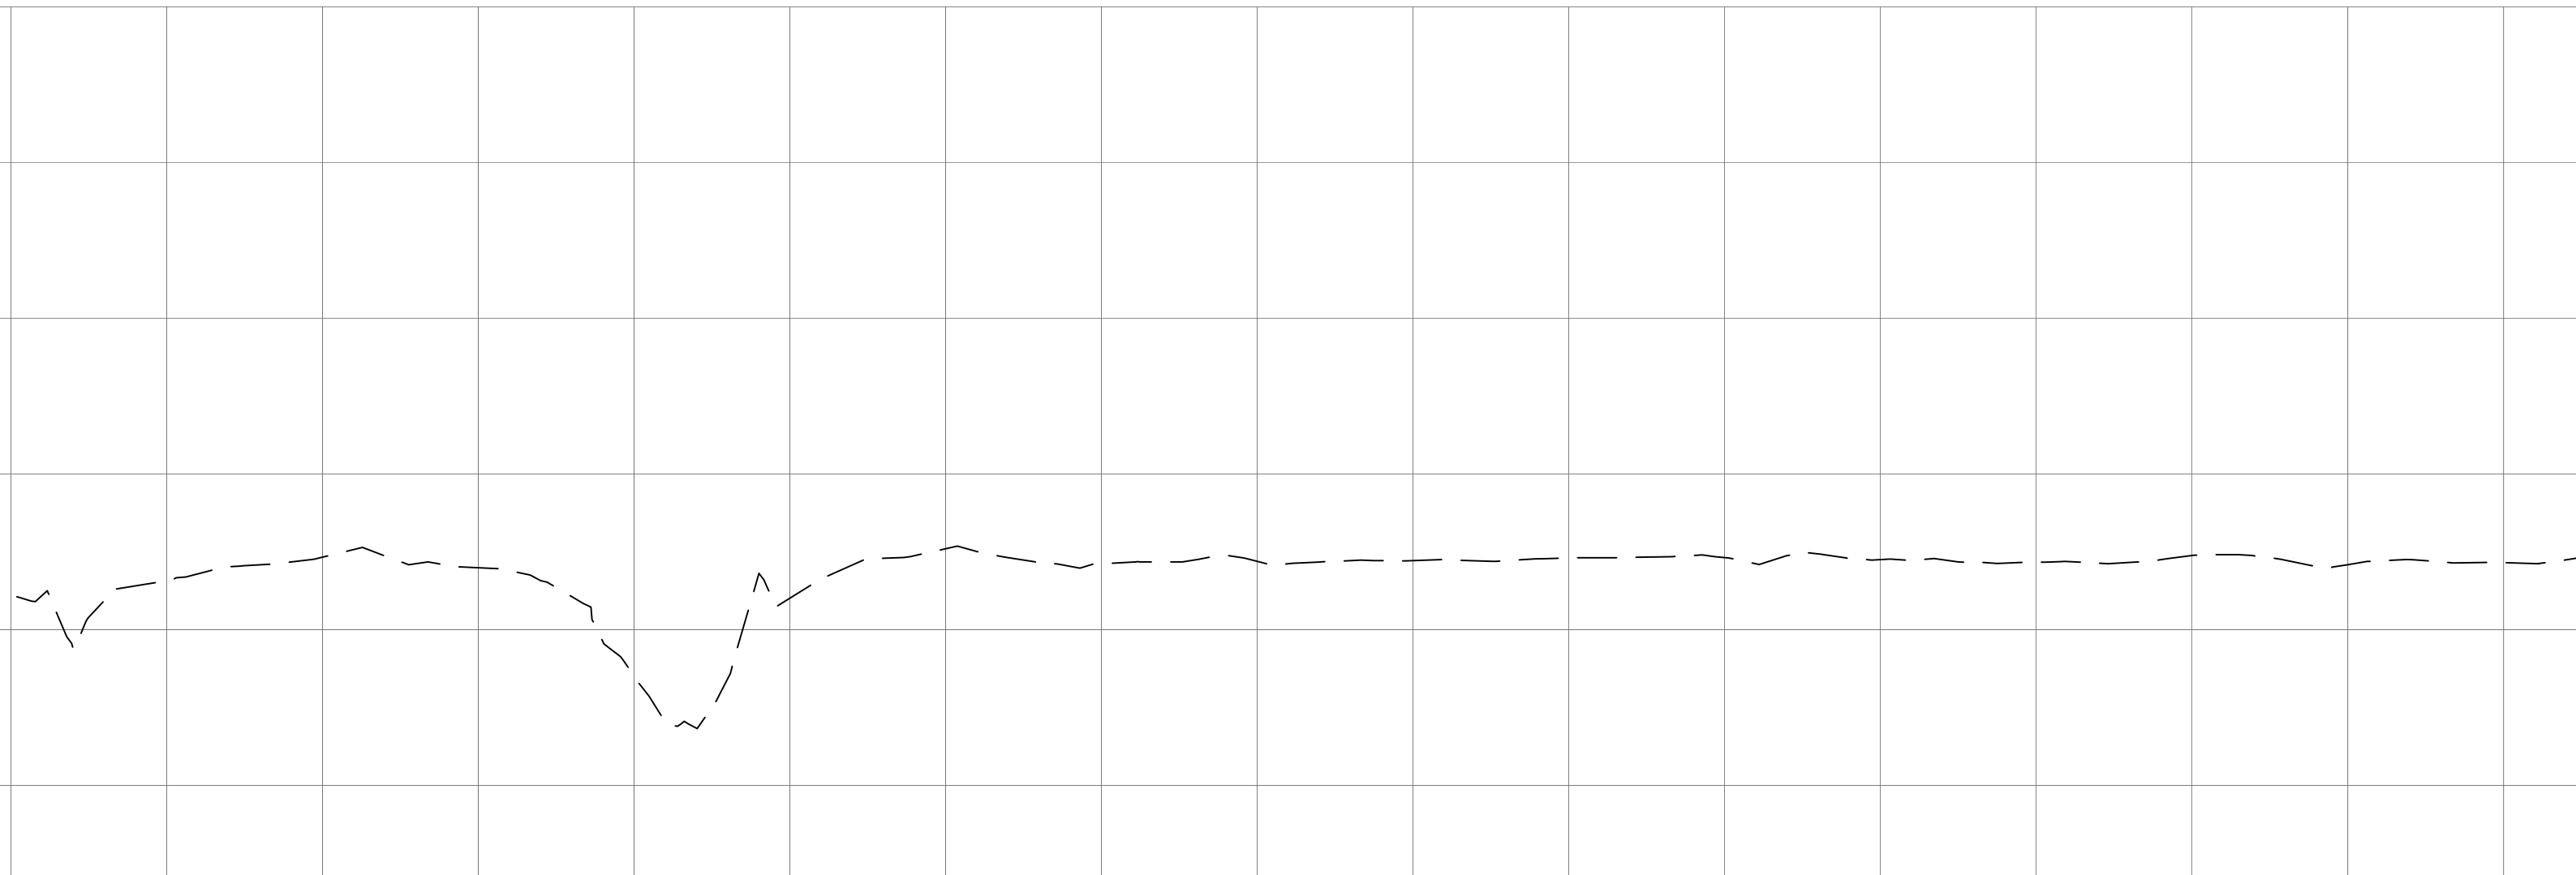


MAIN ULT

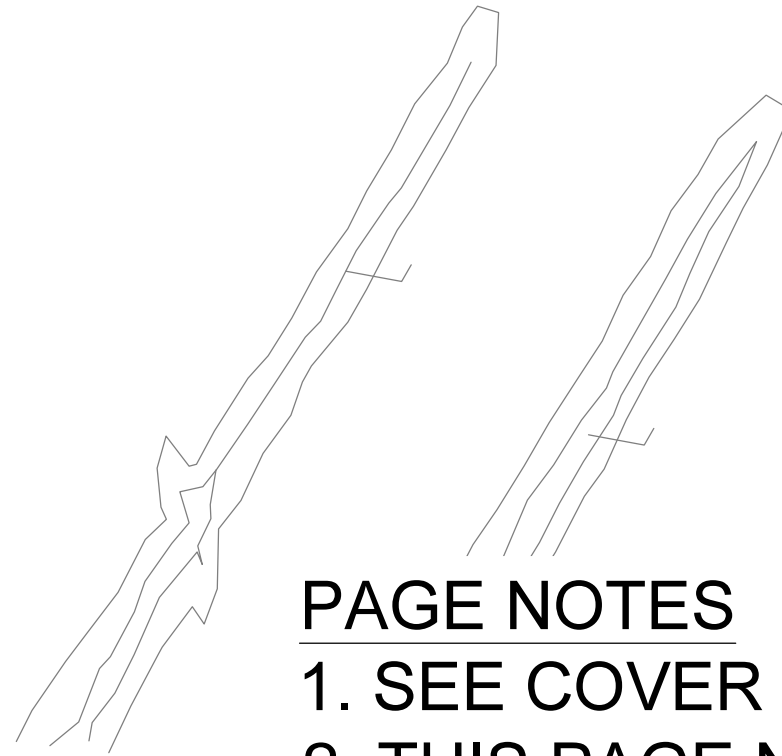

PAGE NOTES


1. SEE COVER SHEET FOR NOTES AND LEGEND
2. THIS PAGE NOT VALID WITHOUT COVER SHEET

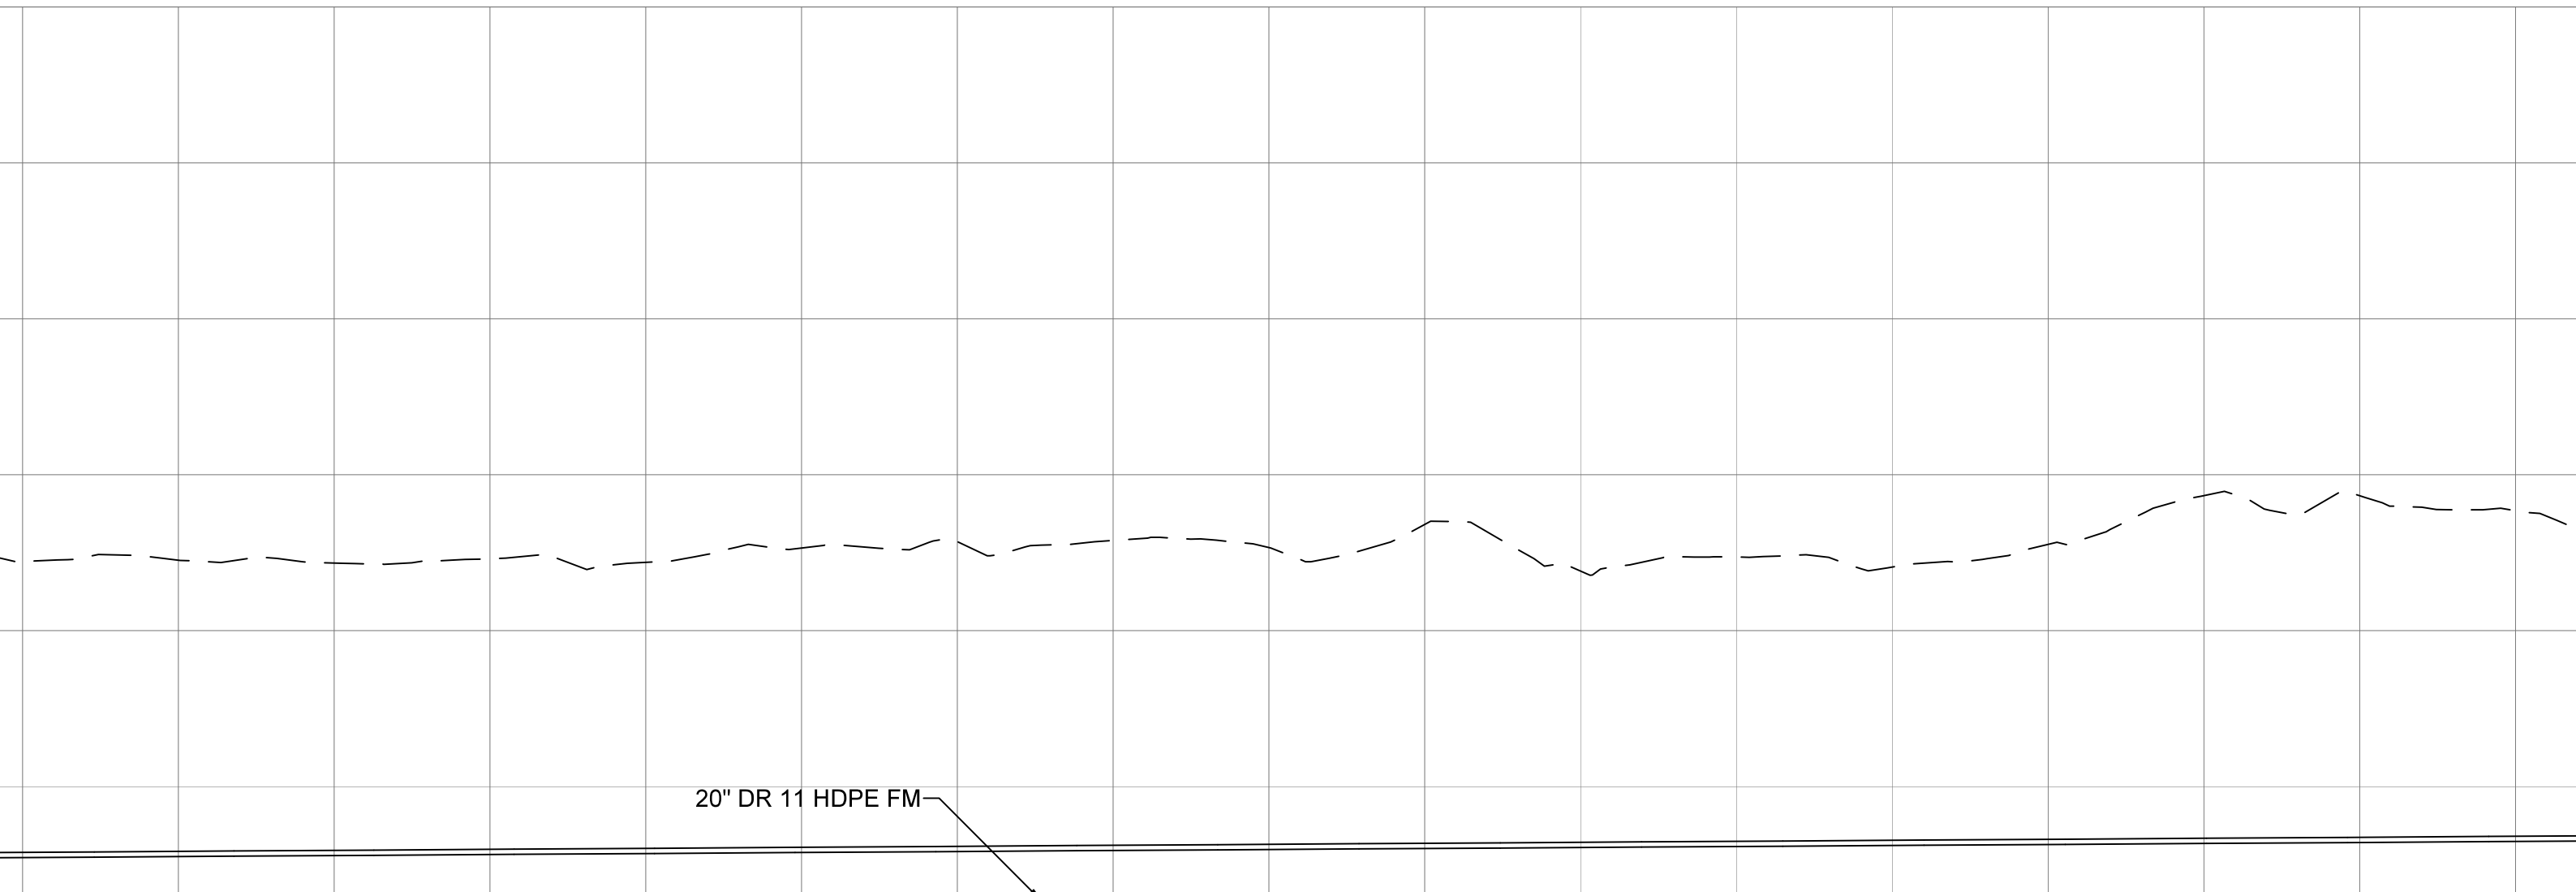


MAIN ULT

PAGE NOTES


1. SEE COVER SHEET FOR NOTES AND LEGEND
2. THIS PAGE NOT VALID WITHOUT COVER SHEET


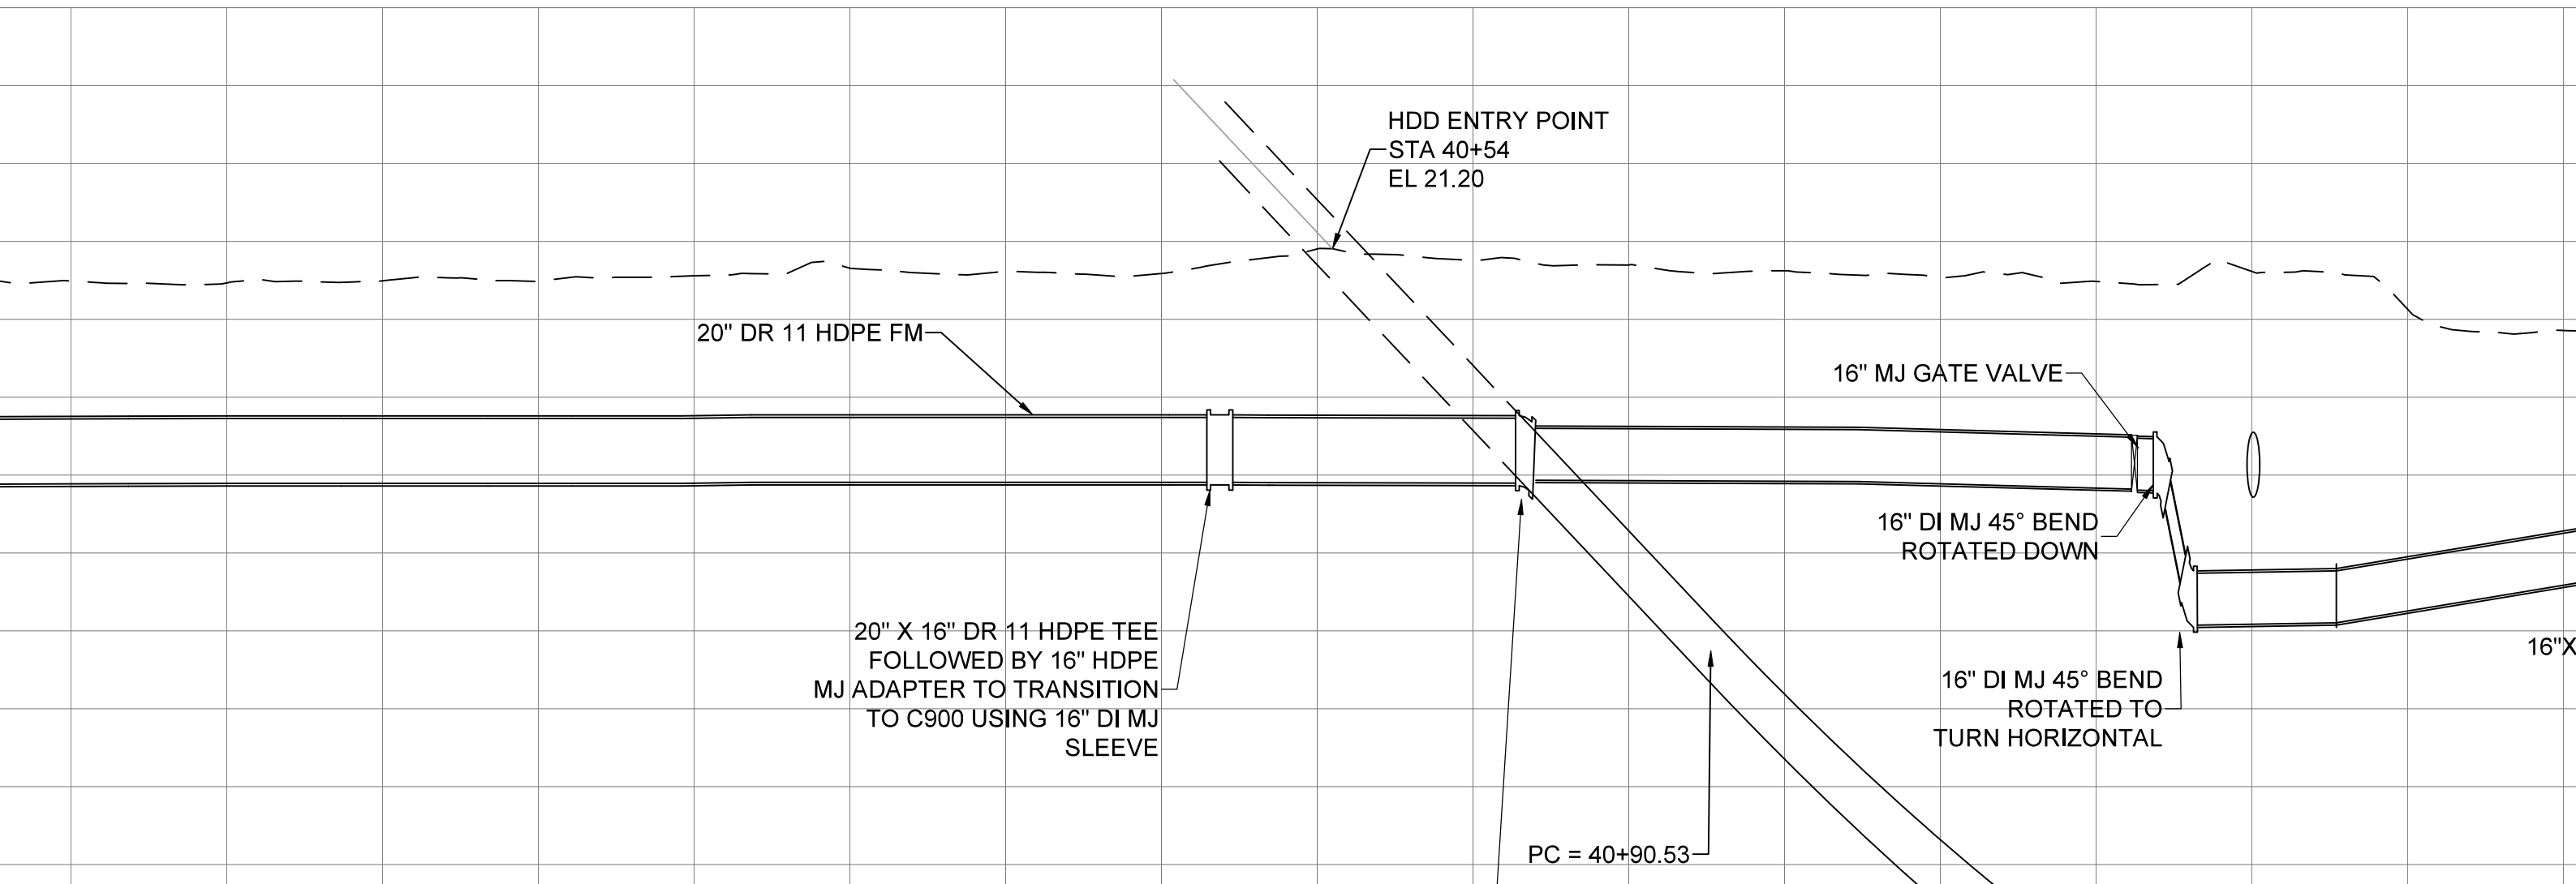



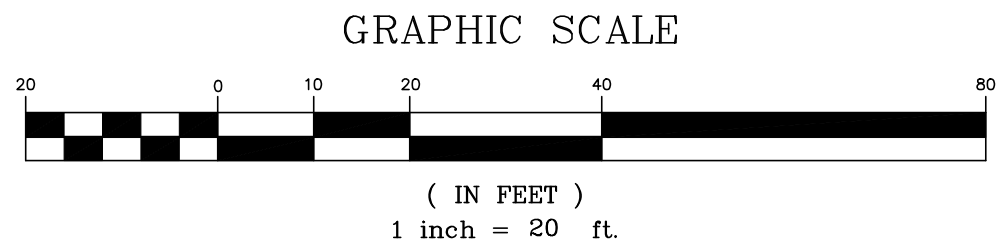



PAGE NOTES

1. SEE COVER SHEET FOR NOTES AND LEGEND
2. THIS PAGE NOT VALID WITHOUT COVER SHEET

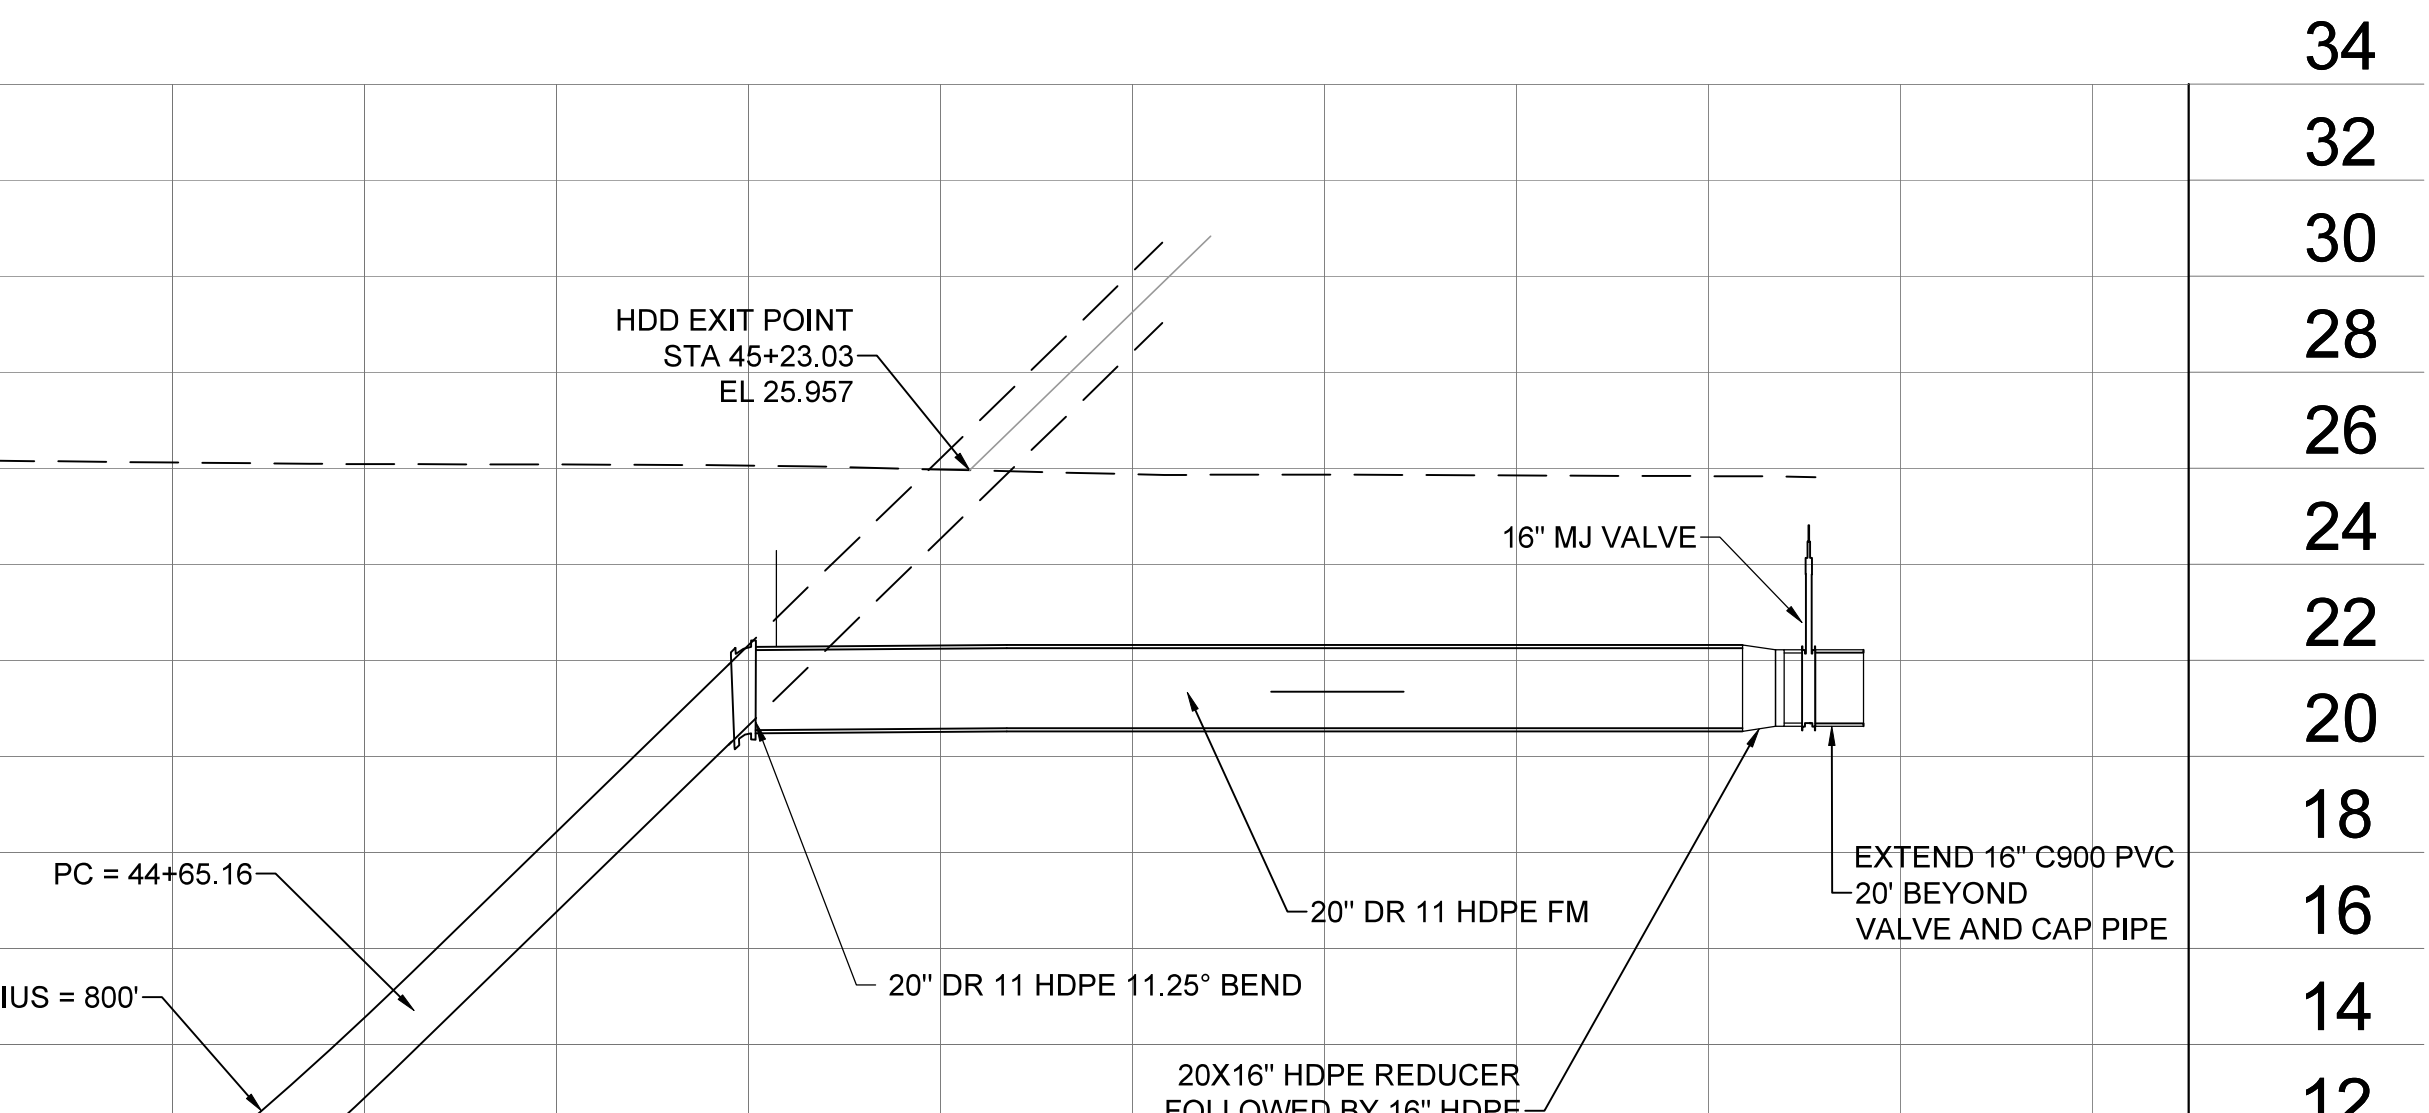

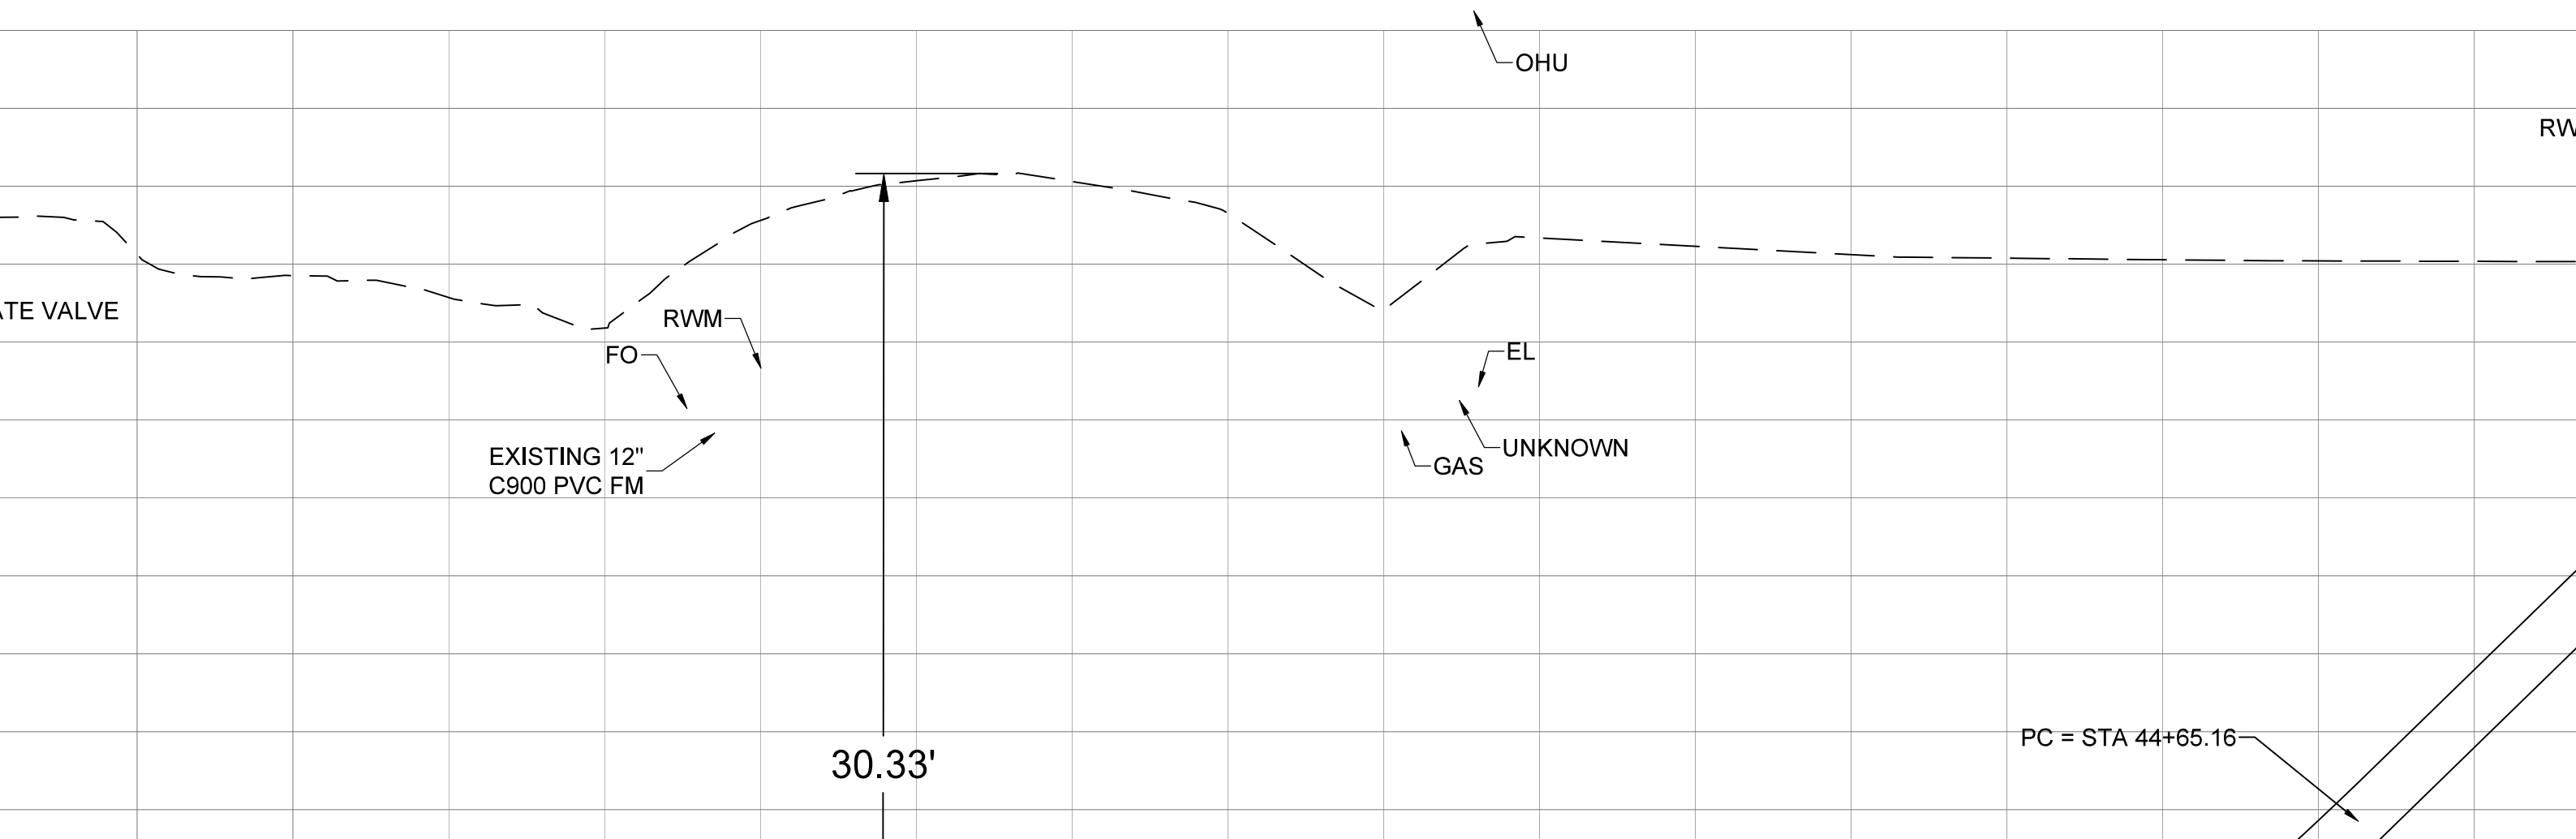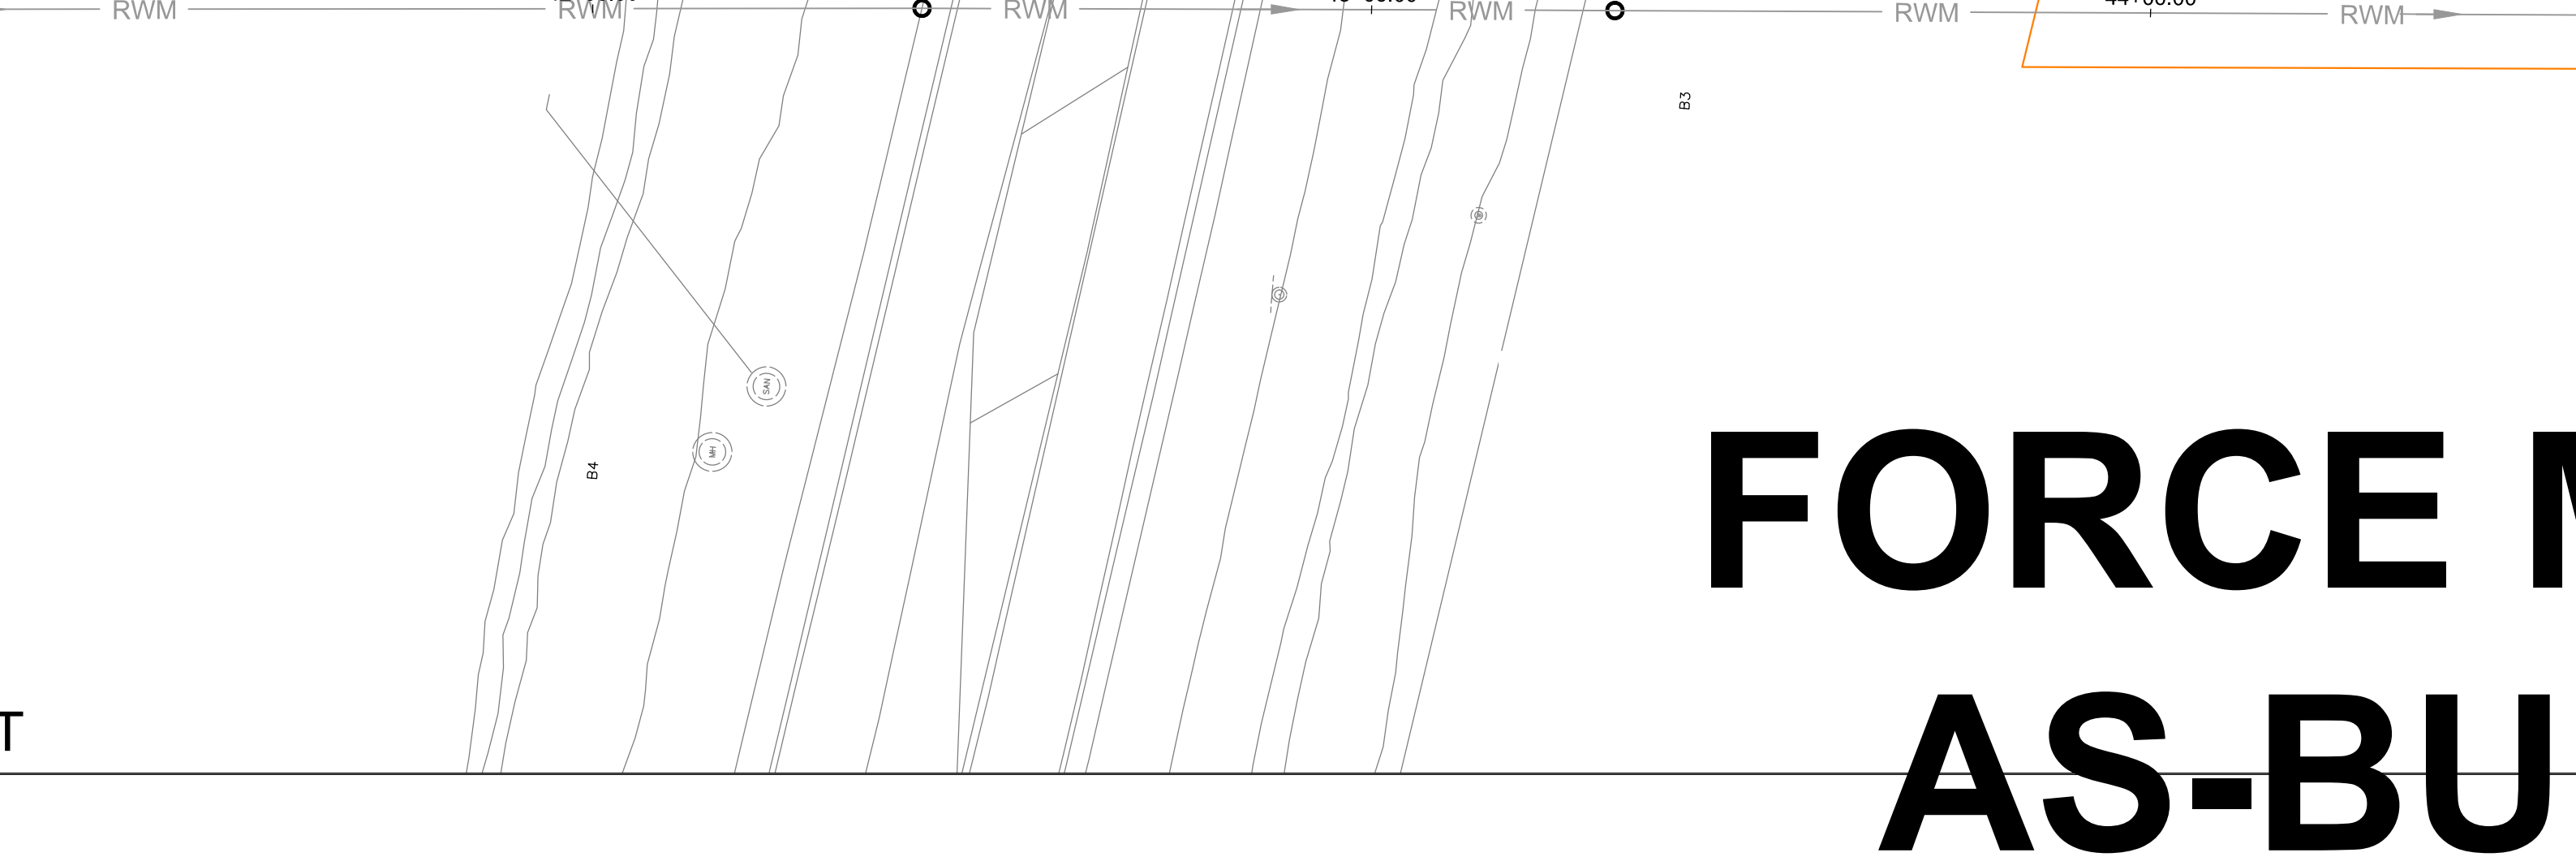


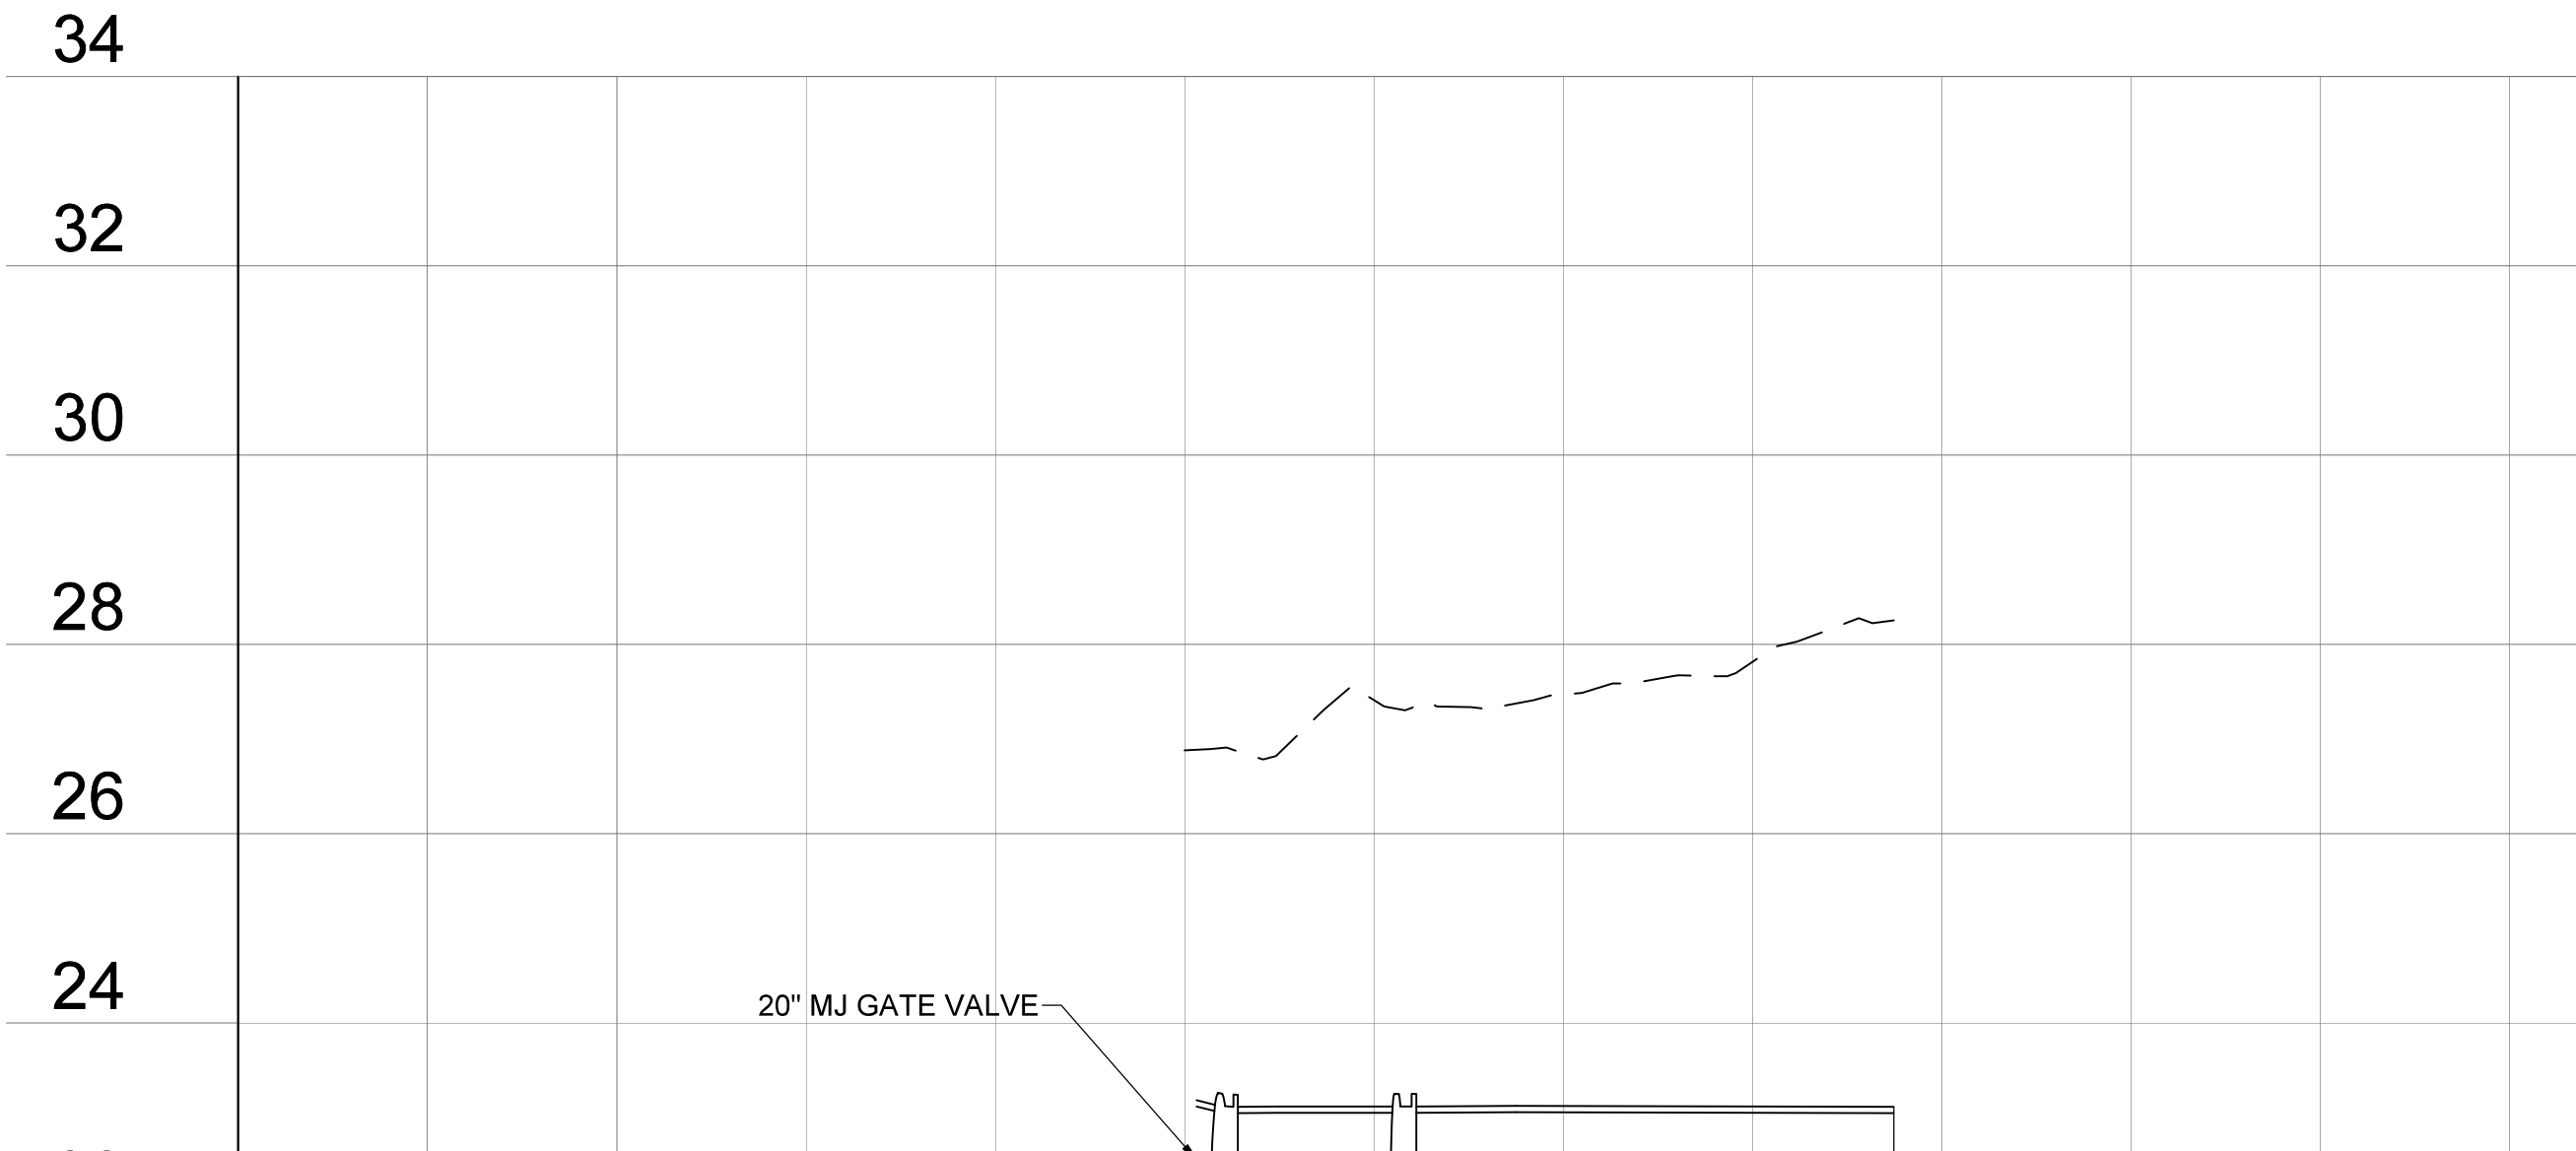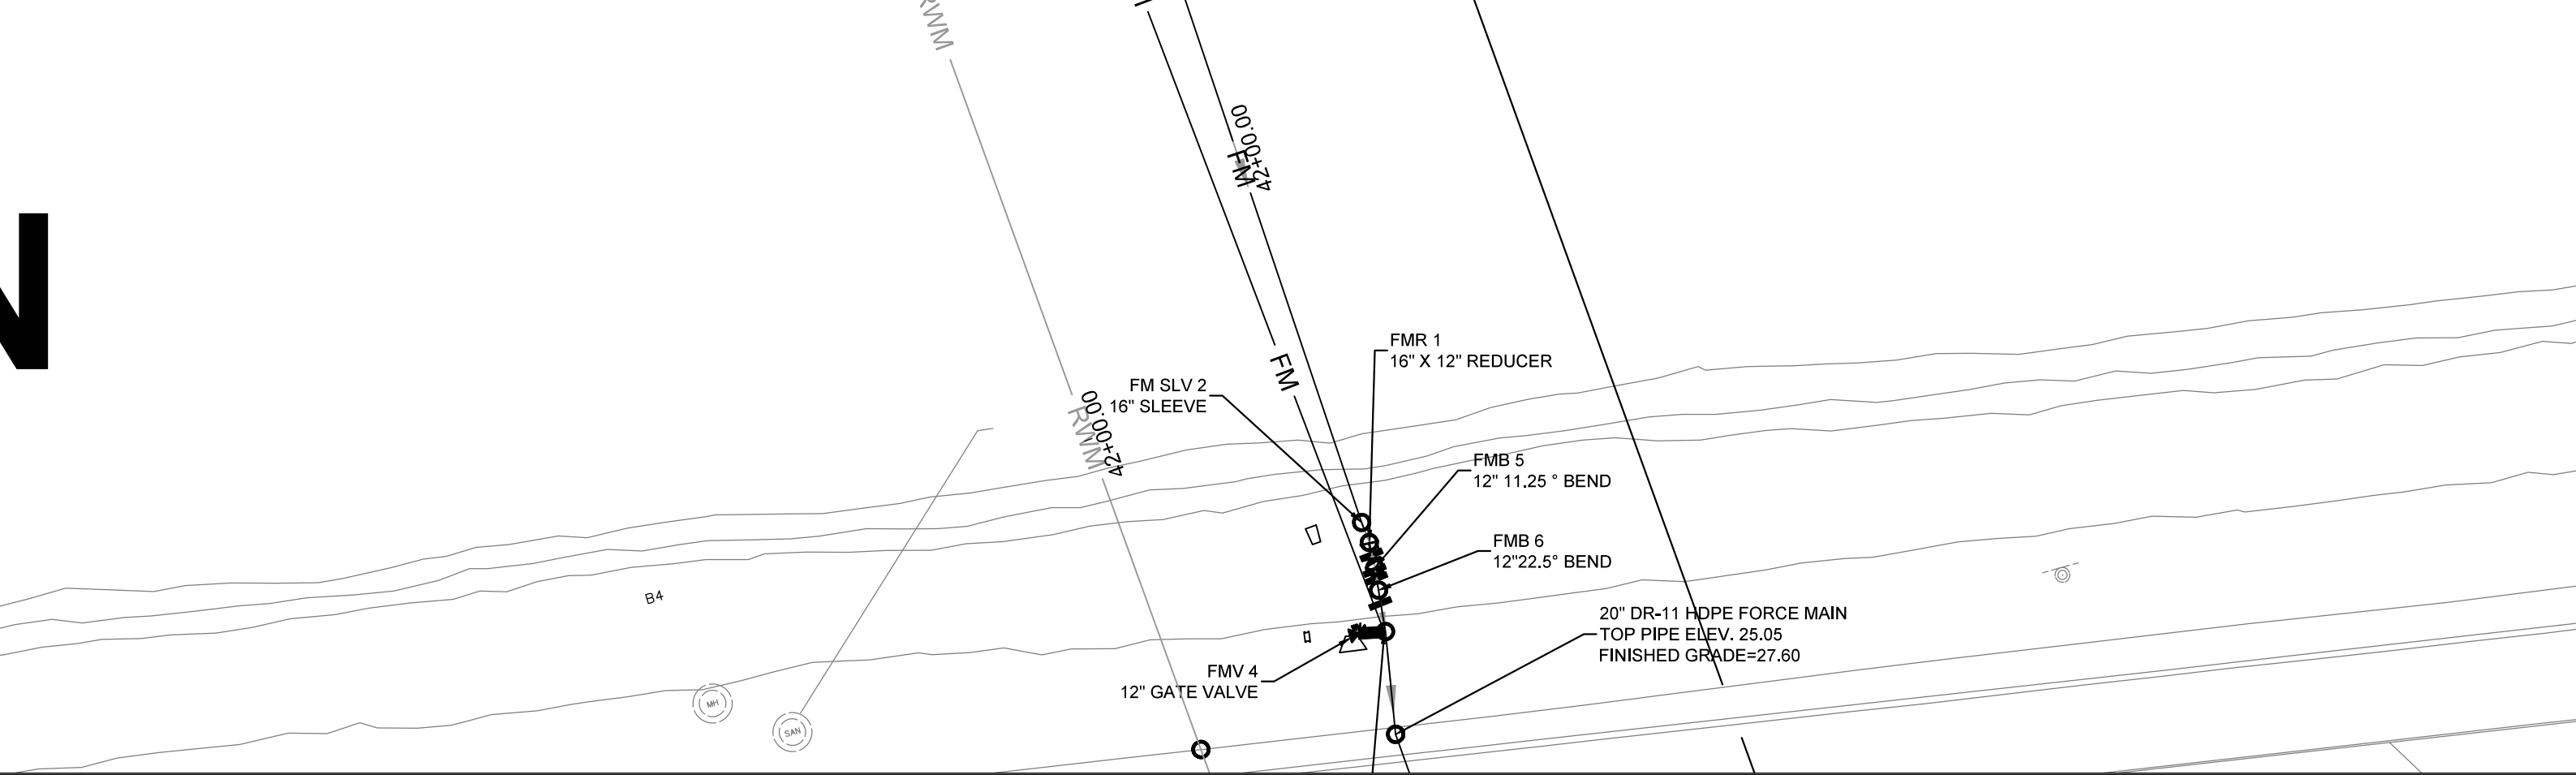


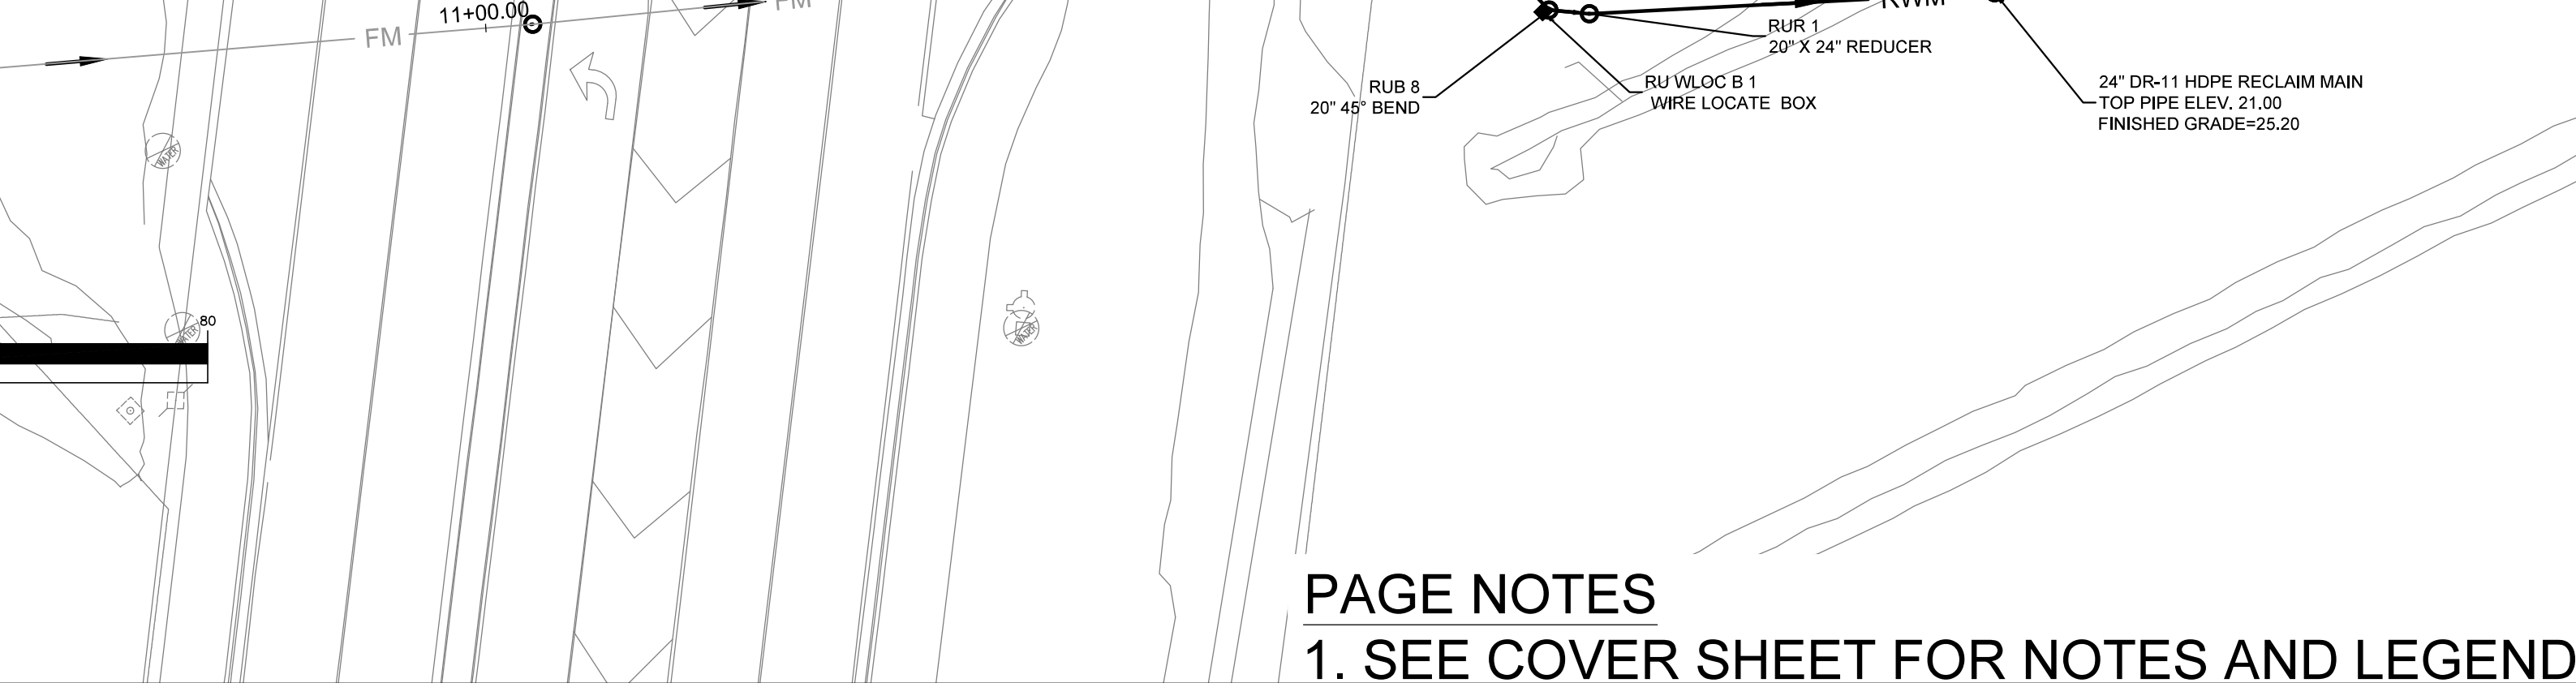

PAGE NOTES


- 1. SEE COVER SHEET FOR NOTES AND LEGEND
- 2. THIS PAGE NOT VALID WITHOUT COVER SHEET

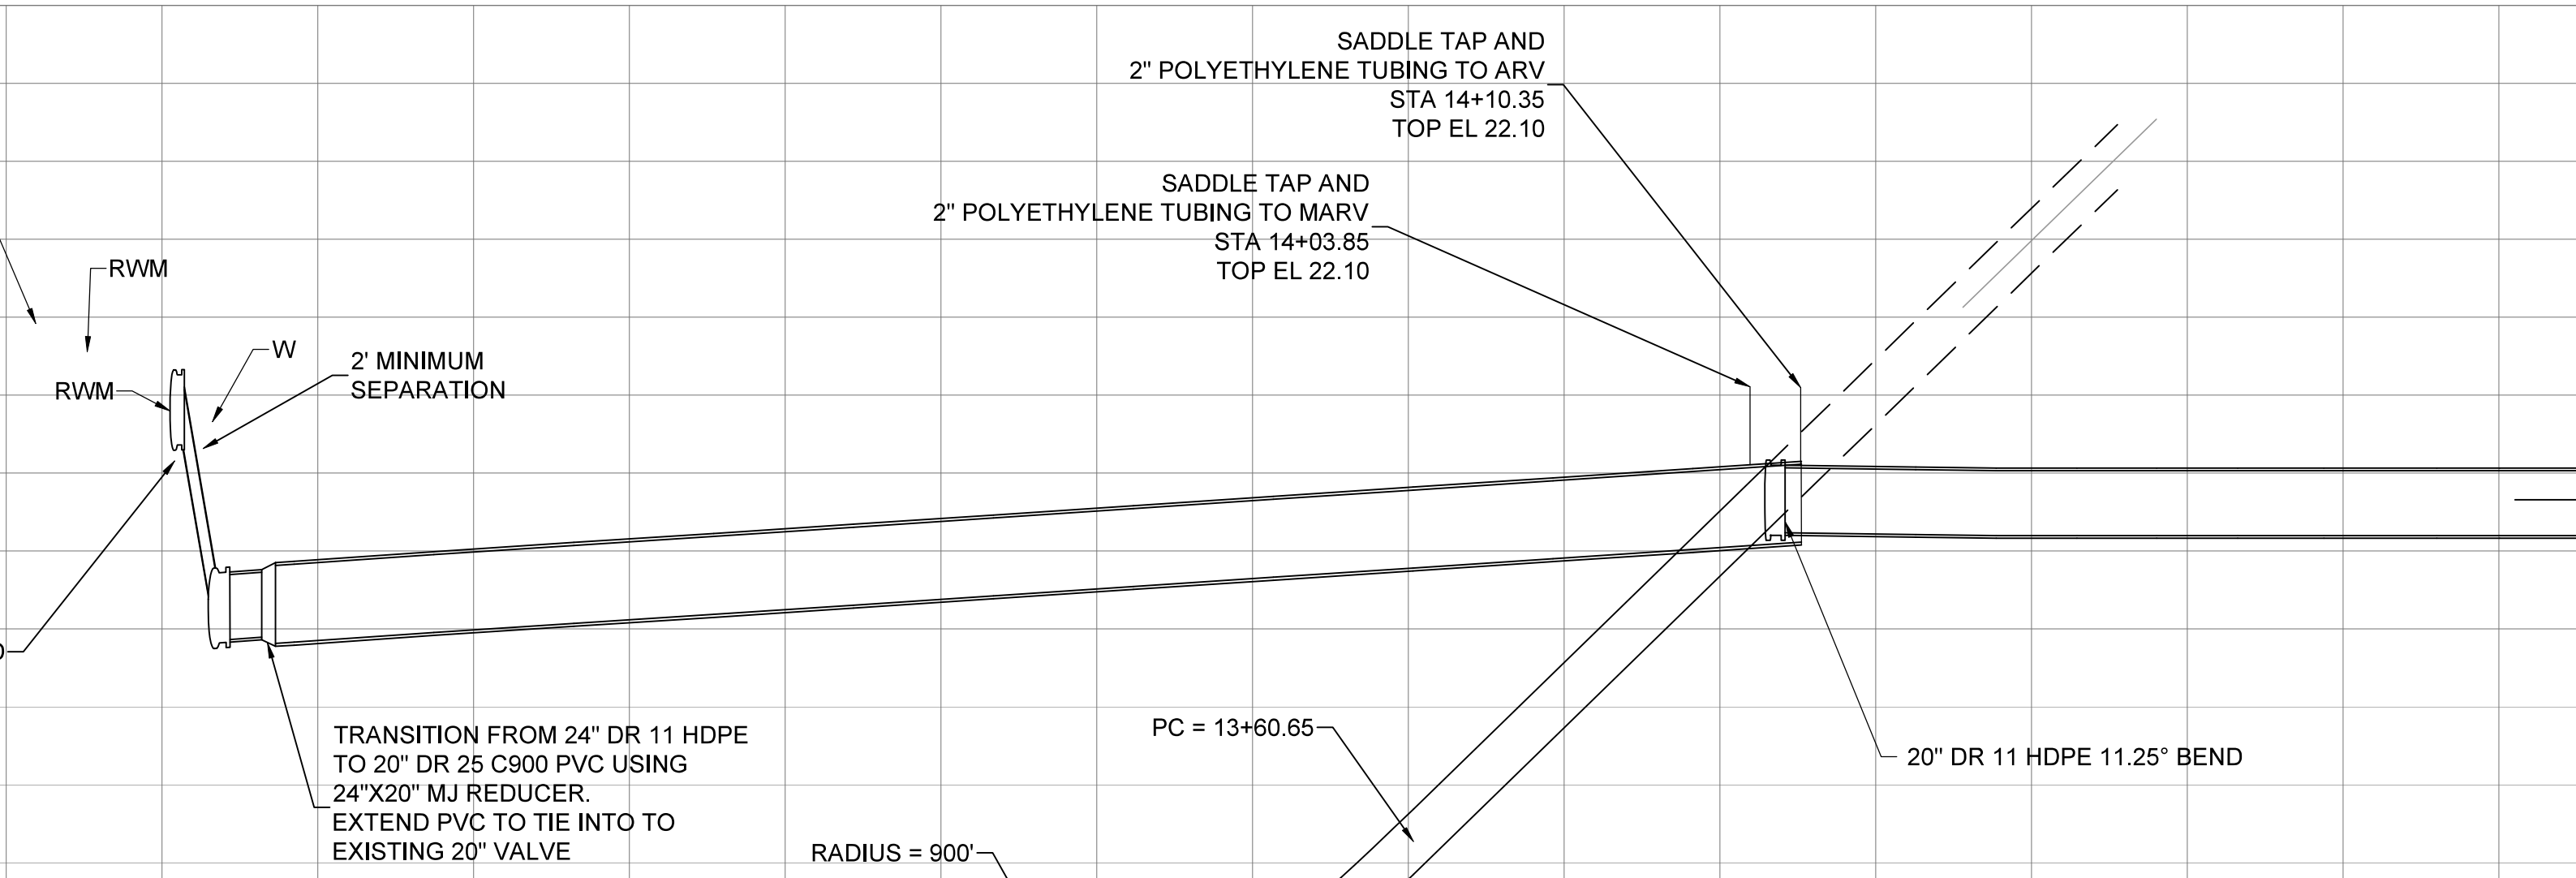


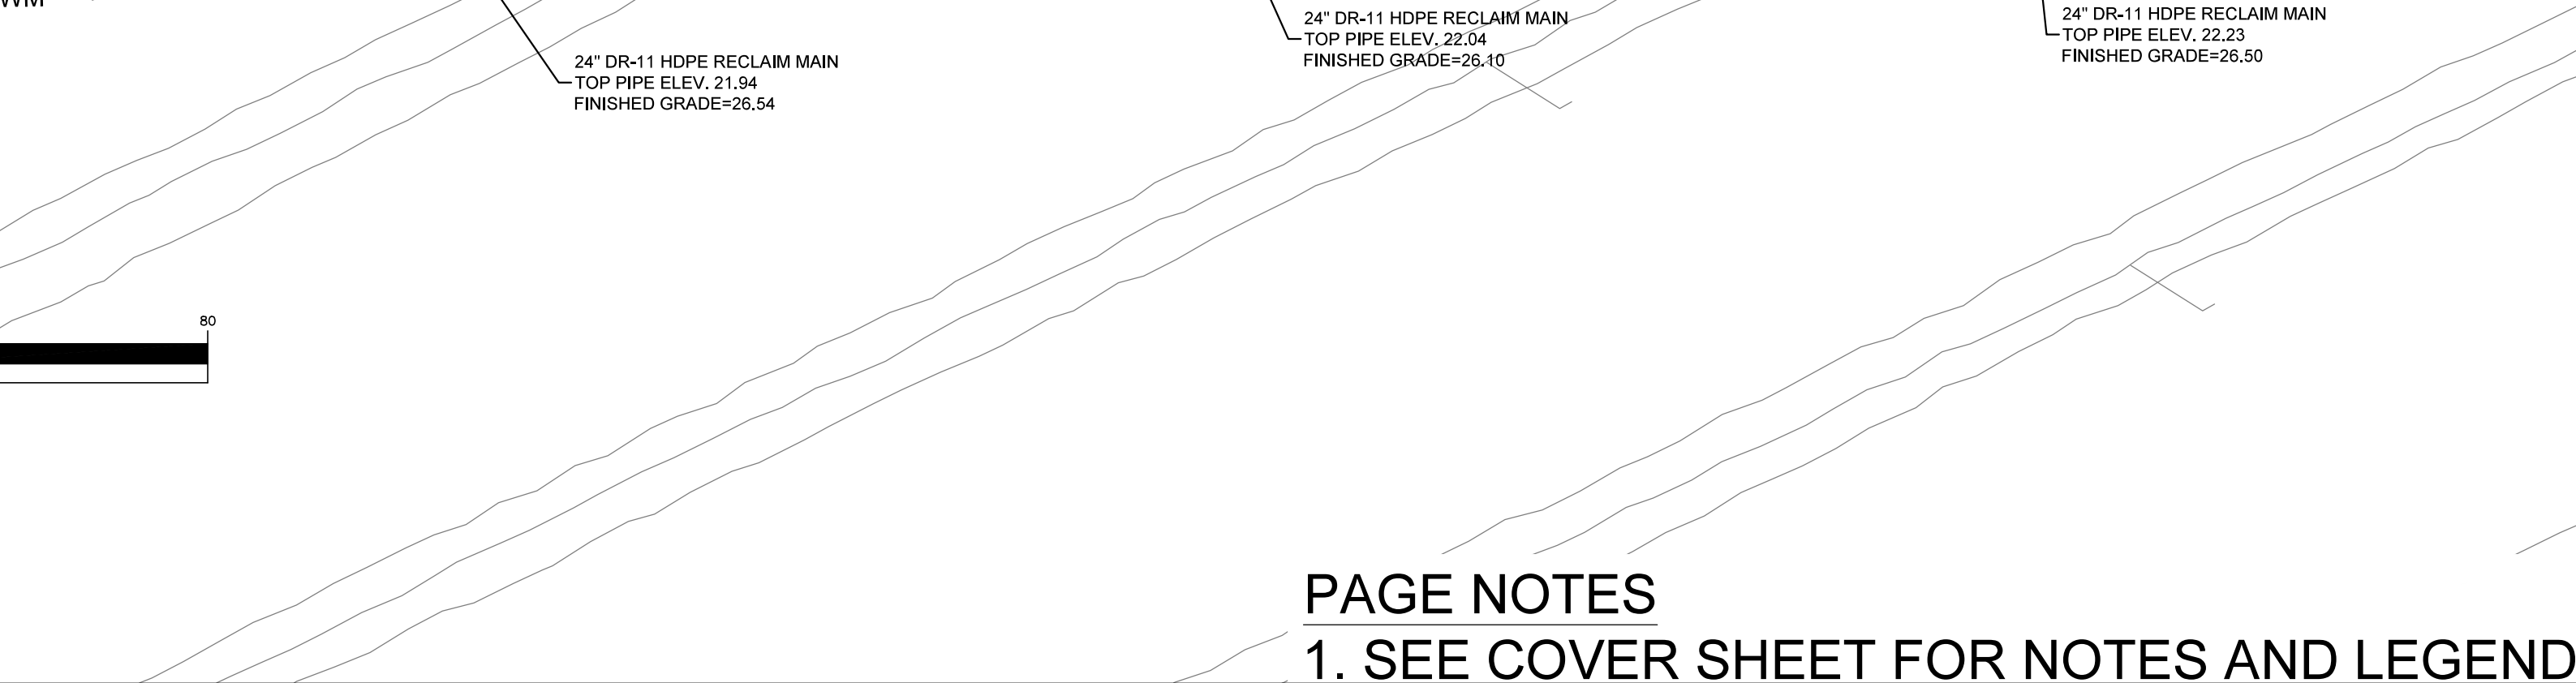

PAGE NOTES


1. SEE COVER SHEET FOR NOTES AND LEGEND
2. THIS PAGE NOT VALID WITHOUT COVER SHEET

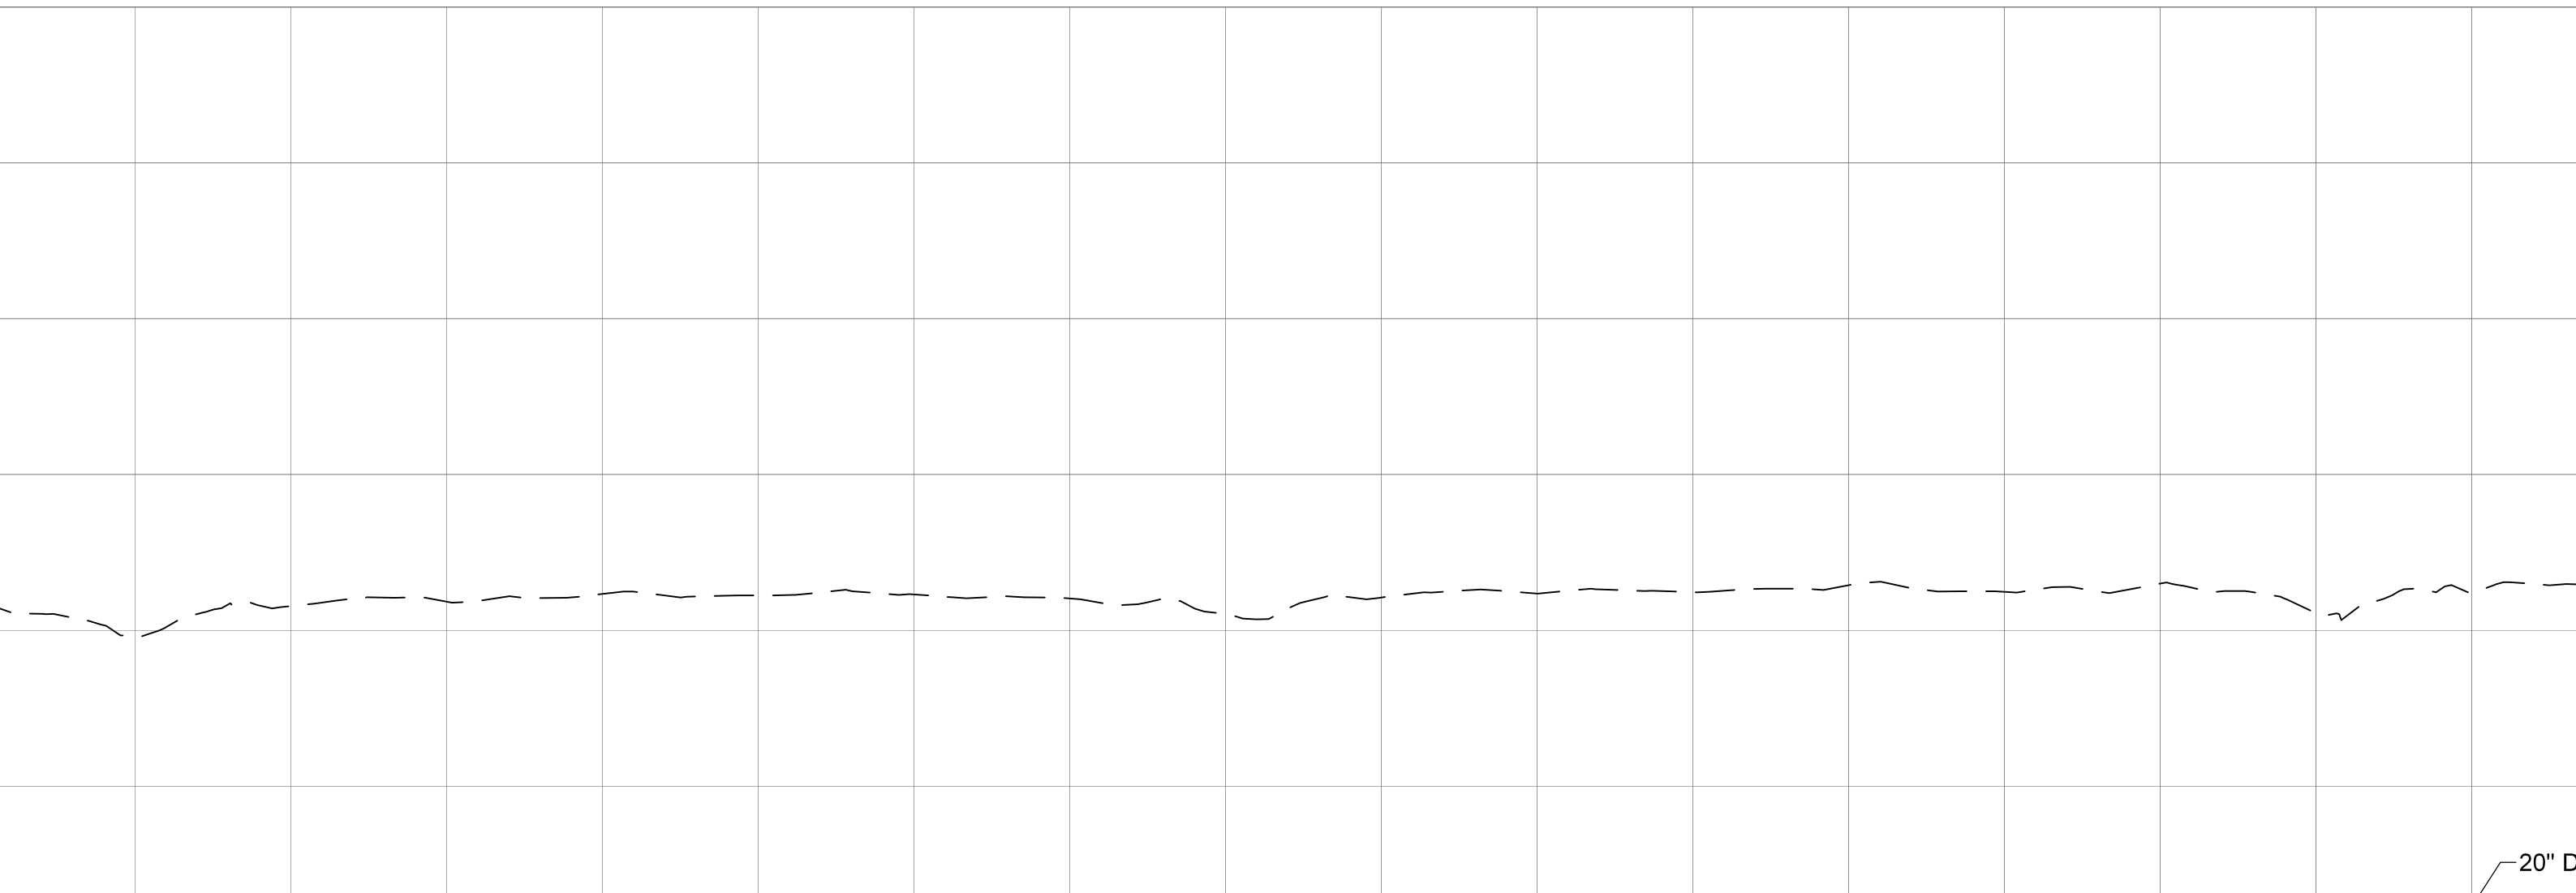

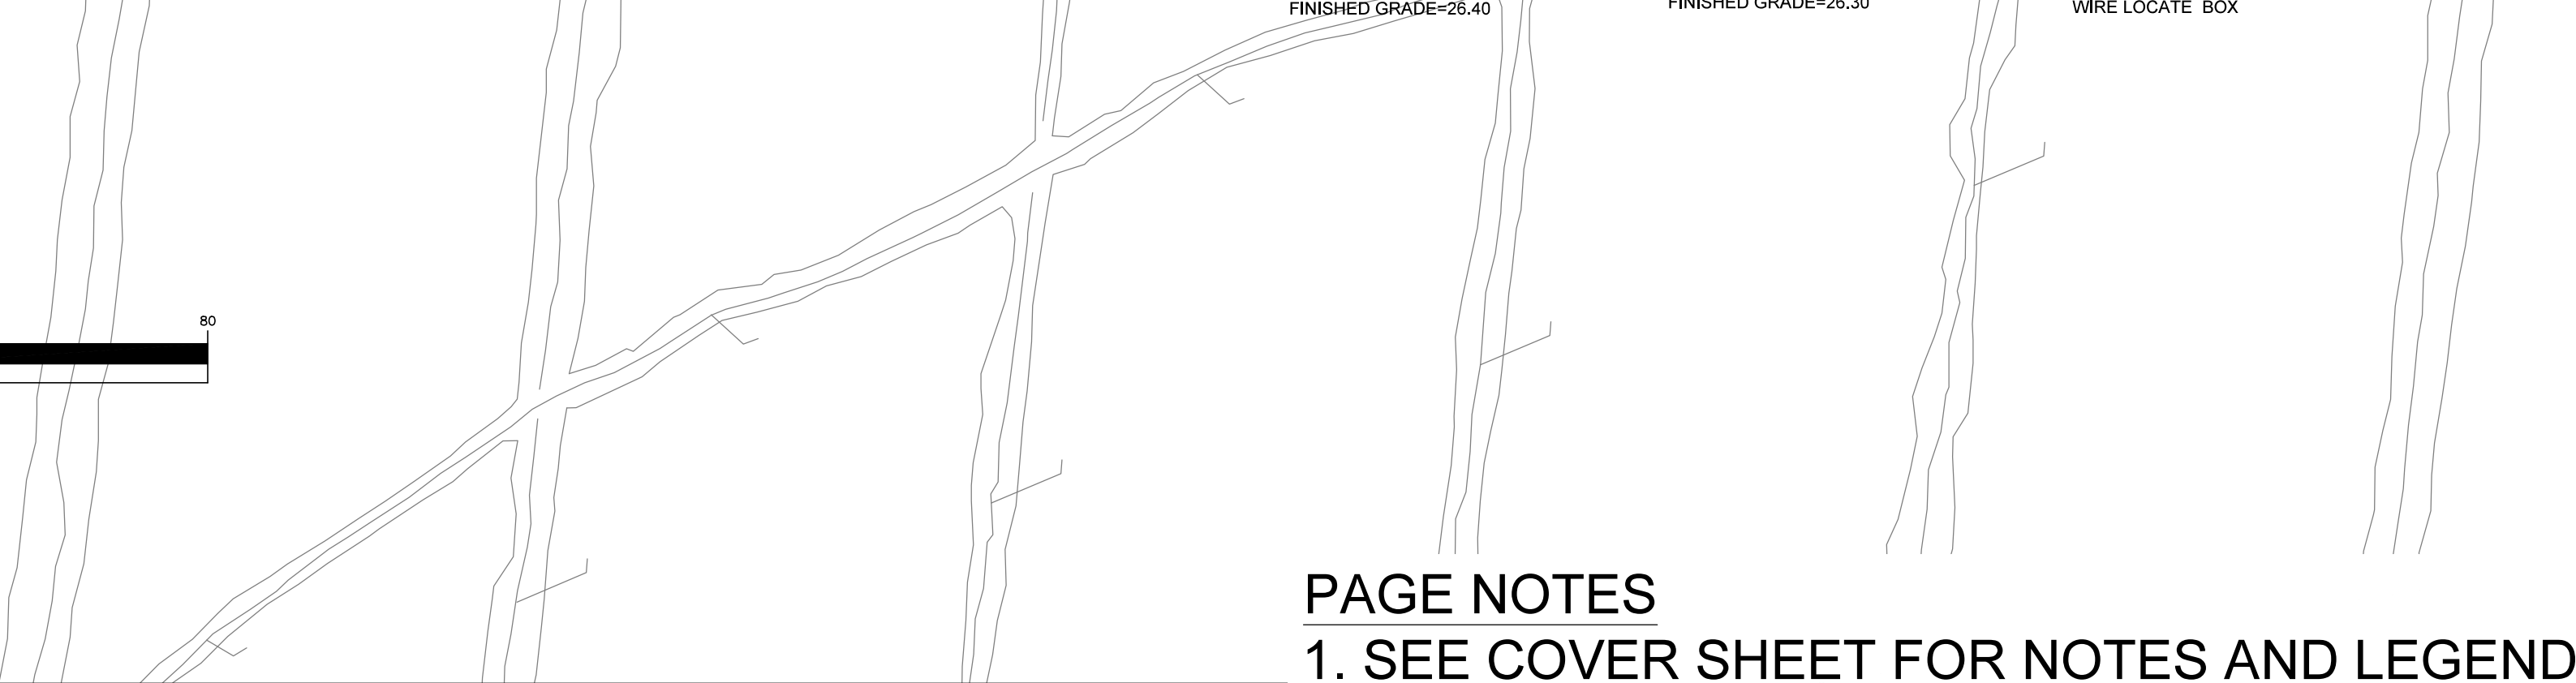


PAGE NOTES

1. SEE COVER SHEET FOR NOTES AND LEGEND
2. THIS PAGE NOT VALID WITHOUT COVER SHEET

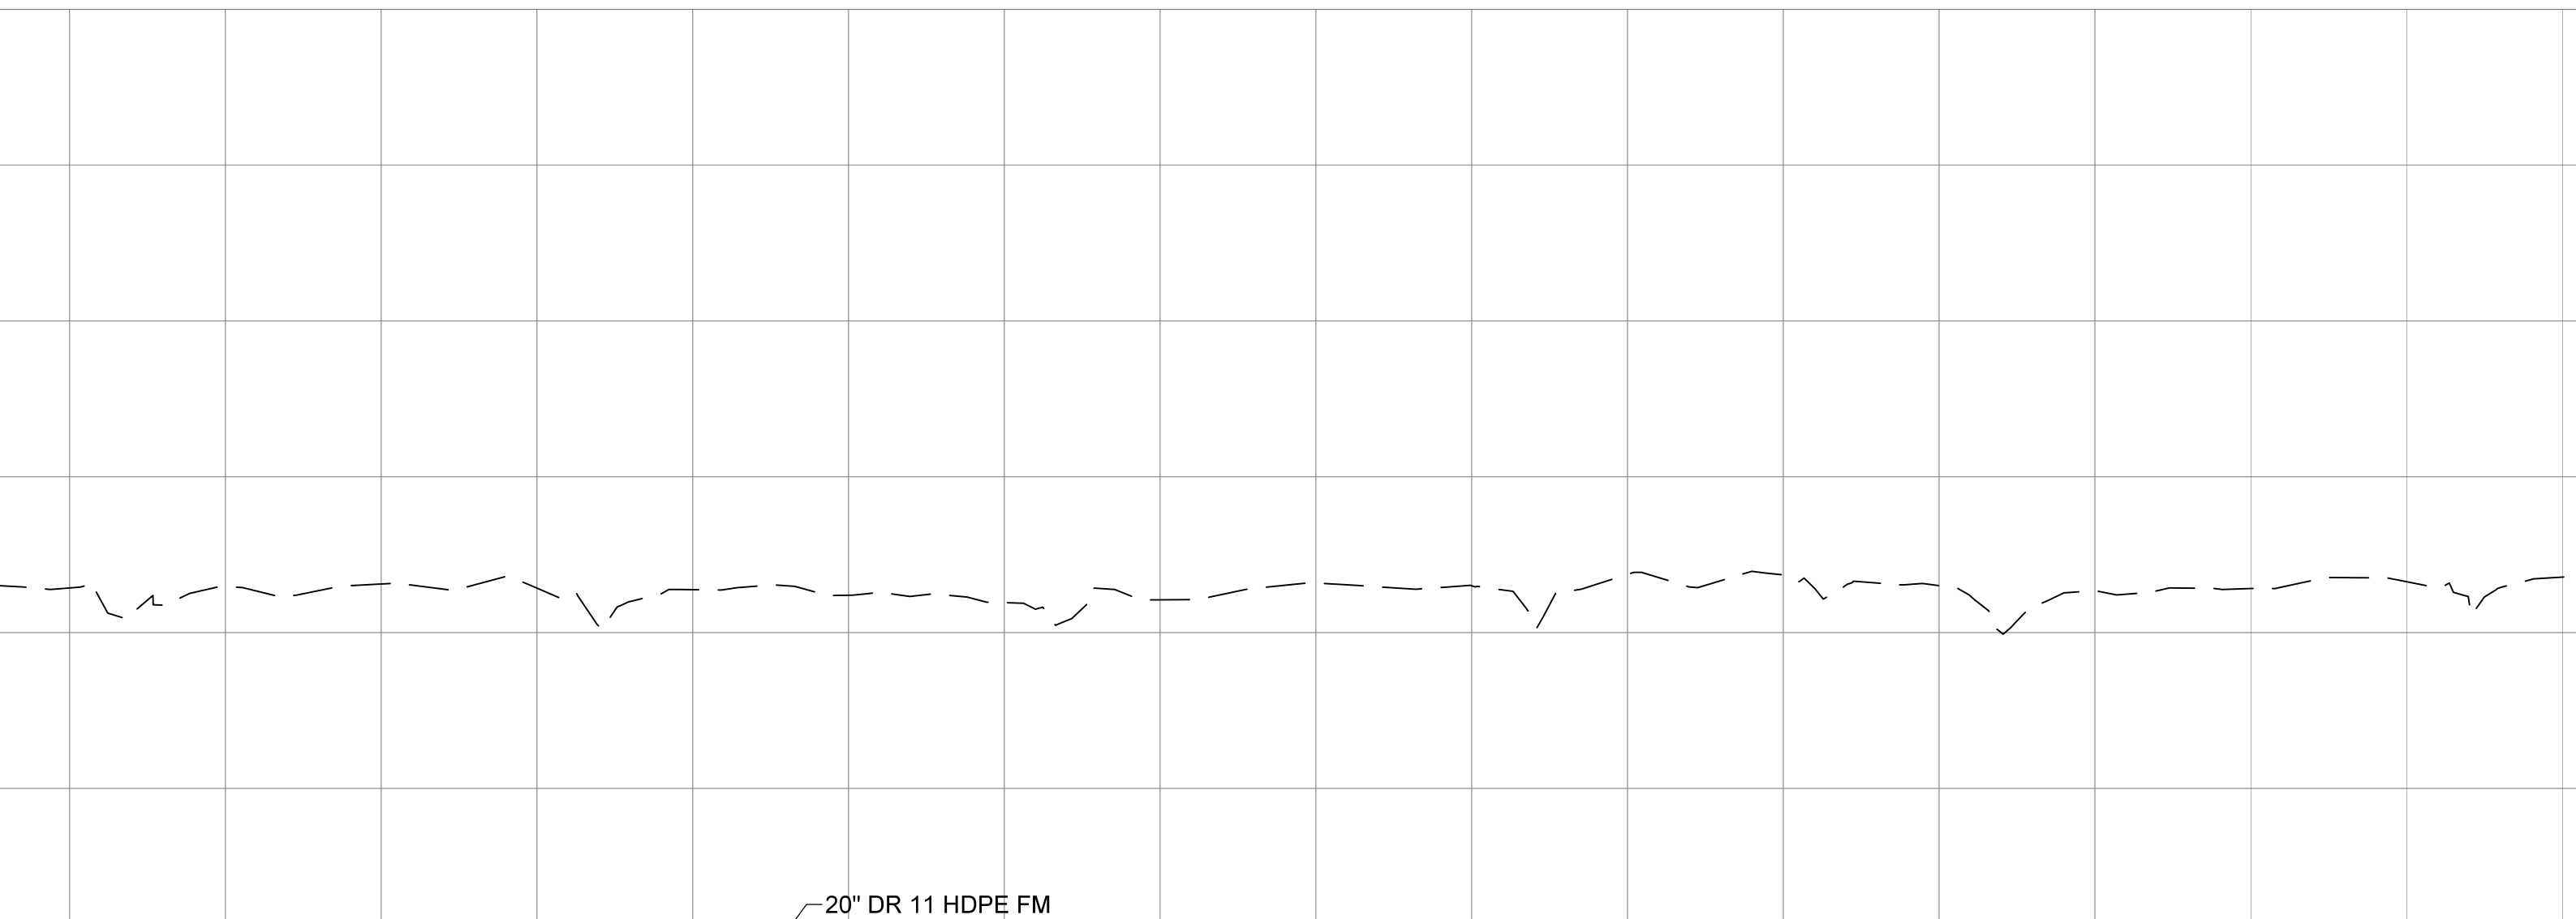


IM
LT

24" DR-11 HDPE RECLAIM
TOP PIPE ELEV. =
FINISHED GRADE =

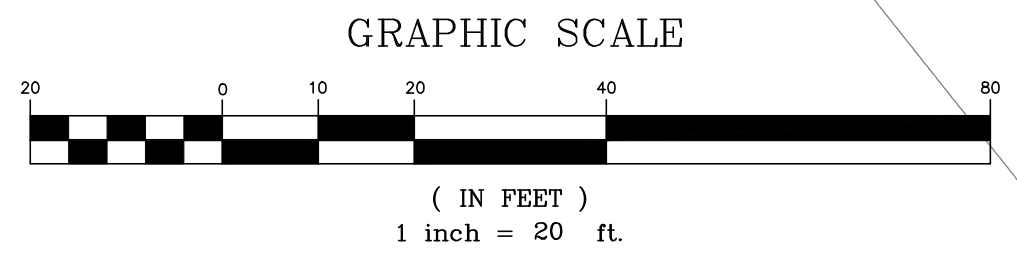


PAGE NOTES

1. SEE COVER SHEET FOR NOTES AND LEGEND
2. THIS PAGE NOT VALID WITHOUT COVER SHEET

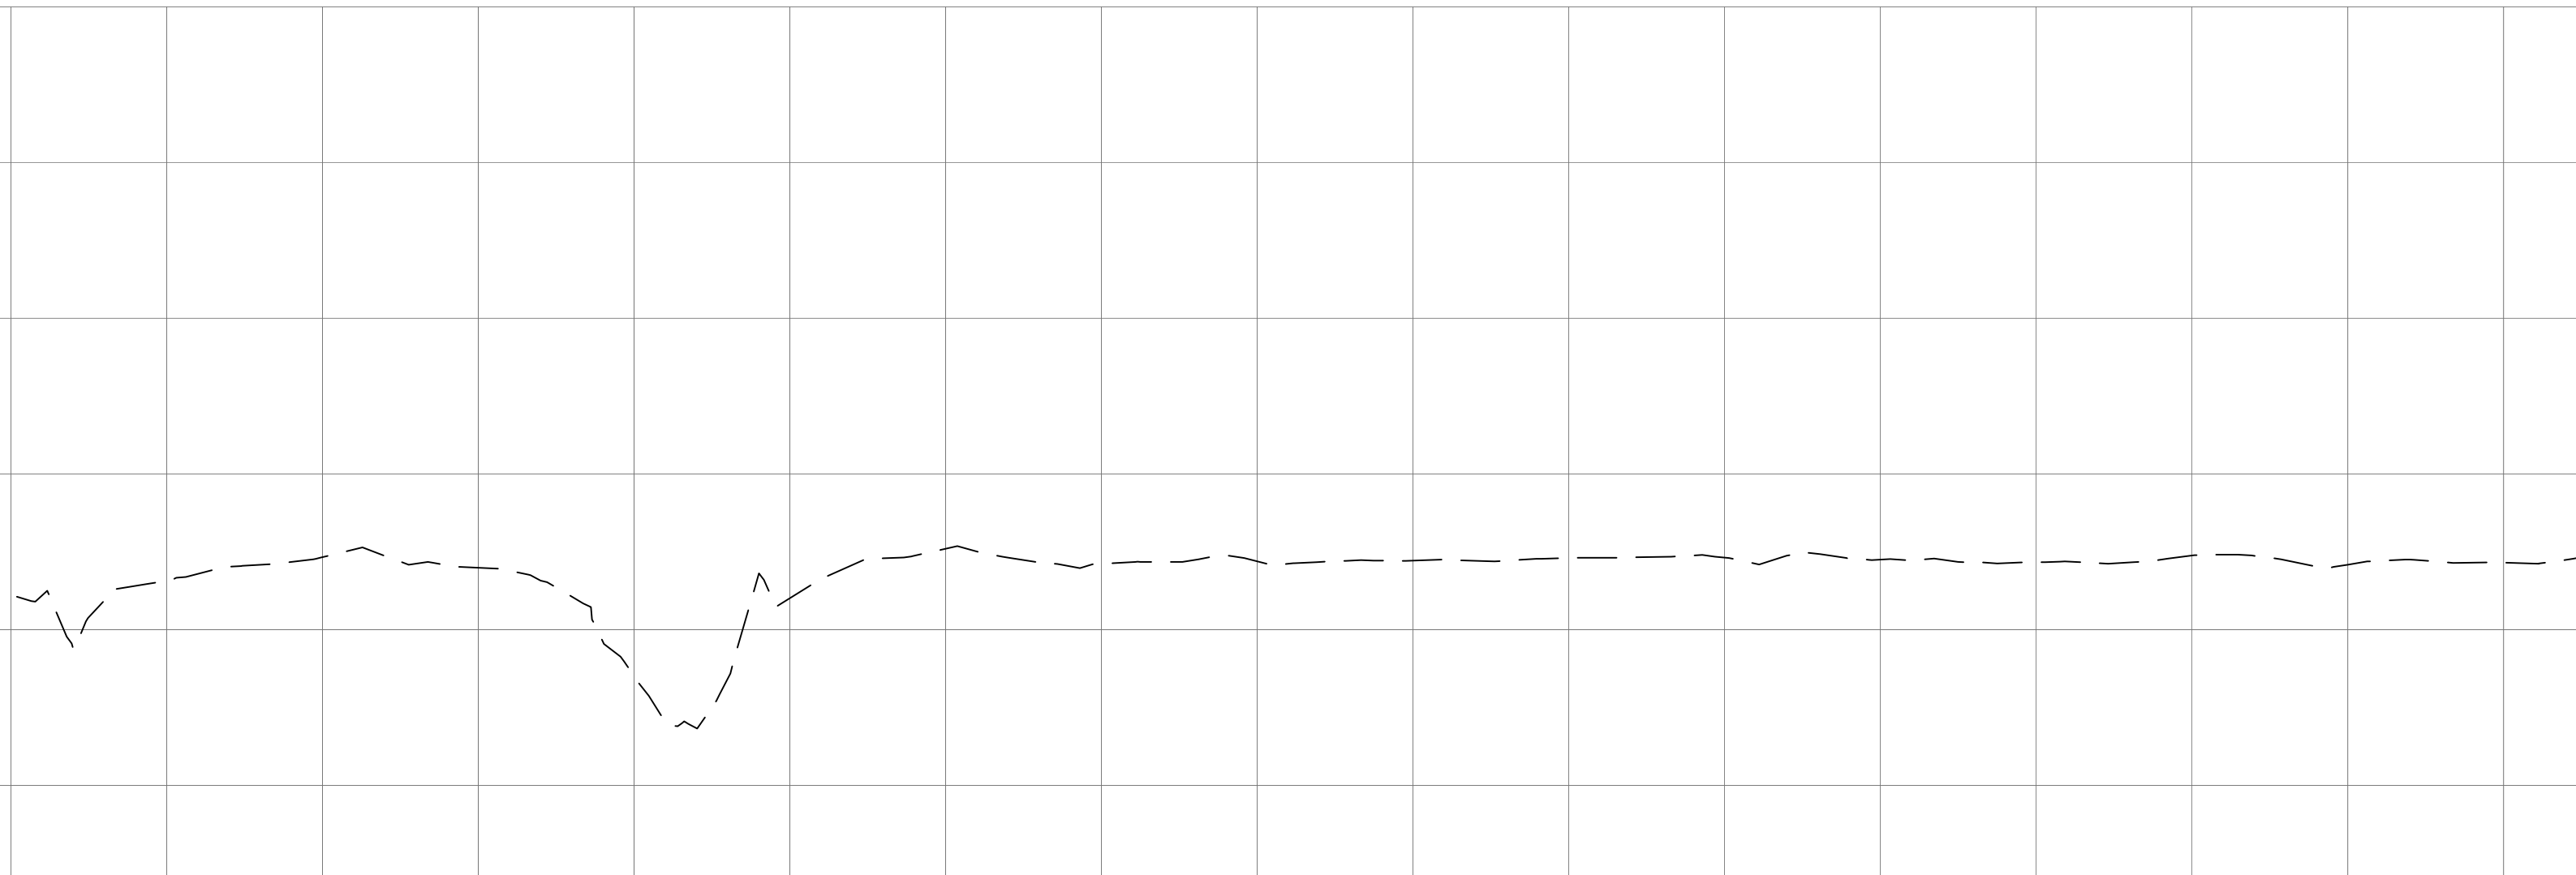


MIN ILT


TOP PIPE ELEV. 22.95
FINISHED GRADE=27.10

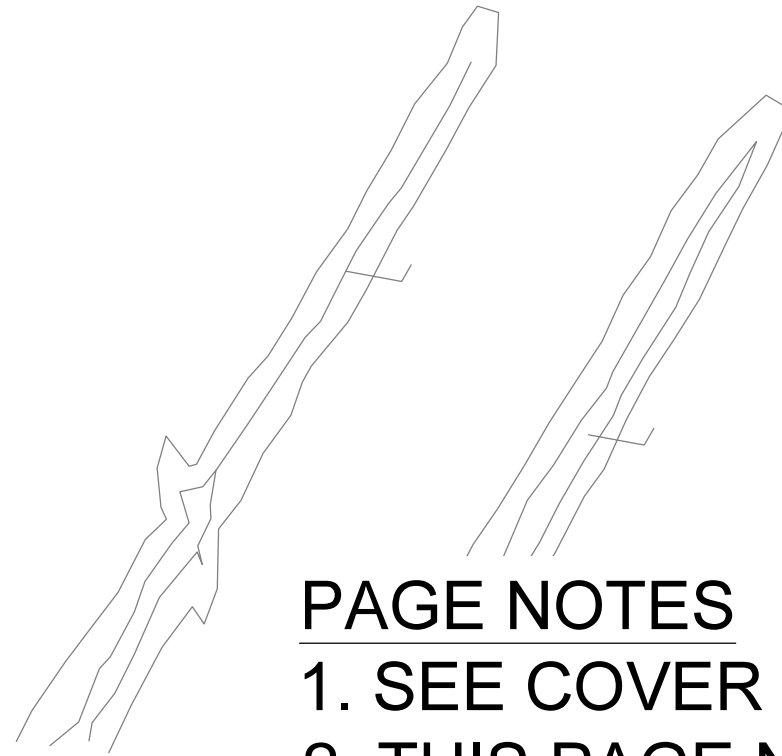

PAGE NOTES


1. SEE COVER SHEET FOR NOTES AND LEGEND
2. THIS PAGE NOT VALID WITHOUT COVER SHEET

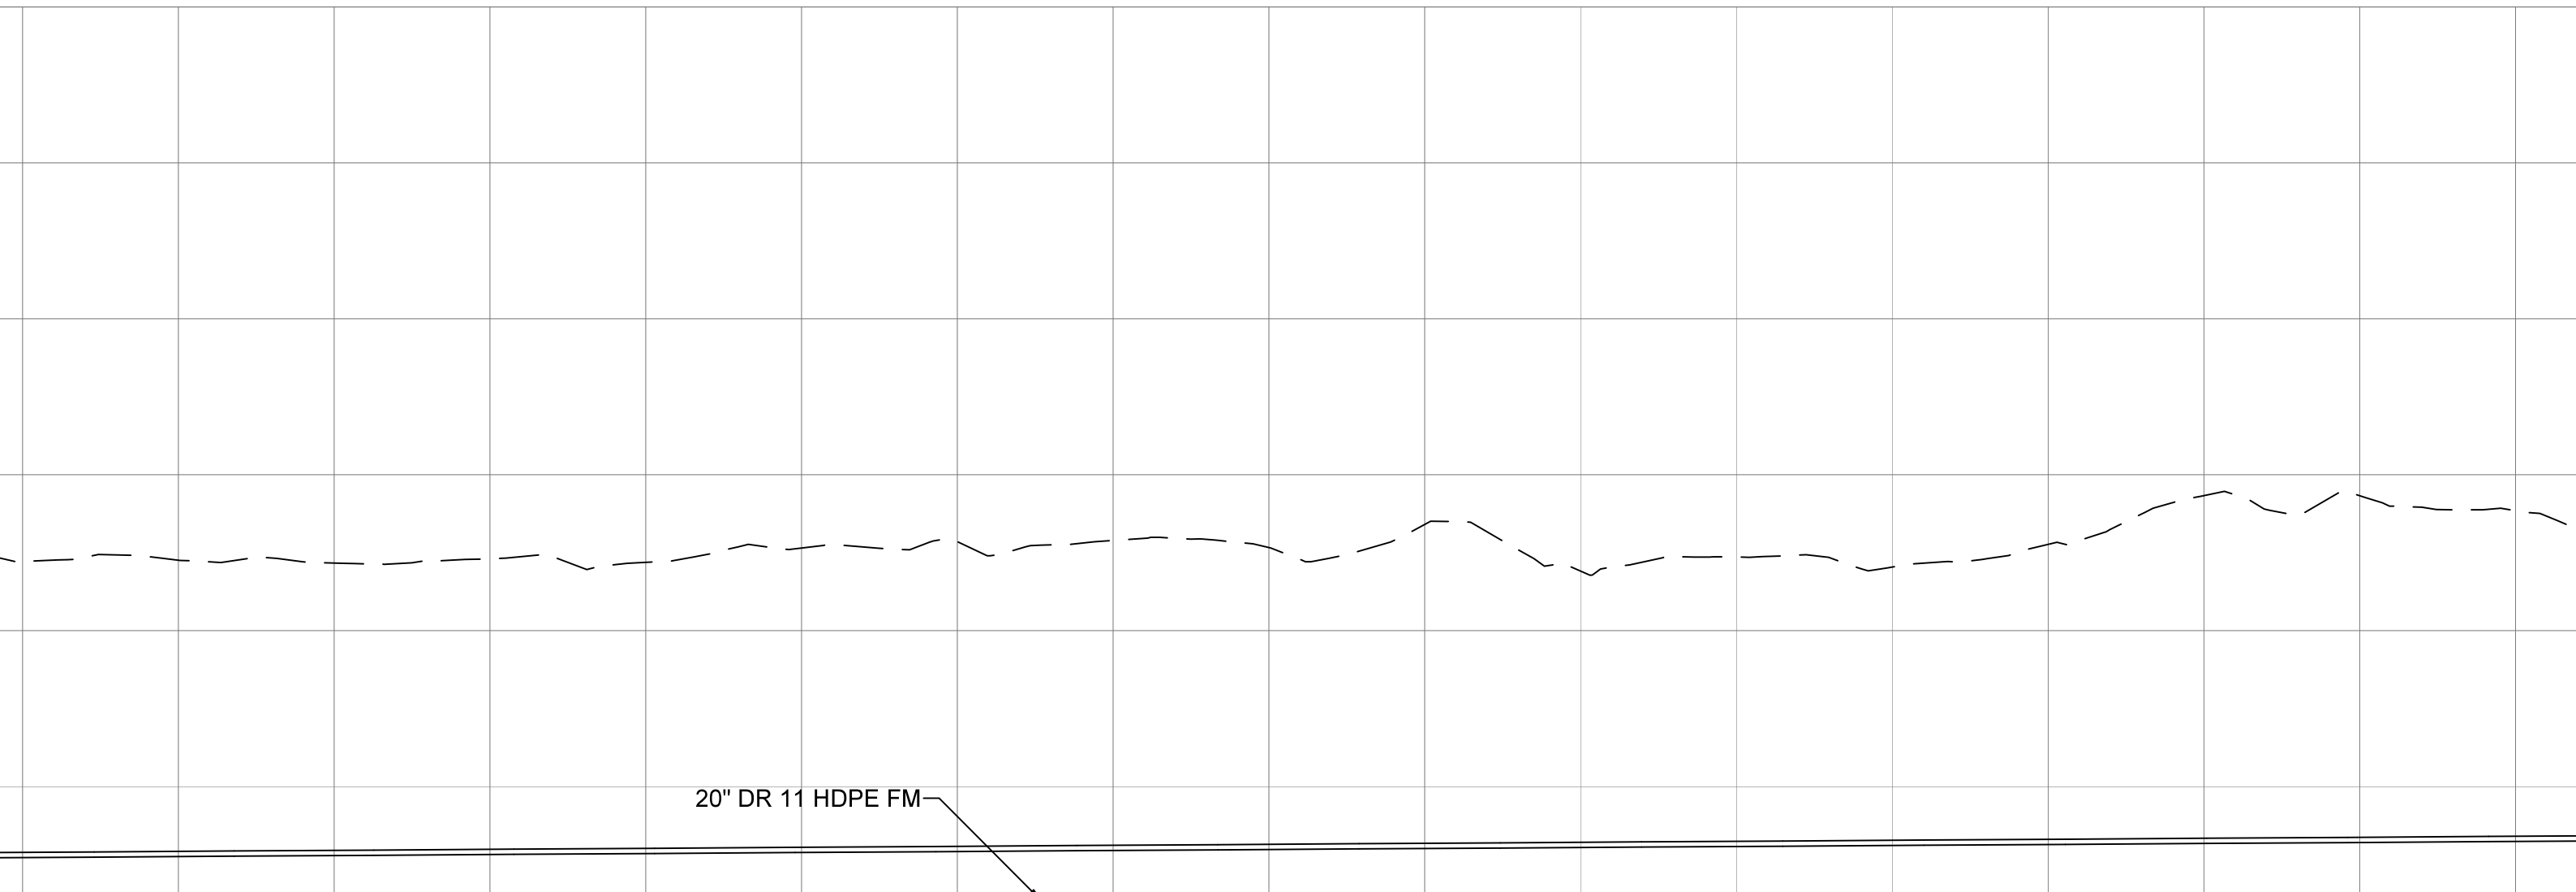


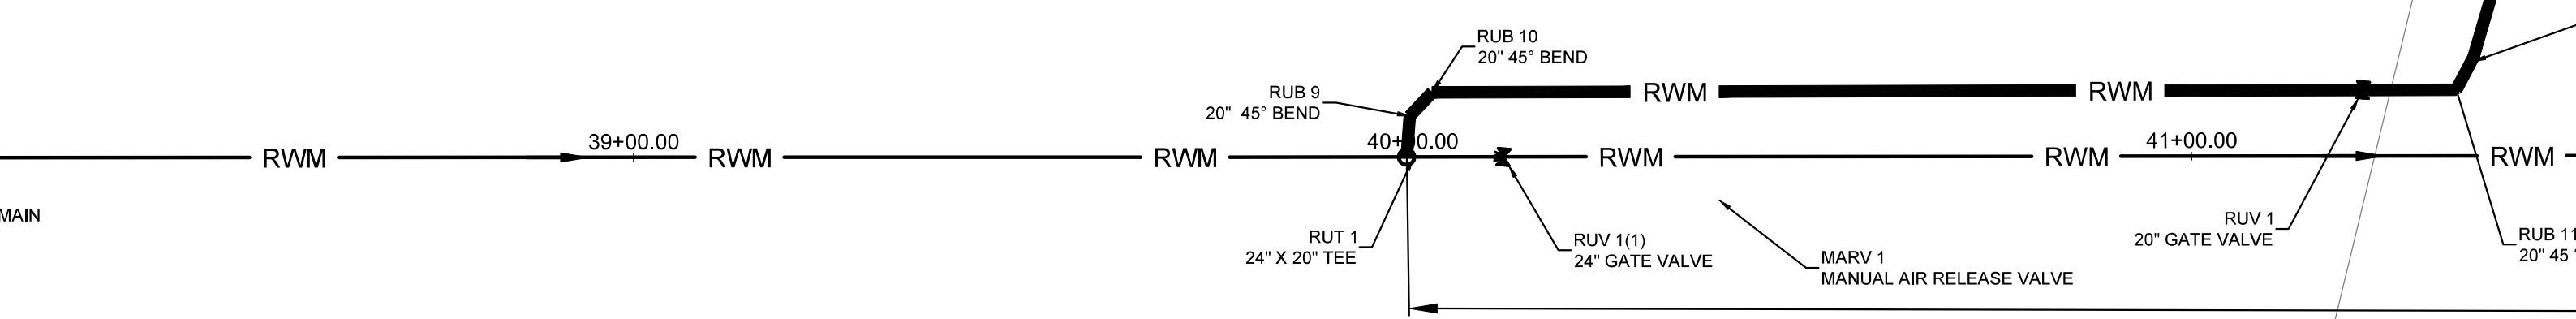

PAGE NOTES


1. SEE COVER SHEET FOR NOTES AND LEGEND
2. THIS PAGE NOT VALID WITHOUT COVER SHEET


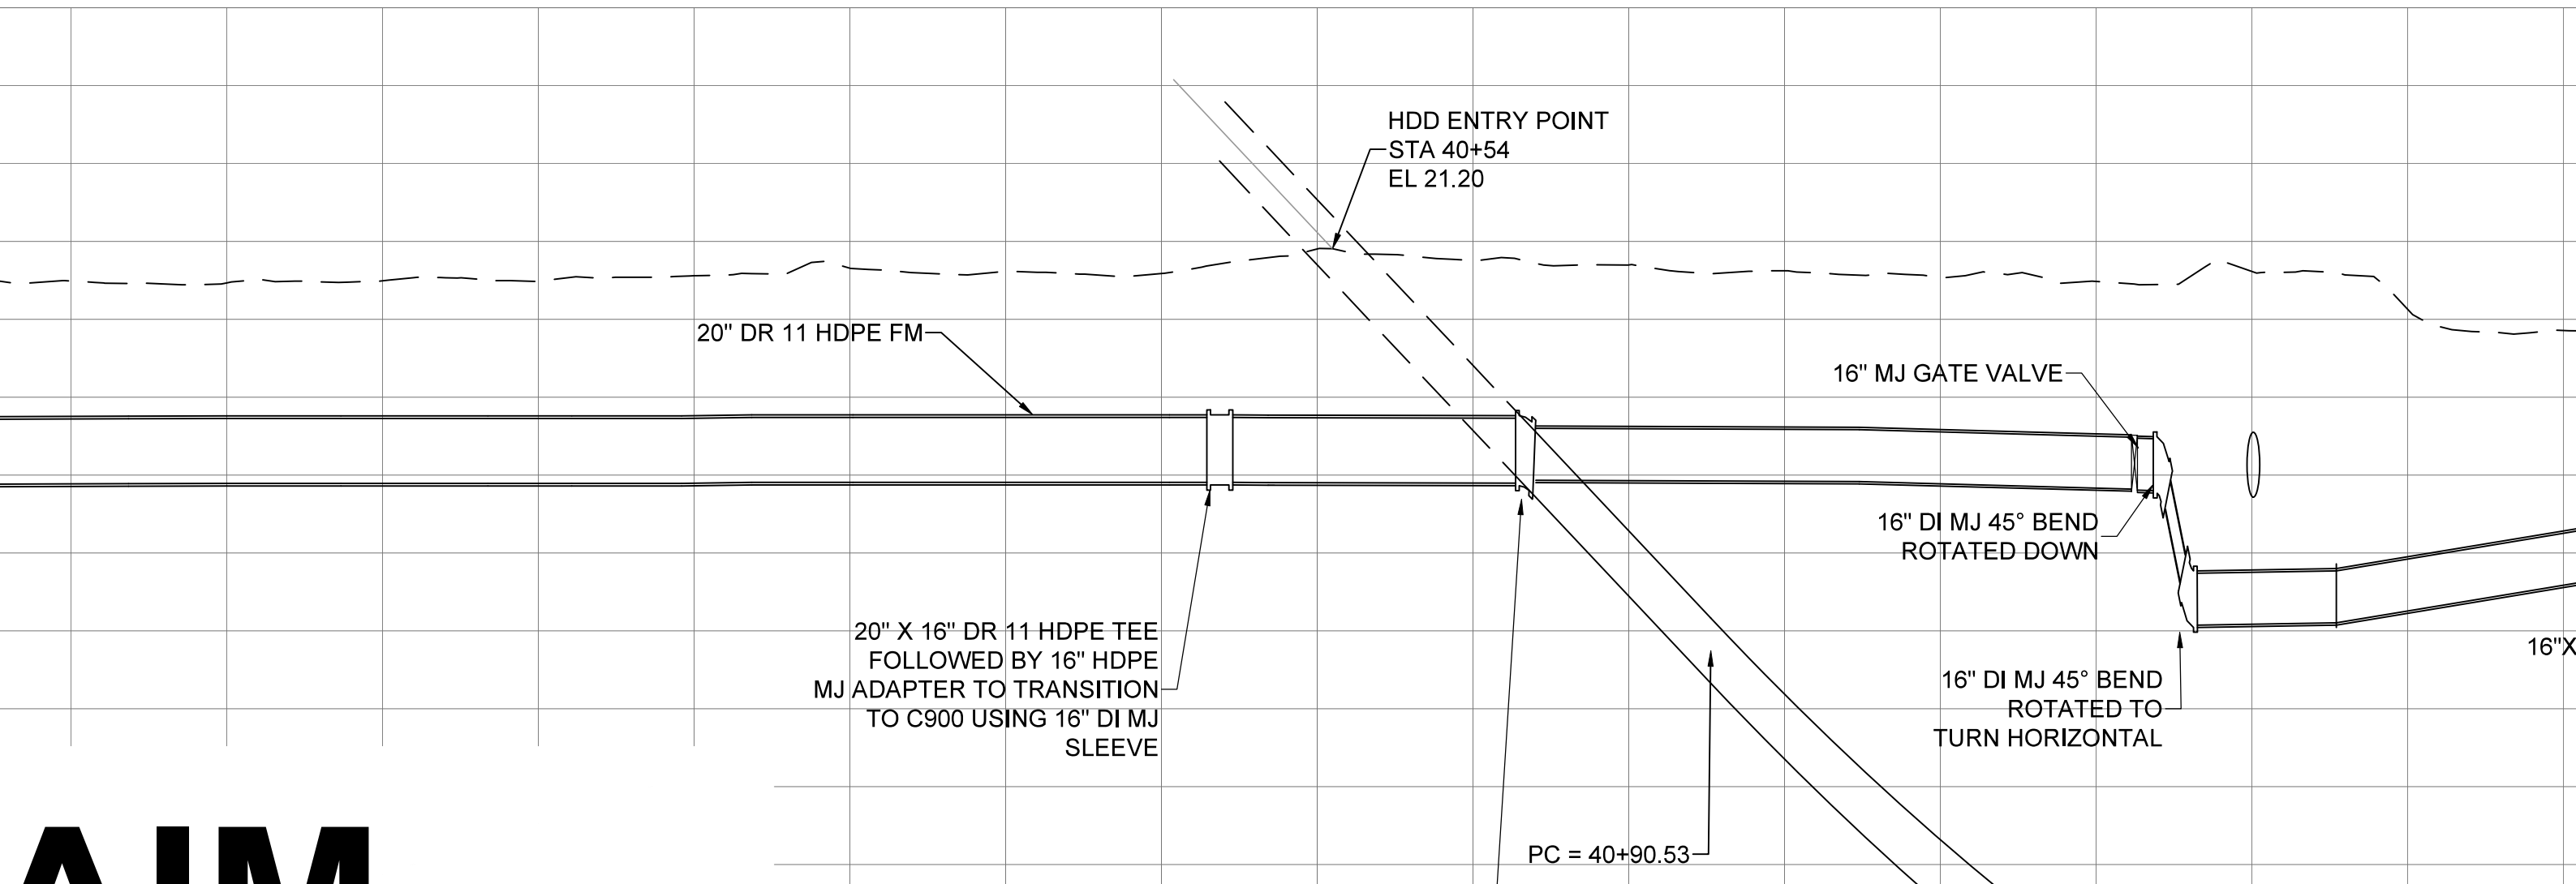


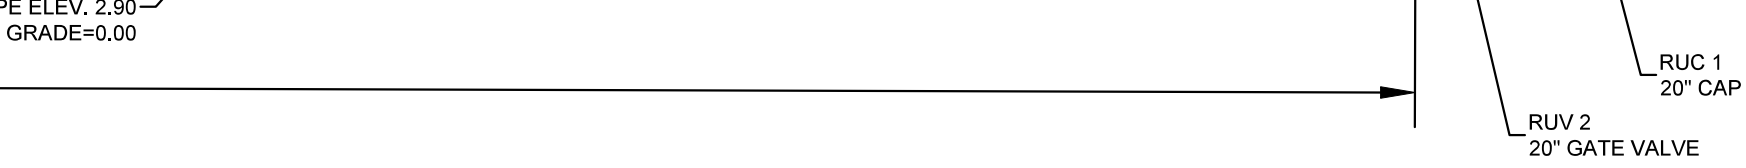


PAGE NOTES

1. SEE COVER SHEET FOR NOTES AND LEGEND
2. THIS PAGE NOT VALID WITHOUT COVER SHEET

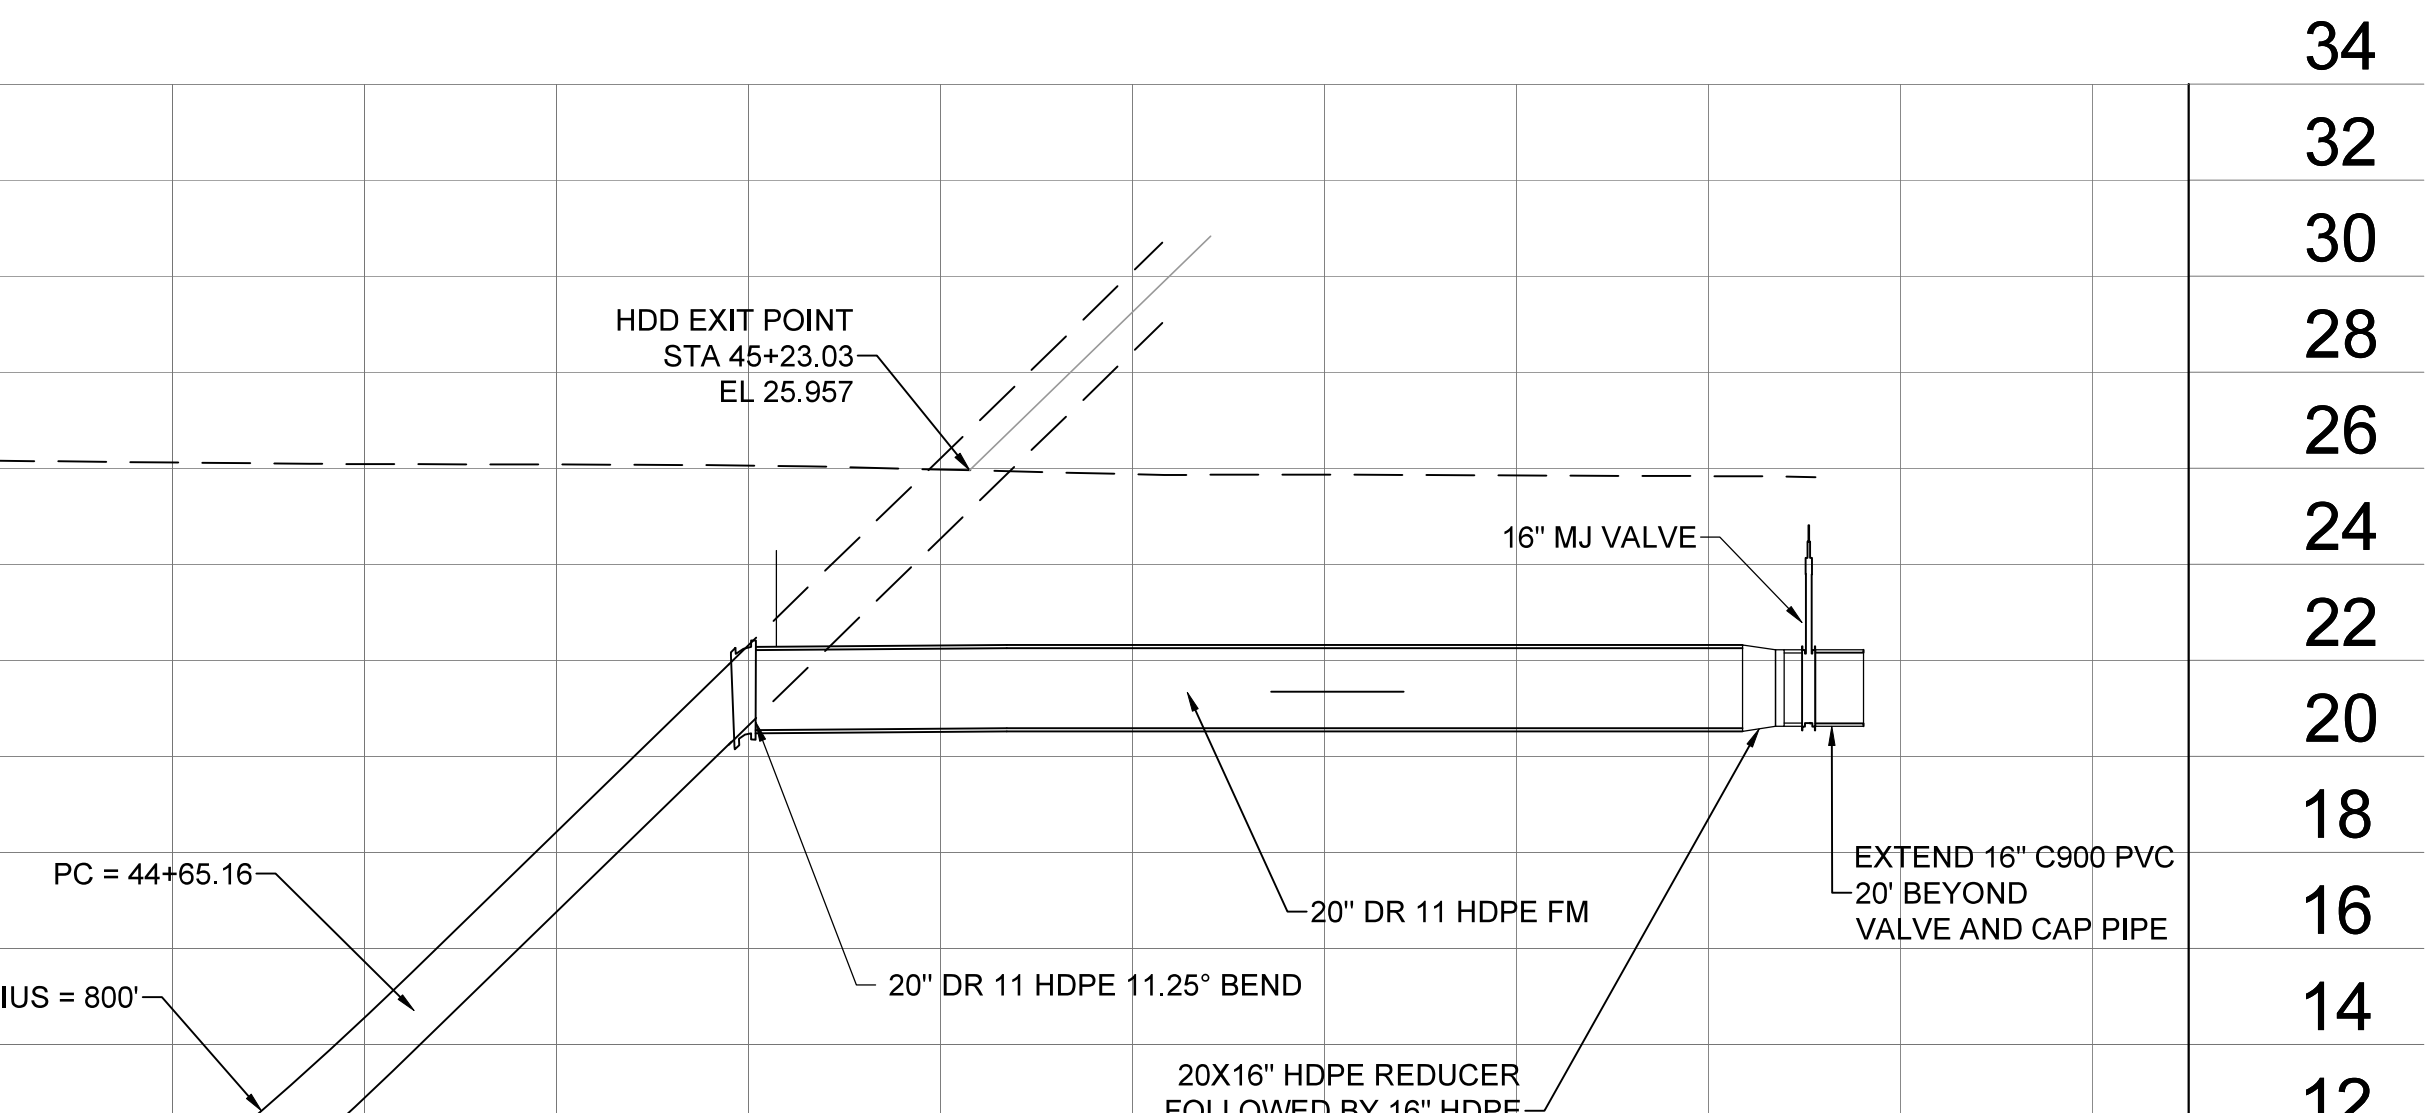


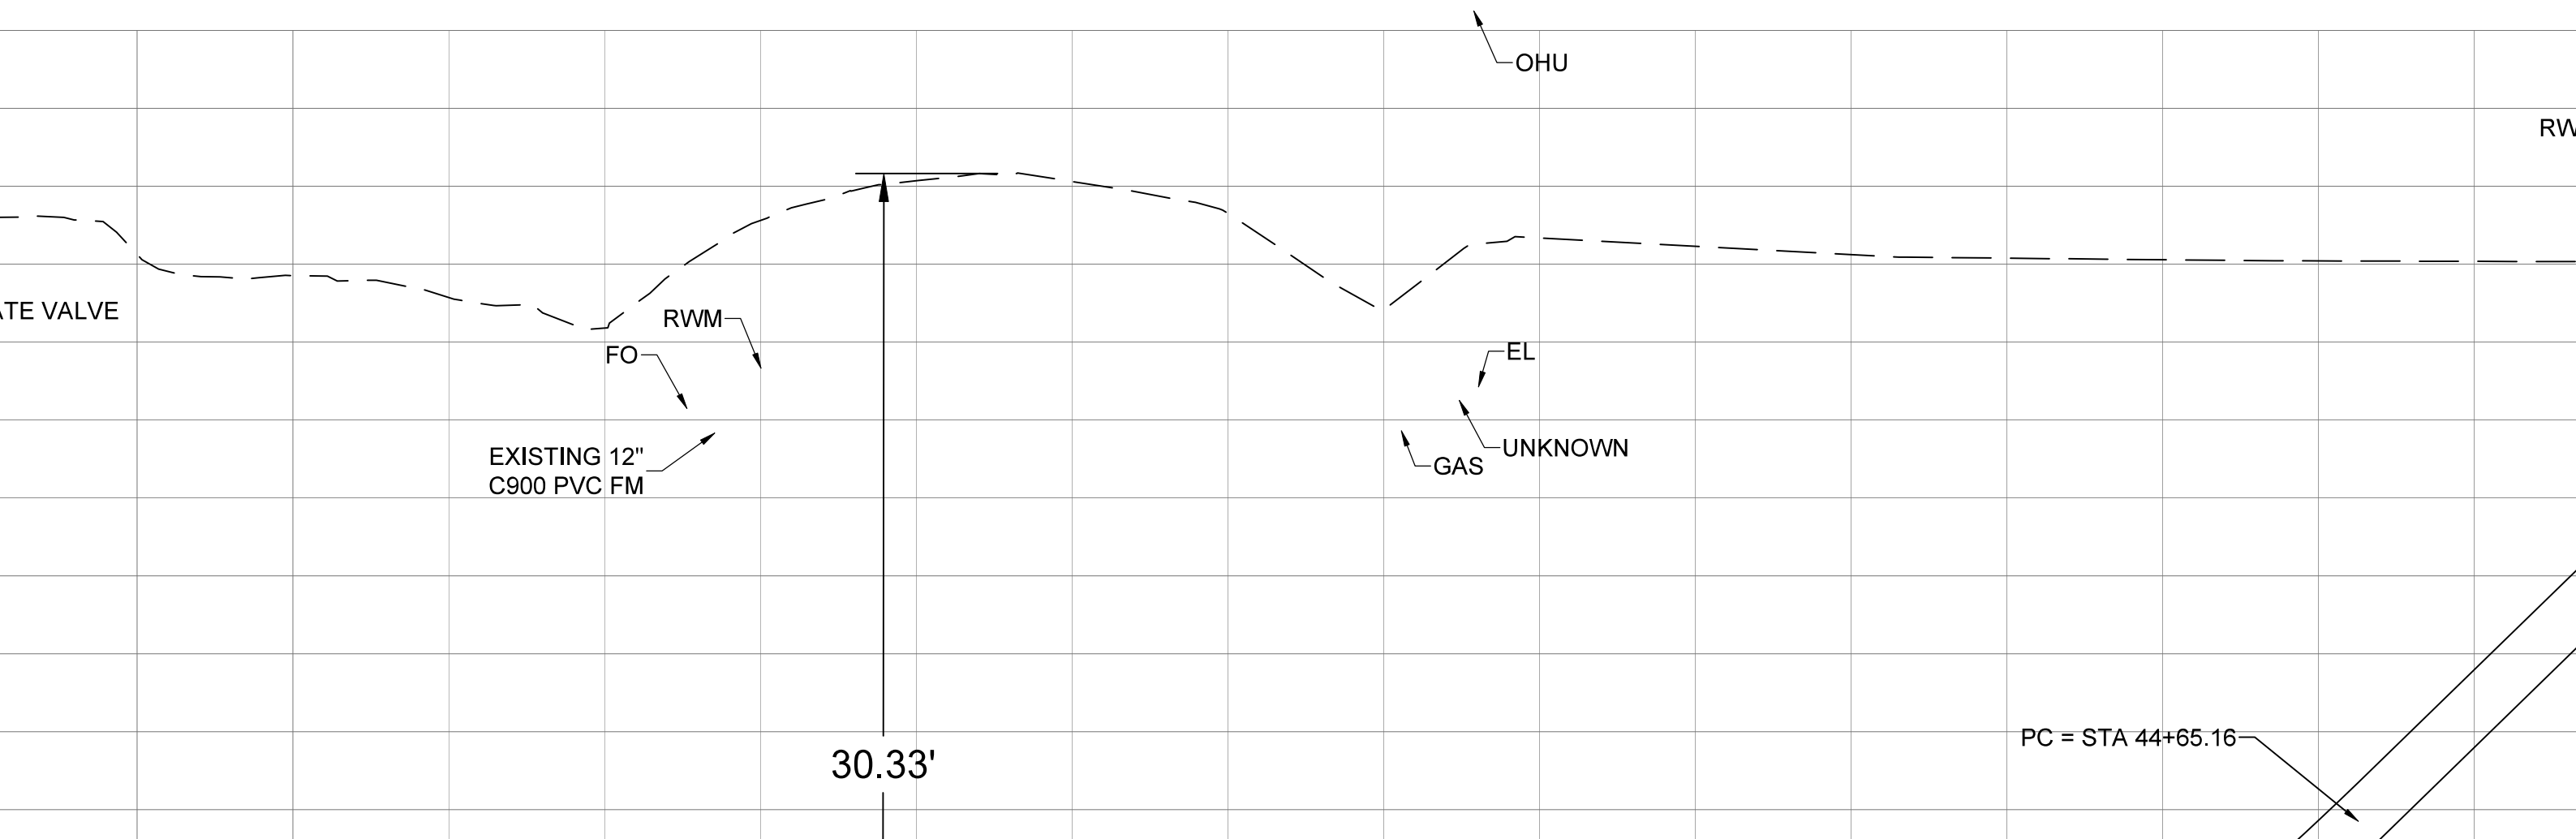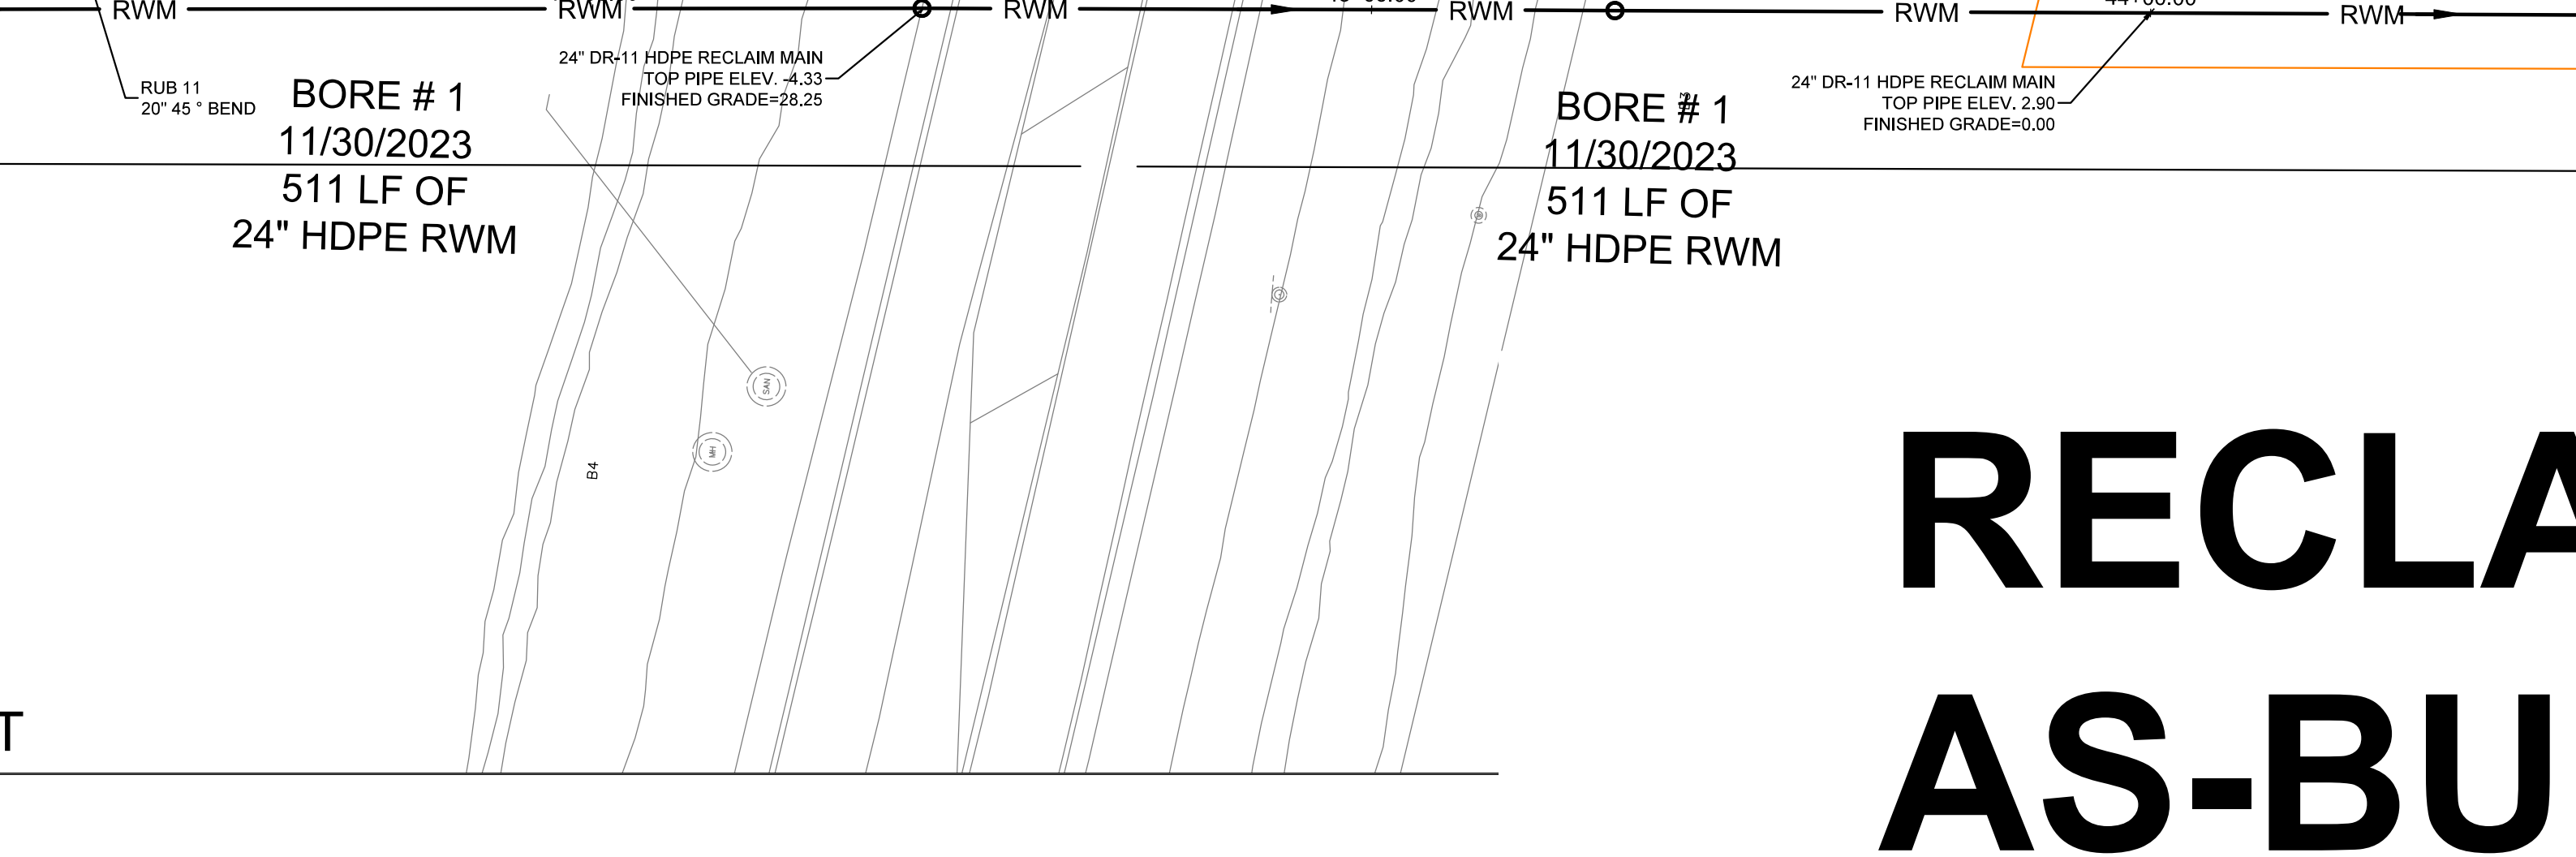

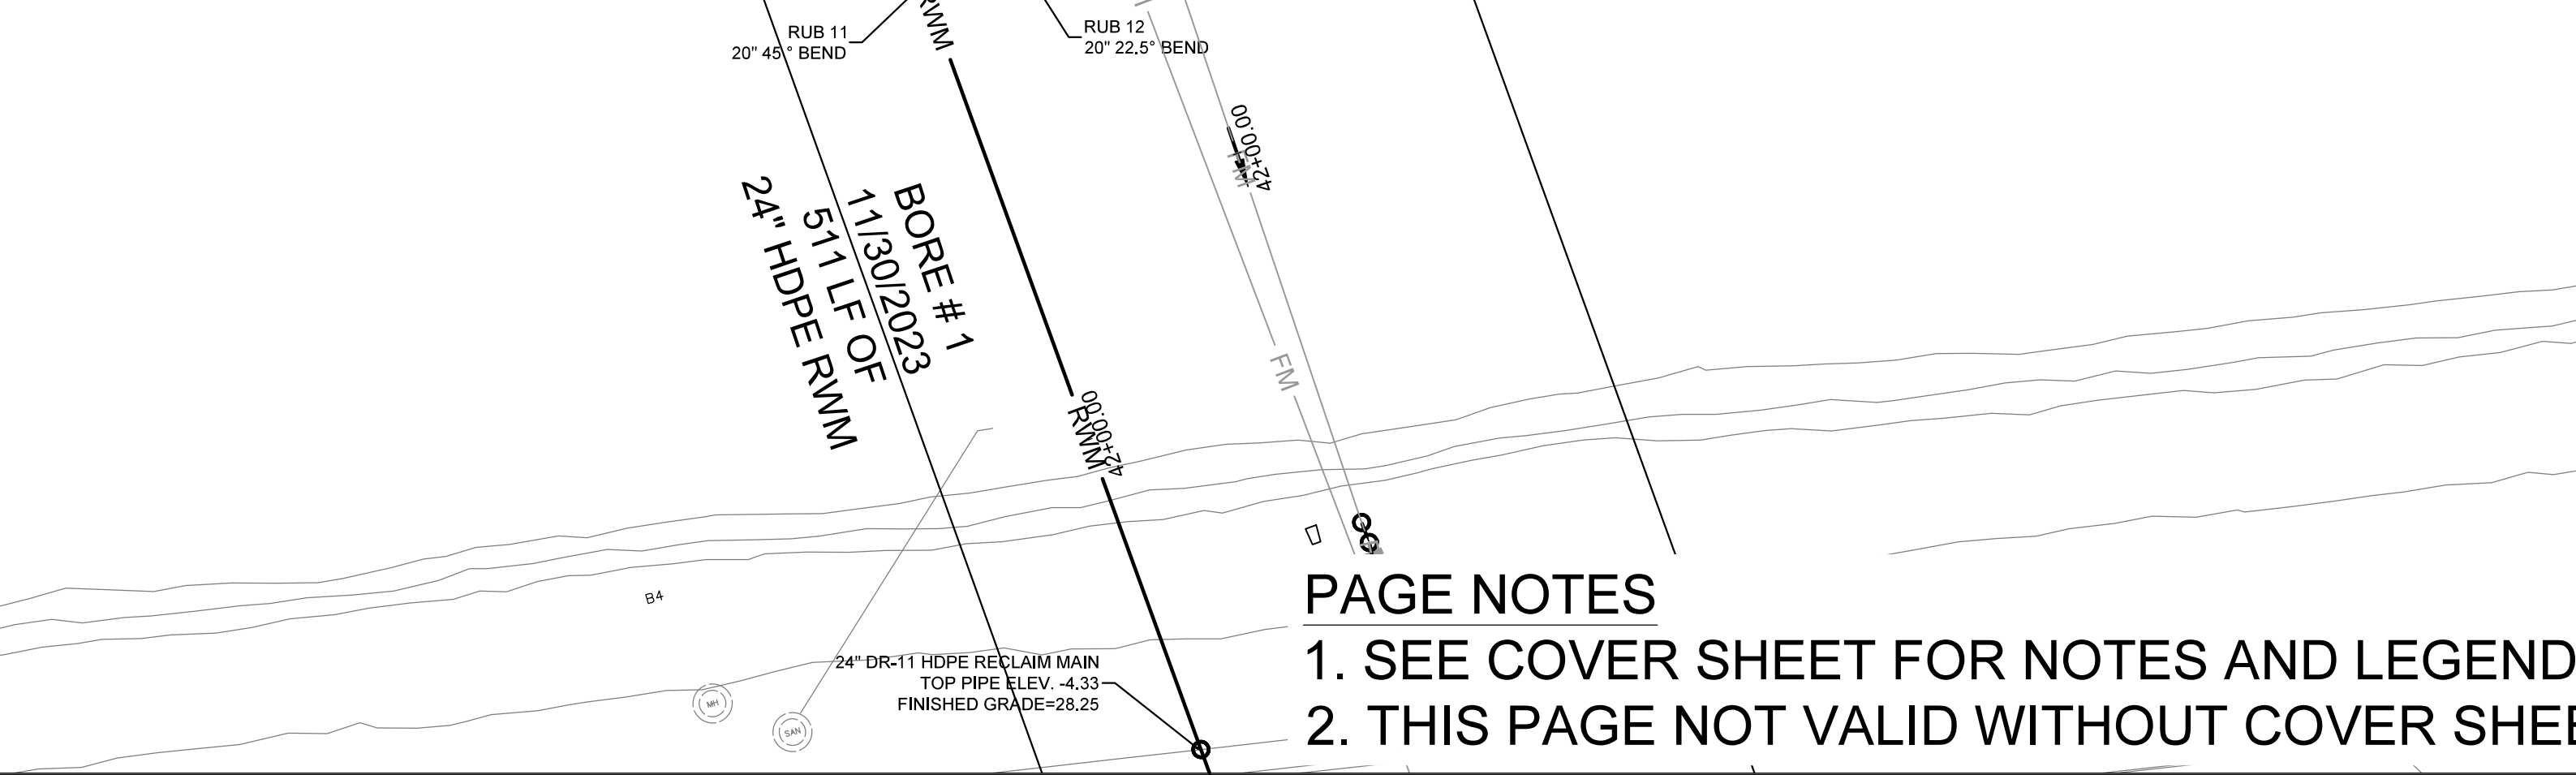

PAGE NOTES

- 1. SEE COVER SHEET FOR NOTES AND LEGEND
- 2. THIS PAGE NOT VALID WITHOUT COVER SHEET

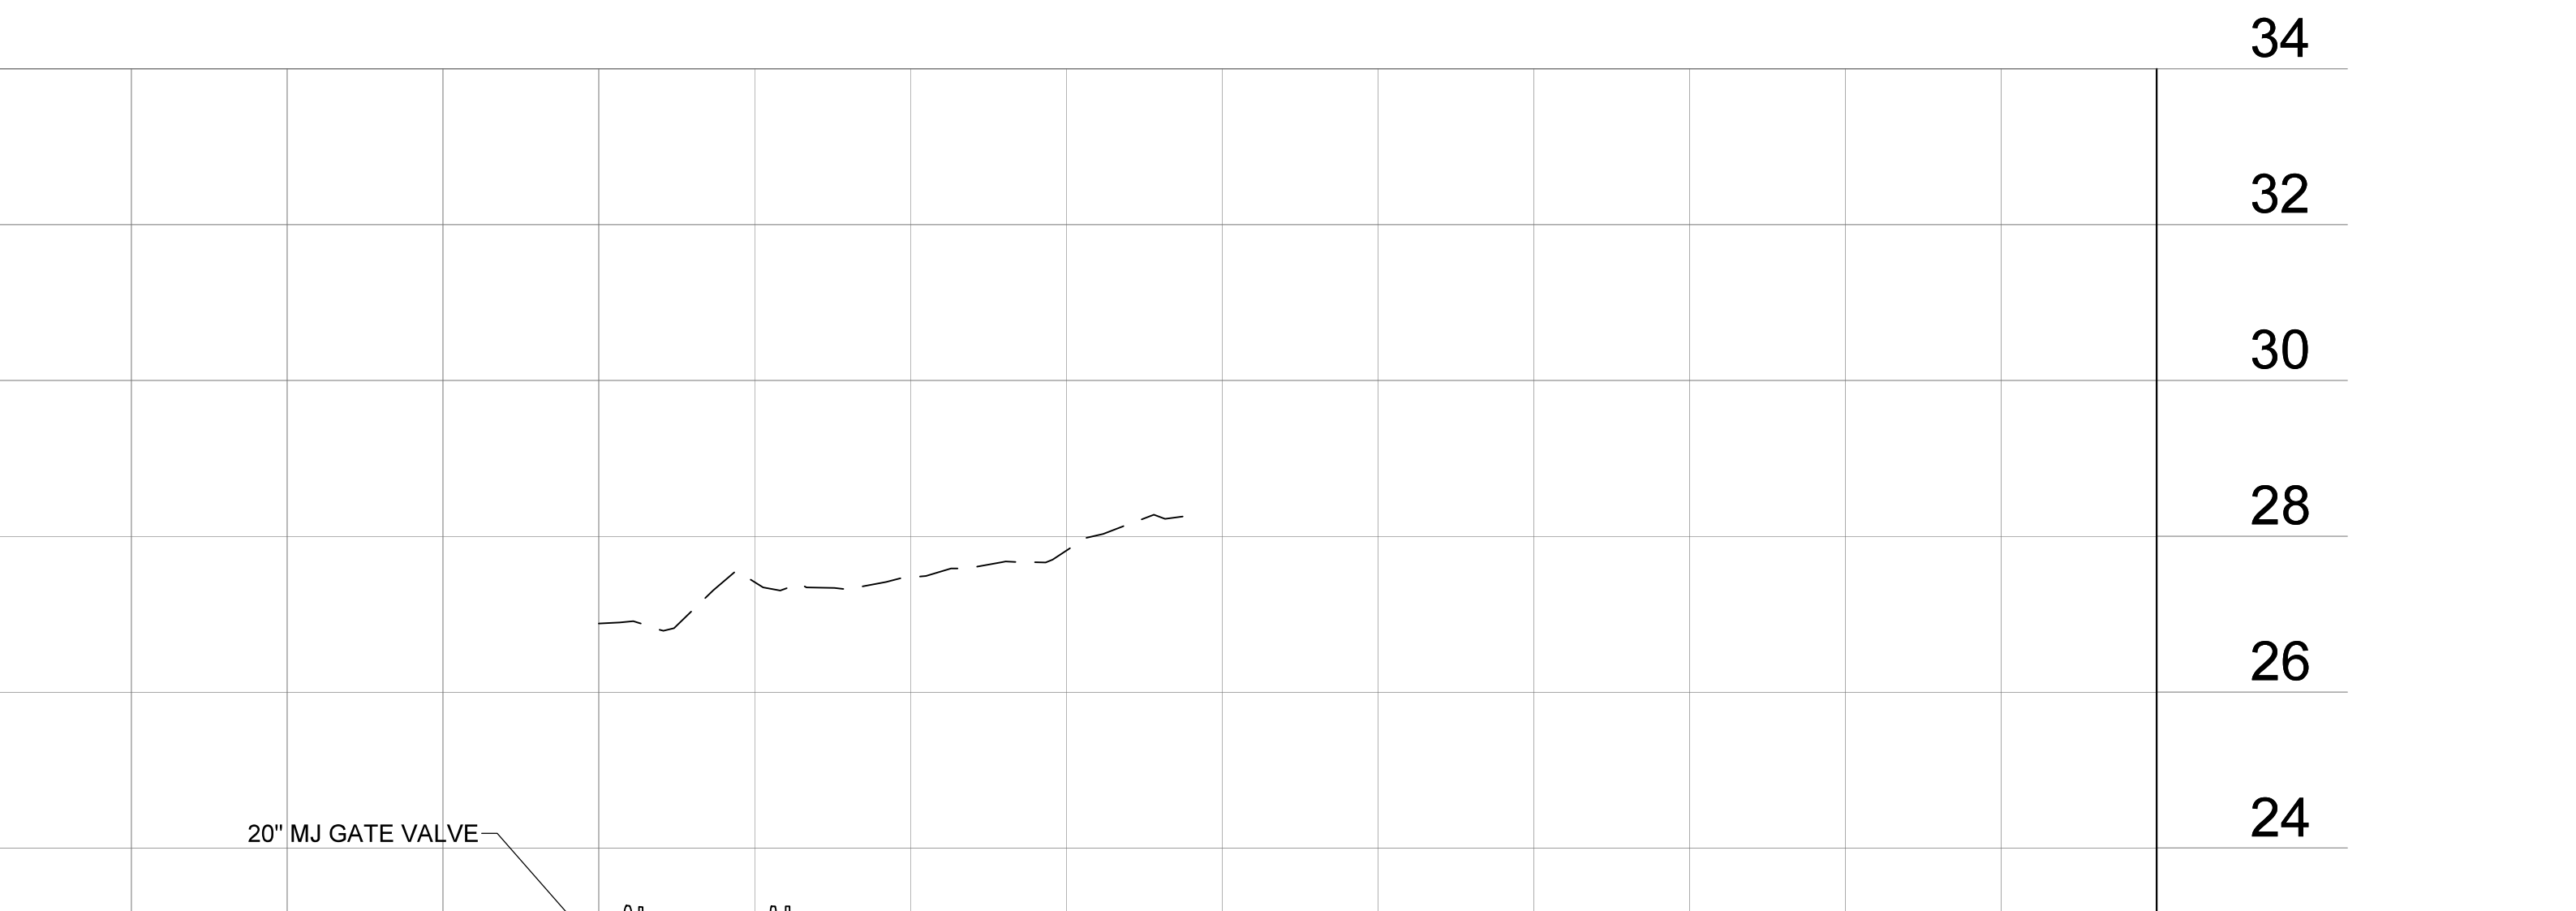

	DI	EPOXY	21.20	26.70	5.50	504324.50	2046593.54	029.96246	-081.47952
--	----	-------	-------	-------	------	-----------	------------	-----------	------------

E DETAIL TABLE					
DEPTH TO NUT	MANUFACTURER	NORTHING LATITUDE	EASTING LONGITUDE	LATITUDE (DECIMAL DEGREES)	LONGITUDE (DECIMAL DEGREES)
-27.35		2046553.93	504322.17	029.58	-081.29
0.25		2046472.65	504342.67	029.58	-081.29
5.90		2046581.95	504325.59	029.58	-081.29
-25.33		2046070.14	504364.46	029.58	-081.29
4.60		2049642.65	502281.16	029.58	-081.29

T B LANDMARK CONSTRUCTION
BORE PROFILE LOG

OWNER/GC: St. Johns County Utilities Department

SITE: CR2209 Corridor @ SR16

STATION START: 40+29

STATION END: 45+38

JOB NUMBER: 9317

JOB NAME: CR2209 FM & RWM Ext. from IGP to SR16

DRILLER: Freddy

ROD	DEPTH	STATION #
20	3'	
40	7'4"	
60	11'9"	
80	17'6"	
100	19'7"	
120	22'7"	
140	23'1"	
160	26'10"	
180	27'6"	
200	27'11"	
220	29'	
240	31'11"	
260	29'10"	
280	29'10"	
300	27'	
320	26'9"	
340	25'11"	
360	23'10"	
380	20'8"	
400	18'2"	
420	14'5"	
440	11'1"	
460	7'6"	
480	3'6"	

ROD
800
820
840
POLY		DI	EPOXY	23.81	27.10	3.29	504348.86	2046589.40	029.96245	-081.47944
ICAL FITTING		DI	EPOXY	22.63	27.60	4.97	504370.39	2046360.39	029.96182	-081.47937
ICAL FITTING		DI	EPOXY	19.76	24.20	4.44	502277.48	2049638.76	029.97081	-081.48602

CE MAIN VALVE DETAIL TABLE							
UT	FINISH GRADE	DEPTH TO NUT	MANUFACTURER	NORTHING	EASTING	LATITUDE (DECIMAL DEGREES)	LONGITUDE (DECIMAL DEGREES)
2.40	25.50	3.10		2048681.44	503067.07	029.96818	-081.48351
1.87	26.87	5.00		2049184.55	502472.28	029.96956	-081.48540
2.40	25.70	3.30		2046079.92	504388.66	029.96105	-081.47931
3.14	25.50	2.36		2049663.53	502248.89	029.97088	-081.48611
5.85	27.10	1.25		2046589.62	504353.22	029.96245	-081.47942
5.52	27.00	1.48		2046480.55	504365.15	029.96215	-081.47939
4.21	27.60	3.39		2046361.00	504367.11	029.96182	-081.47938
3.40	25.70	2.30		2046072.96	504389.10	029.96103	-081.47930

LOCATE		
NO.	LOCATE BOX SUBTYPE	NO.
FM WLOC B 1	WIRE LOCATE BOX	2
FM WLOC B 3	WIRE LOCATE BOX	2
FM WLOC B 4	WIRE LOCATE BOX	2
FM WLOC B 5	WIRE LOCATE BOX	2
FM WLOC B 6	WIRE LOCATE BOX	2
FM WLOC B 7	WIRE LOCATE BOX	2

T B LANDMARK CONSTRUCTION, INC.
BORE PROFILE LOG

OWNER/GC: St. Johns County Utilities Department DATE: 12/4/2023
SITE: CR2209 Corridor @ SR16
STATION START: 40+42
STATION END: 45+63
JOB NUMBER: 9317 BORE #: 2
JOB NAME: CR2209 FM & RWM Ext. from IGP to SR16 SIZE: 20"
DRILLER: Freddy PIPE TYPE: HDPE FM

ROD	DEPTH	STATION #	ROD	DEPTH	STATION #
20	3'		800		
40	6'10"		820		
60	10'8"		840		
80	14'9"		860		
100	18'2"		880		
120	21'9"		900		
140	23'8"		920		
160	25'9"		940		
180	27'7"		960		
200	28'4"		980		
220	26'9"		1000		
240	31'4"		1020		
260	31'		1040		
280	31'		1060		
300	29'11"		1080		
320	26'4"		1100		
340	26'		1120		
360	26'2"		1140		
380	23'9"		1160		
400	20'11"		1180		

T B LANDMARK CONSTRUCTION, INC.
BORE PROFILE LOG


OWNER/GC: St. Johns County Utility Department DATE:
SITE: North Side of International Golf Parkway at St. Johns Parkway
STATION START: 8+52
STATION END: 14+91
JOB NUMBER: 9317 BORE #:
JOB NAME: CR2209 FM & RWM Ext from IGP to SR16 SIZE:
DRILLER: Freddy PIPE TYPE:


ROD	DEPTH	STATION #	ROD	DEPTH	STATION #
20	3'		800		
40	6'4"		820		
60	11'1"		840		
80	14'7"		860		
100	18'4"		880		
120	21'6"		900		
140	24'10"		920		
160	26'10"		940		
180	28'7"		960		
200	29'6"		980		
220	31'		1000		
240	33'9"		1020		
260	33'6"		1040		
280	33'11"		1060		
300	35'		1080		
320	34'1"		1100		
340	35'10"		1120		
360	33'11"		1140		
380	30'4"		1160		
400	29'10"		1180		

Proposed Reclaimed Water Main Design Plans




 SOUTHERN BELL

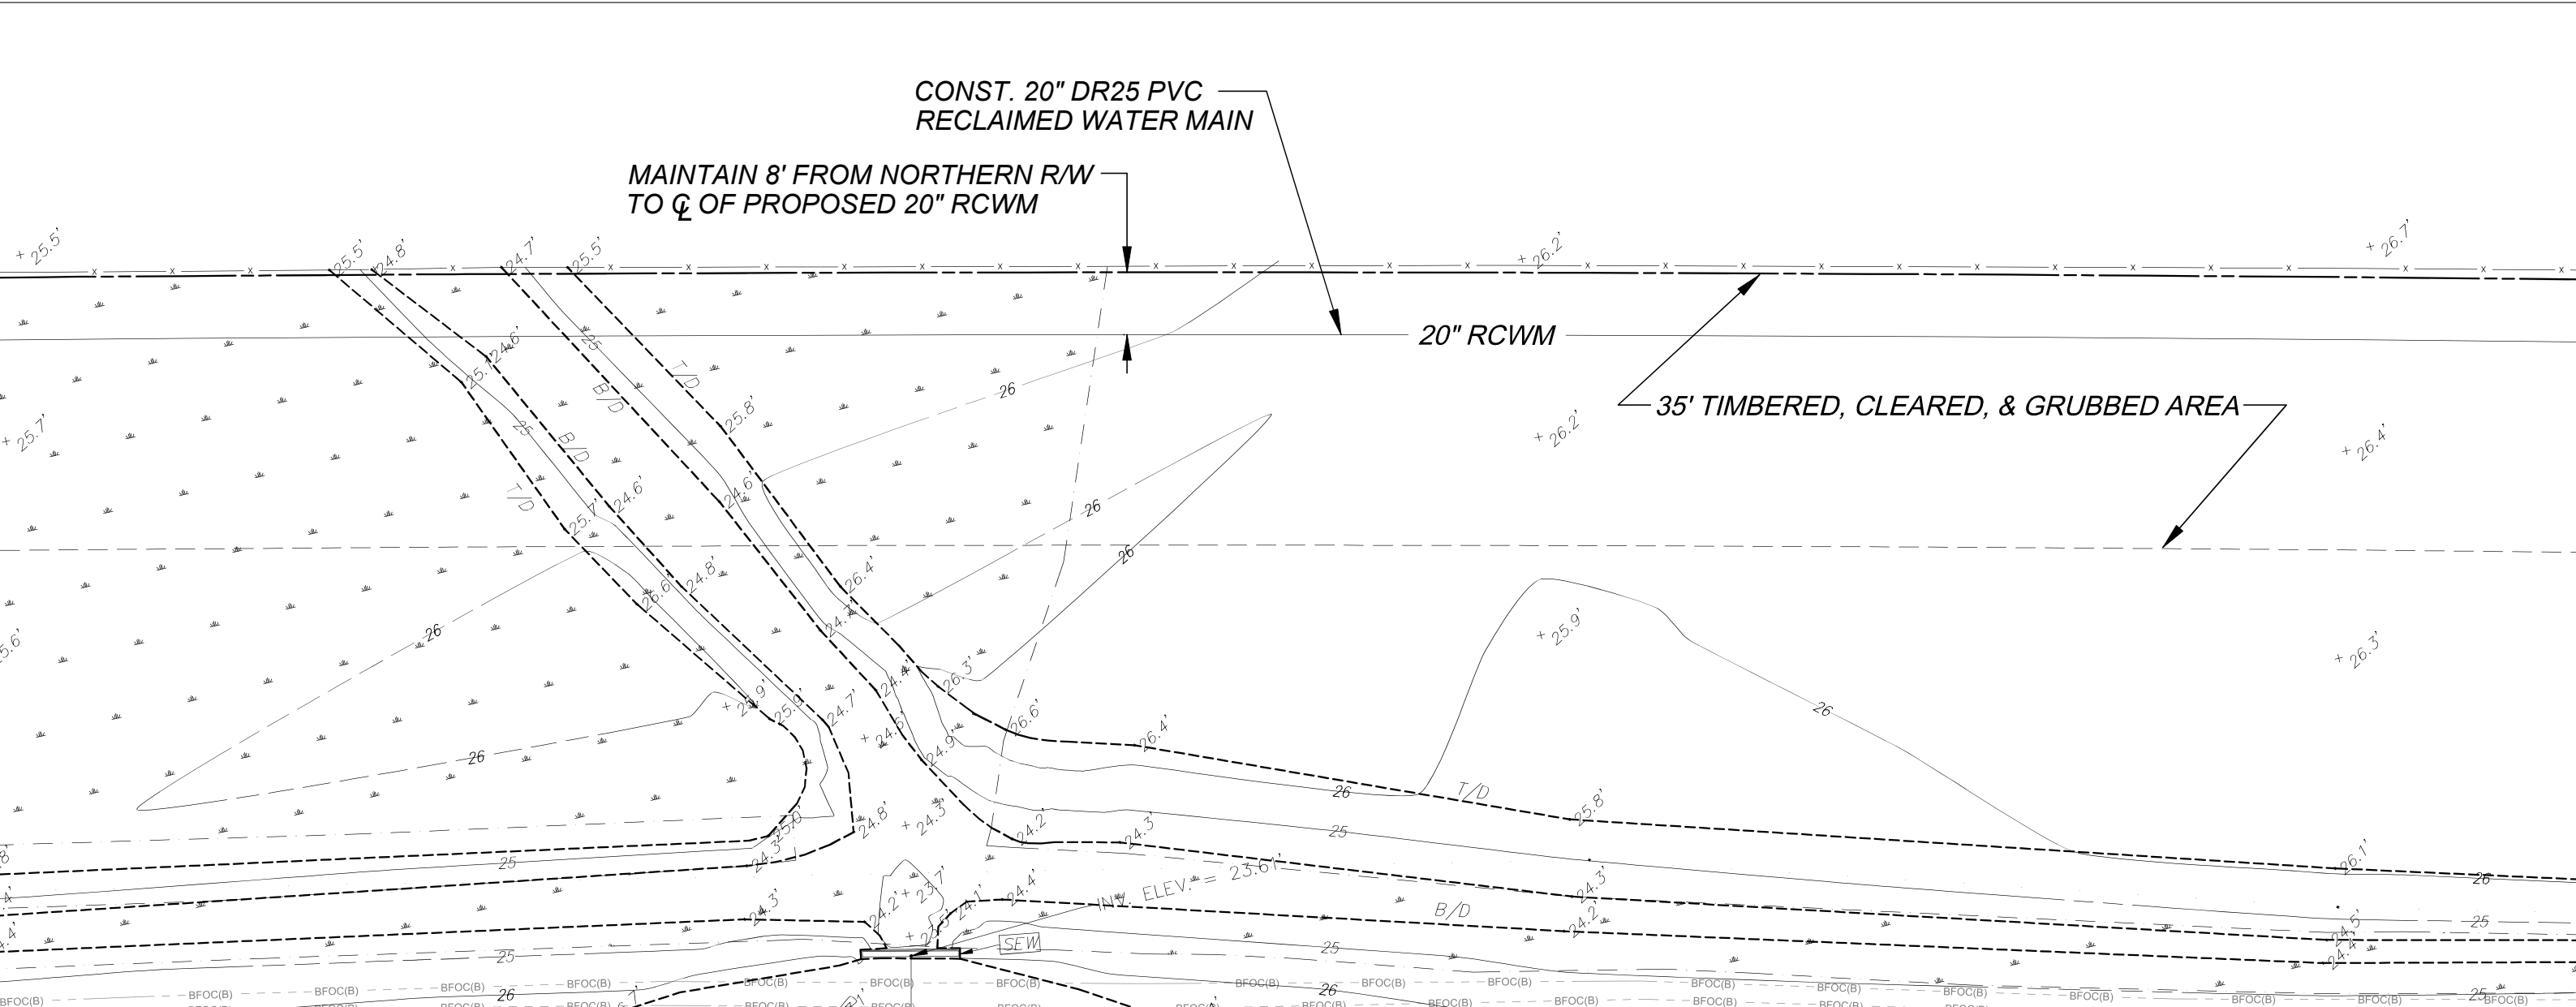


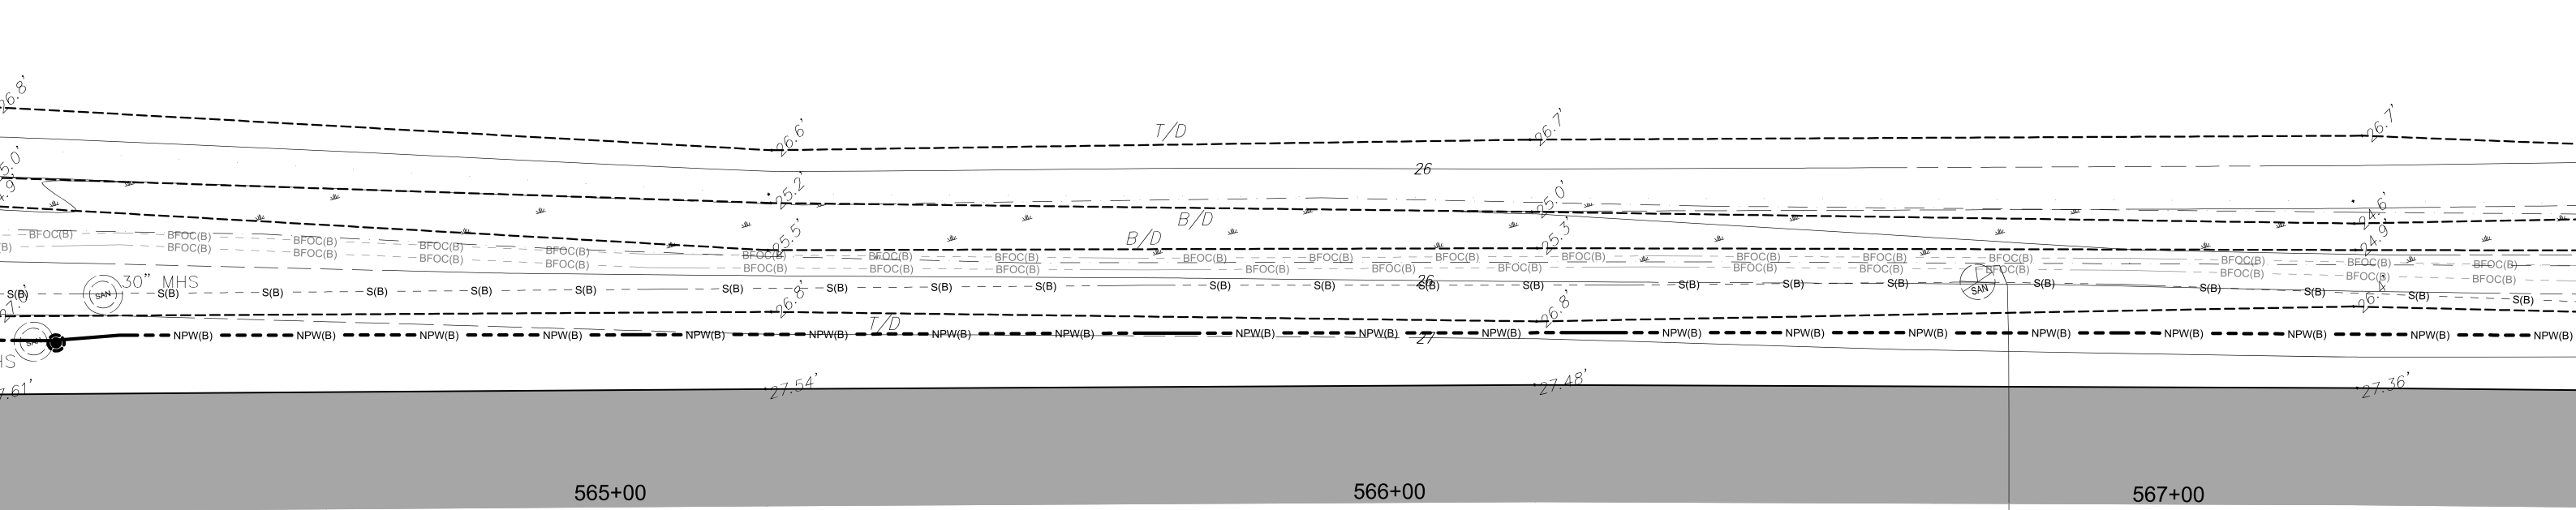

STATE ROAD No. 16
(200' R/W)

CURVE CL1
PI STA. = 561+22.13
DELTA = 09°16'00"
D = 00°20'00"
T = 1393.04'
L = 2780.00'
R = 17188.73'
PC STA. = 547+29.09
PT STA. = 575+09.10

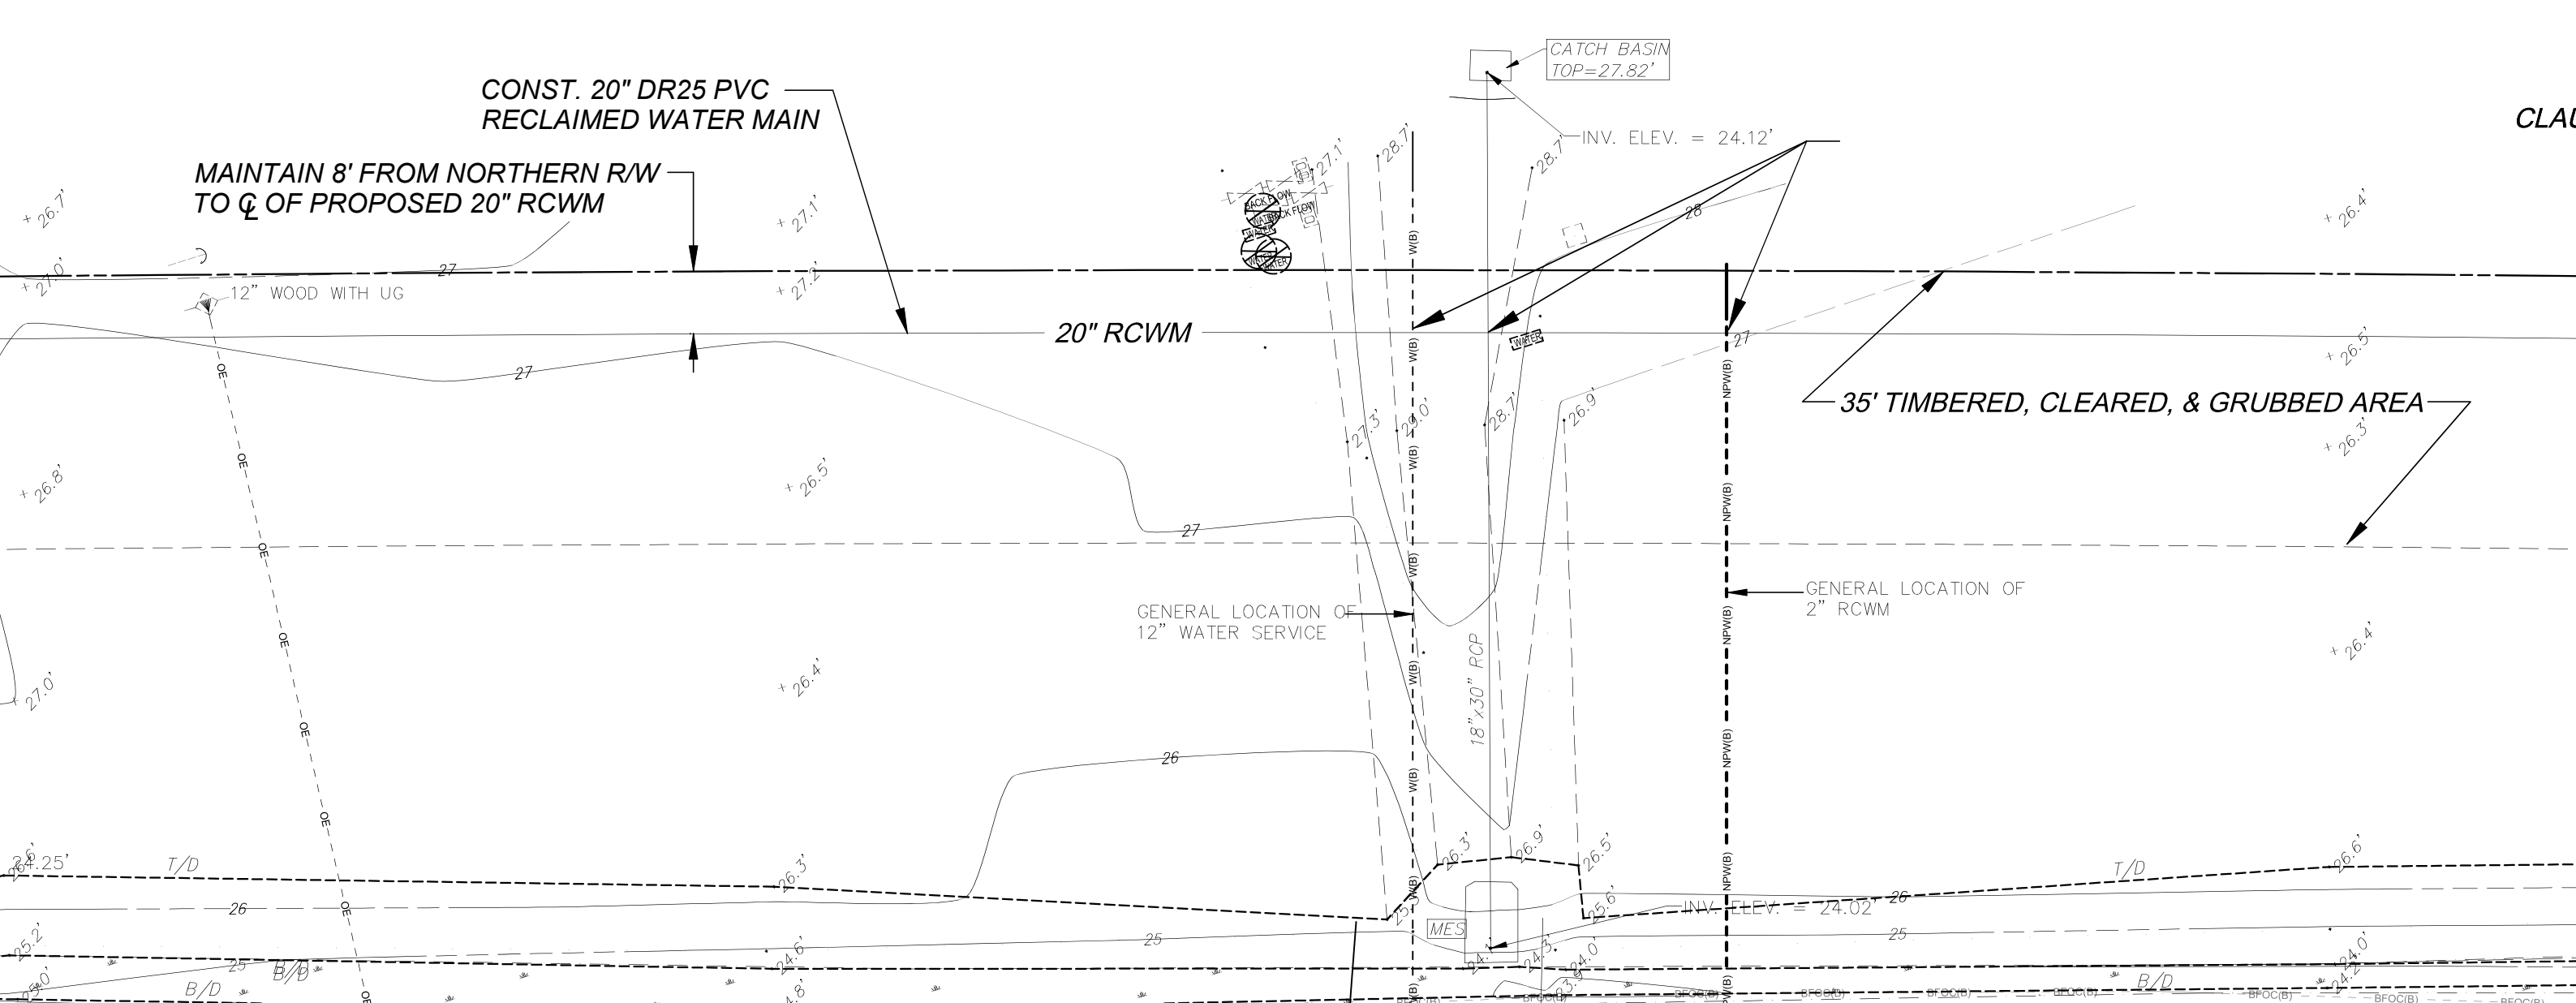

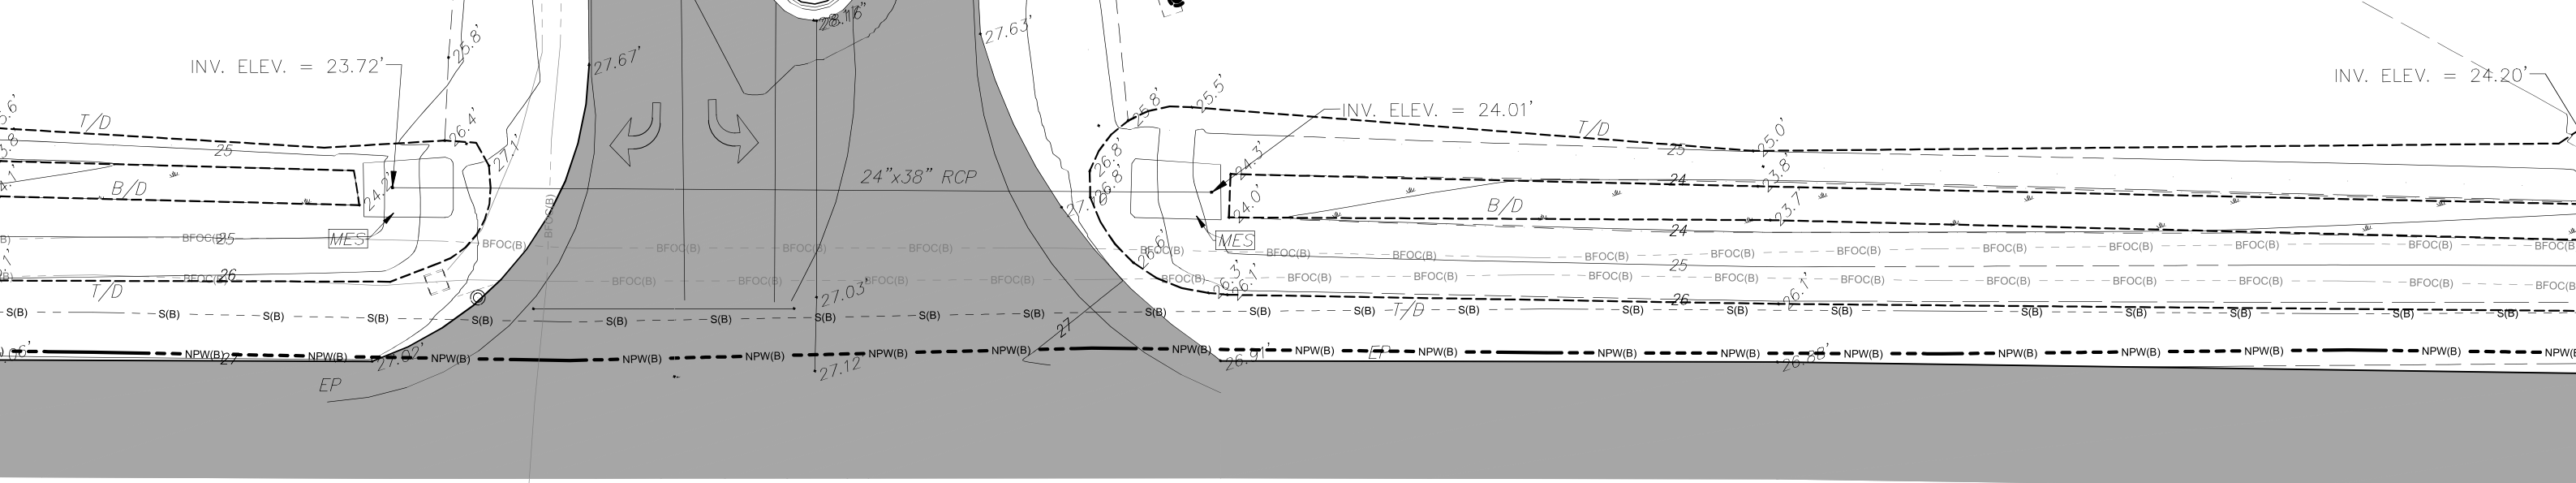

577+00

578+00


579+00

£ OF SURVEY

S 71° 37' 46" E

STATE ROAD No. 16

(200' R/W)

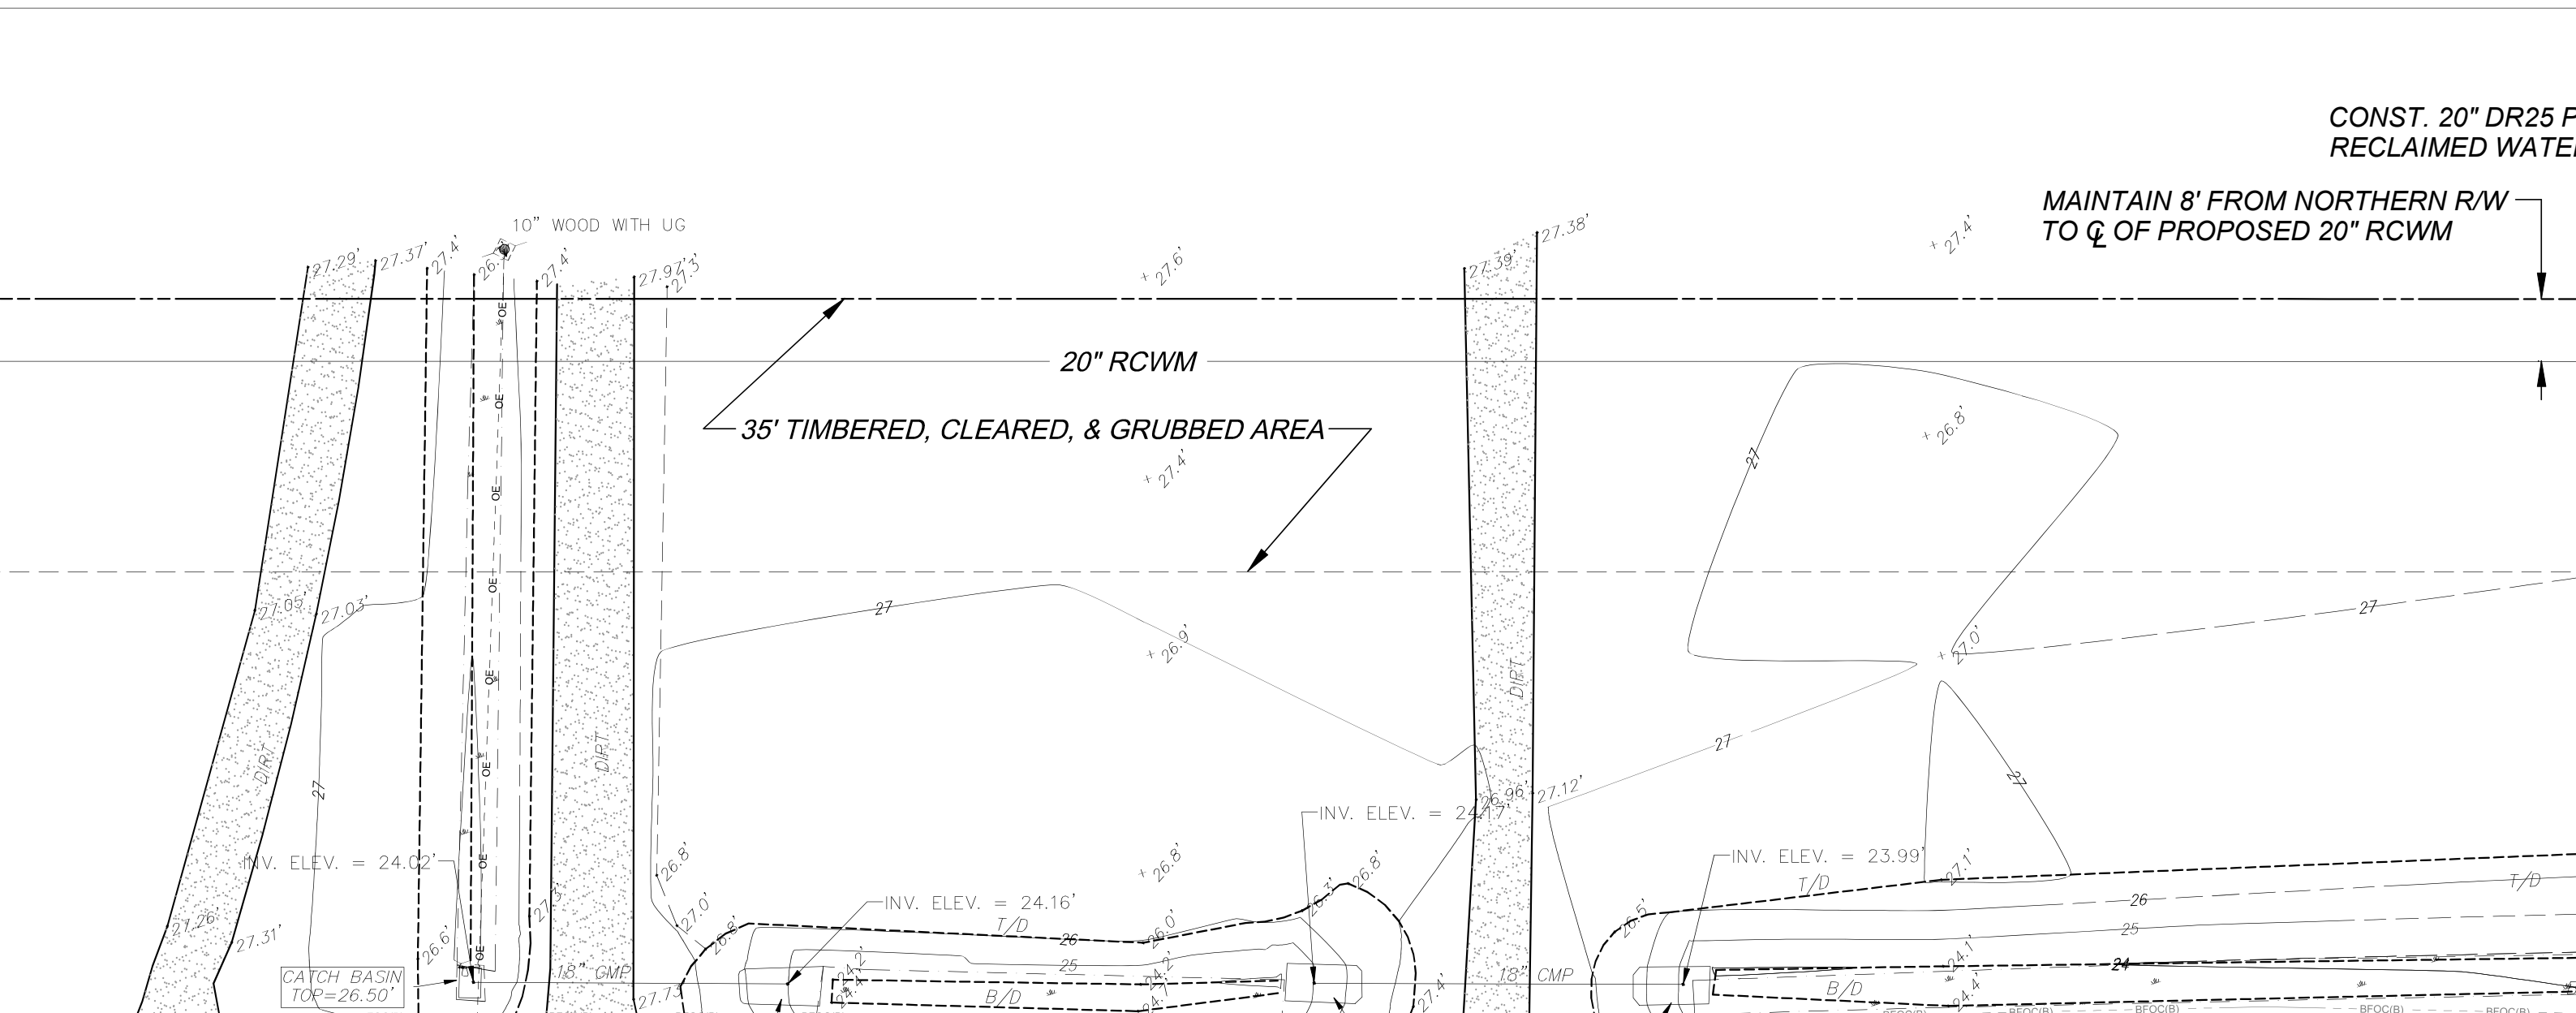

CONST. 20" DR25 P
RECLAIMED WATER

MAINTAIN 8' FROM NORTHERN R/W
TO £ OF PROPOSED 20" RCWM

20" RCWM


35' TIMBERED, CLEARED, & GRUBBED AREA

CATCH BASIN
TOP=26.50'

INV. ELEV. = 24.16'

INV. ELEV. = 24.17'

INV. ELEV. = 23.99'

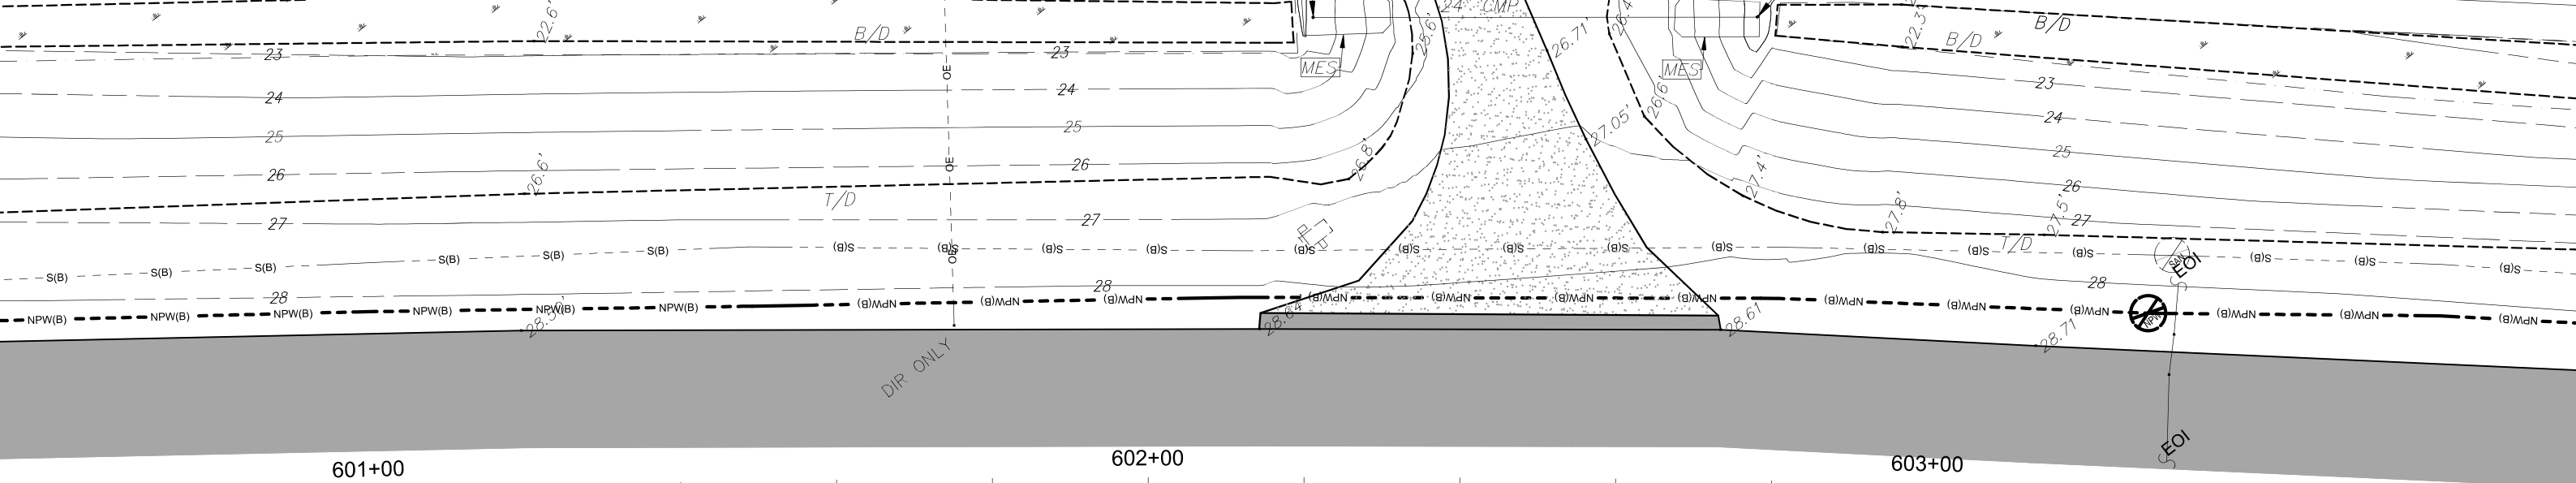



CURVE CL2
PI STA. = 596+11.01
DELTA = 23°43'51"
D = 01°15'00"
T = 963.04'
L = 1898.47'
R = 4583.66'
PC STA. = 586+47.97
PT STA. = 605+46.43

STATE ROAD No. 16
(200' R/W)

602+45
73.0'

BENCHMARK: BM7
SET 5/8" X 30" IR W/ ALUM CAP STMP DRMP LB #2648 78060 TBM7
N = 2044389
E = 510204
ELEV. = 25.43' (NAVD88)

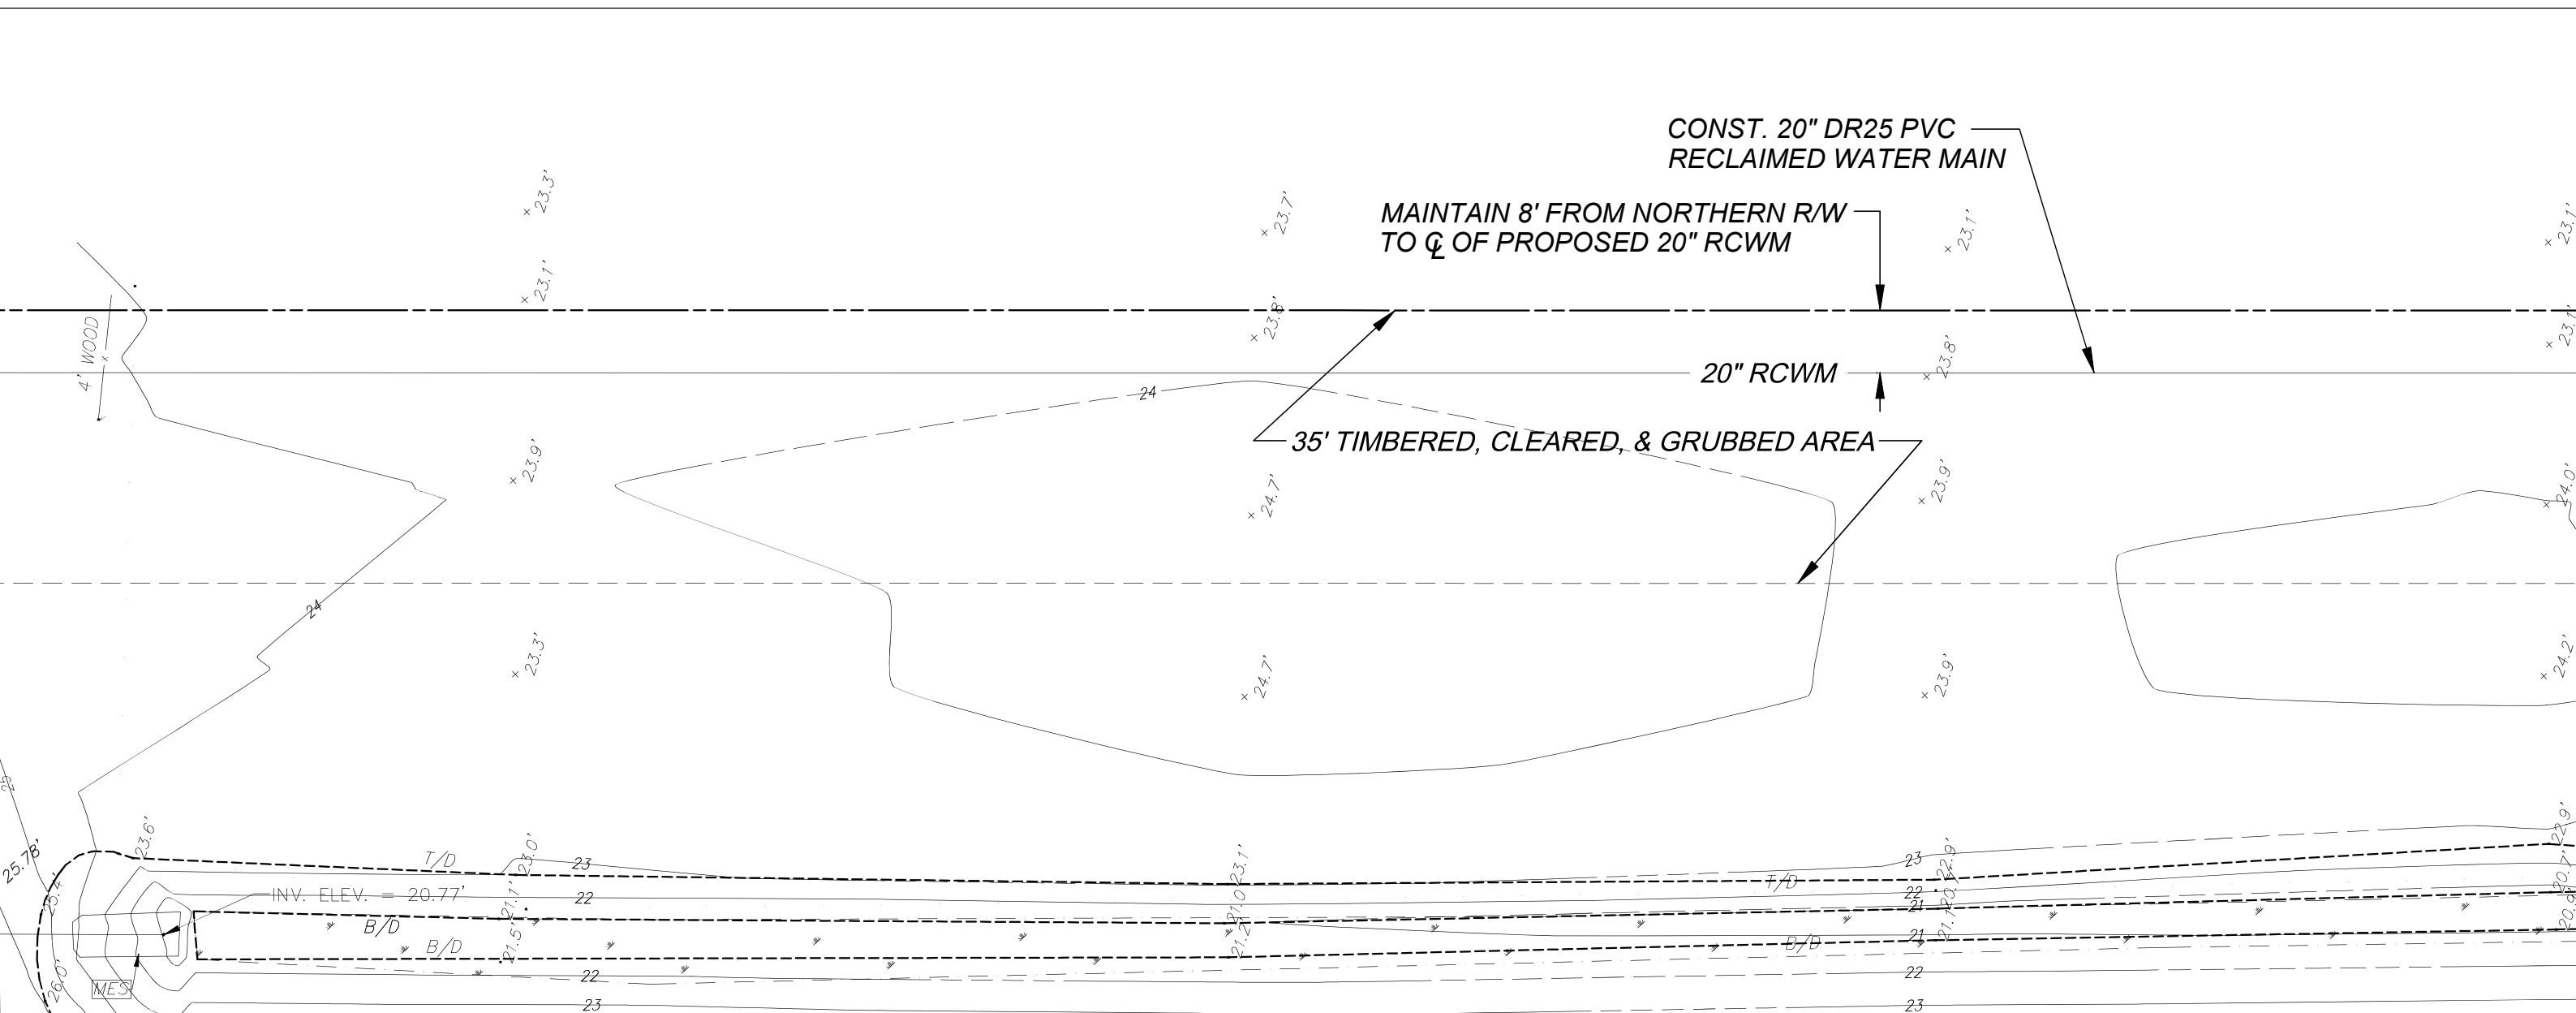

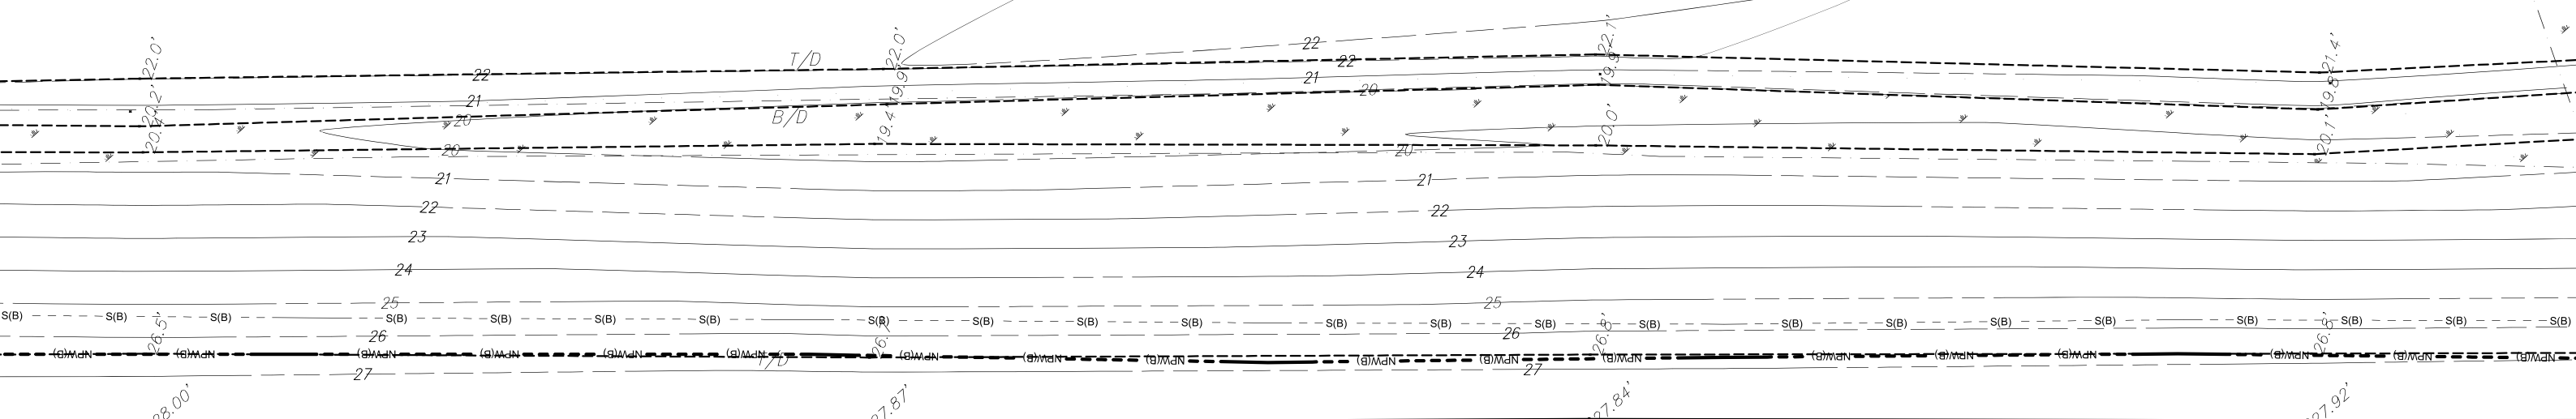

613+00

614+00

615+00

616+00


£ OF SURVEY


S 47° 53' 55" E

STATE ROAD No. 16
(200' R/W)

613+18
66.6'

BENCHMARK: BM8
SET 5/8" X 30" IR W/ ALUM CAP STMP DRMP LB #2648 78060 TBM8
N = 2043685
E = 511008
ELEV. = 21.63' (NAVD88)

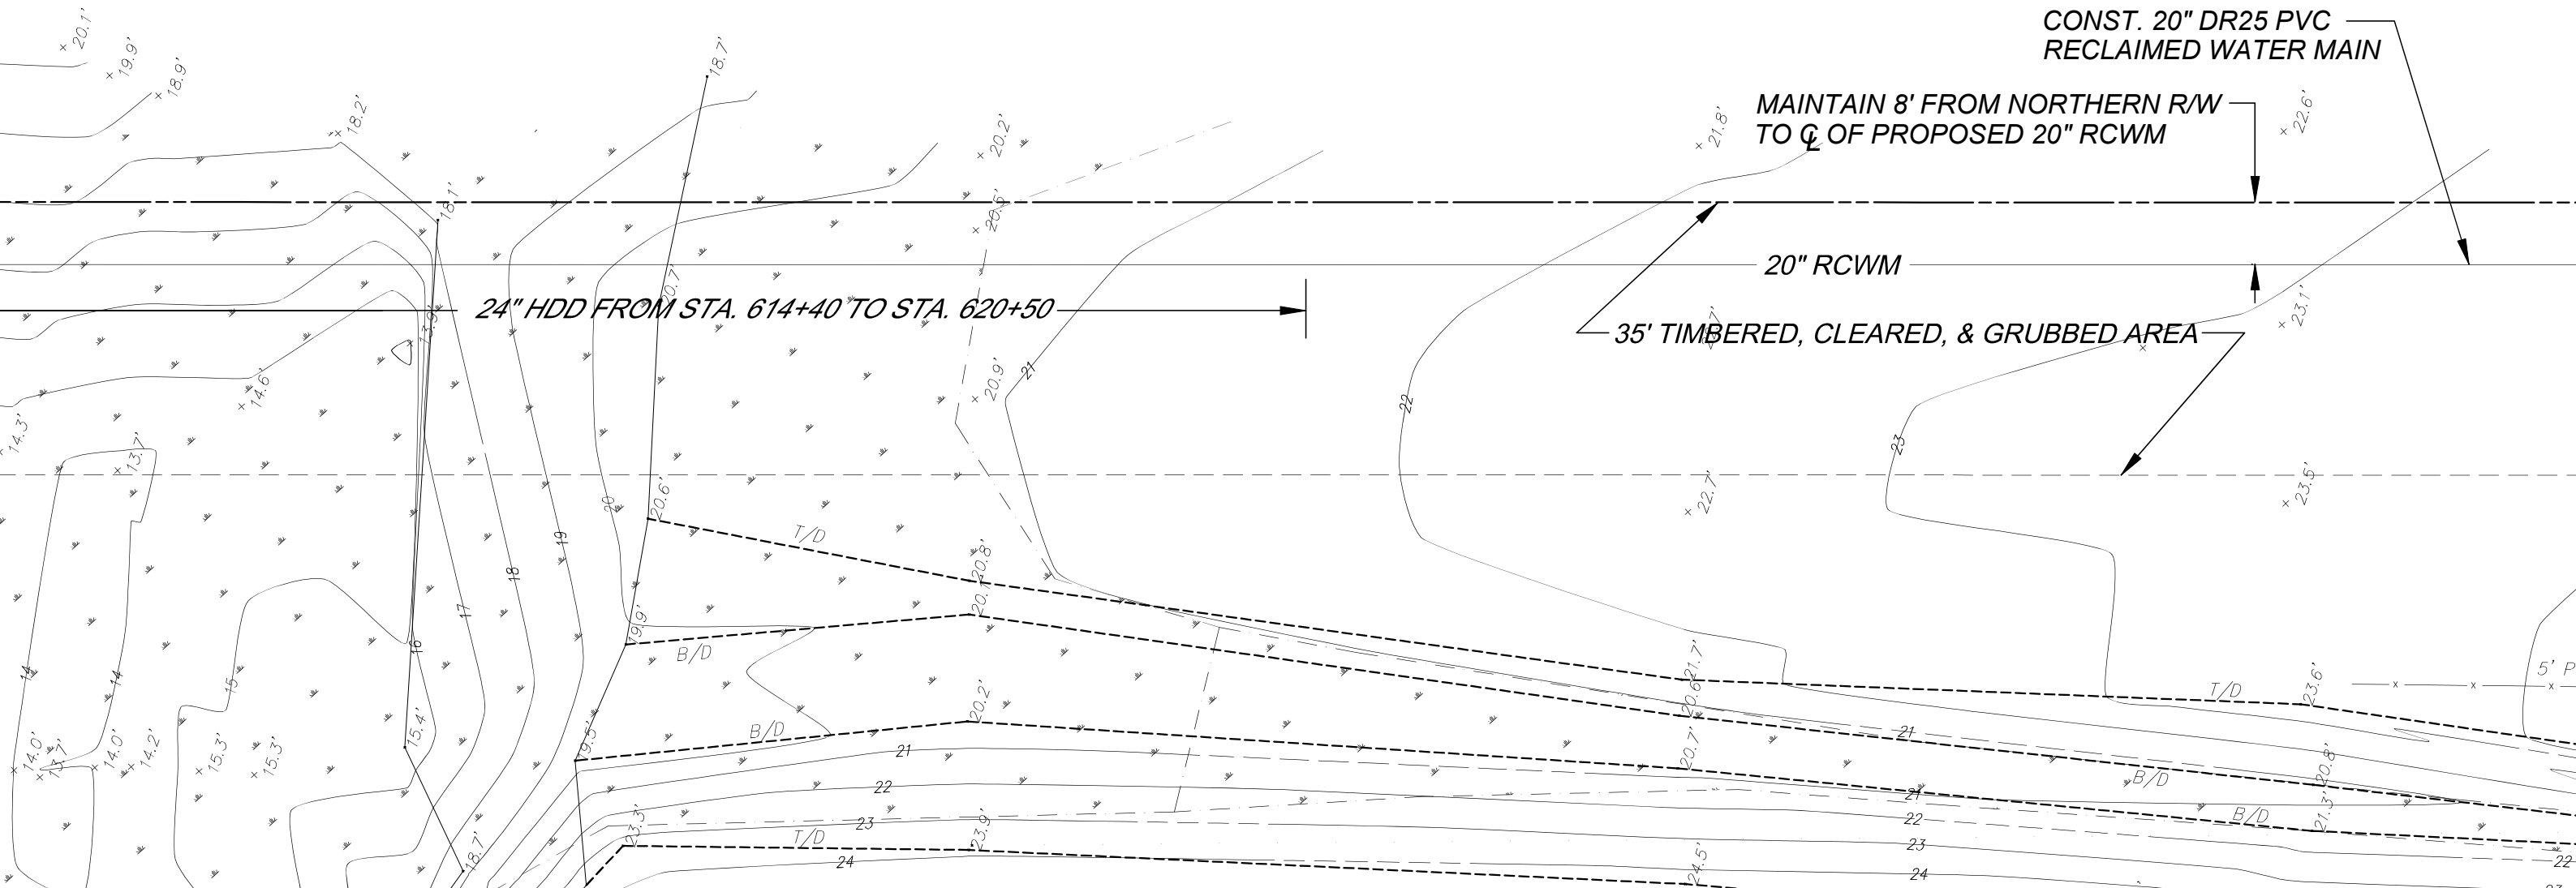

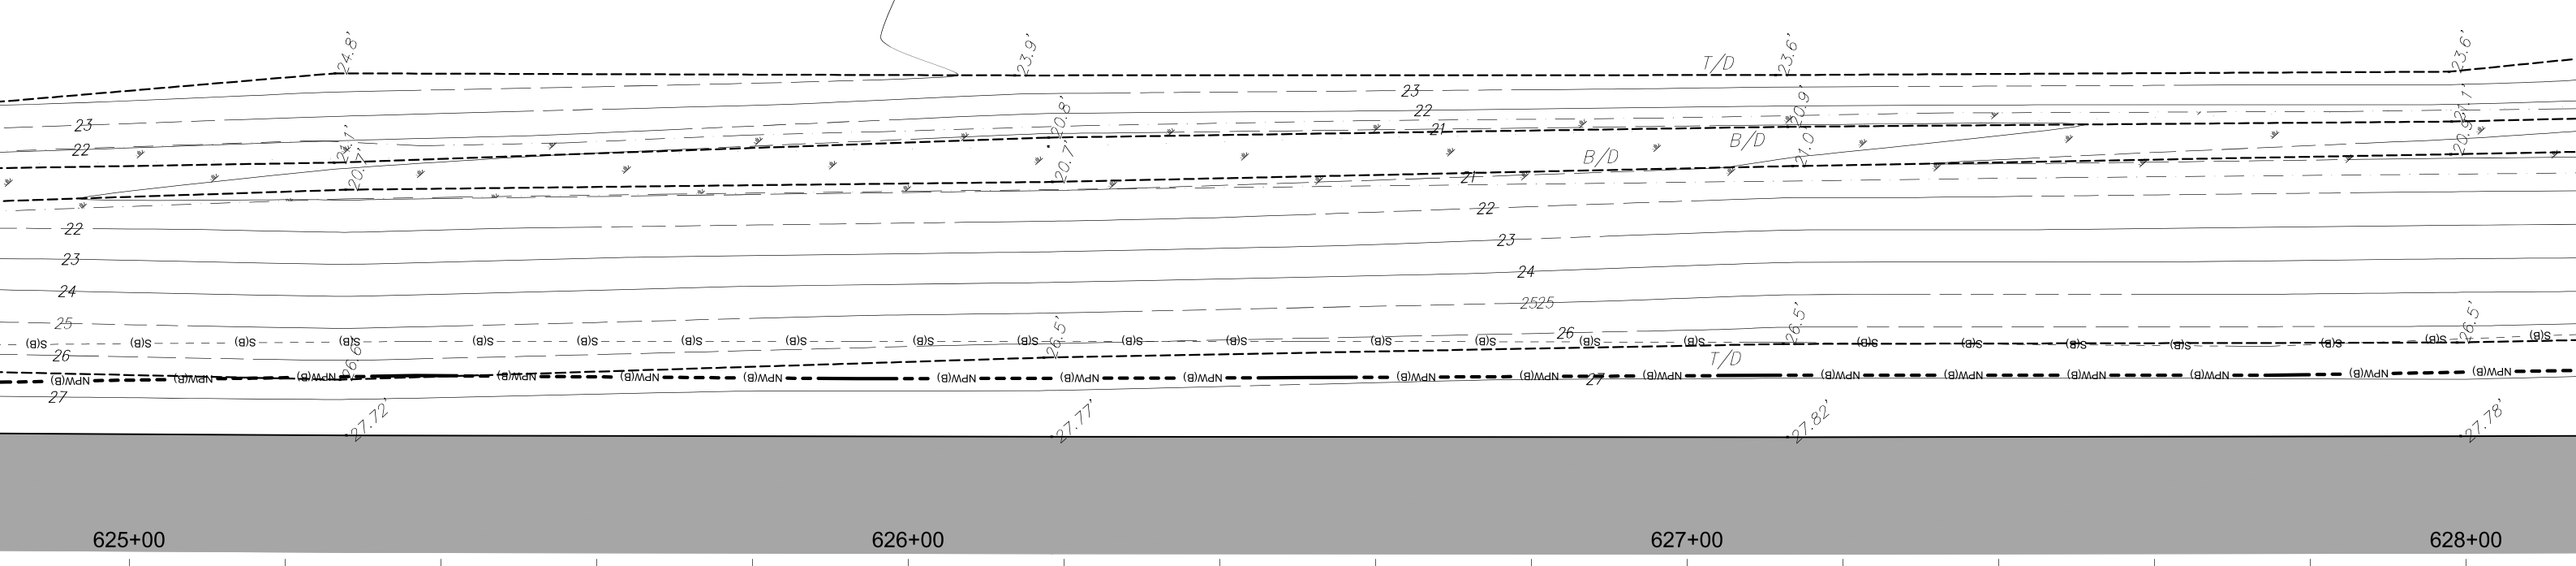



£ OF SURVEY

S 47° 53' 55" E

STATE ROAD No. 16
(200' R/W)

CURVE	
PI STA.	
DELTA	
D =	
T =	
L =	
R =	
PC STA.	
PT STA.	

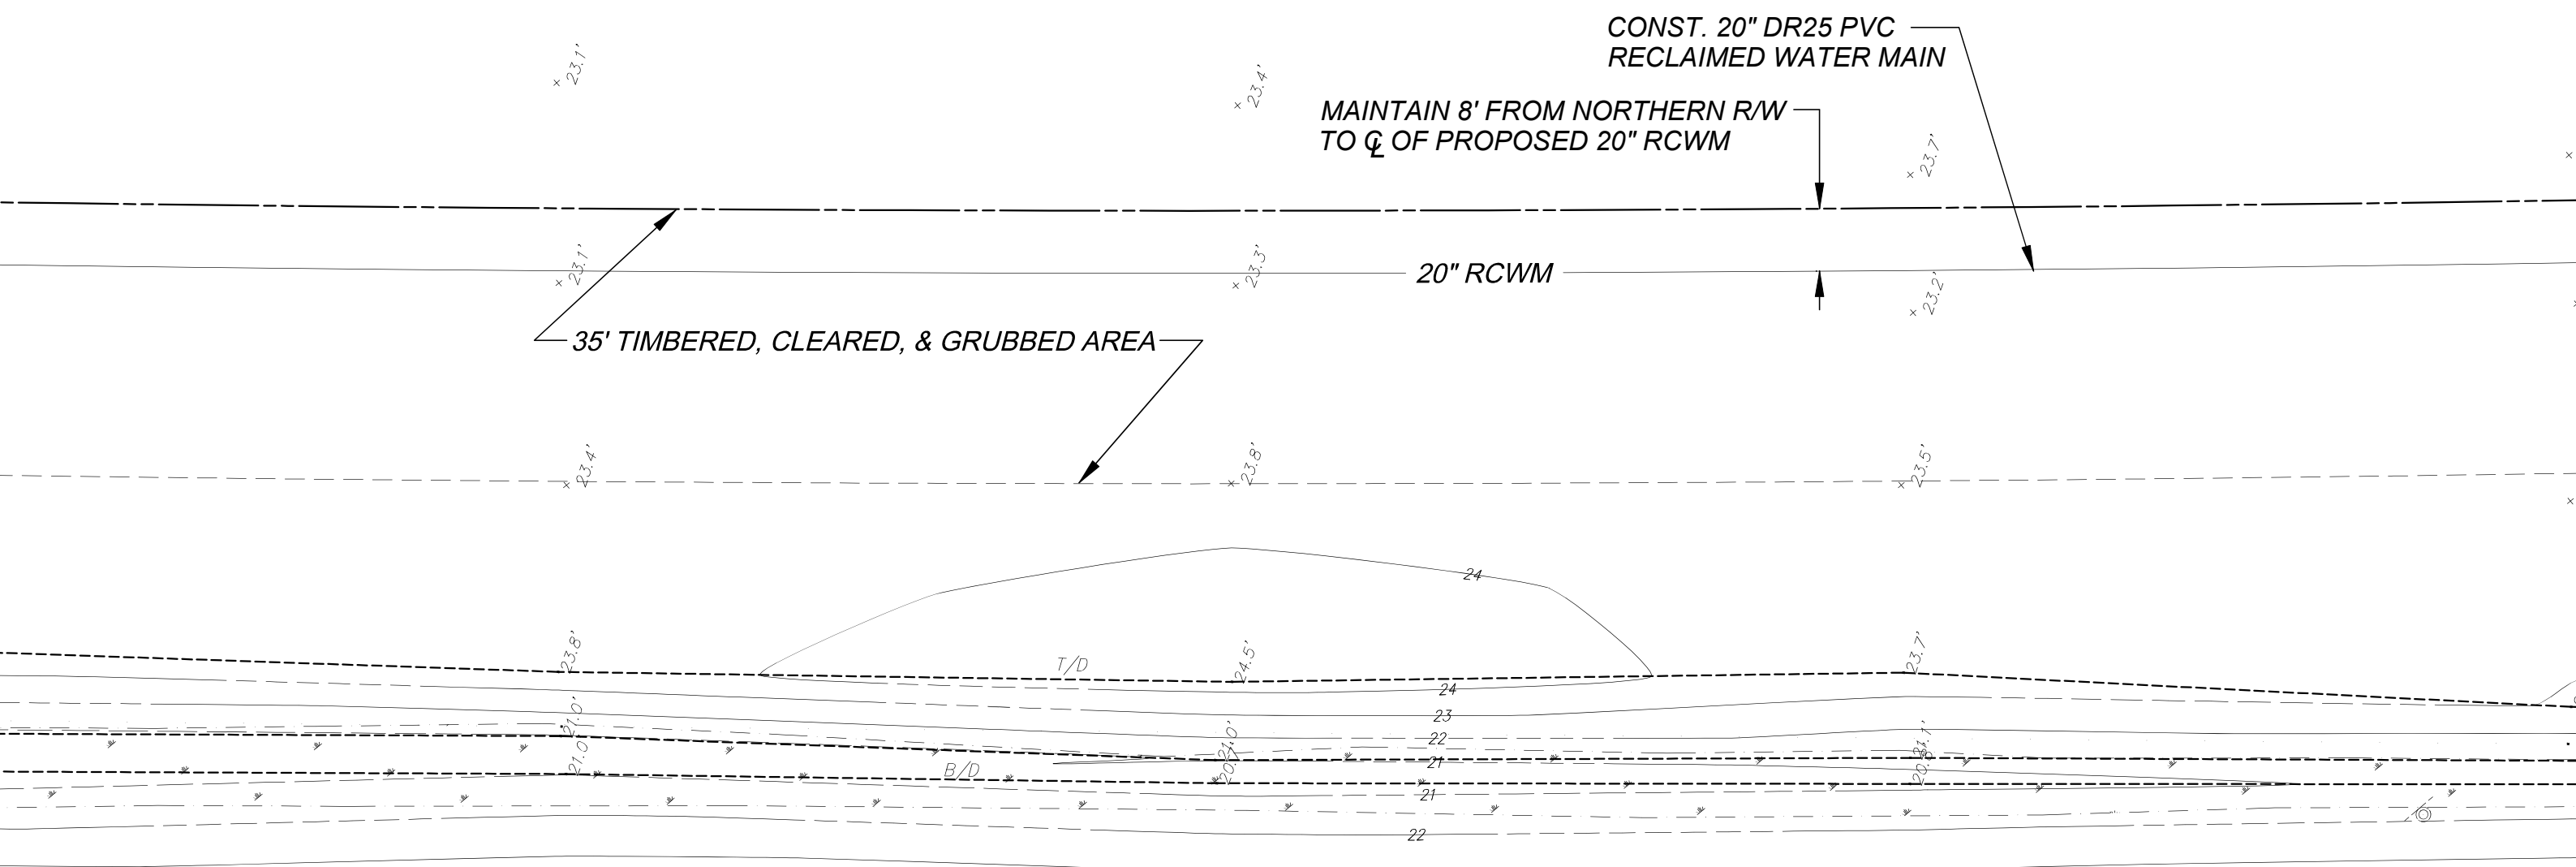



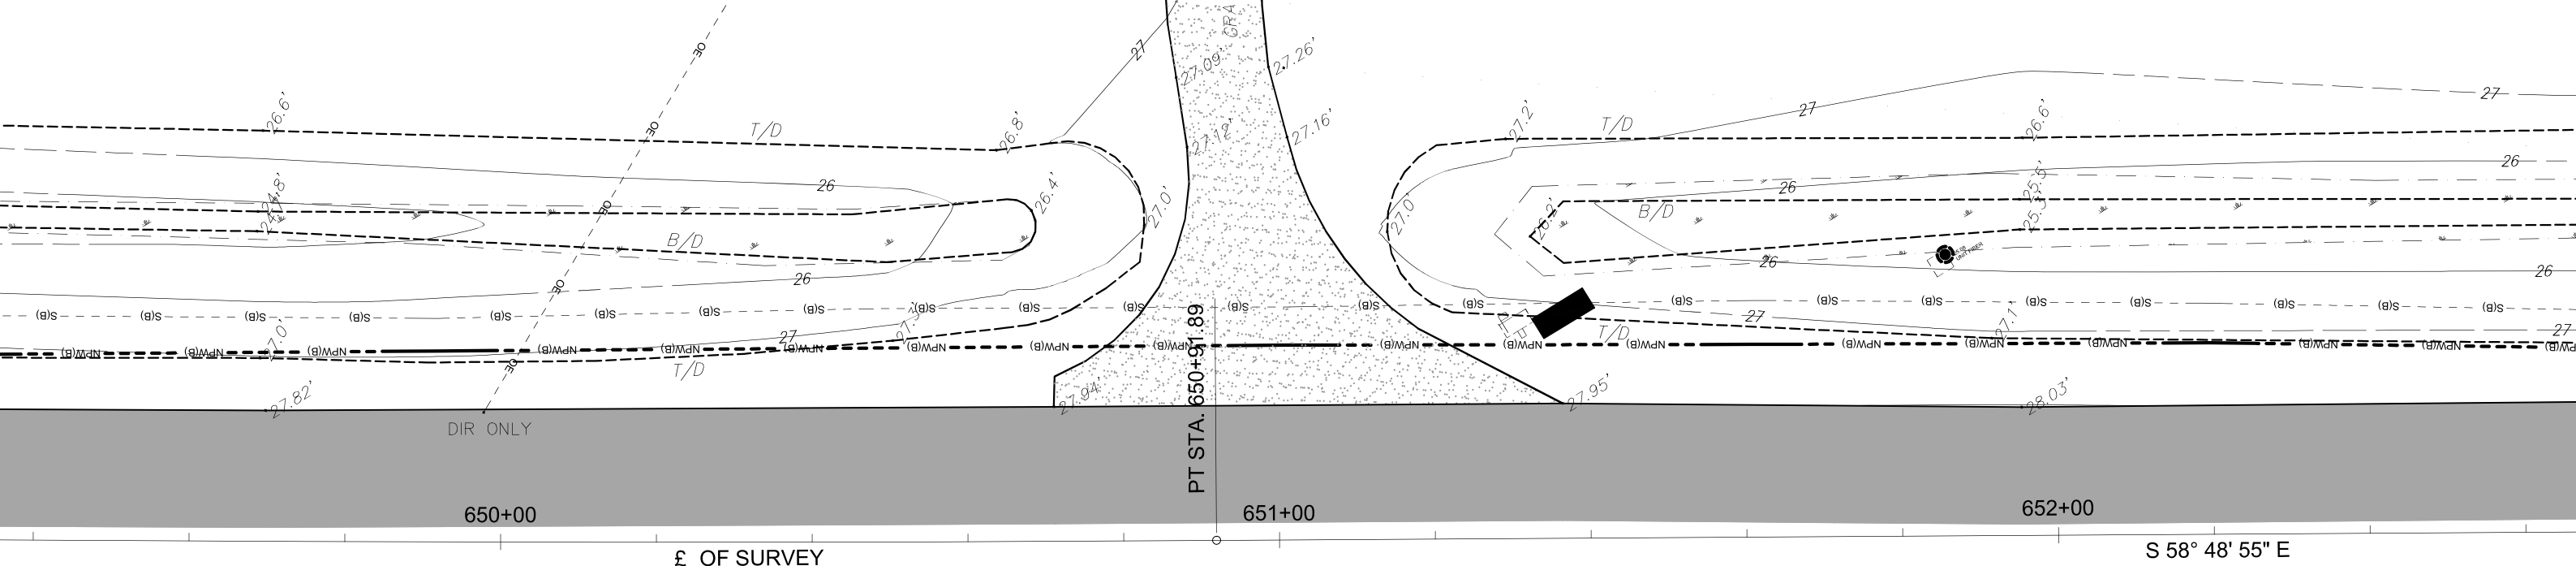




CURVE CL3
PI STA. = 640+03.54
DELTA = 10°55'00"
D = 00°30'00"
T = 1094.98'
L = 2183.34'
R = 11459.16'
PC STA. = 629+08.55
PT STA. = 650+91.89


STATE ROAD No. 16 (200' R/W)

CONTROL POINT **S22**
SET 5/8" IR W/ CAP "DRMP INC. TRAV"
N = 2041342.50
E = 513961.50

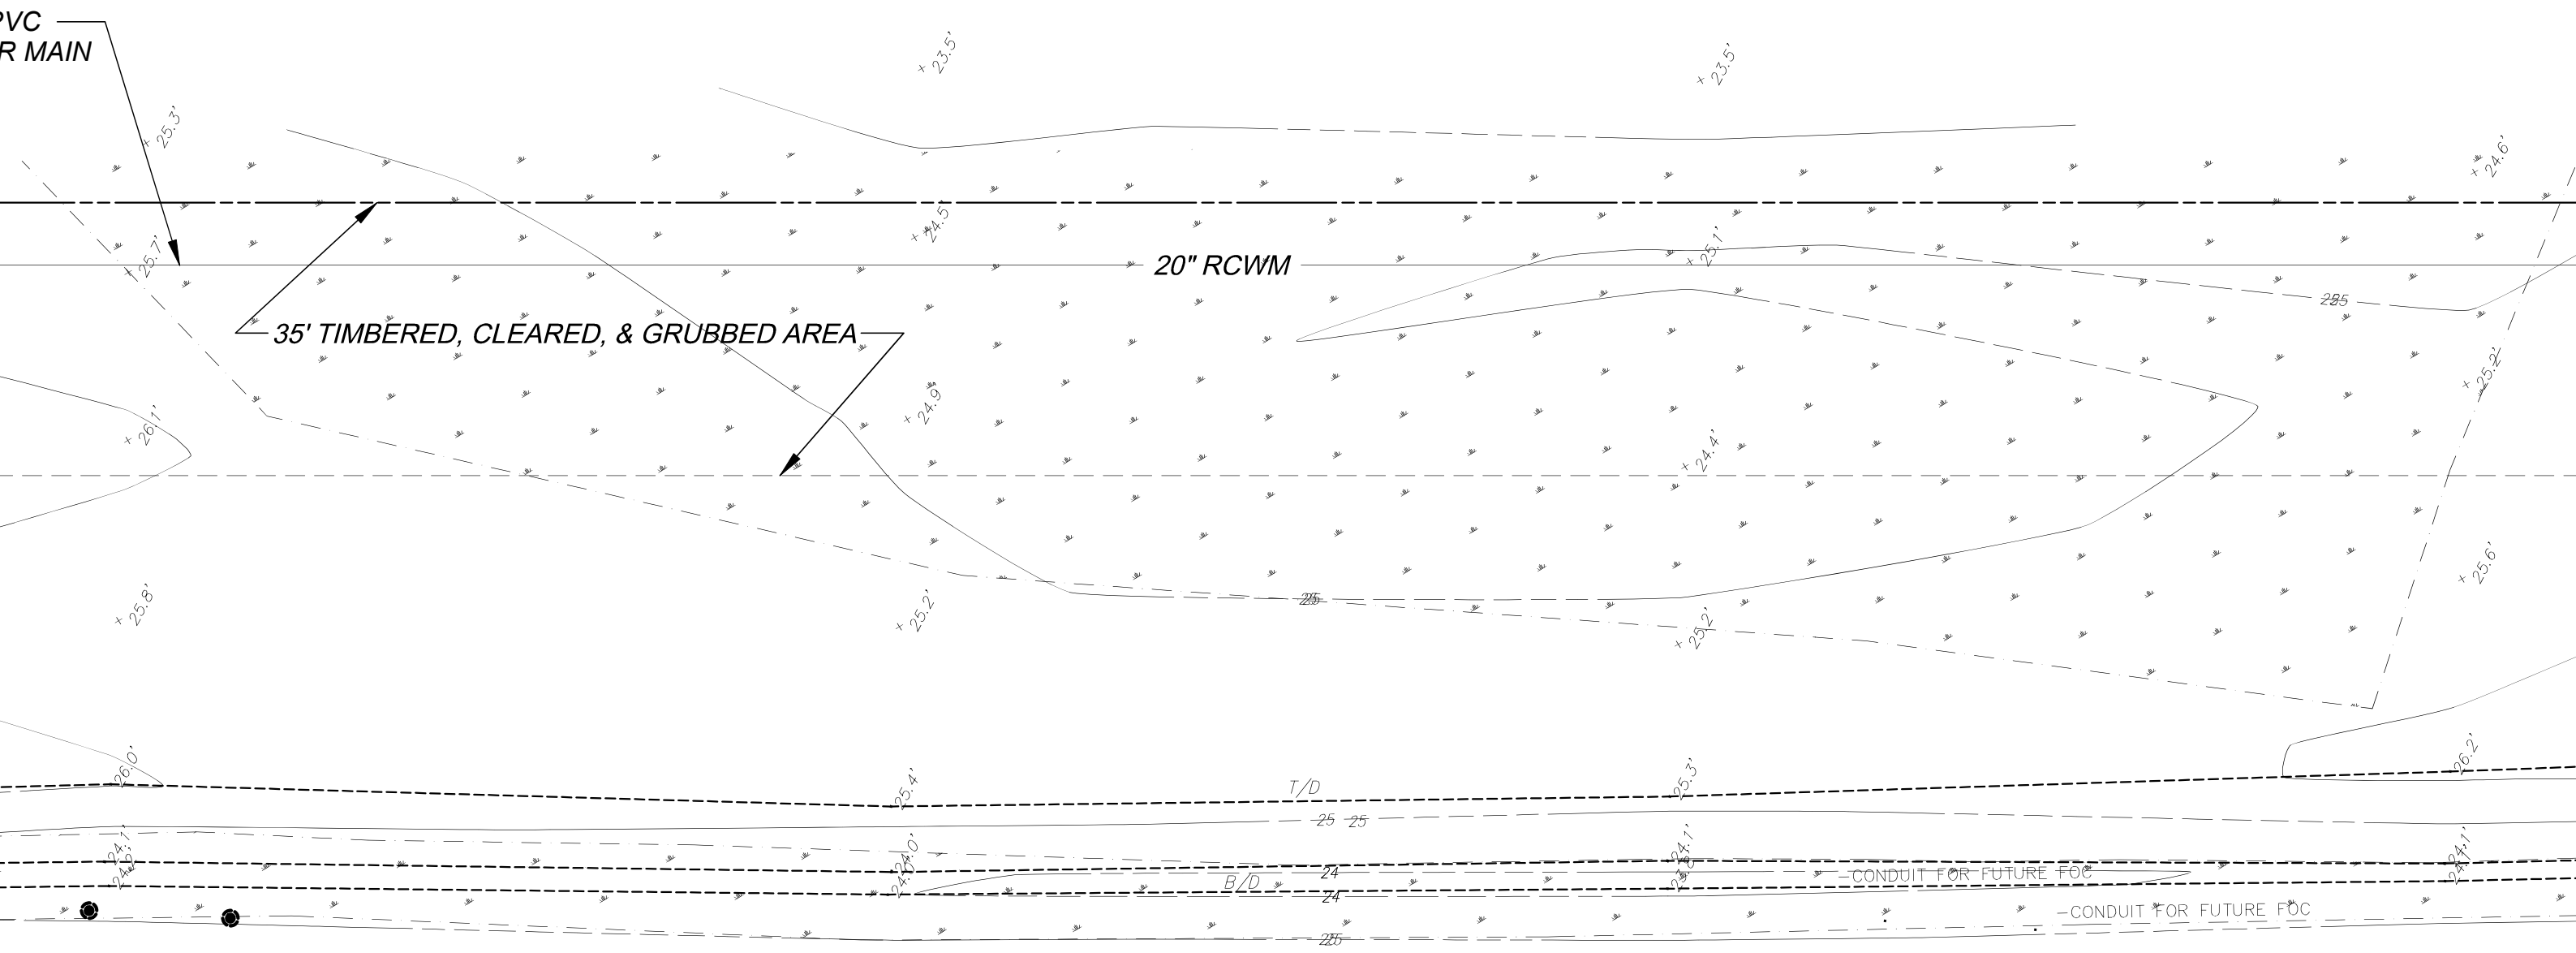

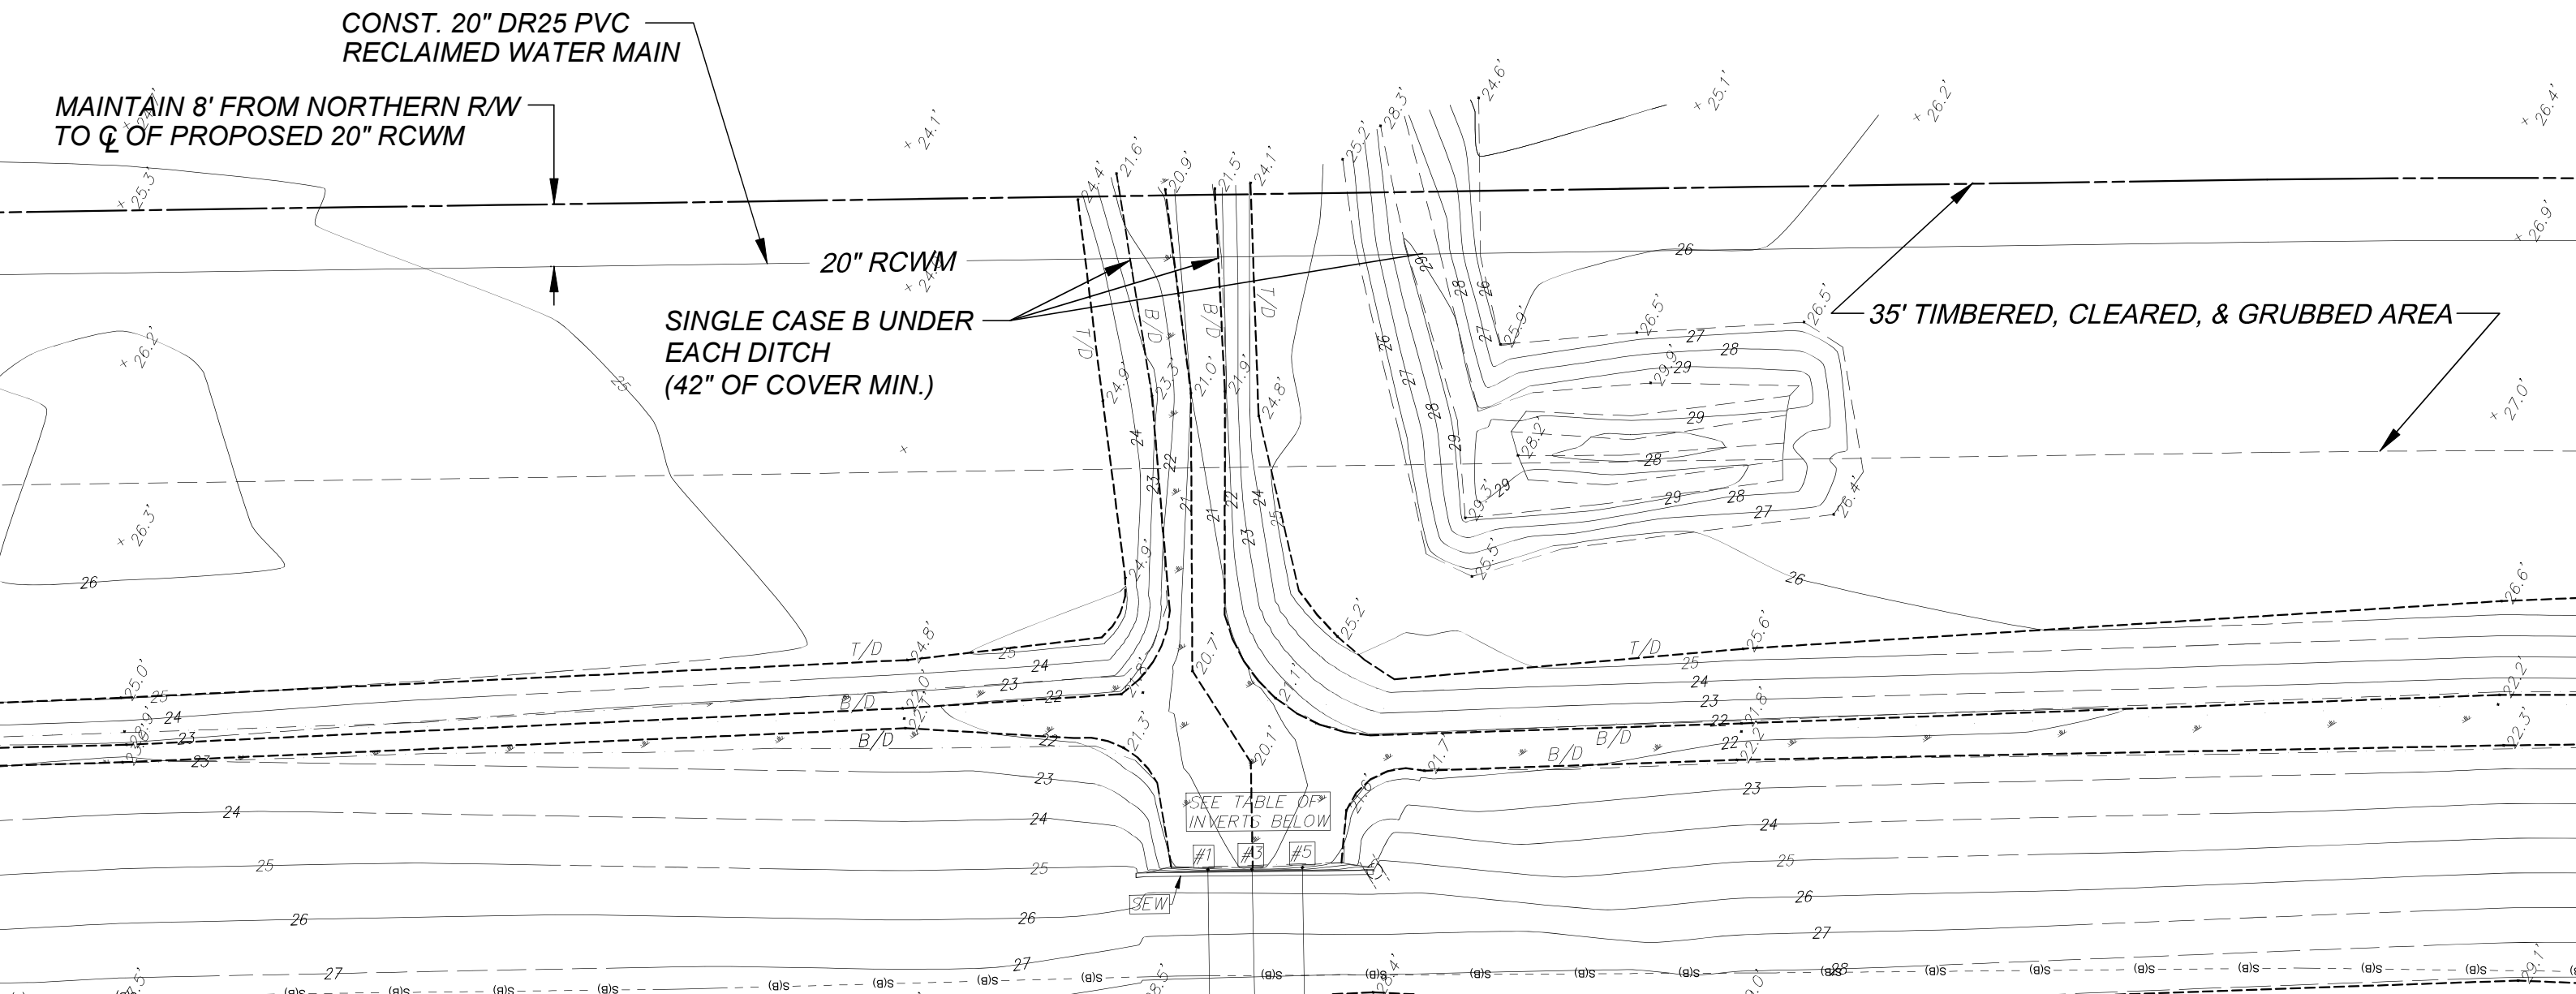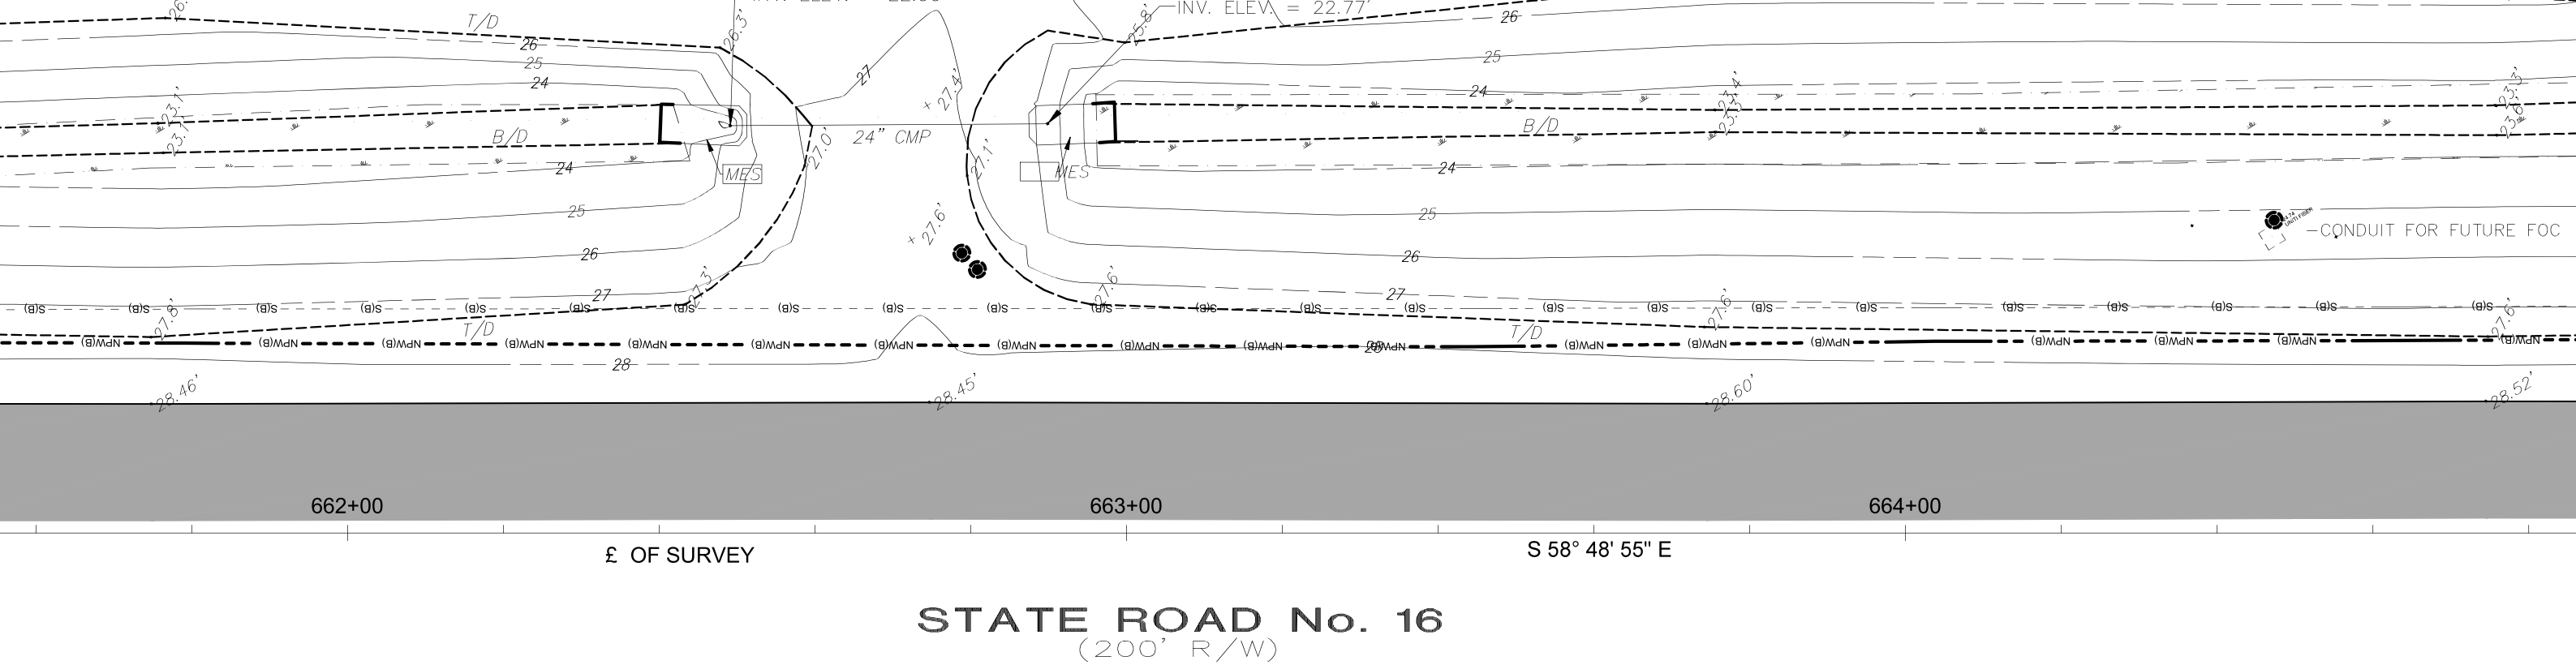

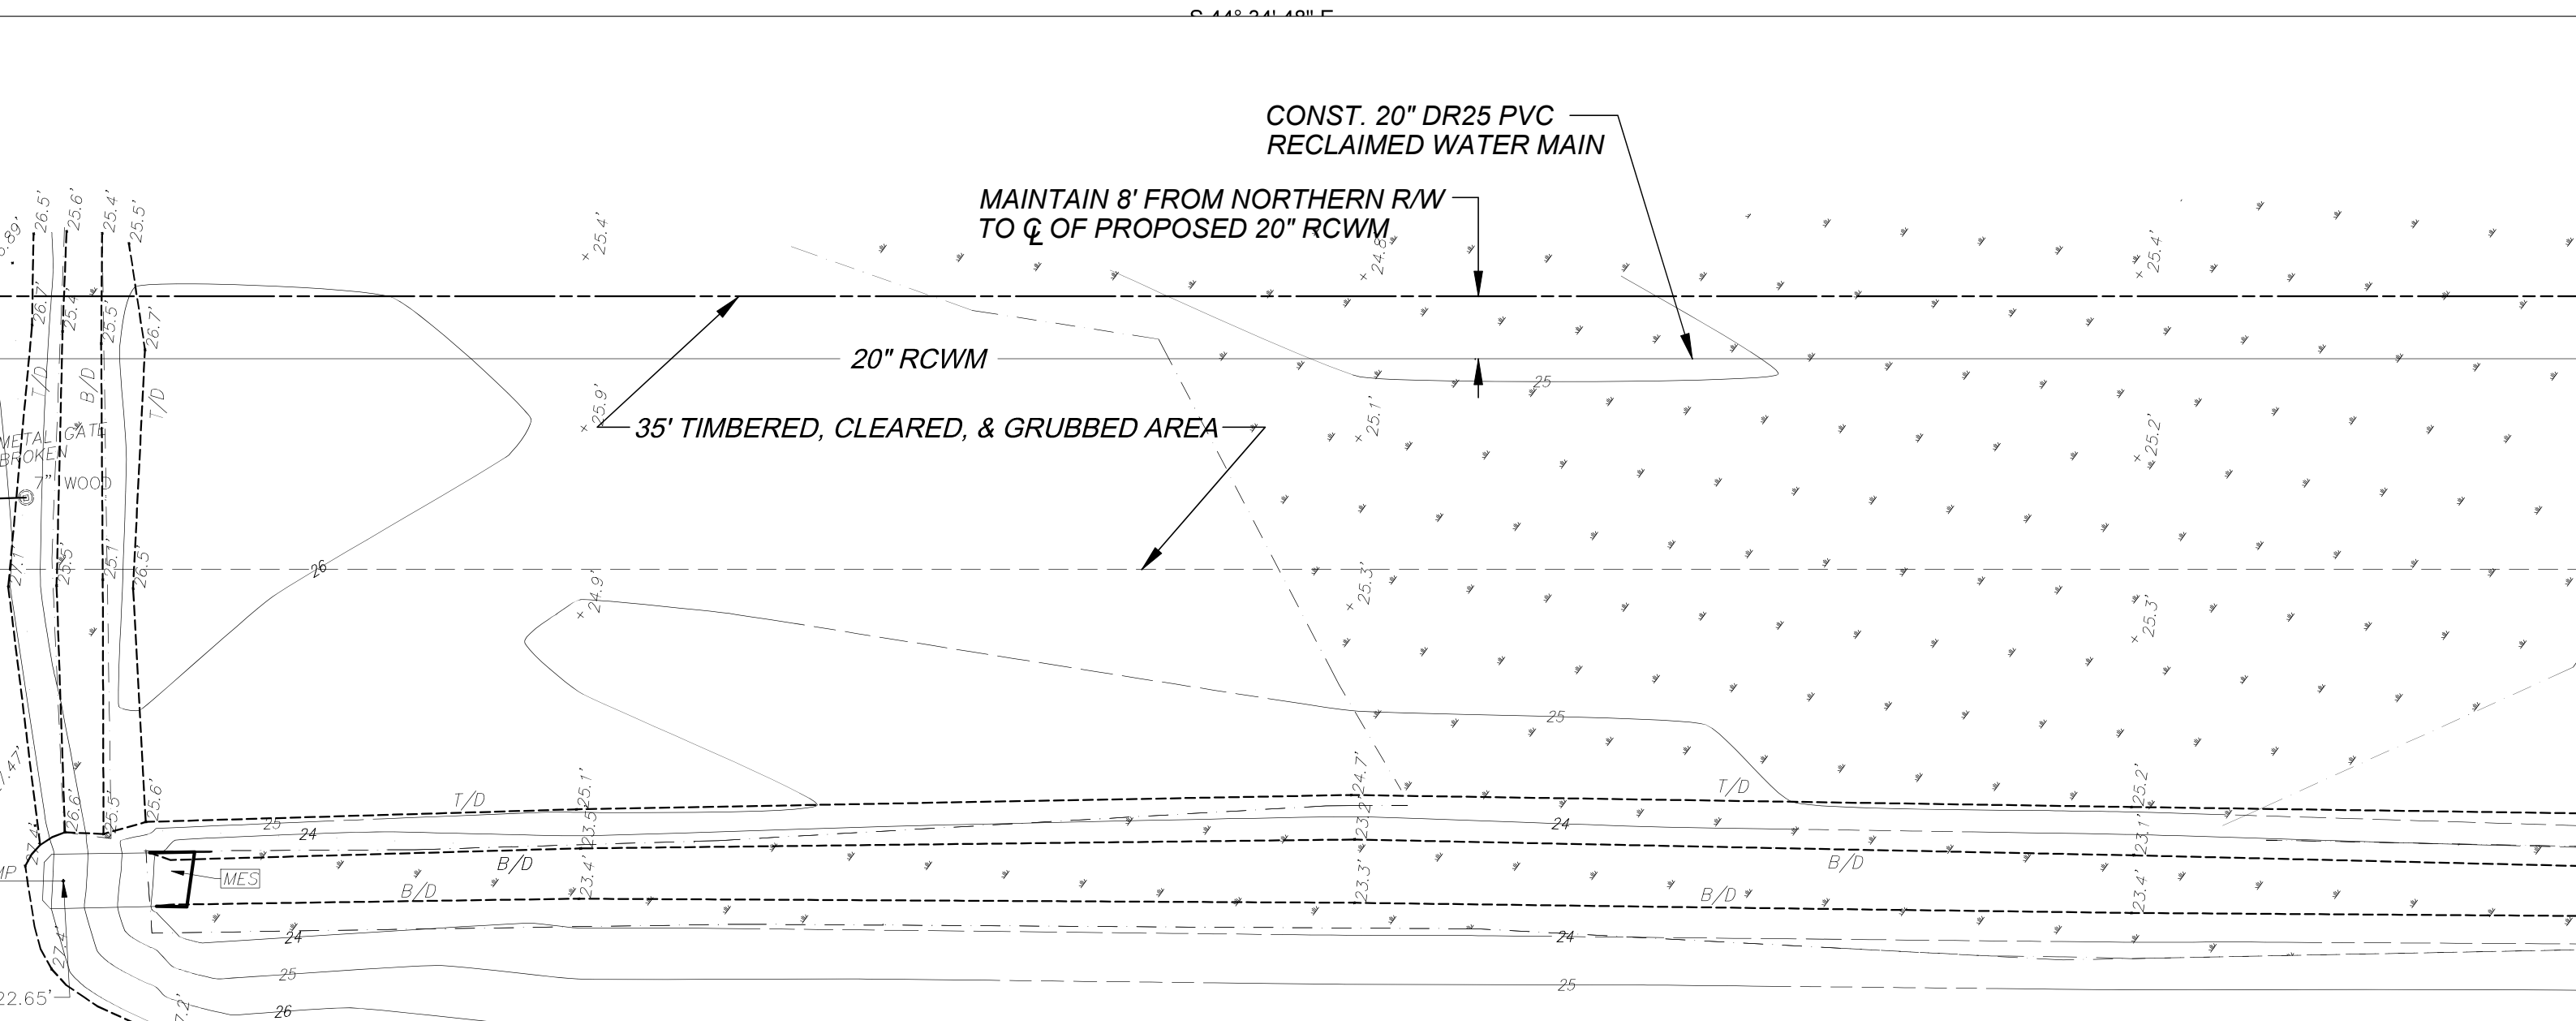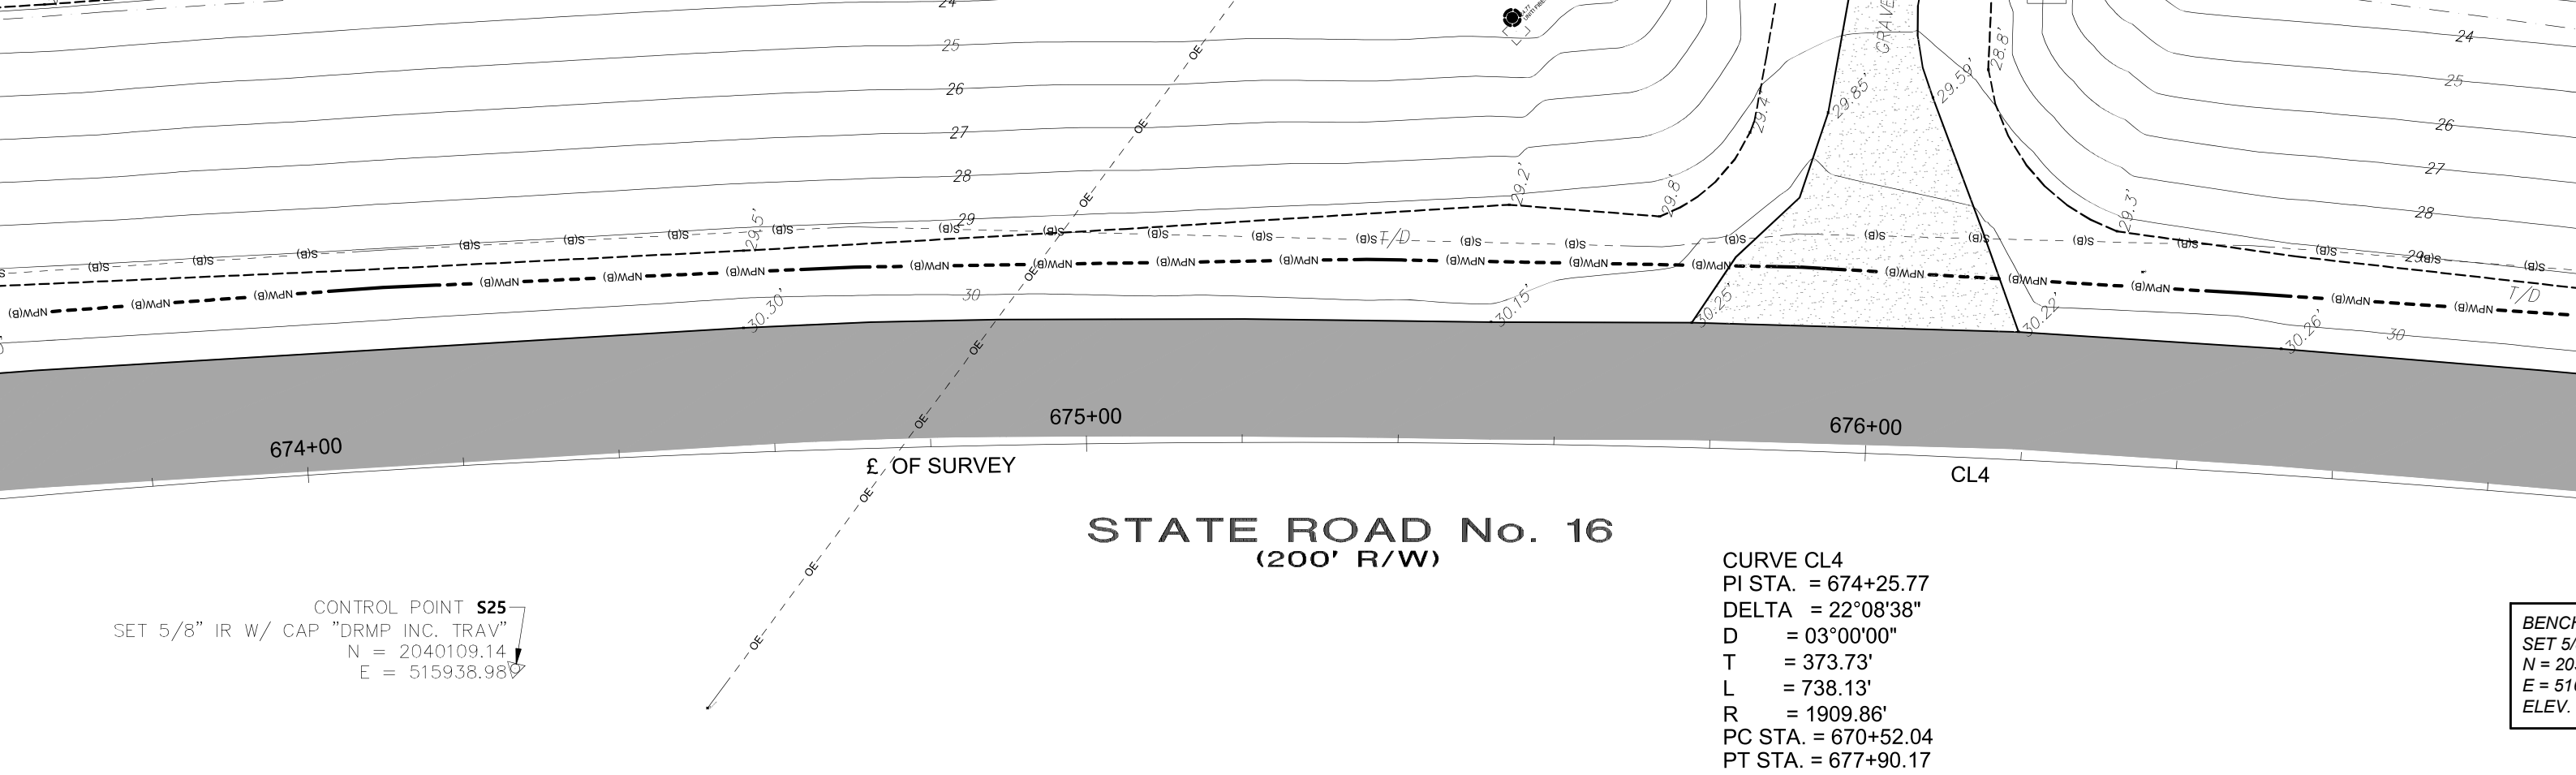

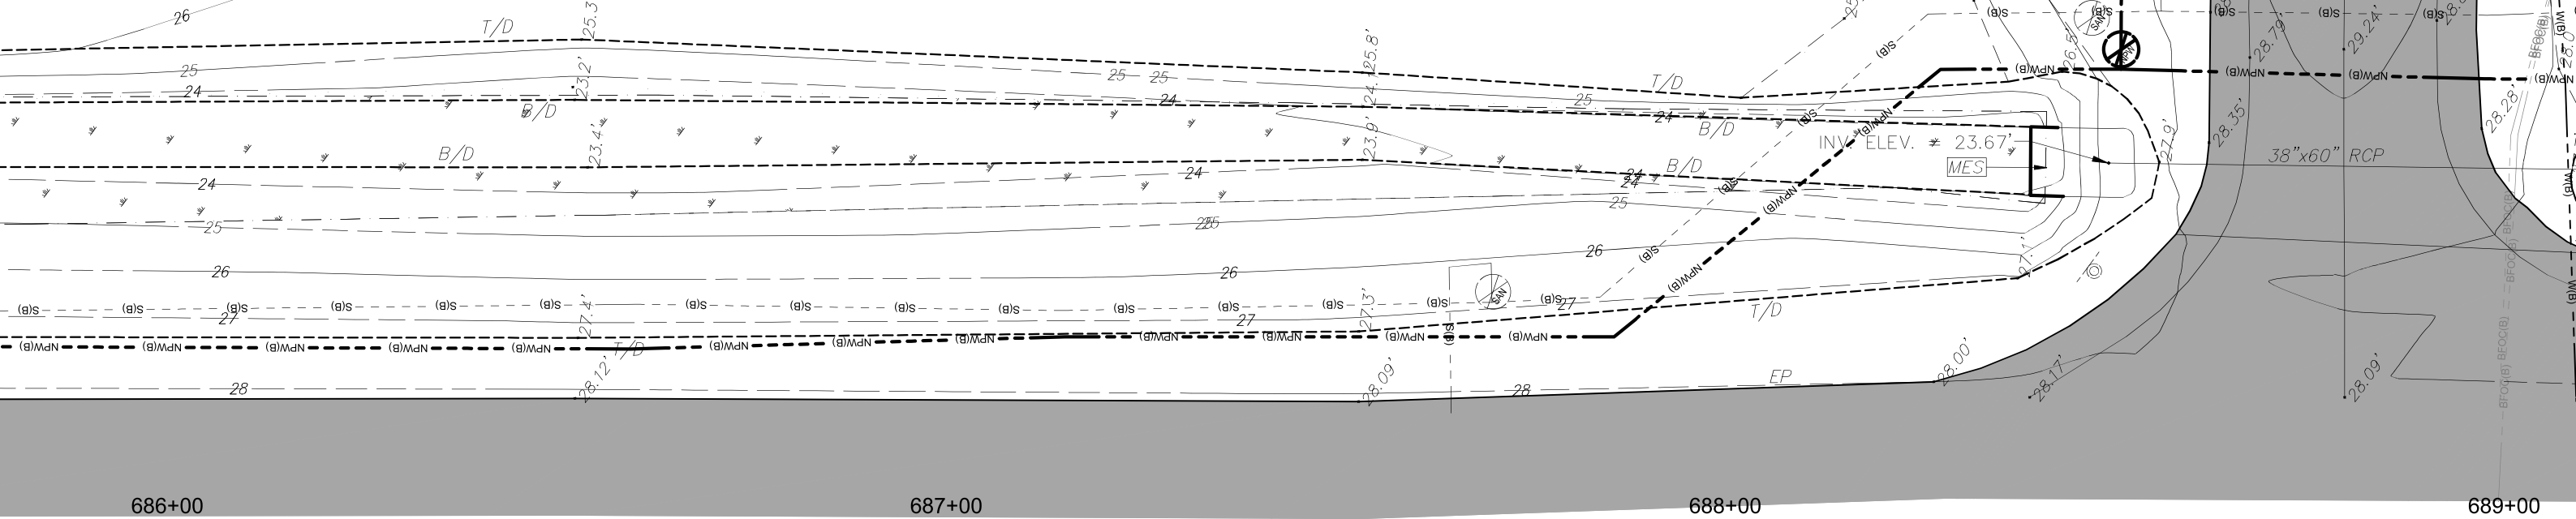


686+53 61.0'

⊗

BENCHMARK: BM13
SET NL W/ DISK STMP DRMP BENCHMARK TBM13
N = 2039130
E = 516668
ELEV. = 26.92' (NAVD88)

STATE ROAD No. 16
(200' R/W)


£ OF SURVEY S 36° 40' 17" E

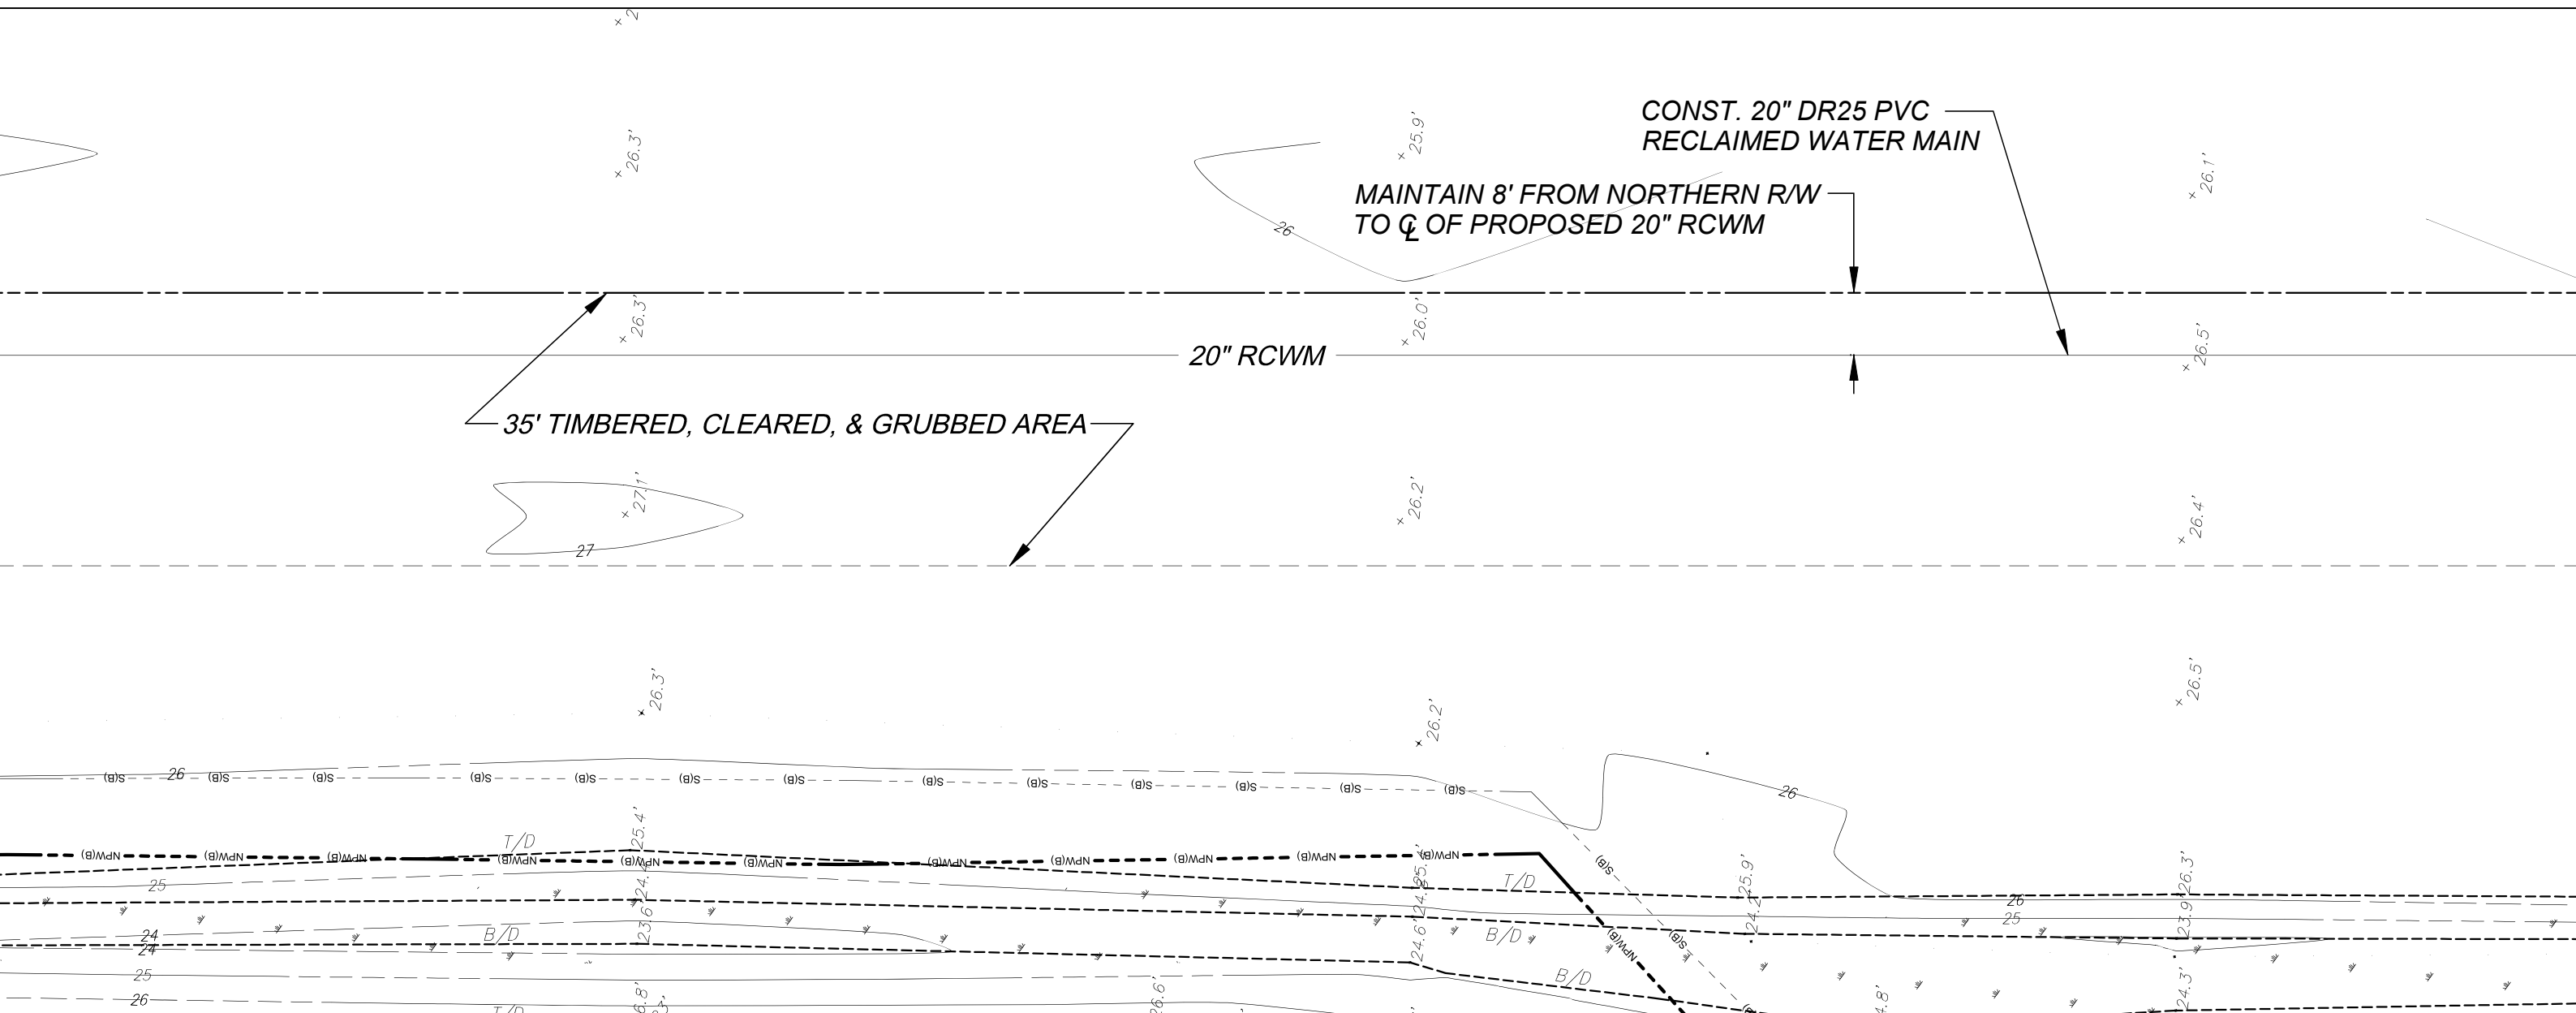




STATE ROAD No. 16
(200' R/W)


CONTROL POINT **S28**
SET 5/8" IR W/ CAP "DRMP INC. TRAV"
N = 2038152.89
E = 517427.52

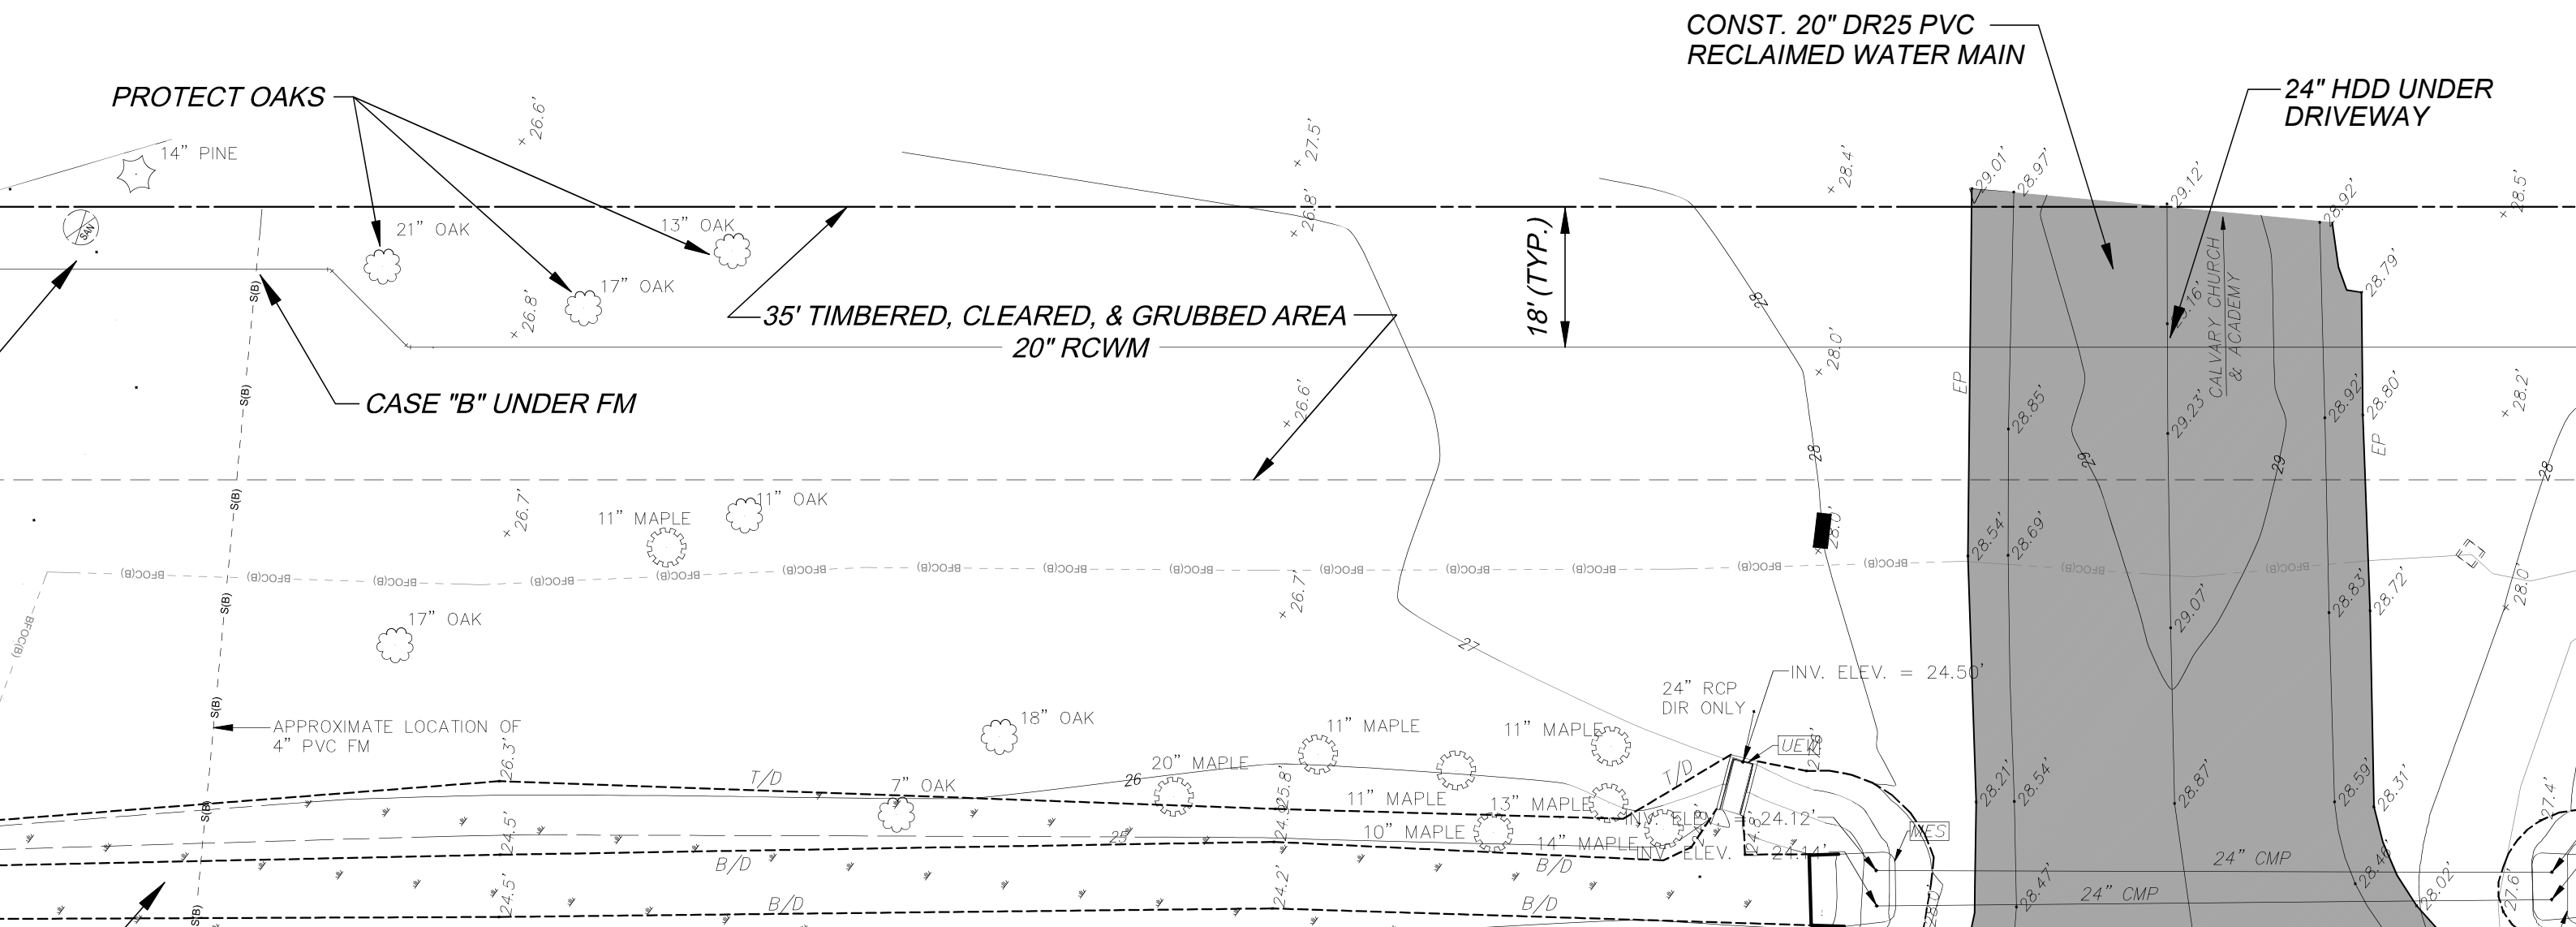


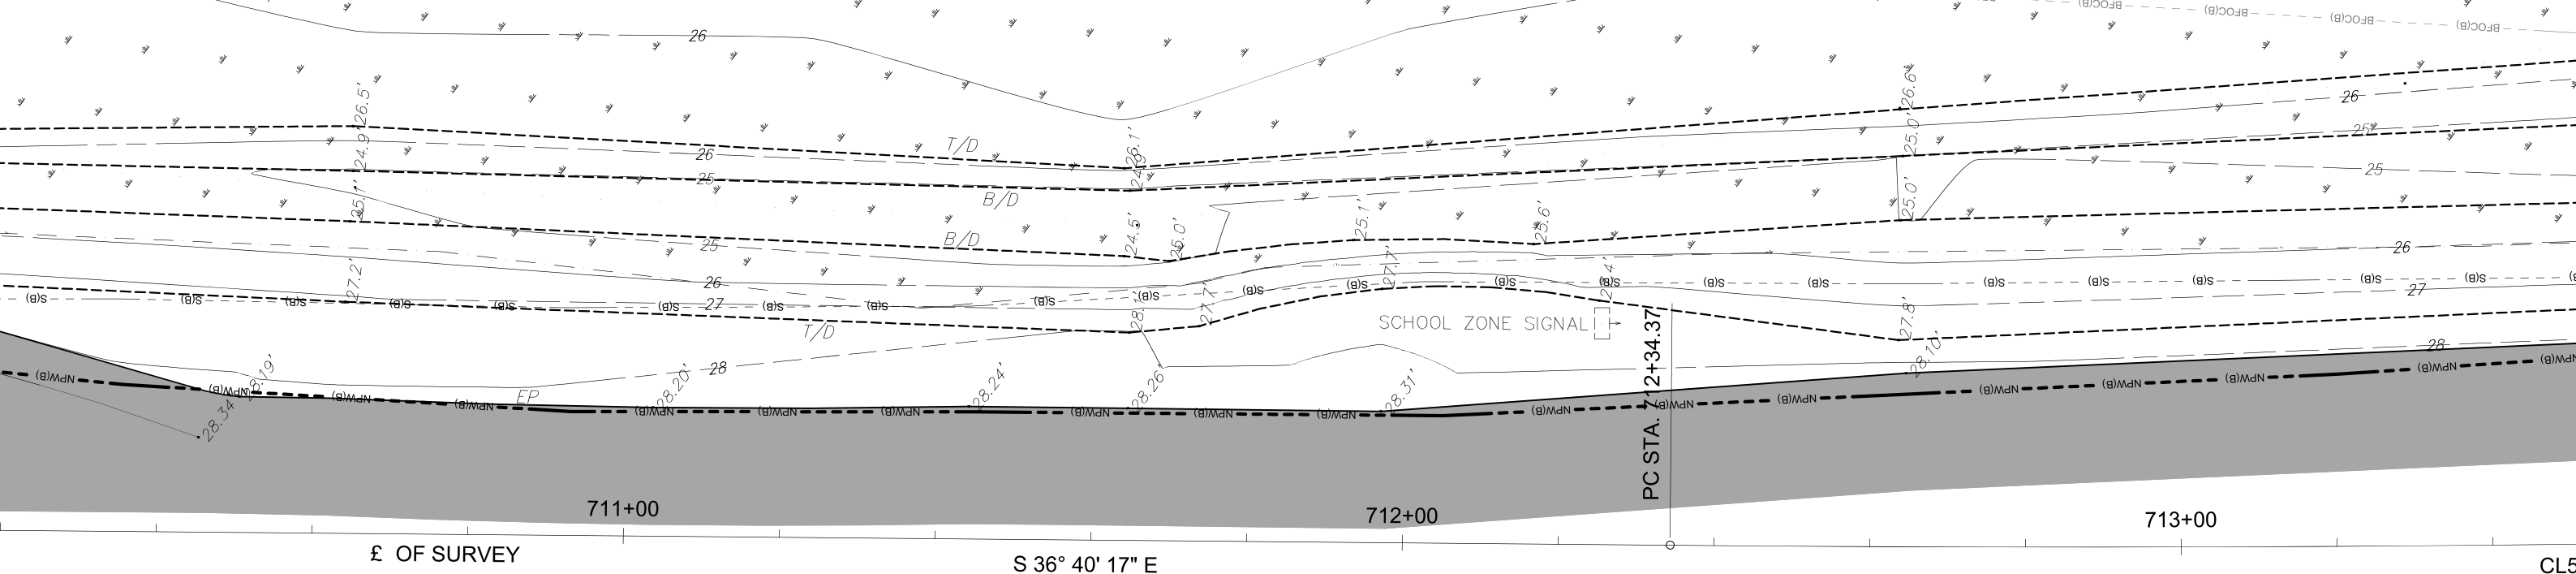

STATE ROAD No. 16
(200' R/W)

CONTROL POINT **S30**
SET 5/8" IR W/ CAP "DRMP INC. TRAV"
N = 2037065.94
E = 518243.40

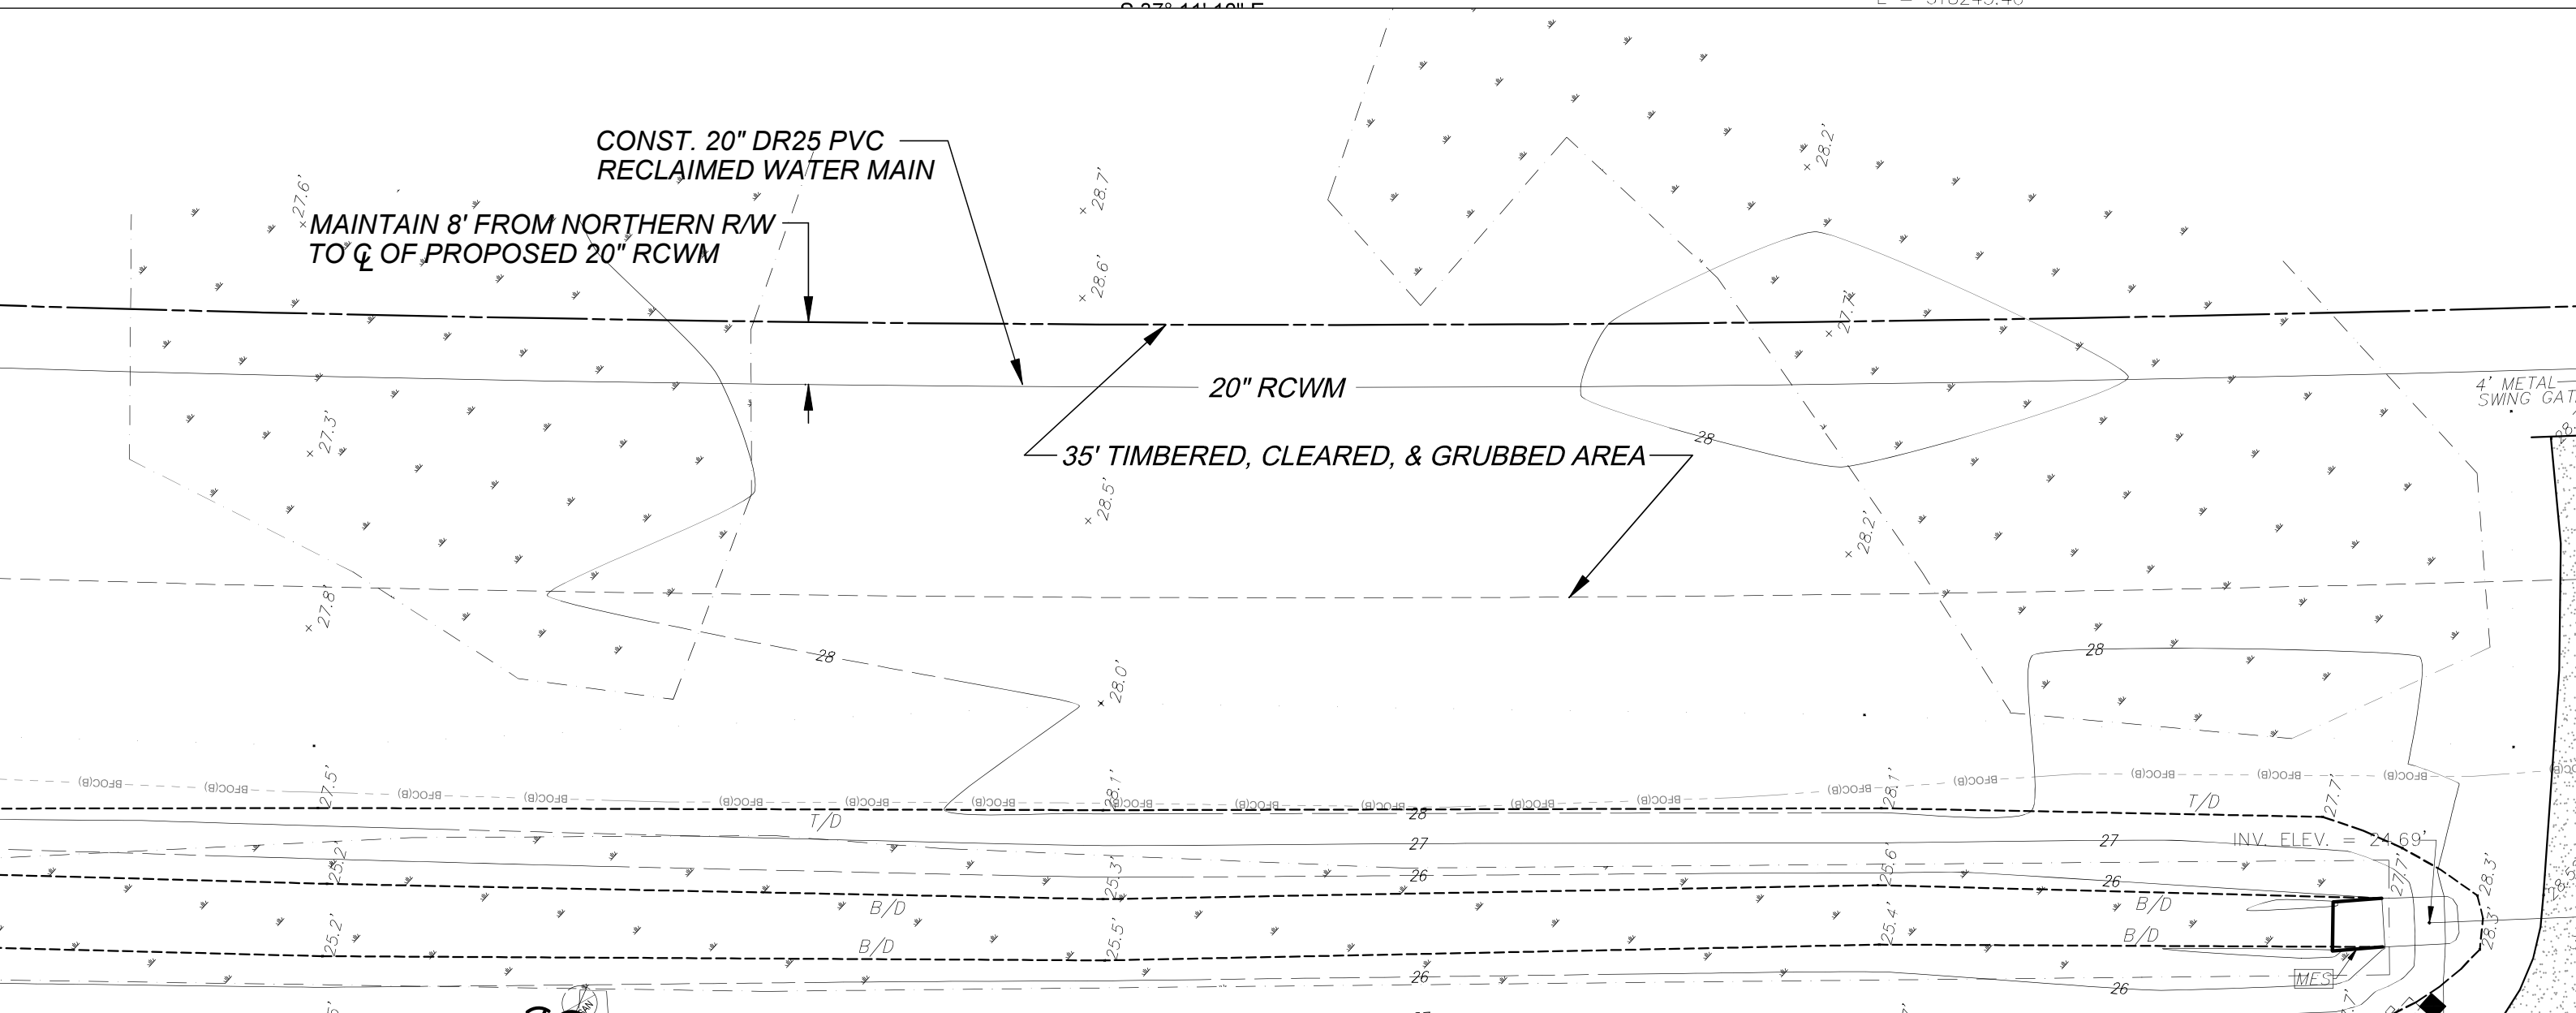

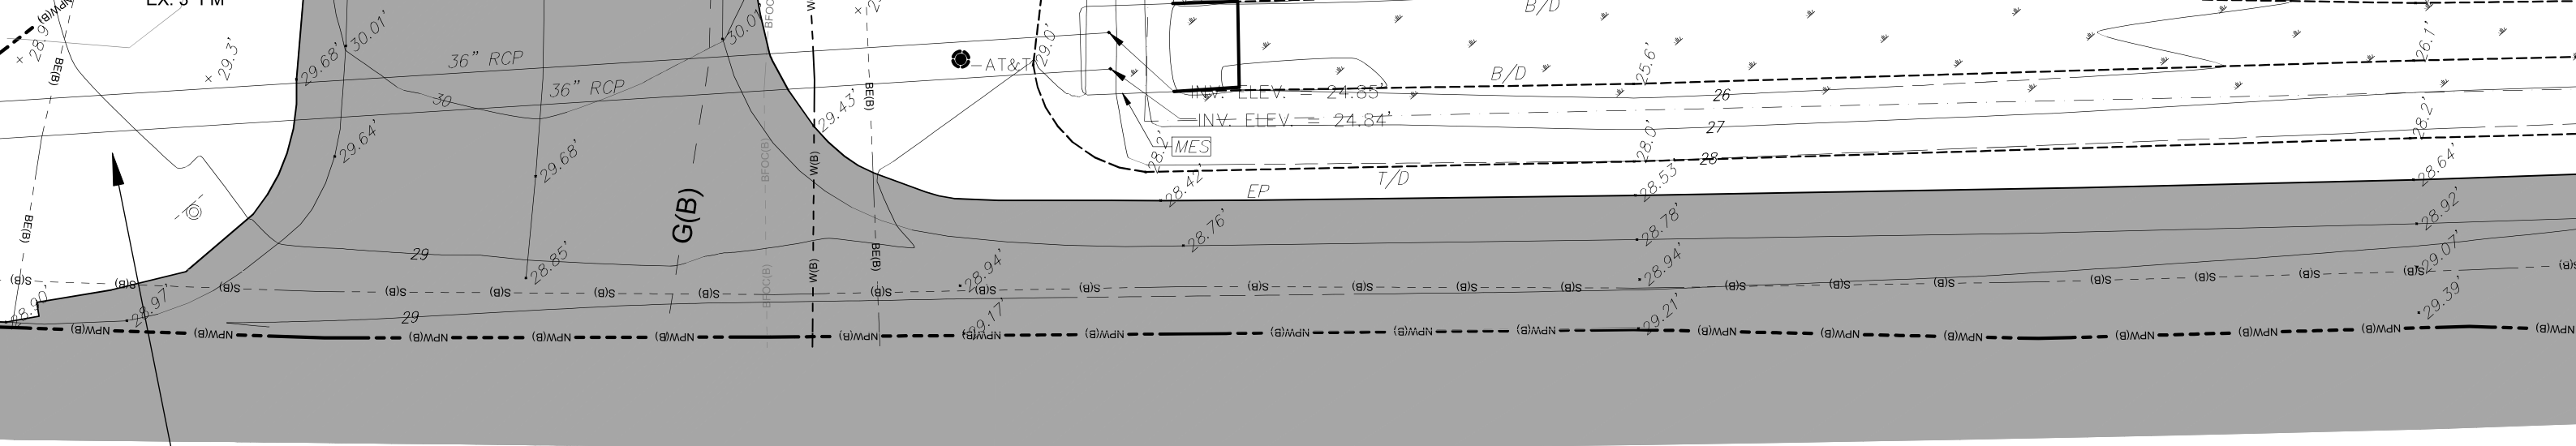

723+00

724+00

725+00


£ OF SURVEY


CL5

CURVE CL5
PI STA. = 722+11.00
DELTA = 19°20'48"
D = 01°00'00"
T = 976.63'
L = 1934.67'
R = 5729.58'
PC STA. = 712+34.37
PT STA. = 731+69.04

FOR UTILITY CONNECTIONS
IN THIS AREA
SEE DETAIL EE & SHEET 22

STATE ROAD No. 16
(200' R/W)

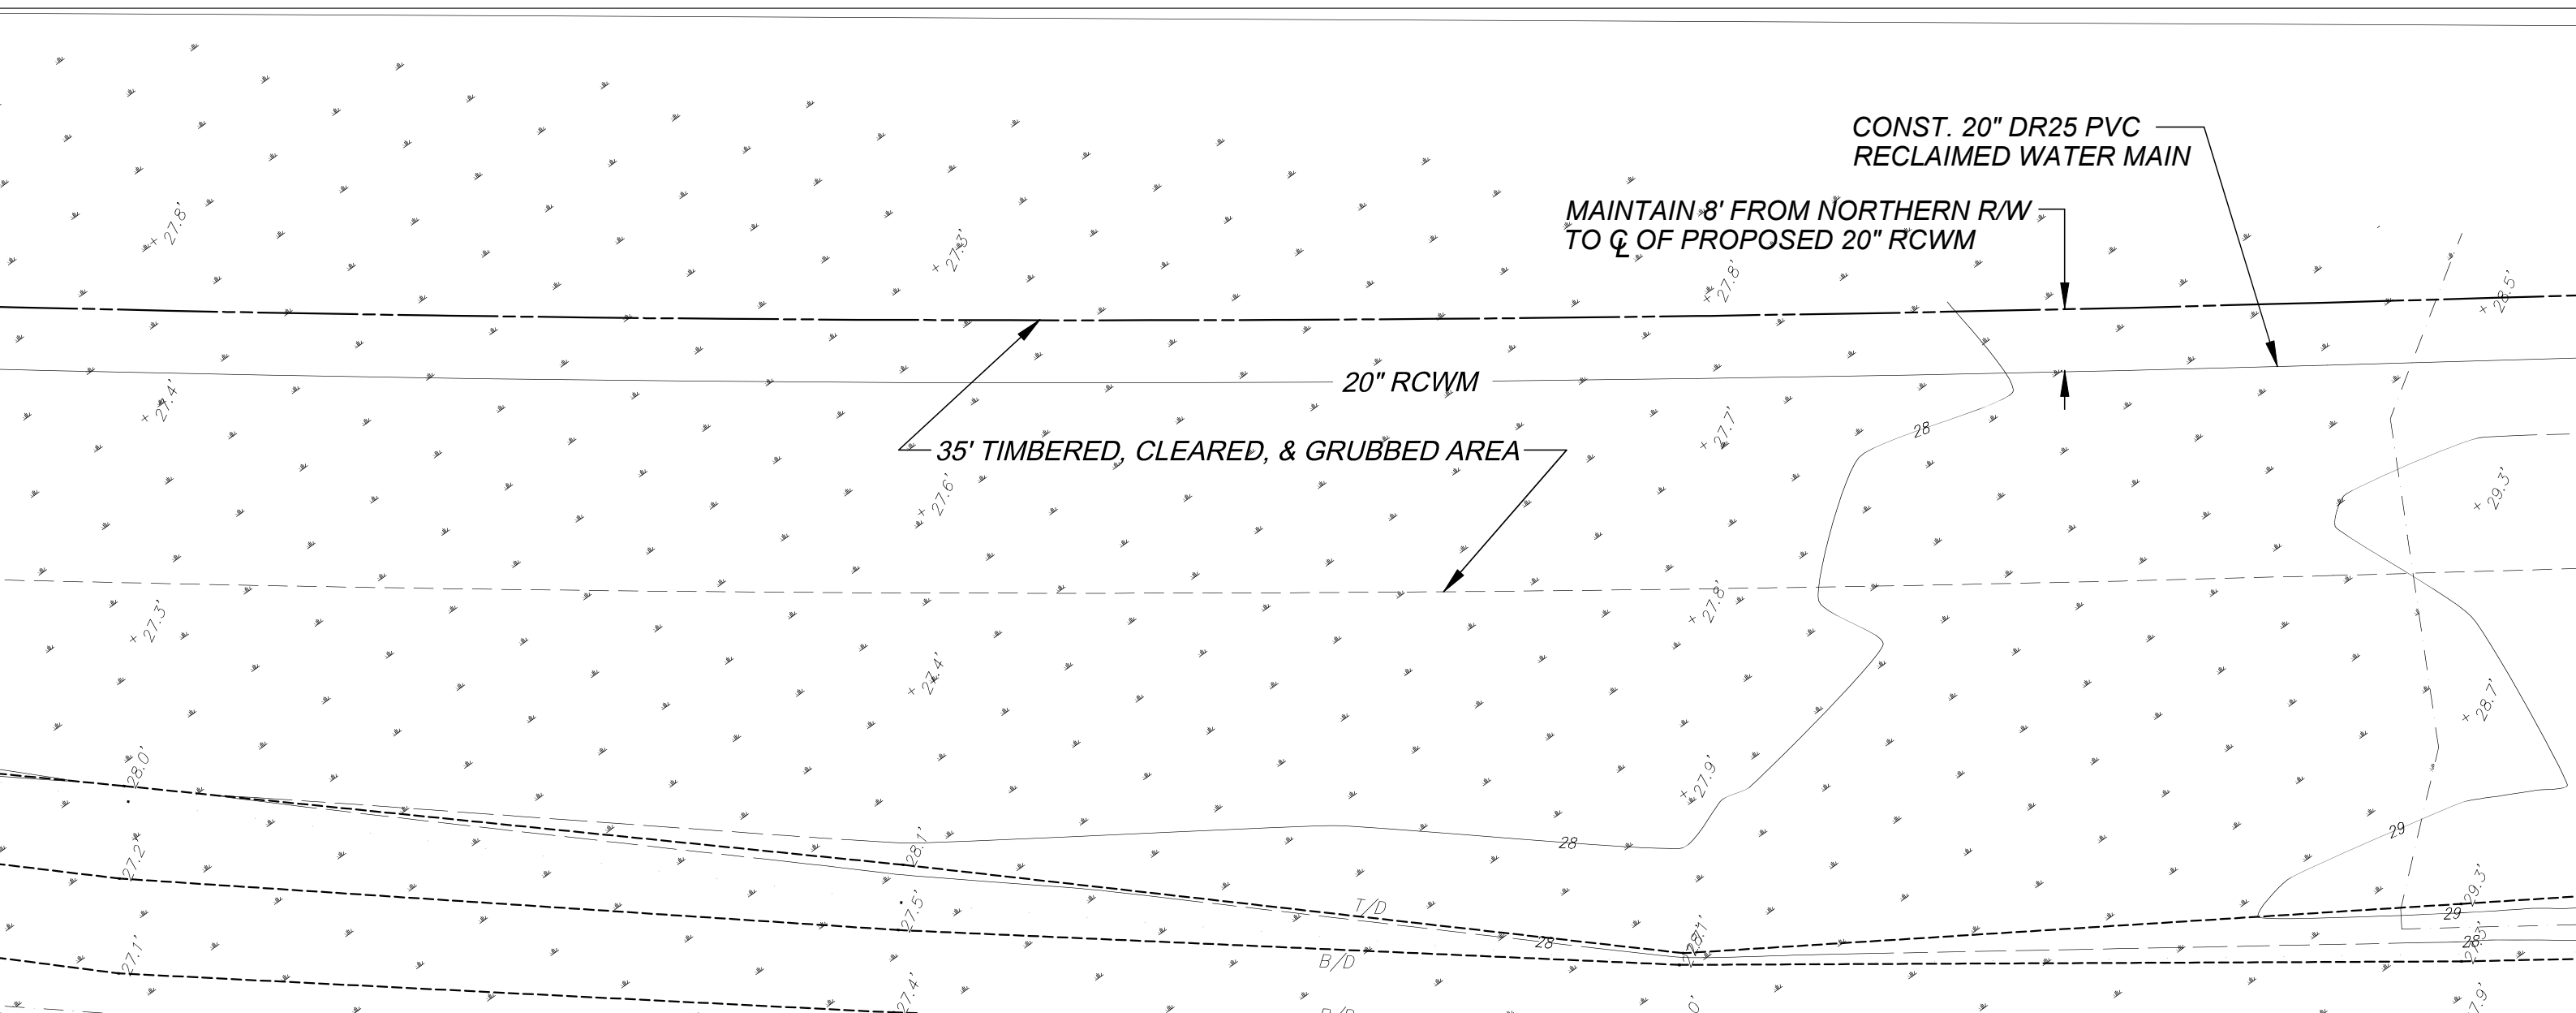



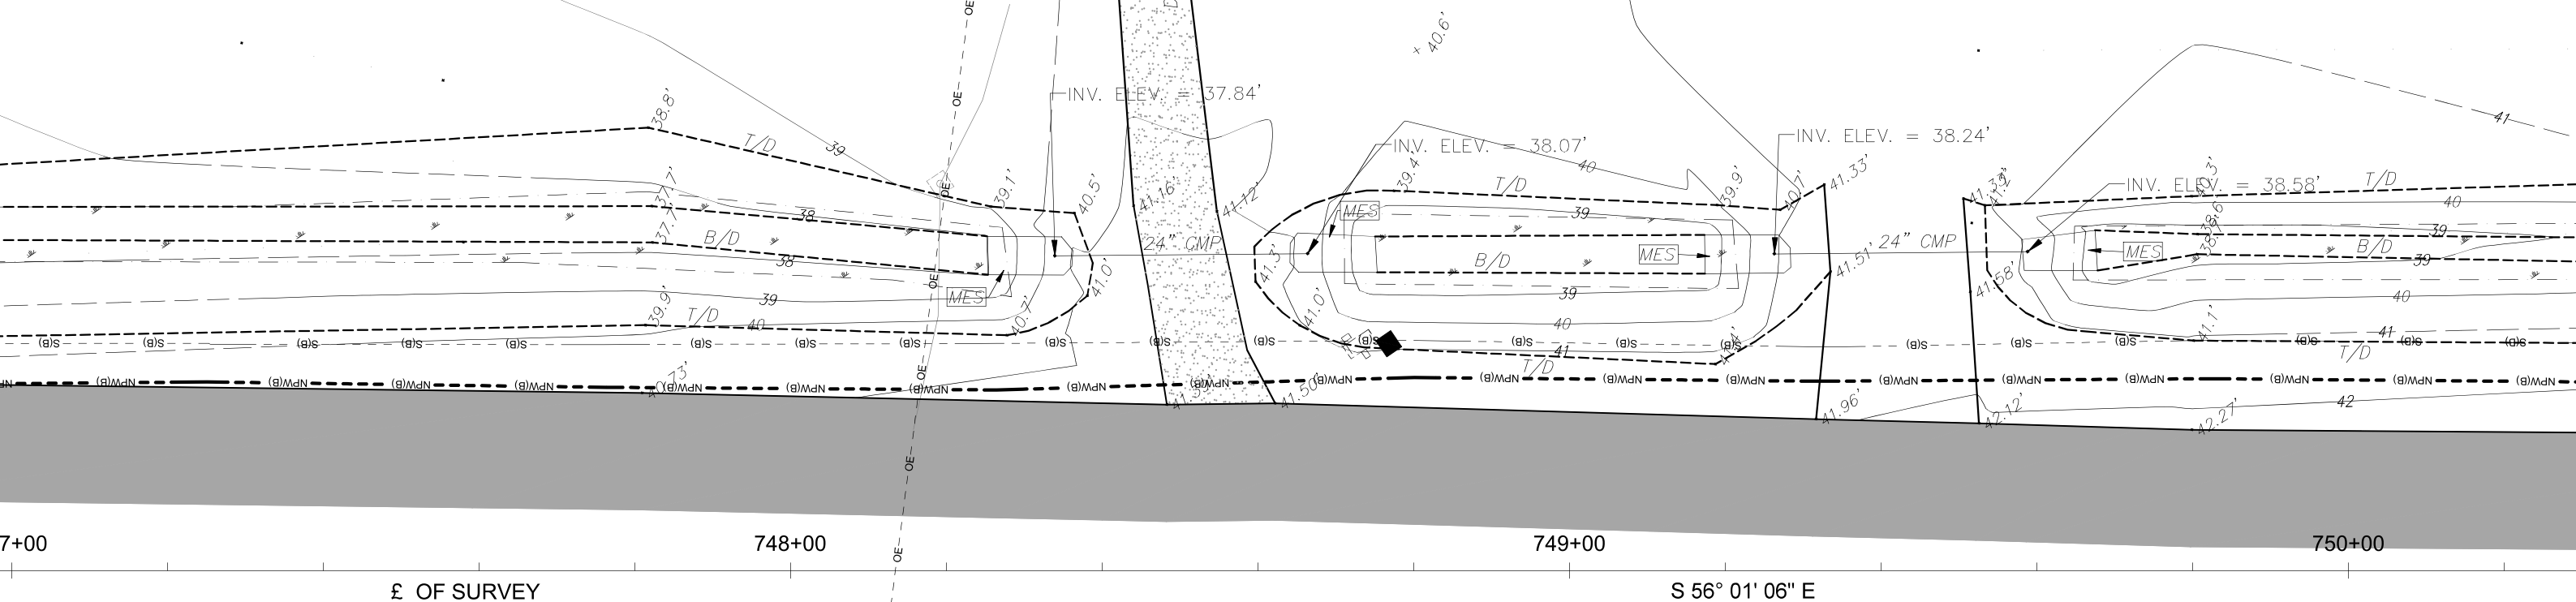


STATE ROAD No. 16
(200' R/W)



CONTROL POINT **S34**
SET 5/8" IR W/ CAP "DRMP INC. TRAV"
N = 2034842.35
E = 520972.63



BENCHMARK: BM16
SET 5/8" X 30" IR W/ ALUM CAP STMP DRMP LB #2648 7
N = 2034663
E = 521173
ELEV. = 41.73' (NAVD88)


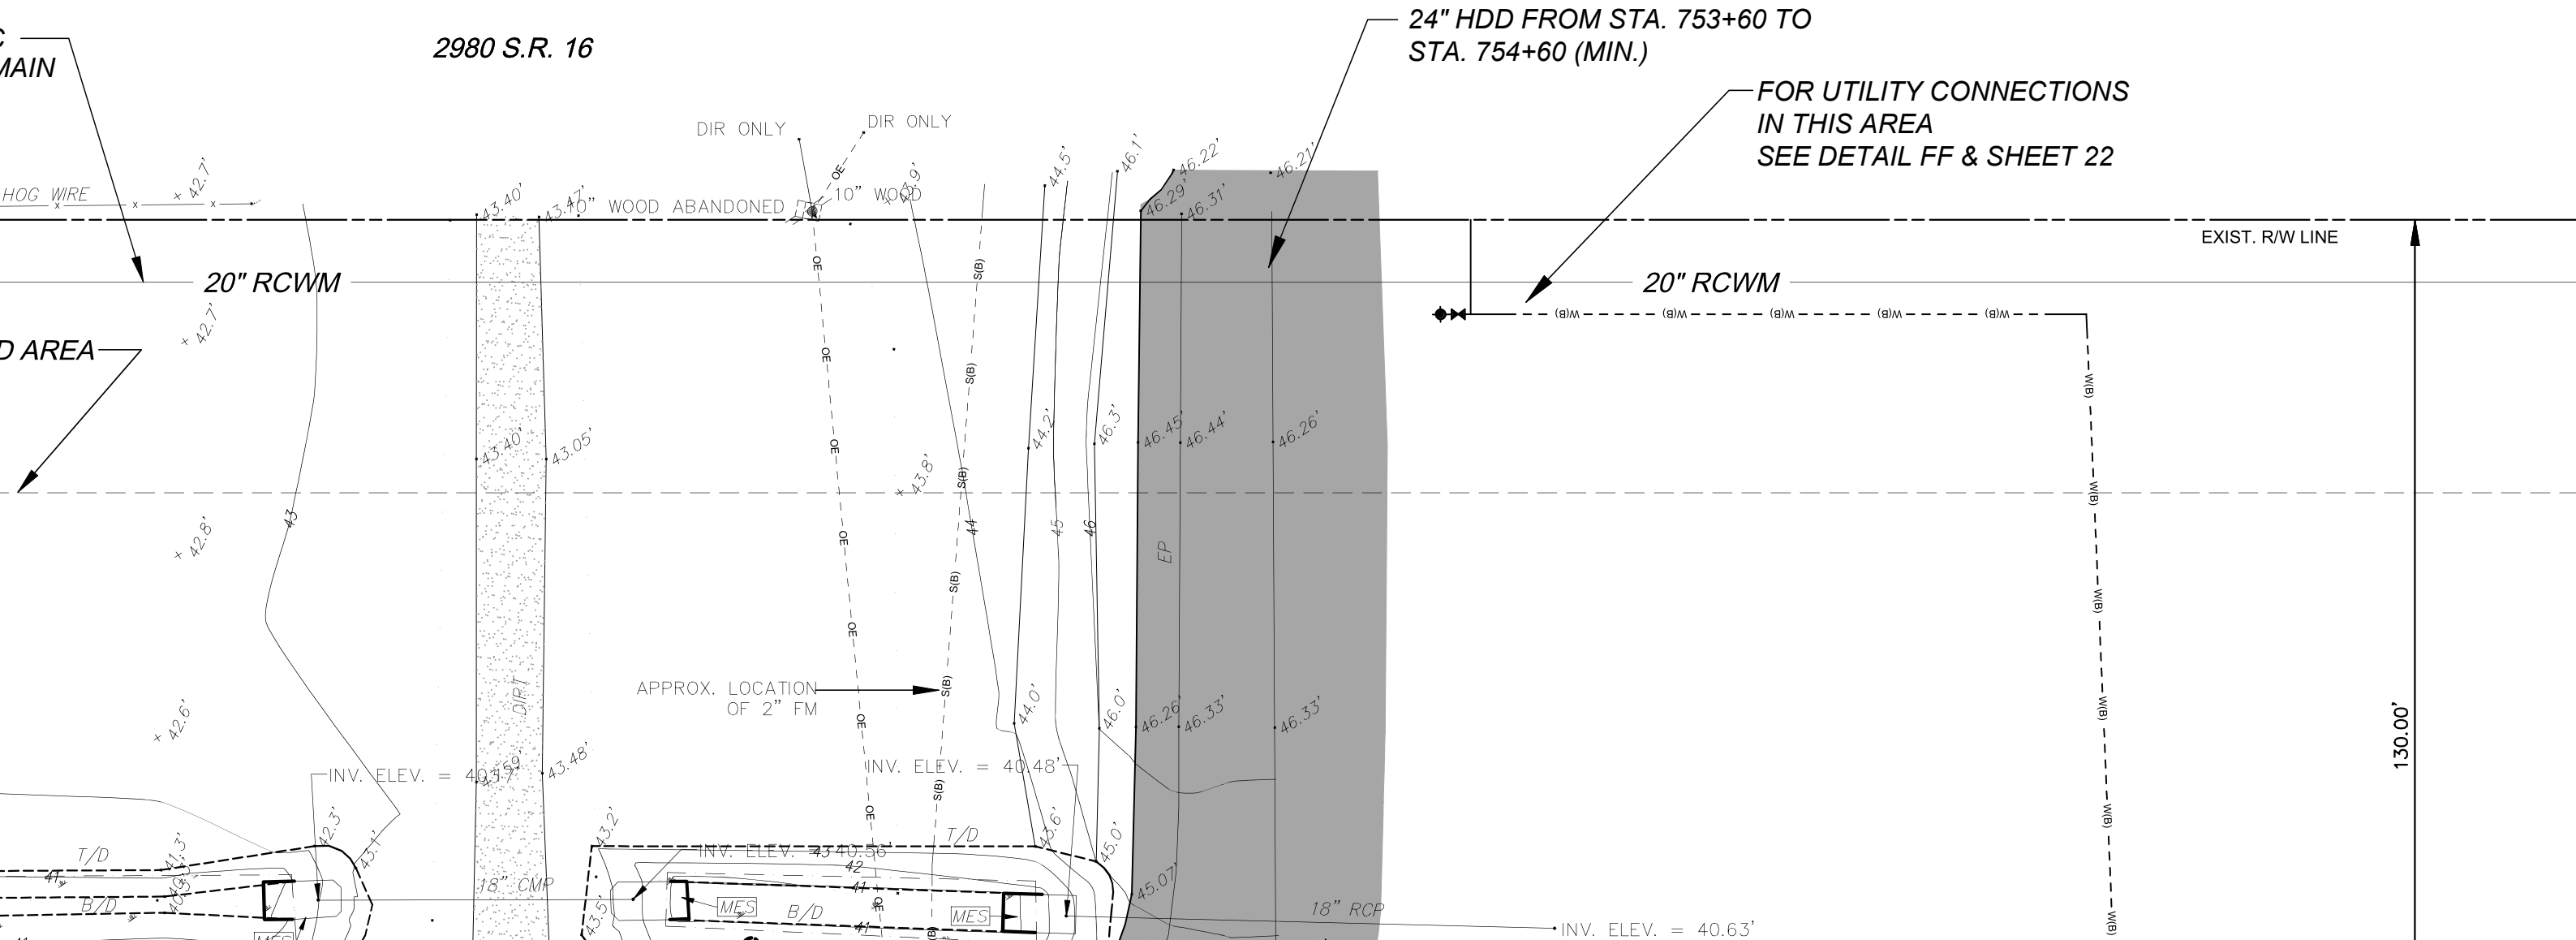


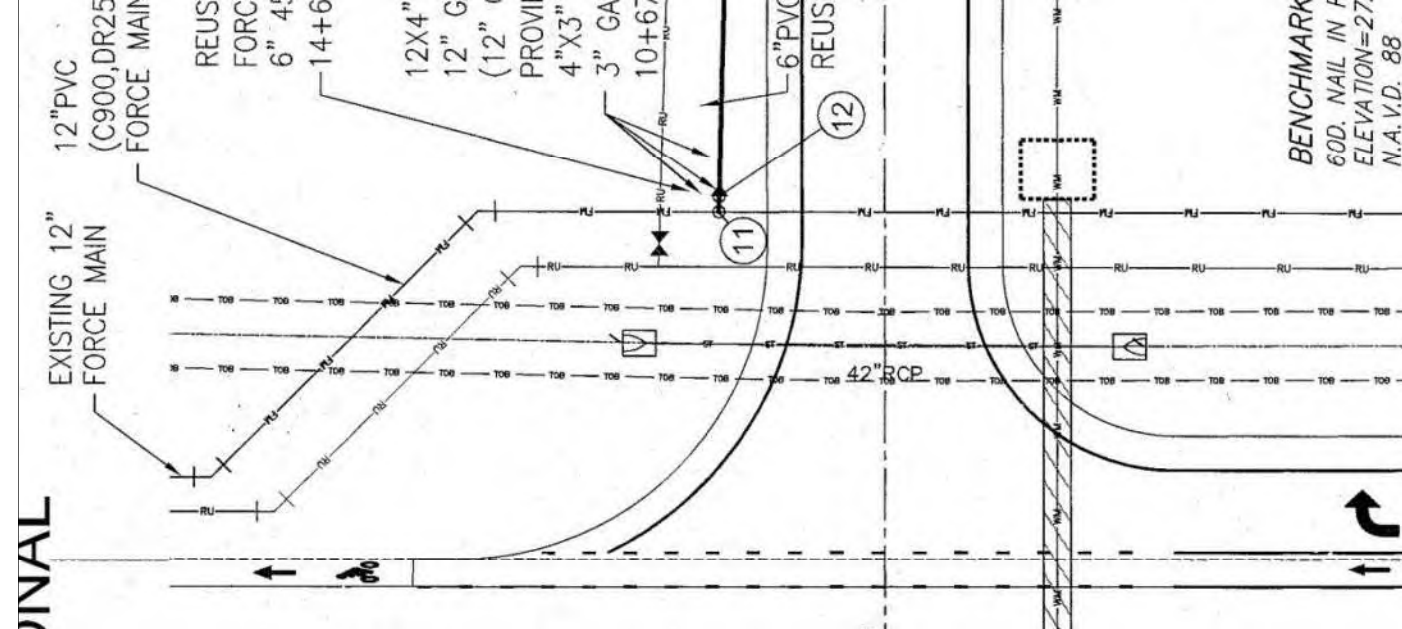
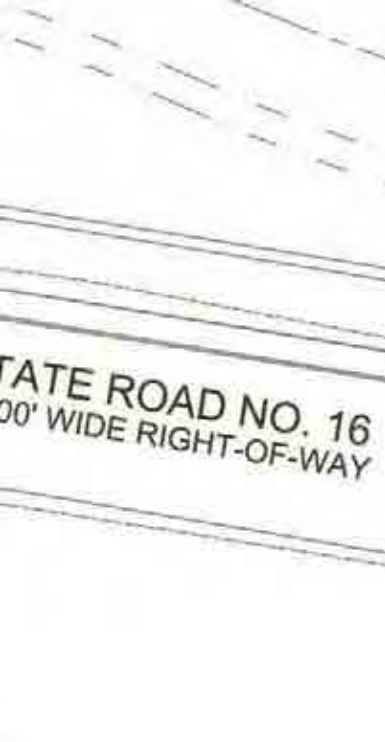




DETAIL BB
N.T.S.

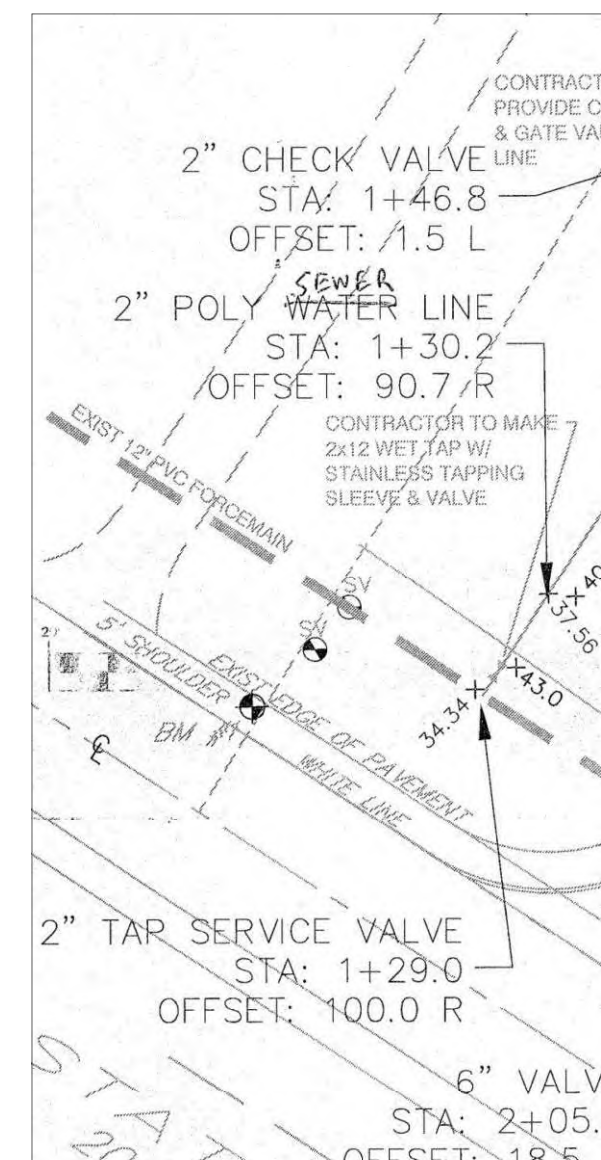
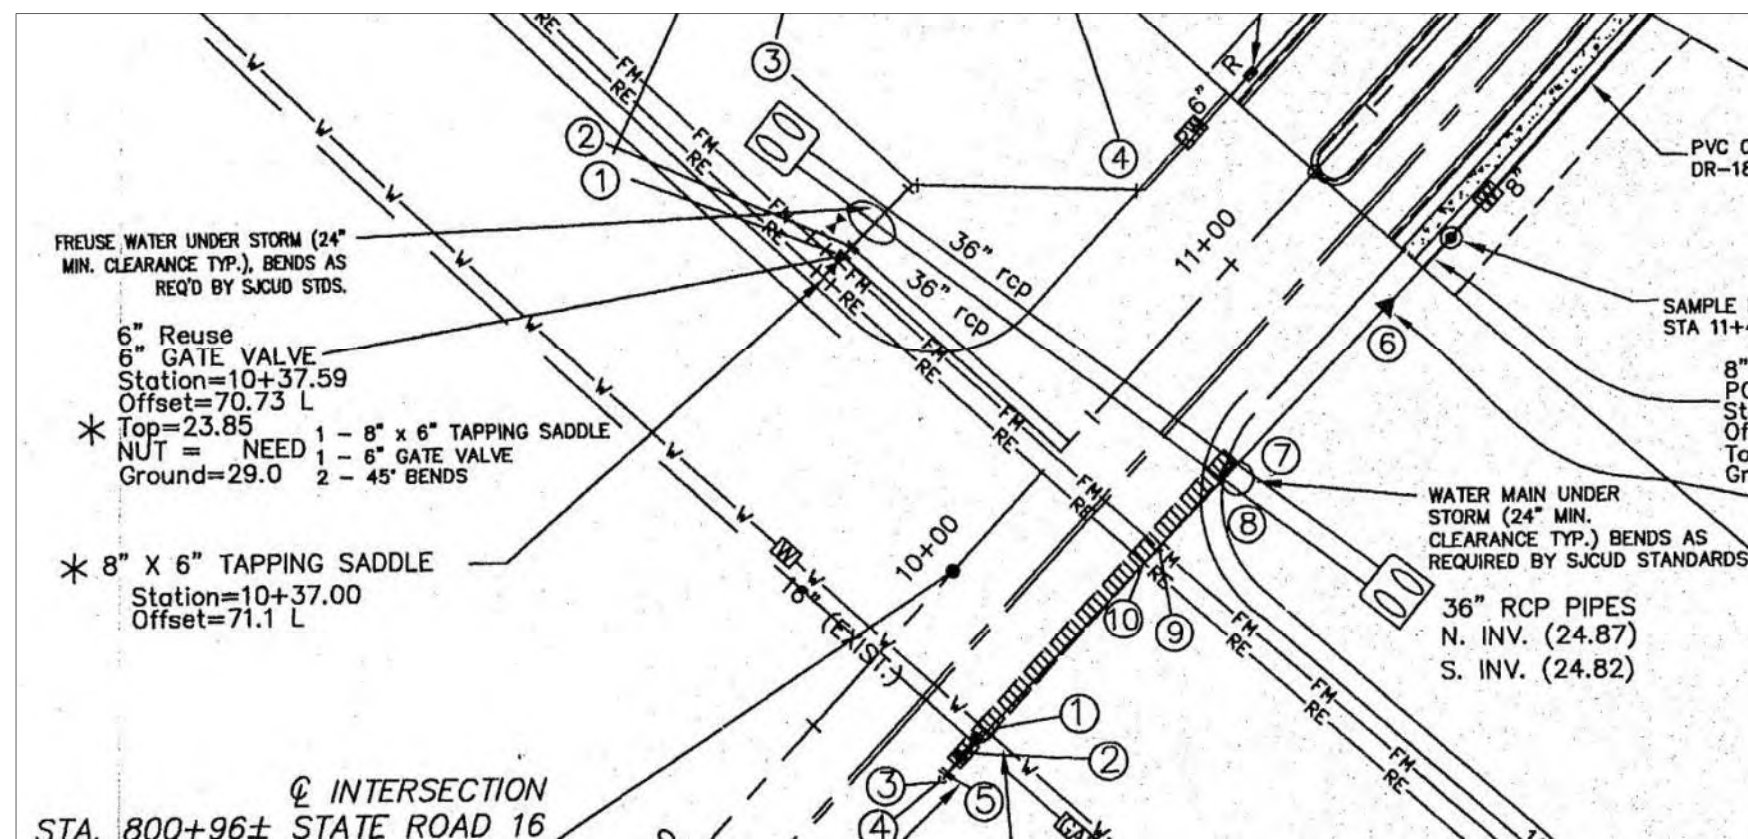


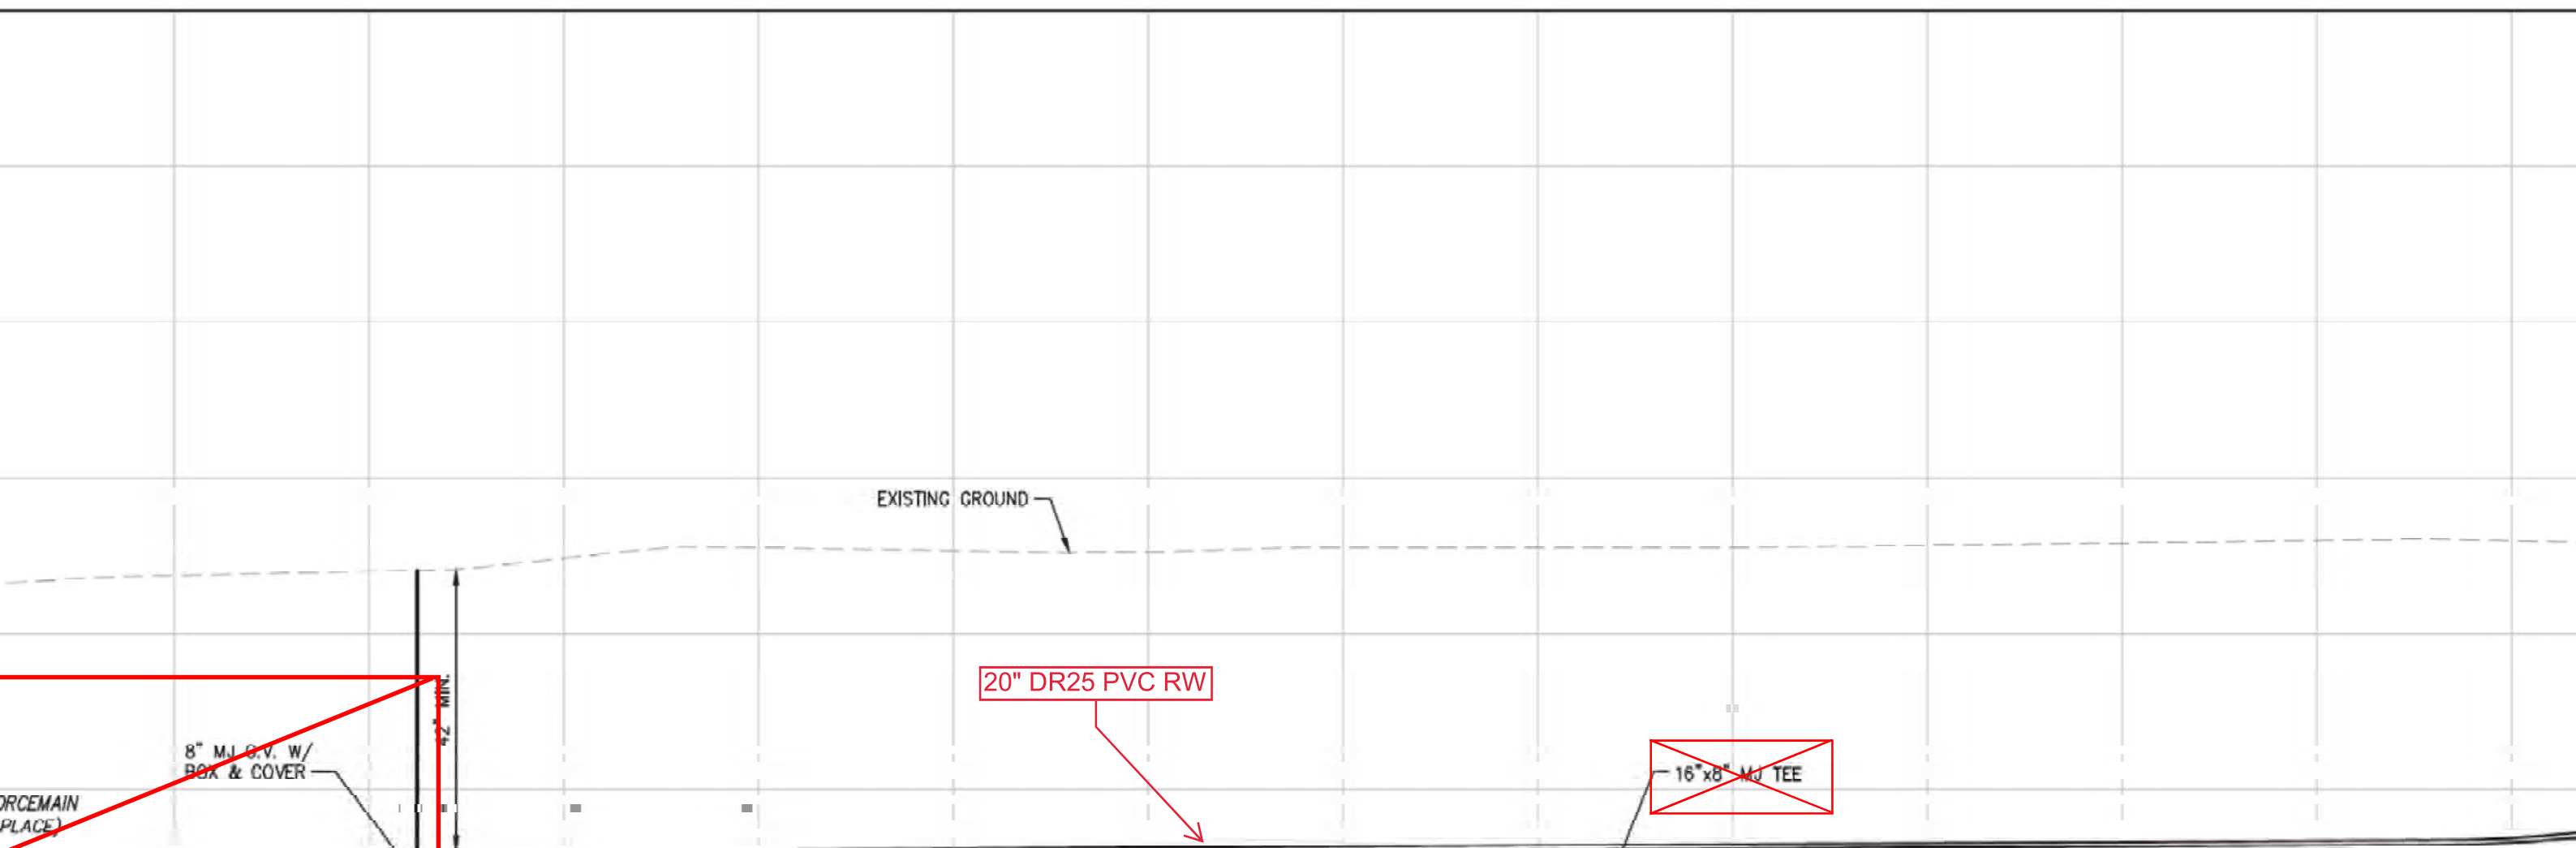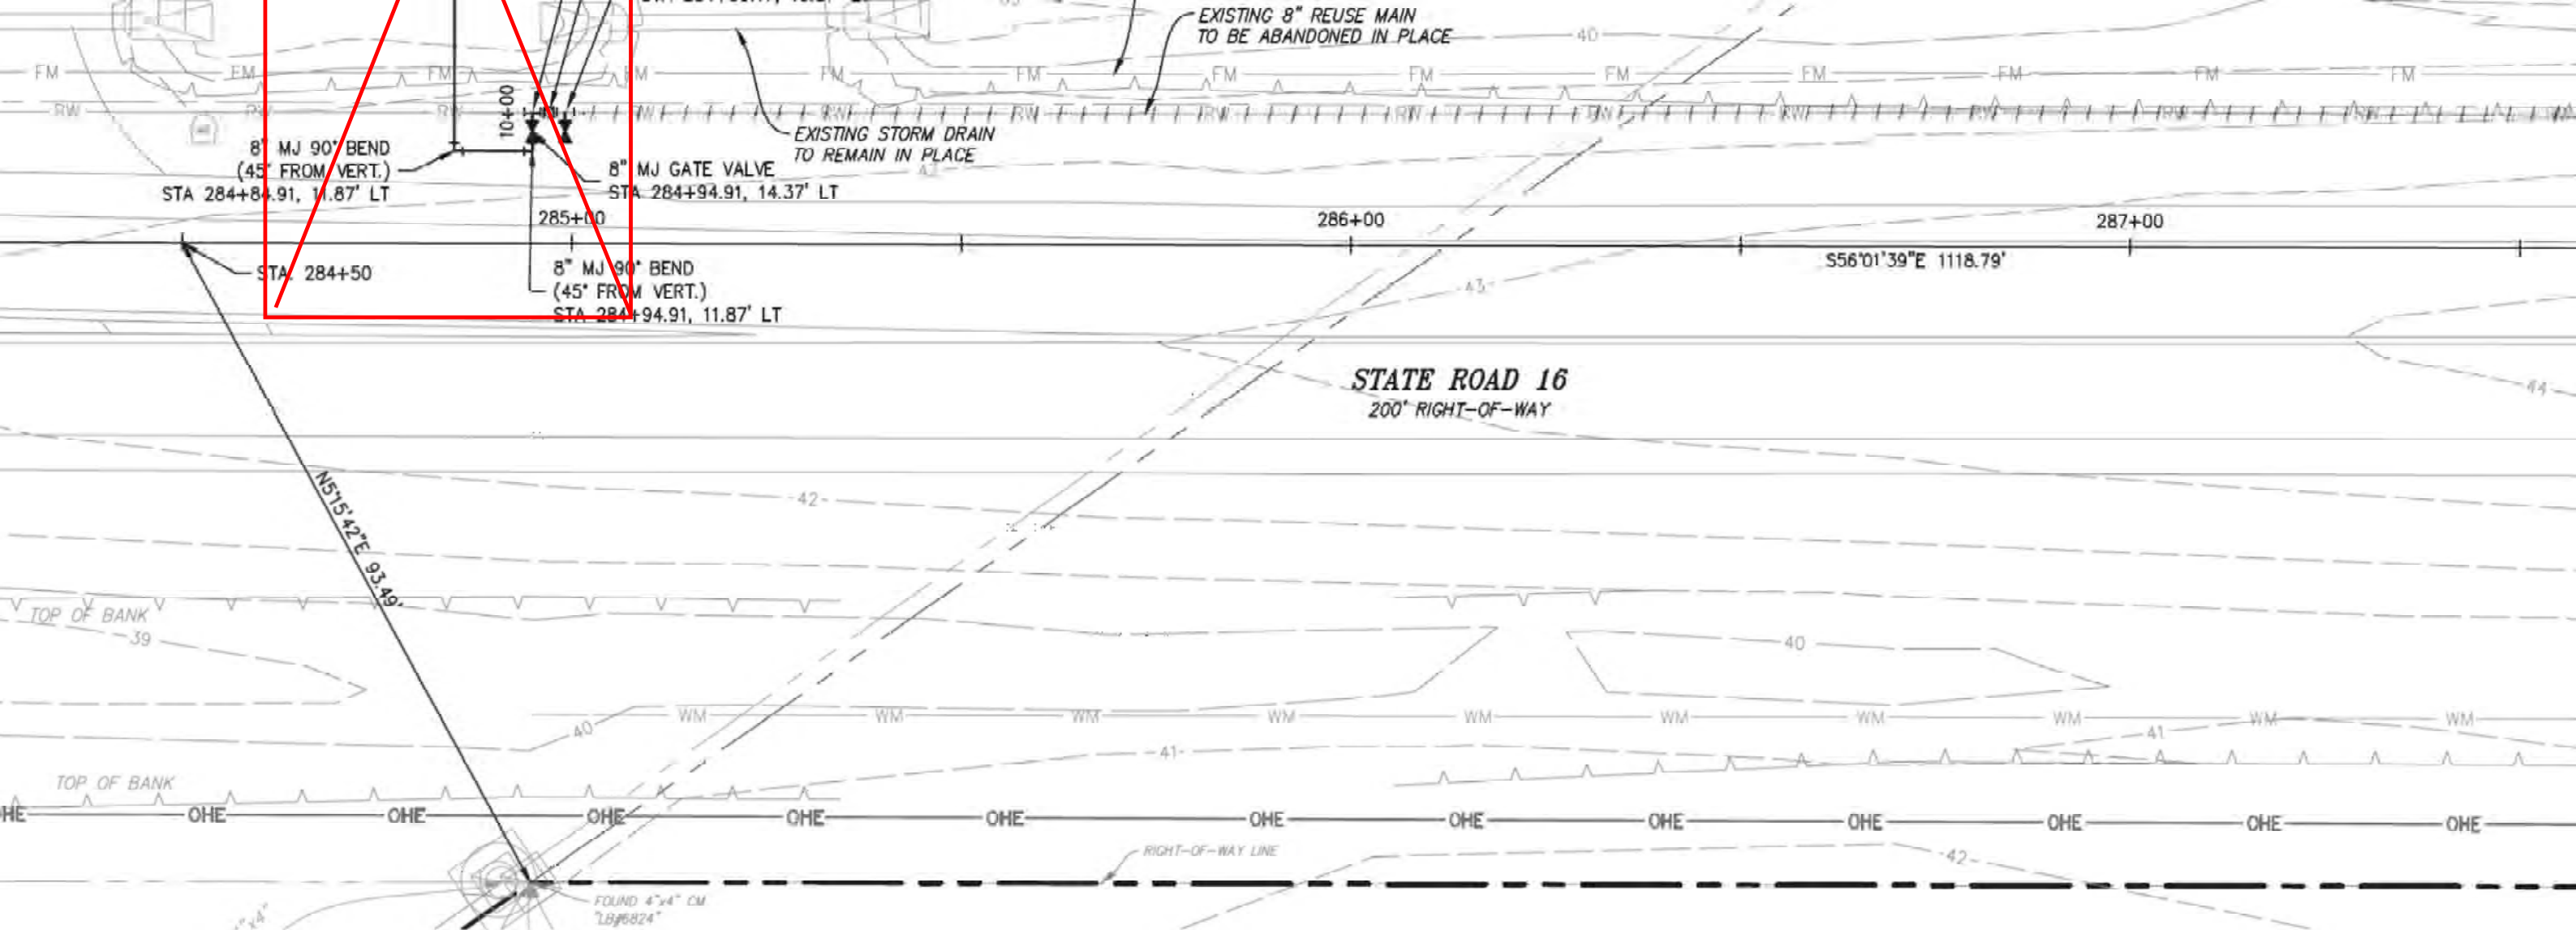


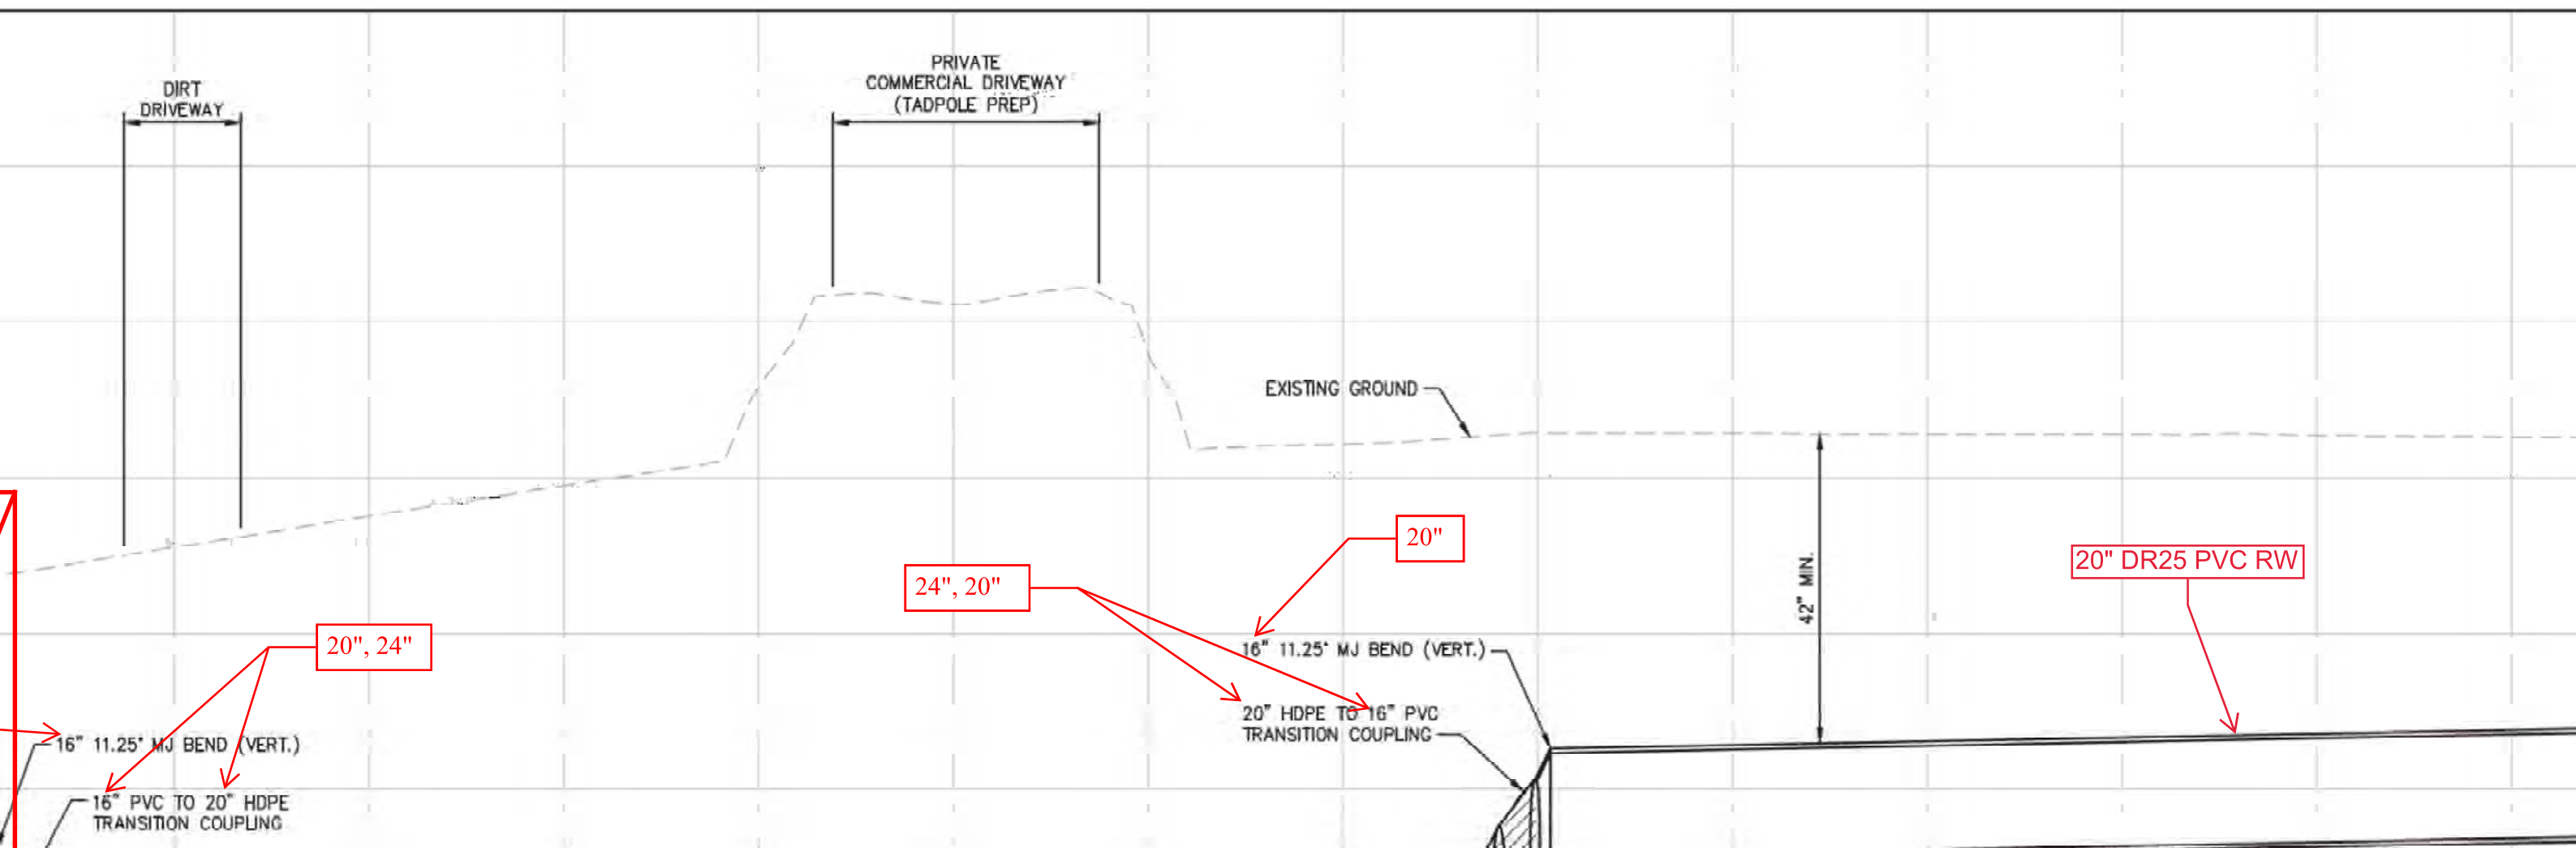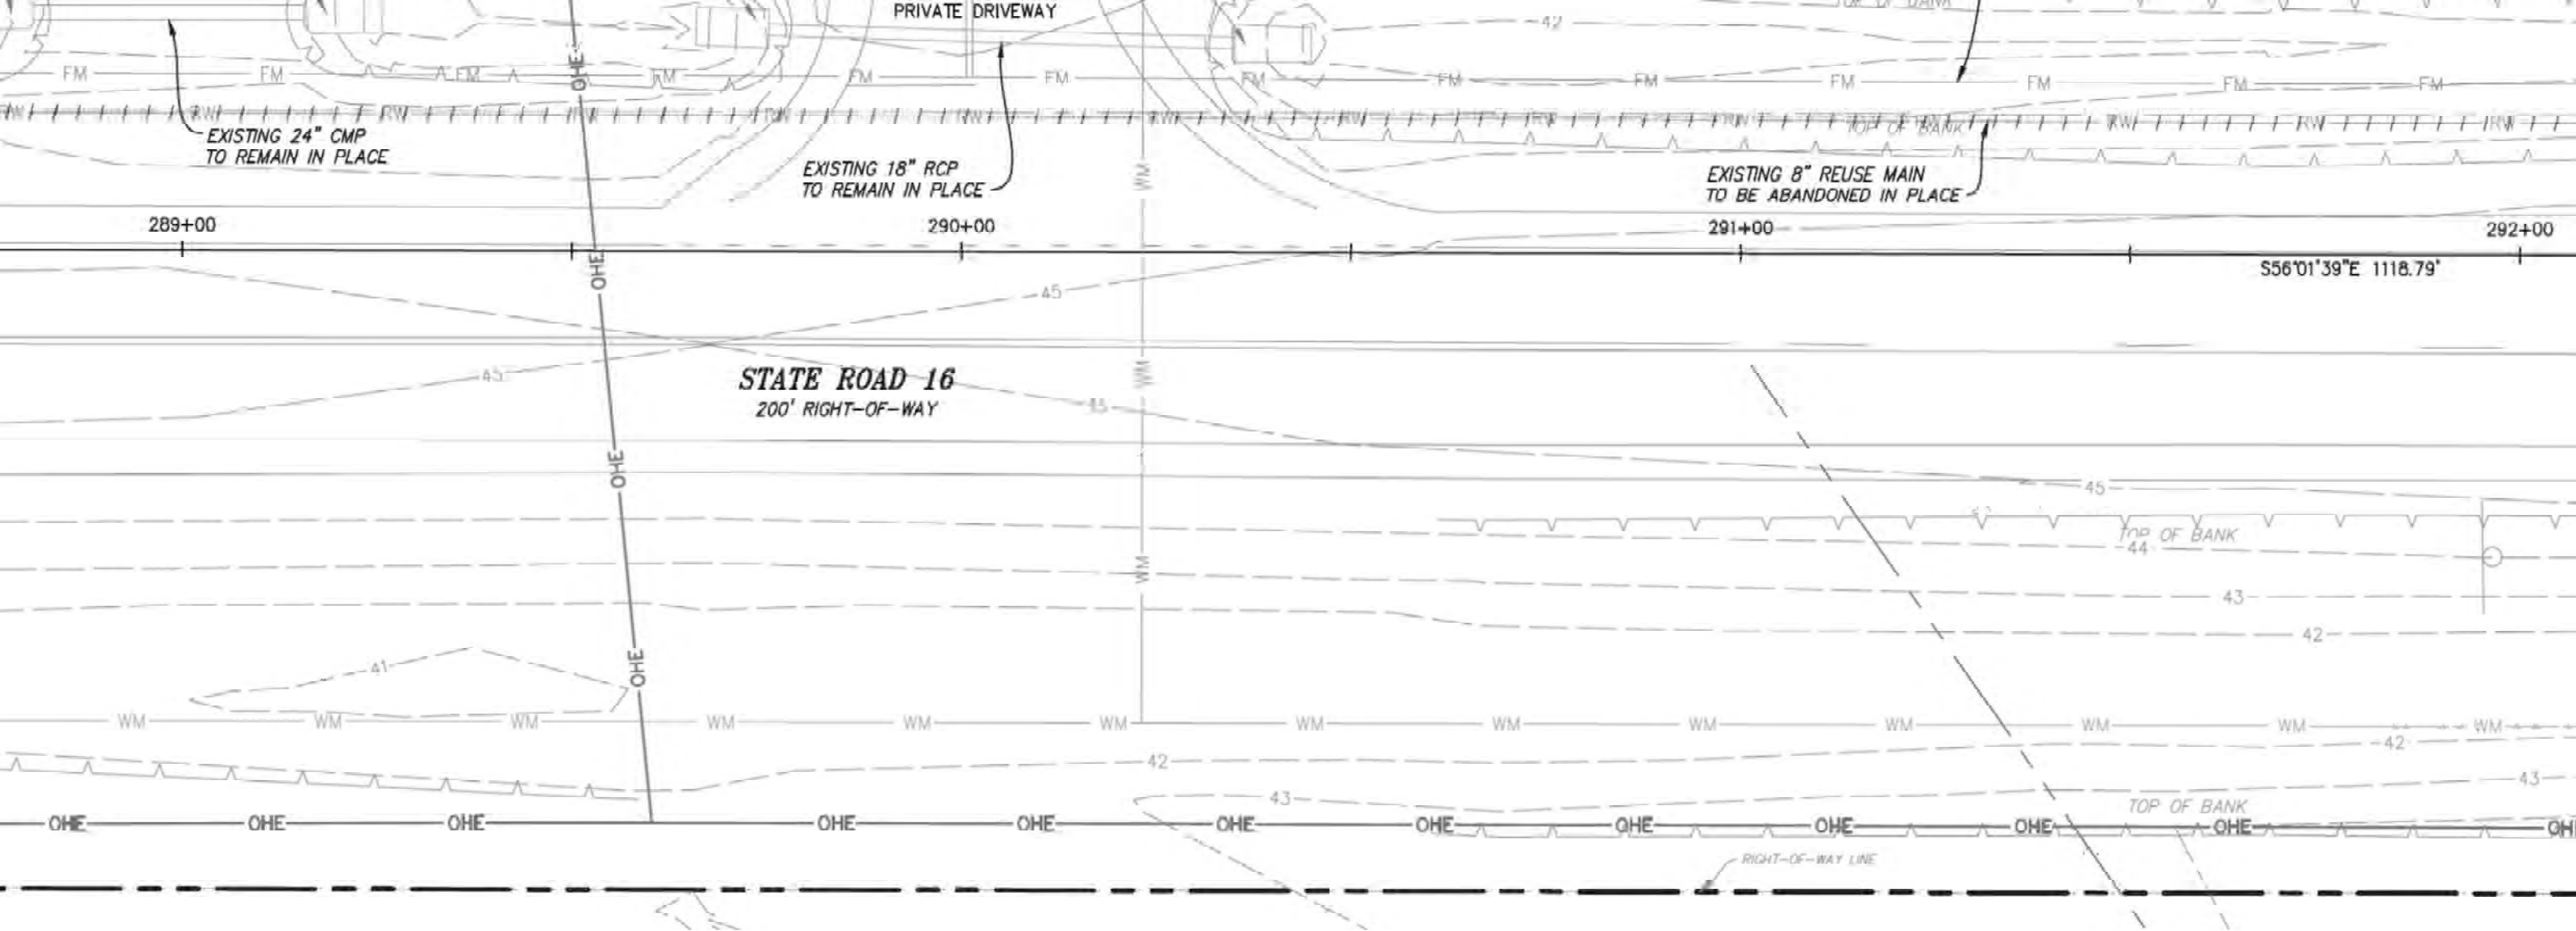

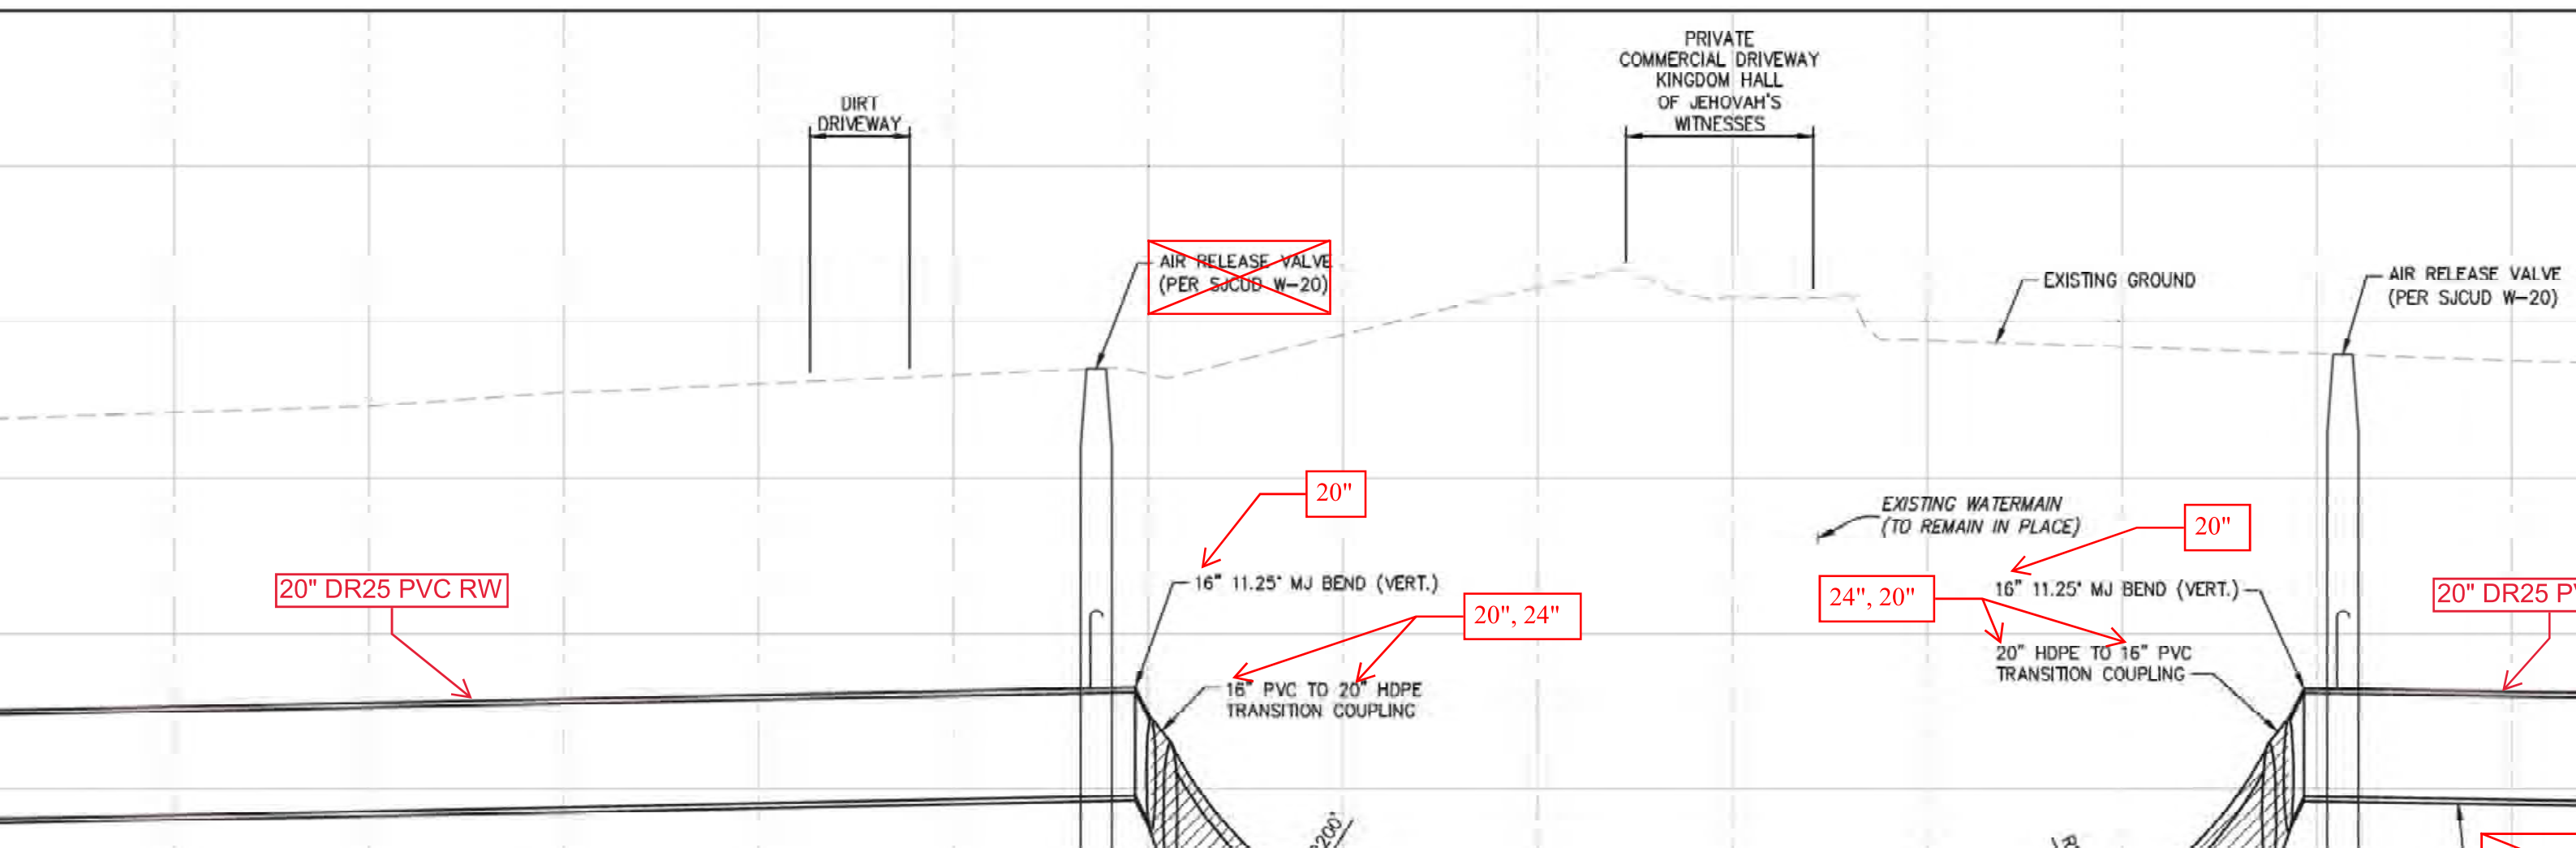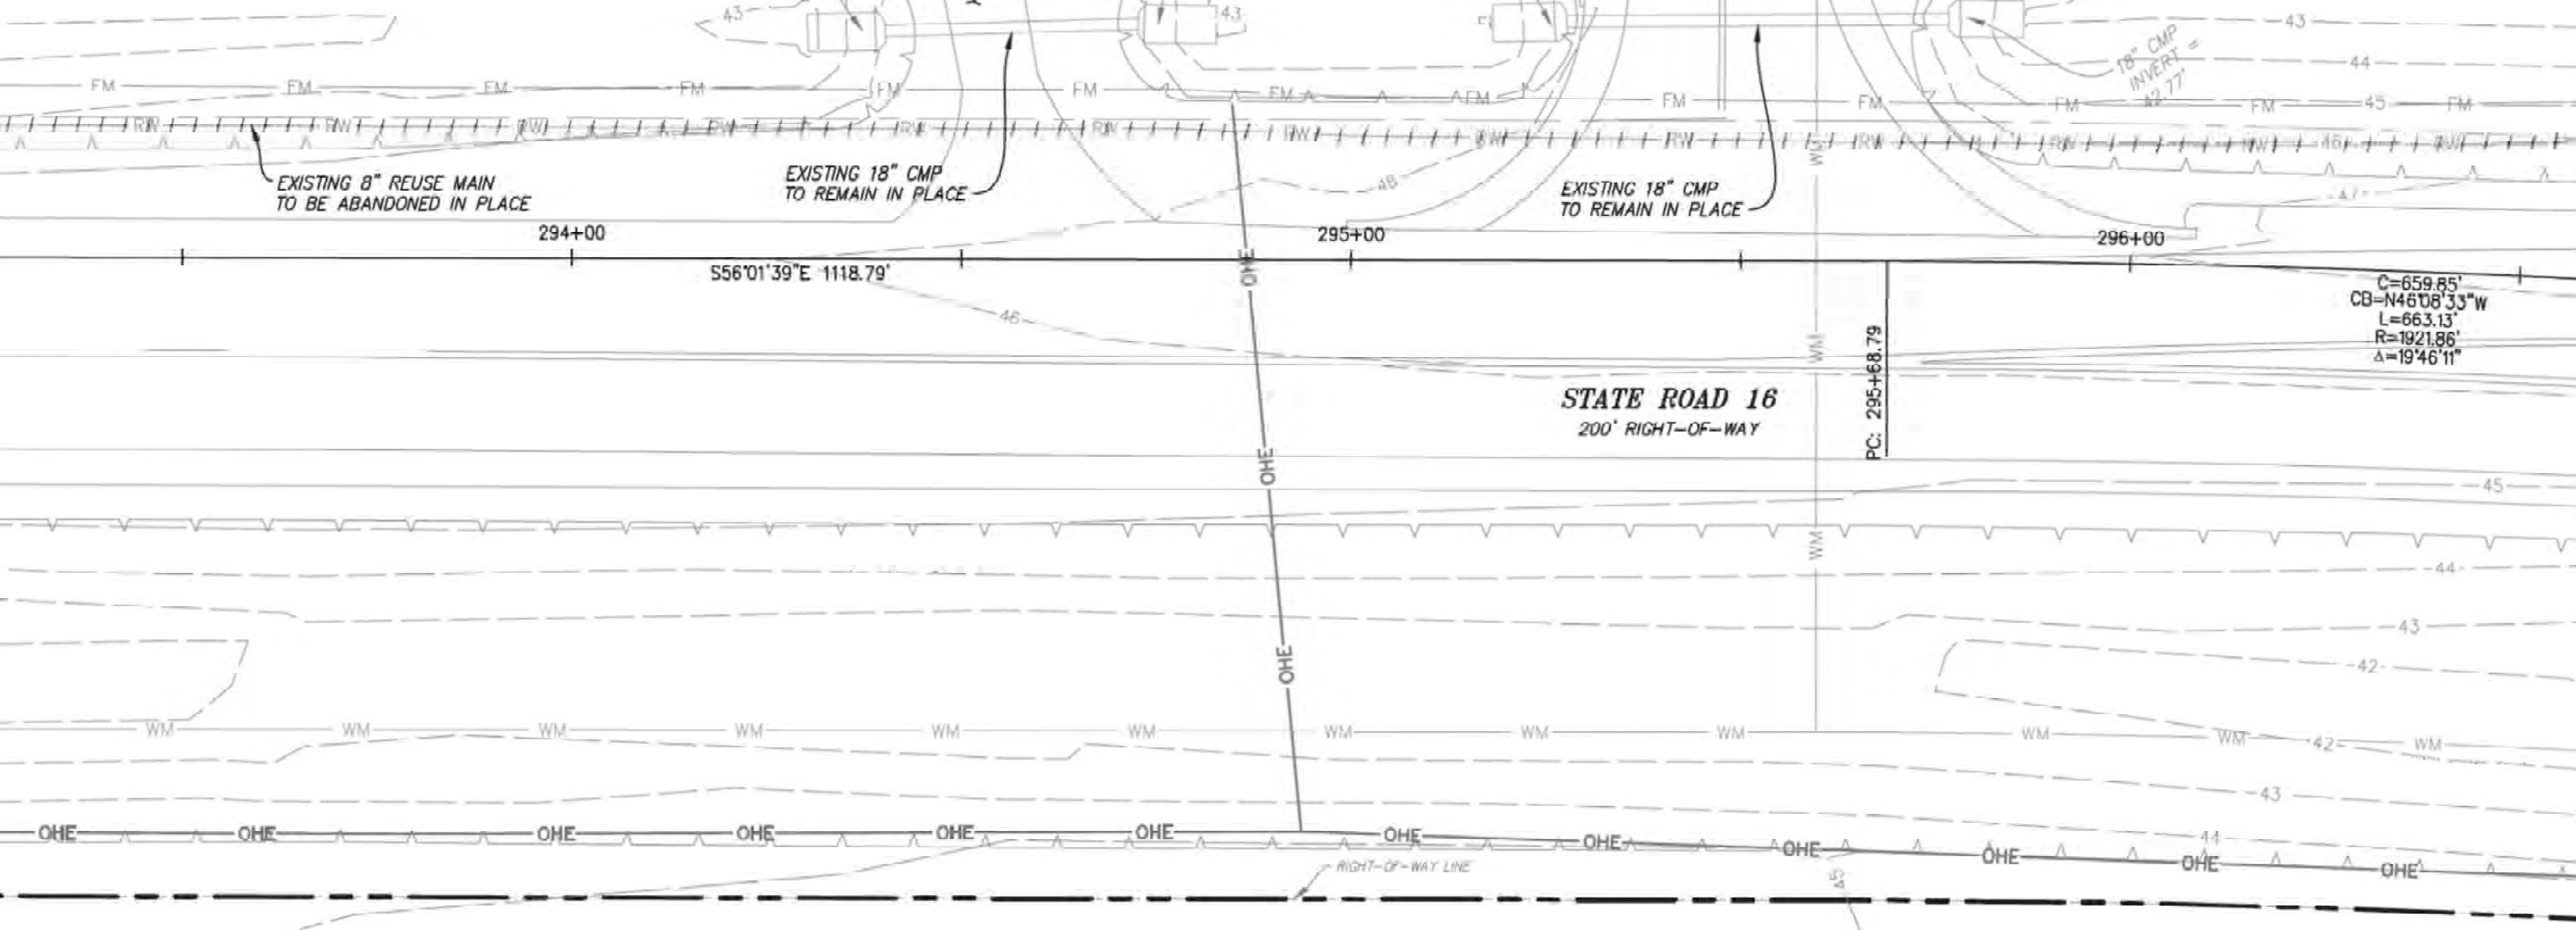

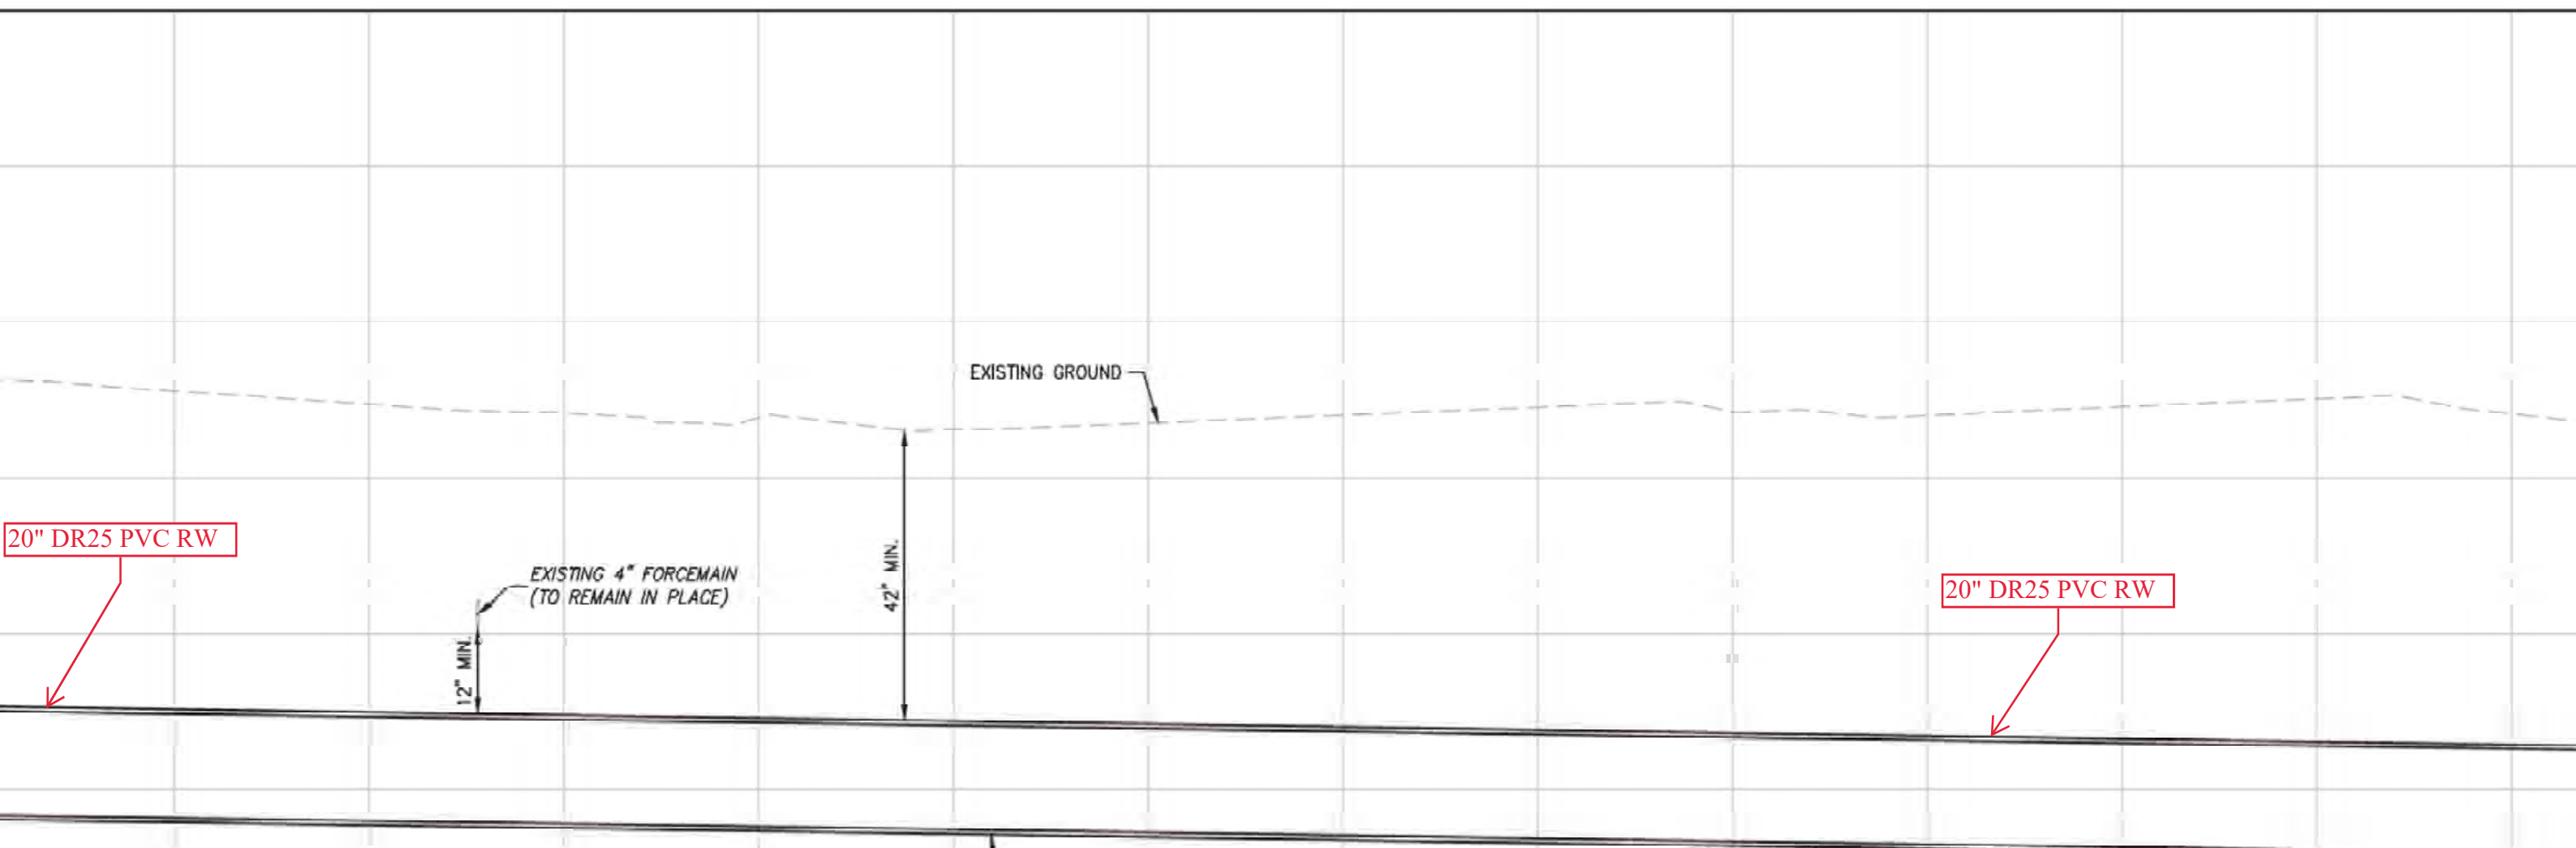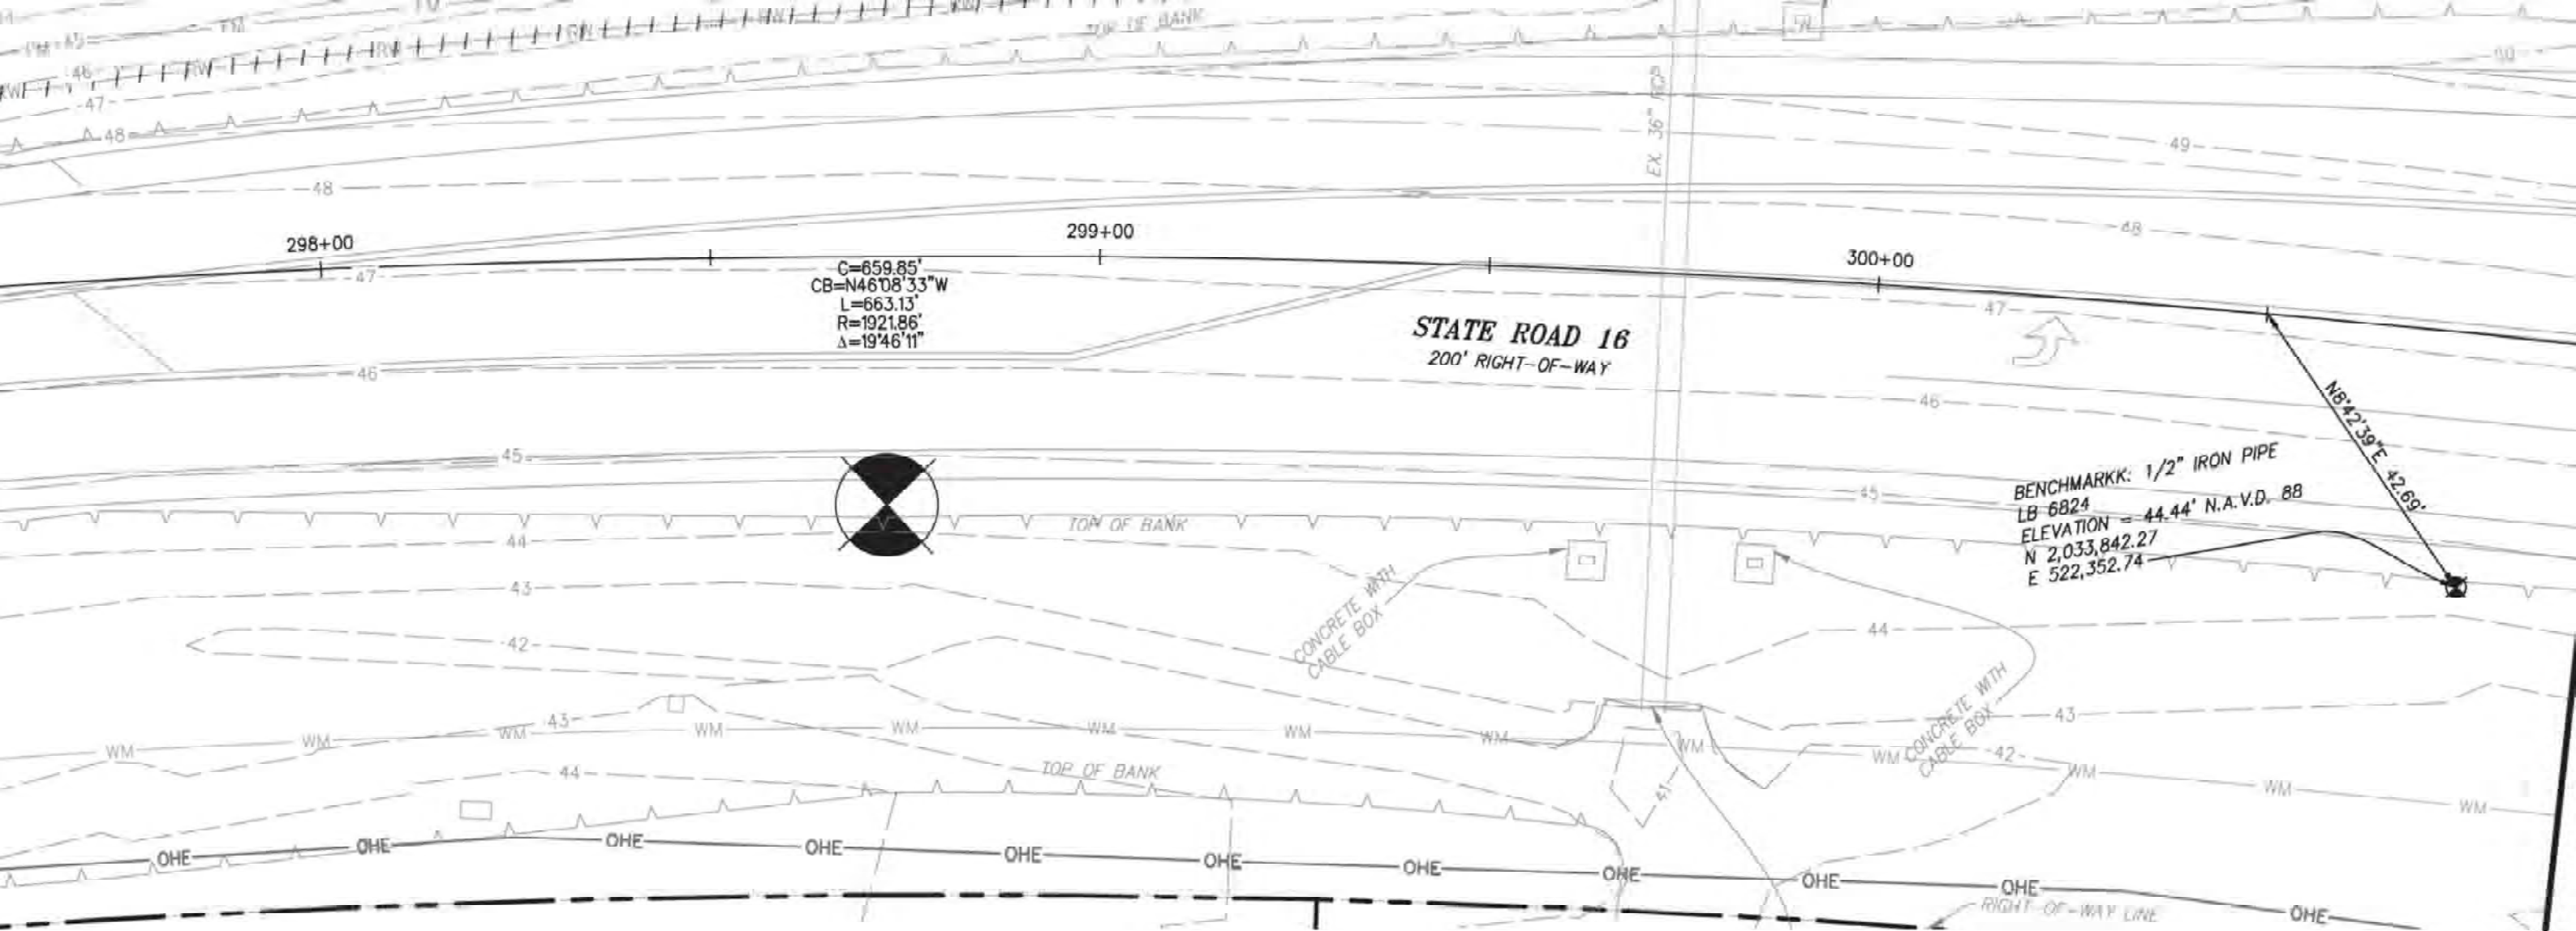

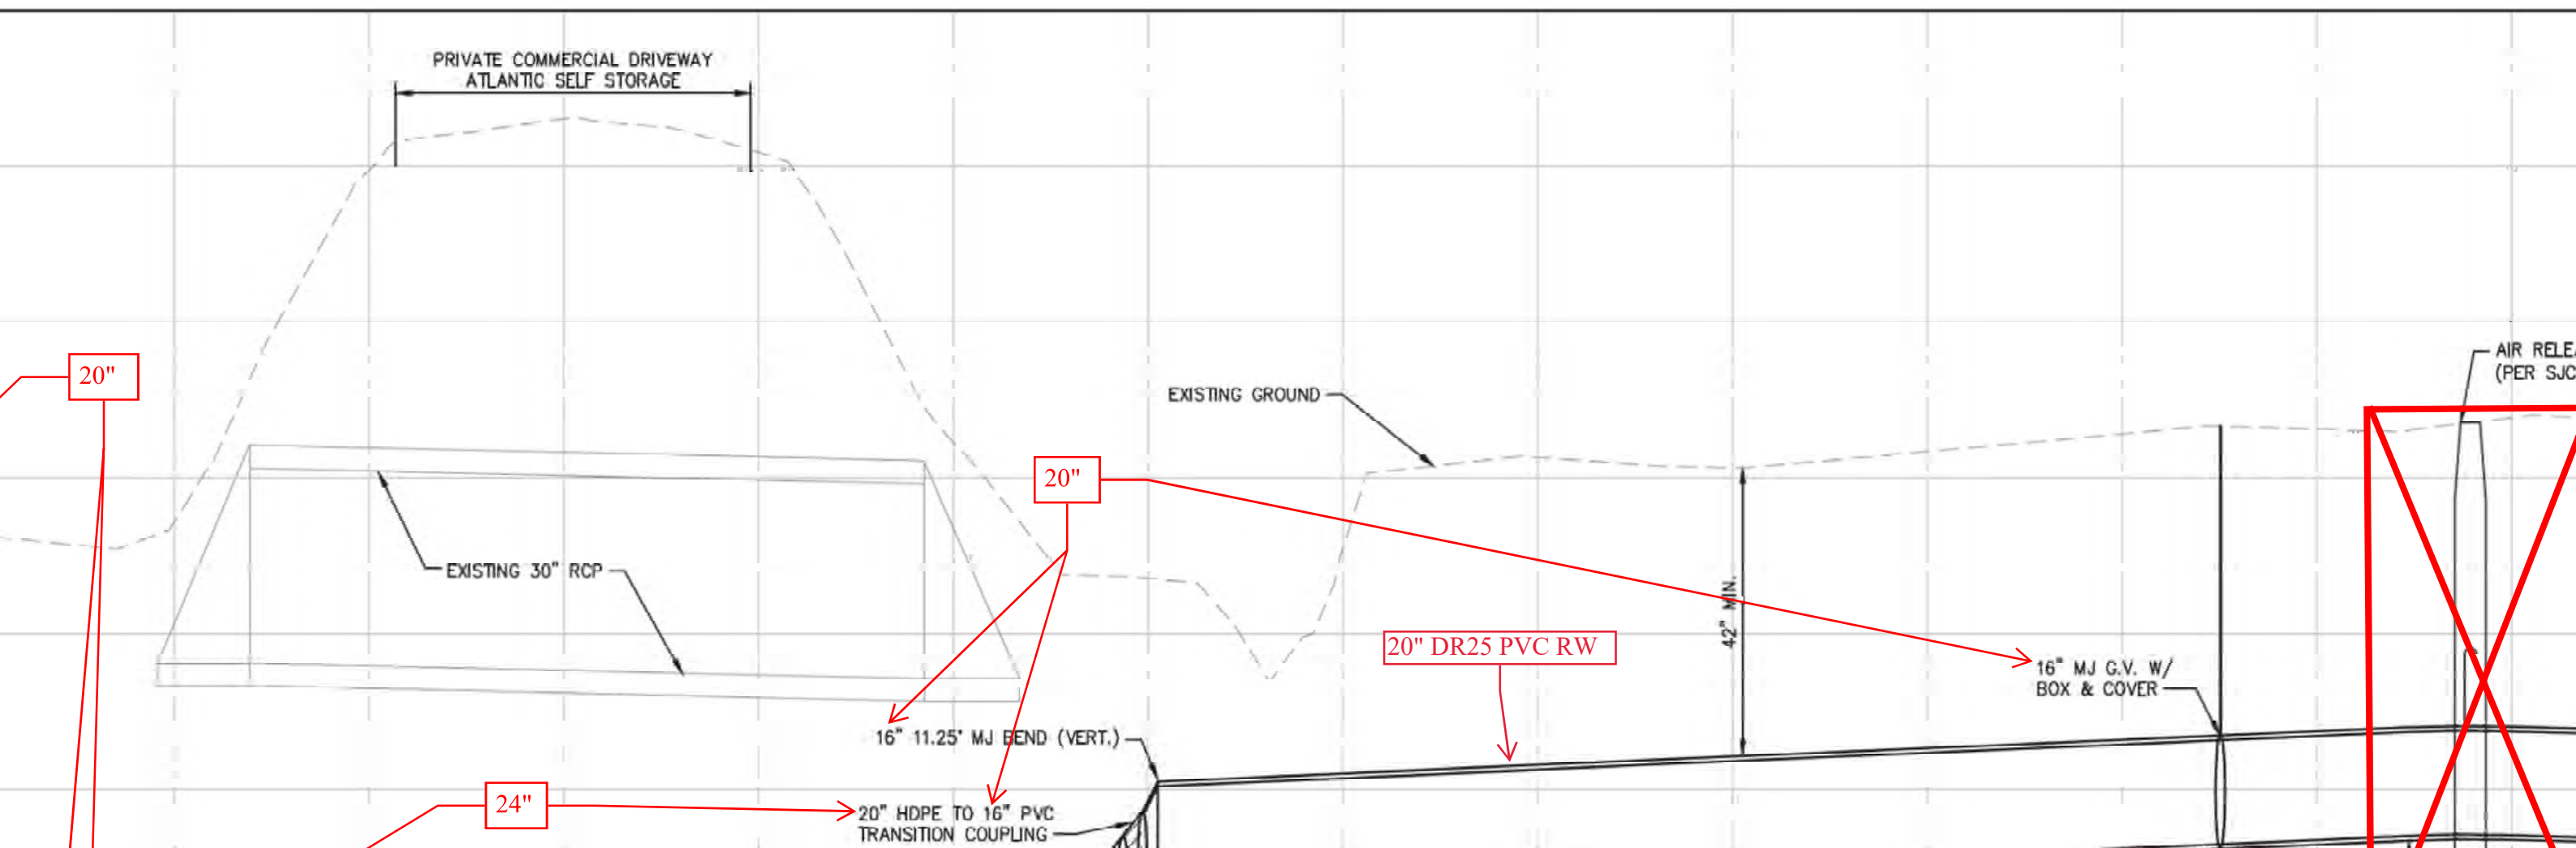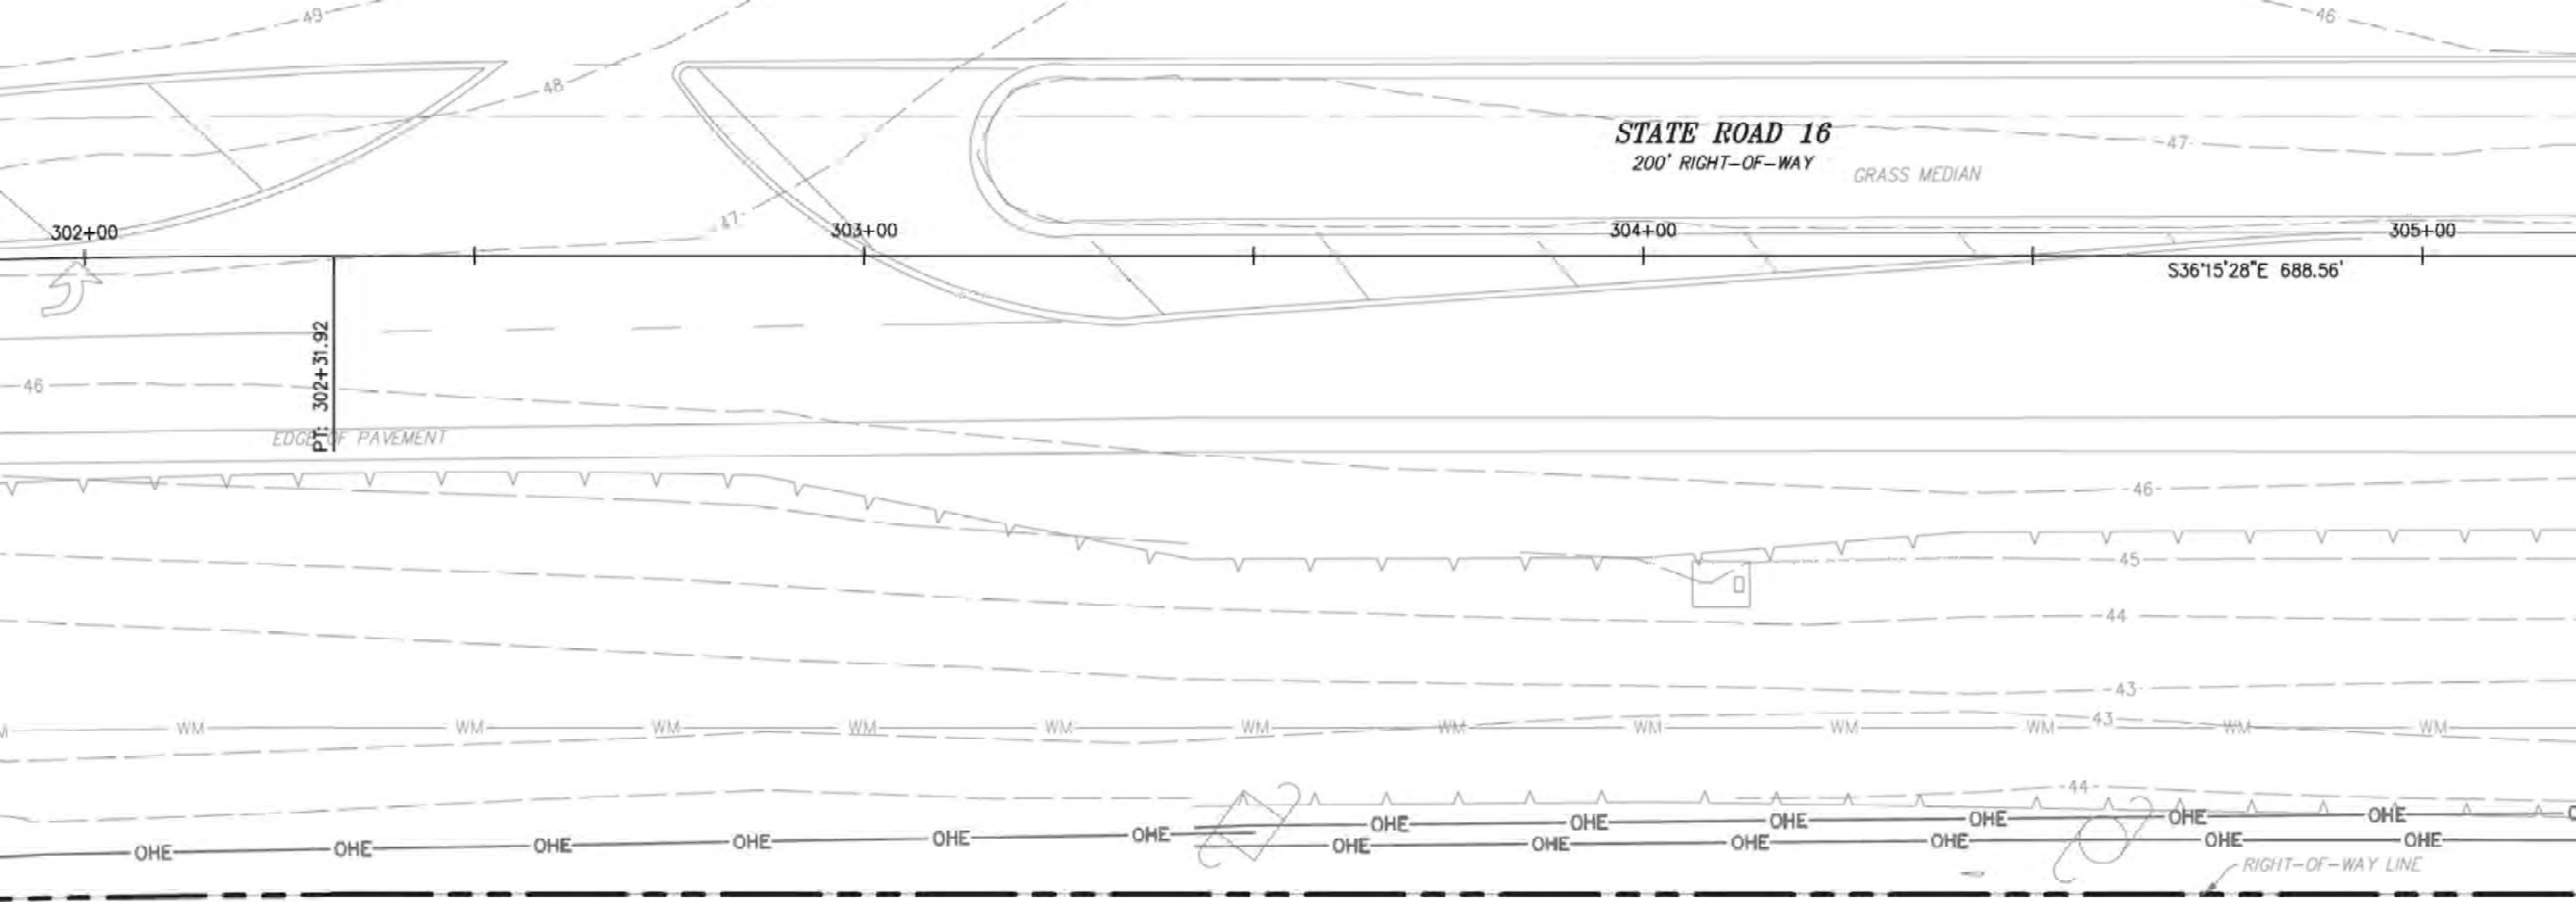

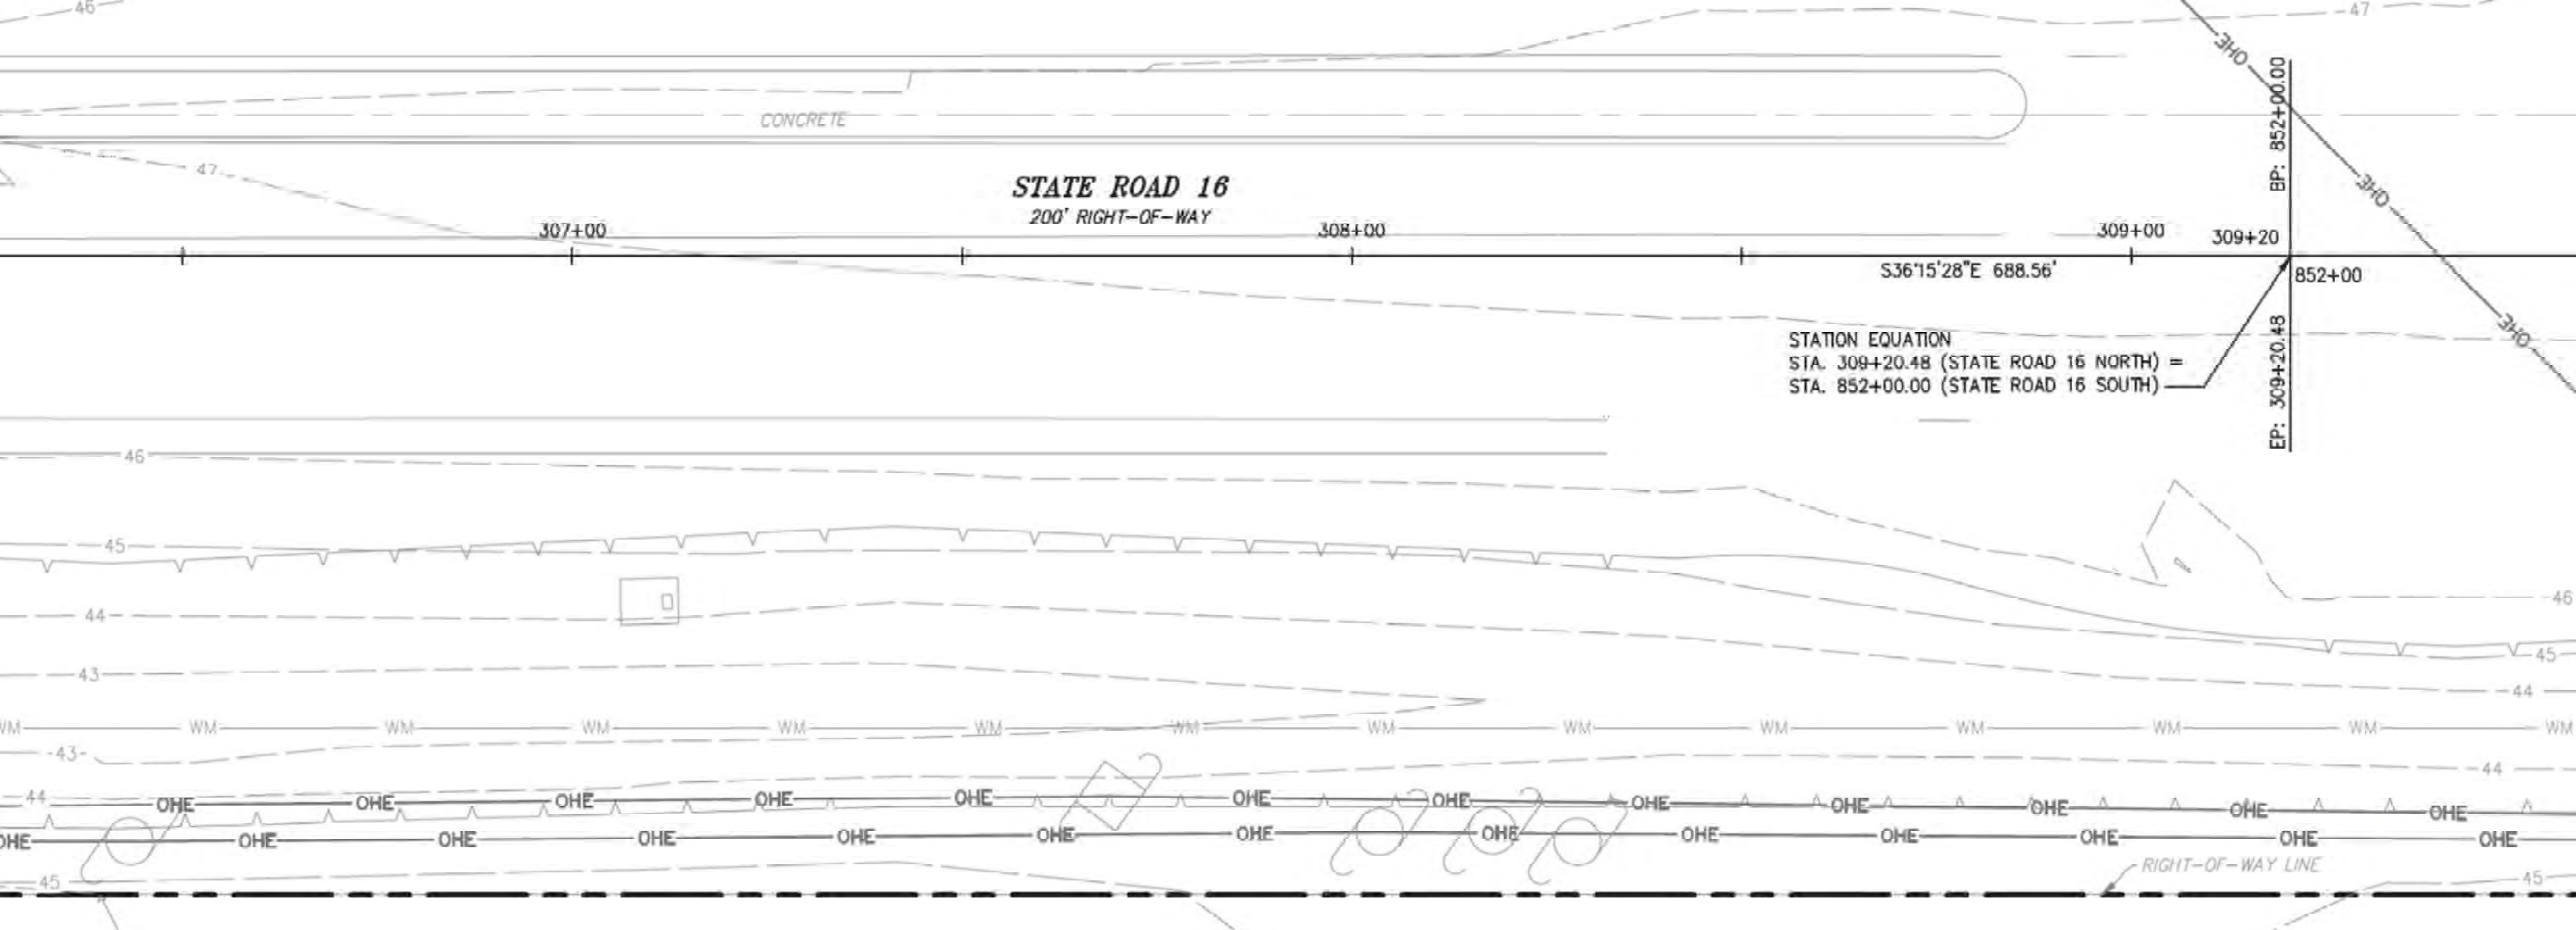

JACK AND BORE IN THIS AREA (BY OTHERS).
WHICH EVER PROJECT IS INSTALLED FIRST
WILL CONNECT WITH THE OTHER PROJECT.

