

# **TECO Peoples Gas Forms and Figures**





## District 2 Utility Contact Form

**Please Fill Out Completely**

Date: 08/16/2024  
Company Name: TECO  
Phone Number: 813-951-7784  
Email Address: mmpeak@tecoenergy.com  
FPI: 210447-5-52-01 SR16 St. Johns Co. Roadway Plan Sheets Dtd 8/5/24 Add Lanes/Reconstruct  
Emergency number to be inserted on plans **813-951-7784**

Existing facilities are located:

- ☒ Within existing FDOT Right-of-Way (between Station: 100 to Station: 398 )  
☐ Within existing County/City Right-of-Way (between Station: to Station: )  
☐ Within railroad Right-of-Way (between Station: to Station: )  
☐ Within an easement or fee title property (Has compensable interest and may claim reimbursement for required relocation) \*  
☐ Not within project limits (Has no facilities within limits)  
☐ No Utility Work Schedule (Has facilities within limits but is not affected)  
☐ There will not be a claim for reimbursement  
☐ There will be a claim for reimbursement \*

\* Please provide any document(s) [i.e. fee title property deed or easement document(s)] within the project limits that formulates the basis for your entitlement to be reimbursed for your utility work. NOTE: A preliminary cost estimate for any utility work within this entitled area is required.

Enclosed please find:

<input checked="" type="checkbox"/> Marked Roadway Plans	<input type="checkbox"/> Company Utility Plans
<input type="checkbox"/> Legal Documents	<input type="checkbox"/> Preliminary Cost Estimate

**POLE OWNERS: List Joint Pole Users**

COMMENTS:

**Matthew Peak** Digitally signed by Matthew Peak  
Date: 2024.08.19 10:34:13 -04'00'


Signed:

Title:

Gas Design & Project Engineer

(Signature is not required if uploading directly in PSEE)

210447-5 FDOT Plan Sheets (Roadway - Dtd 8/5/24) 081224

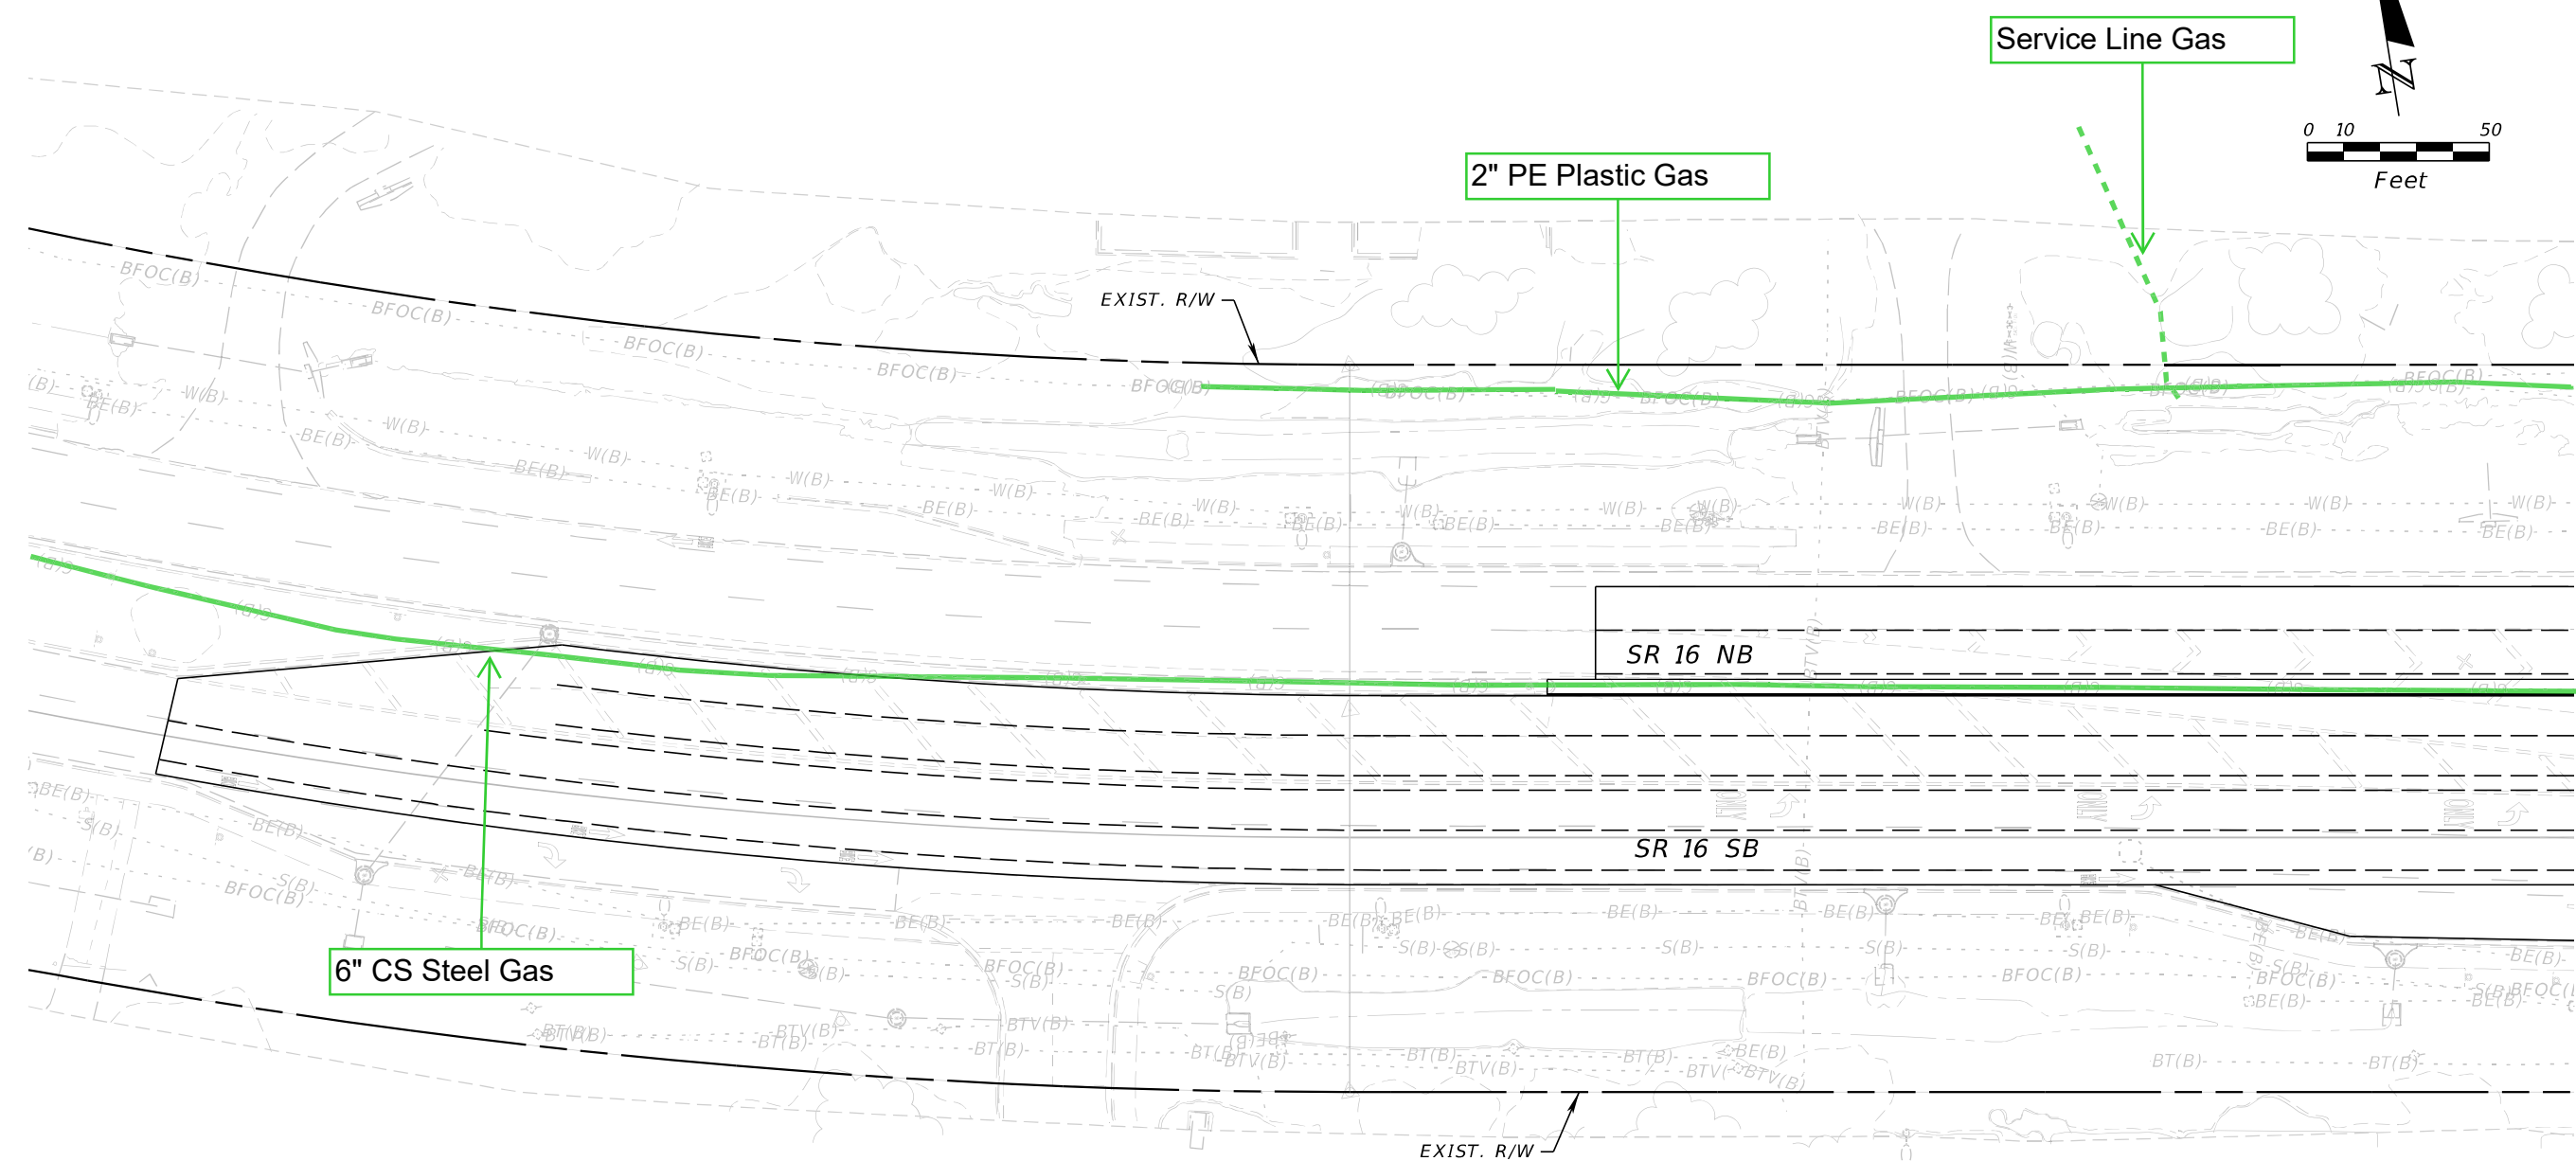


TECO MU  
dtd 08/15/2024

REVISIONS				ENGINEER OF RECORD		STATE OF FLORIDA DEPARTMENT OF TRANSPORTATION			ROADWAY PLAN	SHEET NO.  SR 16 - PLAN
DATE	DESCRIPTION	DATE	DESCRIPTION	STEPHEN J. PARK, P.E. LICENSE NUMBER: 77656 RS&H, INC. 10748 DEERWOOD PARK BLVD. SOUTH JACKSONVILLE, FL 32256		ROAD NO.	COUNTY	FINANCIAL PROJECT ID		
						SR 16	ST. JOHNS	210447-5-52-01		

8/5/2024 4:28:36 PM BeattyM  
c:\pw\_work\sh\_pw\pw\_user\0439575\PLANRD01.dgn


THE OFFICIAL RECORD OF THIS SHEET IS THE ELECTRONIC FILE DIGITALLY SIGNED AND SEALED UNDER RULE 61G15-23.004, F.A.C.

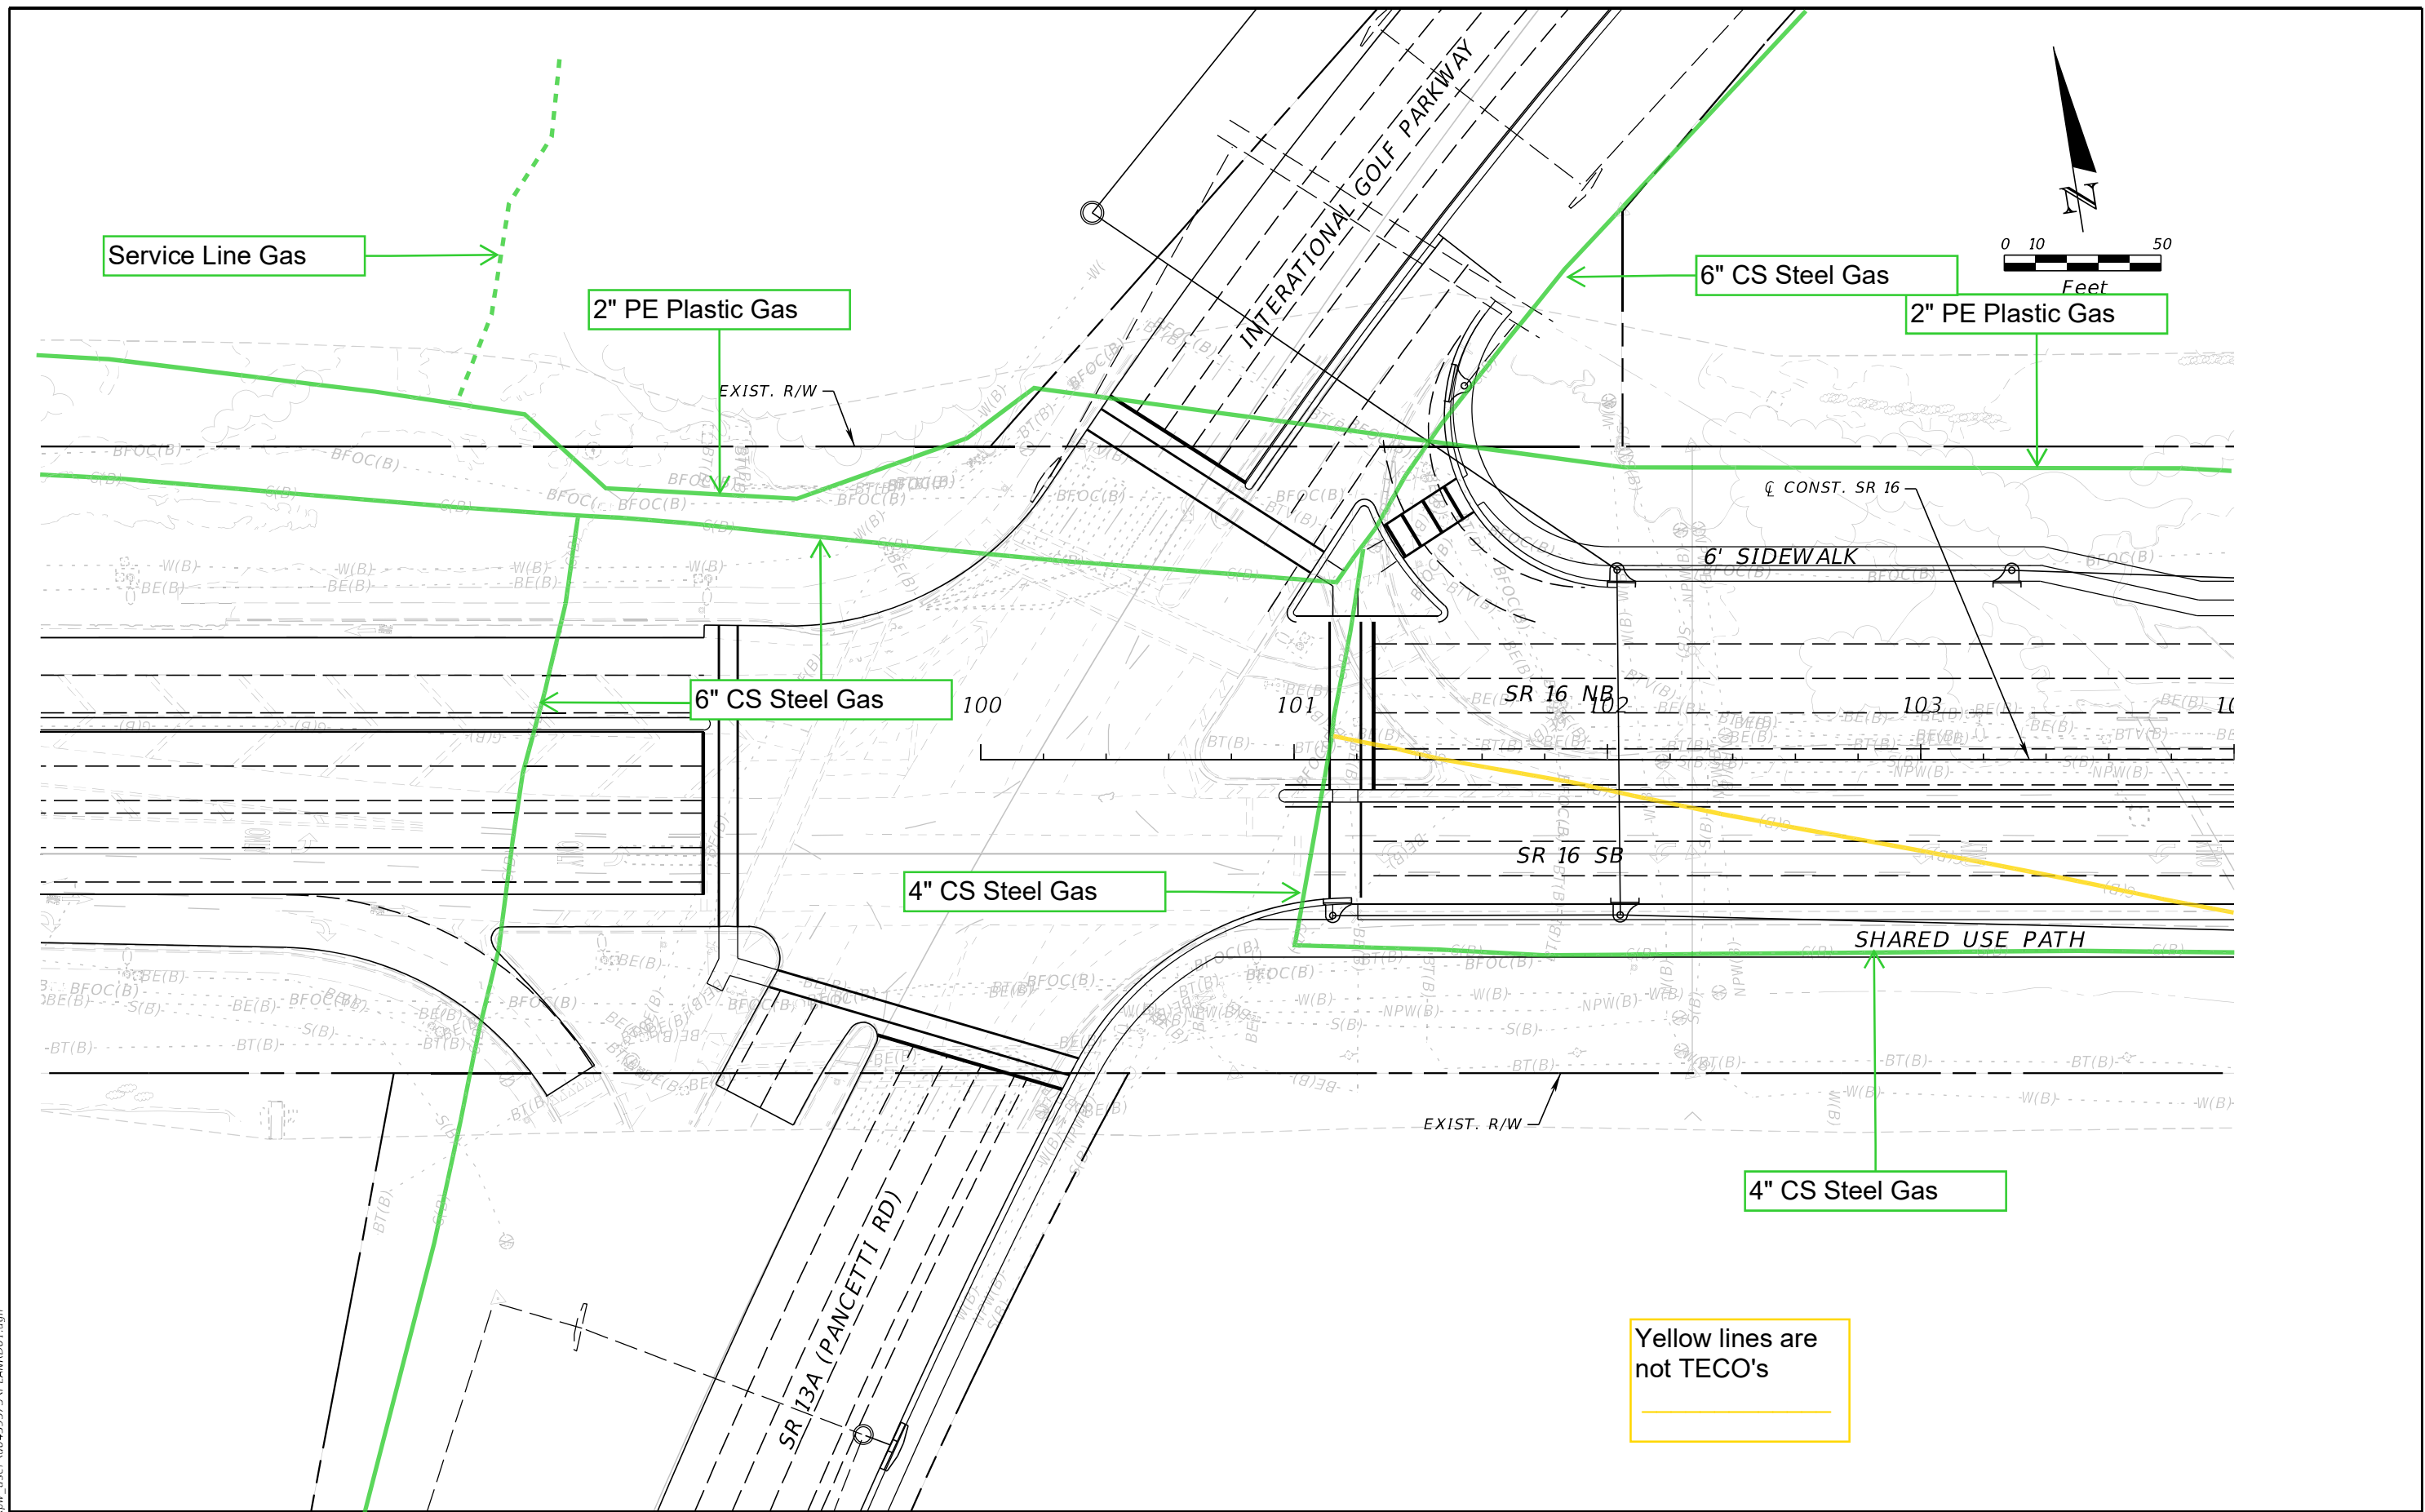

REVISIONS				ENGINEER OF RECORD	STATE OF FLORIDA DEPARTMENT OF TRANSPORTATION			ROADWAY PLAN	SHEET NO.
DATE	DESCRIPTION		DATE	DESCRIPTION	ROAD NO.	COUNTY	FINANCIAL PROJECT ID		SR 16 - PLAN-1
					STEPHEN J. PARK, P.E. LICENSE NUMBER: 77656 RS&H, INC. 10748 DEERWOOD PARK BLVD. SOUTH JACKSONVILLE, FL 32256	SR 16	ST. JOHNS	210447-5-52-01	




8/5/2024 4:28:38 PM BeattyM  
c:\pw\_work\sh\_pw\pw\_user\0439575\PLAINRD01.dgn

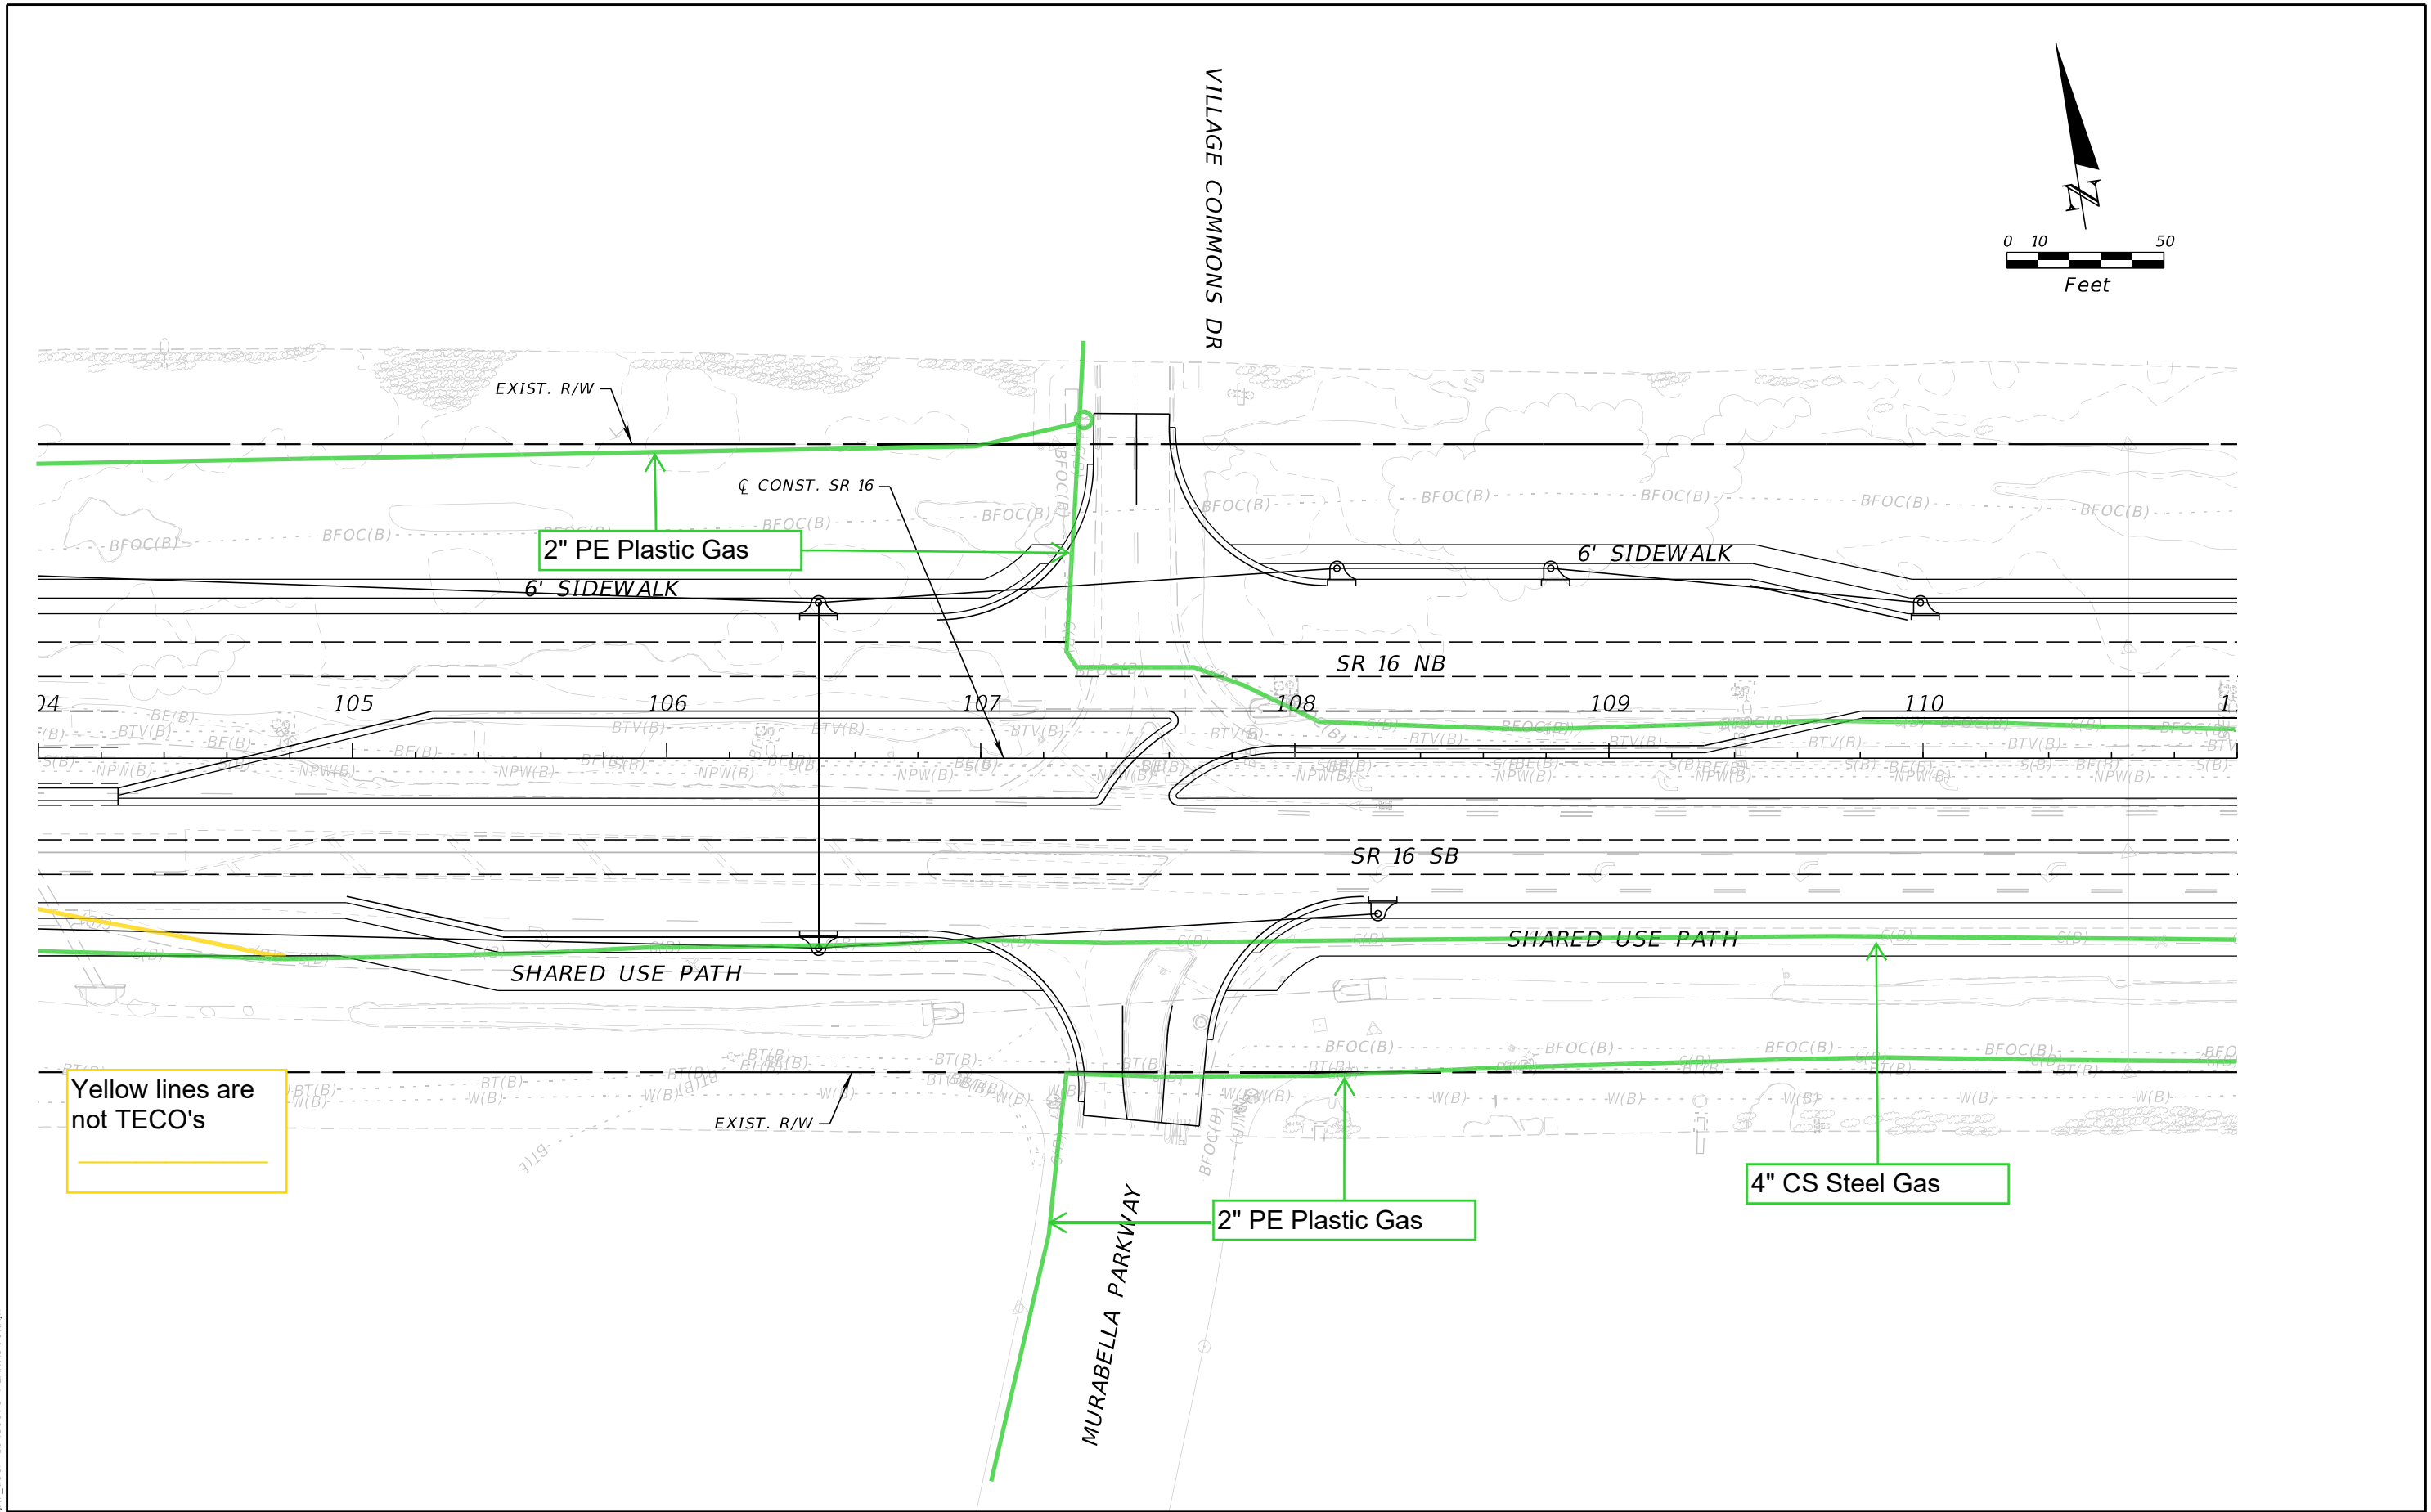

REVISIONS				ENGINEER OF RECORD	STATE OF FLORIDA DEPARTMENT OF TRANSPORTATION			ROADWAY PLAN	SHEET NO.  SR 16 - PLAN - 2
DATE	DESCRIPTION	DATE	DESCRIPTION		ROAD NO.	COUNTY	FINANCIAL PROJECT ID		
				STEPHEN J. PARK, P.E. LICENSE NUMBER: 77656 RS&H, INC. 10748 DEERWOOD PARK BLVD. SOUTH JACKSONVILLE, FL 32256	SR 16	ST. JOHNS	210447-5-52-01		

THE OFFICIAL RECORD OF THIS SHEET IS THE ELECTRONIC FILE DIGITALLY SIGNED AND SEALED UNDER RULE 61G15-23.004, F.A.C.


8/5/2024 4:28:39 PM BeattyM  
c:\pw\_work\sh\_pw\pw\_user\00439575\PLANRD01.dgn

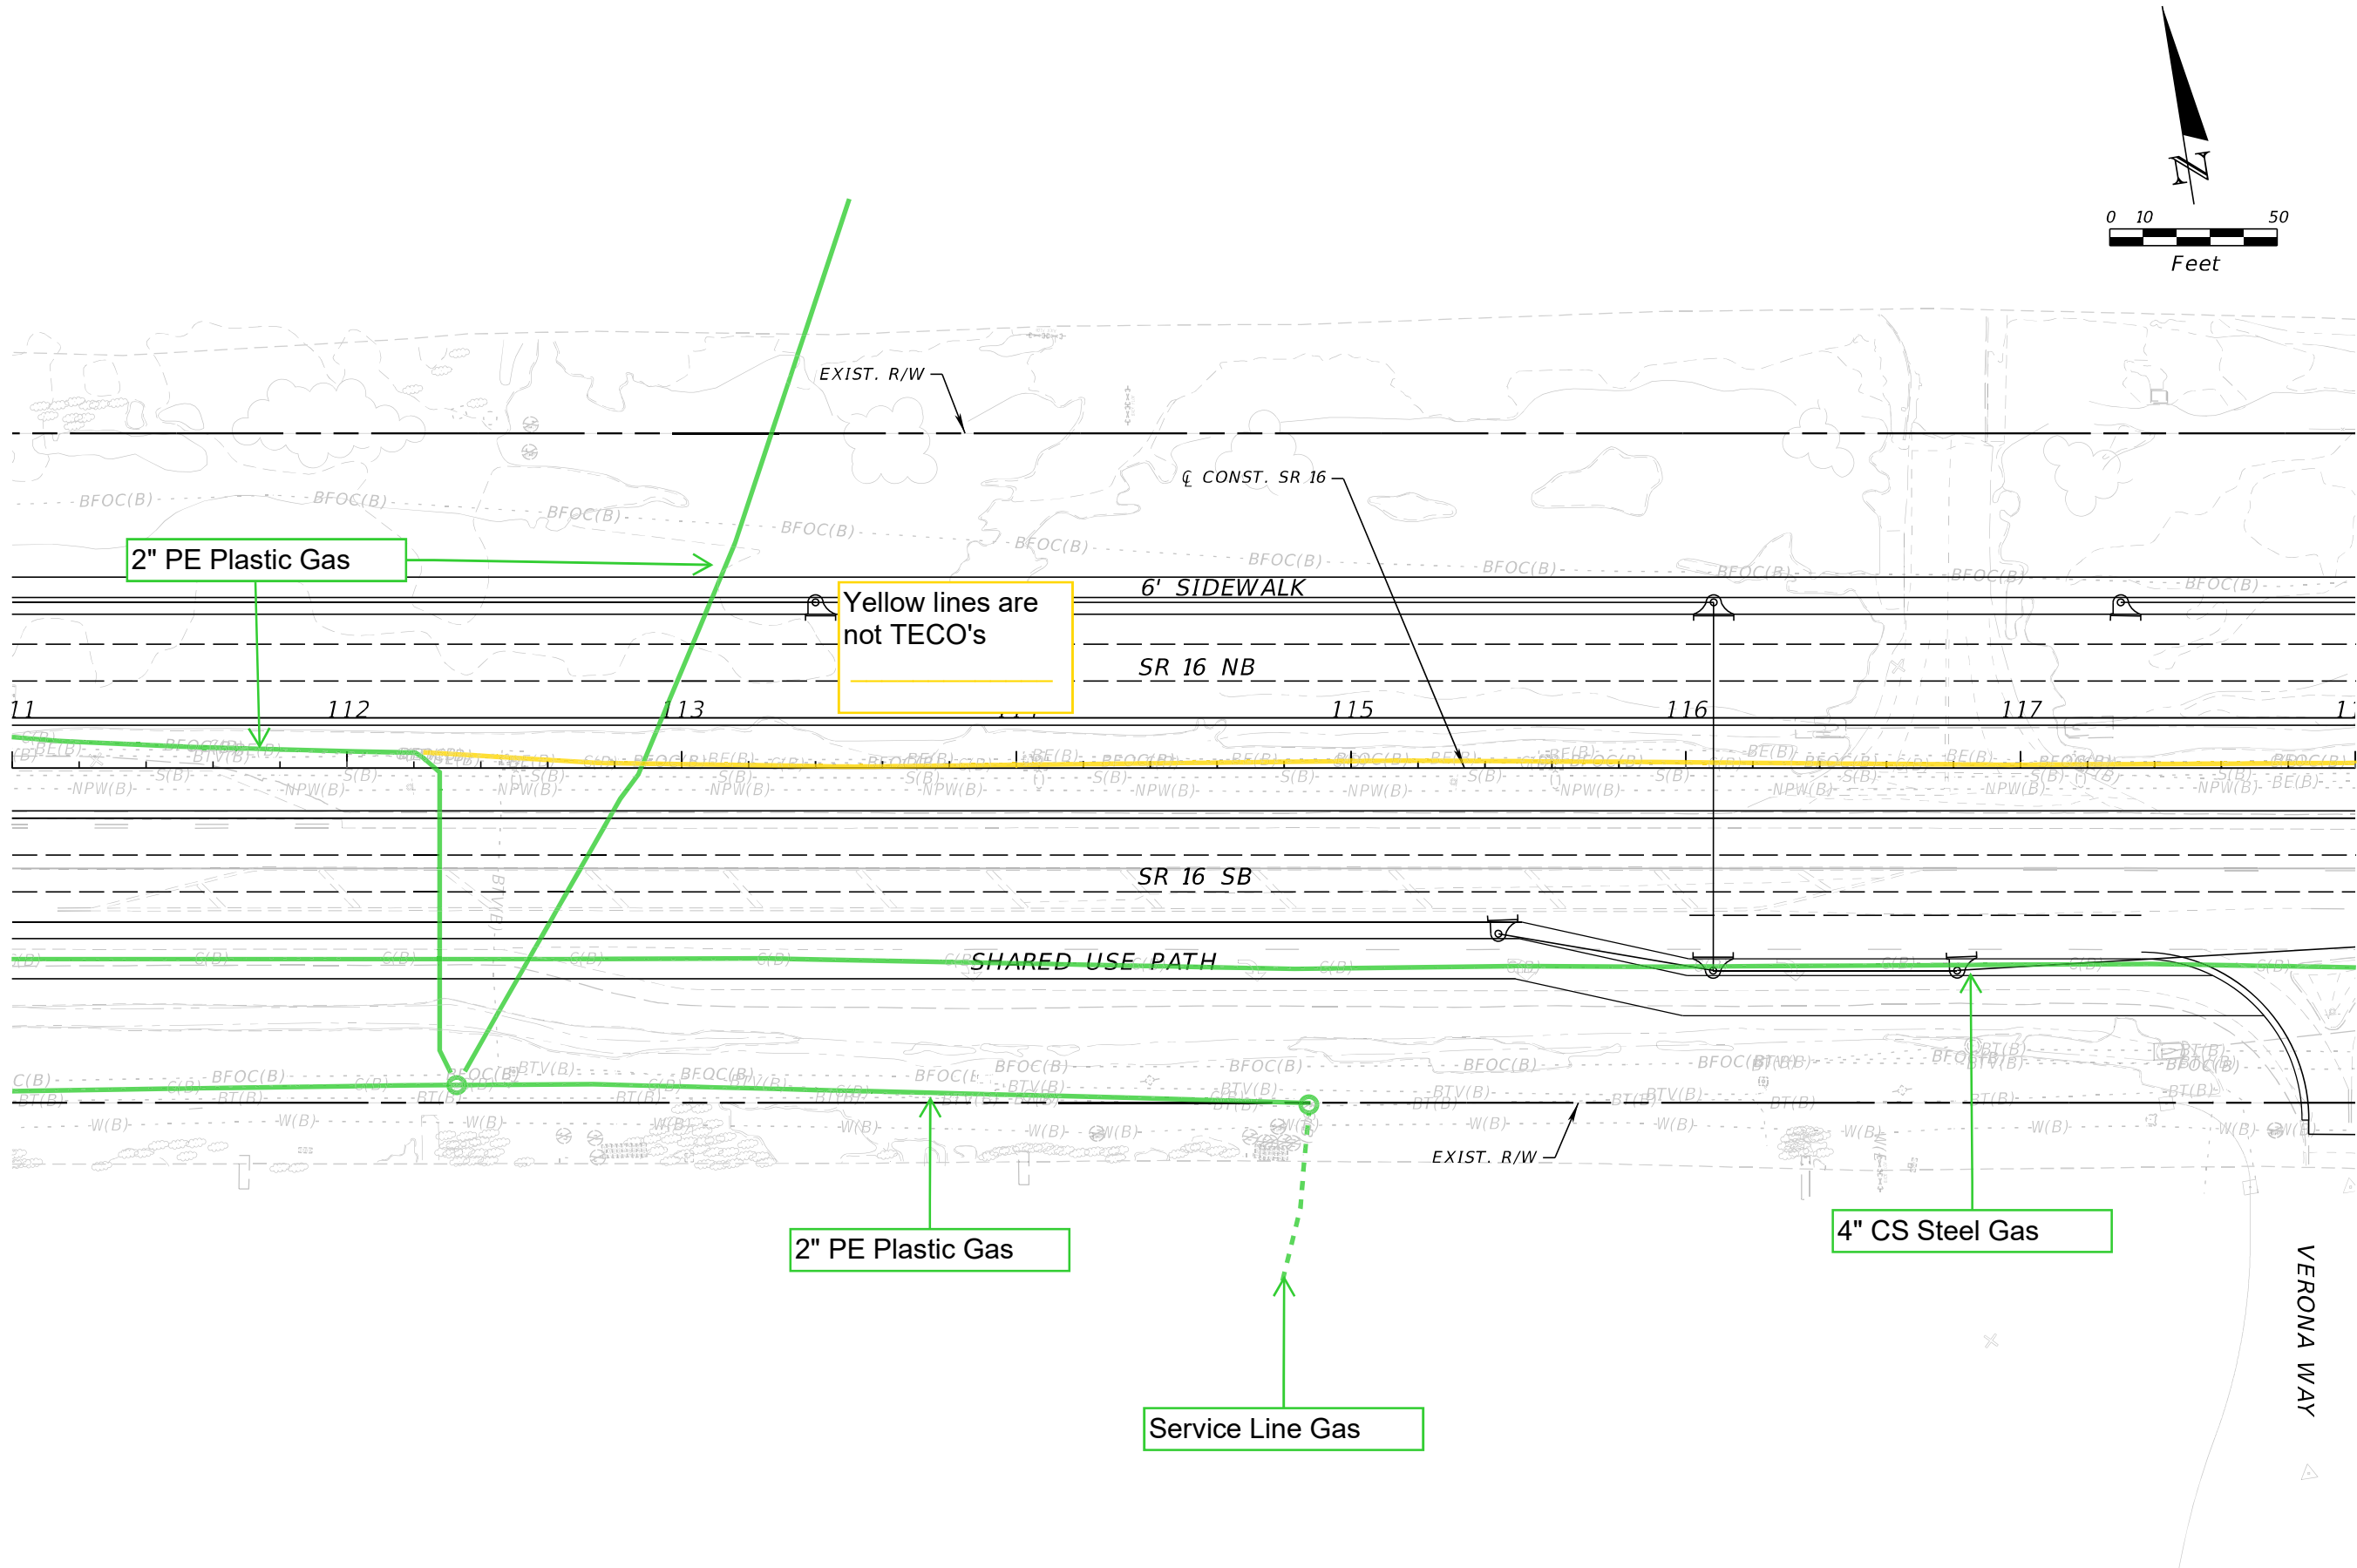

REVISIONS				ENGINEER OF RECORD	STATE OF FLORIDA DEPARTMENT OF TRANSPORTATION			SHEET NO.
DATE	DESCRIPTION	DATE	DESCRIPTION	STEPHEN J. PARK, P.E. LICENSE NUMBER: 77656 RS&H, INC. 10748 DEERWOOD PARK BLVD. SOUTH JACKSONVILLE, FL 32256	ROAD NO.	COUNTY	FINANCIAL PROJECT ID	
					SR 16	ST. JOHNS	210447-5-52-01	
								11x17 Plan Only

THE OFFICIAL RECORD OF THIS SHEET IS THE ELECTRONIC FILE DIGITALLY SIGNED AND SEALED UNDER RULE 61G15-23.004, F.A.C.



8/5/2024 4:28:40 PM BeattyM  
c:\pw\_work\sh\_pw\pw\_user\0439575\PLAINRD01.dgn

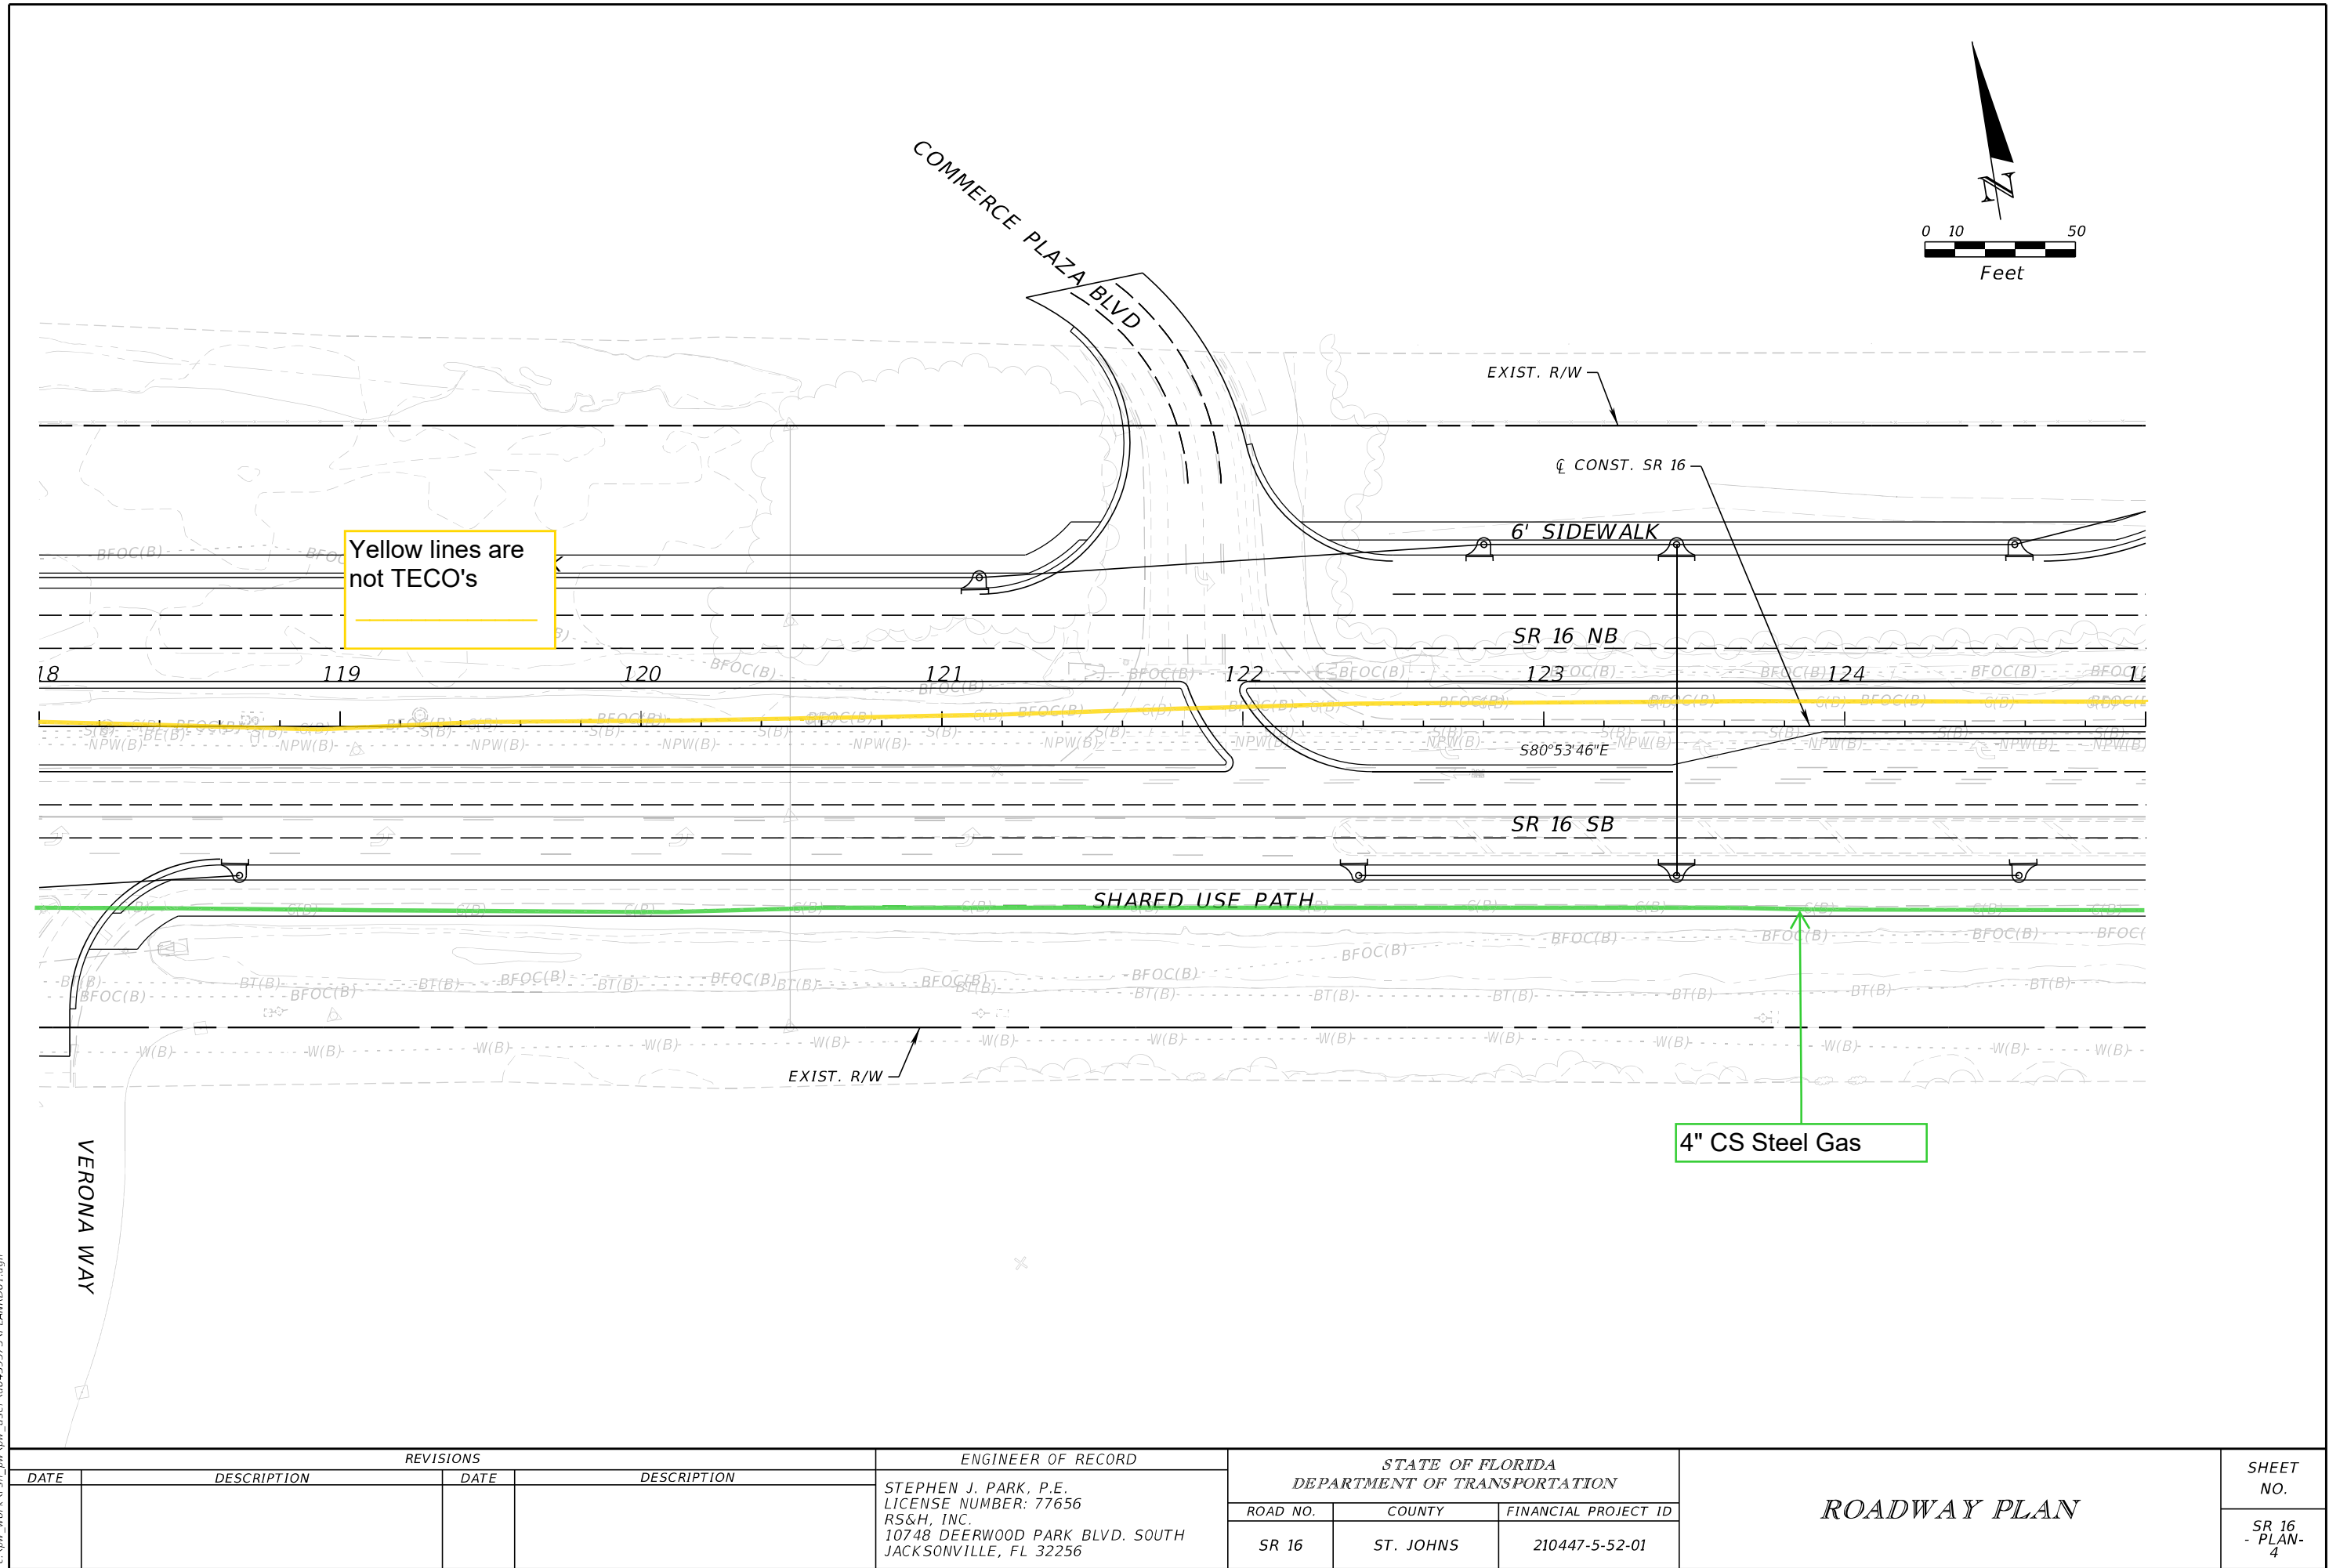

REVISIONS				ENGINEER OF RECORD	STATE OF FLORIDA DEPARTMENT OF TRANSPORTATION			ROADWAY PLAN	SHEET NO.  SR 16 - PLAN - 4
DATE	DESCRIPTION	DATE	DESCRIPTION		ROAD NO.	COUNTY	FINANCIAL PROJECT ID		
				STEPHEN J. PARK, P.E. LICENSE NUMBER: 77656 RS&H, INC. 10748 DEERWOOD PARK BLVD. SOUTH JACKSONVILLE, FL 32256	SR 16	ST. JOHNS	210447-5-52-01		

THE OFFICIAL RECORD OF THIS SHEET IS THE ELECTRONIC FILE DIGITALLY SIGNED AND SEALED UNDER RULE 61G15-23.004, F.A.C.


8/5/2024 4:28:40 PM BeattyM  
c:\pw\_work\sh\_pw\pw\_user\0439575\PLANRD01.dgn

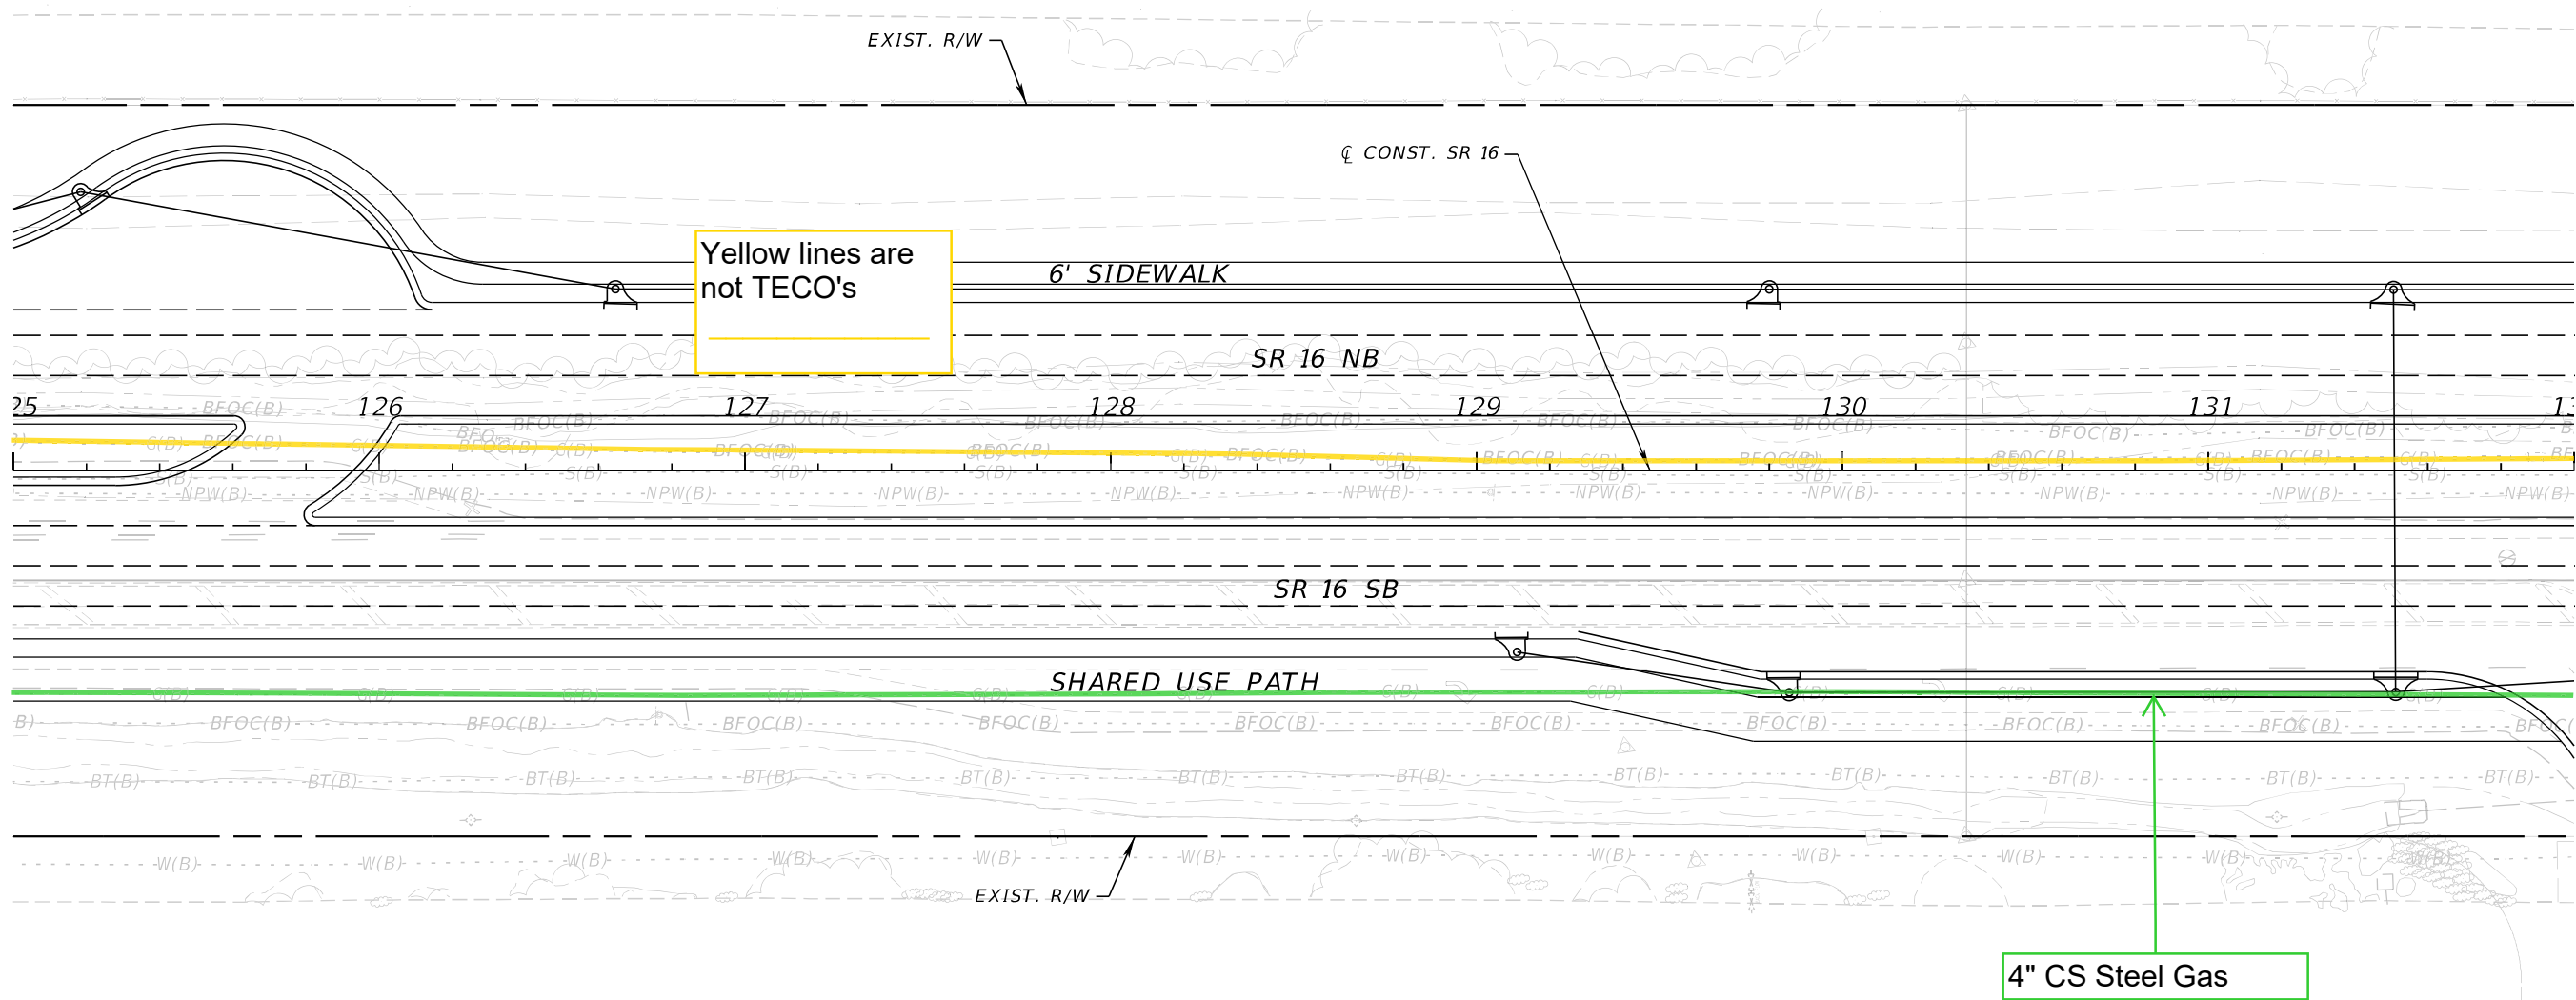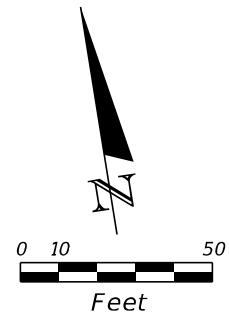

REVISIONS				ENGINEER OF RECORD		STATE OF FLORIDA DEPARTMENT OF TRANSPORTATION			ROADWAY PLAN	SHEET NO.
DATE	DESCRIPTION	DATE	DESCRIPTION	STEPHEN J. PARK, P.E. LICENSE NUMBER: 77656 RS&H, INC. 10748 DEERWOOD PARK BLVD. SOUTH JACKSONVILLE, FL 32256		ROAD NO.	COUNTY	FINANCIAL PROJECT ID		
						SR 16	ST. JOHNS	210447-5-52-01		SR 16 - PLAN- 5

THE OFFICIAL RECORD OF THIS SHEET IS THE ELECTRONIC FILE DIGITALLY SIGNED AND SEALED UNDER RULE 61G15-23.004, F.A.C.


8/5/2024 4:28:41 PM BeattyM  
c:\pw\_work\sh\_pw\pw\_user\0439575\PLANRD01.dgn

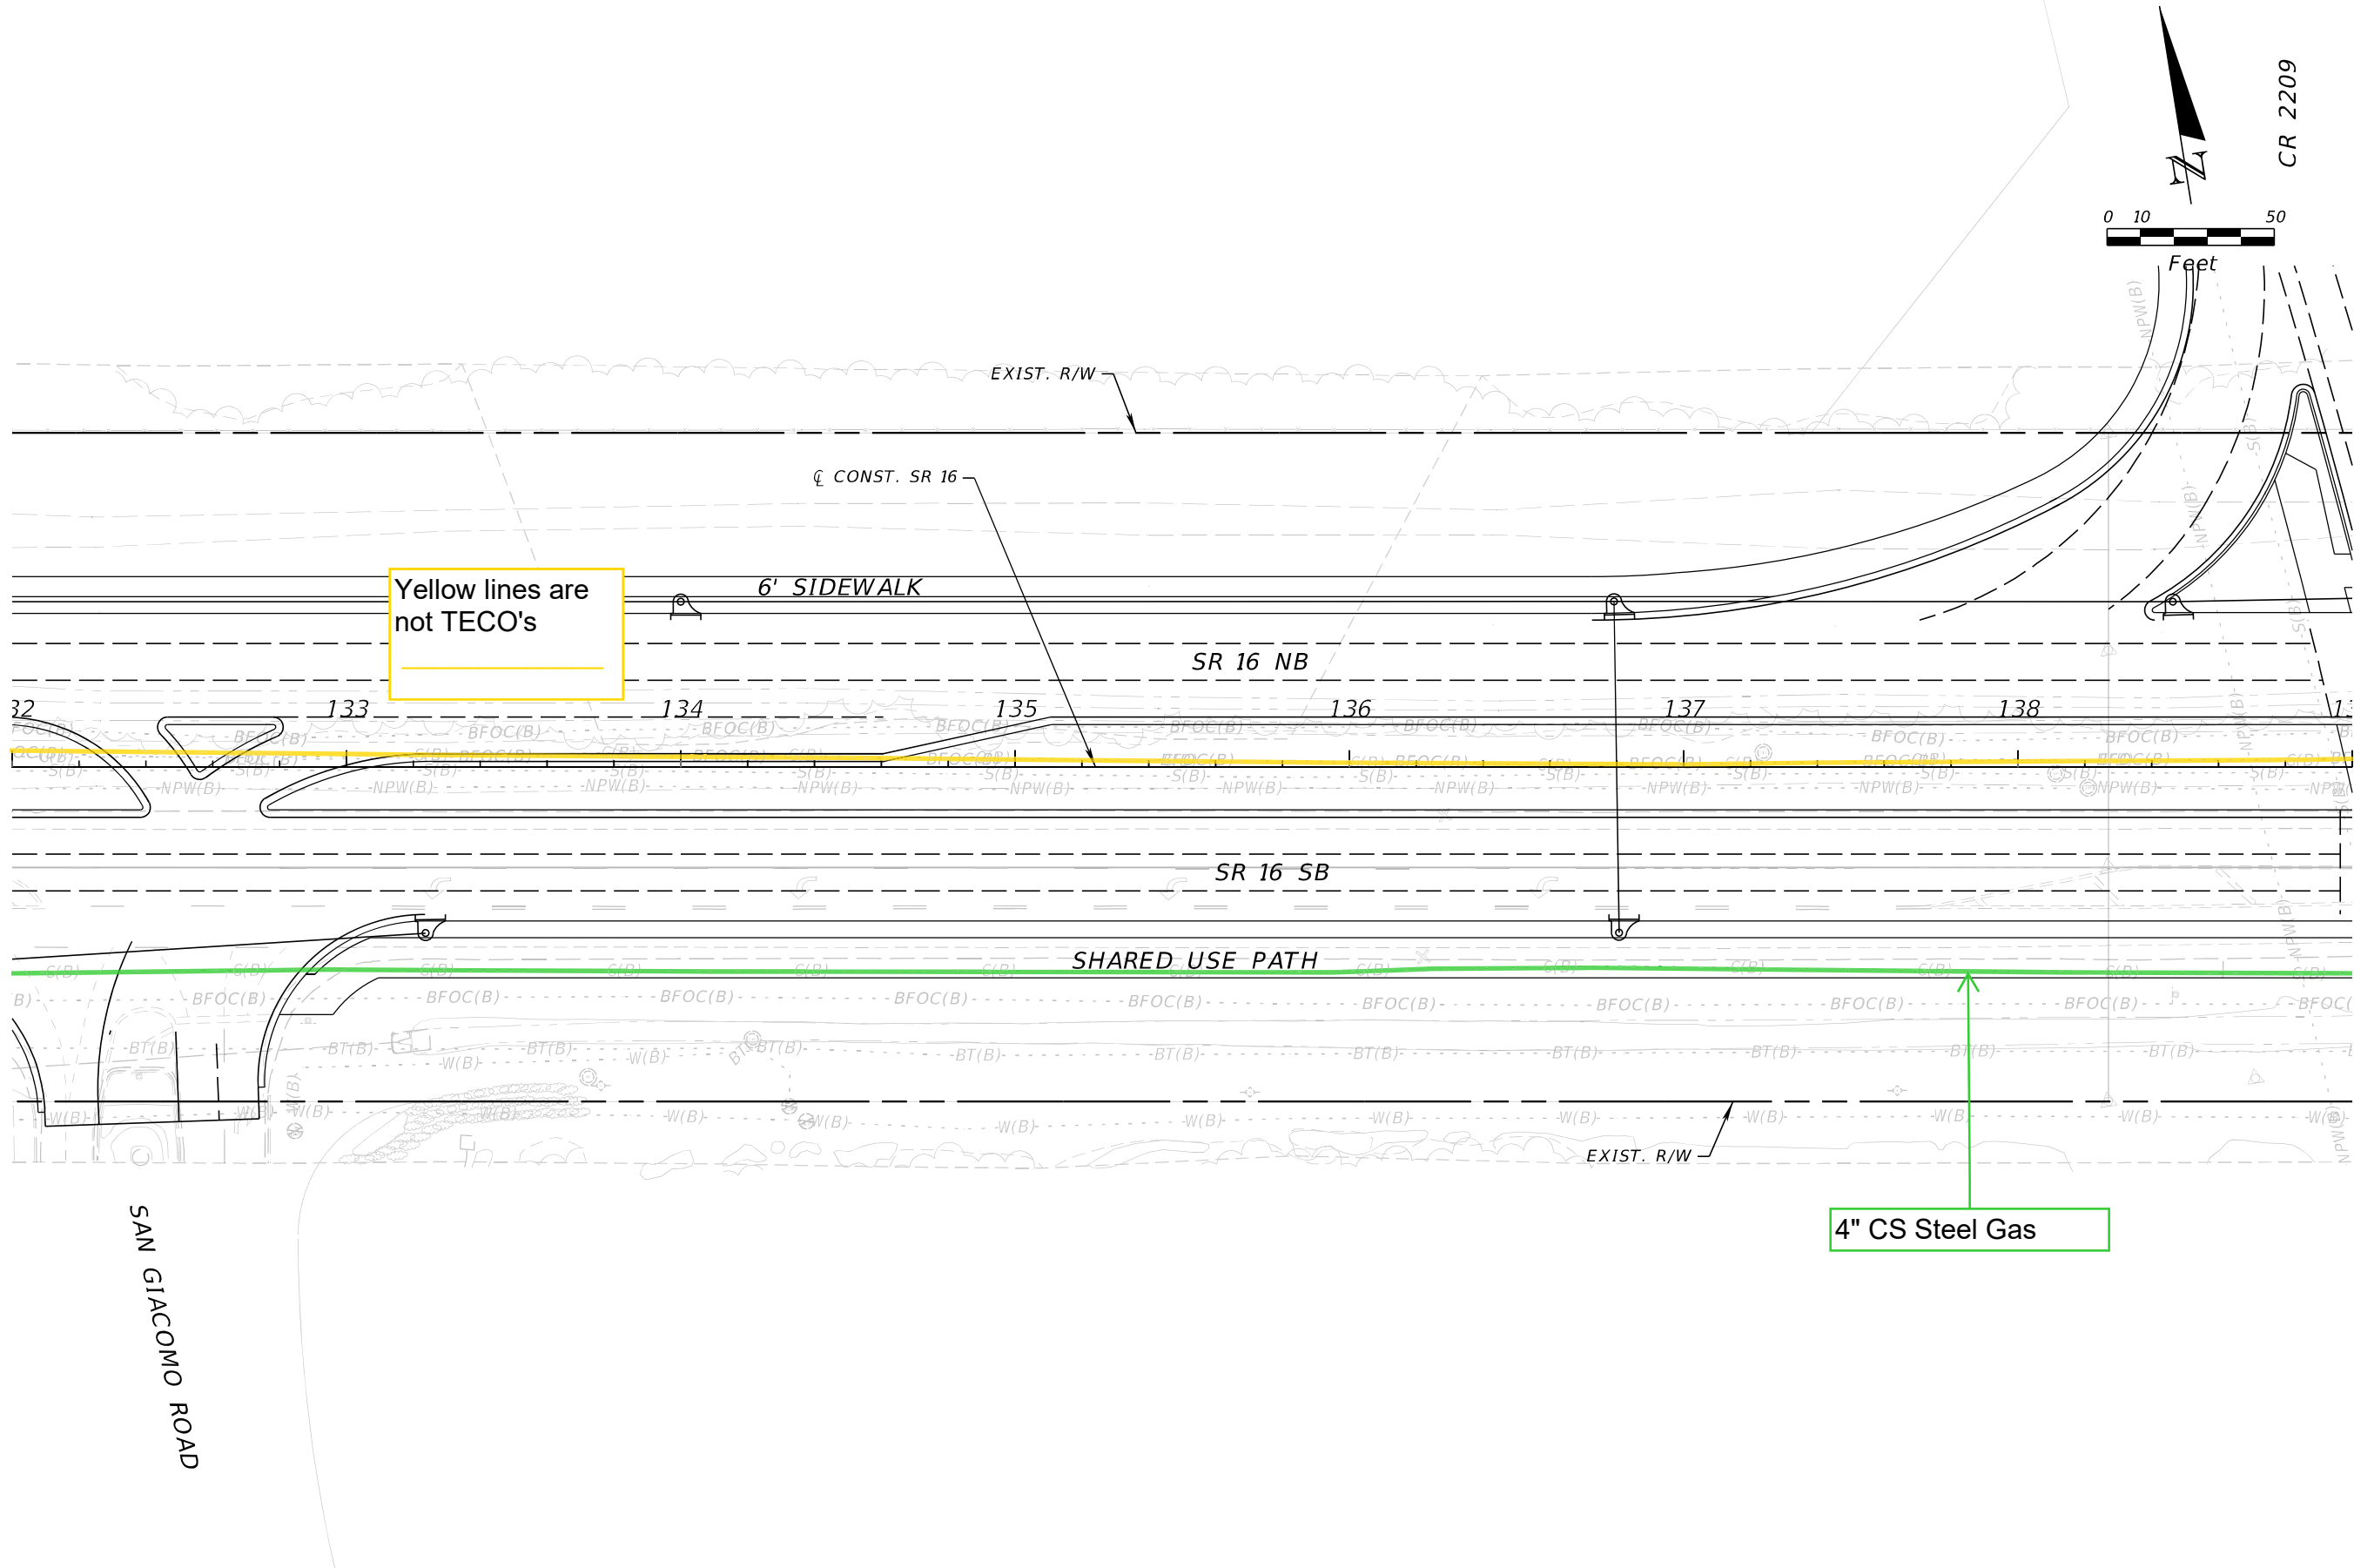

REVISIONS				ENGINEER OF RECORD		STATE OF FLORIDA DEPARTMENT OF TRANSPORTATION			ROADWAY PLAN	SHEET NO.  SR 16 - PLAN - 6
DATE	DESCRIPTION	DATE	DESCRIPTION	STEPHEN J. PARK, P.E. LICENSE NUMBER: 77656 RS&H, INC. 10748 DEERWOOD PARK BLVD. SOUTH JACKSONVILLE, FL 32256		ROAD NO.	COUNTY	FINANCIAL PROJECT ID		
						SR 16	ST. JOHNS	210447-5-52-01		


THE OFFICIAL RECORD OF THIS SHEET IS THE ELECTRONIC FILE DIGITALLY SIGNED AND SEALED UNDER RULE 61G15-23.004, F.A.C.



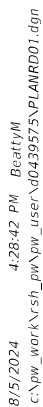

THE OFFICIAL RECORD OF THIS SHEET IS THE ELECTRONIC FILE DIGITALLY SIGNED AND SEALED UNDER RULE 81G13-23.004, F.A.C.


8/5/2024 4:28:42 PM BeattyM  
c:\pw\_work\sh\_pw\pw\_user\0439575\PLANRD01.dgn

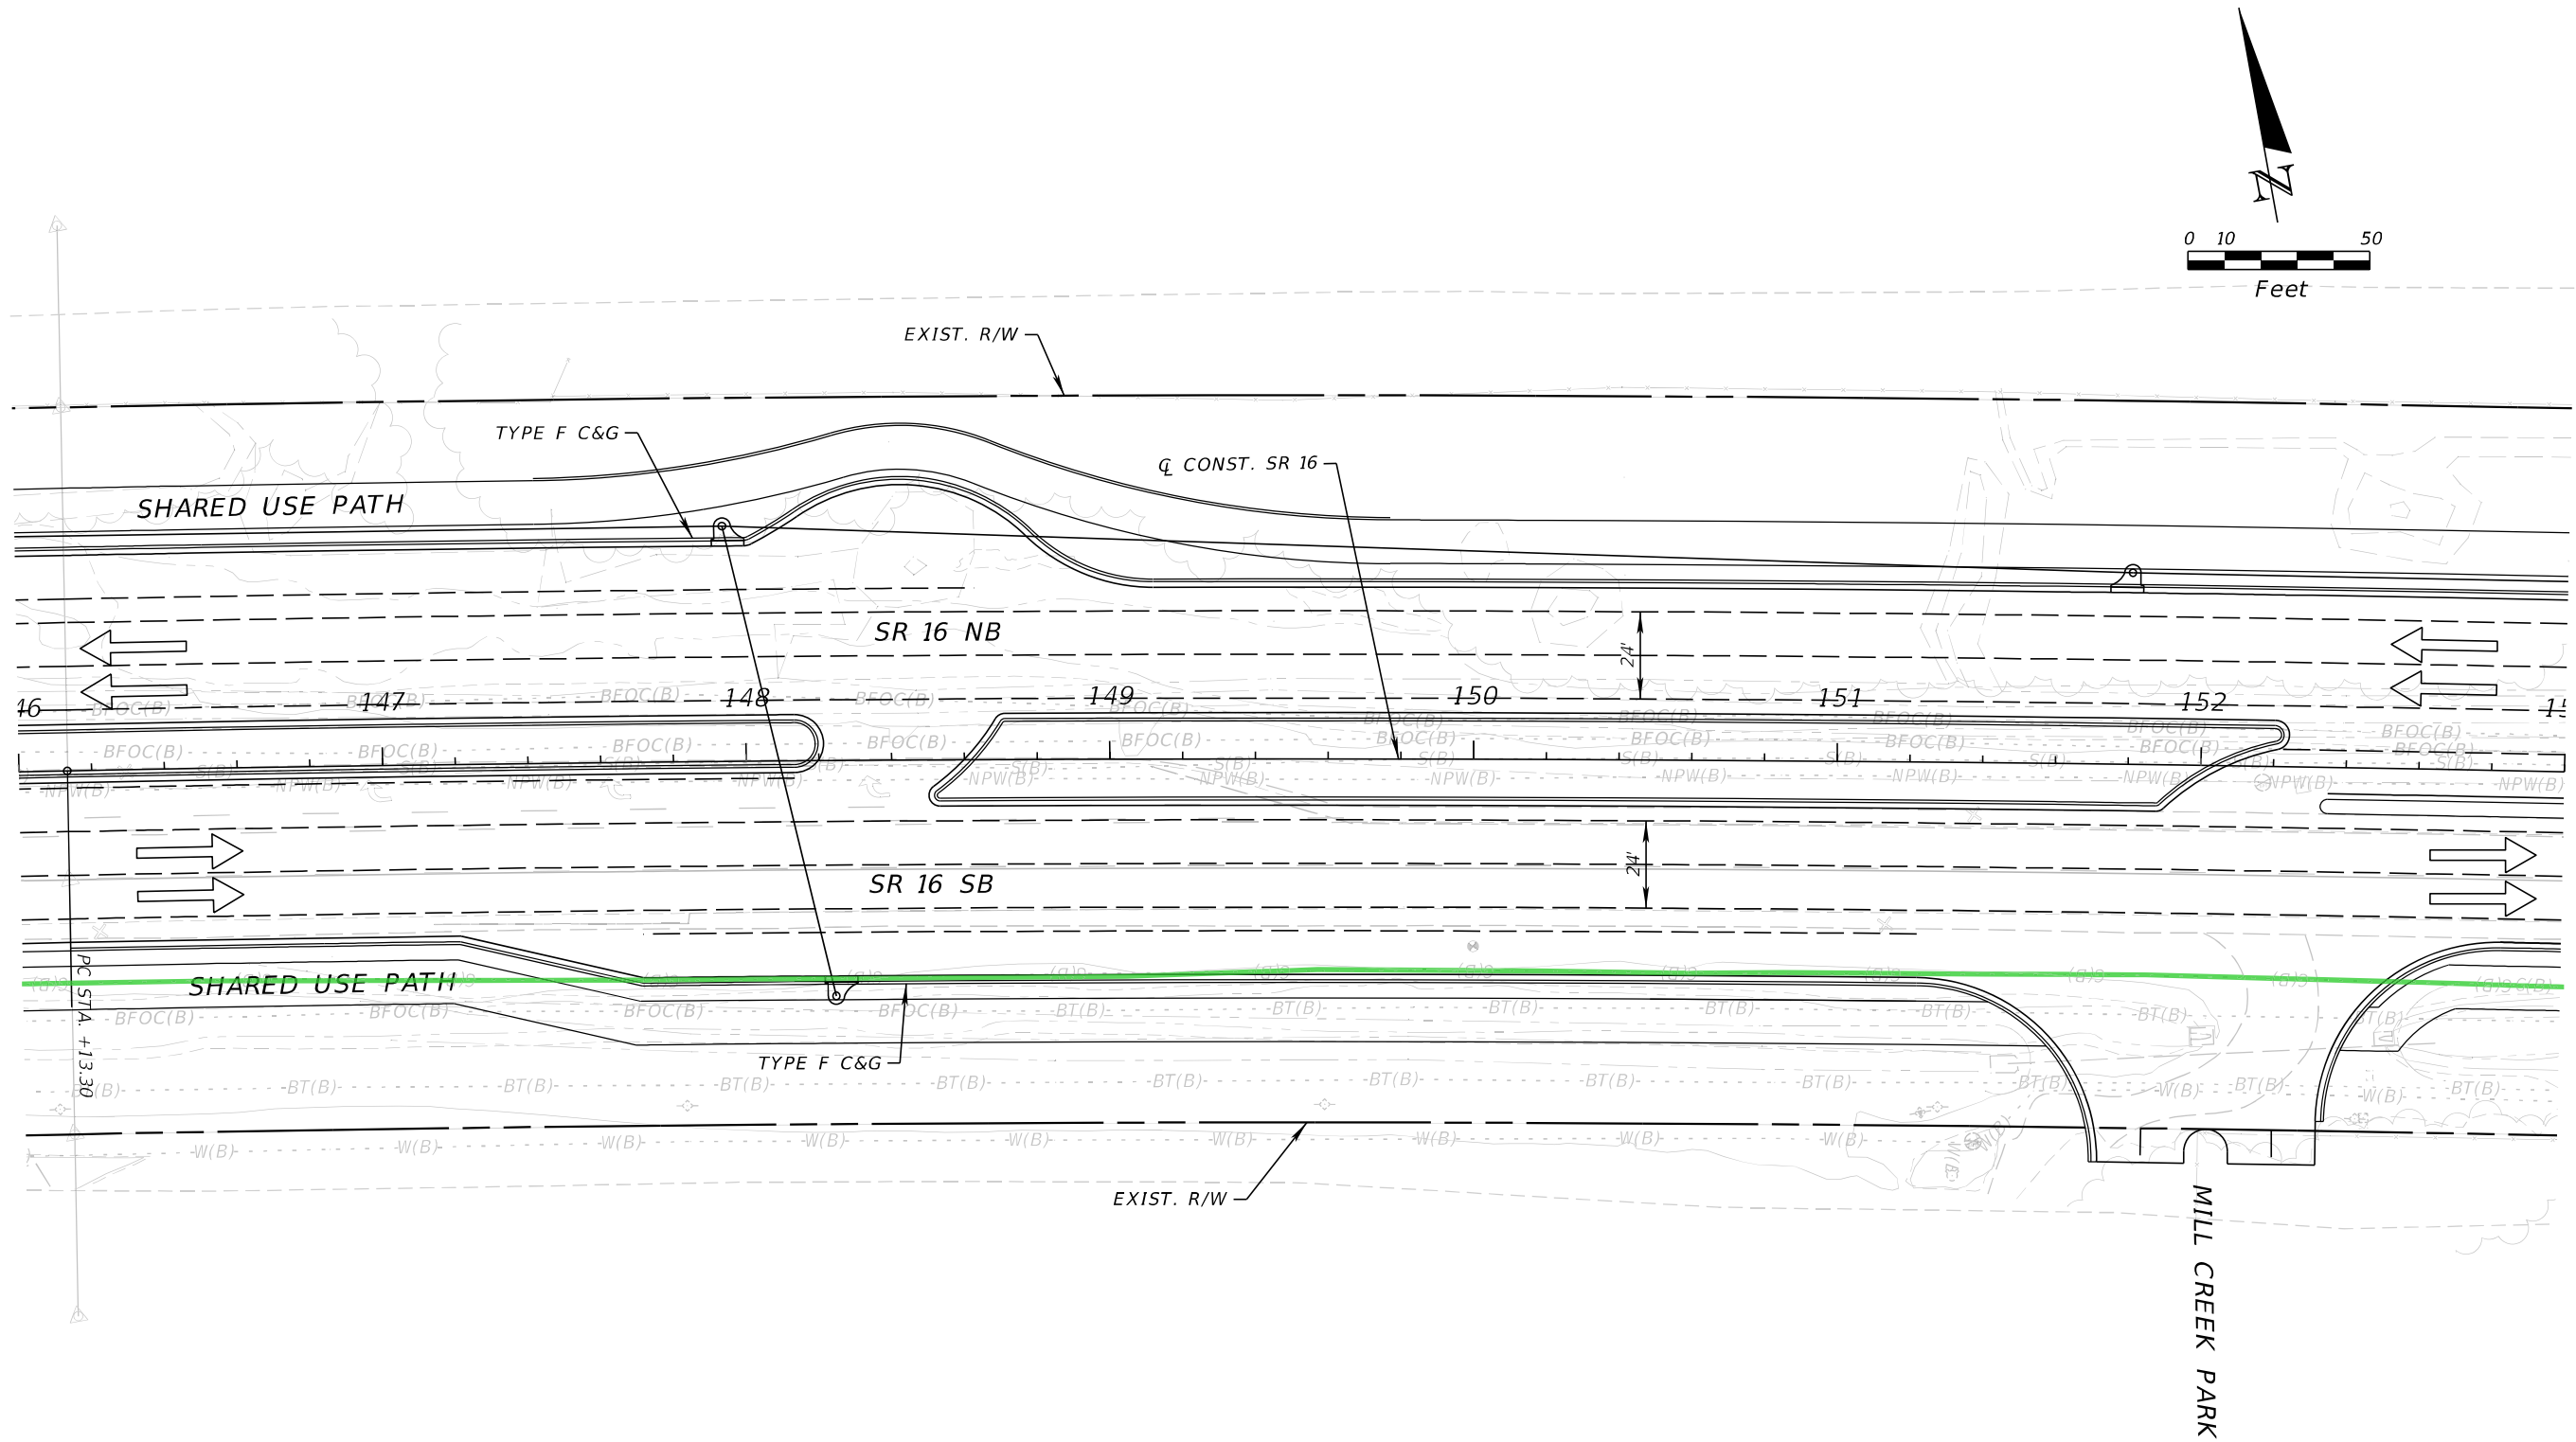

REVISIONS				ENGINEER OF RECORD	STATE OF FLORIDA DEPARTMENT OF TRANSPORTATION			ROADWAY PLAN	SHEET NO.  SR 16 - PLAN - 8
DATE	DESCRIPTION	DATE	DESCRIPTION		ROAD NO.	COUNTY	FINANCIAL PROJECT ID		
				STEPHEN J. PARK, P.E. LICENSE NUMBER: 77656 RS&H, INC. 10748 DEERWOOD PARK BLVD. SOUTH JACKSONVILLE, FL 32256	SR 16	ST. JOHNS	210447-5-52-01		

THE OFFICIAL RECORD OF THIS SHEET IS THE ELECTRONIC FILE DIGITALLY SIGNED AND SEALED UNDER RULE 61G15-23.004, F.A.C.


8/5/2024 4:28:43 PM BeattyM  
c:\pw\_work\sh\_pw\pw\_user\0439575\PLANRD01.dgn

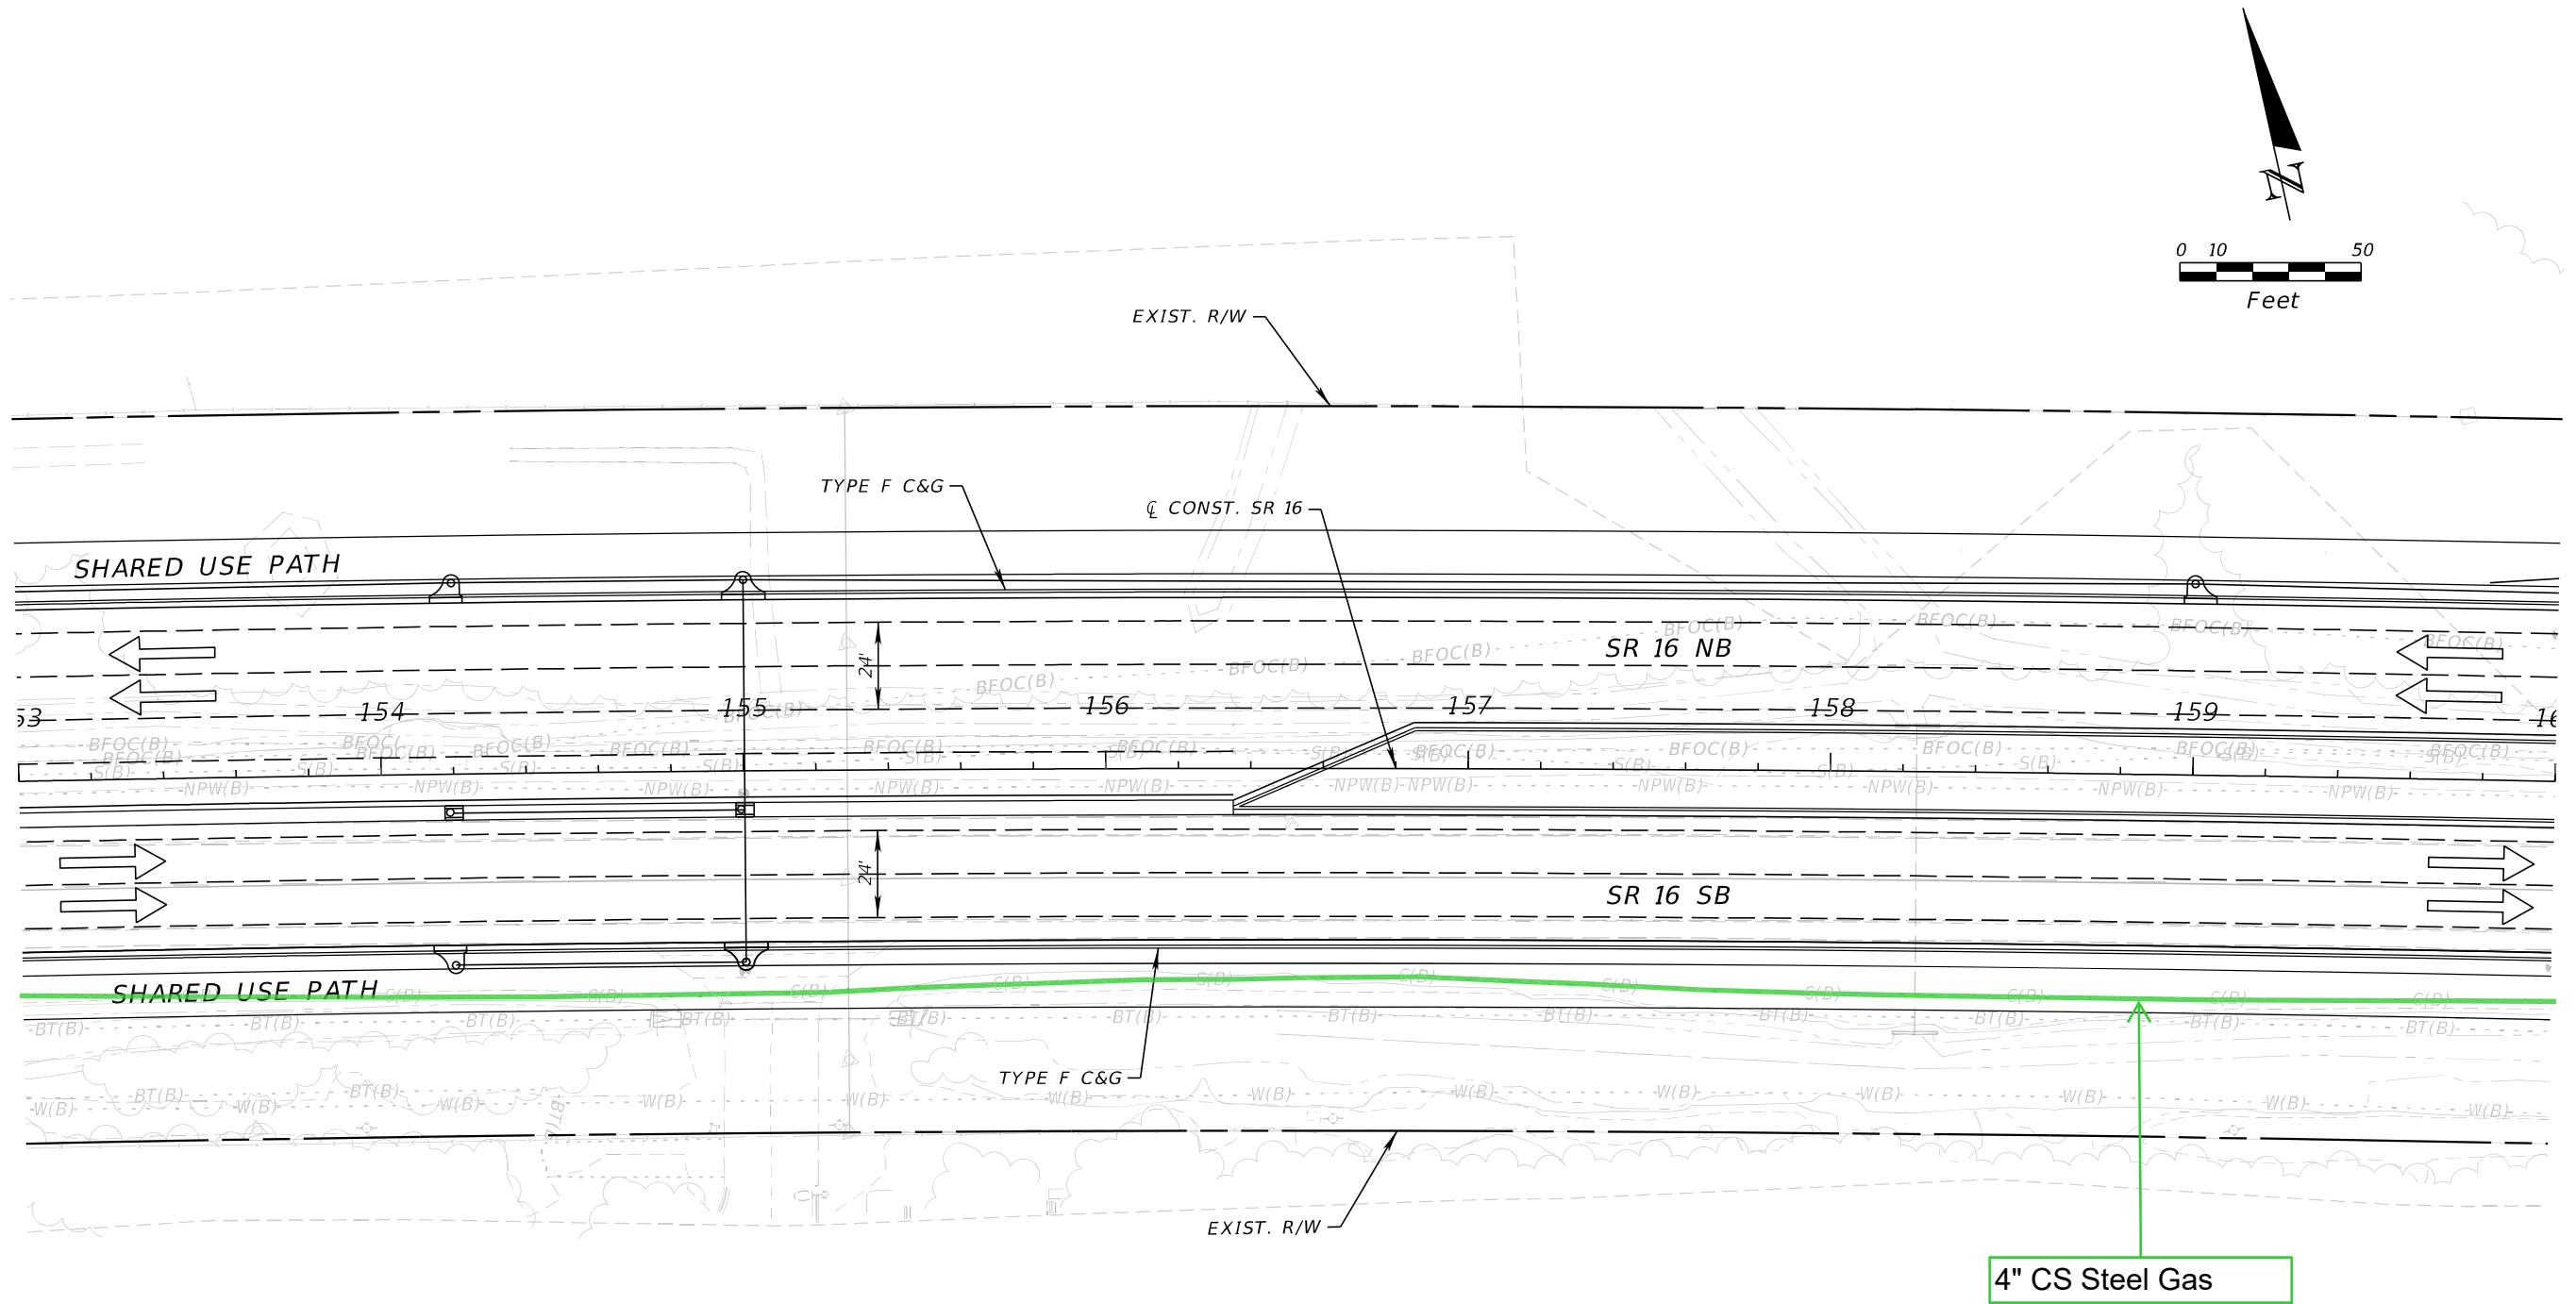

REVISIONS				ENGINEER OF RECORD		STATE OF FLORIDA DEPARTMENT OF TRANSPORTATION			ROADWAY PLAN	SHEET NO.  SR 16 - PLAN - 9
DATE	DESCRIPTION	DATE	DESCRIPTION	STEPHEN J. PARK, P.E. LICENSE NUMBER: 77656 RS&H, INC. 10748 DEERWOOD PARK BLVD. SOUTH JACKSONVILLE, FL 32256		ROAD NO.	COUNTY	FINANCIAL PROJECT ID		
						SR 16	ST. JOHNS	210447-5-52-01		

THE OFFICIAL RECORD OF THIS SHEET IS THE ELECTRONIC FILE DIGITALLY SIGNED AND SEALED UNDER RULE 61G15-23.004, F.A.C.

8/5/2024 4:28:43 PM BeattyM  
c:\pw\_work\sh\_pw\pw\_user\0439575\PLANRD01.dgn

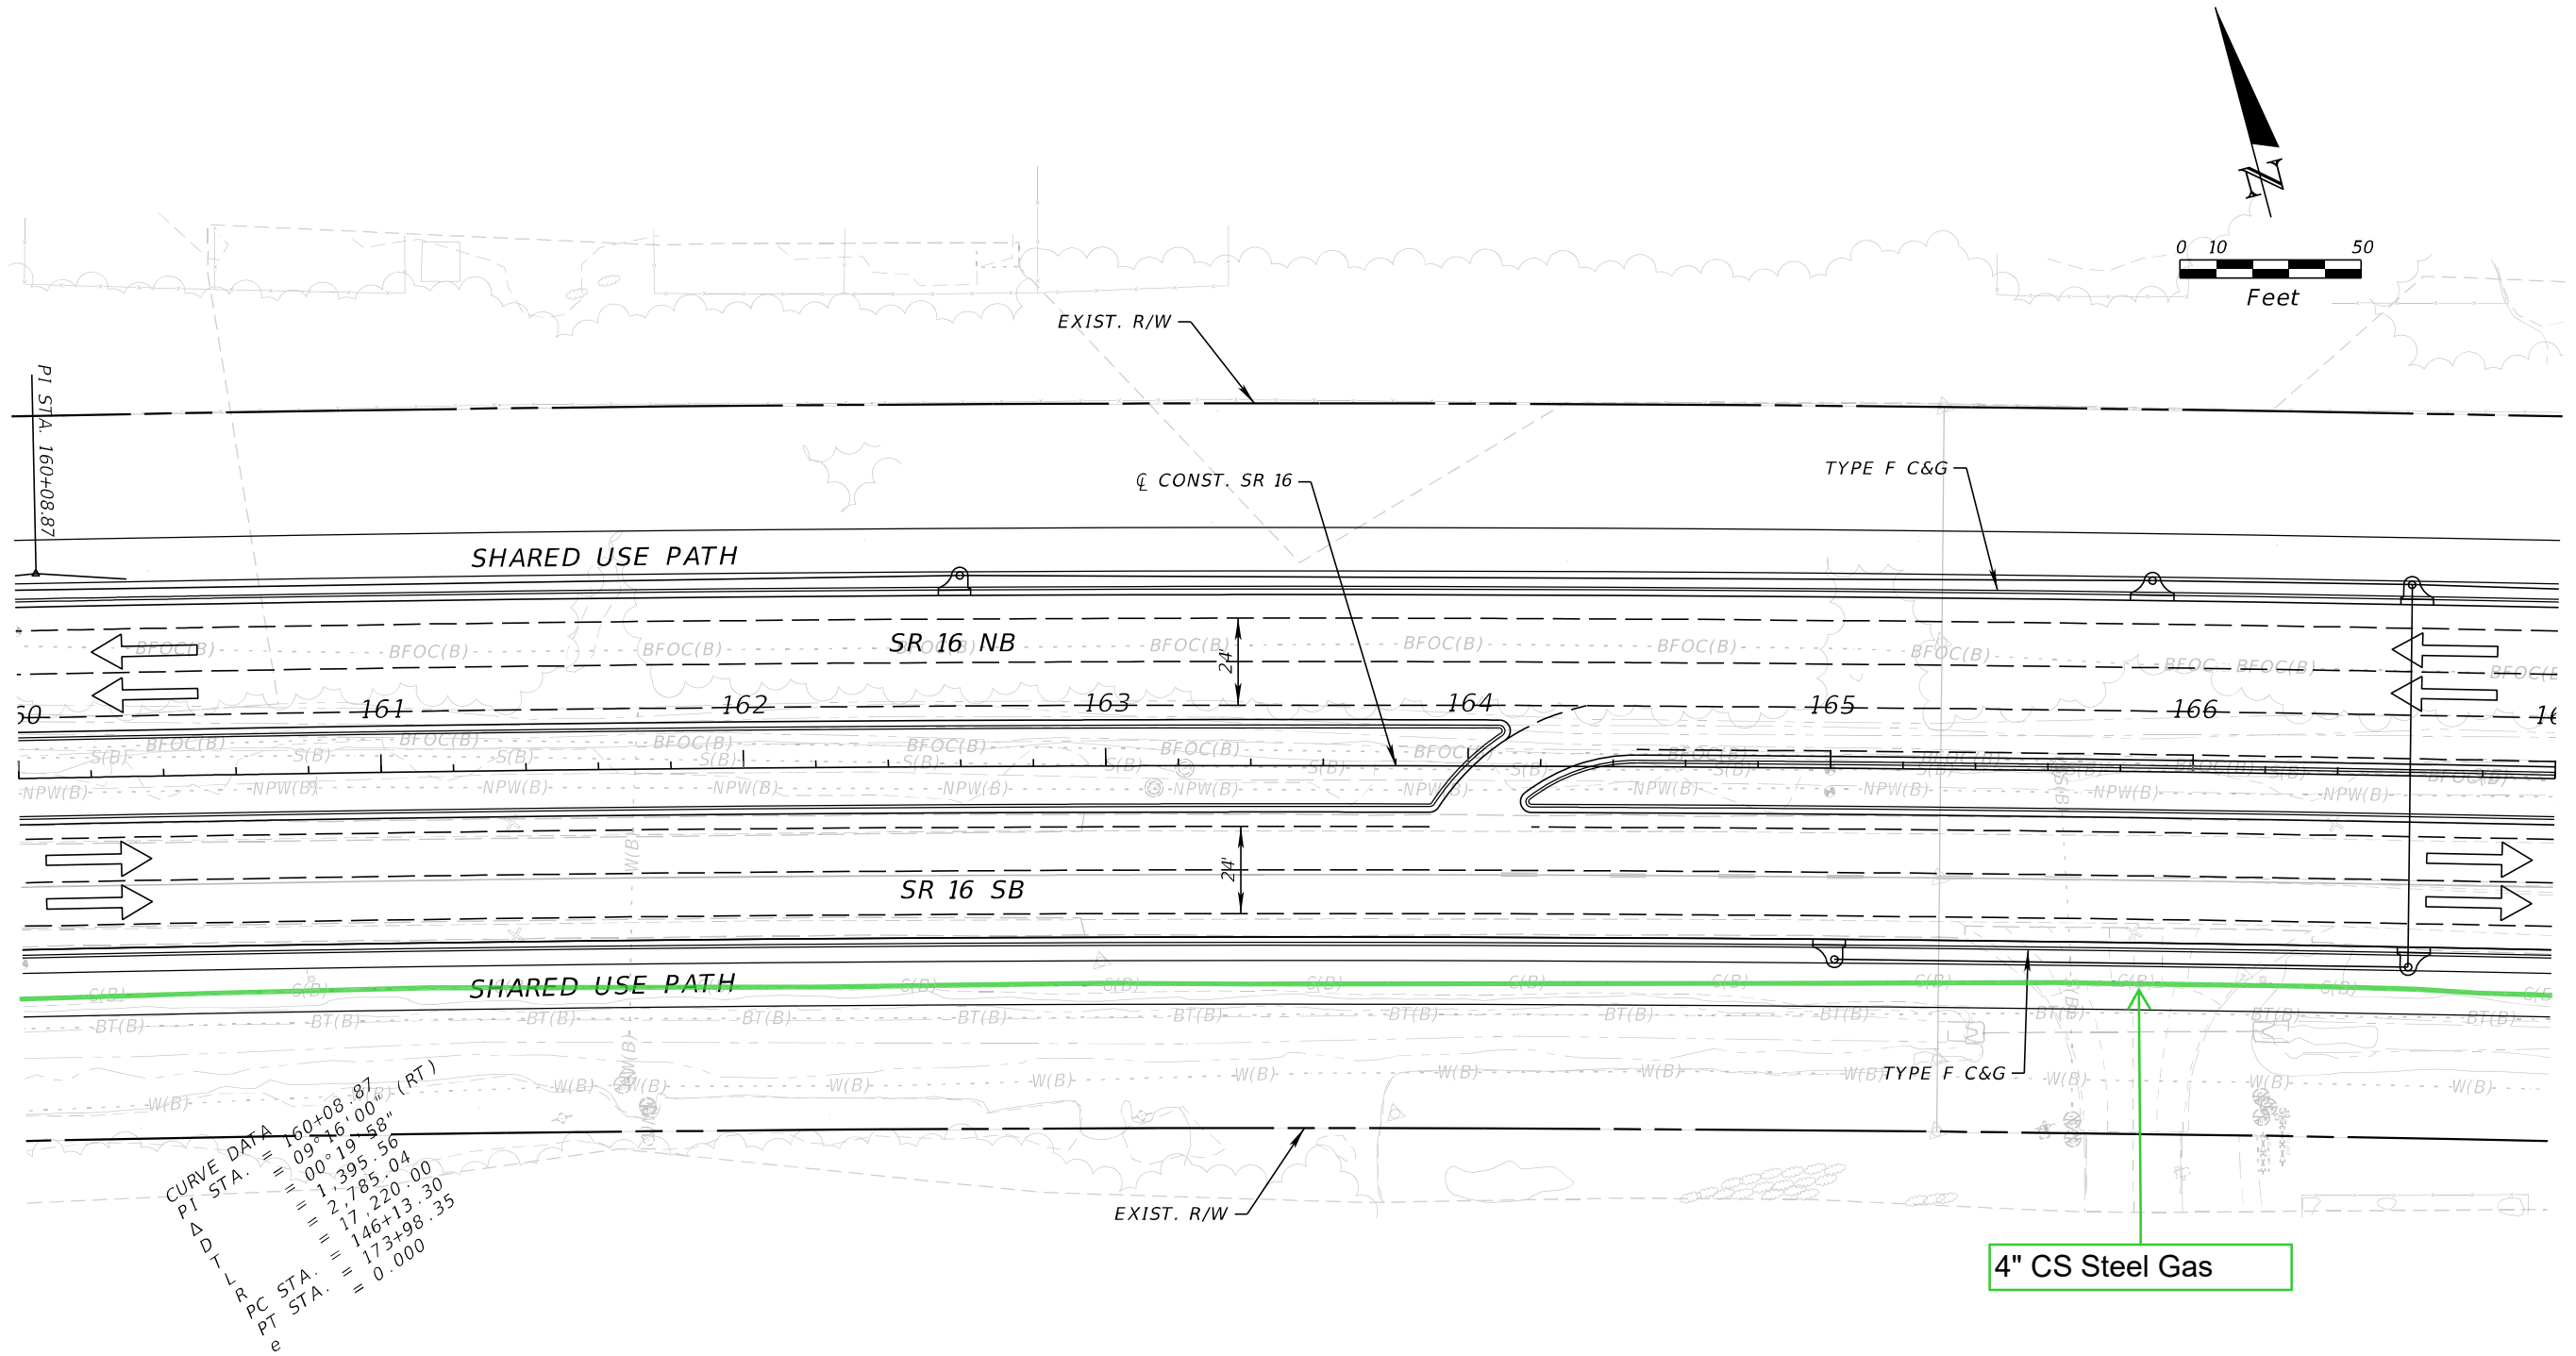

REVISIONS			
DATE	DESCRIPTION	DATE	DESCRIPTION

ENGINEER OF RECORD	
STEPHEN J. PARK, P.E. LICENSE NUMBER: 77656 RS&H, INC. 10748 DEERWOOD PARK BLVD. SOUTH JACKSONVILLE, FL 32256	


STATE OF FLORIDA DEPARTMENT OF TRANSPORTATION		
ROAD NO.	COUNTY	FINANCIAL PROJECT ID
SR 16	ST. JOHNS	210447-5-52-01

ROADWAY PLAN	

SHEET NO.
SR 16 - PLAN - 10

THE OFFICIAL RECORD OF THIS SHEET IS THE ELECTRONIC FILE DIGITALLY SIGNED AND SEALED UNDER RULE 61G15-23.004, F.A.C.

8/5/2024 4:28:44 PM BeattyM  
c:\pw\_work\sh\_pw\pw\_user\0439575\PLANRD01.dgn

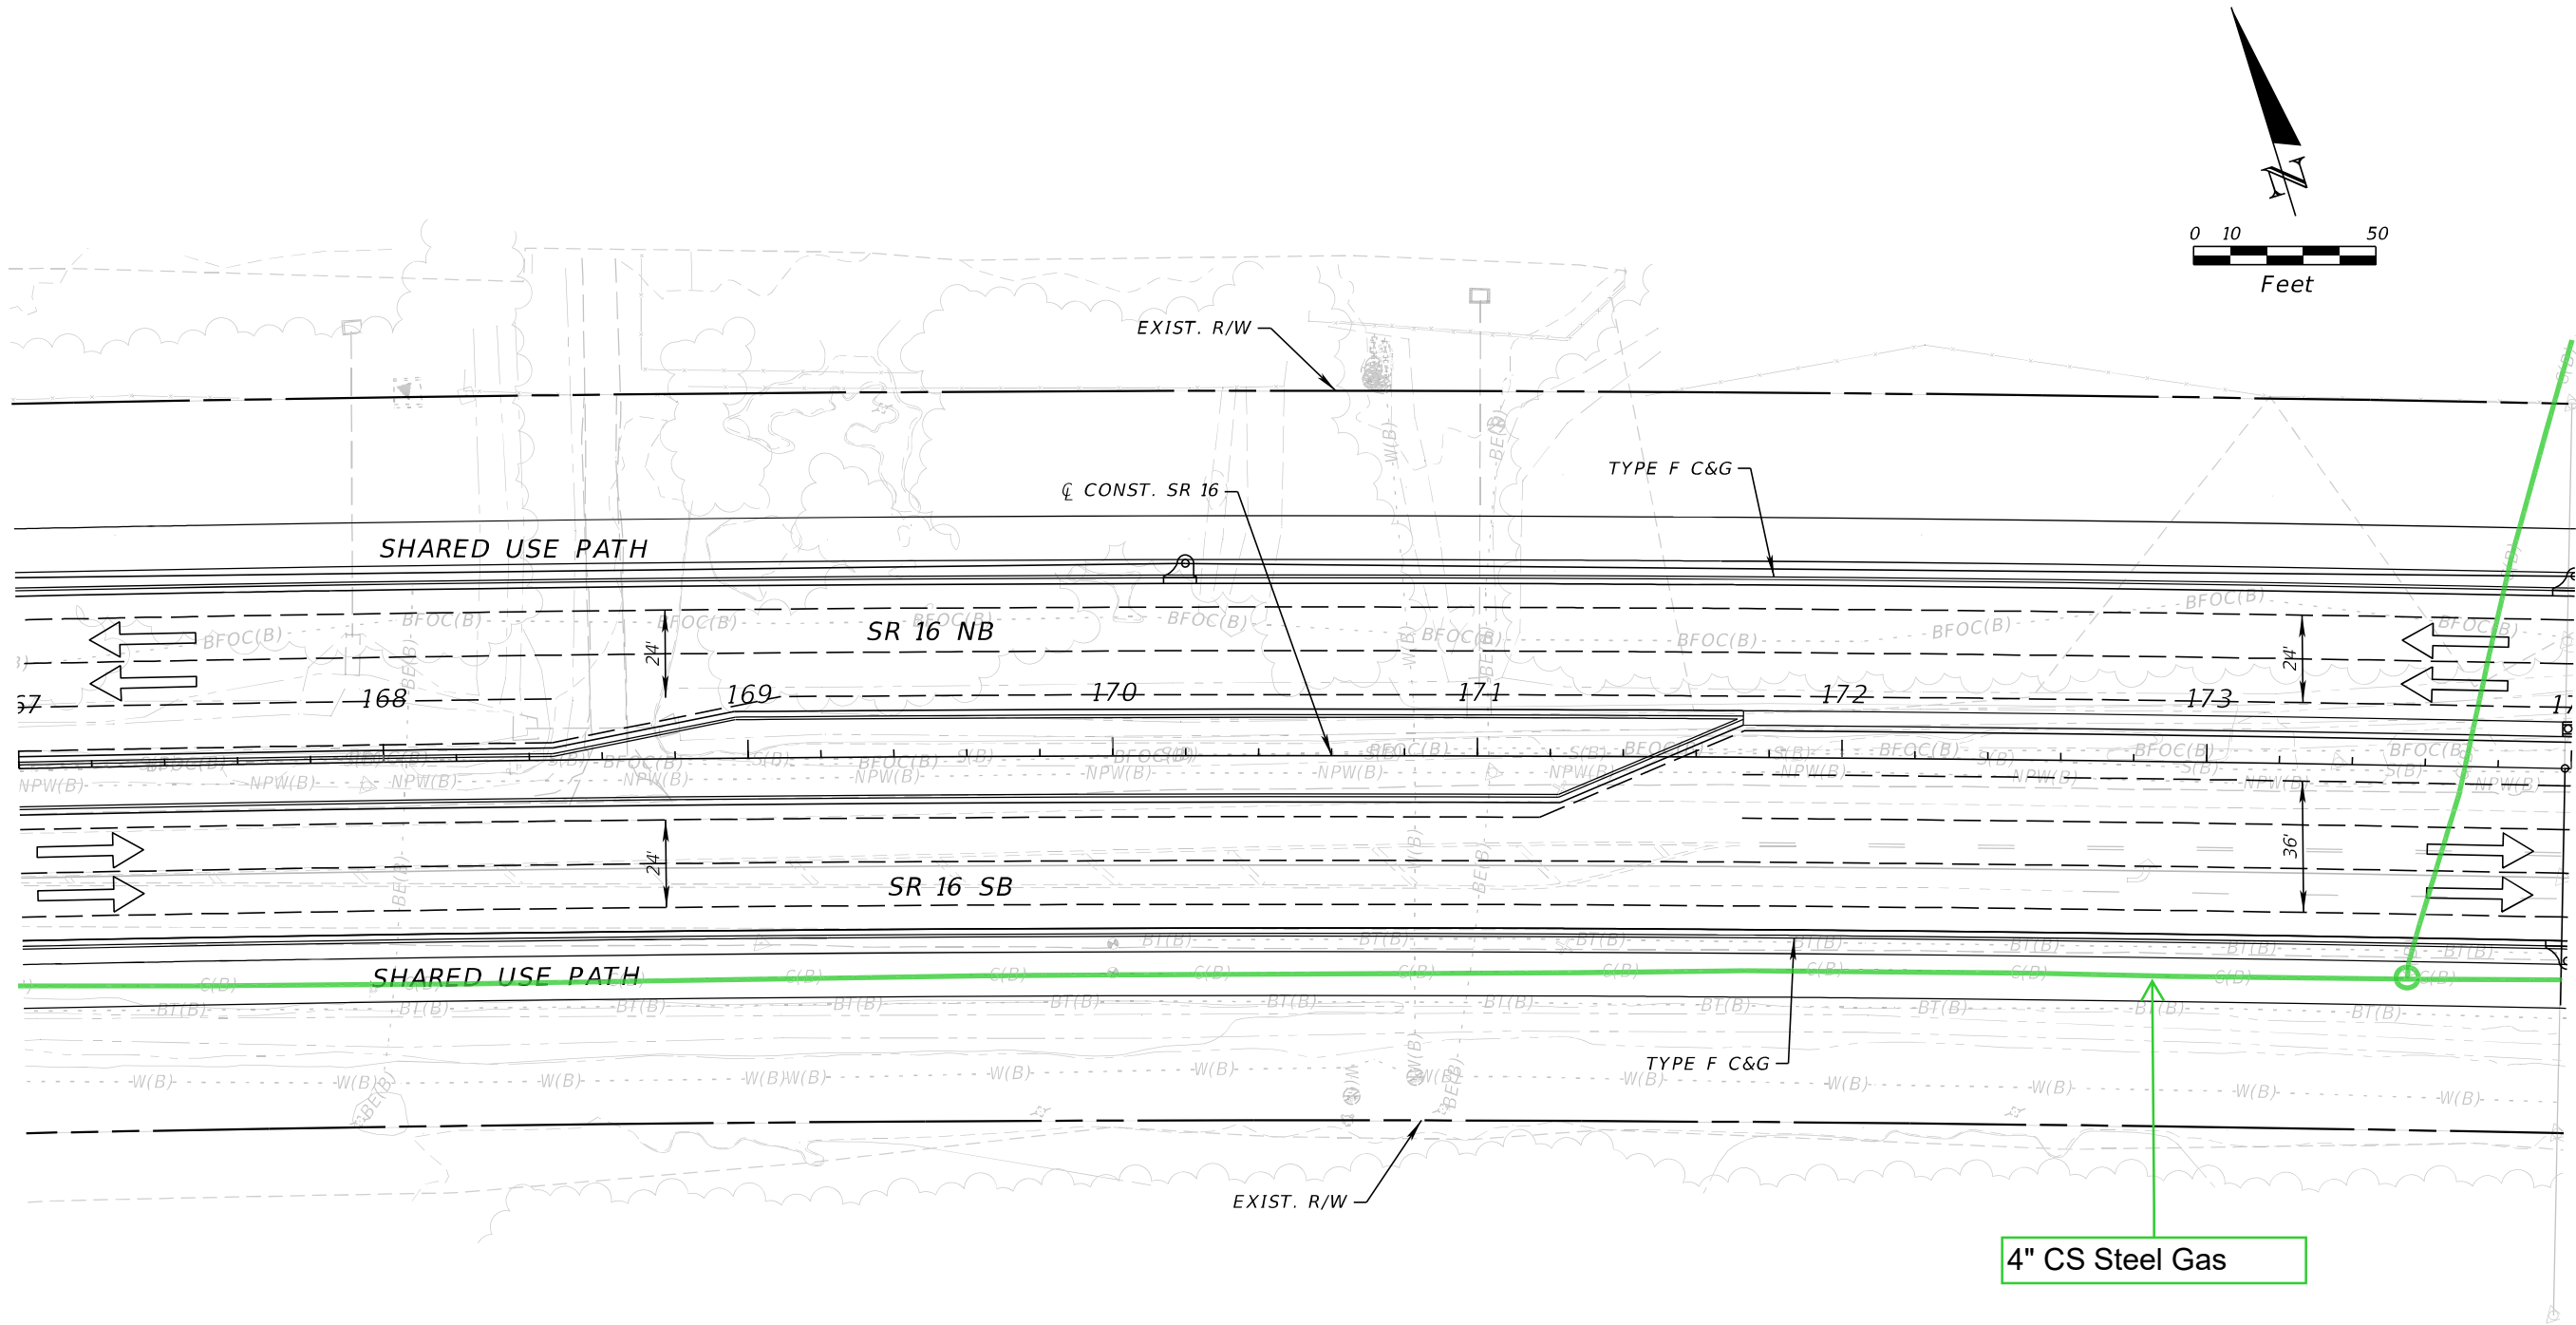


REVISIONS				ENGINEER OF RECORD		STATE OF FLORIDA DEPARTMENT OF TRANSPORTATION			ROADWAY PLAN	SHEET NO.  SR 16 - PLAN - 11
DATE	DESCRIPTION	DATE	DESCRIPTION	STEPHEN J. PARK, P.E. LICENSE NUMBER: 77656 RS&H, INC. 10748 DEERWOOD PARK BLVD. SOUTH JACKSONVILLE, FL 32256		ROAD NO.	COUNTY	FINANCIAL PROJECT ID		
						SR 16	ST. JOHNS	210447-5-52-01		

THE OFFICIAL RECORD OF THIS SHEET IS THE ELECTRONIC FILE DIGITALLY SIGNED AND SEALED UNDER RULE 61G15-23.004, F.A.C.



8/5/2024 4:28:45 PM BeattyM  
c:\pw\_work\ysh\_pw\pw\_user\0439575\PLANRD01.dgn

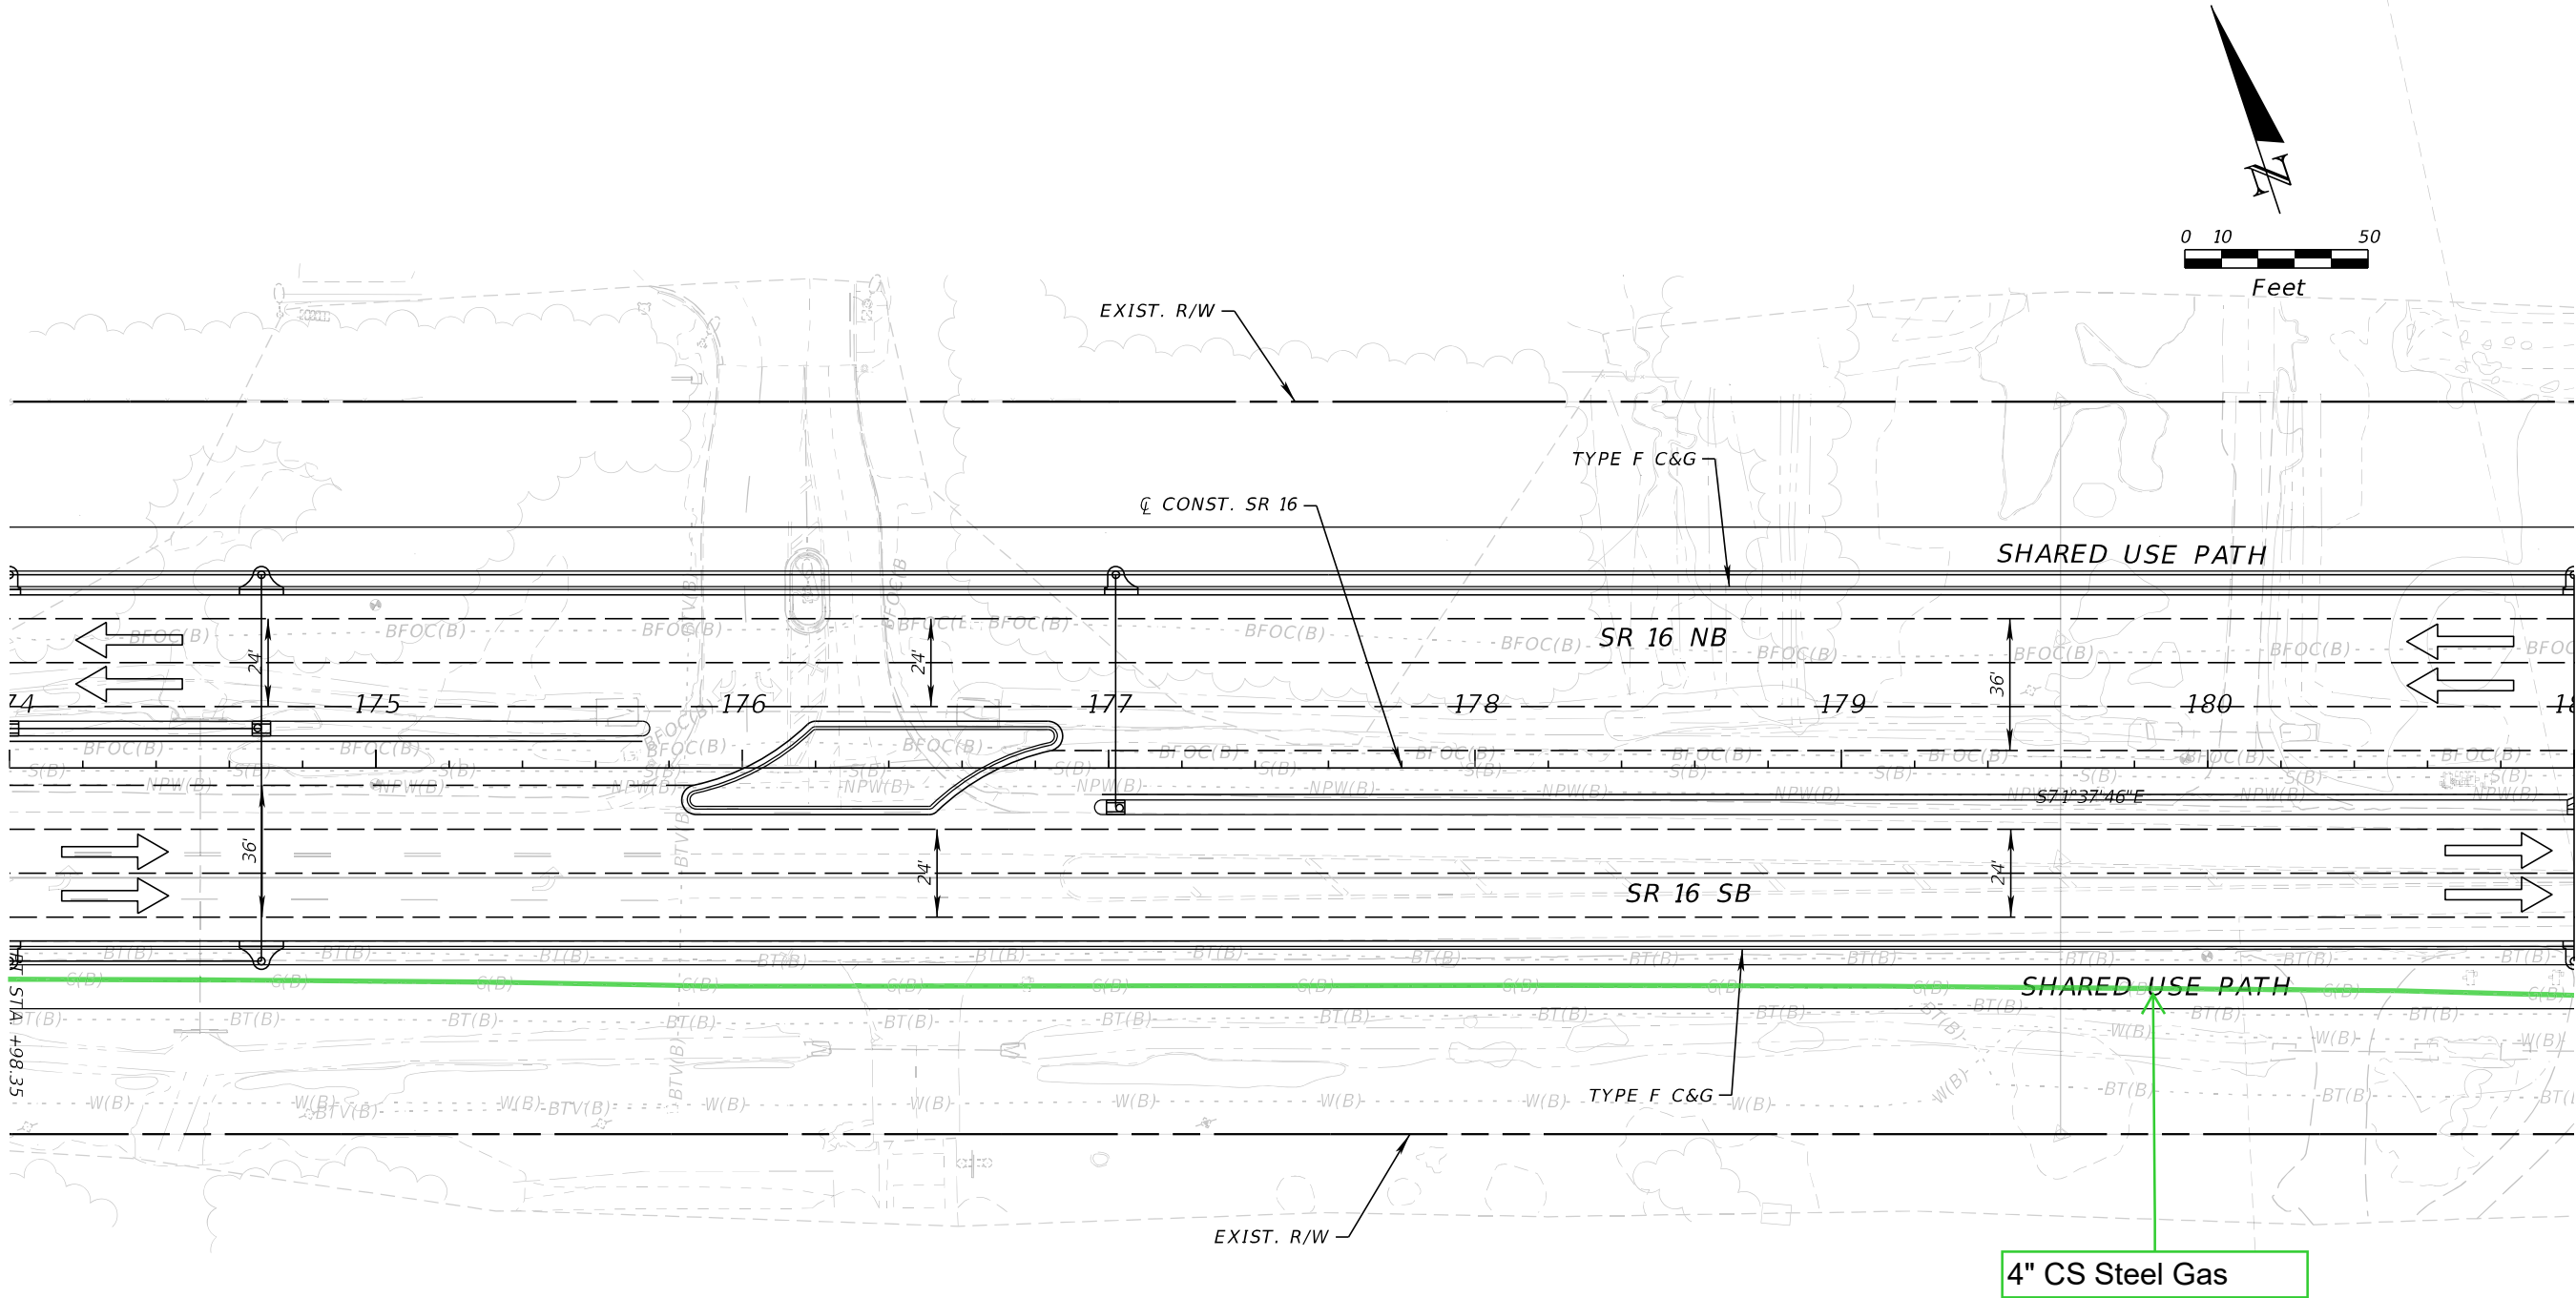

REVISIONS			
DATE	DESCRIPTION	DATE	DESCRIPTION

ENGINEER OF RECORD	
STEPHEN J. PARK, P.E. LICENSE NUMBER: 77656 RS&H, INC. 10748 DEERWOOD PARK BLVD. SOUTH JACKSONVILLE, FL 32256	


STATE OF FLORIDA DEPARTMENT OF TRANSPORTATION		
ROAD NO.	COUNTY	FINANCIAL PROJECT ID
SR 16	ST. JOHNS	210447-5-52-01

ROADWAY PLAN	

SHEET NO.
SR 16 - PLAN - 12

THE OFFICIAL RECORD OF THIS SHEET IS THE ELECTRONIC FILE DIGITALLY SIGNED AND SEALED UNDER RULE 61G15-23.004, F.A.C.


8/5/2024 4:28:45 PM BeattyM  
c:\pw\_work\ysh\_pw\pw\_user\00439575\PLANRD01.dgn

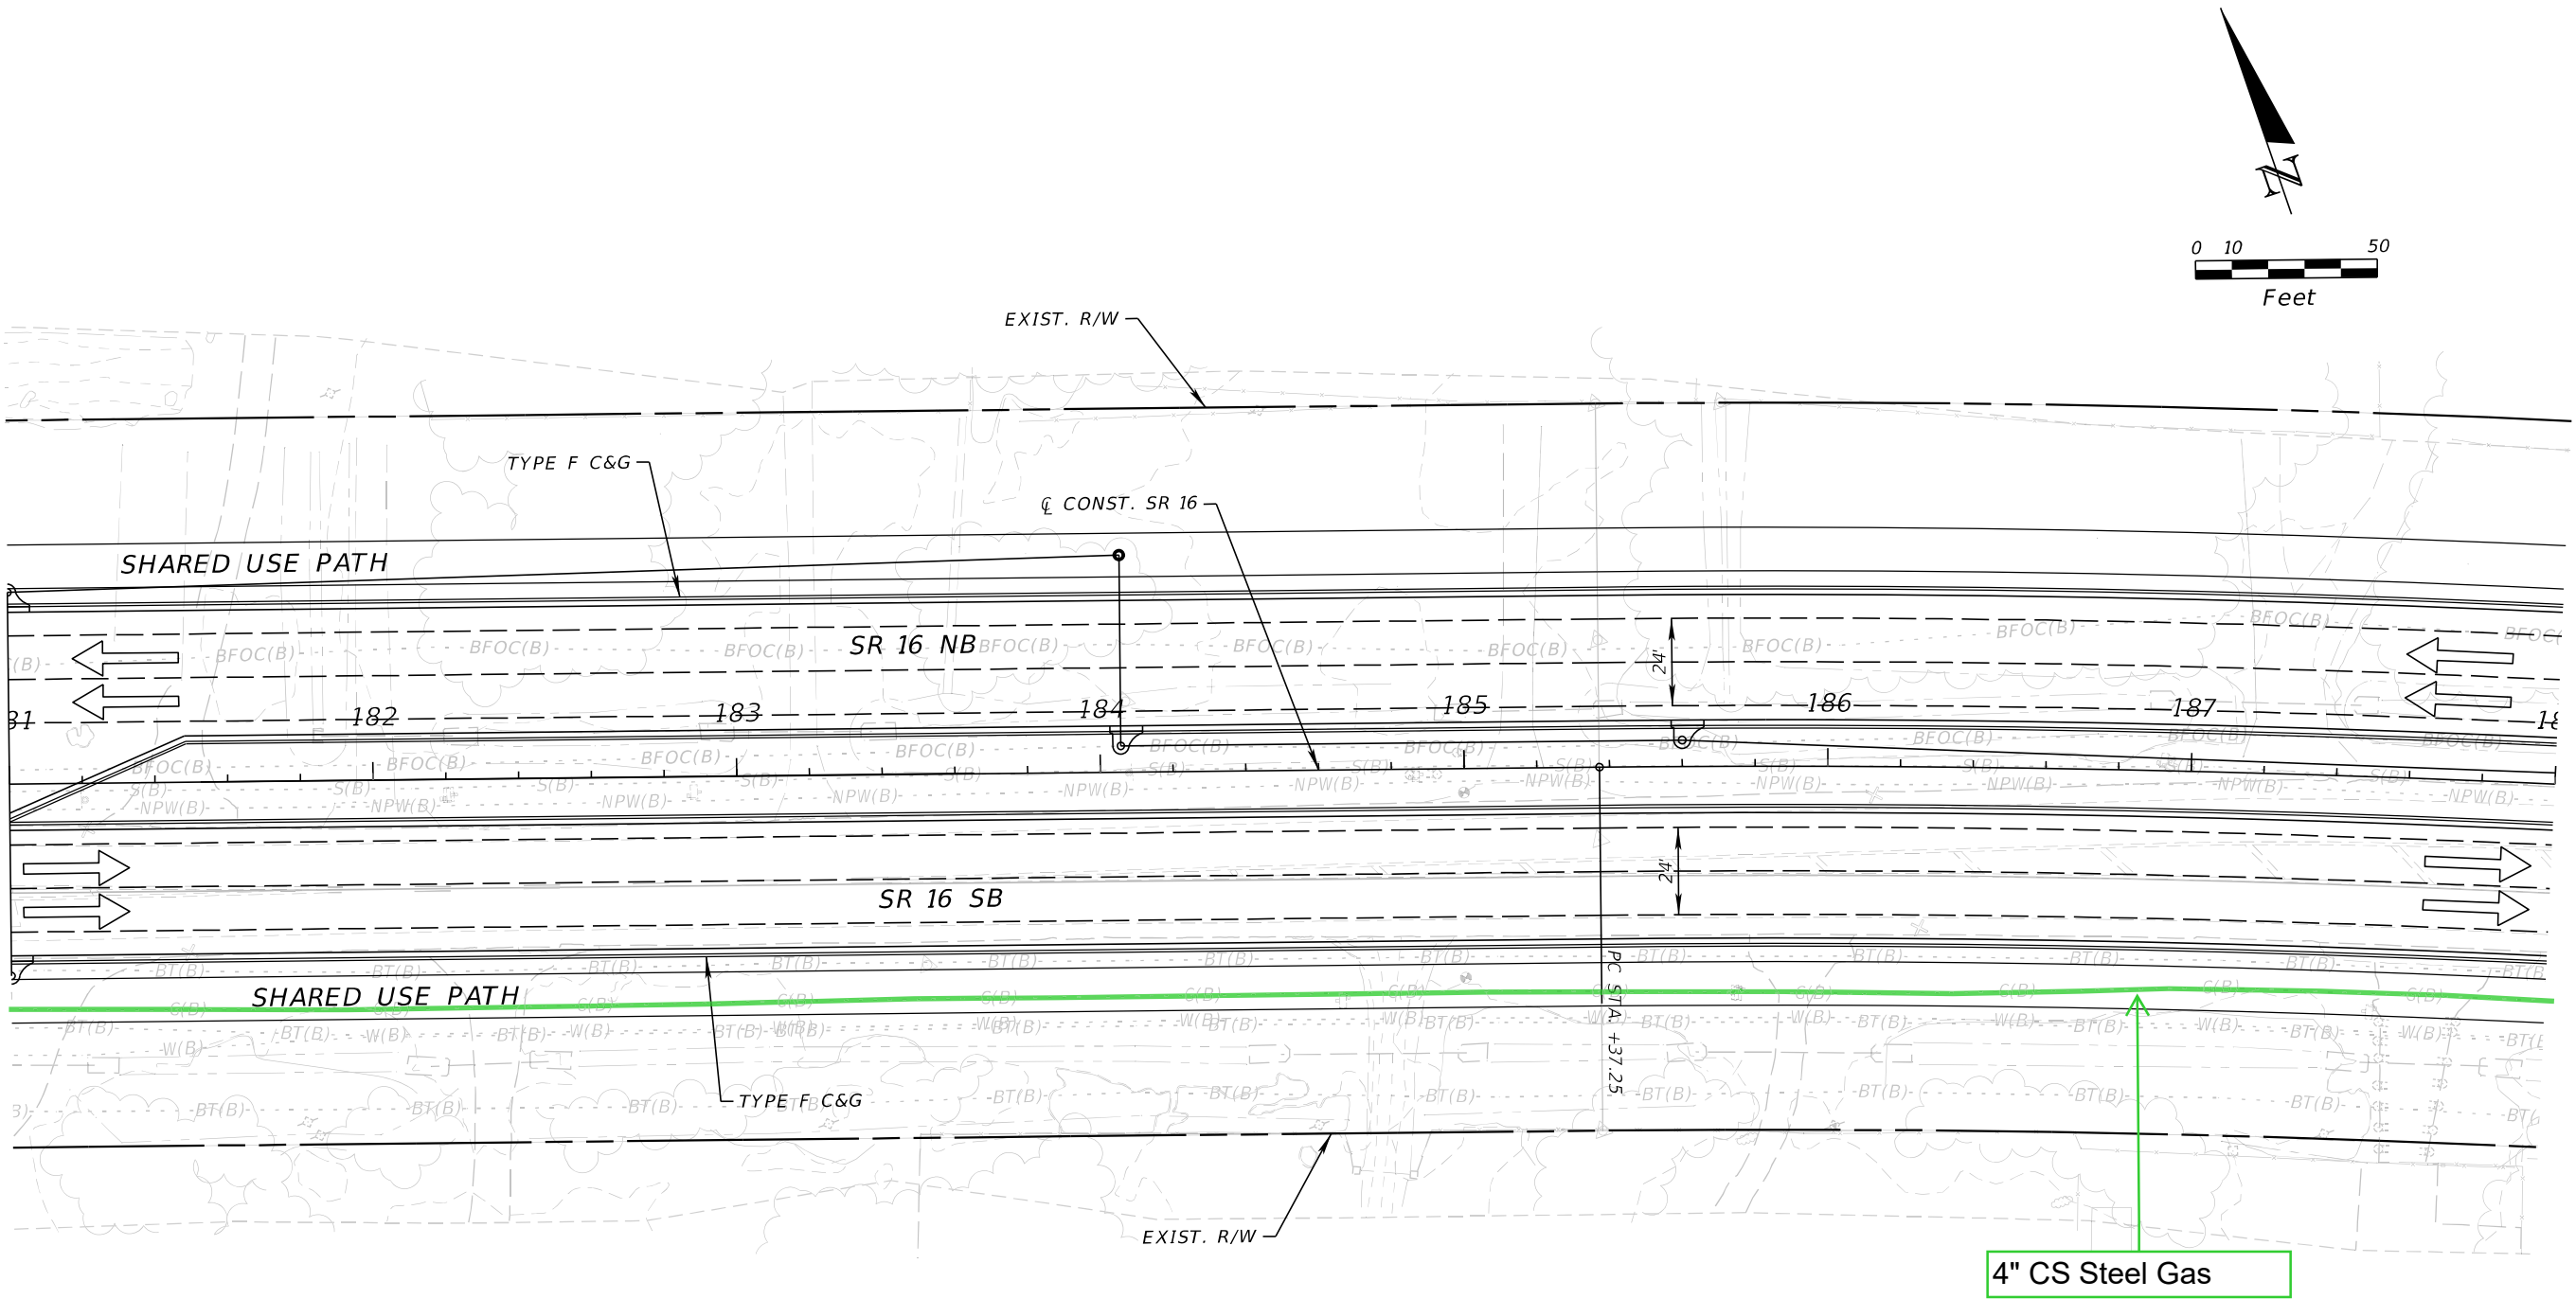

REVISIONS				ENGINEER OF RECORD	STATE OF FLORIDA DEPARTMENT OF TRANSPORTATION			SHEET NO.		
DATE	DESCRIPTION		DATE	DESCRIPTION		ROAD NO.	COUNTY		FINANCIAL PROJECT ID	
						STEPHEN J. PARK, P.E. LICENSE NUMBER: 77656 RS&H, INC. 10748 DEERWOOD PARK BLVD. SOUTH JACKSONVILLE, FL 32256	SR 16	ST. JOHNS	210447-5-52-01	11x17 Plan Only

THE OFFICIAL RECORD OF THIS SHEET IS THE ELECTRONIC FILE DIGITALLY SIGNED AND SEALED UNDER RULE 61G15-23.004, F.A.C.


8/5/2024 4:28:46 PM BeattyM  
c:\pw\_work\ysh\_pw\pw\_user\0439575\PLANRD01.dgn

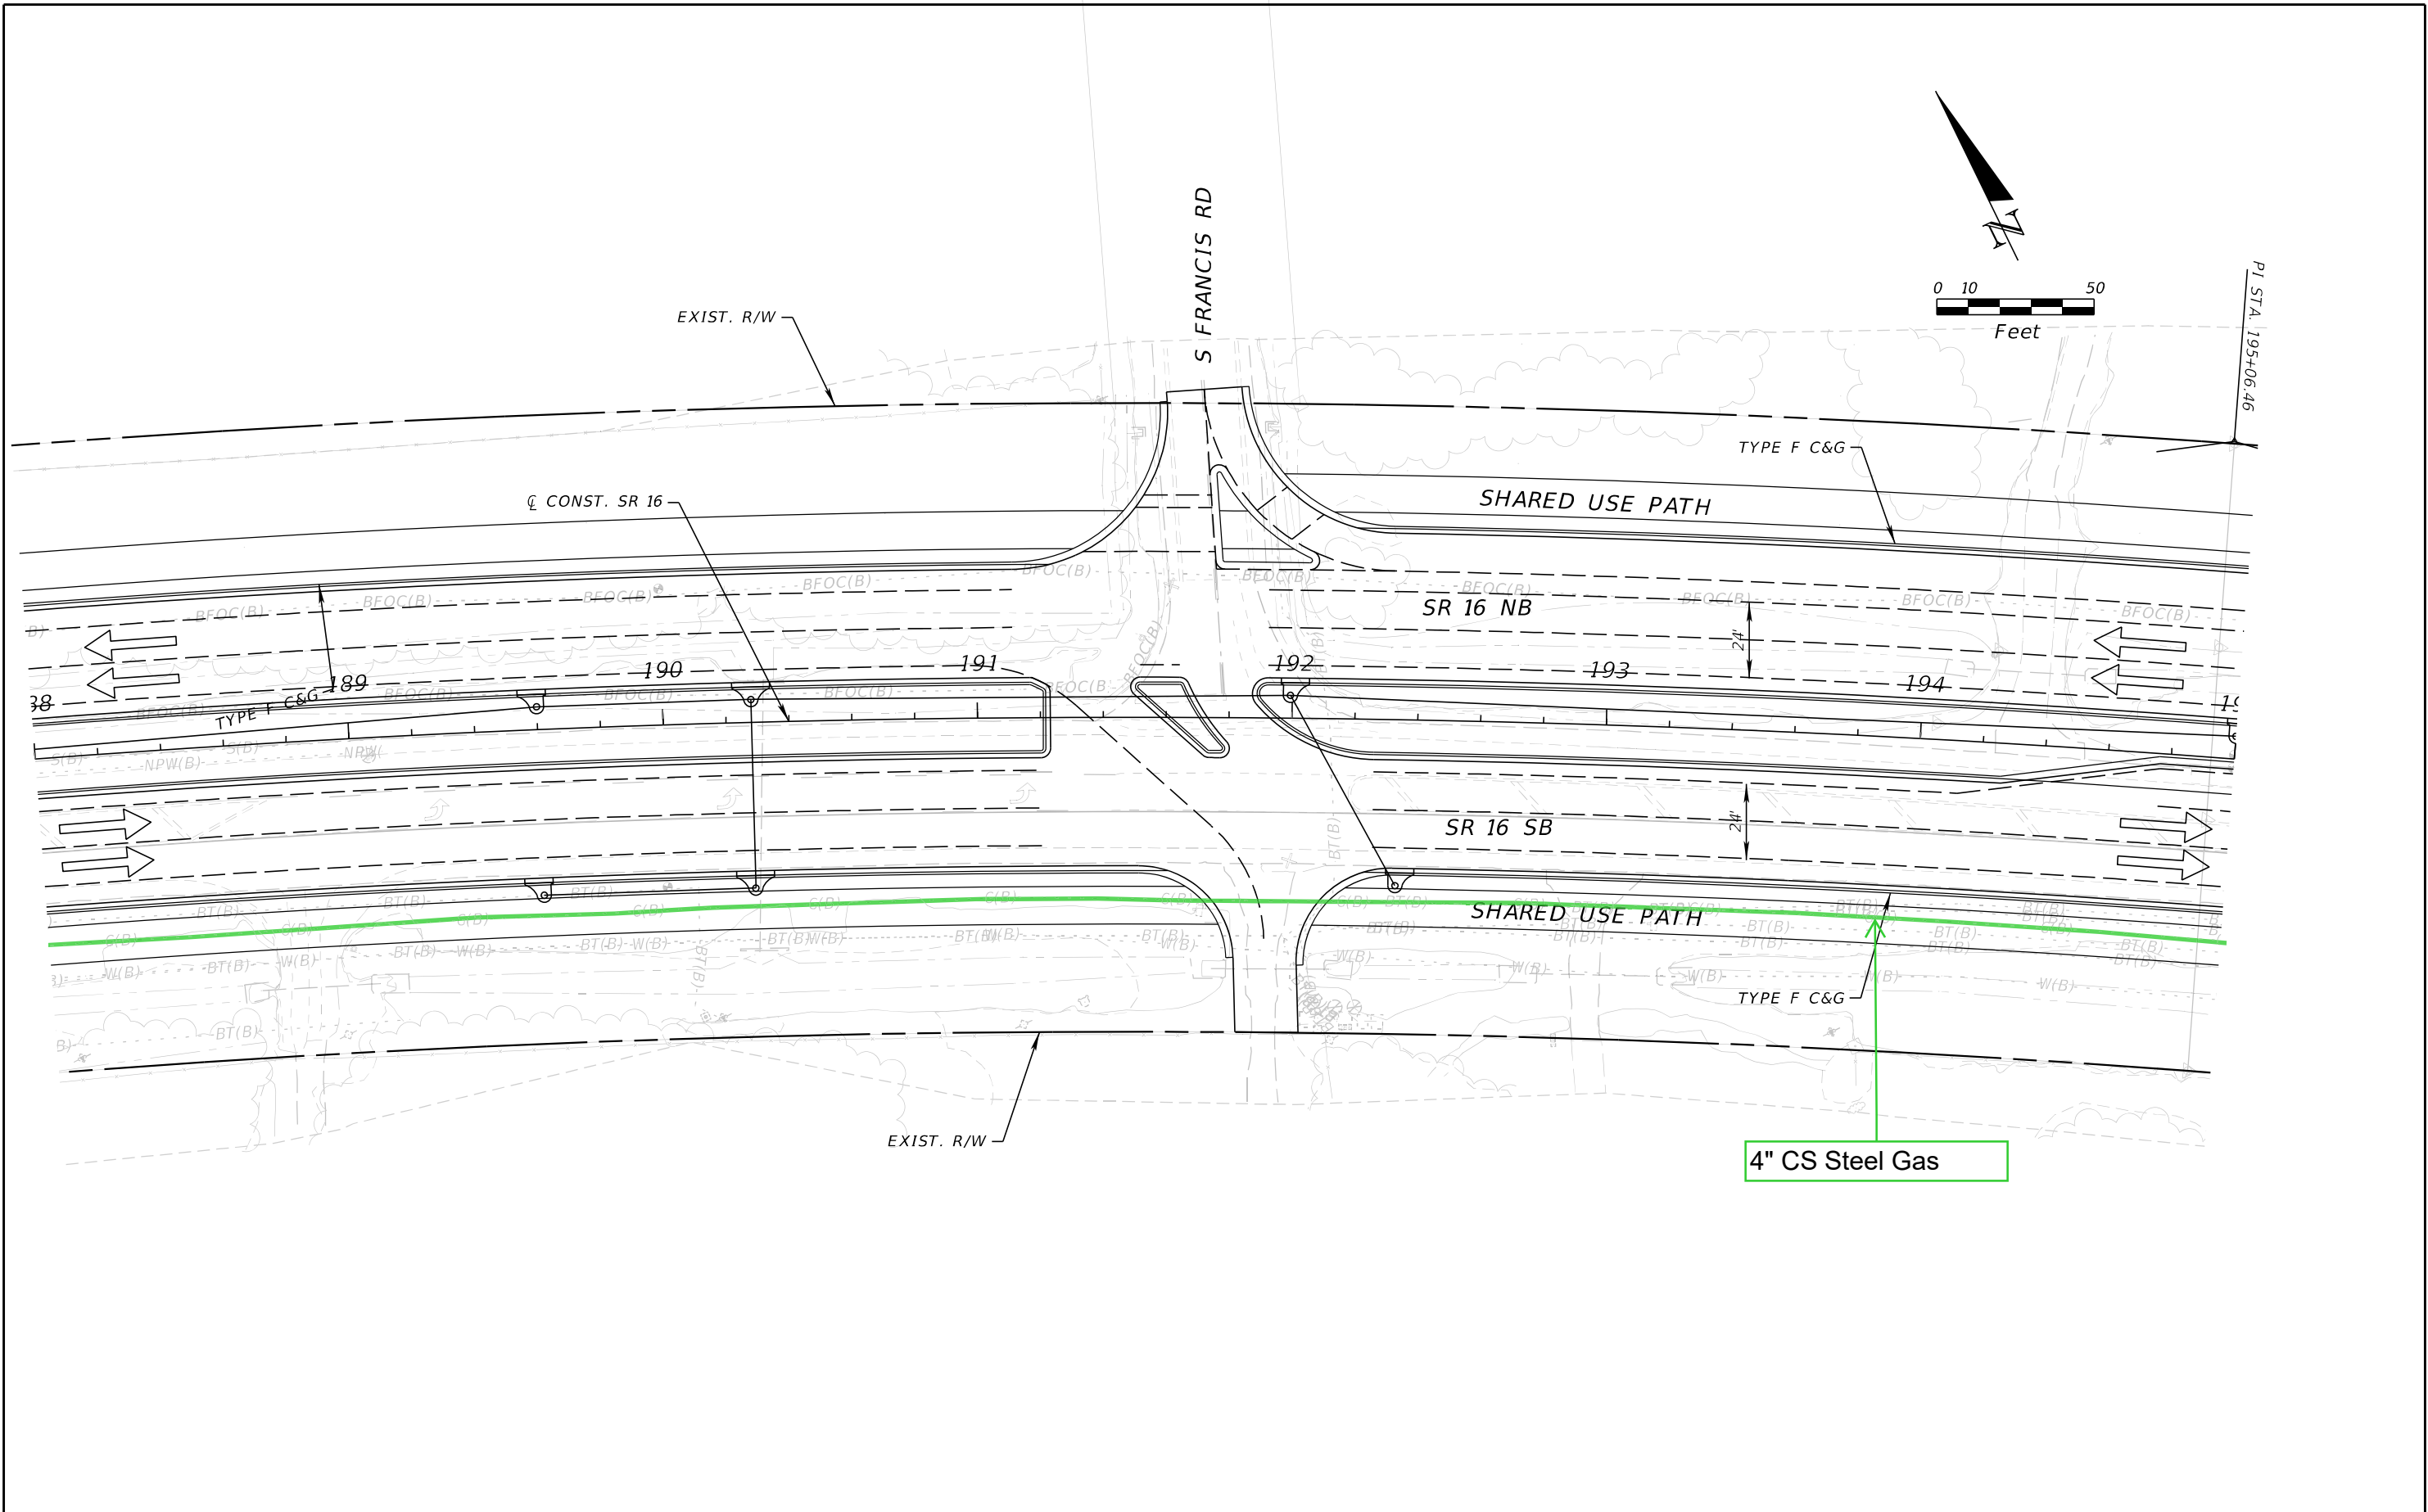

REVISIONS				ENGINEER OF RECORD	STATE OF FLORIDA DEPARTMENT OF TRANSPORTATION			SHEET NO.		
DATE	DESCRIPTION		DATE	DESCRIPTION		ROAD NO.	COUNTY		FINANCIAL PROJECT ID	
						STEPHEN J. PARK, P.E. LICENSE NUMBER: 77656 RS&H, INC. 10748 DEERWOOD PARK BLVD. SOUTH JACKSONVILLE, FL 32256	SR 16	ST. JOHNS	210447-5-52-01	11x17 Plan Only

THE OFFICIAL RECORD OF THIS SHEET IS THE ELECTRONIC FILE DIGITALLY SIGNED AND SEALED UNDER RULE 61G15-23.004, F.A.C.

8/5/2024 4:28:47 PM BeattyM  
c:\pw\_work\ysh\_pw\pw\_user\00439575\PLANRD01.dgn

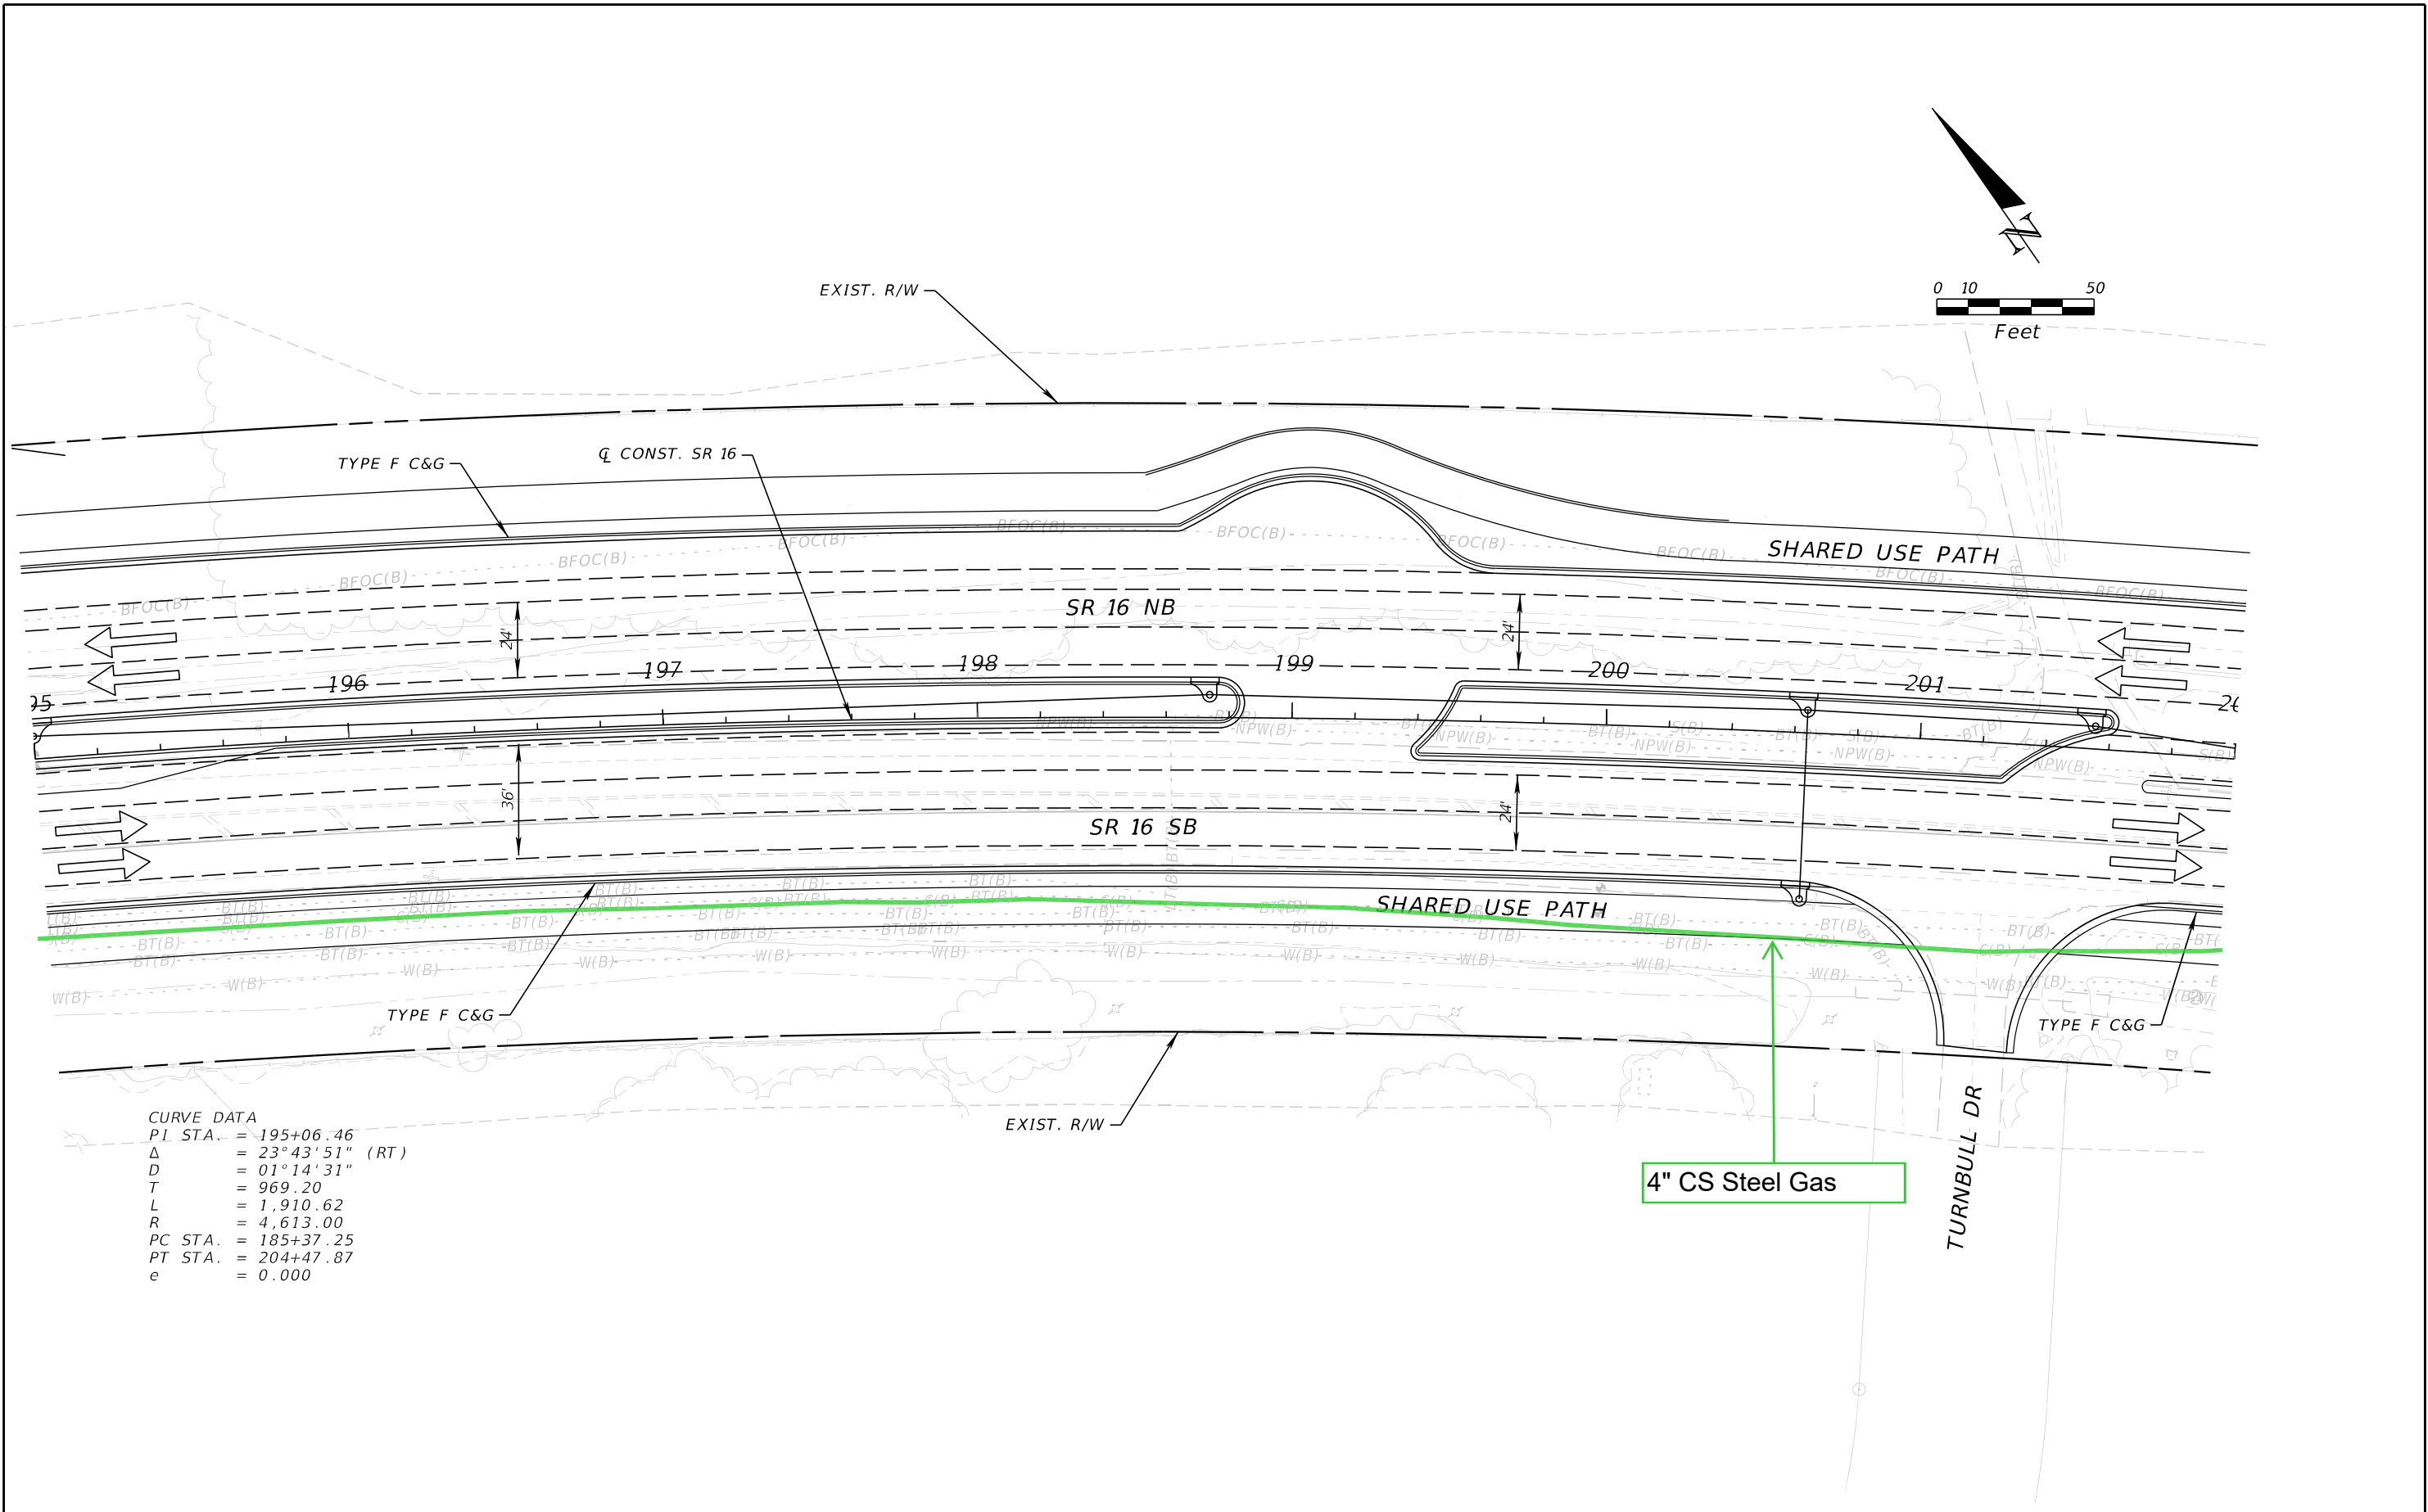


CURVE DATA  
PI STA. = 195+06.46  
Δ = 23°43'51" (RT)  
D = 01°14'31"  
T = 969.20  
L = 1,910.62  
R = 4,613.00  
PC STA. = 185+37.25  
PT STA. = 204+47.87  
e = 0.000

REVISIONS				ENGINEER OF RECORD	STATE OF FLORIDA DEPARTMENT OF TRANSPORTATION			SHEET NO.
DATE	DESCRIPTION	DATE	DESCRIPTION	STEPHEN J. PARK, P.E. LICENSE NUMBER: 77656 RS&H, INC. 10748 DEERWOOD PARK BLVD. SOUTH JACKSONVILLE, FL 32256	ROAD NO.	COUNTY	FINANCIAL PROJECT ID	
					SR 16	ST. JOHNS	210447-5-52-01	
								11x17 Plan Only

THE OFFICIAL RECORD OF THIS SHEET IS THE ELECTRONIC FILE DIGITALLY SIGNED AND SEALED UNDER RULE 61G15-23.004, F.A.C.

8/5/2024 4:28:48 PM BeattyM  
c:\pw\_work\sh\_pw\pw\_user\0439575\PLANRD01.dgn

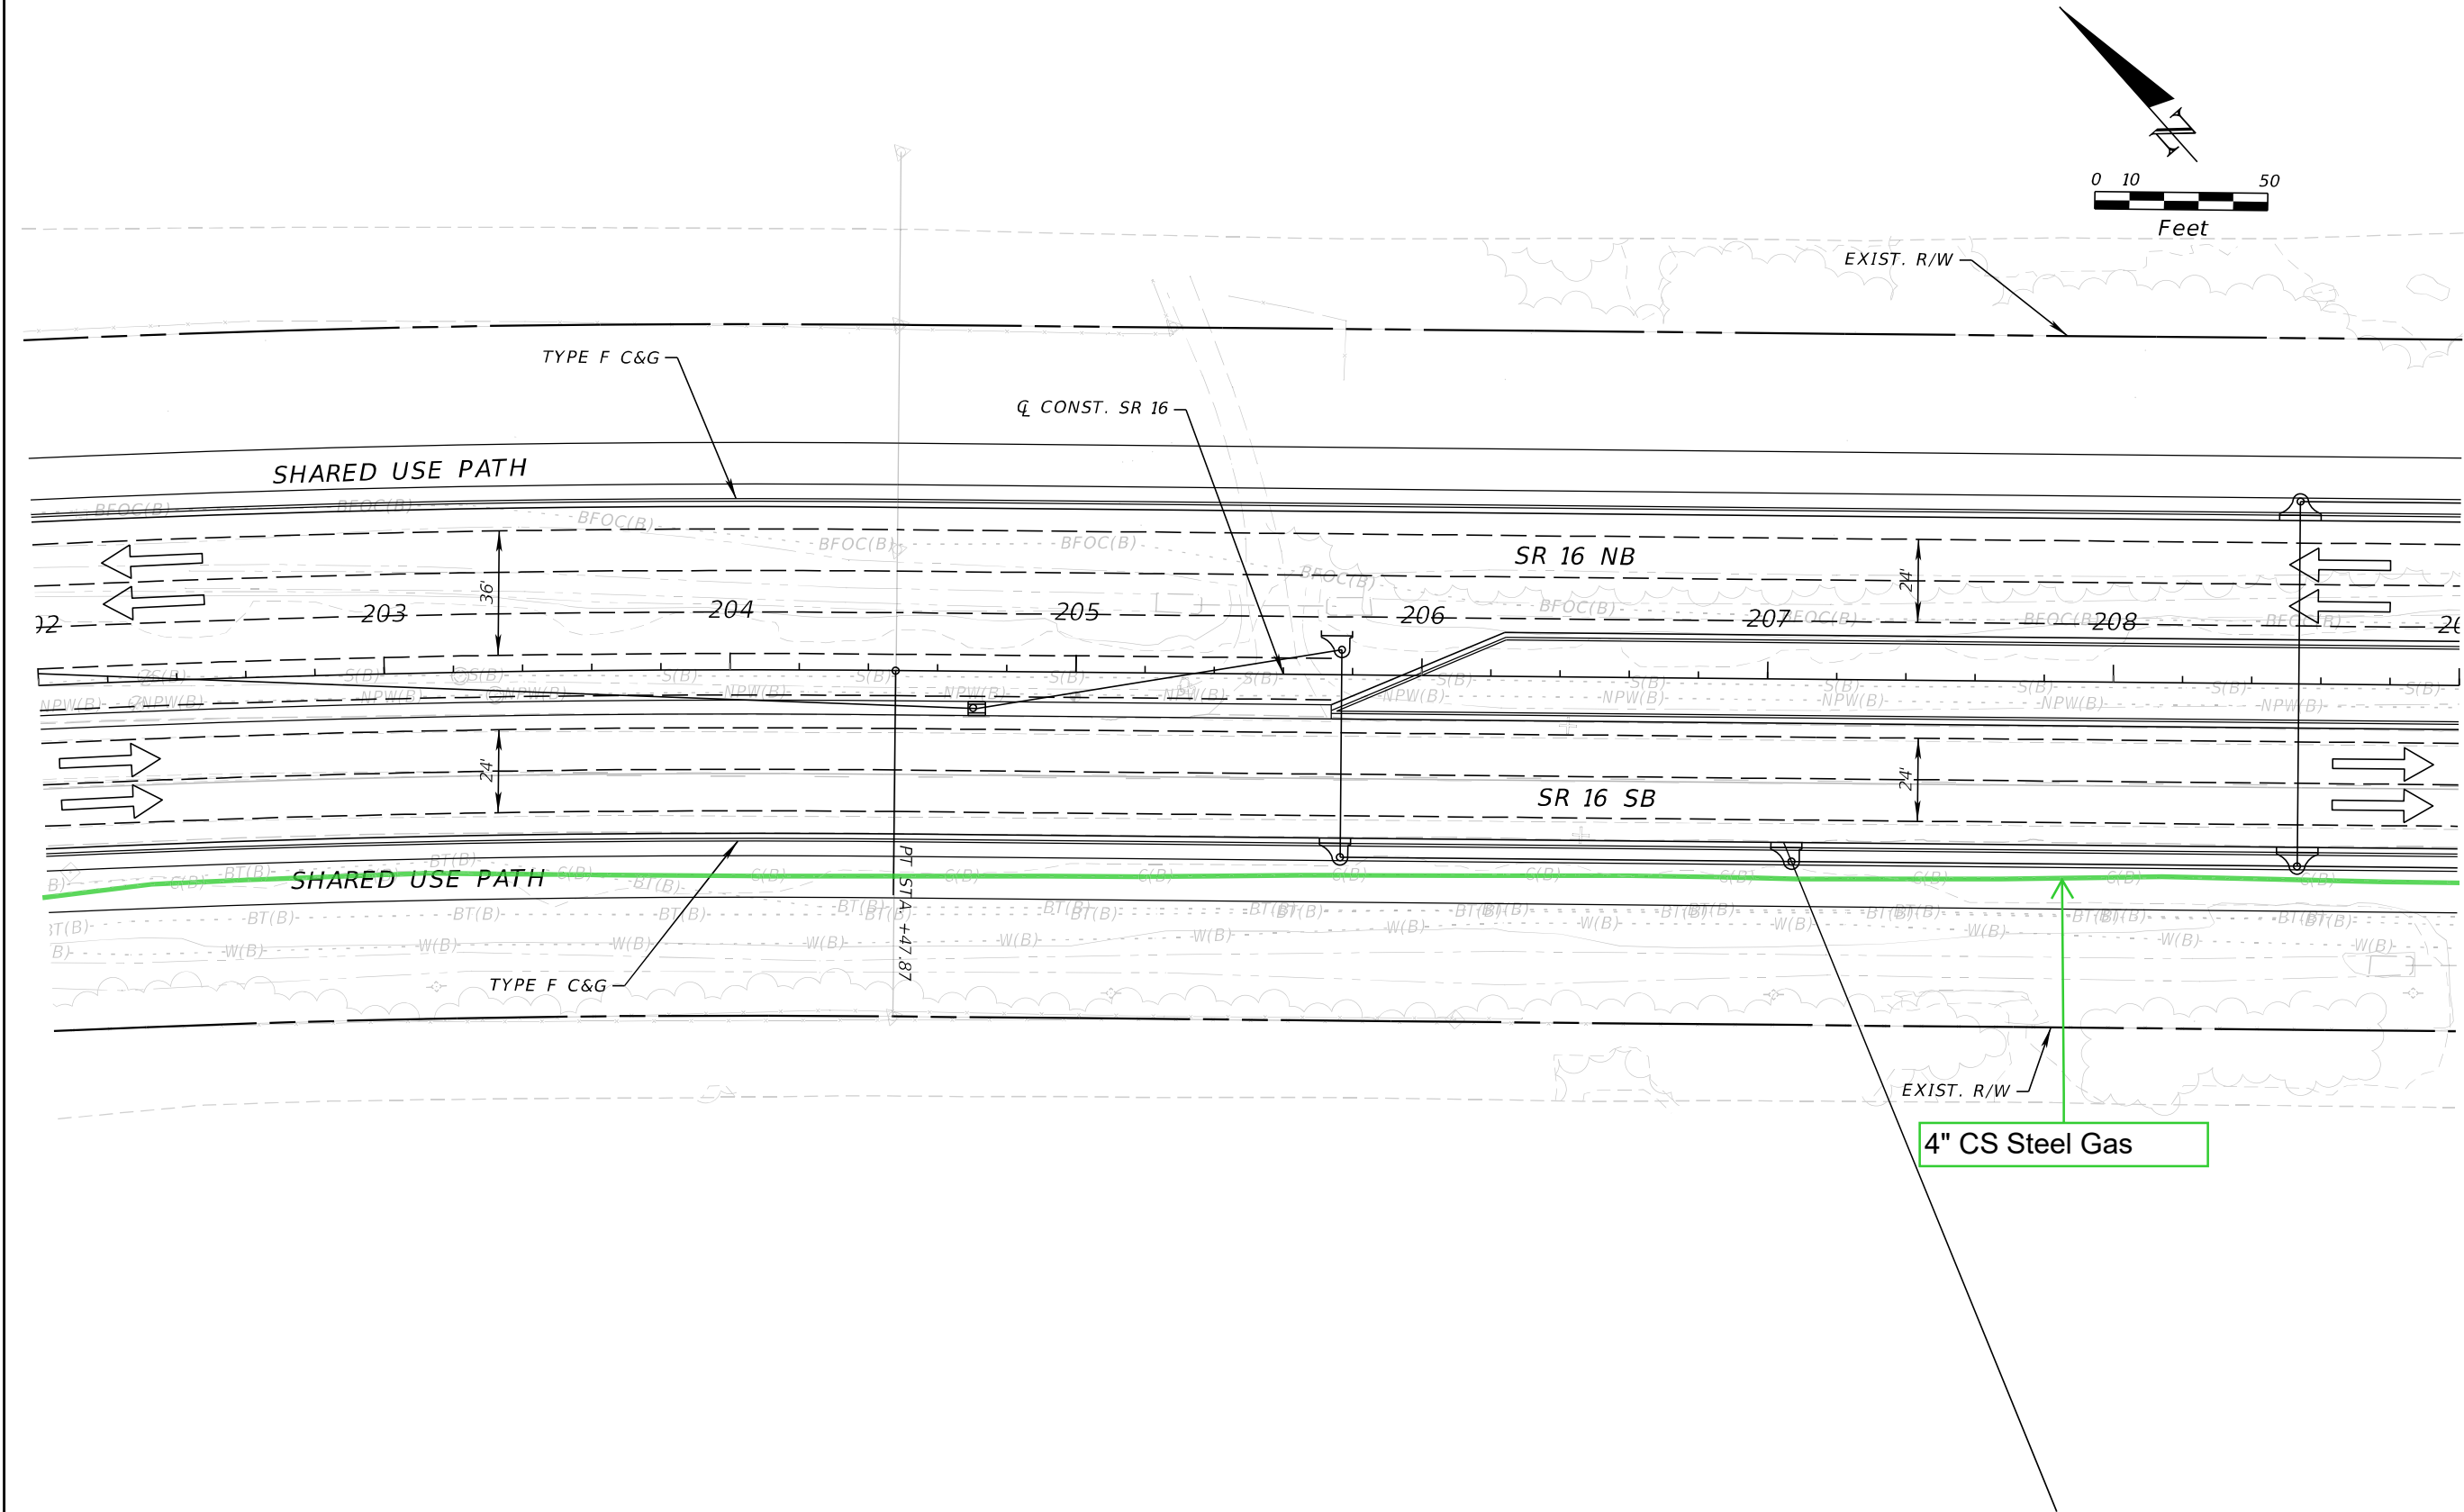


REVISIONS				ENGINEER OF RECORD	STATE OF FLORIDA DEPARTMENT OF TRANSPORTATION			SHEET NO.
DATE	DESCRIPTION	DATE	DESCRIPTION	STEPHEN J. PARK, P.E. LICENSE NUMBER: 77656 RS&H, INC. 10748 DEERWOOD PARK BLVD. SOUTH JACKSONVILLE, FL 32256	ROAD NO.	COUNTY	FINANCIAL PROJECT ID	
						SR 16	ST. JOHNS	210447-5-52-01

THE OFFICIAL RECORD OF THIS SHEET IS THE ELECTRONIC FILE DIGITALLY SIGNED AND SEALED UNDER RULE 61G15-23.004, F.A.C.




8/5/2024 4:28:48 PM BeattyM  
c:\pw\_work\sh\_pw\pw\_user\00439575\PLANRD01.dgn

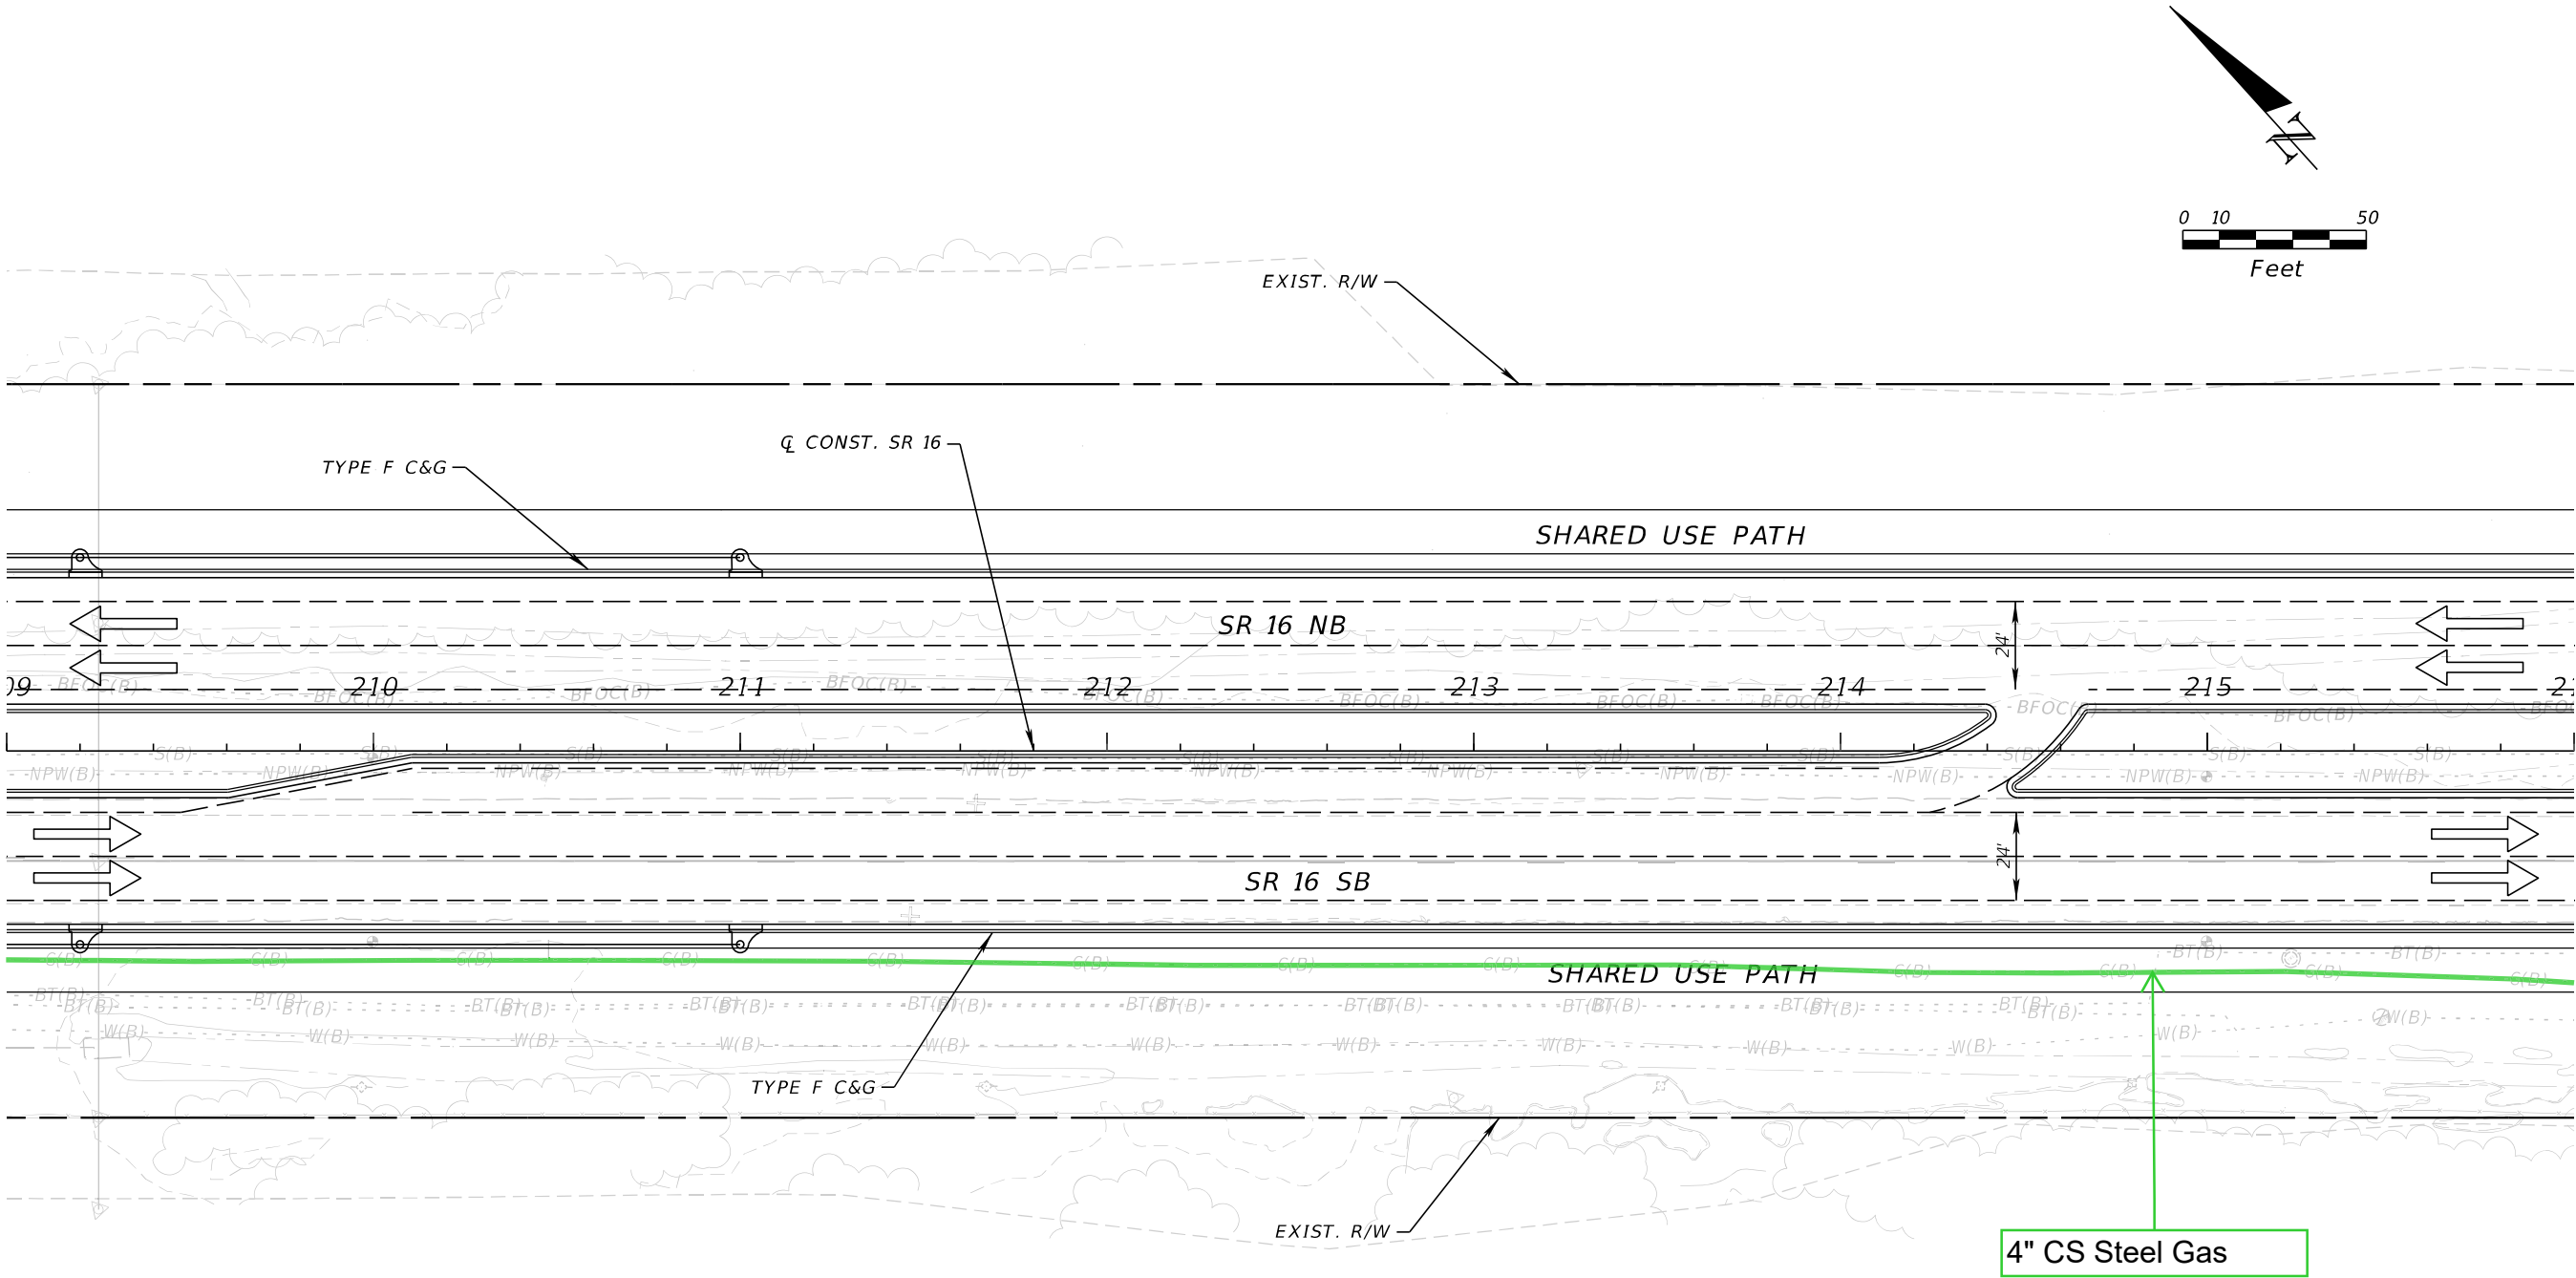

REVISIONS				ENGINEER OF RECORD		STATE OF FLORIDA DEPARTMENT OF TRANSPORTATION			SHEET NO.
DATE	DESCRIPTION	DATE	DESCRIPTION	STEPHEN J. PARK, P.E. LICENSE NUMBER: 77656 RS&H, INC. 10748 DEERWOOD PARK BLVD. SOUTH JACKSONVILLE, FL 32256		ROAD NO.	COUNTY	FINANCIAL PROJECT ID	
						SR 16	ST. JOHNS	210447-5-52-01	

THE OFFICIAL RECORD OF THIS SHEET IS THE ELECTRONIC FILE DIGITALLY SIGNED AND SEALED UNDER RULE 61G15-23.004, F.A.C.


8/5/2024 4:28:49 PM BeattyM  
c:\pw\_work\sh\_pw\pw\_user\0439575\PLANRD01.dgn

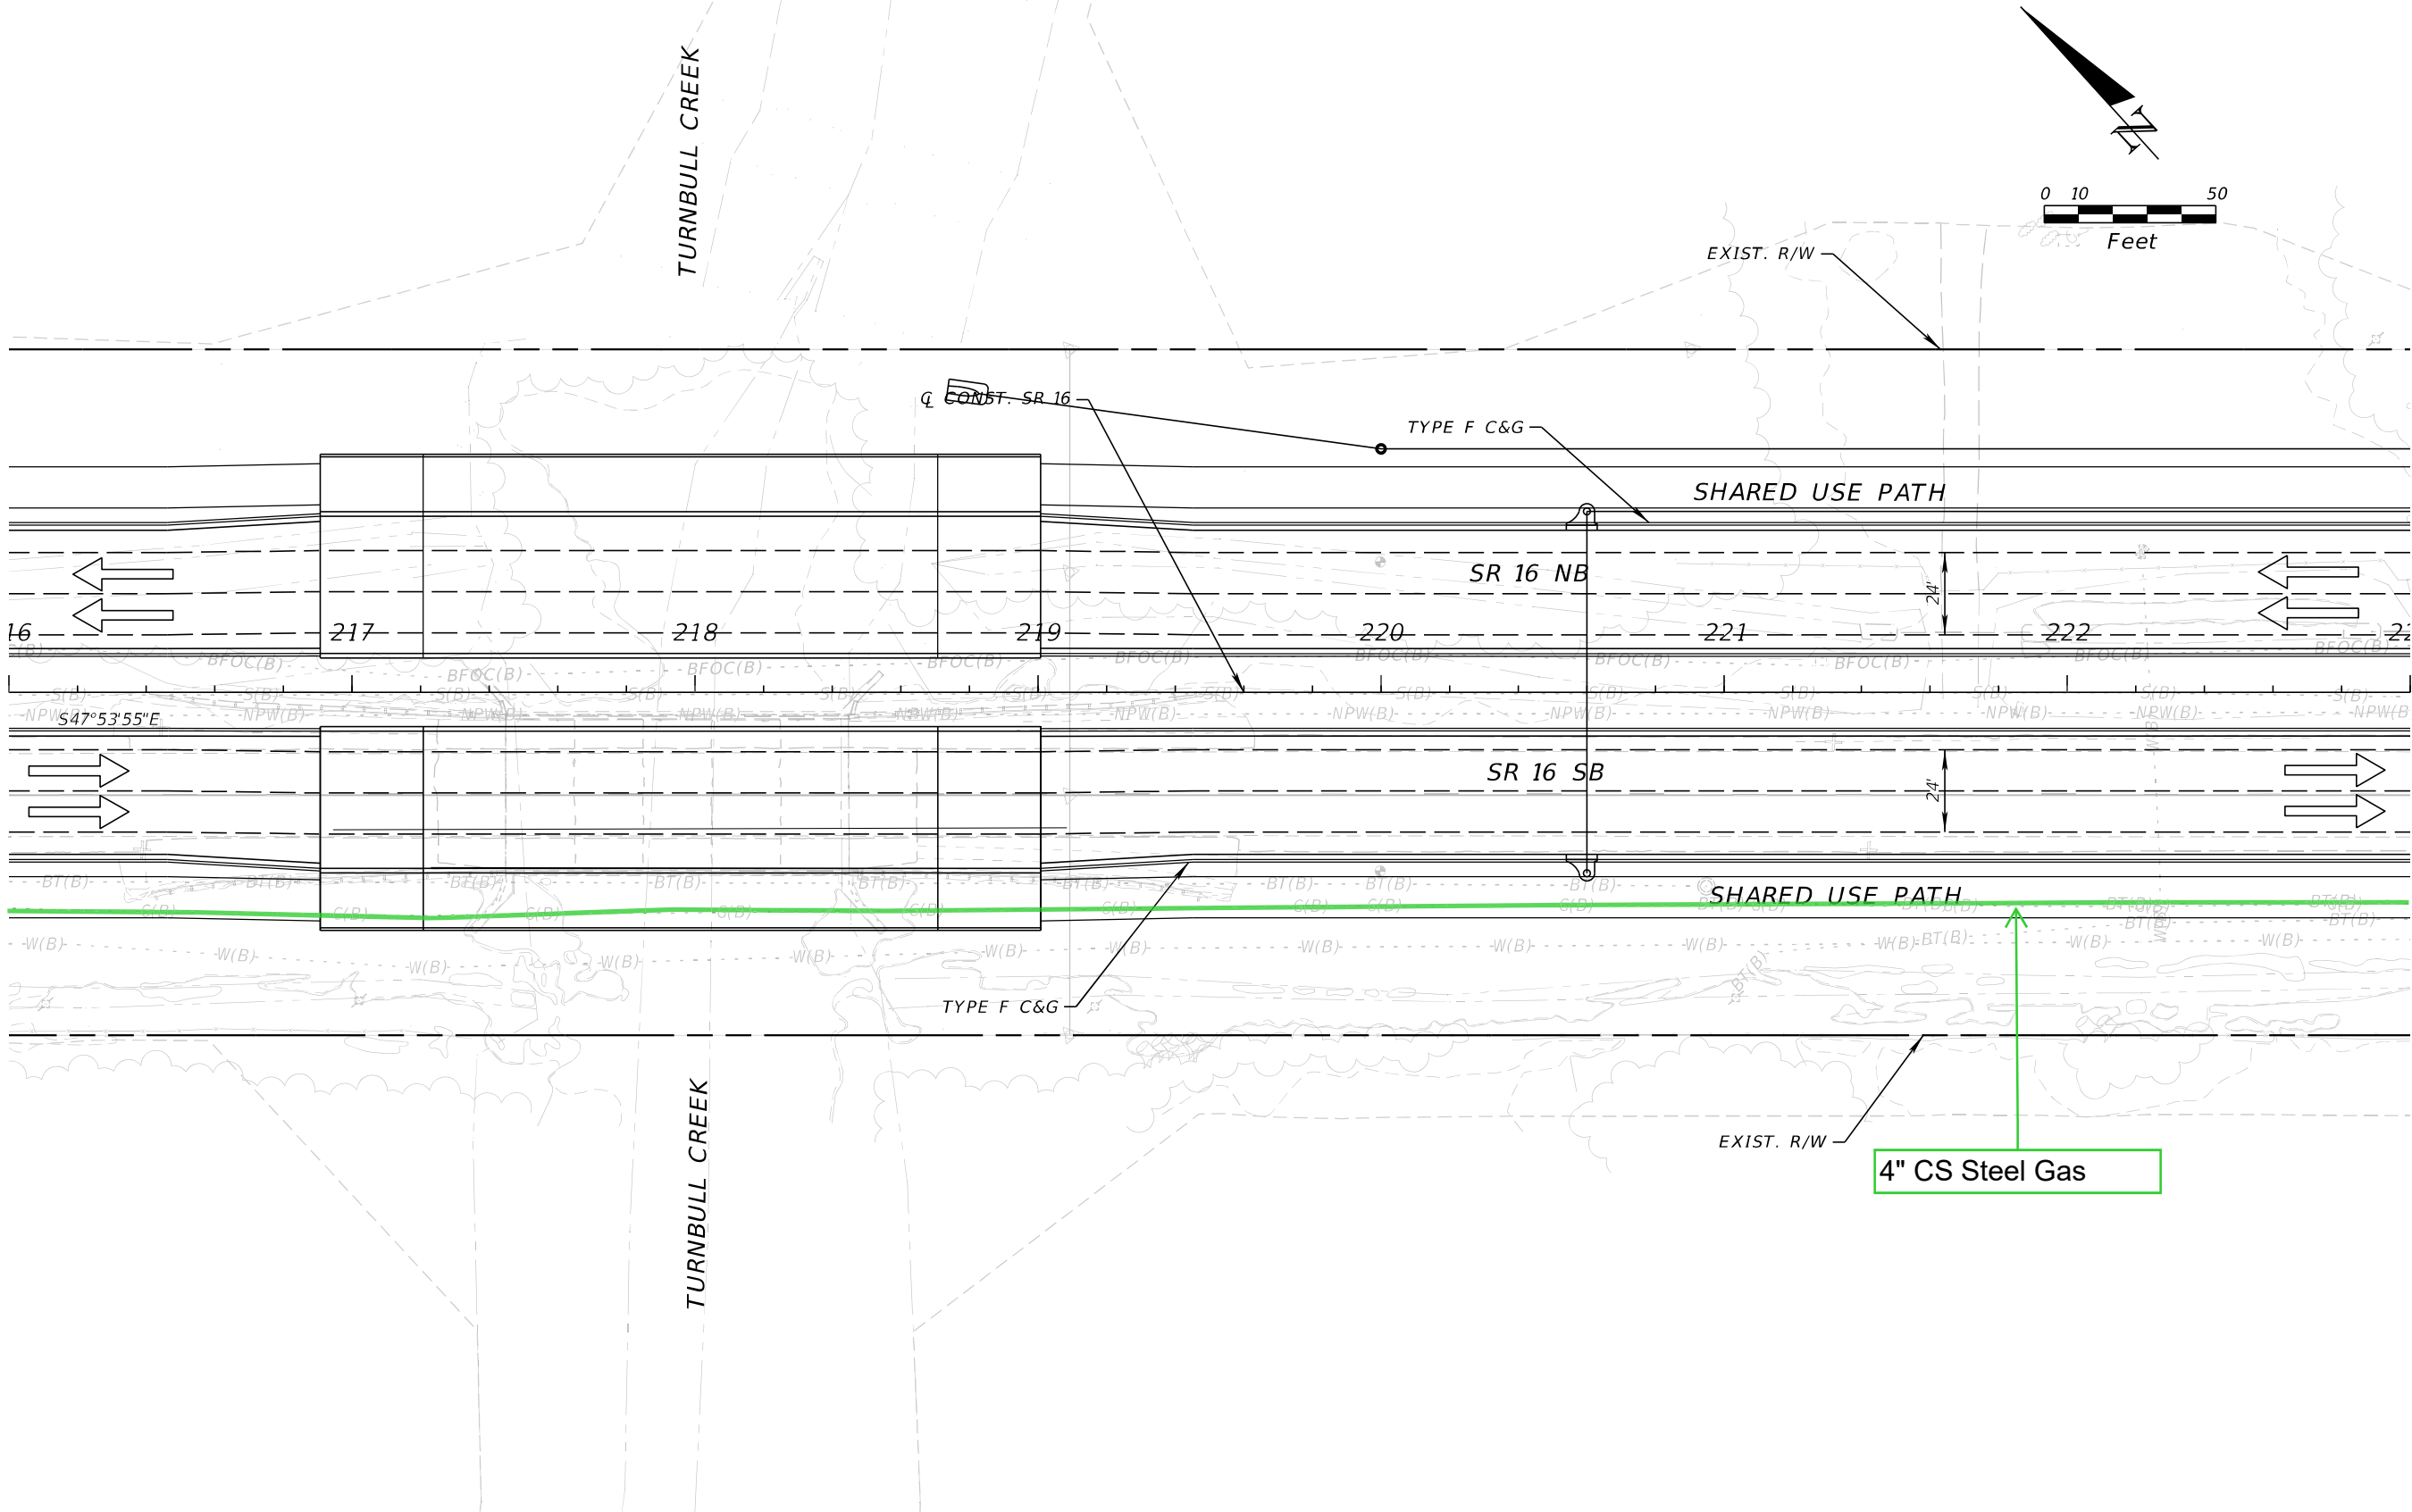

REVISIONS				ENGINEER OF RECORD	STATE OF FLORIDA DEPARTMENT OF TRANSPORTATION			SHEET NO.		
DATE	DESCRIPTION		DATE	DESCRIPTION		ROAD NO.	COUNTY		FINANCIAL PROJECT ID	
						STEPHEN J. PARK, P.E. LICENSE NUMBER: 77656 RS&H, INC. 10748 DEERWOOD PARK BLVD. SOUTH JACKSONVILLE, FL 32256	SR 16	ST. JOHNS	210447-5-52-01	11x17 Plan Only

THE OFFICIAL RECORD OF THIS SHEET IS THE ELECTRONIC FILE DIGITALLY SIGNED AND SEALED UNDER RULE 61G15-23.004, F.A.C.


8/5/2024 4:28:49 PM BeattyM  
c:\pw\_work\sh\_pw\pw\_user\00439575\PLANRD01.dgn

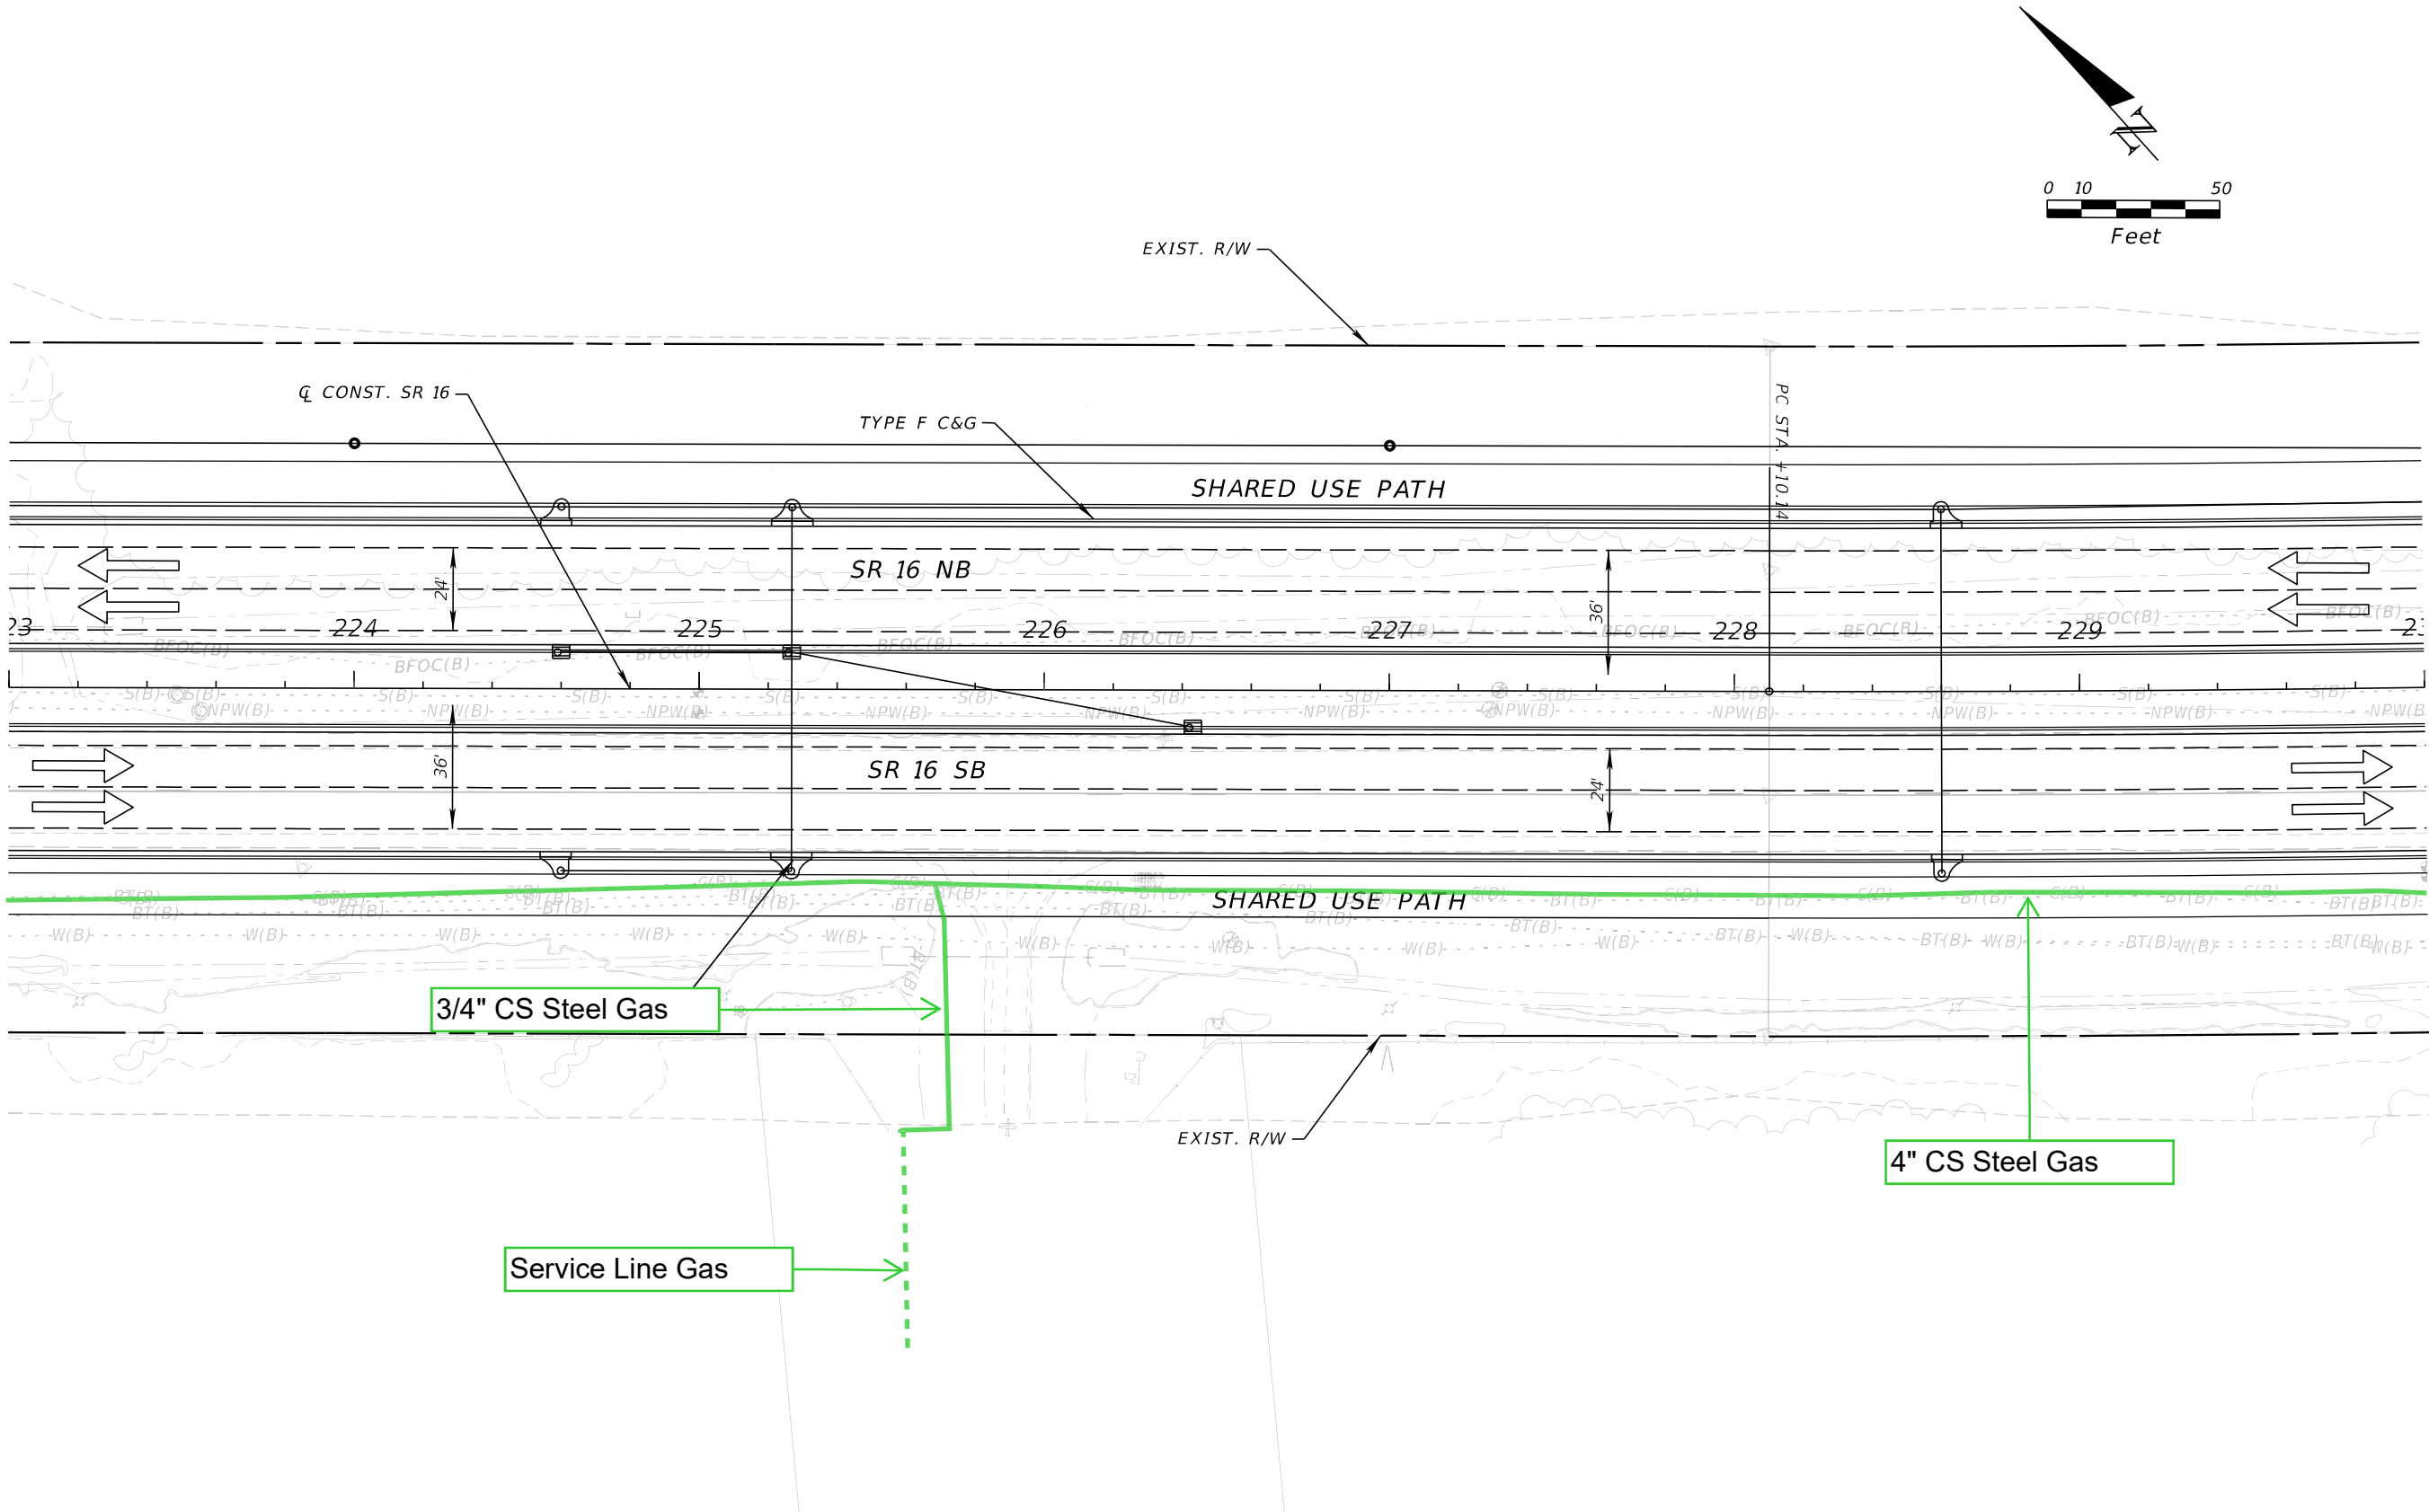

REVISIONS				ENGINEER OF RECORD		STATE OF FLORIDA DEPARTMENT OF TRANSPORTATION			ROADWAY PLAN	SHEET NO.  SR 16 - PLAN - 19
DATE	DESCRIPTION	DATE	DESCRIPTION	STEPHEN J. PARK, P.E. LICENSE NUMBER: 77656 RS&H, INC. 10748 DEERWOOD PARK BLVD. SOUTH JACKSONVILLE, FL 32256		ROAD NO.	COUNTY	FINANCIAL PROJECT ID		
						SR 16	ST. JOHNS	210447-5-52-01		

THE OFFICIAL RECORD OF THIS SHEET IS THE ELECTRONIC FILE DIGITALLY SIGNED AND SEALED UNDER RULE 61G15-23.004, F.A.C.

8/5/2024 4:28:50 PM BeattyM  
c:\pw\_work\sh\_pw\pw\_user\0439575\PLAINRD01.dgn


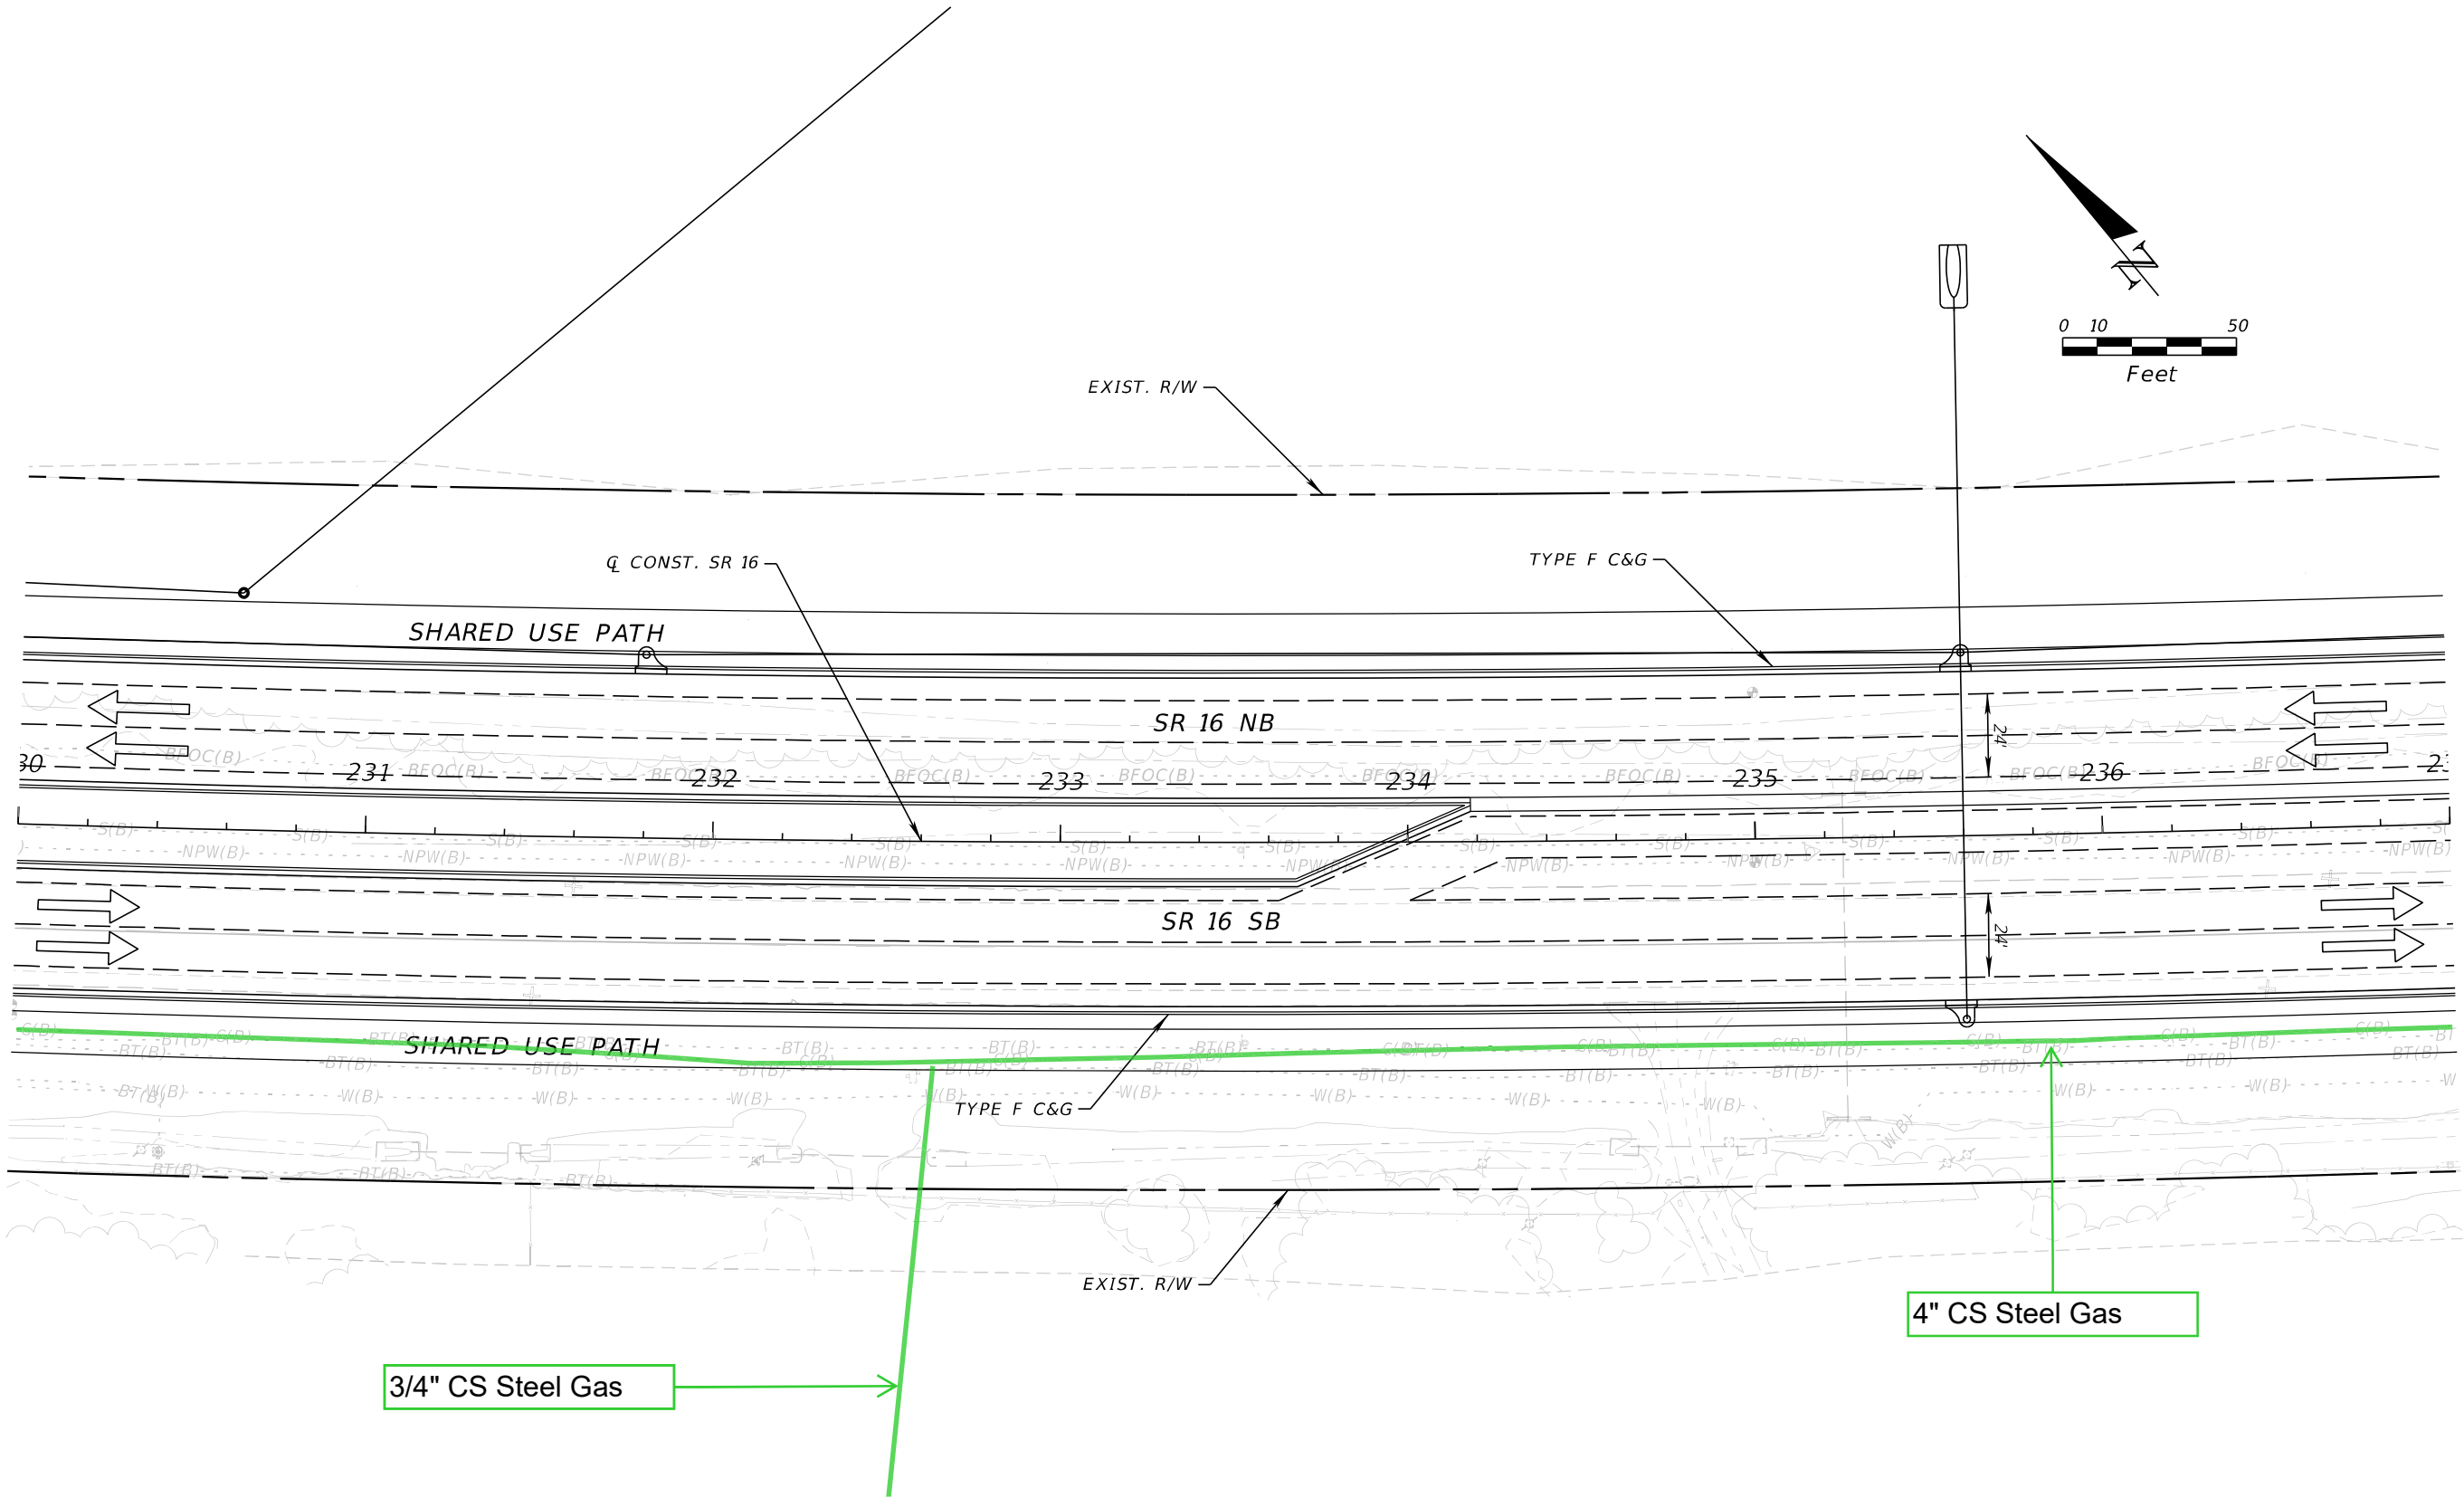


REVISIONS				ENGINEER OF RECORD	STATE OF FLORIDA DEPARTMENT OF TRANSPORTATION			SHEET NO.
DATE	DESCRIPTION	DATE	DESCRIPTION	STEPHEN J. PARK, P.E. LICENSE NUMBER: 77656 RS&H, INC. 10748 DEERWOOD PARK BLVD. SOUTH JACKSONVILLE, FL 32256				
					SR 16	ST. JOHNS	210447-5-52-01	
								11x17 Plan Only

THE OFFICIAL RECORD OF THIS SHEET IS THE ELECTRONIC FILE DIGITALLY SIGNED AND SEALED UNDER RULE 61G15-23.004, F.A.C.

8/5/2024 4:28:51 PM BeattyM  
c:\pw\_work\ysh\_pw\pw\_user\0439575\PLANRD01.dgn

CURVE DATA  
PI STA. = 239+02.25  
Δ = 10°55'00" (LT)  
D = 00°30'05"  
T = 1,092.10  
L = 2,177.60  
R = 2,177.60  
PC STA. = 228+10.14  
PT STA. = 249+87.74  
e = 0.000

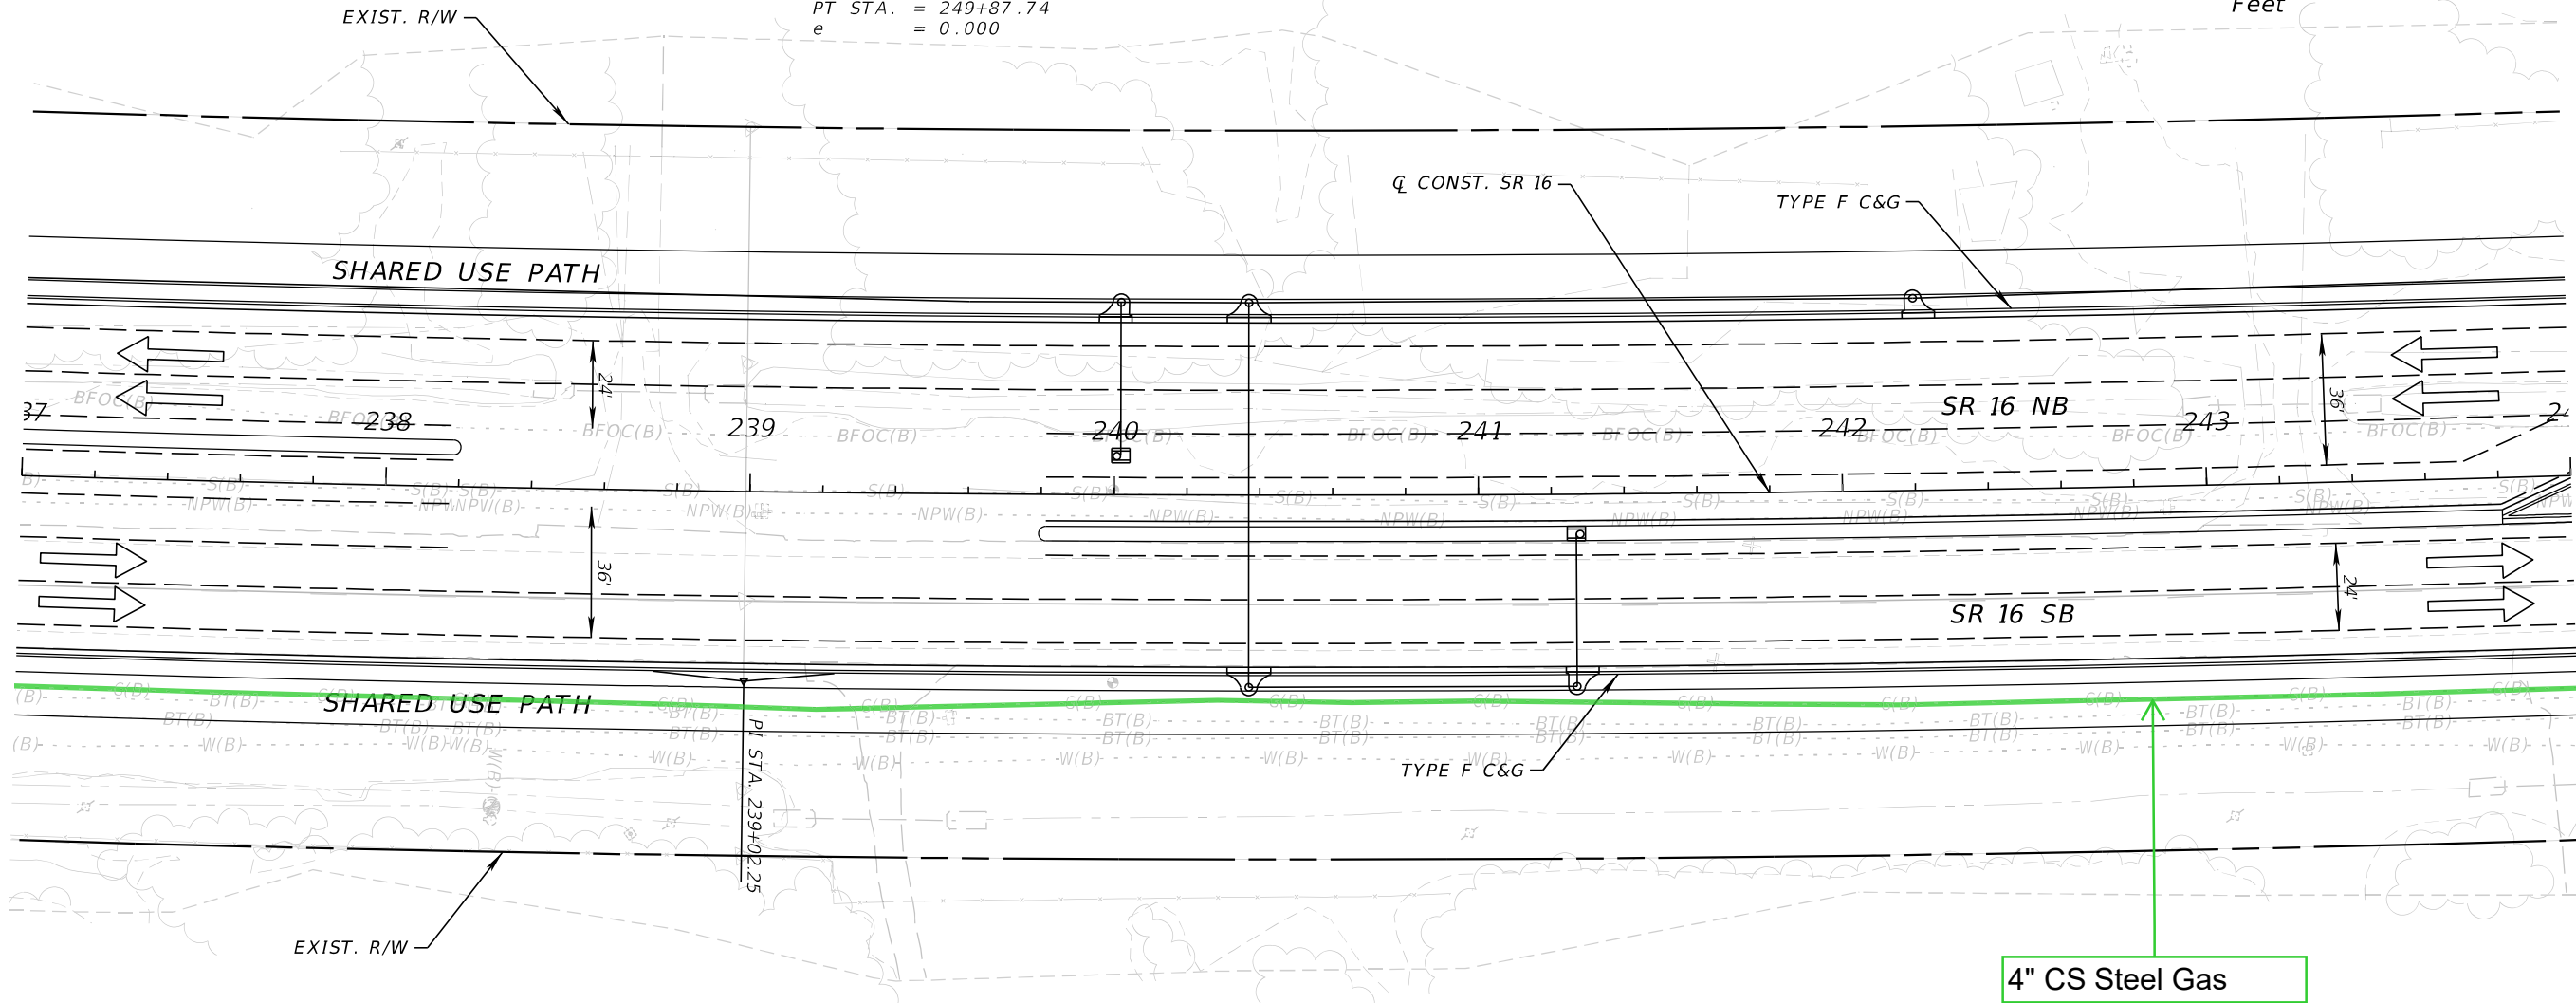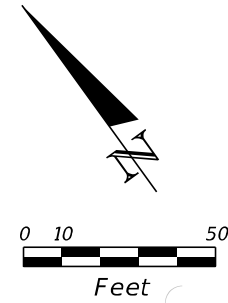


REVISIONS				ENGINEER OF RECORD		STATE OF FLORIDA DEPARTMENT OF TRANSPORTATION			SHEET NO.
DATE	DESCRIPTION	DATE	DESCRIPTION	STEPHEN J. PARK, P.E. LICENSE NUMBER: 77656 RS&H, INC. 10748 DEERWOOD PARK BLVD. SOUTH JACKSONVILLE, FL 32256		ROAD NO.	COUNTY	FINANCIAL PROJECT ID	
						SR 16	ST. JOHNS	210447-5-52-01	

THE OFFICIAL RECORD OF THIS SHEET IS THE ELECTRONIC FILE DIGITALLY SIGNED AND SEALED UNDER RULE 61G15-23.004, F.A.C.




8/5/2024 4:28:51 PM BeattyM  
c:\pw\_work\sh\_pw\pw\_user\0439575\PLAINRD01.dgn

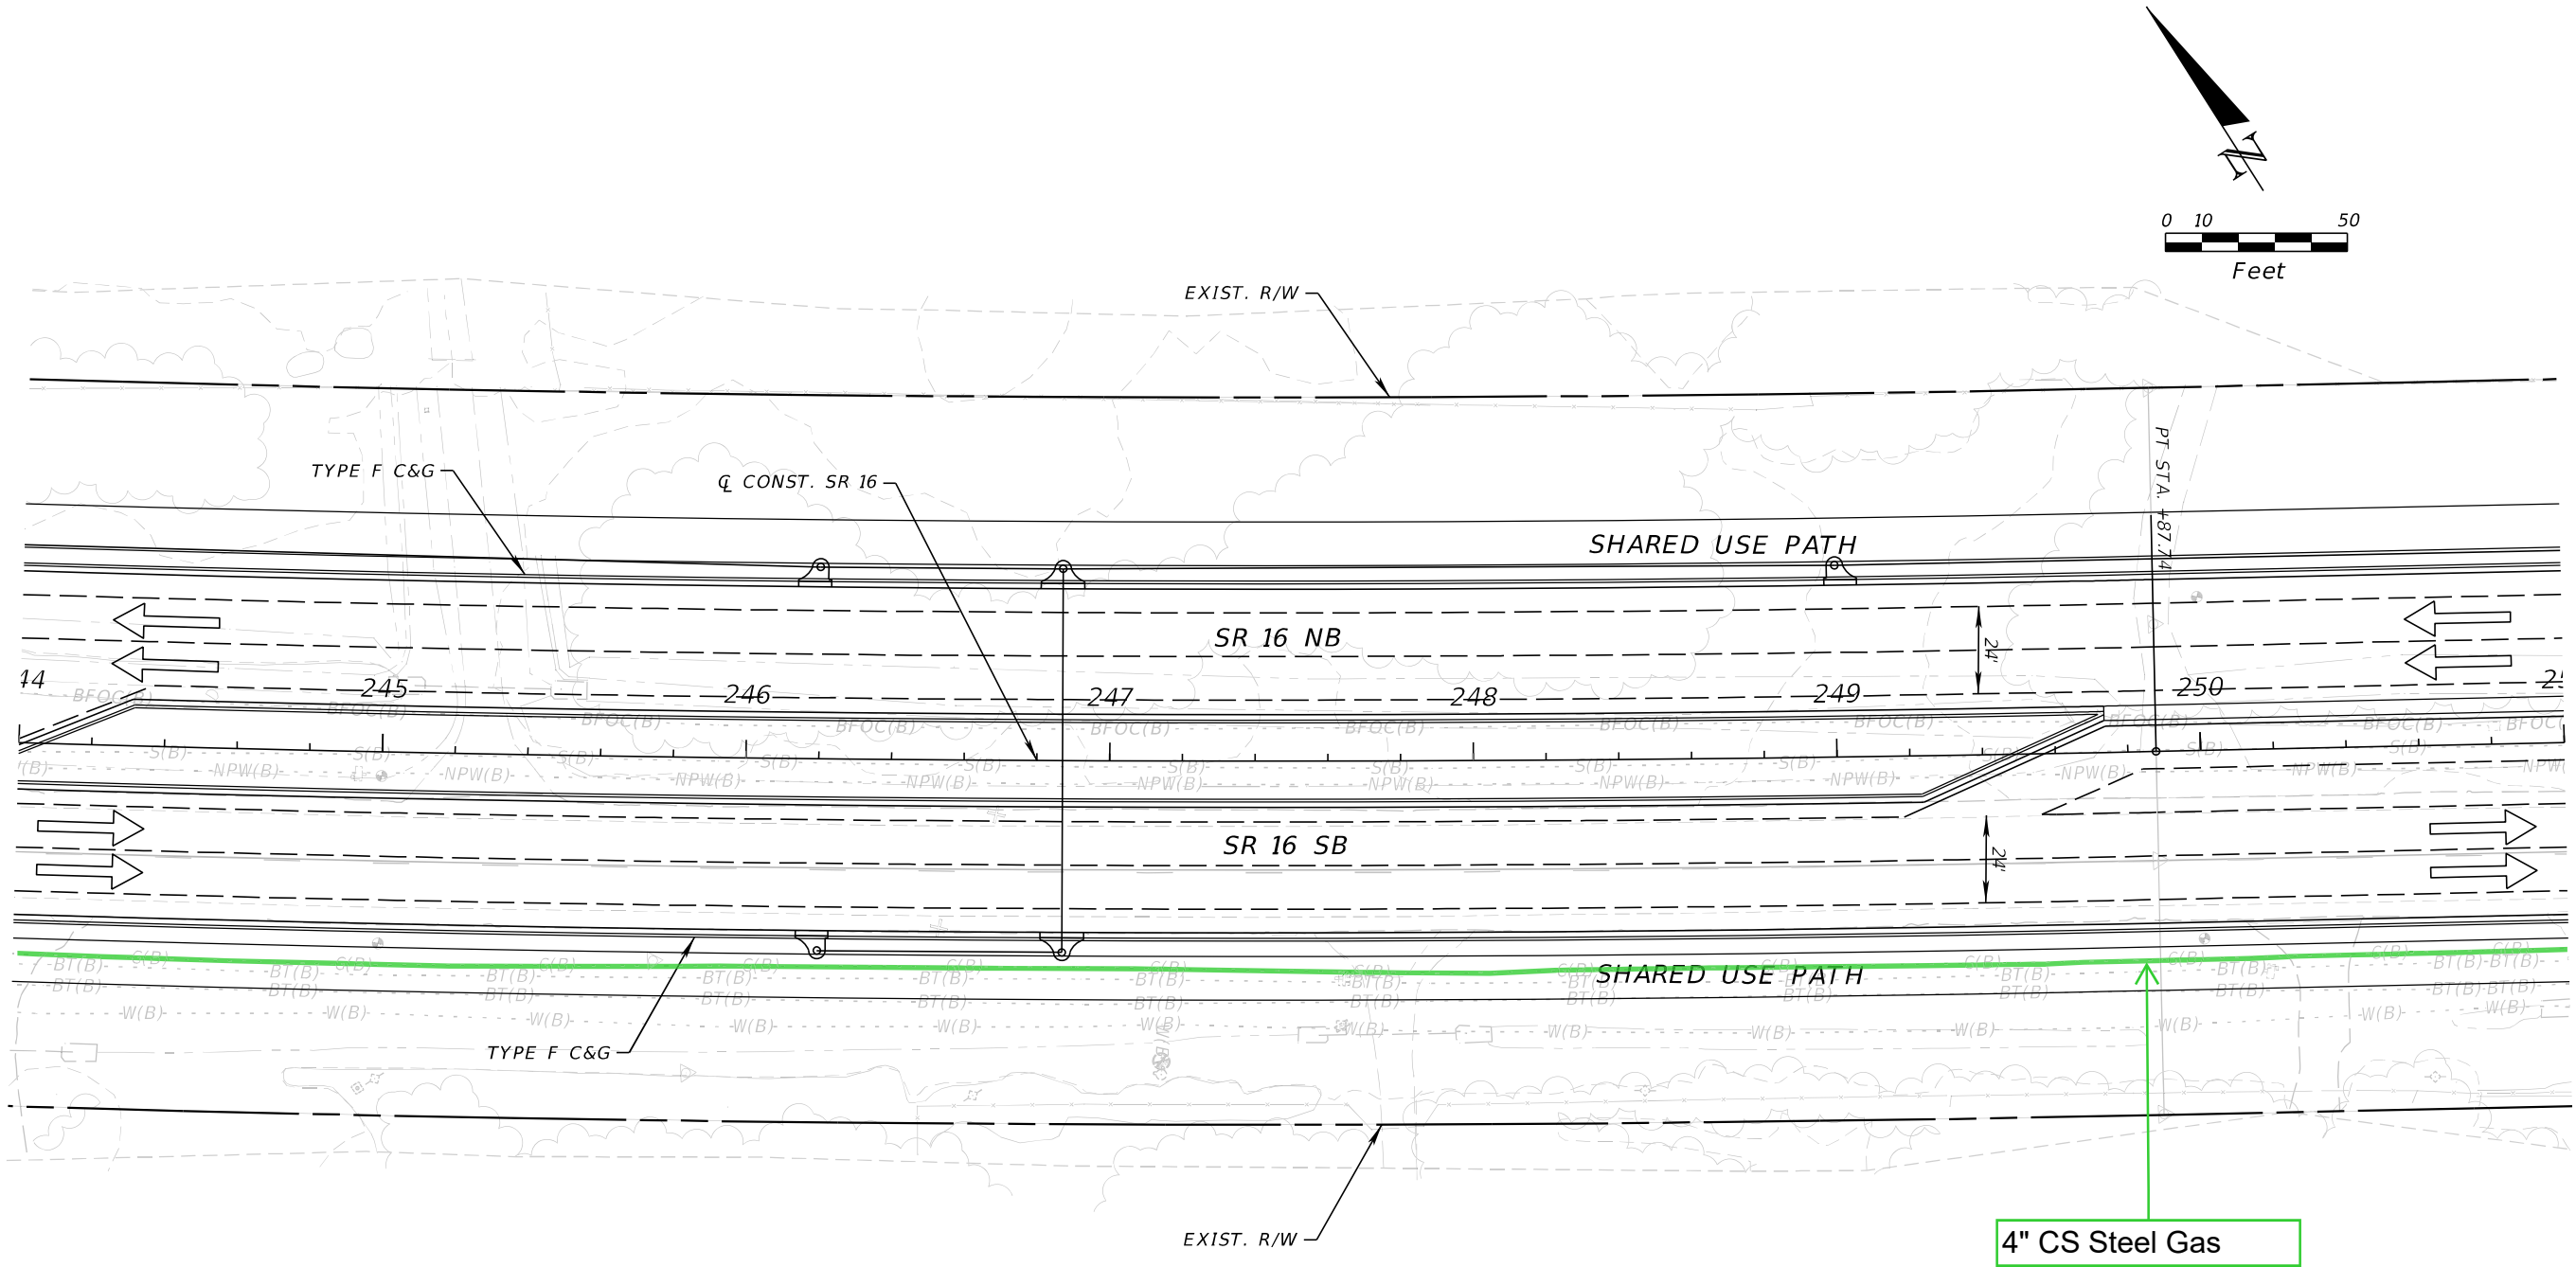

REVISIONS				ENGINEER OF RECORD	STATE OF FLORIDA DEPARTMENT OF TRANSPORTATION			SHEET NO.
DATE	DESCRIPTION	DATE	DESCRIPTION	STEPHEN J. PARK, P.E. LICENSE NUMBER: 77656 RS&H, INC. 10748 DEERWOOD PARK BLVD. SOUTH JACKSONVILLE, FL 32256	ROAD NO.	COUNTY	FINANCIAL PROJECT ID	
					SR 16	ST. JOHNS	210447-5-52-01	
								11x17 Plan Only

THE OFFICIAL RECORD OF THIS SHEET IS THE ELECTRONIC FILE DIGITALLY SIGNED AND SEALED UNDER RULE 61G15-23.004, F.A.C.


8/5/2024 4:28:52 PM BeattyM  
c:\pw\_work\ysh\_pw\pw\_user\00439575\PLANRD01.dgn

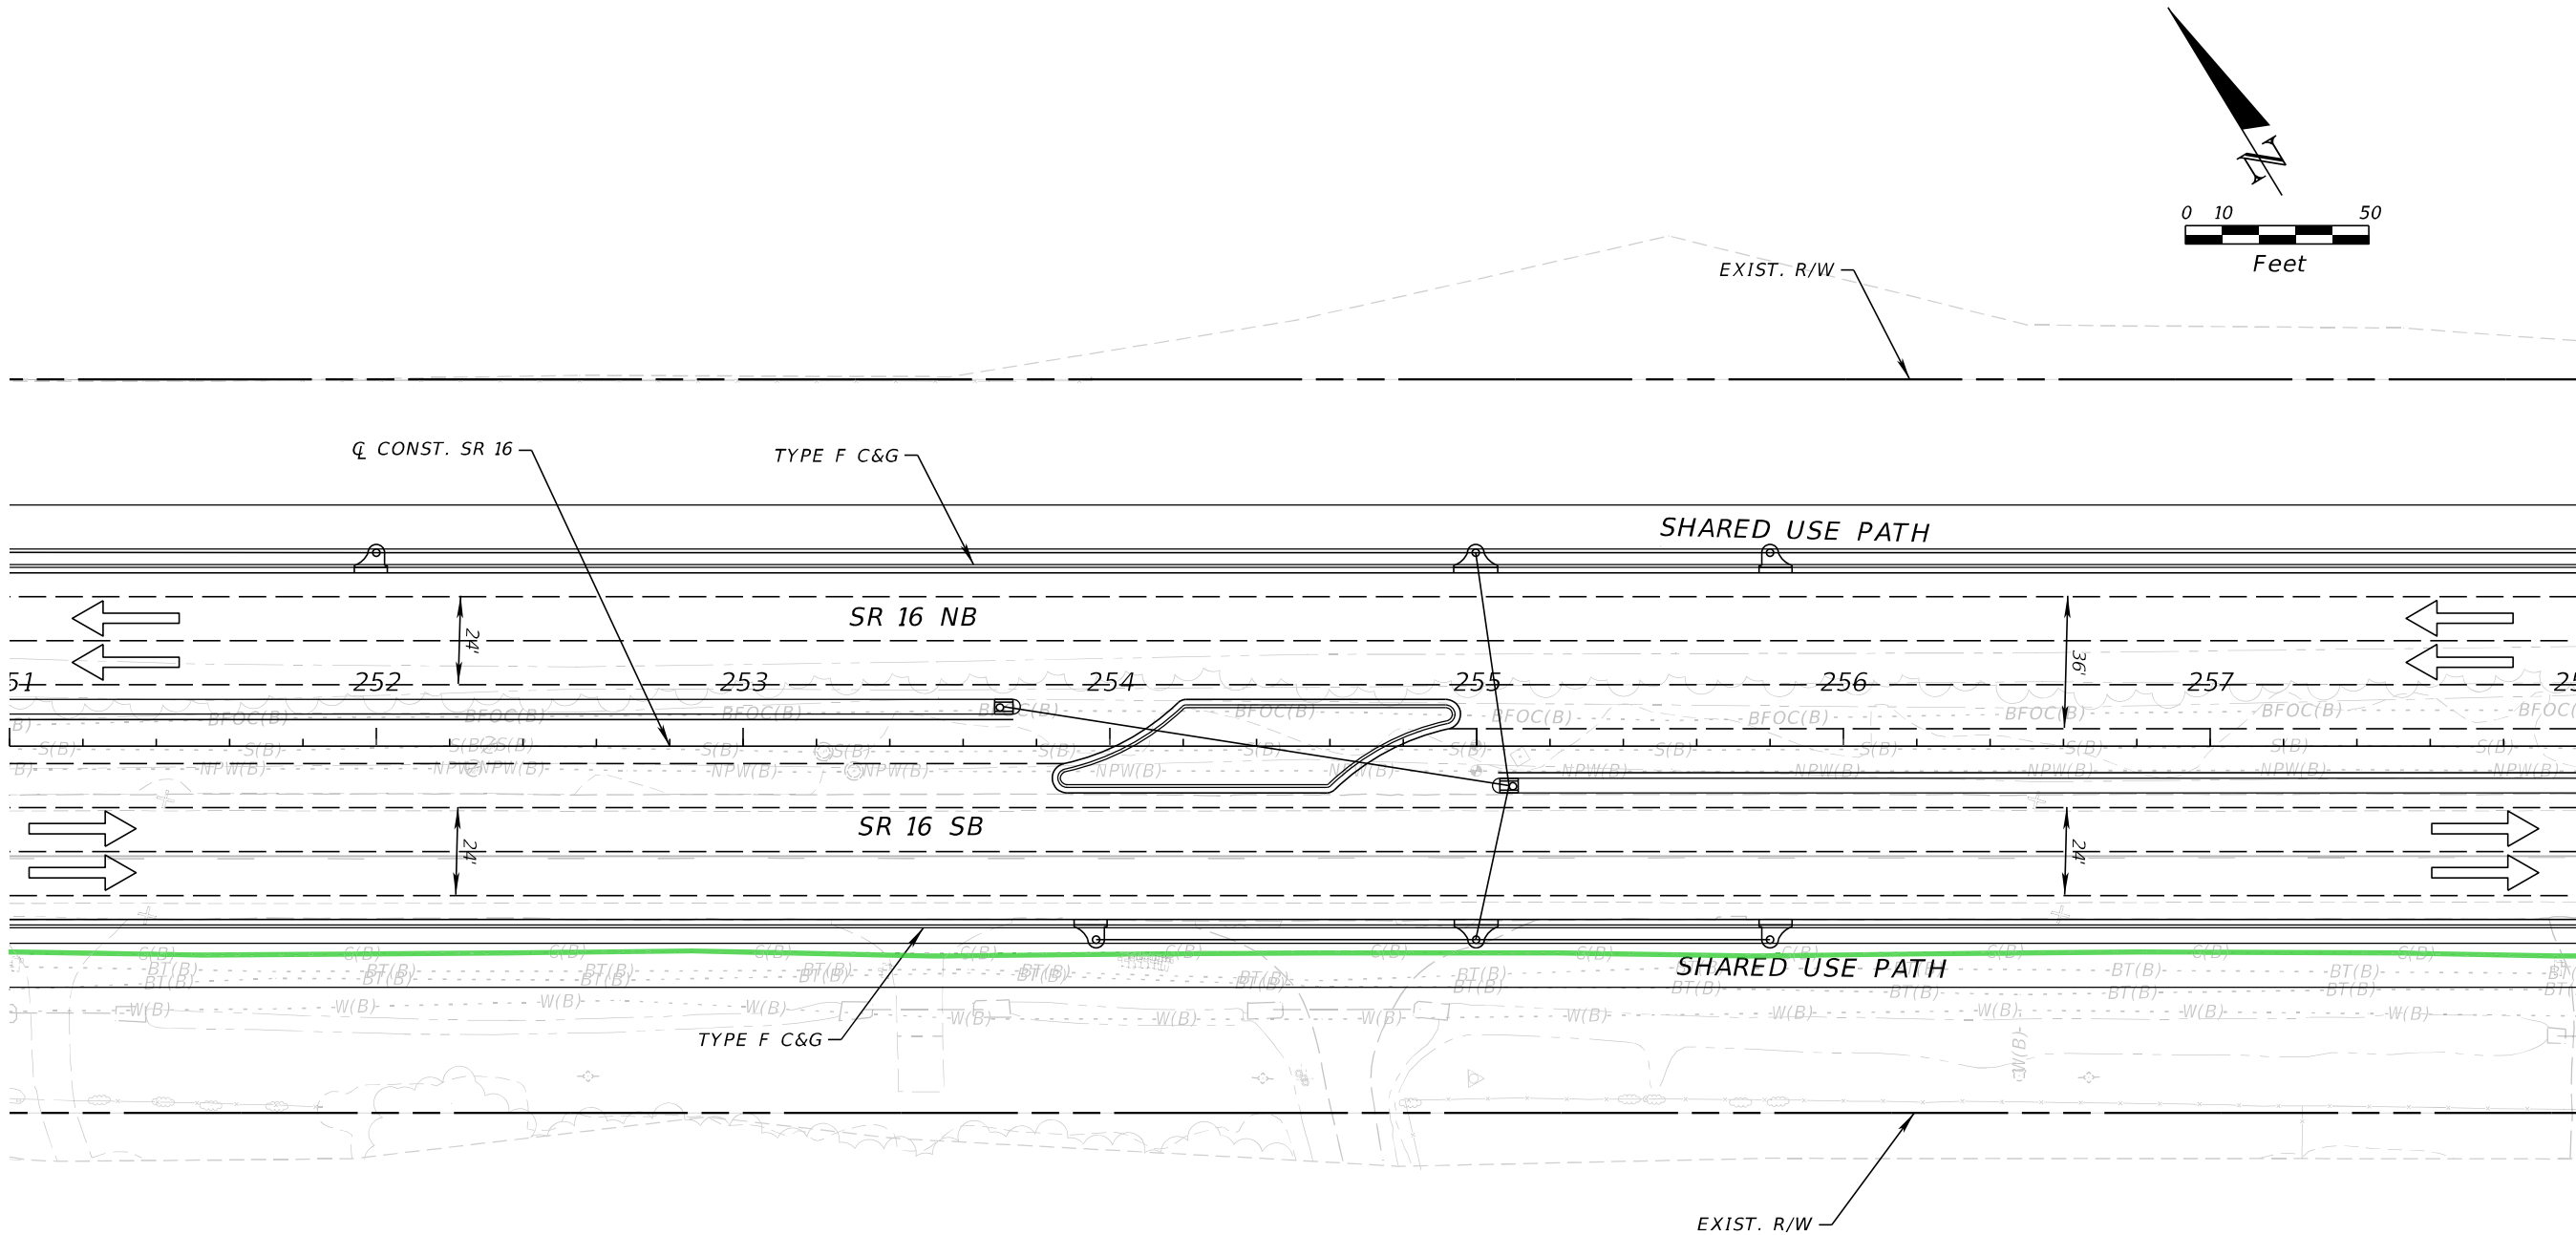

REVISIONS				ENGINEER OF RECORD	STATE OF FLORIDA DEPARTMENT OF TRANSPORTATION			SHEET NO.
DATE	DESCRIPTION	DATE	DESCRIPTION	STEPHEN J. PARK, P.E. LICENSE NUMBER: 77656 RS&H, INC. 10748 DEERWOOD PARK BLVD. SOUTH JACKSONVILLE, FL 32256	ROAD NO.	COUNTY	FINANCIAL PROJECT ID	
					SR 16	ST. JOHNS	210447-5-52-01	11x17 Plan Only

THE OFFICIAL RECORD OF THIS SHEET IS THE ELECTRONIC FILE DIGITALLY SIGNED AND SEALED UNDER RULE 61G15-23.004, F.A.C.


8/5/2024 4:28:52 PM BeattyM  
c:\pw\_work\ysh\_pw\pw\_user\00439575\PLANRD01.dgn

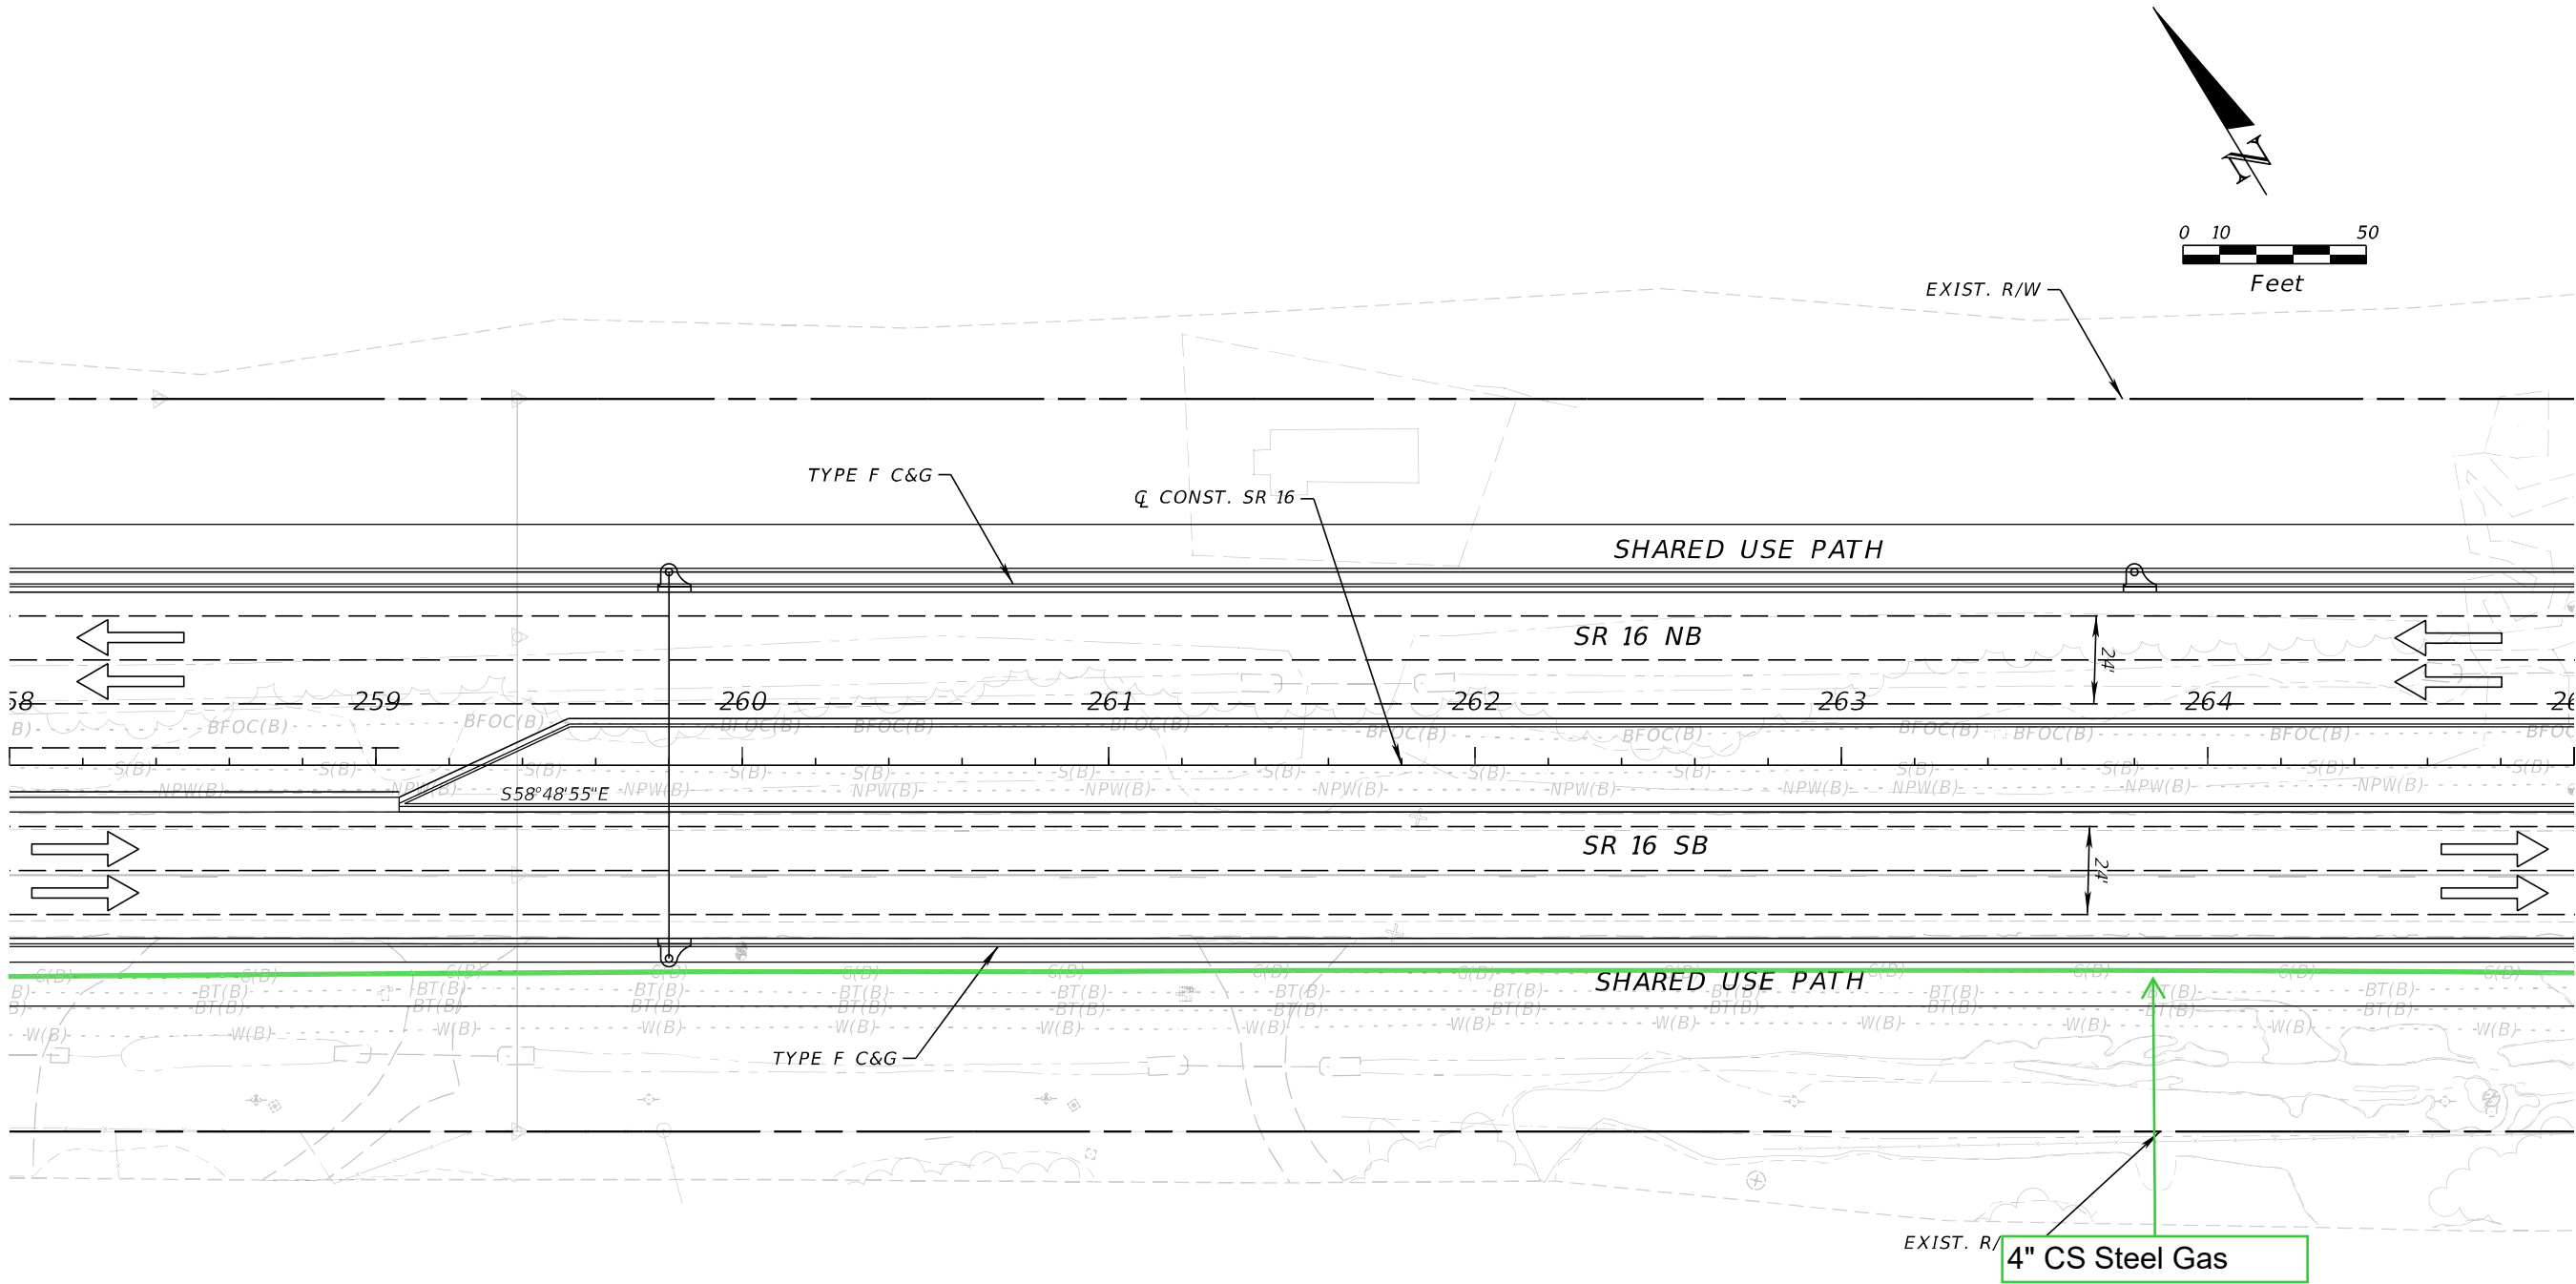

REVISIONS				ENGINEER OF RECORD	STATE OF FLORIDA DEPARTMENT OF TRANSPORTATION			SHEET NO.
DATE	DESCRIPTION	DATE	DESCRIPTION	STEPHEN J. PARK, P.E. LICENSE NUMBER: 77656 RS&H, INC. 10748 DEERWOOD PARK BLVD. SOUTH JACKSONVILLE, FL 32256	ROAD NO.	COUNTY	FINANCIAL PROJECT ID	
					SR 16	ST. JOHNS	210447-5-52-01	
11x17 Plan Only								

THE OFFICIAL RECORD OF THIS SHEET IS THE ELECTRONIC FILE DIGITALLY SIGNED AND SEALED UNDER RULE 61G15-23.004, F.A.C.


8/5/2024 4:28:53 PM BeattyM  
c:\pw\_work\ysh\_pw\pw\_user\0439575\PLANRD01.dgn

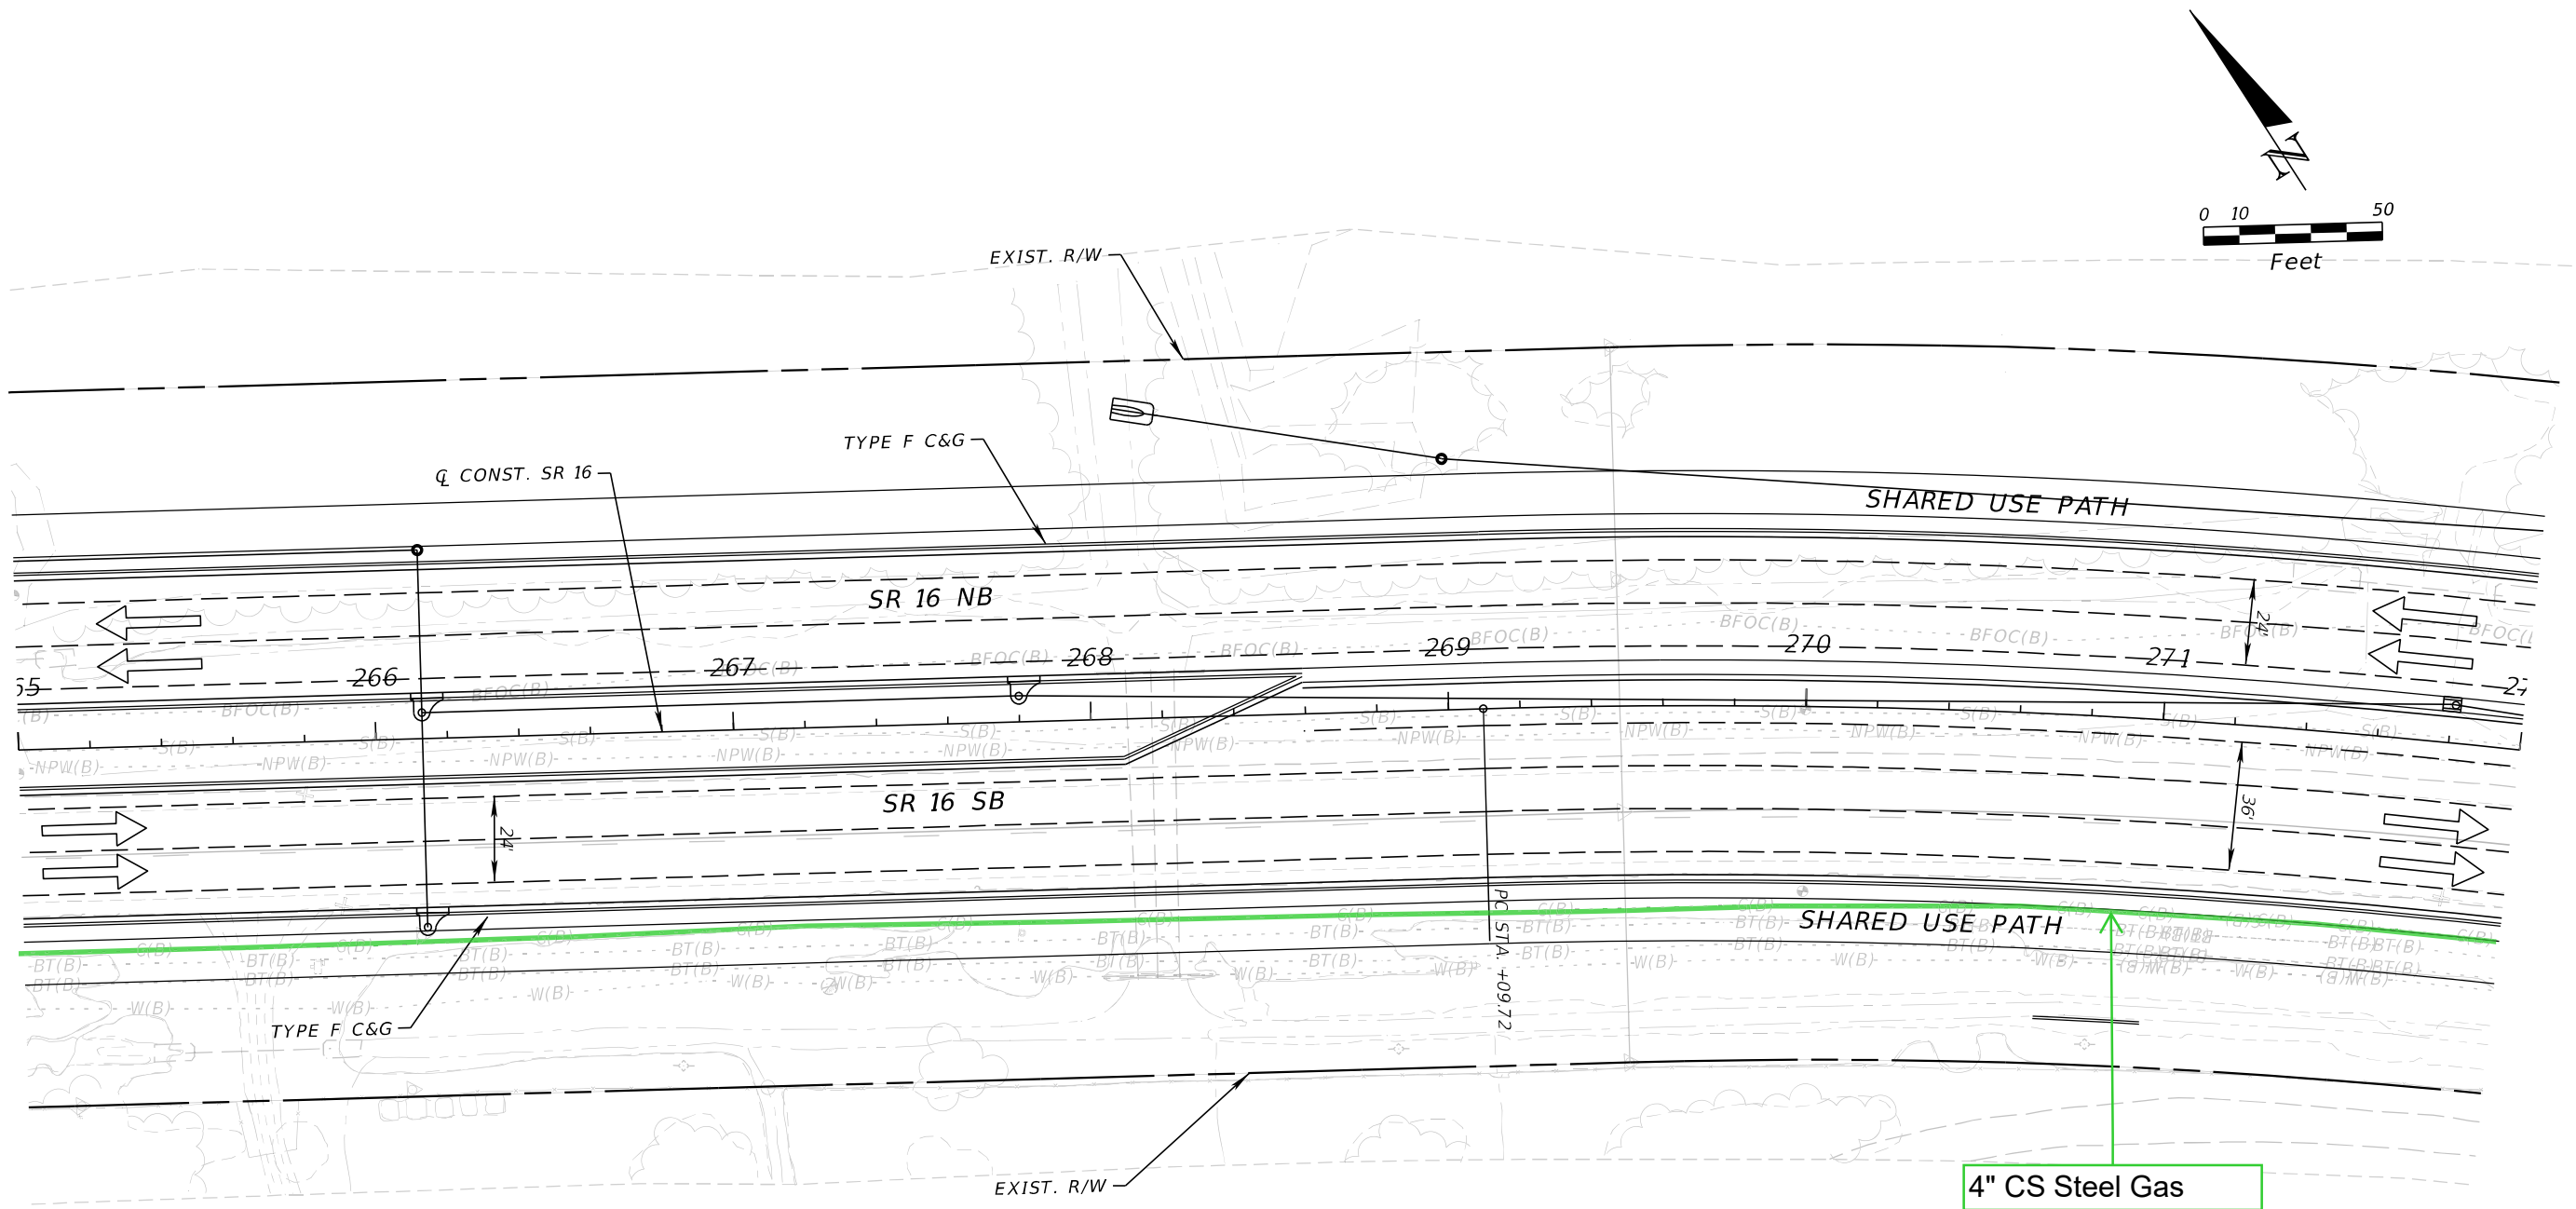

REVISIONS				ENGINEER OF RECORD	STATE OF FLORIDA DEPARTMENT OF TRANSPORTATION			SHEET NO.
DATE	DESCRIPTION	DATE	DESCRIPTION	STEPHEN J. PARK, P.E. LICENSE NUMBER: 77656 RS&H, INC. 10748 DEERWOOD PARK BLVD. SOUTH JACKSONVILLE, FL 32256	ROAD NO.	COUNTY	FINANCIAL PROJECT ID	
					SR 16	ST. JOHNS	210447-5-52-01	
							11x17 Plan Only	

THE OFFICIAL RECORD OF THIS SHEET IS THE ELECTRONIC FILE DIGITALLY SIGNED AND SEALED UNDER RULE 61G15-23.004, F.A.C.

8/5/2024 4:28:54 PM BeattyM  
c:\pw\_work\ysh\_pw\pw\_user\00439575\PLANRD01.dgn

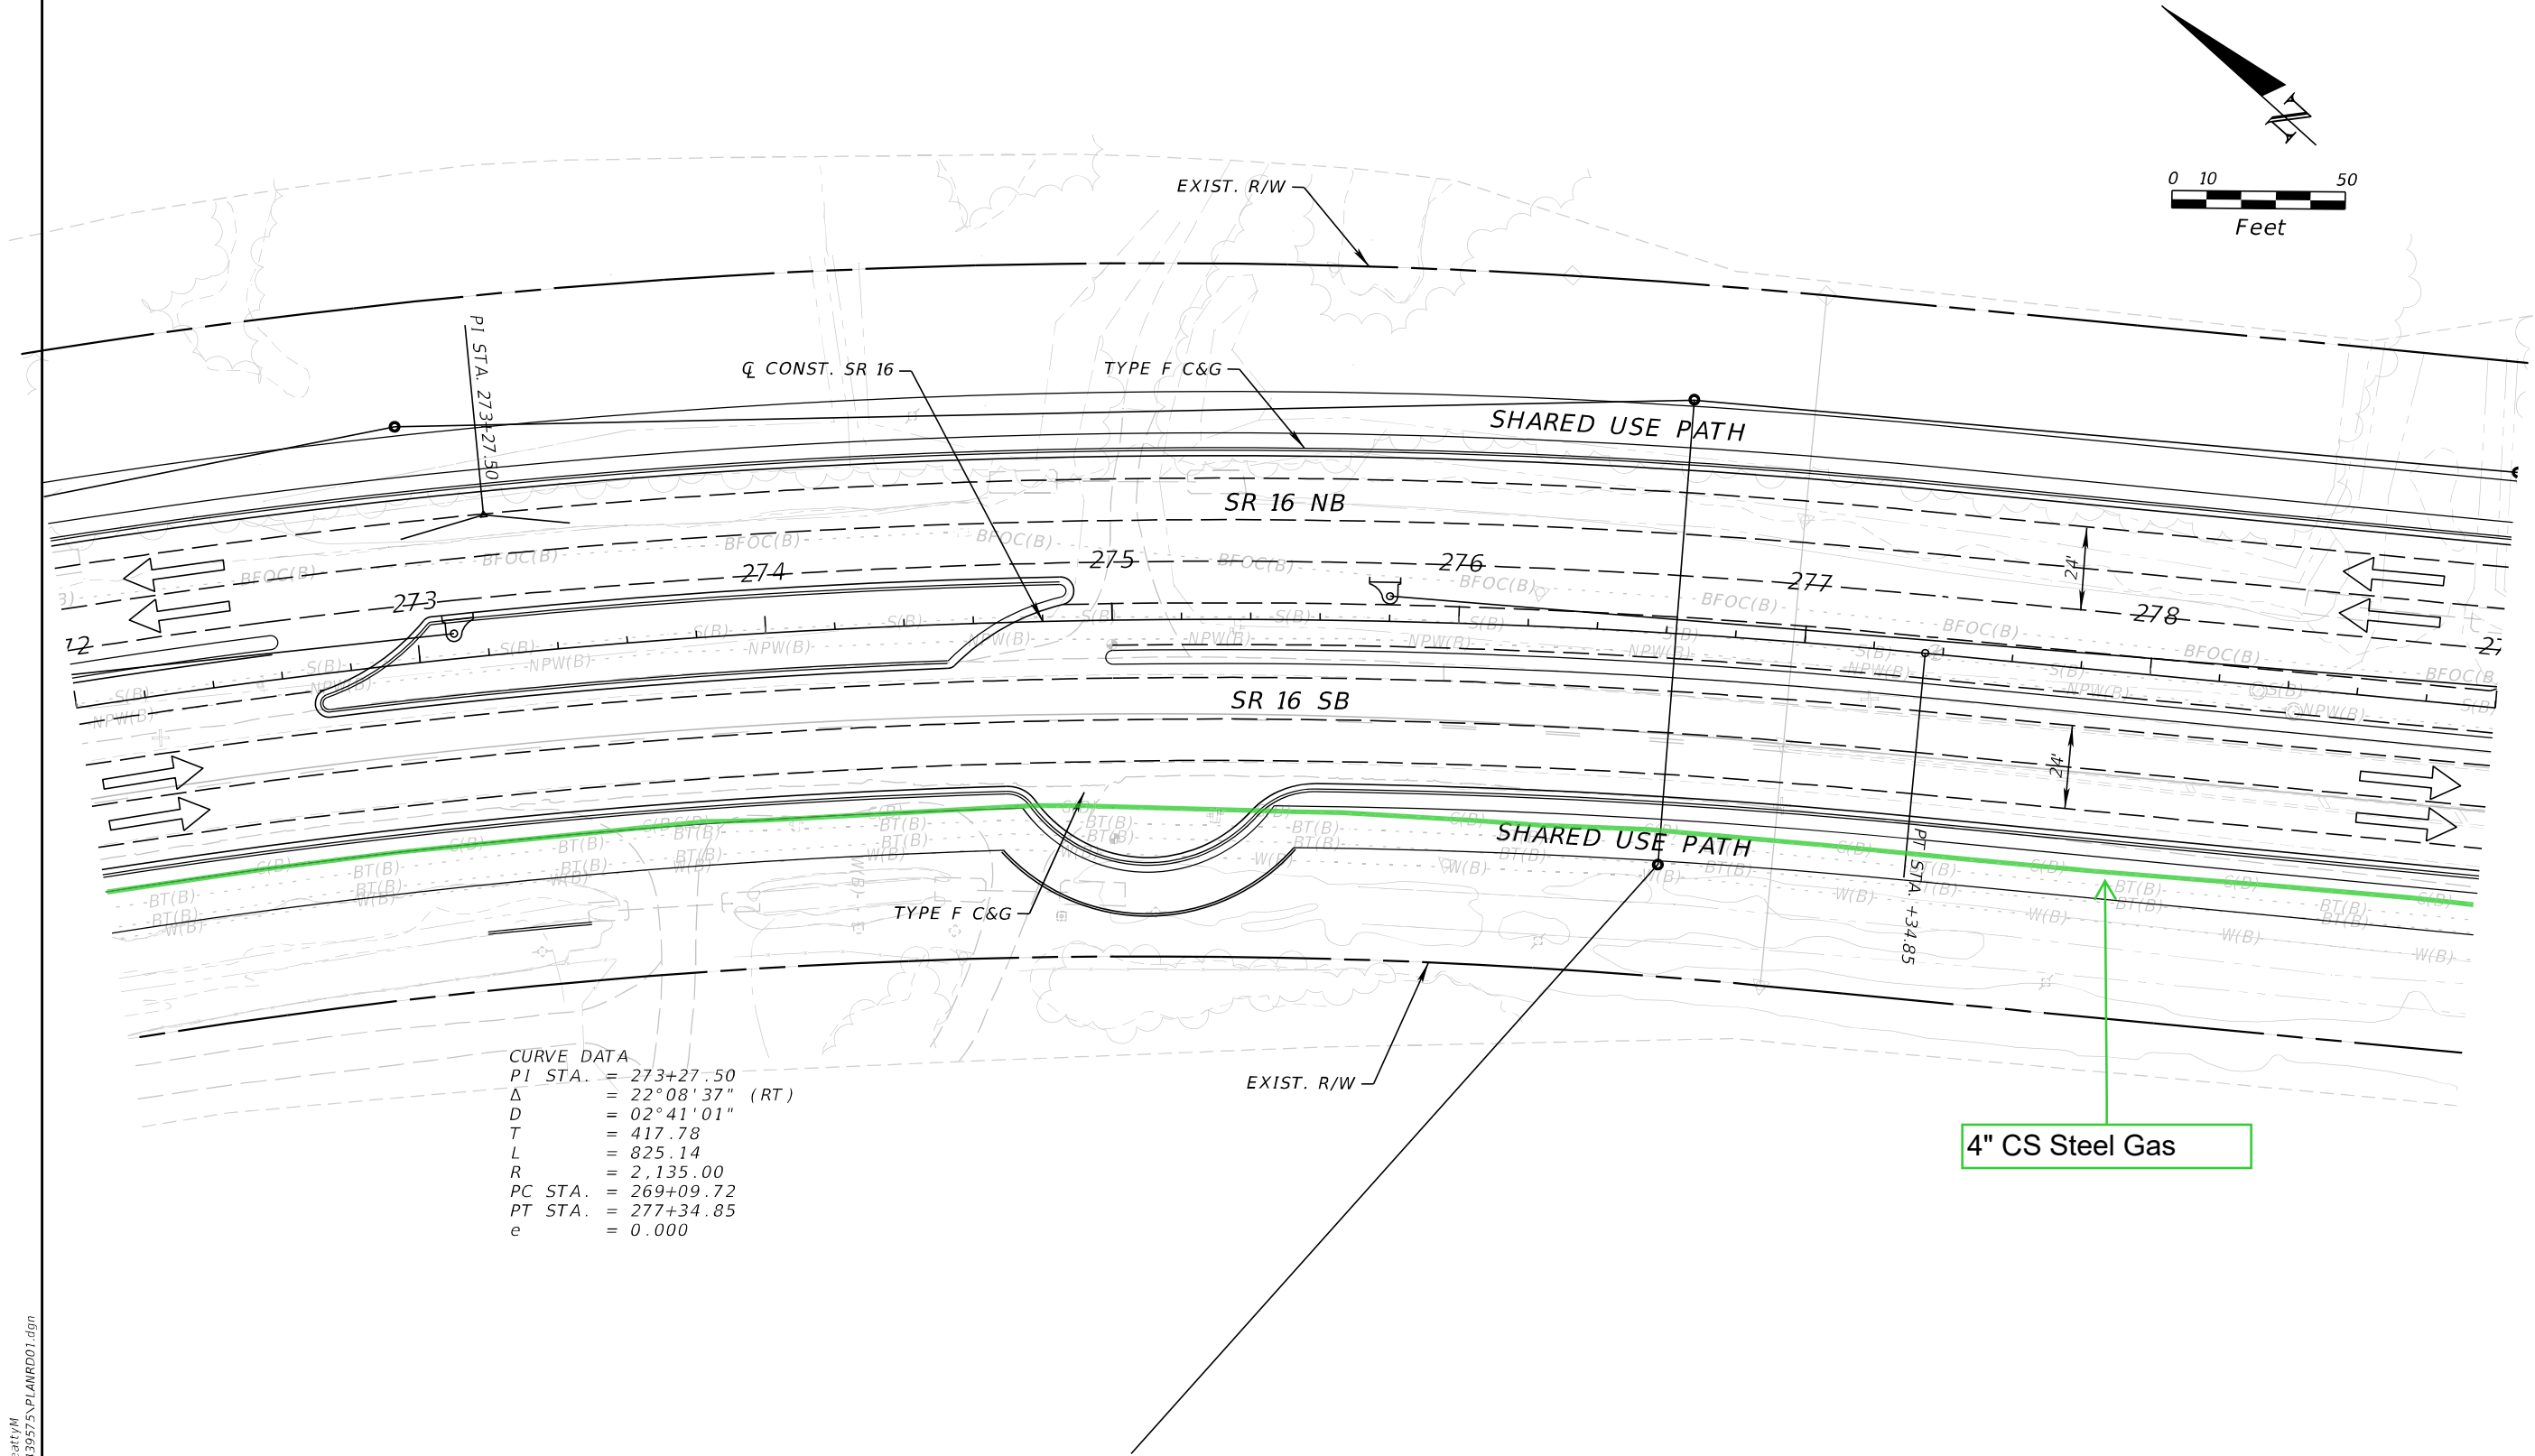

REVISIONS			
DATE	DESCRIPTION	DATE	DESCRIPTION

ENGINEER OF RECORD	
STEPHEN J. PARK, P.E. LICENSE NUMBER: 77656 RS&H, INC. 10748 DEERWOOD PARK BLVD. SOUTH JACKSONVILLE, FL 32256	


STATE OF FLORIDA DEPARTMENT OF TRANSPORTATION		
ROAD NO.	COUNTY	FINANCIAL PROJECT ID
SR 16	ST. JOHNS	210447-5-52-01

SHEET NO.
11x17 Plan Only

THE OFFICIAL RECORD OF THIS SHEET IS THE ELECTRONIC FILE DIGITALLY SIGNED AND SEALED UNDER RULE 61G15-23.004, F.A.C.




8/5/2024 4:28:54 PM BeattyM  
c:\pw\_work\sh\_pw\pw\_user\0439575\PLAINRD01.dgn

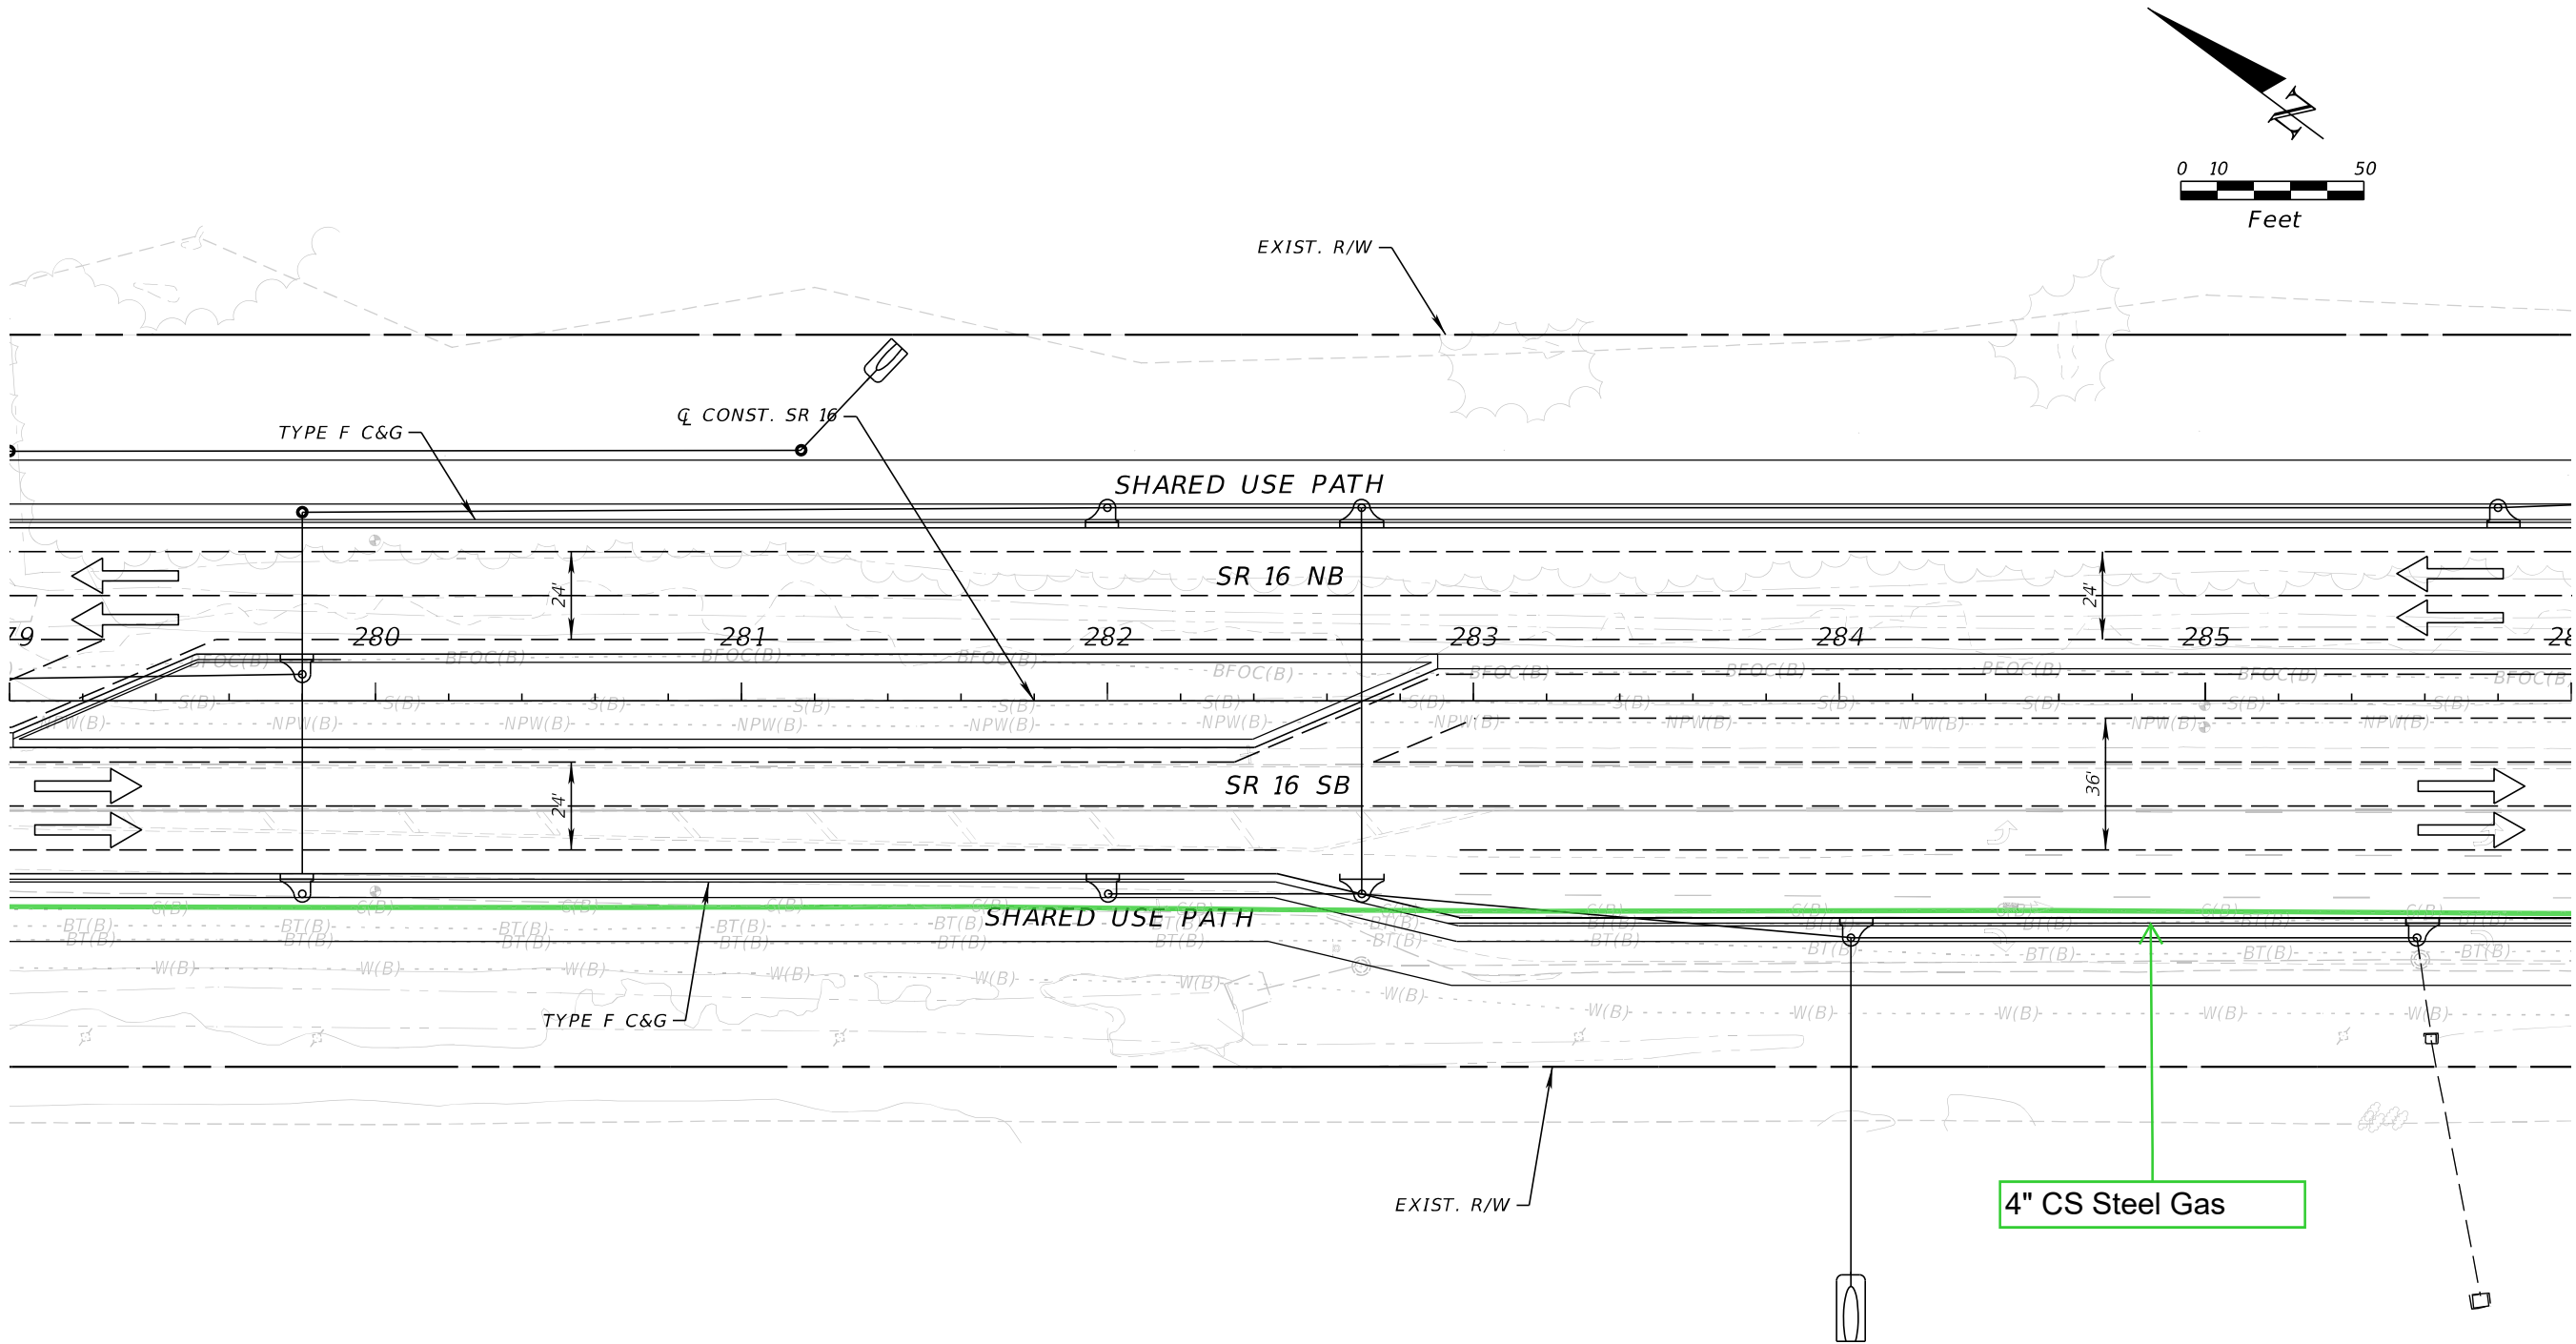

REVISIONS				ENGINEER OF RECORD	STATE OF FLORIDA DEPARTMENT OF TRANSPORTATION			SHEET NO.
DATE	DESCRIPTION	DATE	DESCRIPTION	STEPHEN J. PARK, P.E. LICENSE NUMBER: 77656 RS&H, INC. 10748 DEERWOOD PARK BLVD. SOUTH JACKSONVILLE, FL 32256	ROAD NO.	COUNTY	FINANCIAL PROJECT ID	
					SR 16	ST. JOHNS	210447-5-52-01	
								11x17 Plan Only

THE OFFICIAL RECORD OF THIS SHEET IS THE ELECTRONIC FILE DIGITALLY SIGNED AND SEALED UNDER RULE 61G15-23.004, F.A.C.


8/5/2024 4:28:55 PM BeattyM  
c:\pw\_work\sh\_pw\pw\_user\0439575\PLANRD01.dgn

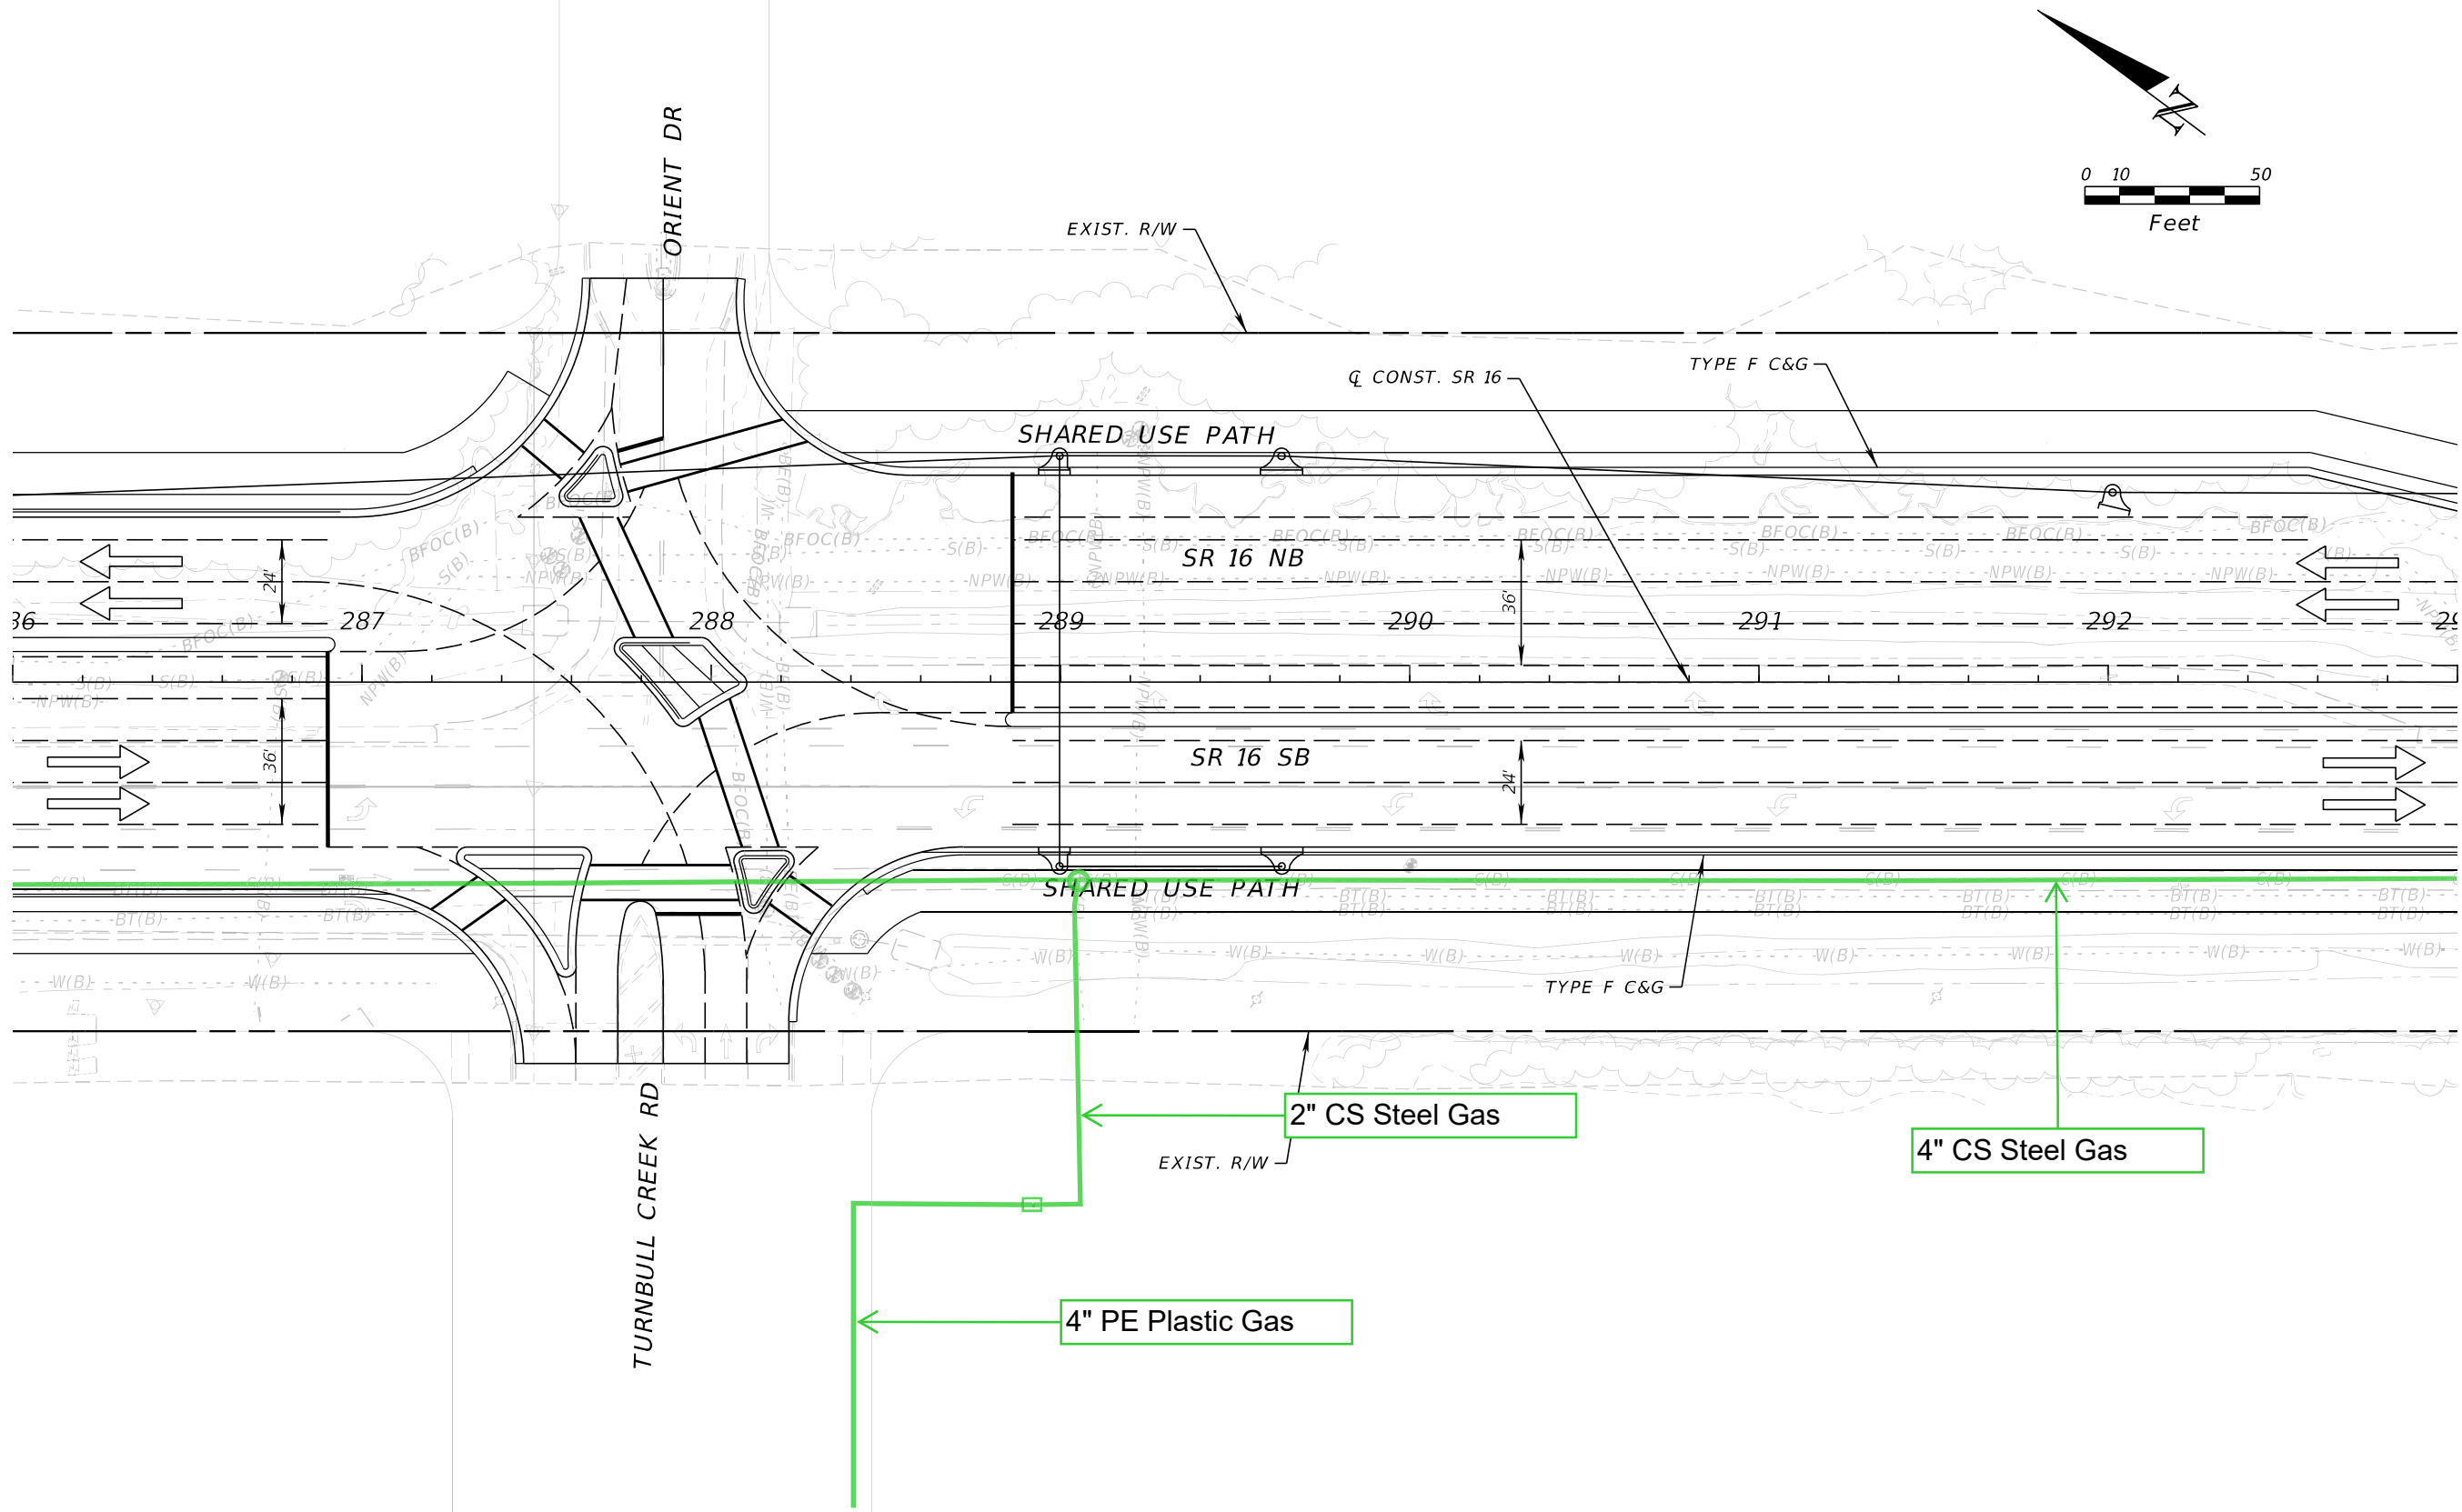

REVISIONS				ENGINEER OF RECORD	STATE OF FLORIDA DEPARTMENT OF TRANSPORTATION			SHEET NO.
DATE	DESCRIPTION	DATE	DESCRIPTION		ROAD NO.	COUNTY	FINANCIAL PROJECT ID	
					SR 16	ST. JOHNS	210447-5-52-01	
				STEPHEN J. PARK, P.E. LICENSE NUMBER: 77656 RS&H, INC. 10748 DEERWOOD PARK BLVD. SOUTH JACKSONVILLE, FL 32256				11x17 Plan Only

THE OFFICIAL RECORD OF THIS SHEET IS THE ELECTRONIC FILE DIGITALLY SIGNED AND SEALED UNDER RULE 61G15-23.004, F.A.C.


8/5/2024 4:28:55 PM BeattyM  
c:\pw\_work\sh\_pw\pw\_user\00439575\PLANRD01.dgn

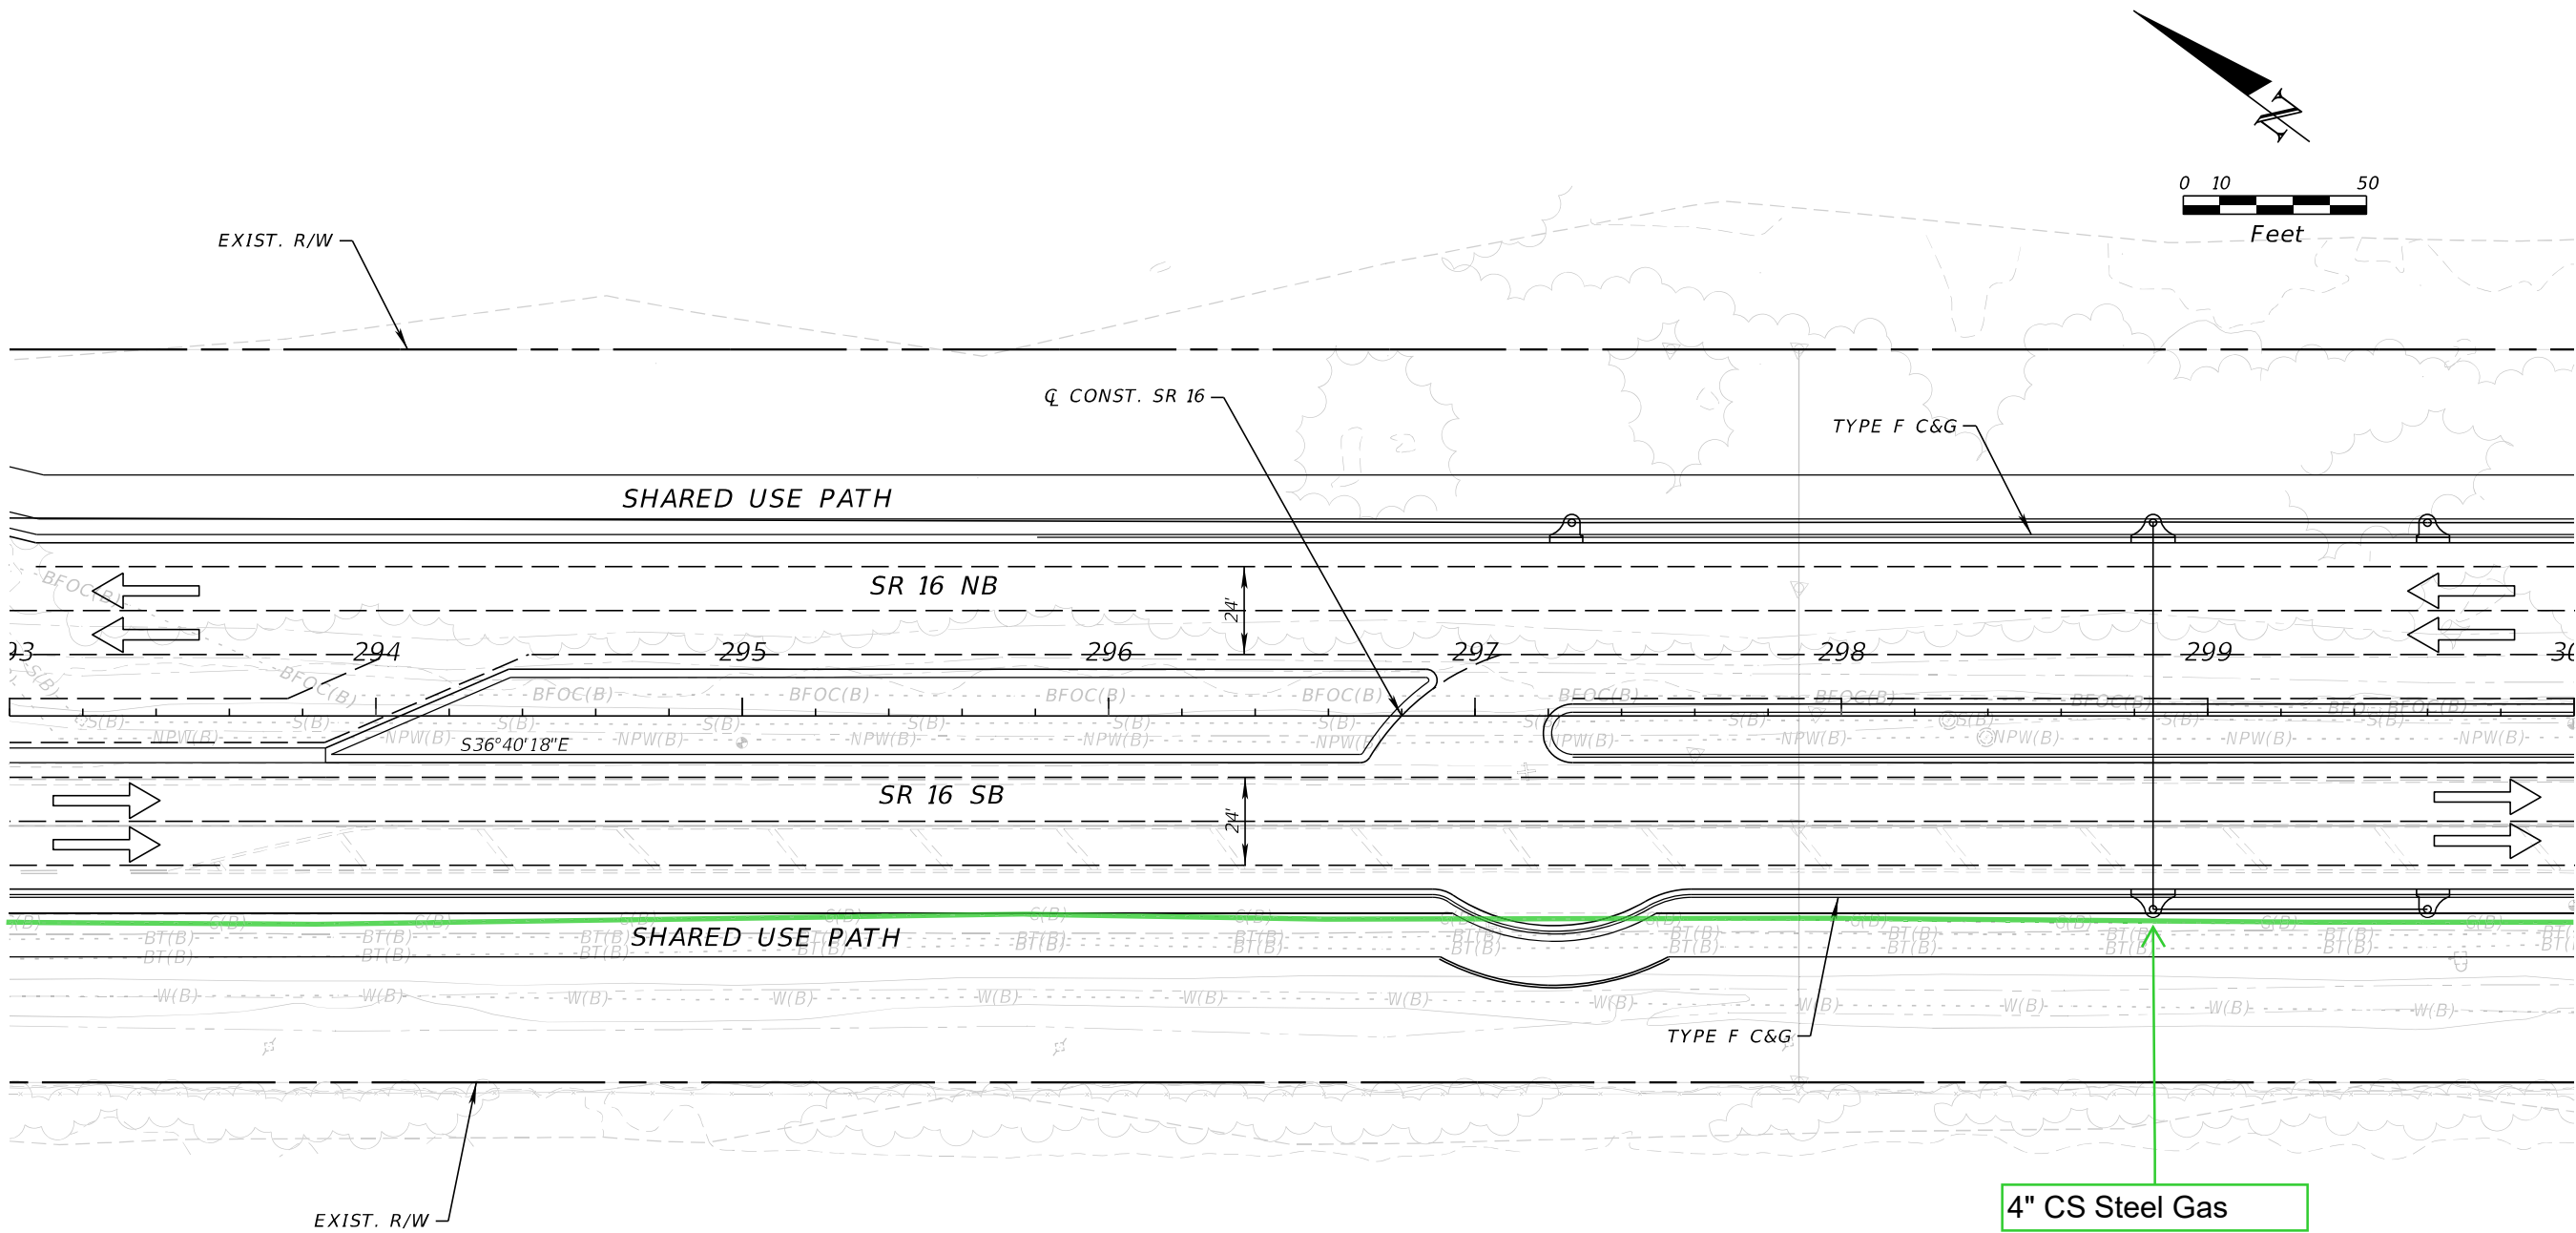

REVISIONS				ENGINEER OF RECORD	STATE OF FLORIDA DEPARTMENT OF TRANSPORTATION			SHEET NO.
DATE	DESCRIPTION	DATE	DESCRIPTION	STEPHEN J. PARK, P.E. LICENSE NUMBER: 77656 RS&H, INC. 10748 DEERWOOD PARK BLVD. SOUTH JACKSONVILLE, FL 32256				
					ROAD NO.	COUNTY	FINANCIAL PROJECT ID	
				SR 16	ST. JOHNS	210447-5-52-01		

THE OFFICIAL RECORD OF THIS SHEET IS THE ELECTRONIC FILE DIGITALLY SIGNED AND SEALED UNDER RULE 61G15-23.004, F.A.C.


8/5/2024 4:28:56 PM BeattyM  
c:\pw\_work\ysh\_pw\pw\_user\0439575\PLANRD01.dgn

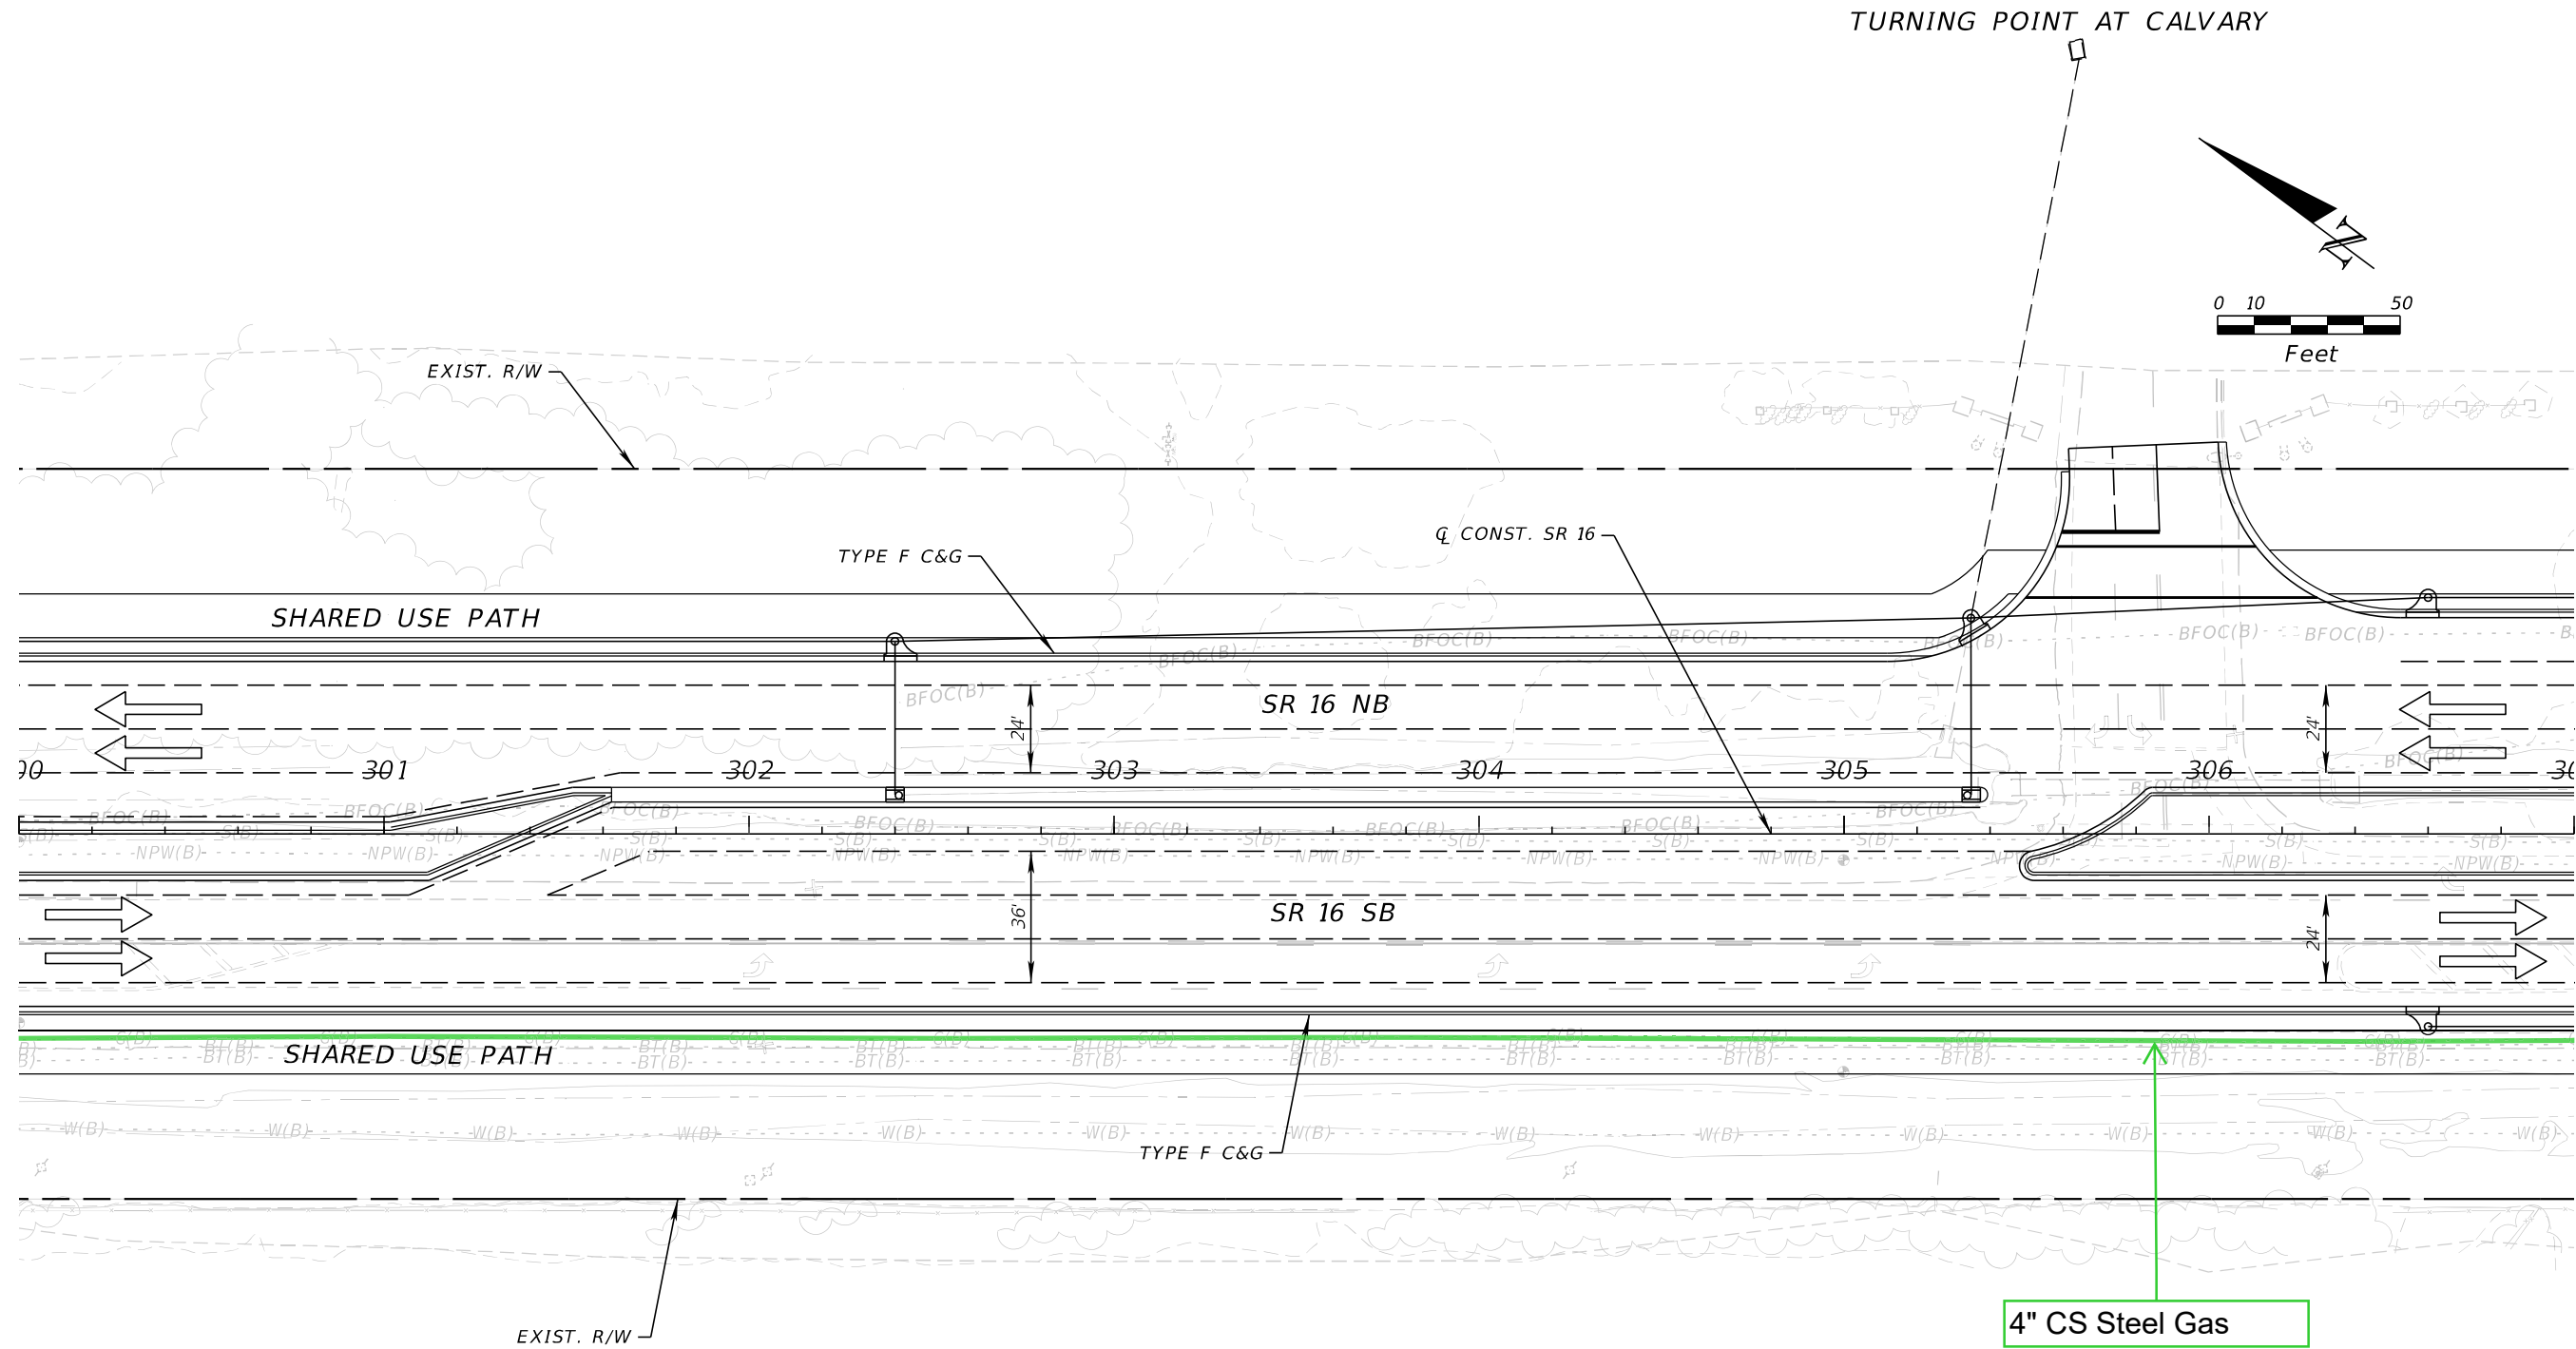

REVISIONS				ENGINEER OF RECORD	STATE OF FLORIDA DEPARTMENT OF TRANSPORTATION			SHEET NO.
DATE	DESCRIPTION	DATE	DESCRIPTION	STEPHEN J. PARK, P.E. LICENSE NUMBER: 77656 RS&H, INC. 10748 DEERWOOD PARK BLVD. SOUTH JACKSONVILLE, FL 32256	ROAD NO.	COUNTY	FINANCIAL PROJECT ID	
					SR 16	ST. JOHNS	210447-5-52-01	
								11x17 Plan Only

THE OFFICIAL RECORD OF THIS SHEET IS THE ELECTRONIC FILE DIGITALLY SIGNED AND SEALED UNDER RULE 61G15-23.004, F.A.C.

8/5/2024 4:28:57 PM BeattyM  
c:\pw\_work\ysh\_pw\pw\_user\0439575\PLANRD01.dgn

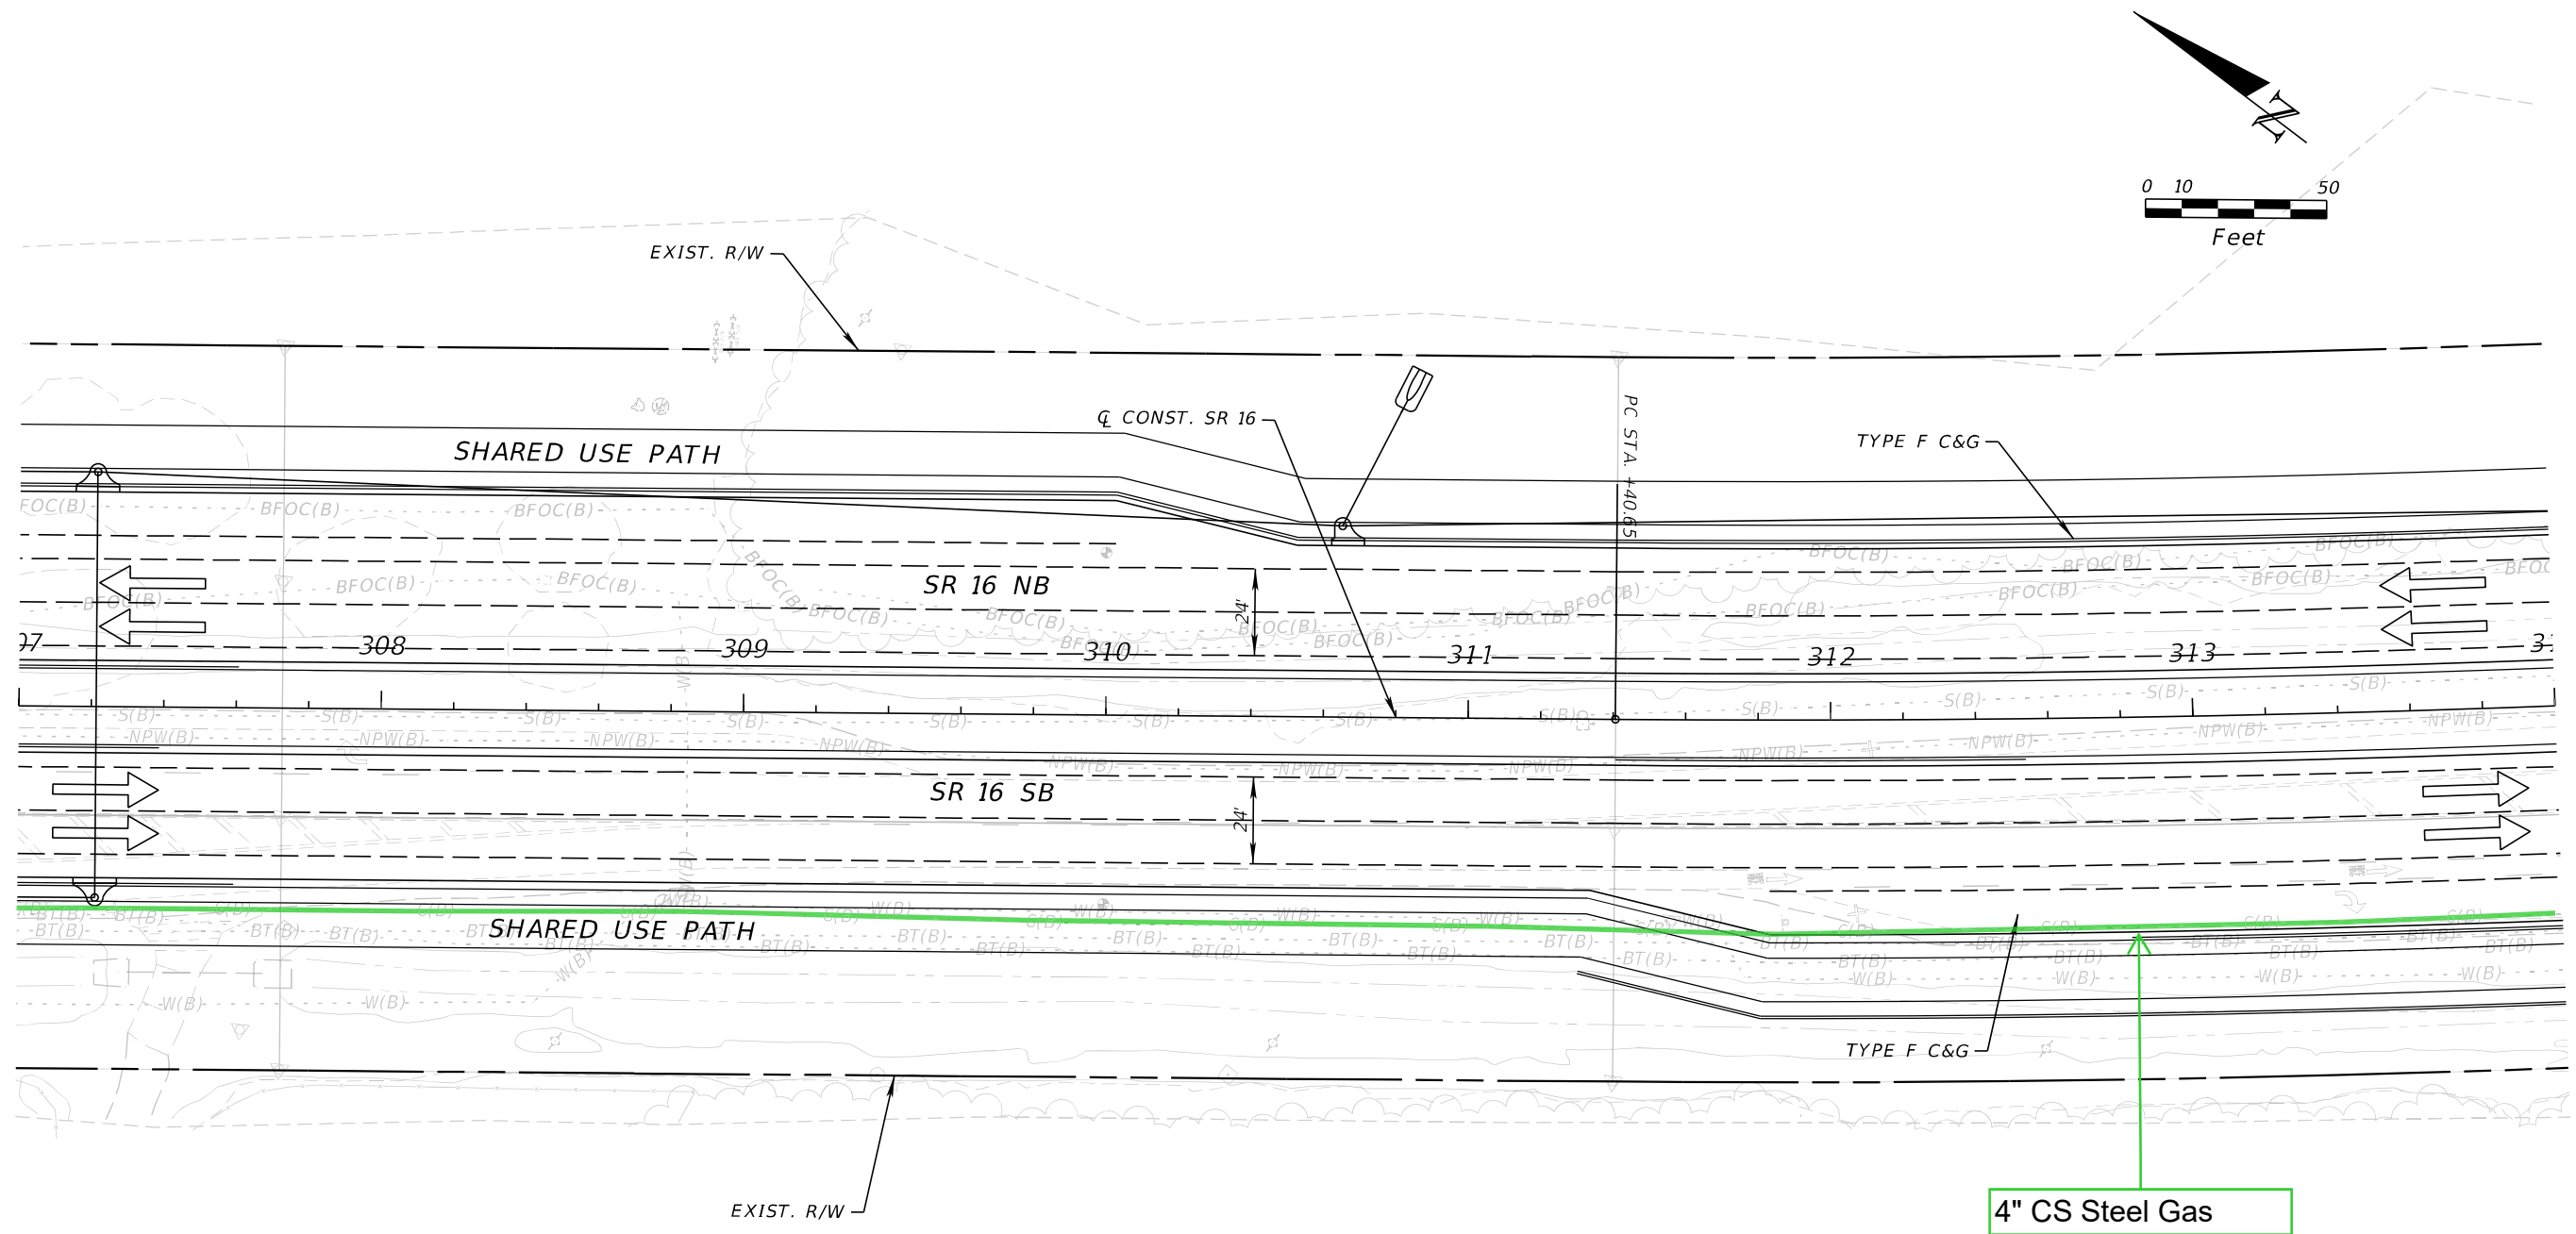


REVISIONS				ENGINEER OF RECORD	STATE OF FLORIDA DEPARTMENT OF TRANSPORTATION			SHEET NO.		
DATE	DESCRIPTION		DATE	DESCRIPTION		ROAD NO.	COUNTY		FINANCIAL PROJECT ID	
						STEPHEN J. PARK, P.E. LICENSE NUMBER: 77656 RS&H, INC. 10748 DEERWOOD PARK BLVD. SOUTH JACKSONVILLE, FL 32256	SR 16	ST. JOHNS	210447-5-52-01	11x17 Plan Only

THE OFFICIAL RECORD OF THIS SHEET IS THE ELECTRONIC FILE DIGITALLY SIGNED AND SEALED UNDER RULE 61G15-23.004, F.A.C.





8/5/2024 4:28:57 PM BeattyM  
c:\pw\_work\ysh\_pw\pw\_user\0439575\PLAINRD01.dgn

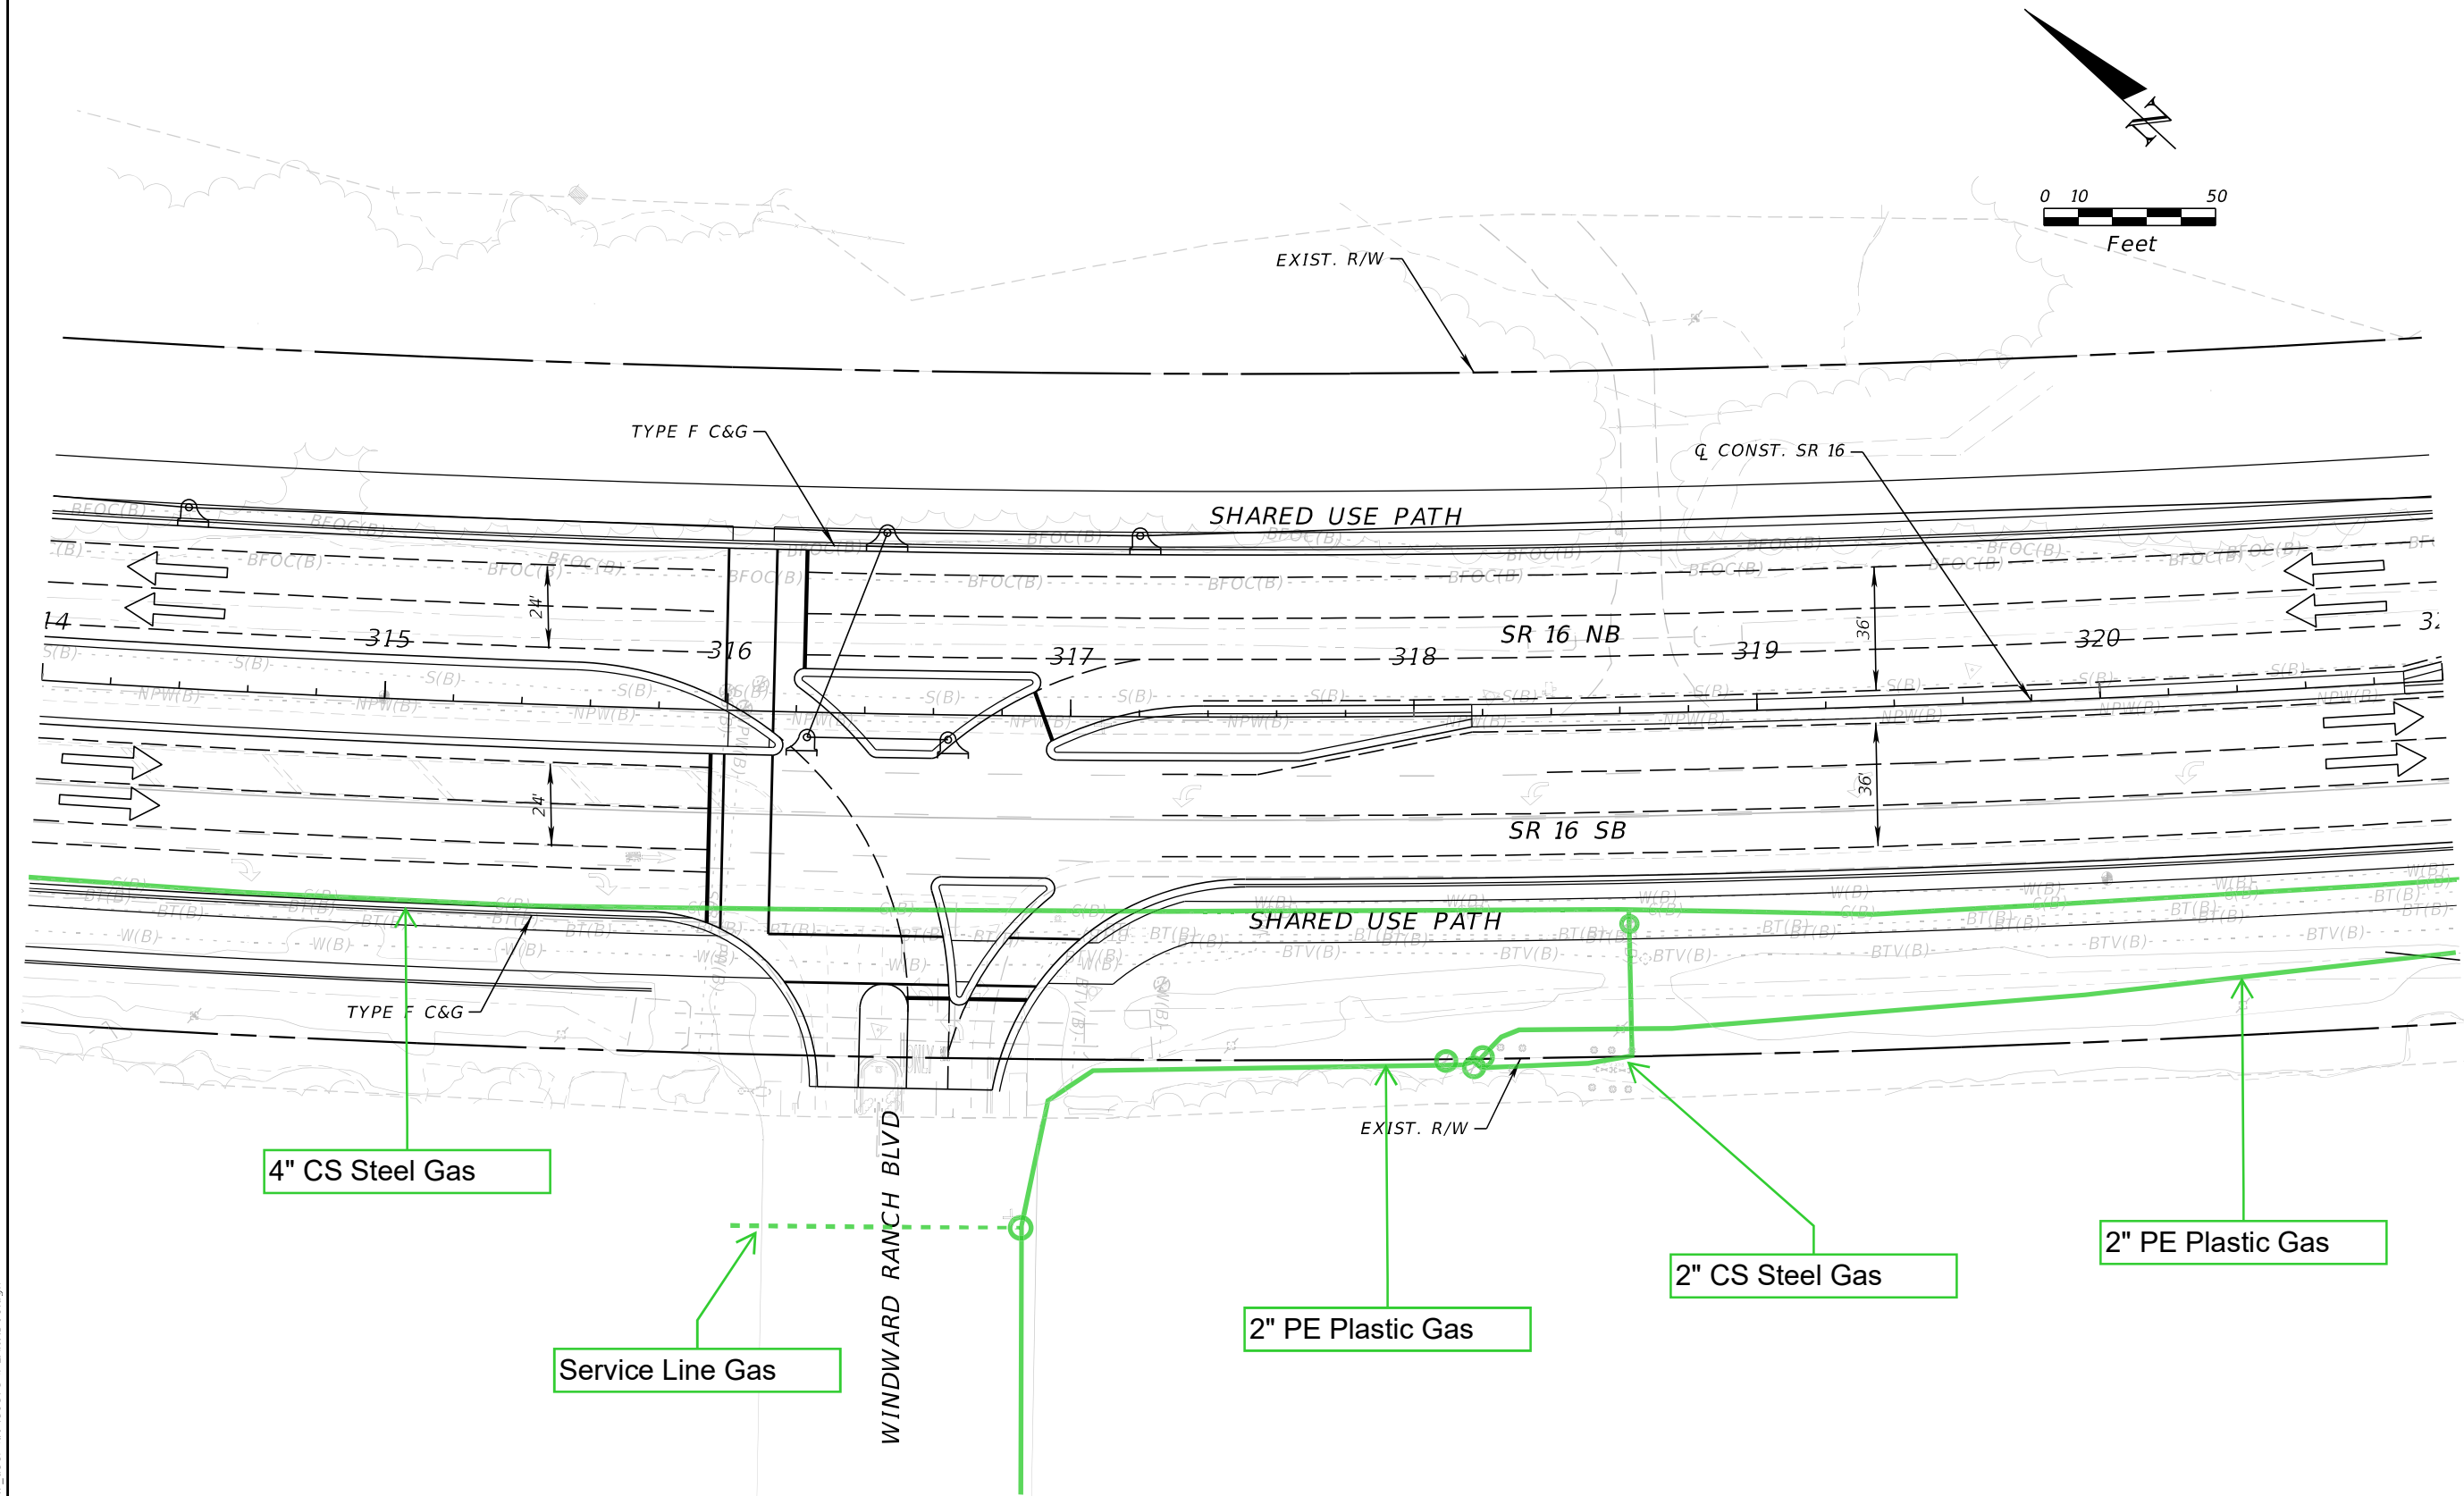

REVISIONS				ENGINEER OF RECORD	STATE OF FLORIDA DEPARTMENT OF TRANSPORTATION			SHEET NO.
DATE	DESCRIPTION	DATE	DESCRIPTION		ROAD NO.	COUNTY	FINANCIAL PROJECT ID	
				STEPHEN J. PARK, P.E. LICENSE NUMBER: 77656 RS&H, INC. 10748 DEERWOOD PARK BLVD. SOUTH JACKSONVILLE, FL 32256	SR 16	ST. JOHNS	210447-5-52-01	11x17 Plan Only

THE OFFICIAL RECORD OF THIS SHEET IS THE ELECTRONIC FILE DIGITALLY SIGNED AND SEALED UNDER RULE 61G15-23.004, F.A.C.

CURVE DATA  
PI STA. = 321+12.24  
Δ = 19°20'48" (LT)  
D = 01°00'19"  
T = 971.59  
L = 1,924.68  
R = 1,924.68  
PC STA. = 311+40.65  
PT STA. = 330+65.33  
e = 0.000

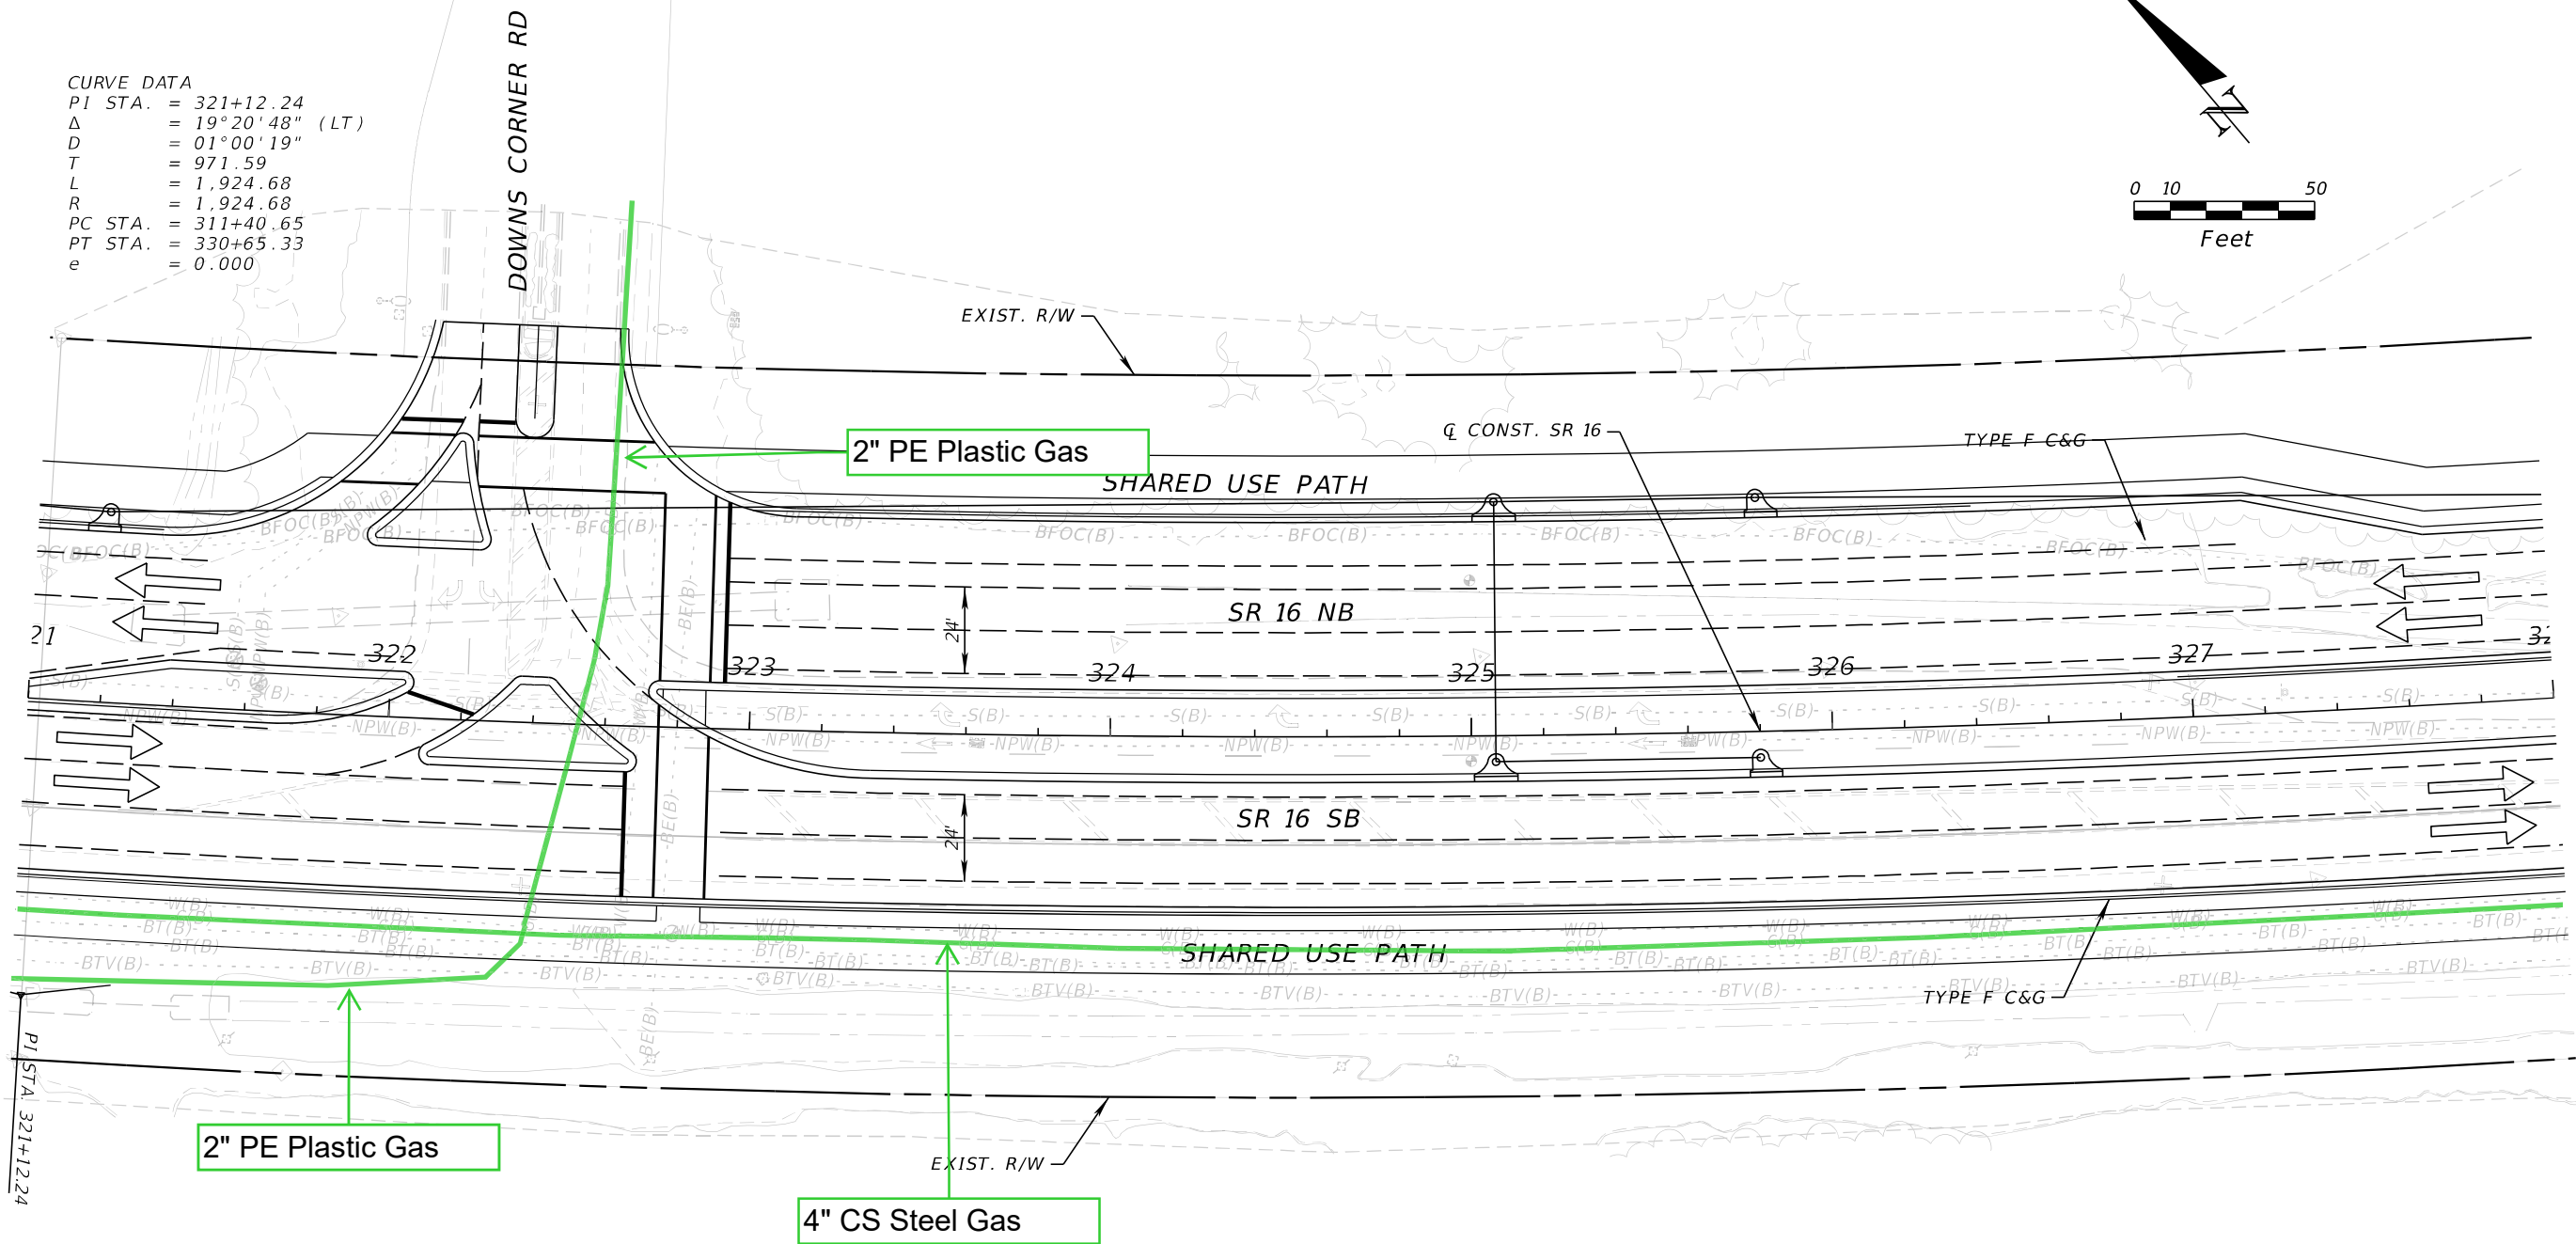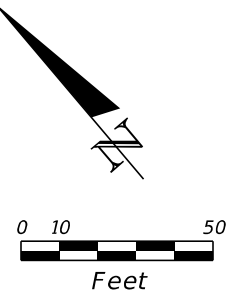


8/5/2024 4:28:58 PM BeattyM  
c:\pw\_work\sh\_pw\pw\_user\0439575\PLANRD01.dgn

REVISIONS				ENGINEER OF RECORD		STATE OF FLORIDA DEPARTMENT OF TRANSPORTATION			SHEET NO.
DATE	DESCRIPTION	DATE	DESCRIPTION	STEPHEN J. PARK, P.E. LICENSE NUMBER: 77656 RS&H, INC. 10748 DEERWOOD PARK BLVD. SOUTH JACKSONVILLE, FL 32256		ROAD NO.	COUNTY	FINANCIAL PROJECT ID	
						SR 16	ST. JOHNS	210447-5-52-01	

11x17  
Plan  
Only

THE OFFICIAL RECORD OF THIS SHEET IS THE ELECTRONIC FILE DIGITALLY SIGNED AND SEALED UNDER RULE 61G15-23.004, F.A.C.


8/5/2024 4:28:59 PM BeattyM  
c:\pw\_work\ysh\_pw\pw\_user\0439575\PLANRD01.dgn

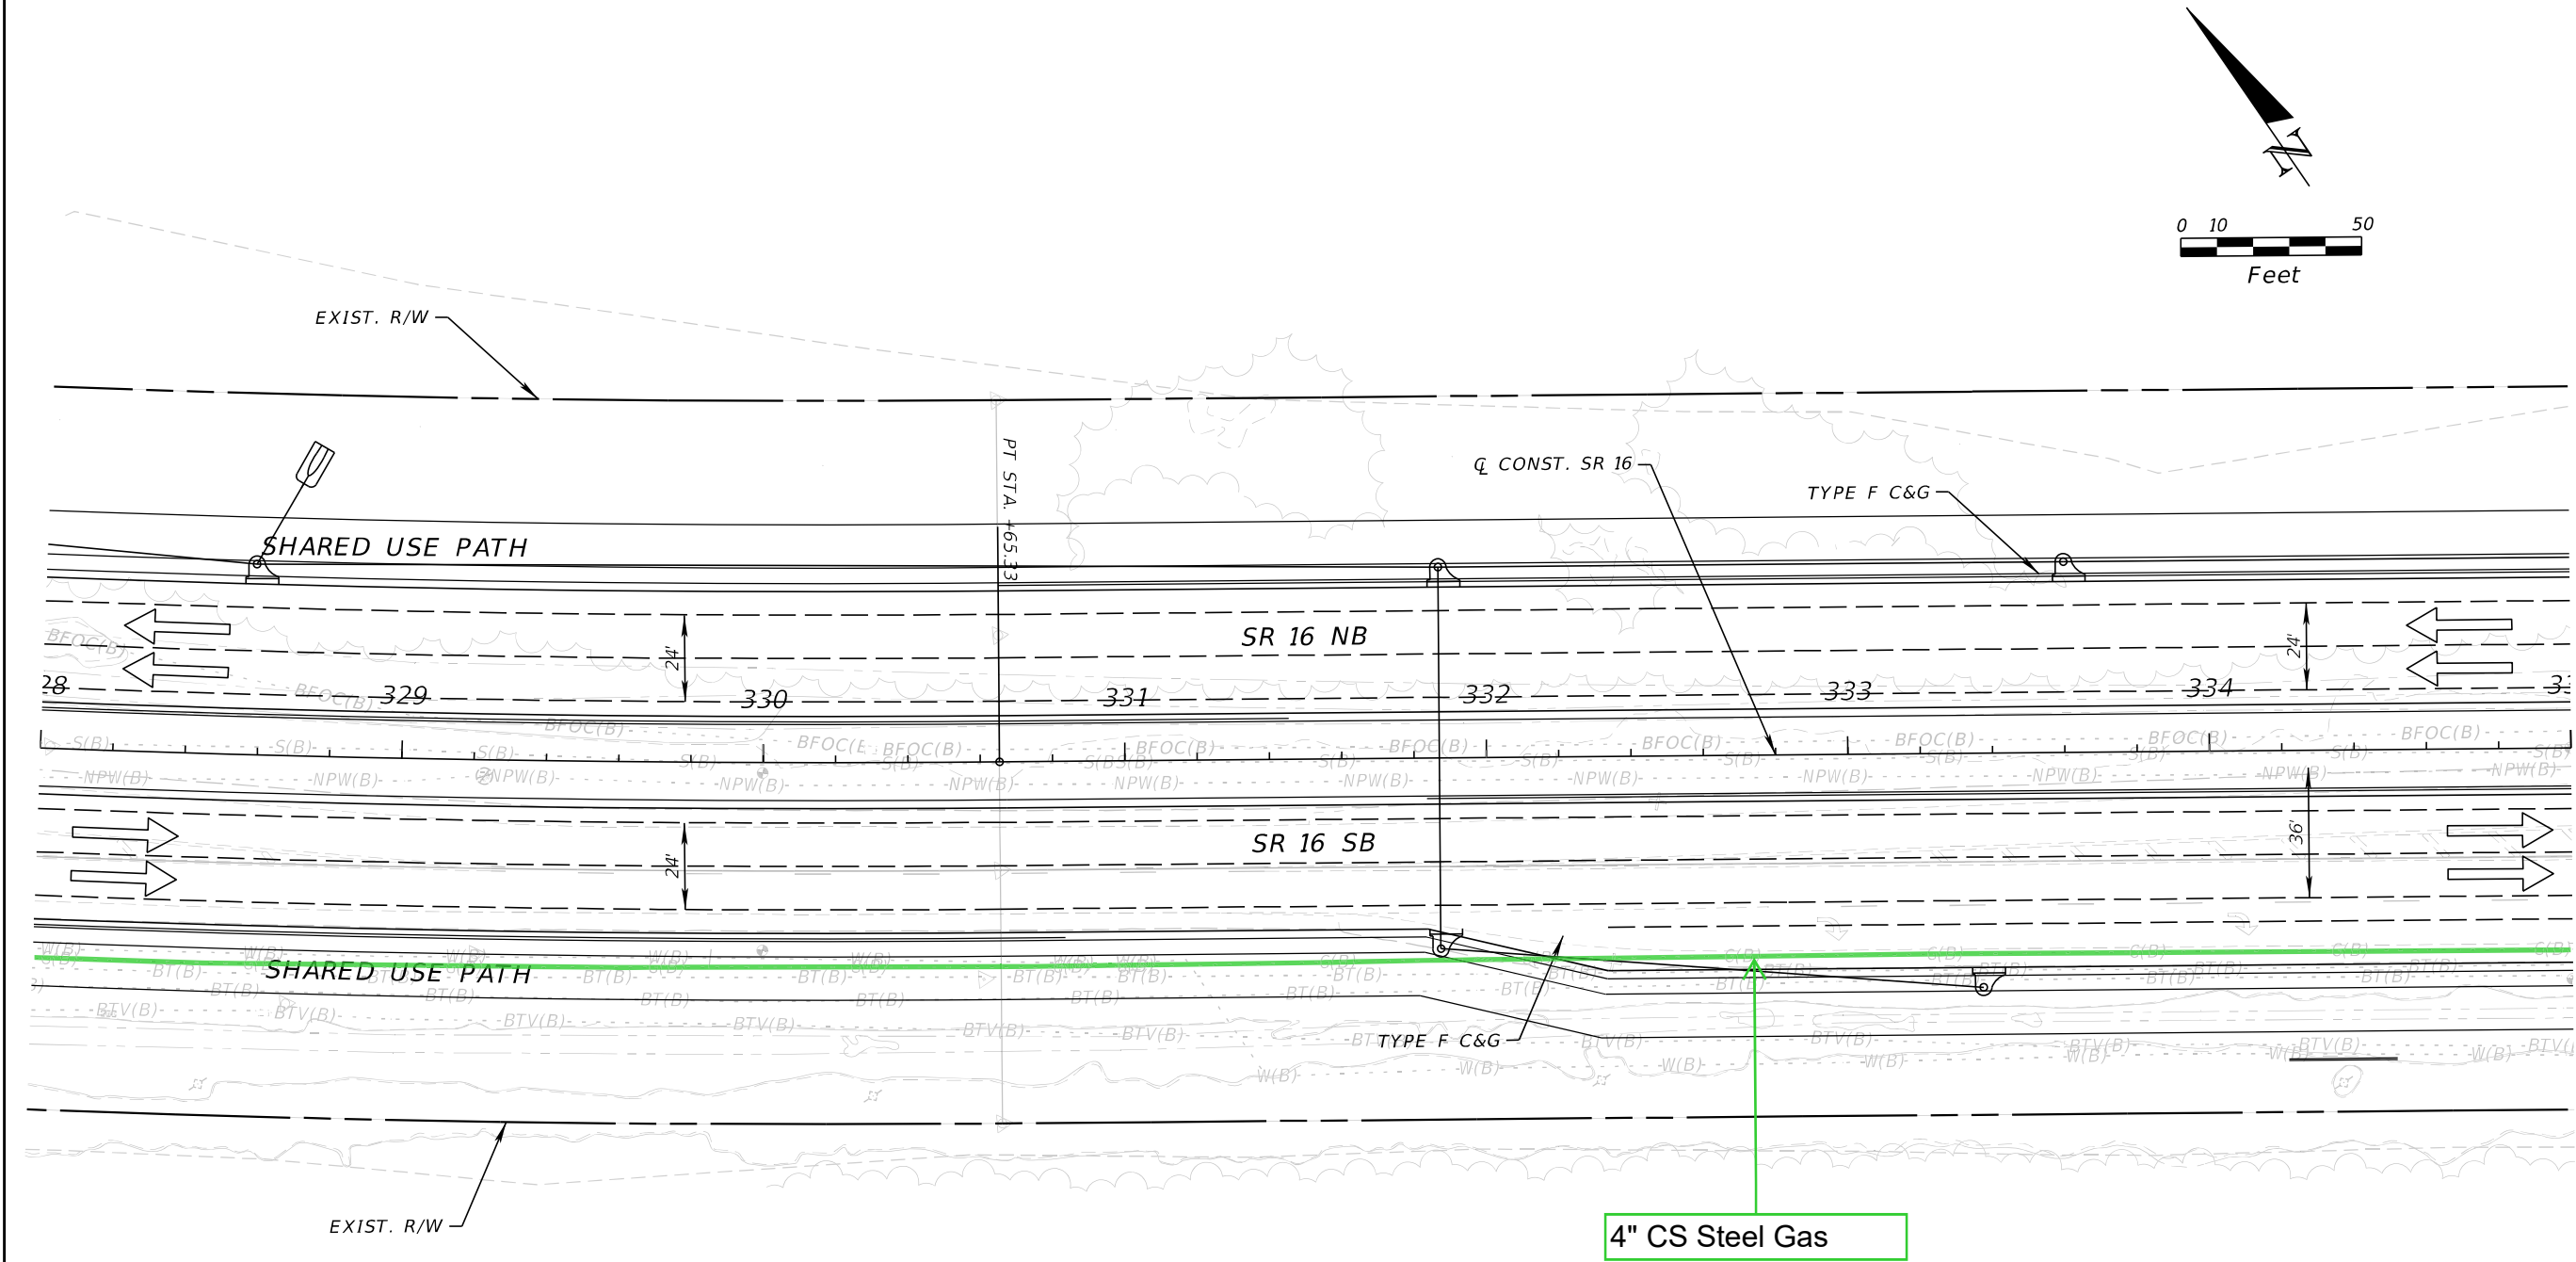

REVISIONS				ENGINEER OF RECORD		STATE OF FLORIDA DEPARTMENT OF TRANSPORTATION			SHEET NO.
DATE	DESCRIPTION	DATE	DESCRIPTION	STEPHEN J. PARK, P.E. LICENSE NUMBER: 77656 RS&H, INC. 10748 DEERWOOD PARK BLVD. SOUTH JACKSONVILLE, FL 32256		ROAD NO.	COUNTY	FINANCIAL PROJECT ID	
						SR 16	ST. JOHNS	210447-5-52-01	

THE OFFICIAL RECORD OF THIS SHEET IS THE ELECTRONIC FILE DIGITALLY SIGNED AND SEALED UNDER RULE 61G15-23.004, F.A.C.

8/5/2024 4:28:59 PM BeattyM  
c:\pw\_work\ysh\_pw\pw\_user\0439575\PLAINRD01.dgn

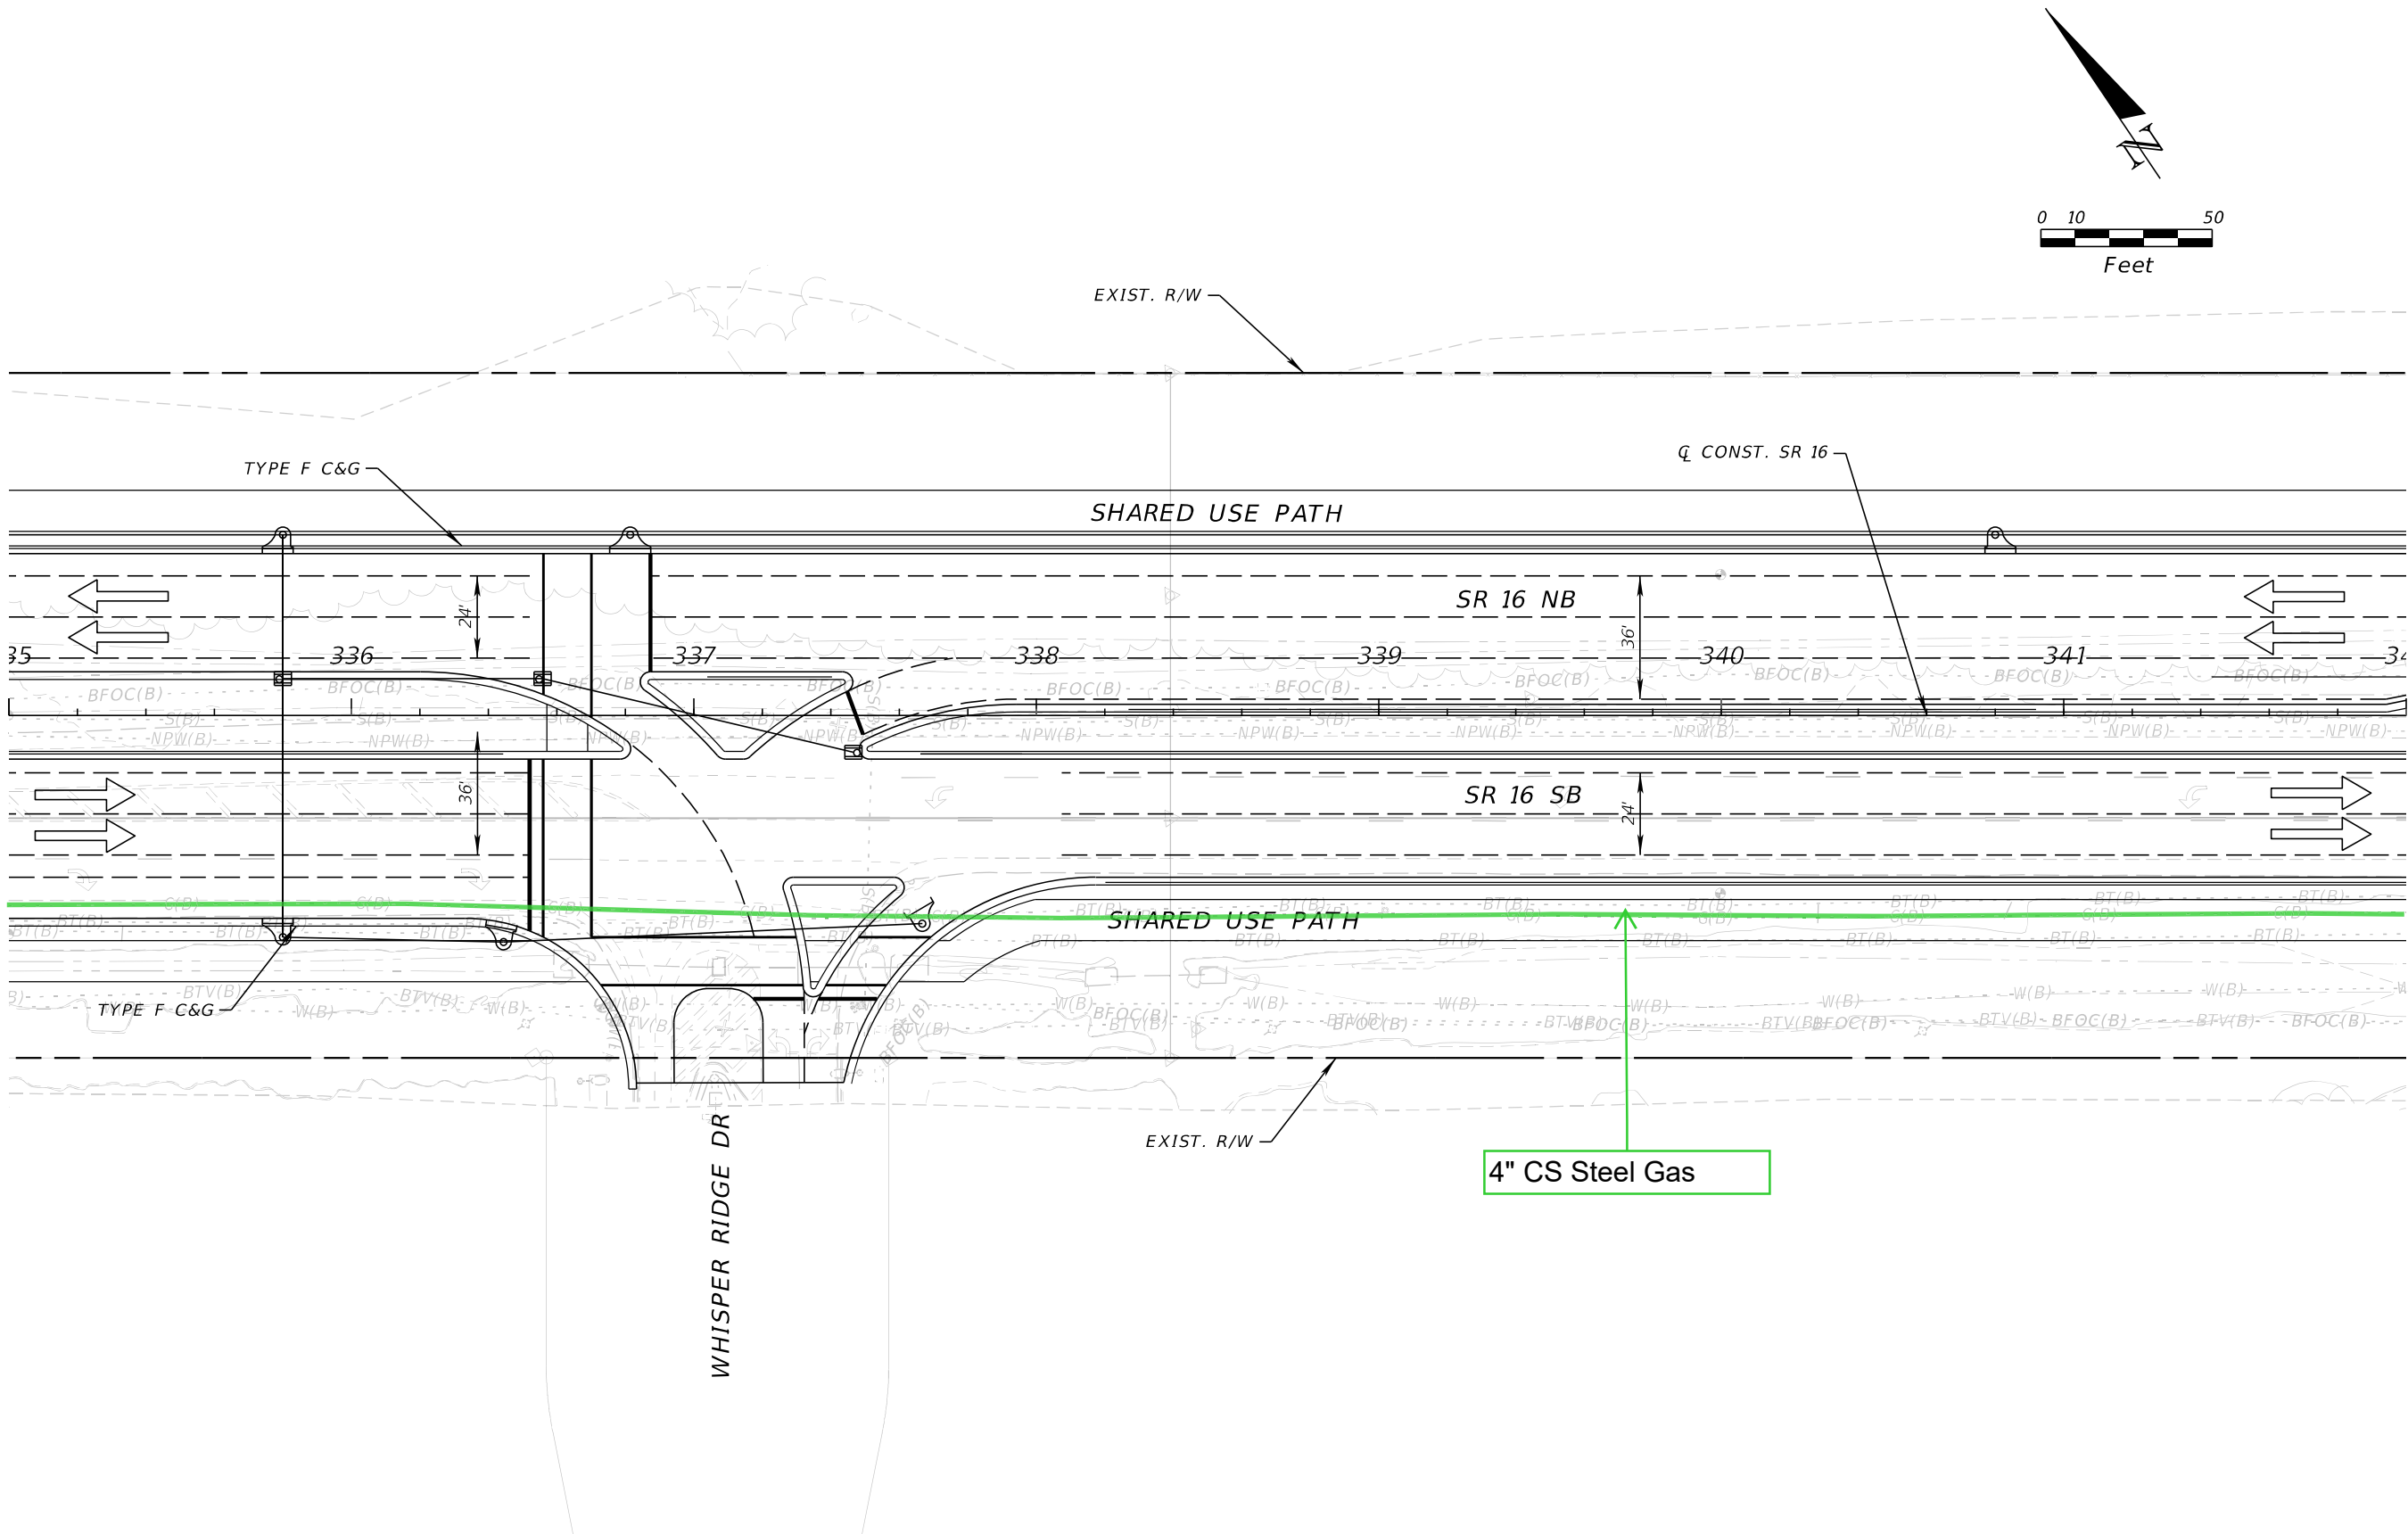


REVISIONS				ENGINEER OF RECORD	STATE OF FLORIDA DEPARTMENT OF TRANSPORTATION			SHEET NO.
DATE	DESCRIPTION	DATE	DESCRIPTION		ROAD NO.	COUNTY	FINANCIAL PROJECT ID	
					SR 16	ST. JOHNS	210447-5-52-01	

STEPHEN J. PARK, P.E.  
LICENSE NUMBER: 77656  
RS&H, INC.  
10748 DEERWOOD PARK BLVD. SOUTH  
JACKSONVILLE, FL 32256

11x17  
Plan  
Only

THE OFFICIAL RECORD OF THIS SHEET IS THE ELECTRONIC FILE DIGITALLY SIGNED AND SEALED UNDER RULE 61G15-23.004, F.A.C.

8/5/2024 4:29:00 PM BeattyM  
c:\pw\_work\sh\_pw\pw\_user\0439575\PLANRD01.dgn


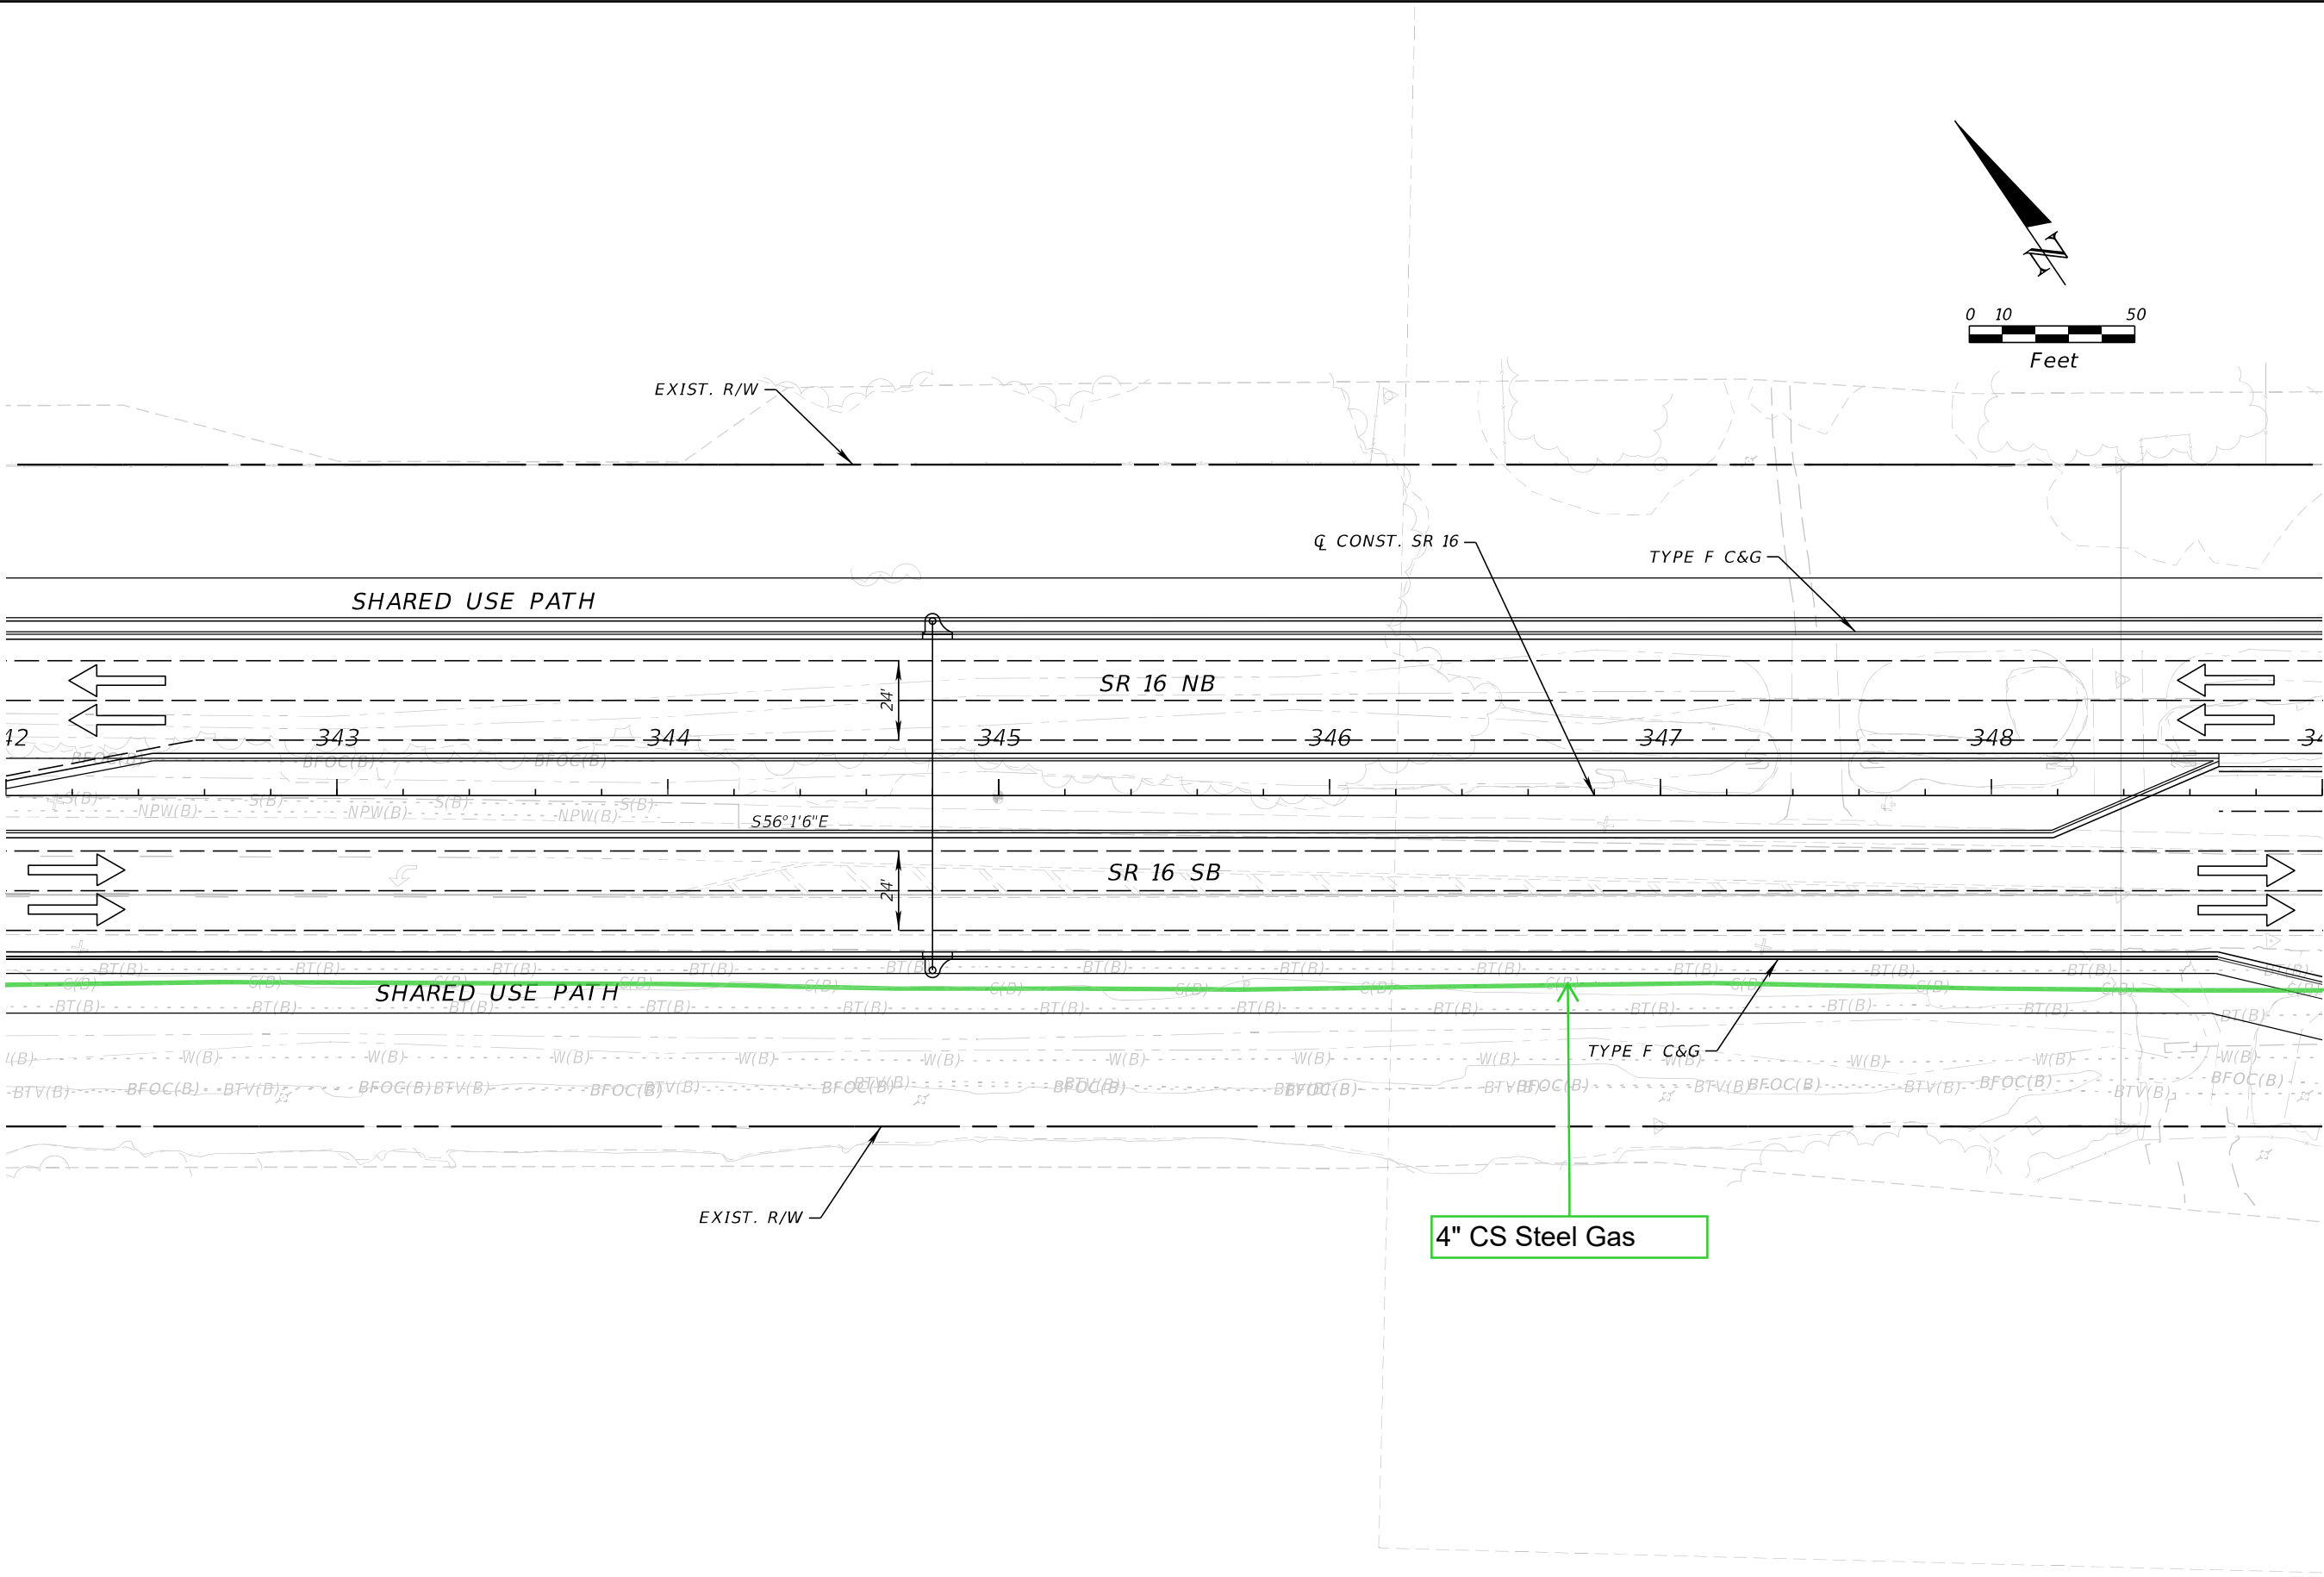


REVISIONS				ENGINEER OF RECORD		STATE OF FLORIDA DEPARTMENT OF TRANSPORTATION			SHEET NO.
DATE	DESCRIPTION	DATE	DESCRIPTION	STEPHEN J. PARK, P.E. LICENSE NUMBER: 77656 RS&H, INC. 10748 DEERWOOD PARK BLVD. SOUTH JACKSONVILLE, FL 32256		ROAD NO.	COUNTY	FINANCIAL PROJECT ID	
						SR 16	ST. JOHNS	210447-5-52-01	

THE OFFICIAL RECORD OF THIS SHEET IS THE ELECTRONIC FILE DIGITALLY SIGNED AND SEALED UNDER RULE 61G15-23.004, F.A.C.



TADPOLE PREP

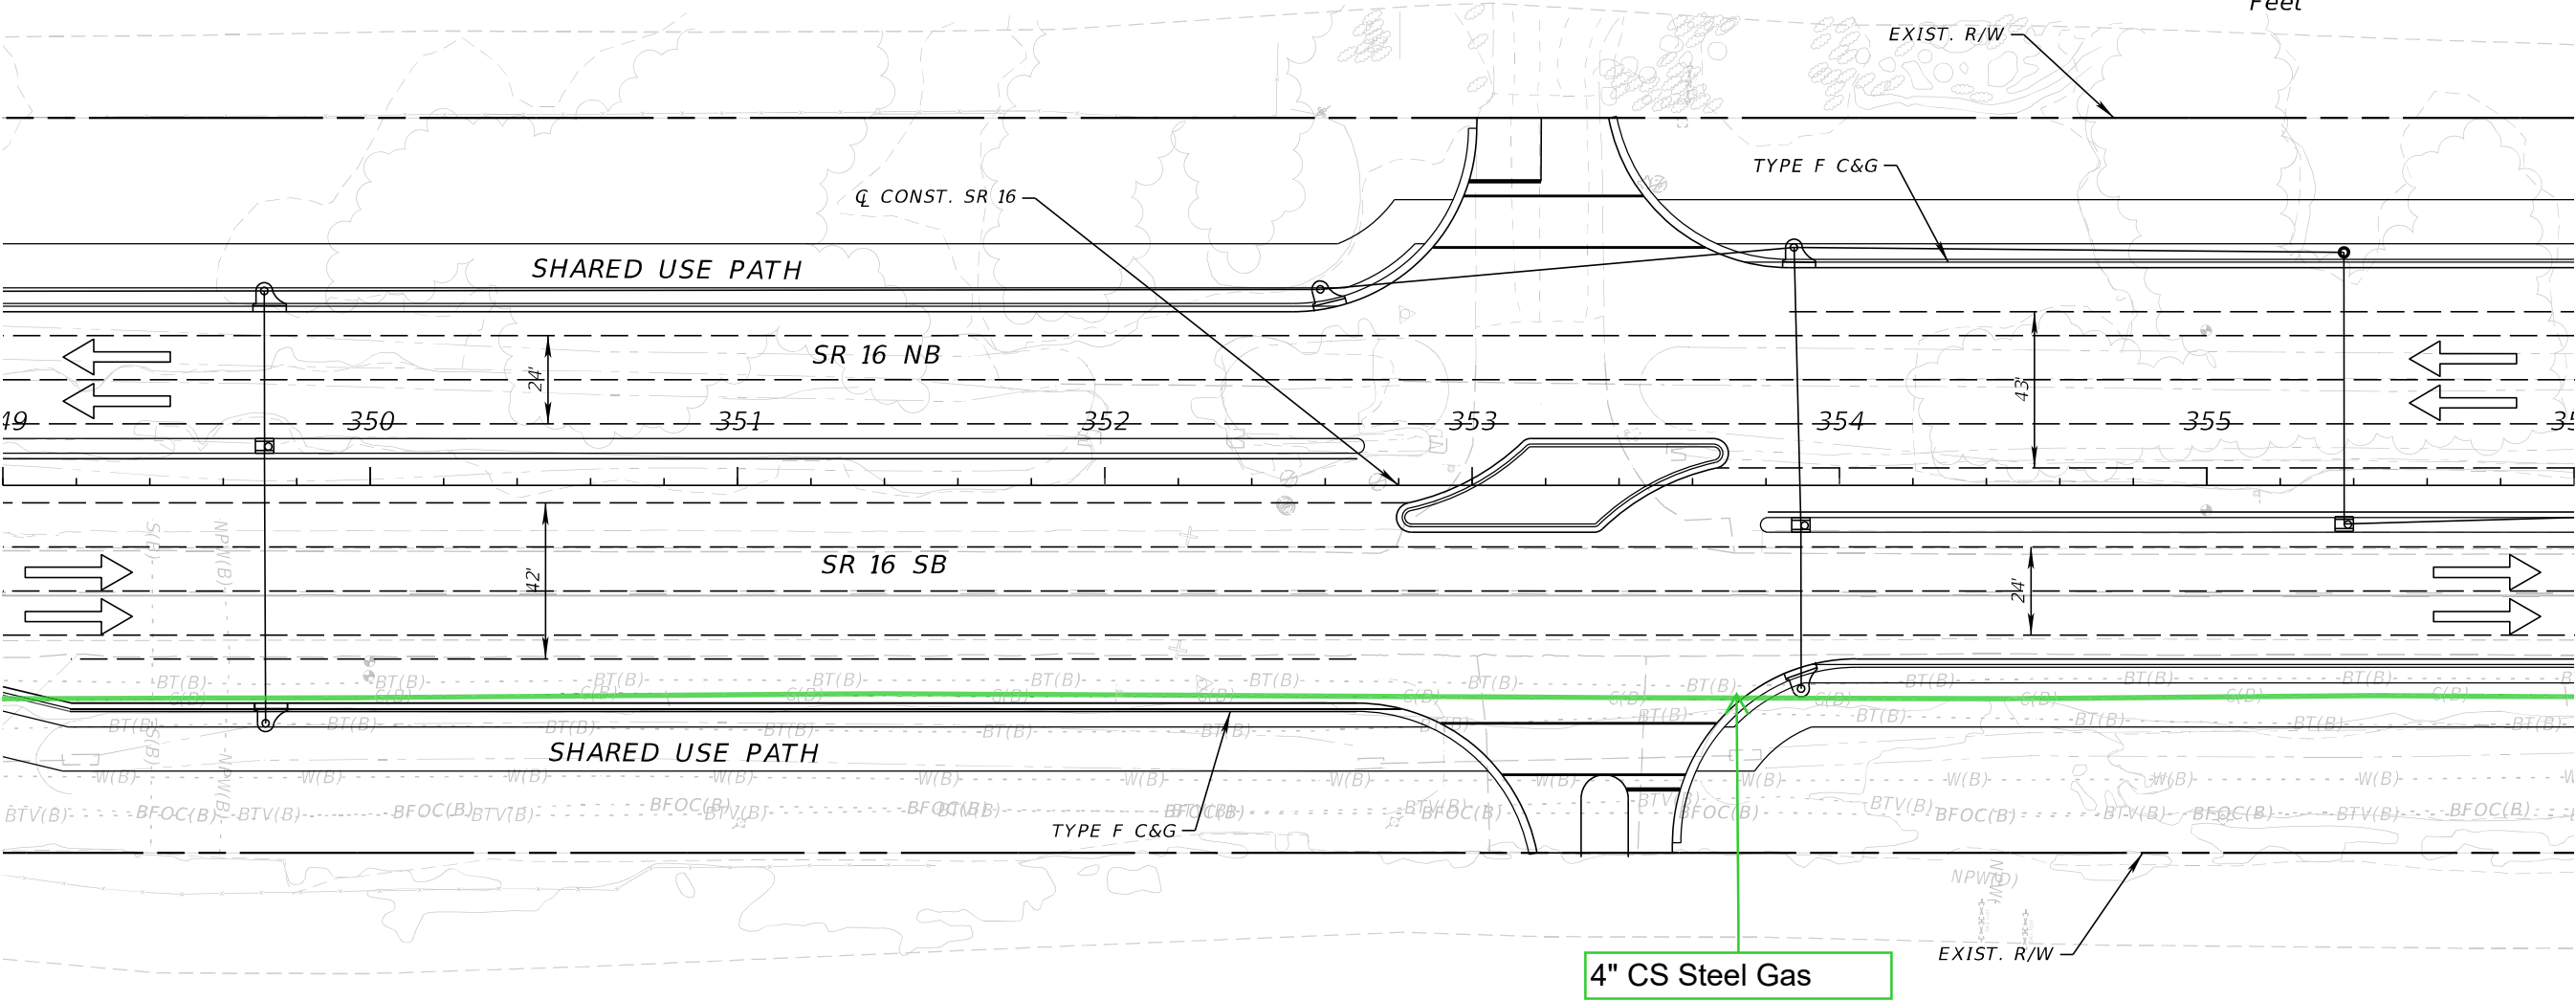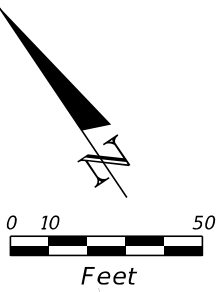



SOLUNA (UNDER CONSTRUCTION)

8/5/2024 4:29:01 PM BeattyM  
c:\pw\_work\sh\_pw\pw\_user\0439575\PLANRD01.dgn

REVISIONS				ENGINEER OF RECORD	STATE OF FLORIDA DEPARTMENT OF TRANSPORTATION			SHEET NO.
DATE	DESCRIPTION	DATE	DESCRIPTION	STEPHEN J. PARK, P.E. LICENSE NUMBER: 77656 RS&H, INC. 10748 DEERWOOD PARK BLVD. SOUTH JACKSONVILLE, FL 32256	ROAD NO.	COUNTY	FINANCIAL PROJECT ID	
					SR 16	ST. JOHNS	210447-5-52-01	
								11x17 Plan Only

THE OFFICIAL RECORD OF THIS SHEET IS THE ELECTRONIC FILE DIGITALLY SIGNED AND SEALED UNDER RULE 61G15-23.004, F.A.C.

KINGDOM HALL OF  
JEHOVA'S WITNESSES

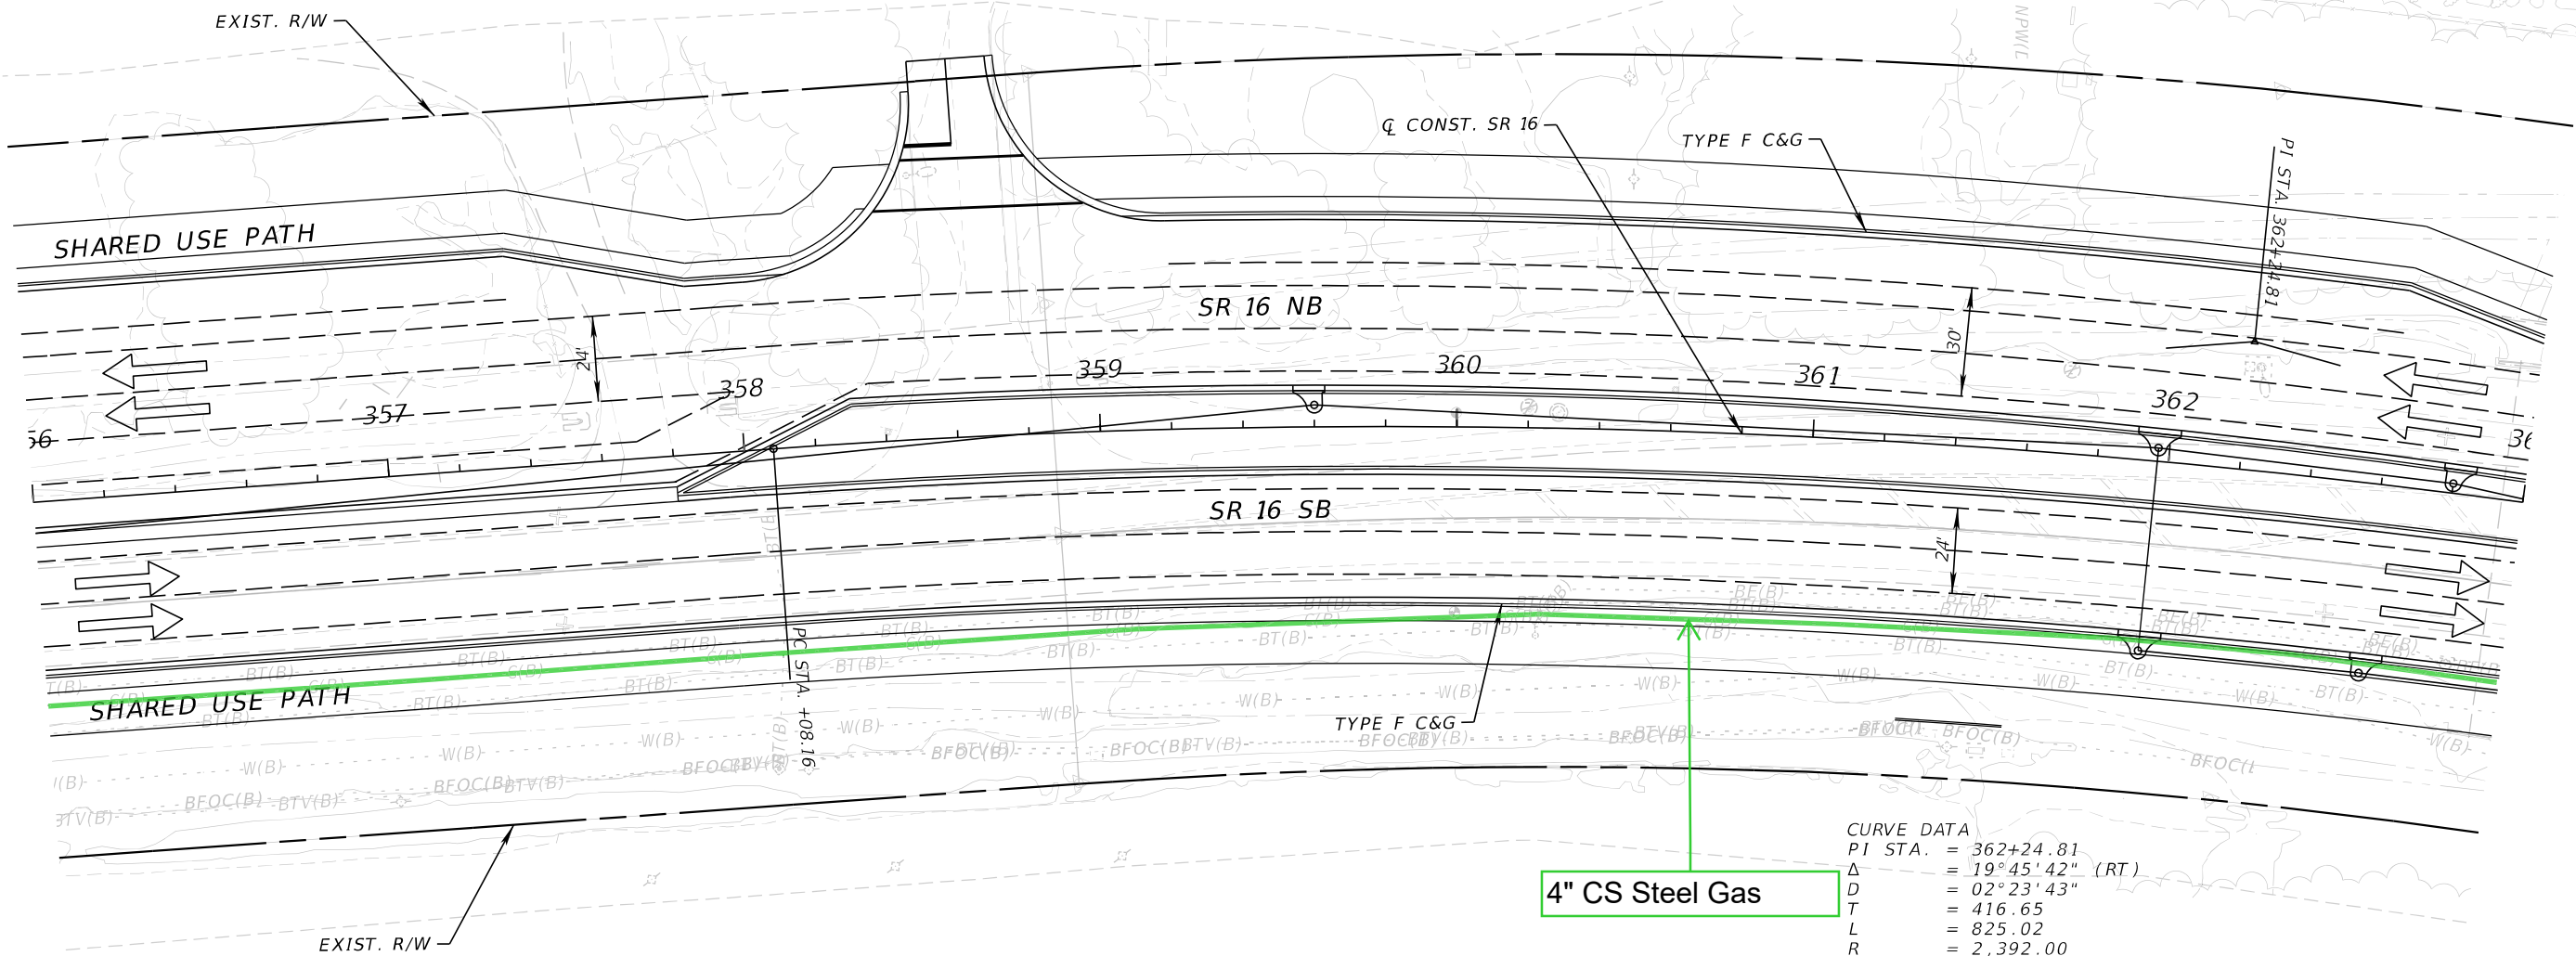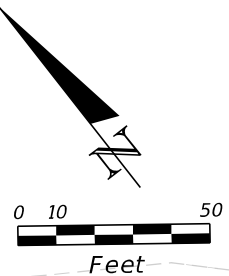



CURVE DATA	
PI STA.	= 362+24.81
Δ	= 19°45'42" (RT)
D	= 02°23'43"
T	= 416.65
L	= 825.02
R	= 2,392.00
PC STA.	= 358+08.16
PT STA.	= 366+33.18
e	= 0.000

8/5/2024 4:29:01 PM BeattyM  
c:\pw\_work\ysh\_pw\pw\_user\0439575\PLANRD01.dgn

REVISIONS				ENGINEER OF RECORD		STATE OF FLORIDA DEPARTMENT OF TRANSPORTATION			SHEET NO.
DATE	DESCRIPTION	DATE	DESCRIPTION	STEPHEN J. PARK, P.E. LICENSE NUMBER: 77656 RS&H, INC. 10748 DEERWOOD PARK BLVD. SOUTH JACKSONVILLE, FL 32256		ROAD NO.	COUNTY	FINANCIAL PROJECT ID	
						SR 16	ST. JOHNS	210447-5-52-01	

THE OFFICIAL RECORD OF THIS SHEET IS THE ELECTRONIC FILE DIGITALLY SIGNED AND SEALED UNDER RULE 61G15-23.004, F.A.C.

ATLANTIC SELF STORAGE

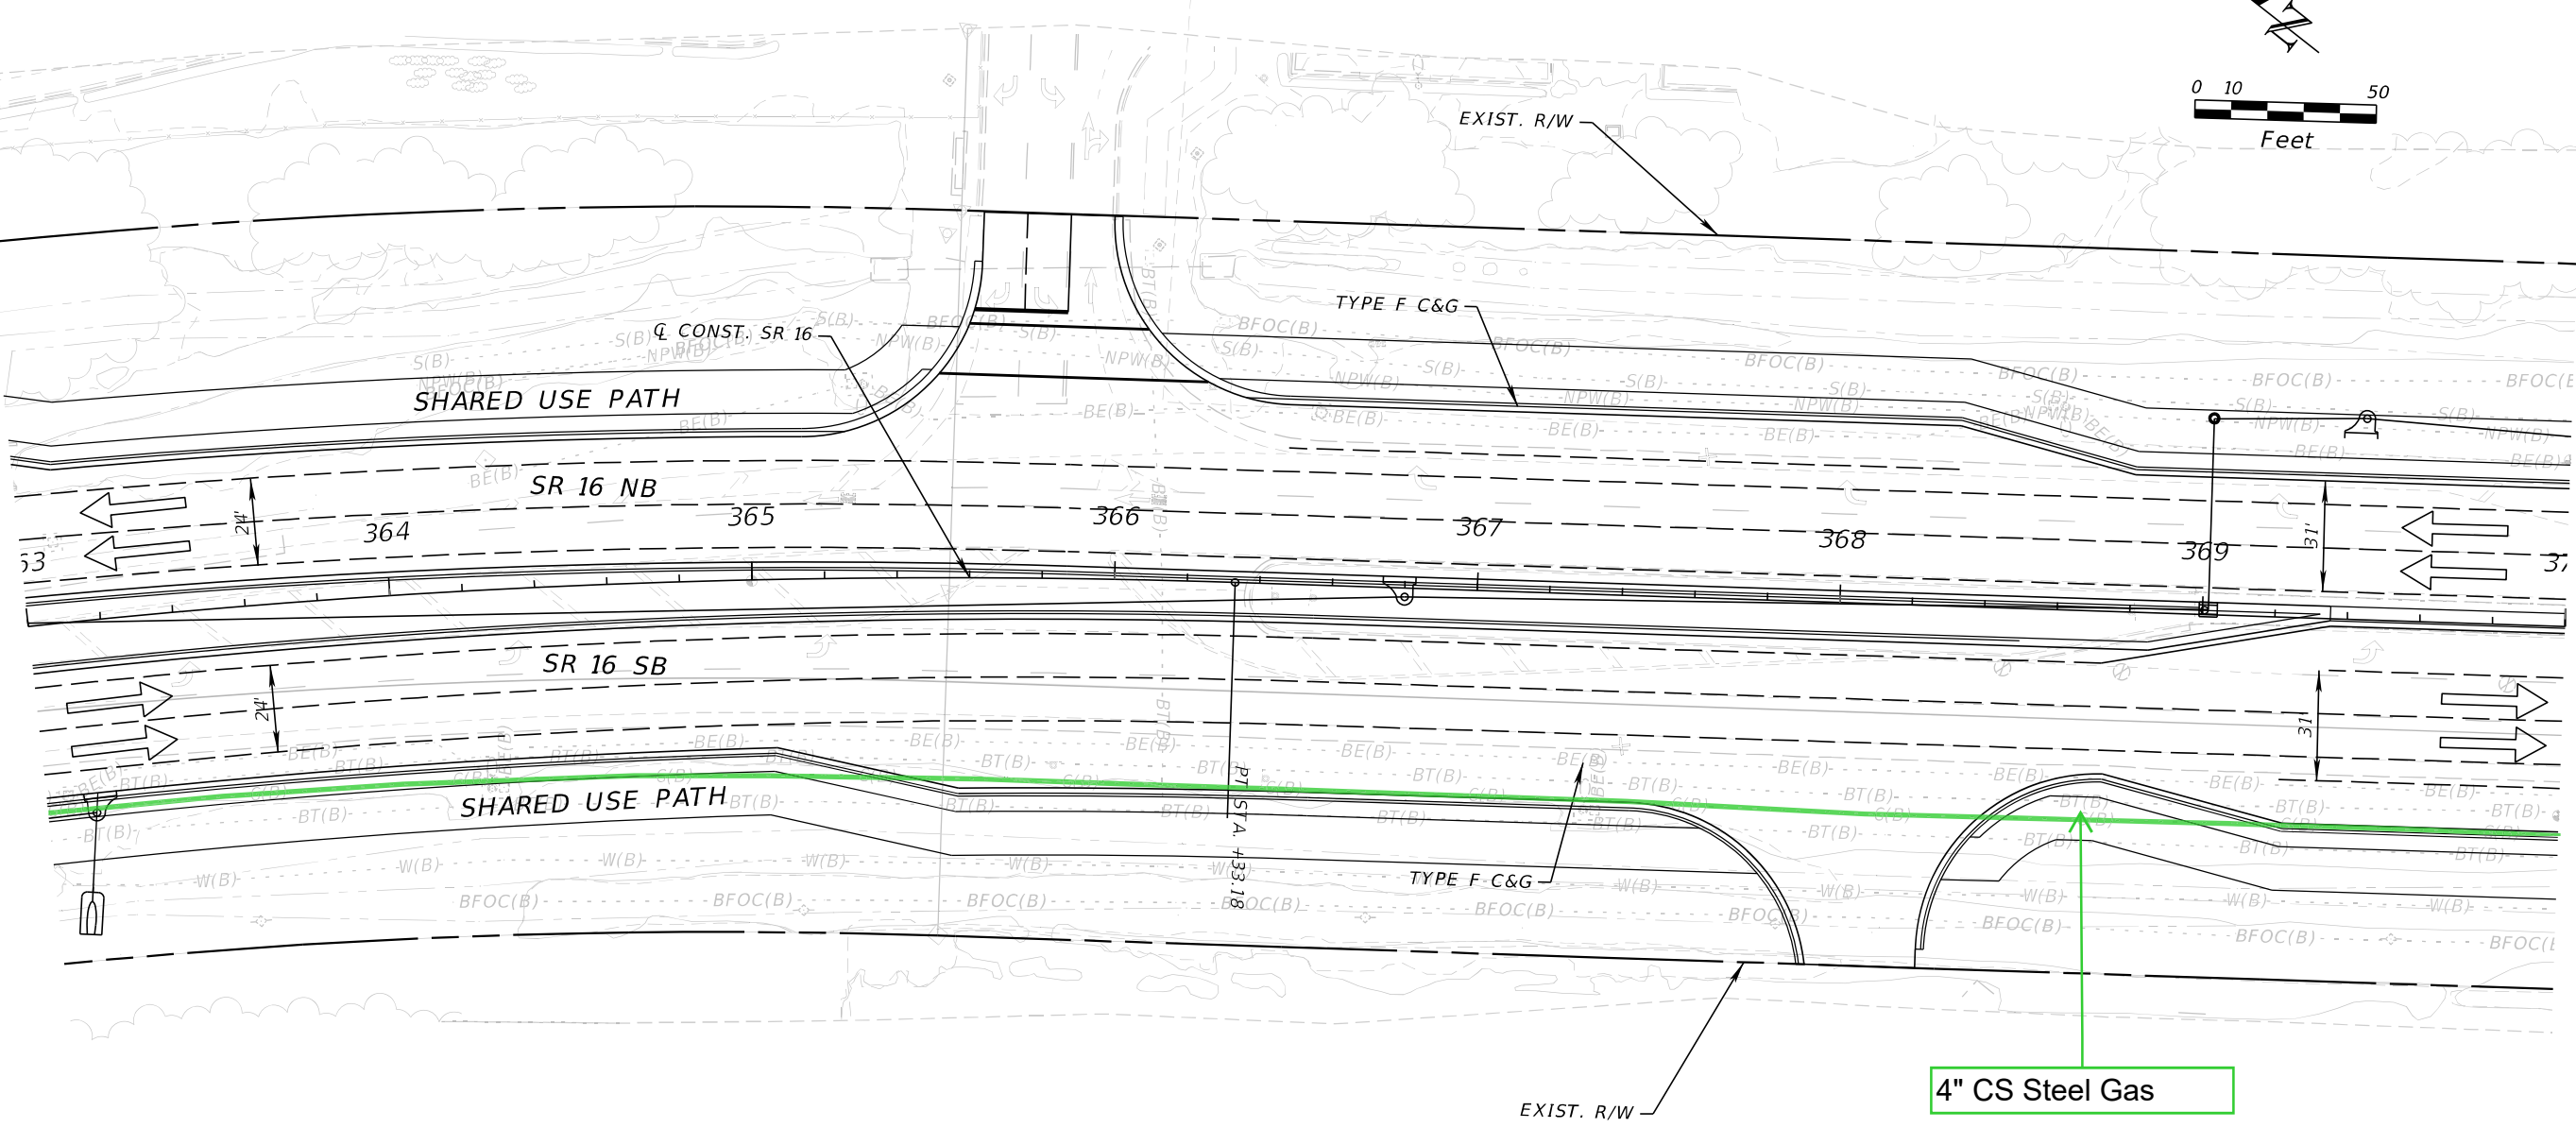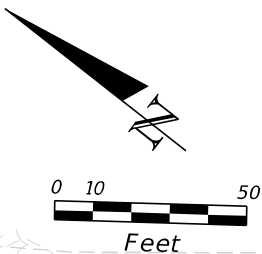


8/5/2024 4:29:02 PM BeattyM  
c:\pw\_work\ysh\_pw\pw\_user\0439575\PLANRD01.dgn

REVISIONS				ENGINEER OF RECORD		STATE OF FLORIDA DEPARTMENT OF TRANSPORTATION			SHEET NO.
DATE	DESCRIPTION	DATE	DESCRIPTION	STEPHEN J. PARK, P.E. LICENSE NUMBER: 77656 RS&H, INC. 10748 DEERWOOD PARK BLVD. SOUTH JACKSONVILLE, FL 32256		ROAD NO.	COUNTY	FINANCIAL PROJECT ID	
						SR 16	ST. JOHNS	210447-5-52-01	

THE OFFICIAL RECORD OF THIS SHEET IS THE ELECTRONIC FILE DIGITALLY SIGNED AND SEALED UNDER RULE 61G15-23.004, F.A.C.


8/5/2024 4:29:03 PM BeattyM  
c:\pw\_work\ysh\_pw\pw\_user\0439575\PLANRD01.dgn

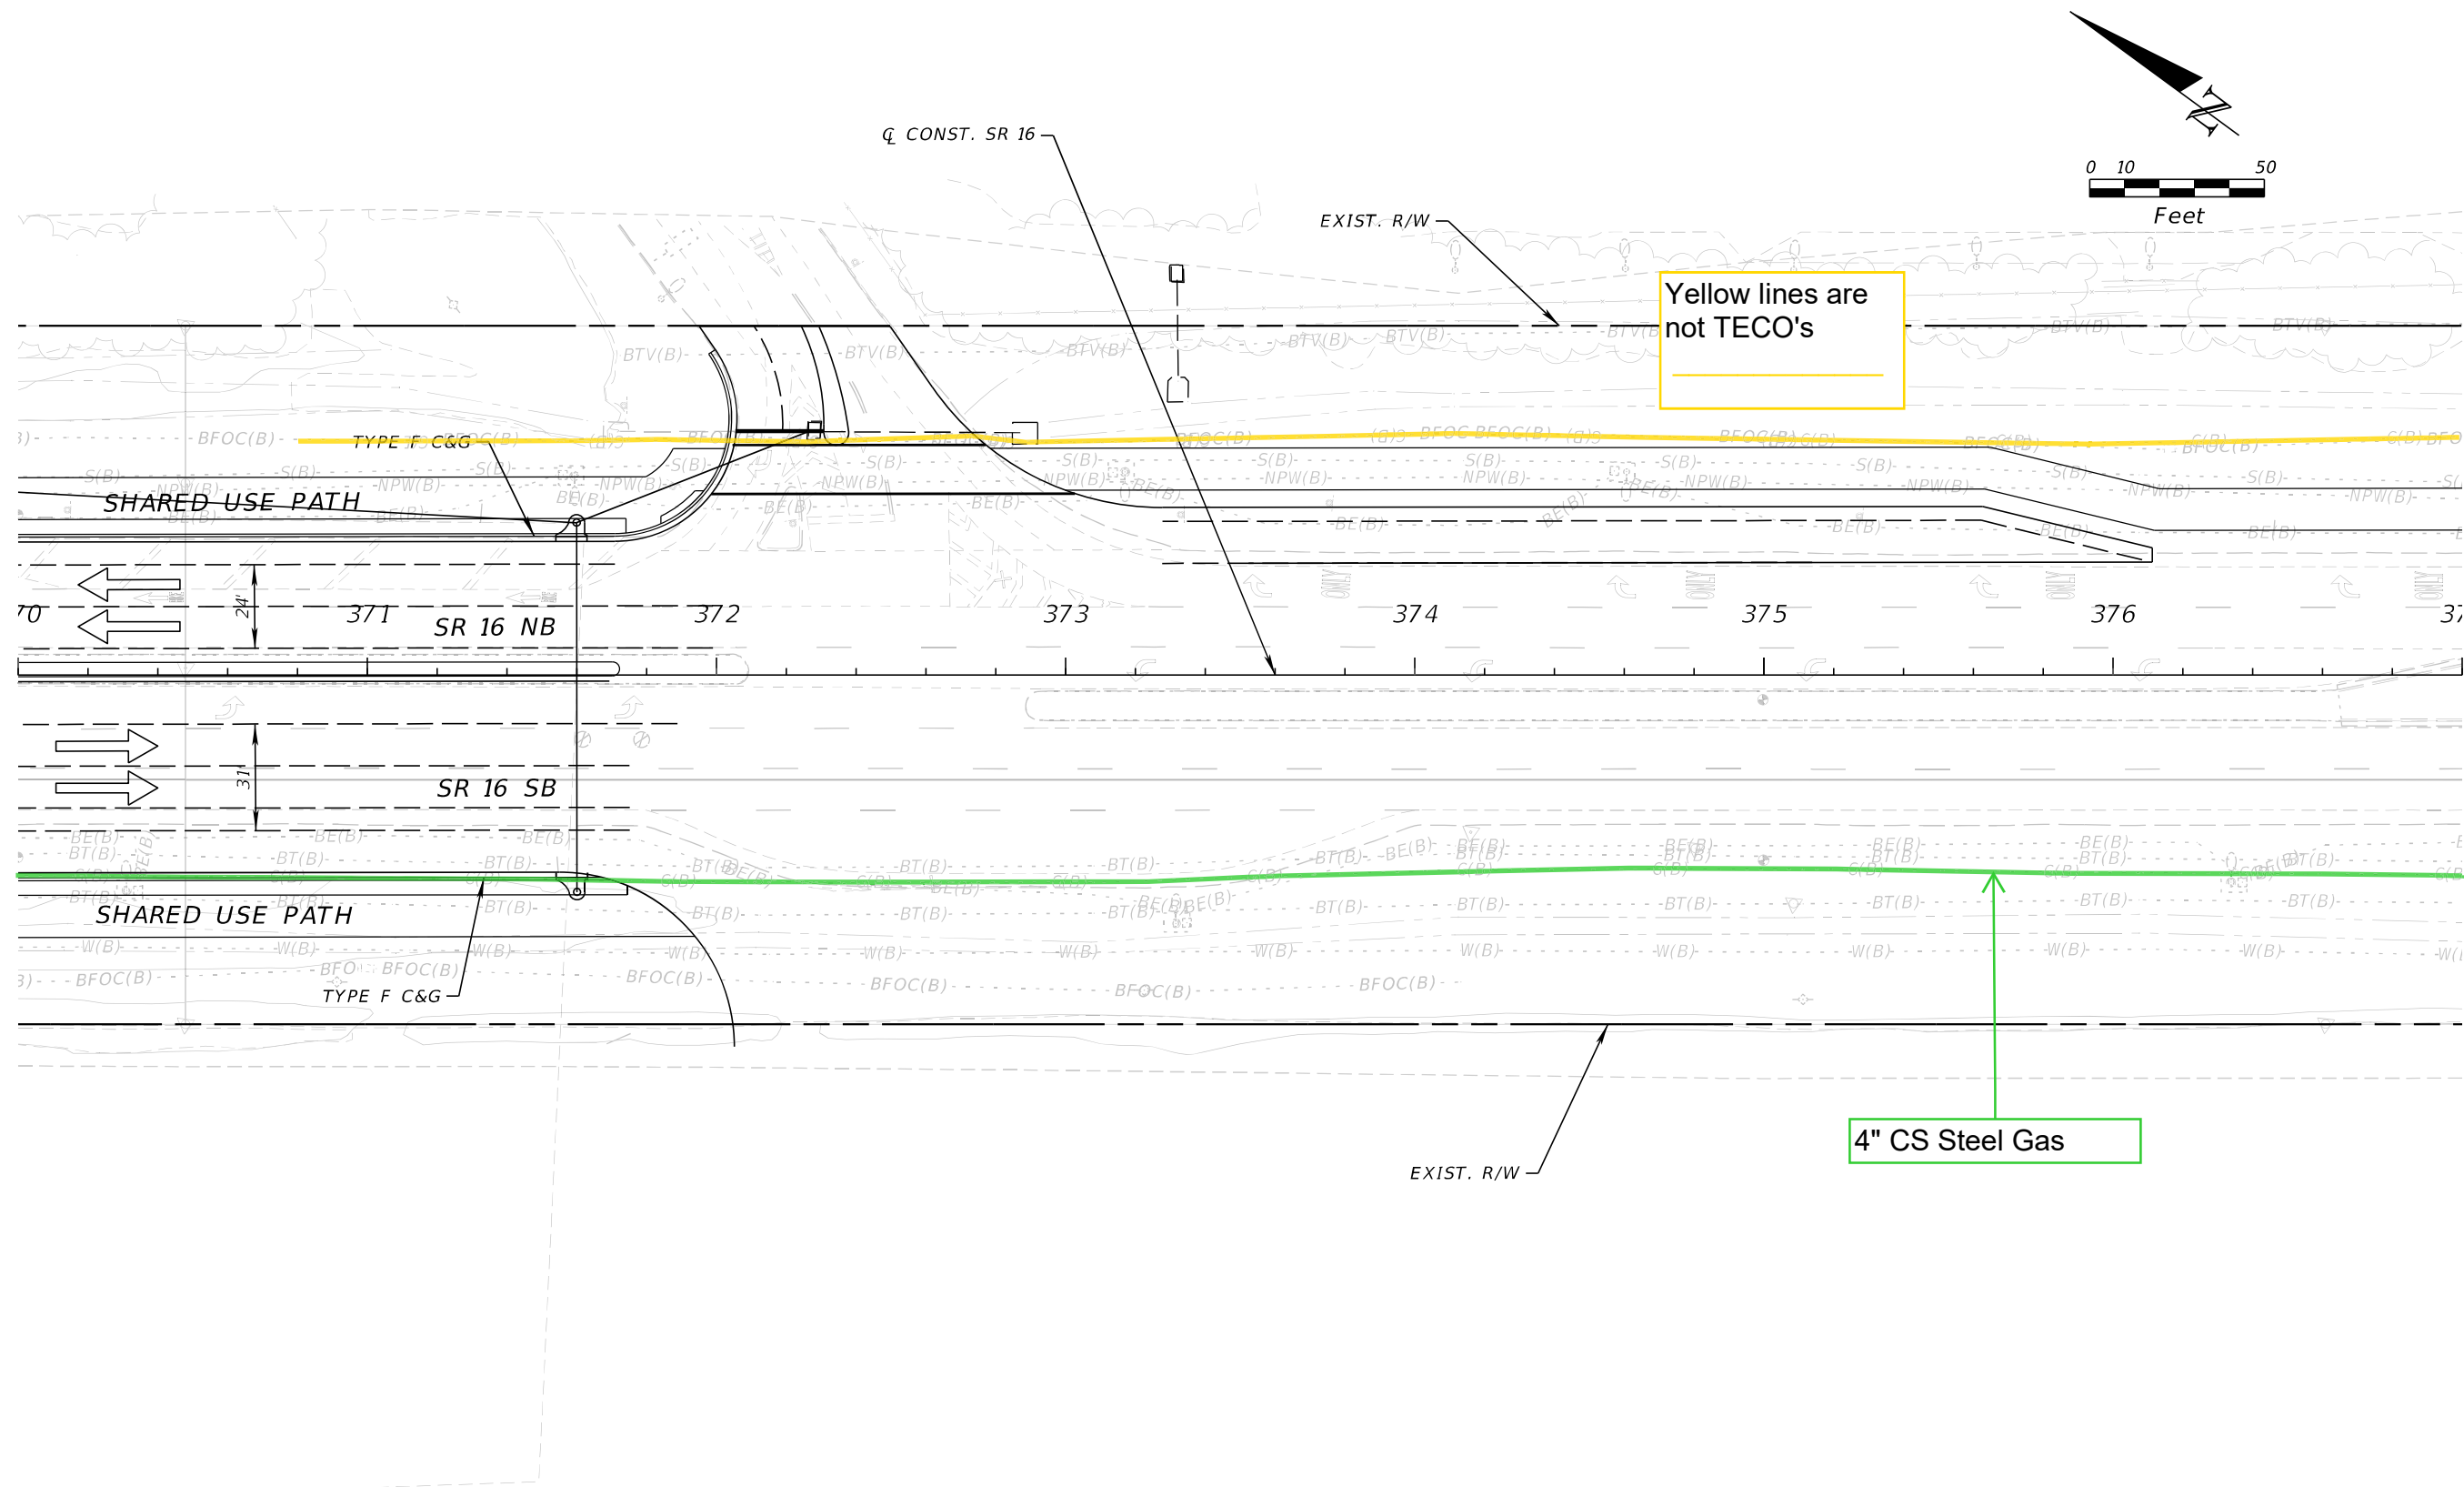

REVISIONS				ENGINEER OF RECORD		STATE OF FLORIDA DEPARTMENT OF TRANSPORTATION			SHEET NO.
DATE	DESCRIPTION	DATE	DESCRIPTION	STEPHEN J. PARK, P.E. LICENSE NUMBER: 77656 RS&H, INC. 10748 DEERWOOD PARK BLVD. SOUTH JACKSONVILLE, FL 32256		ROAD NO.	COUNTY	FINANCIAL PROJECT ID	
						SR 16	ST. JOHNS	210447-5-52-01	

THE OFFICIAL RECORD OF THIS SHEET IS THE ELECTRONIC FILE DIGITALLY SIGNED AND SEALED UNDER RULE 61G15-23.004, F.A.C.

8/5/2024 4:29:03 PM BeattyM  
c:\pw\_work\ysh\_pw\pw\_user\00439575\PLANRD01.dgn


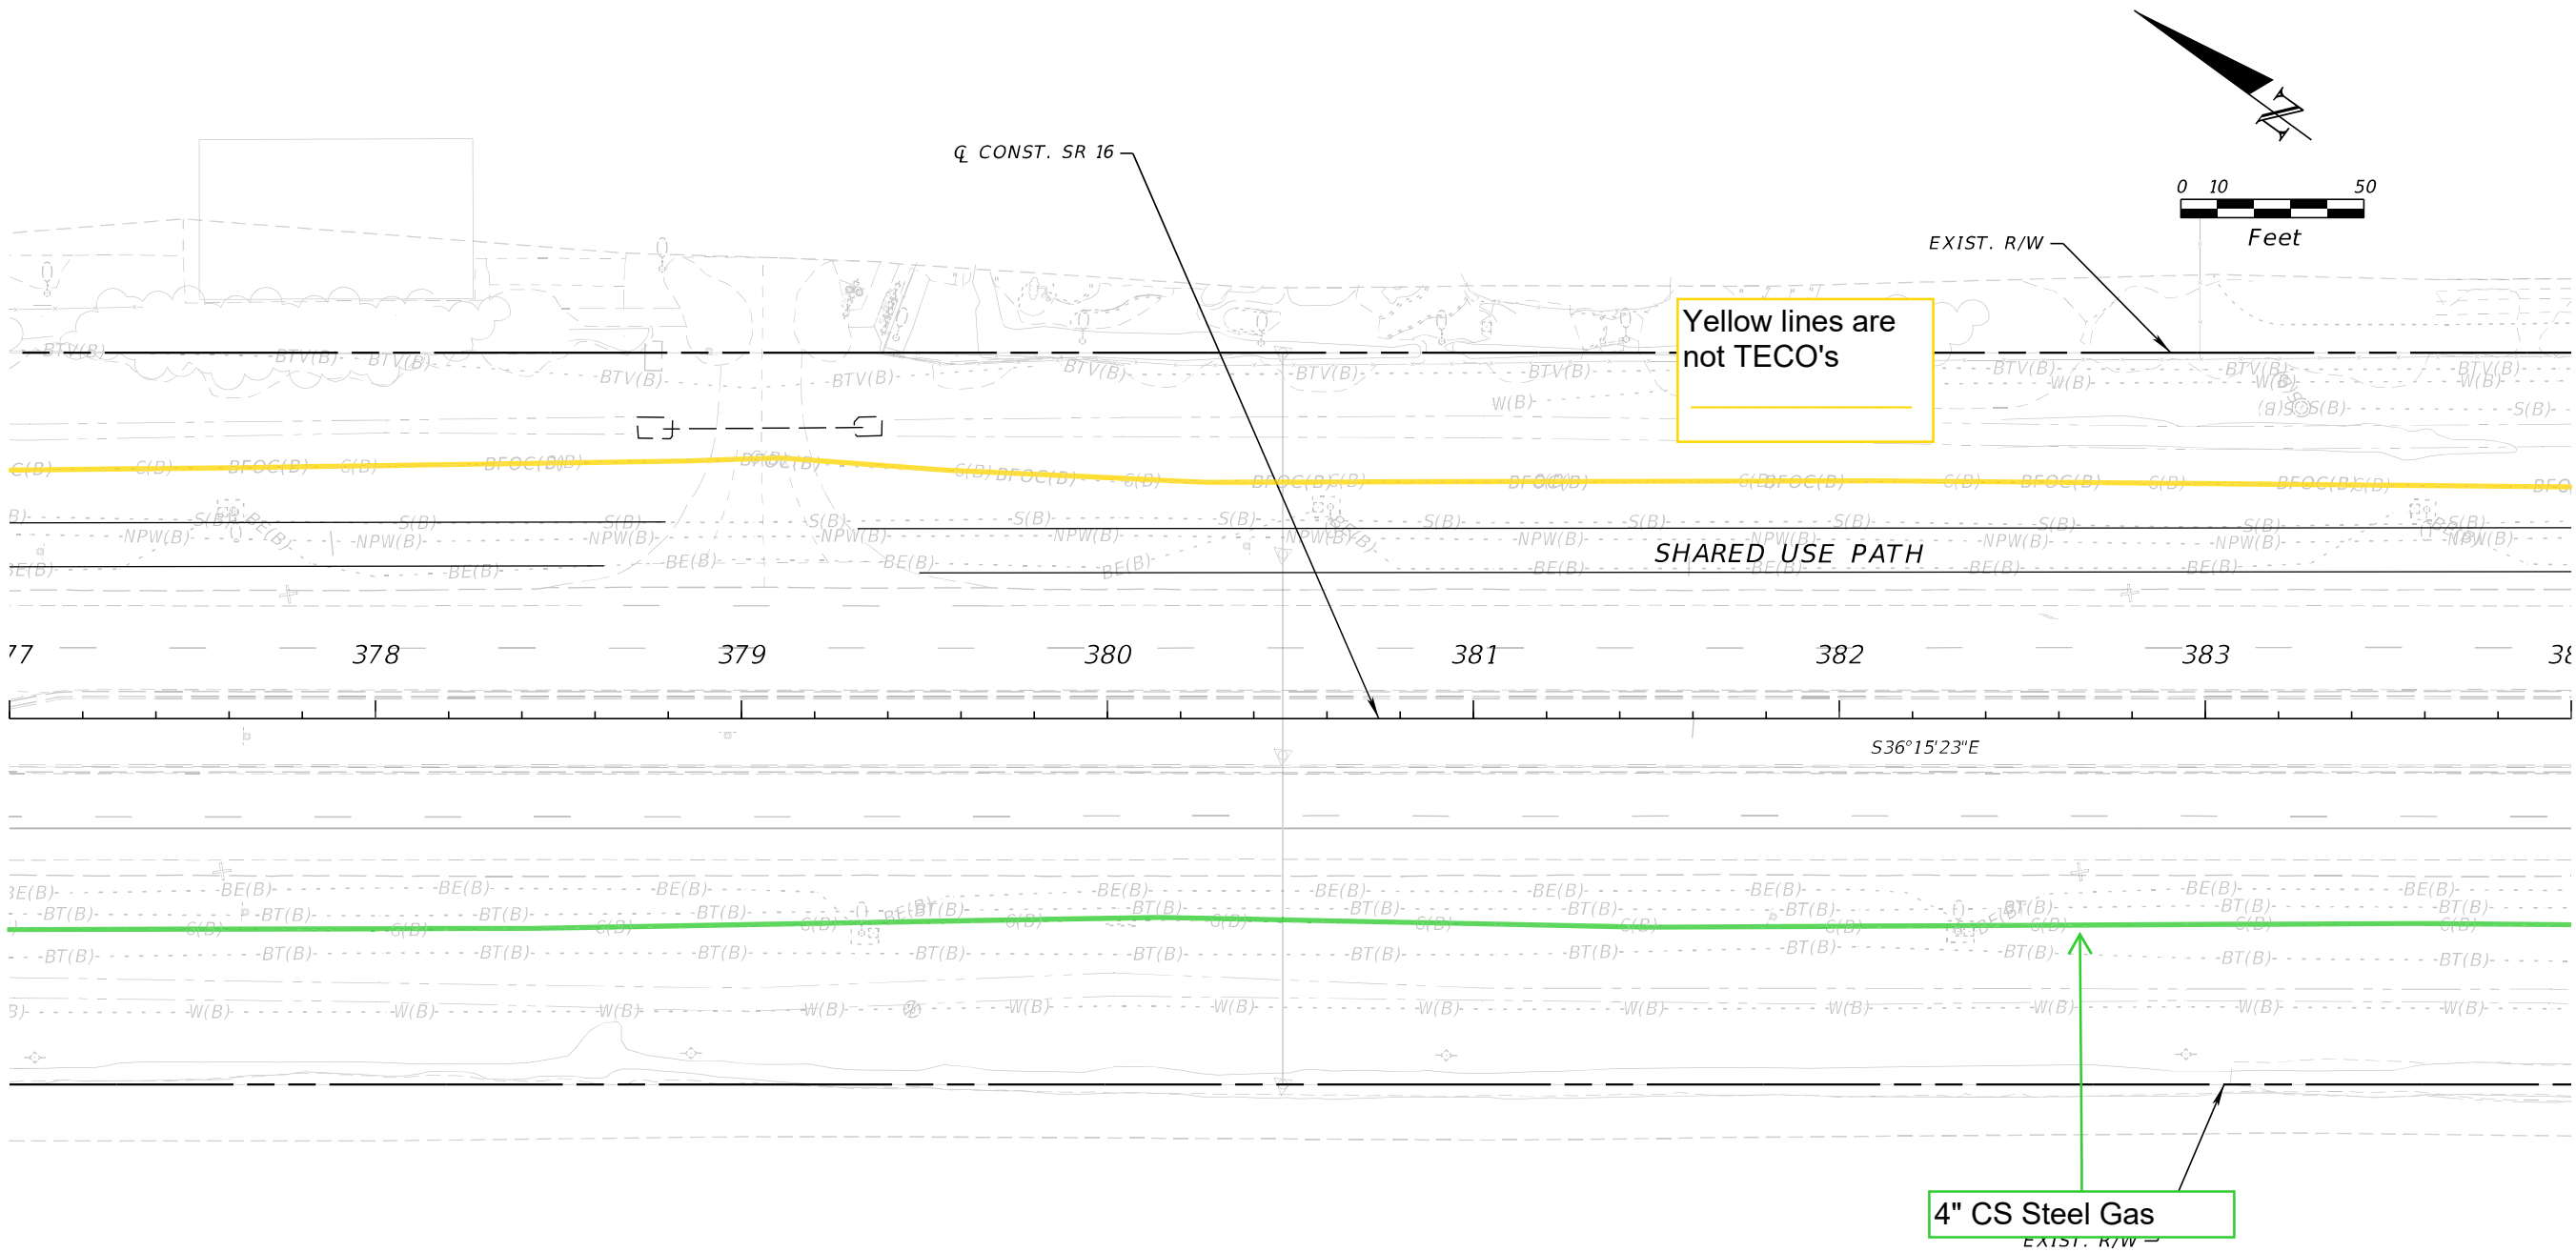


REVISIONS				ENGINEER OF RECORD		STATE OF FLORIDA DEPARTMENT OF TRANSPORTATION			SHEET NO.
DATE	DESCRIPTION	DATE	DESCRIPTION	STEPHEN J. PARK, P.E. LICENSE NUMBER: 77656 RS&H, INC. 10748 DEERWOOD PARK BLVD. SOUTH JACKSONVILLE, FL 32256		ROAD NO.	COUNTY	FINANCIAL PROJECT ID	
						SR 16	ST. JOHNS	210447-5-52-01	

THE OFFICIAL RECORD OF THIS SHEET IS THE ELECTRONIC FILE DIGITALLY SIGNED AND SEALED UNDER RULE 61G15-23.004, F.A.C.



SHOPPES AT MILL CREEK

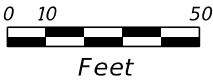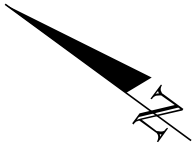

Yellow lines are  
not TECO's

2" PE Plastic Gas

SHARED USE PATH

4" CS Steel Gas


Service Line Gas

8/5/2024 4:29:04 PM BeattyM  
c:\pw\_work\ysh\_pw\pw\_user\00439575\PLANRD01.dgn

REVISIONS				ENGINEER OF RECORD		STATE OF FLORIDA DEPARTMENT OF TRANSPORTATION			SHEET NO.
DATE	DESCRIPTION	DATE	DESCRIPTION	STEPHEN J. PARK, P.E. LICENSE NUMBER: 77656 RS&H, INC. 10748 DEERWOOD PARK BLVD. SOUTH JACKSONVILLE, FL 32256		ROAD NO.	COUNTY	FINANCIAL PROJECT ID	
						SR 16	ST. JOHNS	210447-5-52-01	

THE OFFICIAL RECORD OF THIS SHEET IS THE ELECTRONIC FILE DIGITALLY SIGNED AND SEALED UNDER RULE 61G15-23.004, F.A.C.

8/5/2024 4:29:04 PM BeattyM  
c:\pw\_work\ysh\_pw\pw\_user\00439575\PLANRD01.dgn


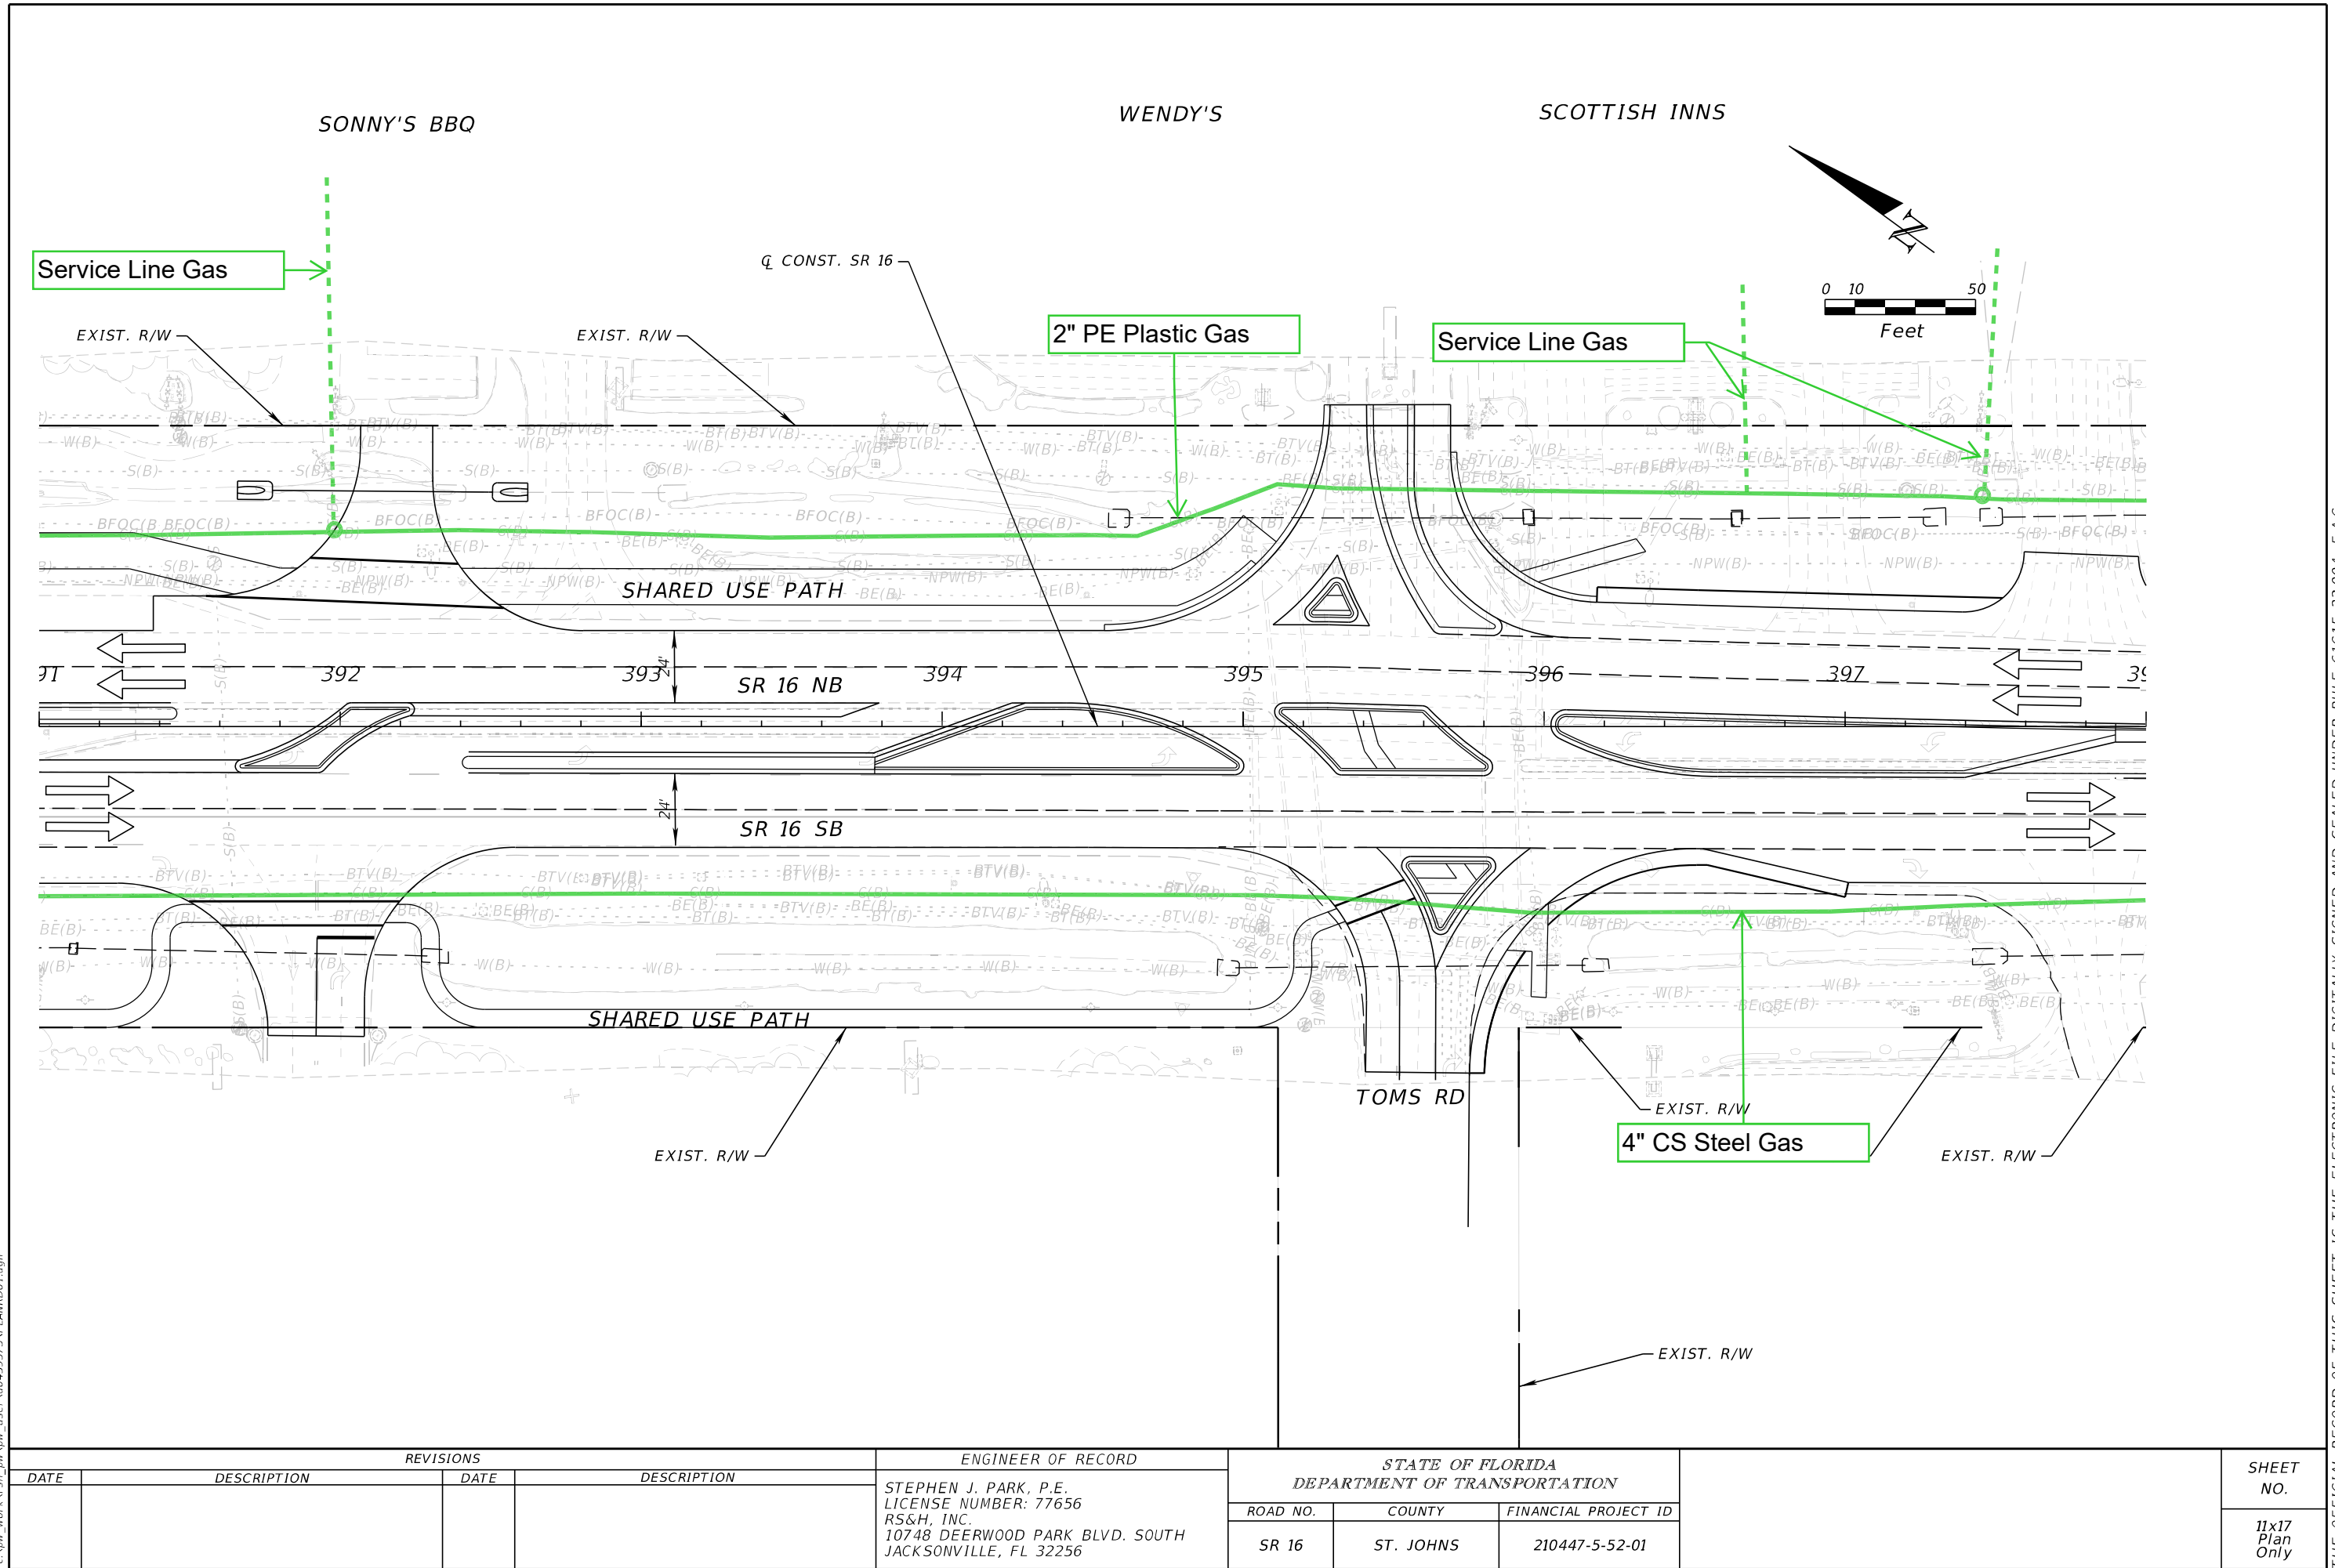


REVISIONS				ENGINEER OF RECORD		STATE OF FLORIDA DEPARTMENT OF TRANSPORTATION			SHEET NO.
DATE	DESCRIPTION	DATE	DESCRIPTION	STEPHEN J. PARK, P.E. LICENSE NUMBER: 77656 RS&H, INC. 10748 DEERWOOD PARK BLVD. SOUTH JACKSONVILLE, FL 32256		ROAD NO.	COUNTY	FINANCIAL PROJECT ID	
						SR 16	ST. JOHNS	210447-5-52-01	11x17 Plan Only

THE OFFICIAL RECORD OF THIS SHEET IS THE ELECTRONIC FILE DIGITALLY SIGNED AND SEALED UNDER RULE 61G15-23.004, F.A.C.

DAYS INN

IHOP

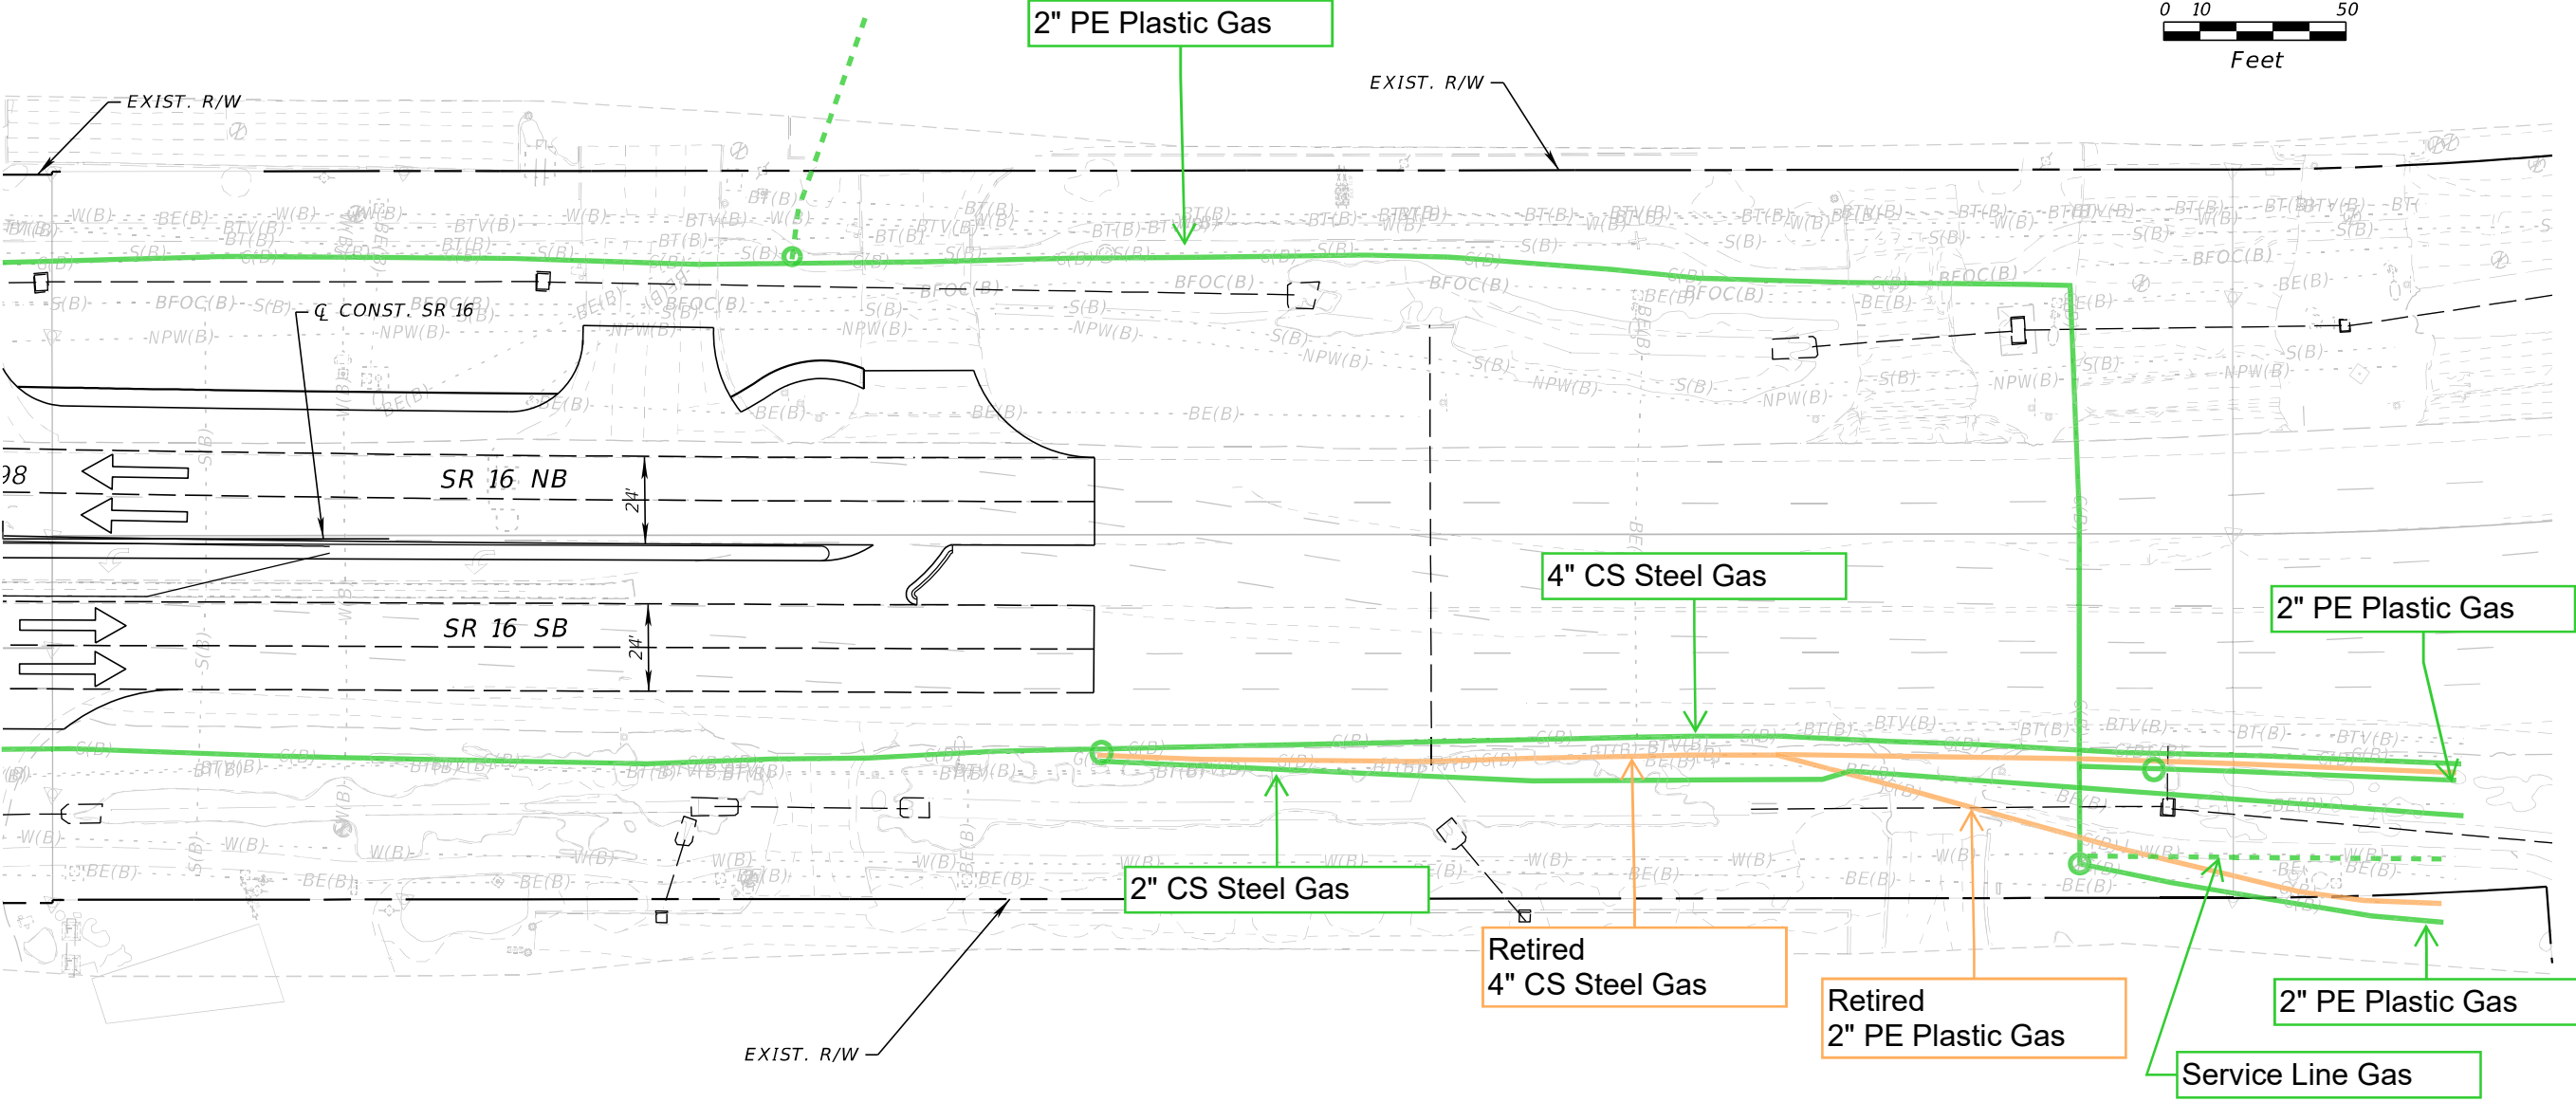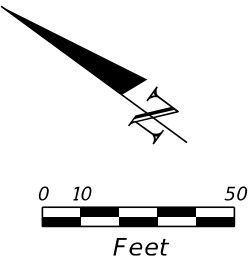

8/5/2024 4:29:05 PM BeattyM  
c:\pw\_work\ysh\_pw\pw\_user\0439575\PLANRD01.dgn

REVISIONS				ENGINEER OF RECORD		STATE OF FLORIDA DEPARTMENT OF TRANSPORTATION			SHEET NO.
DATE	DESCRIPTION	DATE	DESCRIPTION	STEPHEN J. PARK, P.E. LICENSE NUMBER: 77656 RS&H, INC. 10748 DEERWOOD PARK BLVD. SOUTH JACKSONVILLE, FL 32256		ROAD NO.	COUNTY	FINANCIAL PROJECT ID	
						SR 16	ST. JOHNS	210447-5-52-01	SR 16 - PLAN - 44

THE OFFICIAL RECORD OF THIS SHEET IS THE ELECTRONIC FILE DIGITALLY SIGNED AND SEALED UNDER RULE 61G15-23.004, F.A.C.